



K:\2012 Jobs\Engineering\12-3680\Working Documents\MicroStation\HI SR 200-00_PLAN AND PROFILE03.dgn 9:34:27 AM 3/14/2013

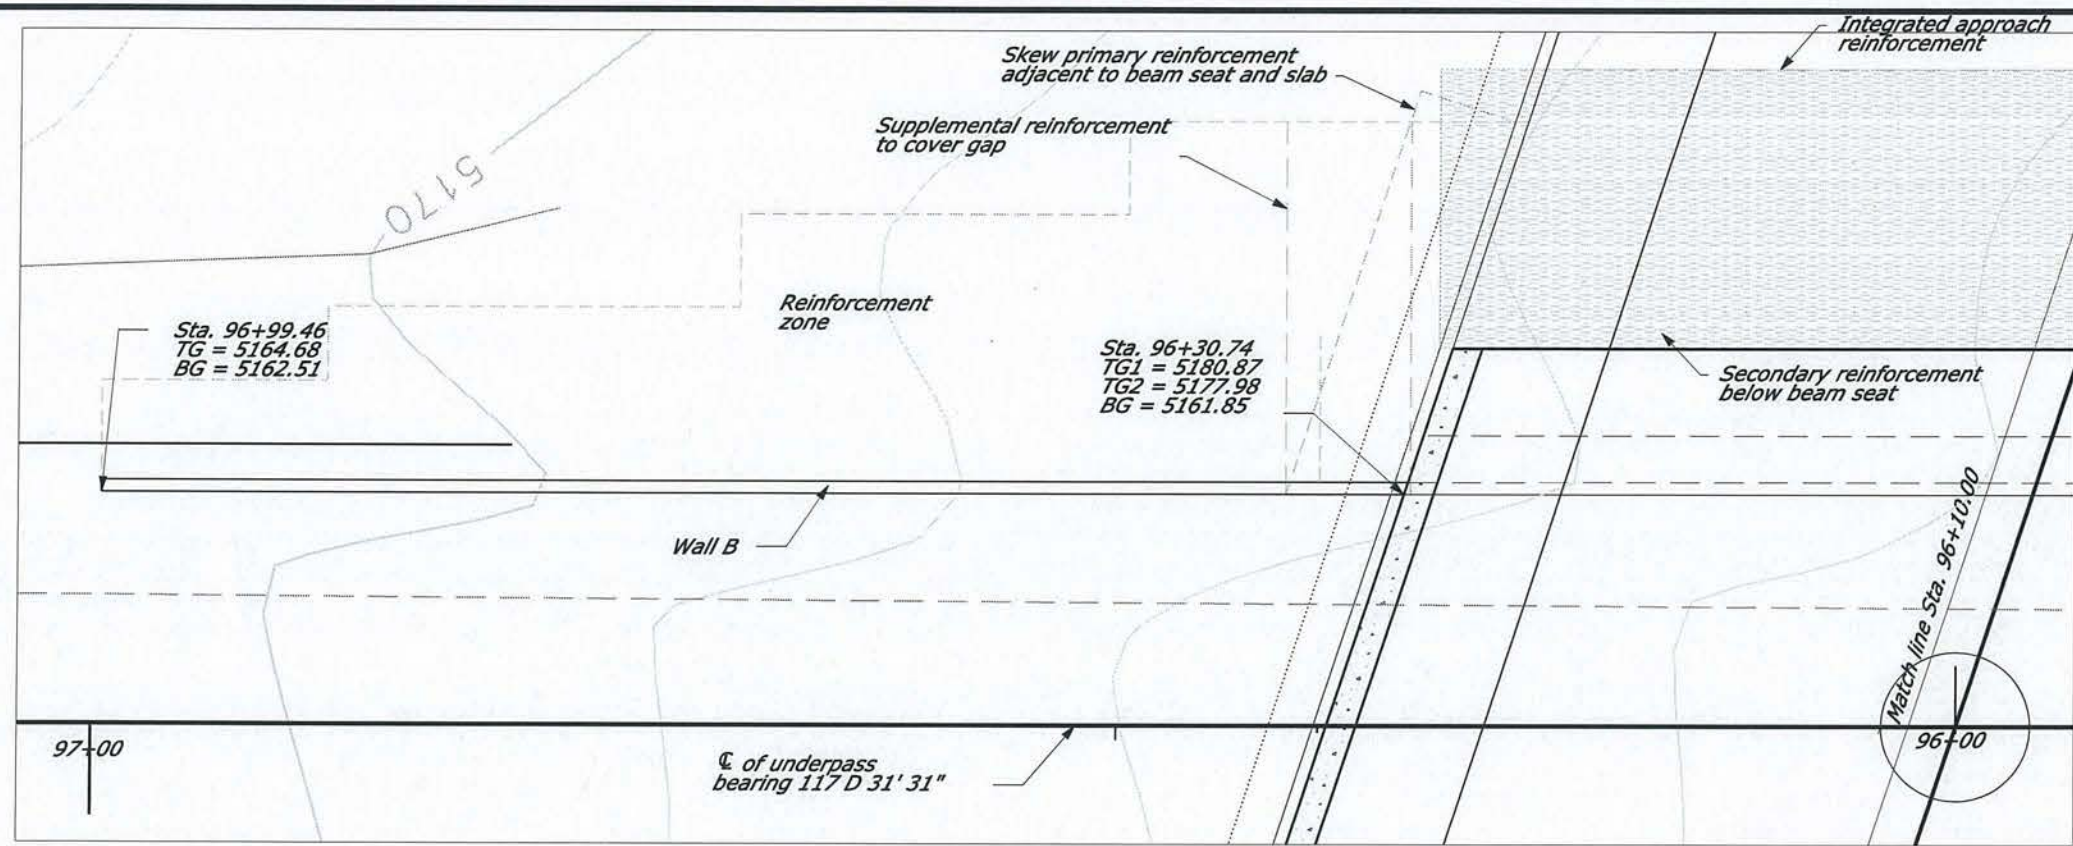


REGION	STATE	PROJECT	SHEET NO.	TOTAL SHEETS
	HI	HI A-AD 6(7)	S12	S16

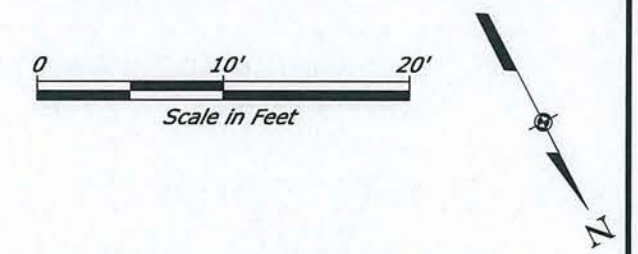

- TW Top of wall (Top of uppermost block)
 - TG Finish grade at top of wall
 - BG Finish grade at bottom of wall
 - BW Bottom of wall (Top of RSF)
 - Geotextile (Mirafi HP570)
 - EL.94.37 Elevations (+5,100 feet)
 - Limits of required 7.5' secondary reinforcement (secondary reinforcement not shown)
- Primary reinforcement shall be placed at vertical spacing equal to the height of CMU Block at each course of blocks.
- Secondary reinforcement shall be placed between layers of primary reinforcement at equal vertical spacing.

B1 Sta. 96+99.46
Begin Wall B
(East)

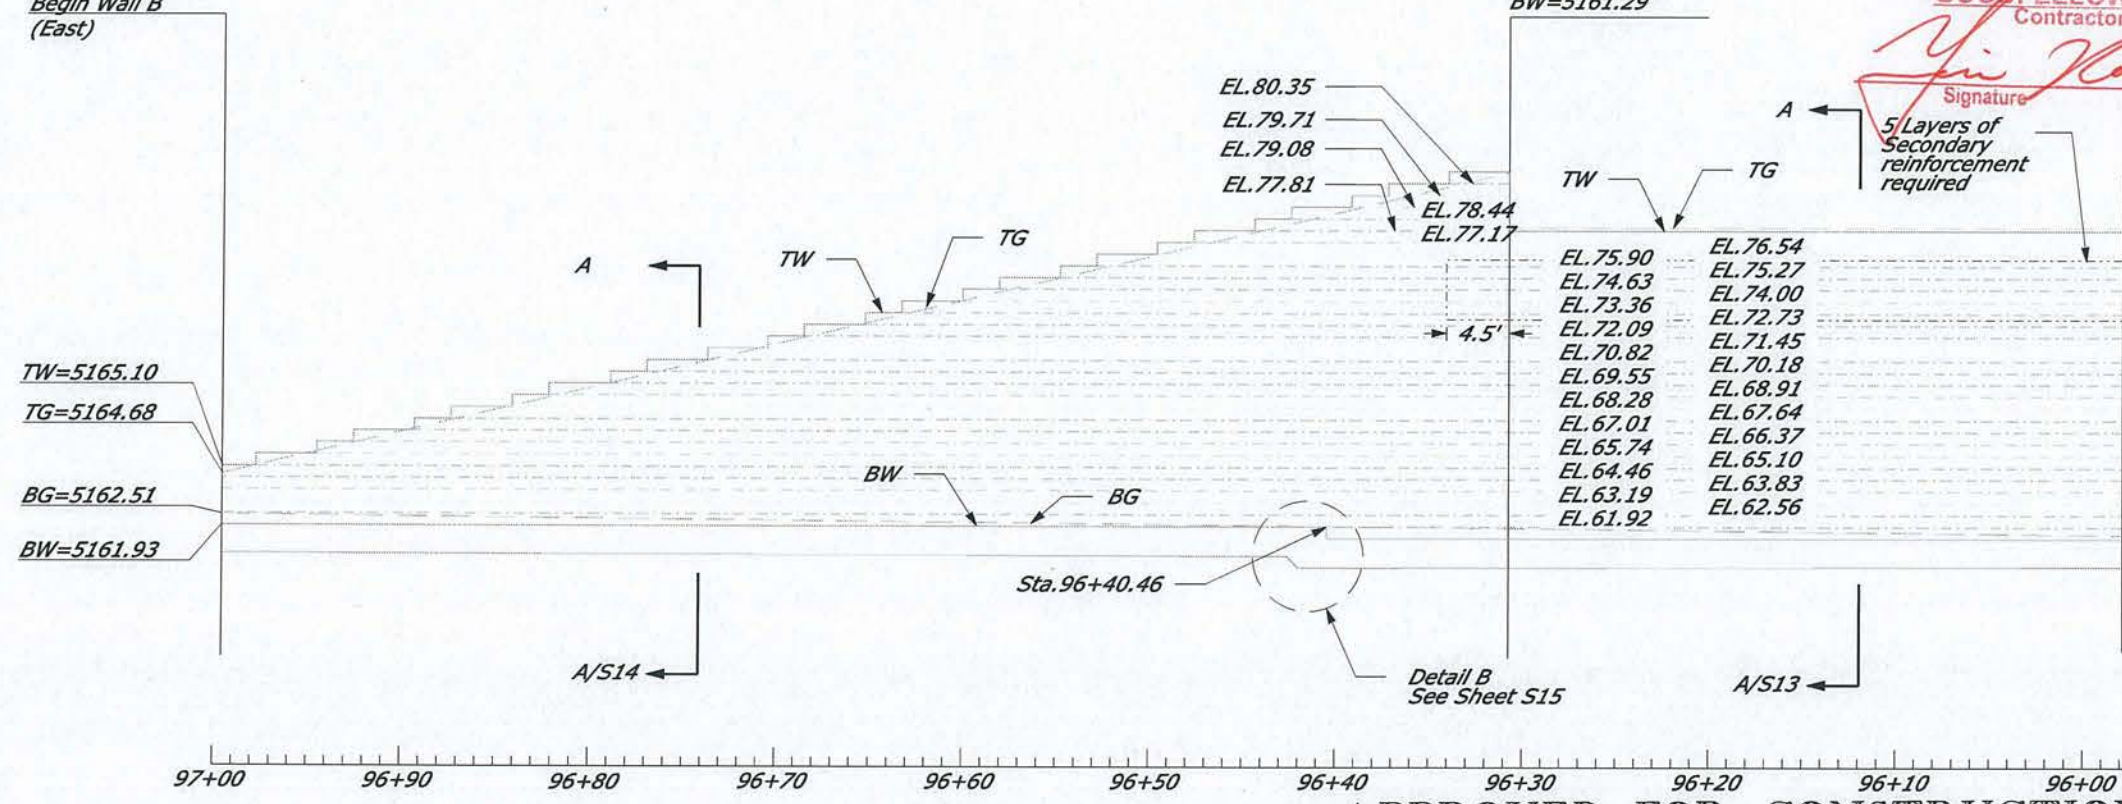

AS-BUILT DRAWINGS/SPECIFICATIONS

This certifies that the dimensions and details shown on this sheet reflect the dimensions and details and specifications as constructed in the field.

GOODFELLOW BROS., INC.
Contractor's Name:

Signature: *Yin Han*
Date: 1/2/14



THIS WORK WAS PREPARED BY ME OR UNDER MY SUPERVISION.

Signature: *Hsiang-Chiang*

SIGNATURE: _____ EXPIRATION DATE OF THE LICENSE: 04/30/14

U.S. DEPARTMENT OF TRANSPORTATION
FEDERAL HIGHWAY ADMINISTRATION
CENTRAL FEDERAL LANDS HIGHWAY DIVISION

GRS-IBS
WALL B PLAN AND PROFILE 01
STA. 96+99.46 TO STA. 96+10.00


APPROVED FOR CONSTRUCTION

NO.	DATE	BY	REVISIONS	NO.	DATE	BY	REVISIONS	DESIGNED BY	DRAWN BY	CHECKED BY	SCALE
								J.ARTHURS	H.SIDERS	H.H.CHIANG	AS SHOWN



BRIDGE DRAWING	DATE	DRAWING NO.
12 of 16	MARCH 2013	-


REGION	STATE	PROJECT	SHEET NO.	TOTAL SHEETS
	HI	HI A-AD 6(7)	S13	S16

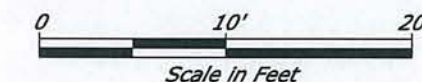

- TW Top of wall (Top of uppermost block)
- TG Finish grade at top of wall
- BG Finish grade at bottom of wall
- BW Bottom of wall (Top of RSF)
- Geotextile (Mirafi HP570)
- EL. 94.37 Elevations (+5, 100 feet)
- Limits of required 7.5' secondary reinforcement (secondary reinforcement not shown)

Primary reinforcement shall be placed at vertical spacing equal to the height of CMU Block at each course of blocks.

Secondary reinforcement shall be placed between layers of primary reinforcement at equal vertical spacing.

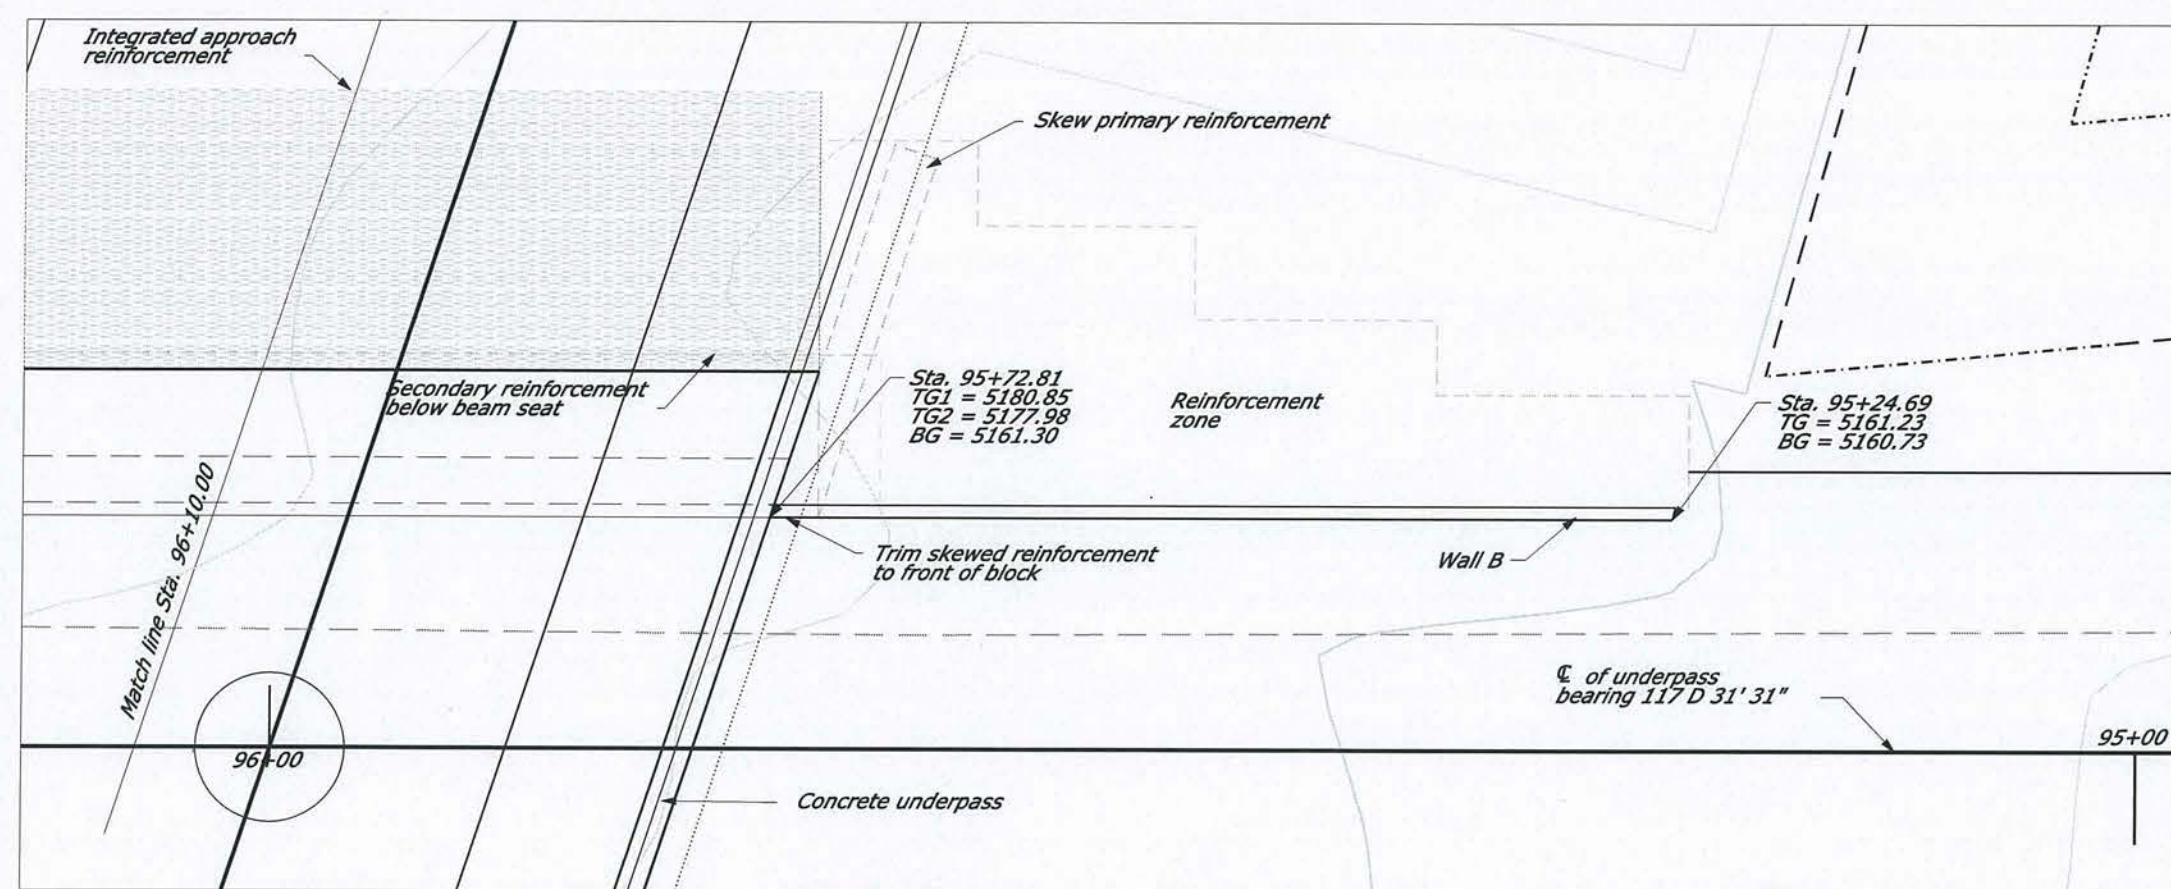

B3 Sta. 95+72.81
TW=5177.81 / 80.35
TG=5177.98 / 80.85
BG=5161.30
BW=5160.65

B4 Sta. 95+24.69
End Wall B
(West)

AS-BUILT DRAWINGS/SPECIFICATIONS
This certifies that the dimensions and details shown on this sheet reflect the dimensions and details and specifications as constructed in the field.
GOODFELLOW BROS., INC.
Contractor's Name:
[Signature]
Signature
1/2/14
Date




THIS WORK WAS PREPARED BY ME OR UNDER MY SUPERVISION.

SIGNATURE 04/30/14
EXPIRATION DATE OF THE LICENSE

U.S. DEPARTMENT OF TRANSPORTATION
FEDERAL HIGHWAY ADMINISTRATION
CENTRAL FEDERAL LANDS HIGHWAY DIVISION

**GRS-IBS
WALL B PLAN AND PROFILE 02
STA. 96+ 10.00 TO STA. 95+24.69**

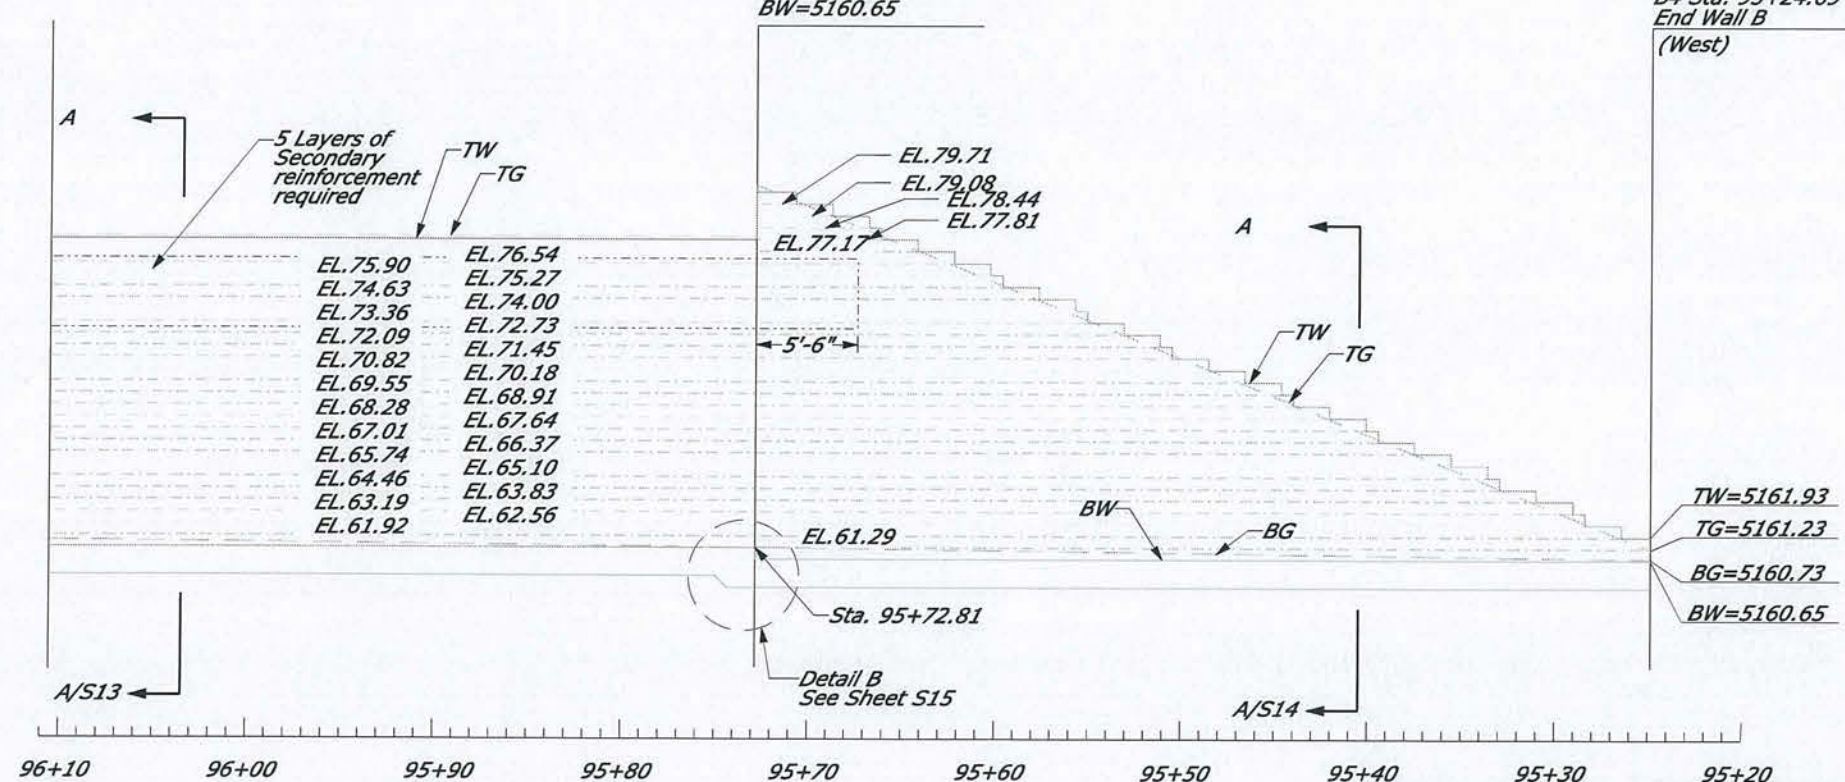

APPROVED FOR CONSTRUCTION

3/14/2013 9:35:21 AM K:\2012 Jobs\Engineering\12-3680\Working Documents\MicroStation\HI SR 200-00_PLAN AND PROFILE04.dgn

NO.	DATE	BY	REVISIONS	NO.	DATE	BY	REVISIONS	DESIGNED BY	DRAWN BY	CHECKED BY	SCALE
								J.ARTHURS	H.SIDERS	H.H.CHIANG	AS SHOWN



BRIDGE DRAWING	DATE	DRAWING NO.
13 of 16	MARCH 2013	-