


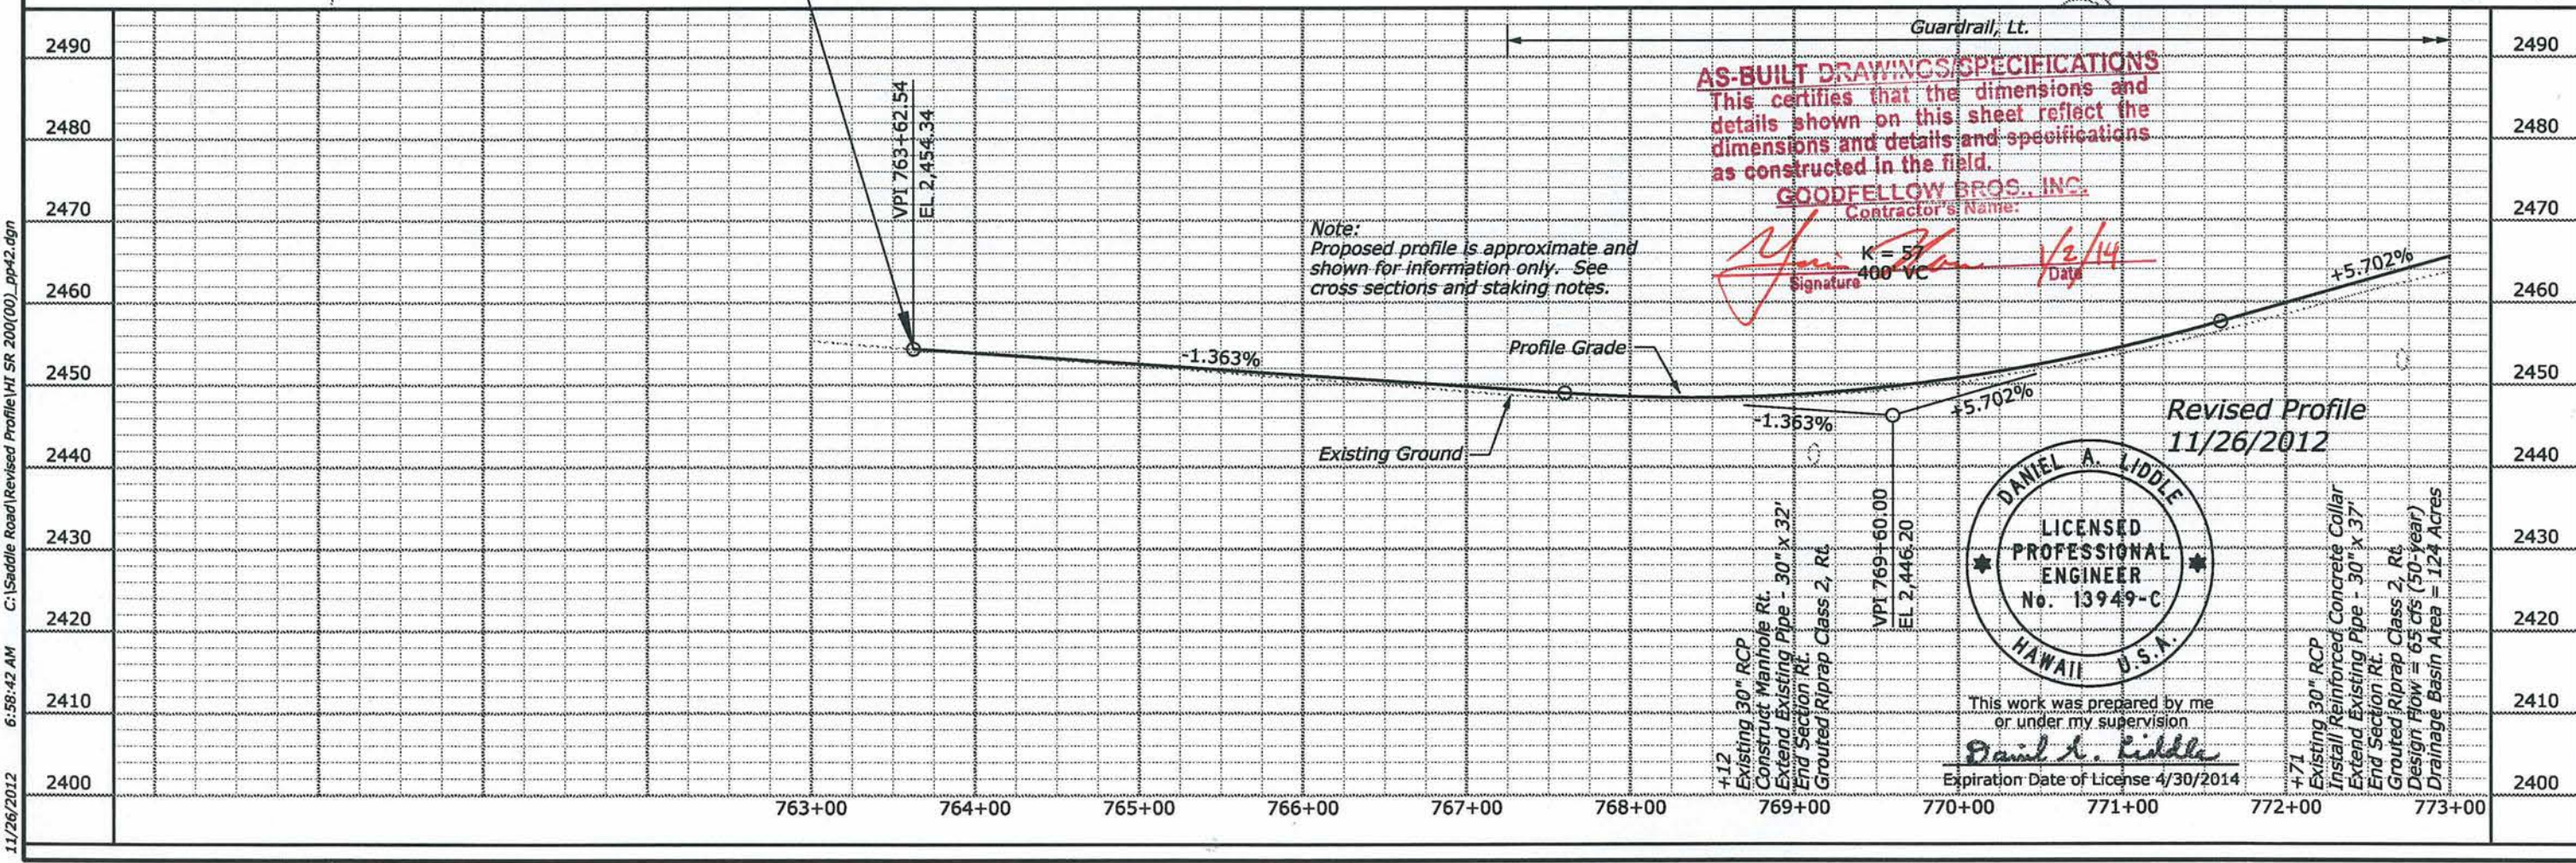
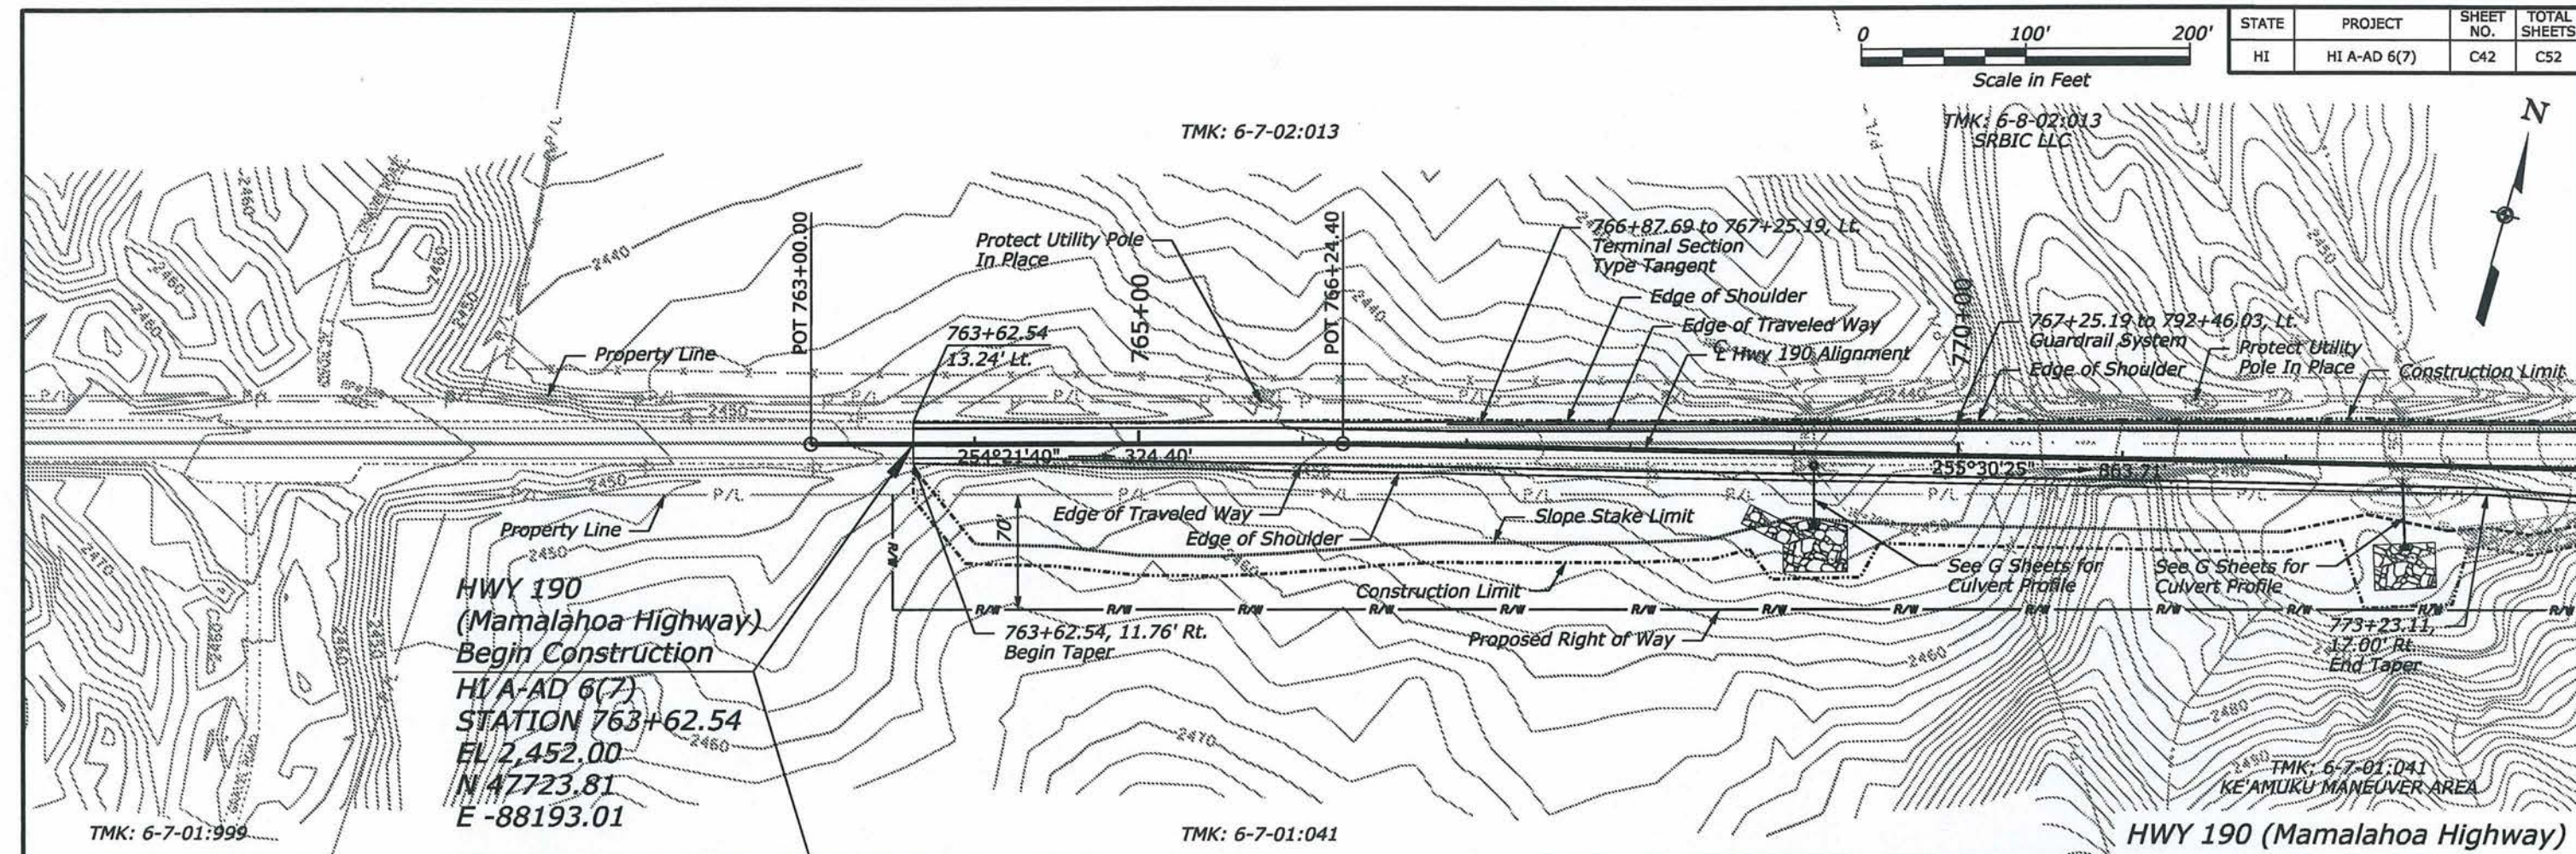


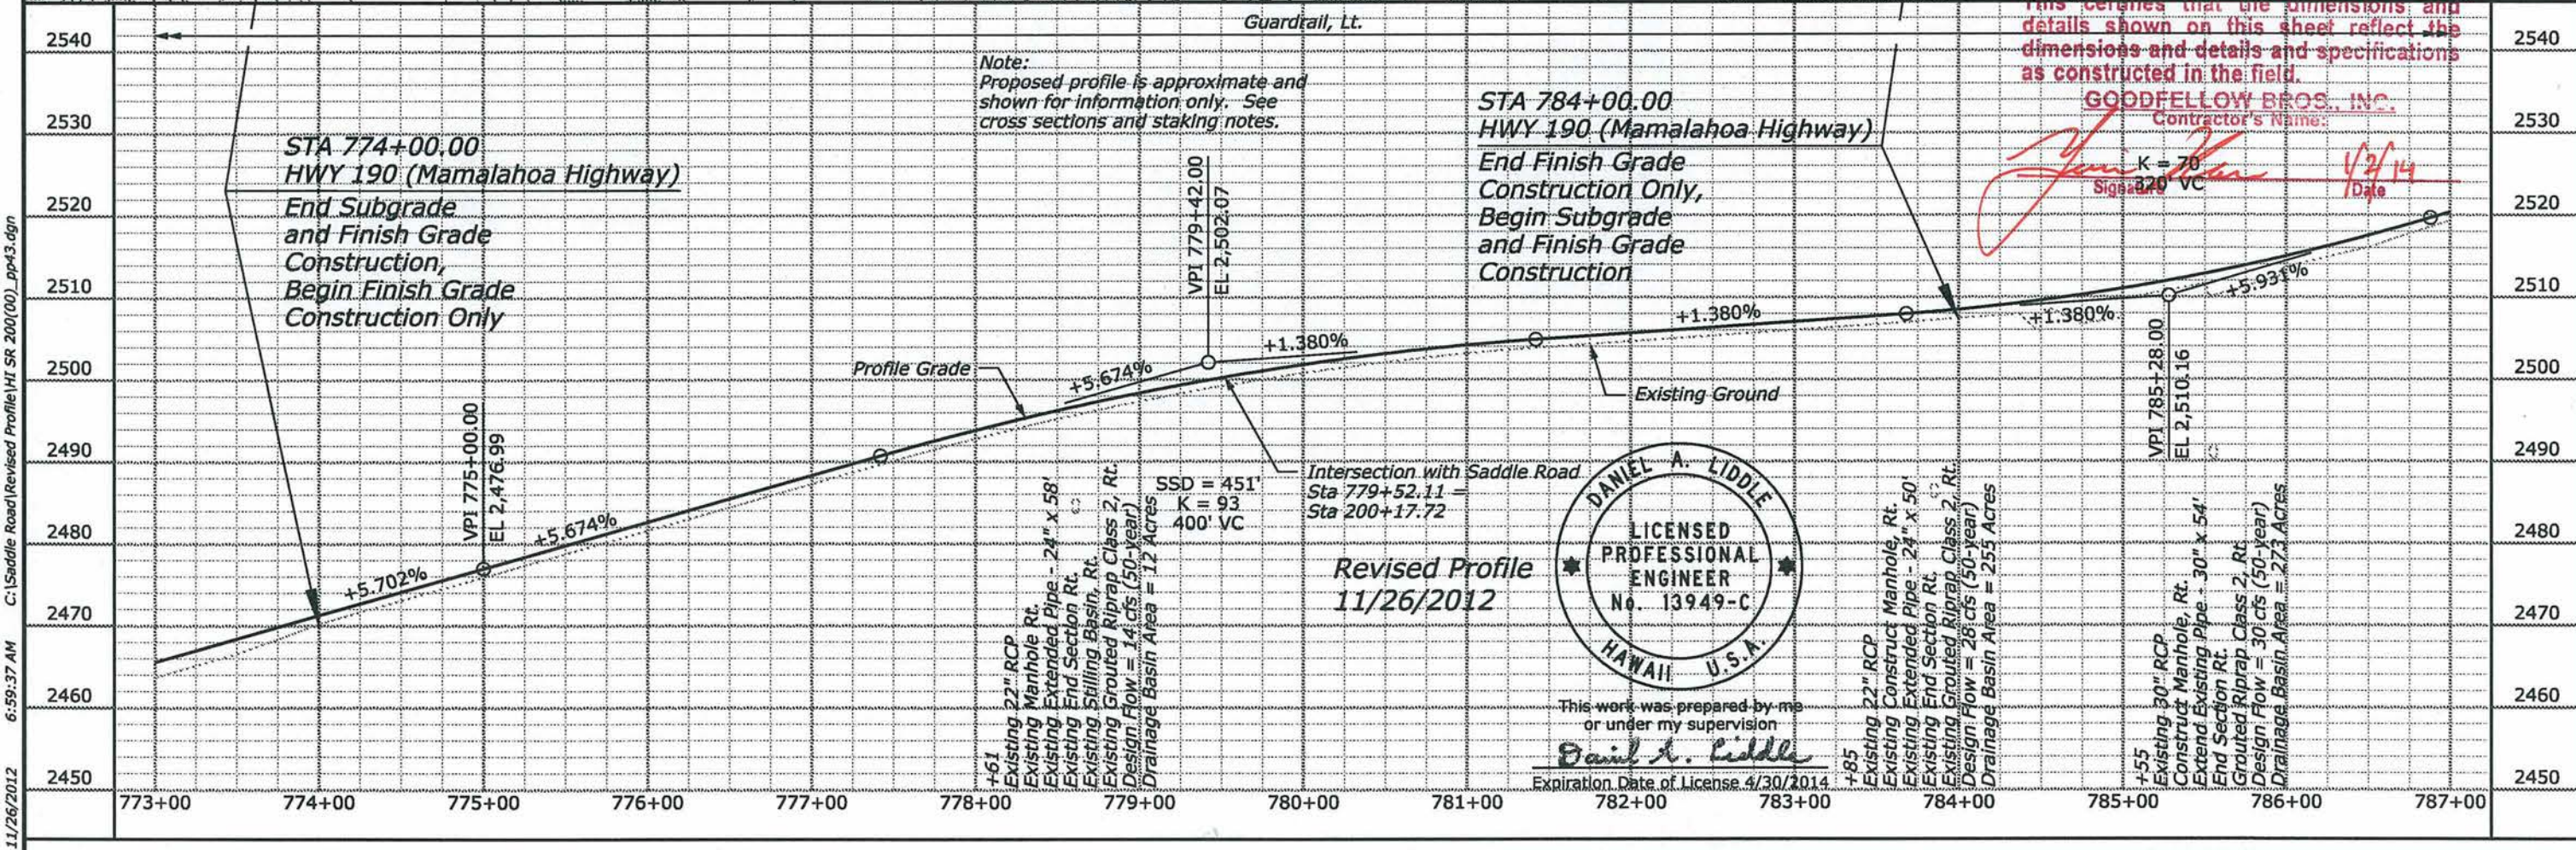

11/26/2012 6:58:42 AM C:\Saddle Road\Revised Profile\HI SR 200(00)_pp42.dgn

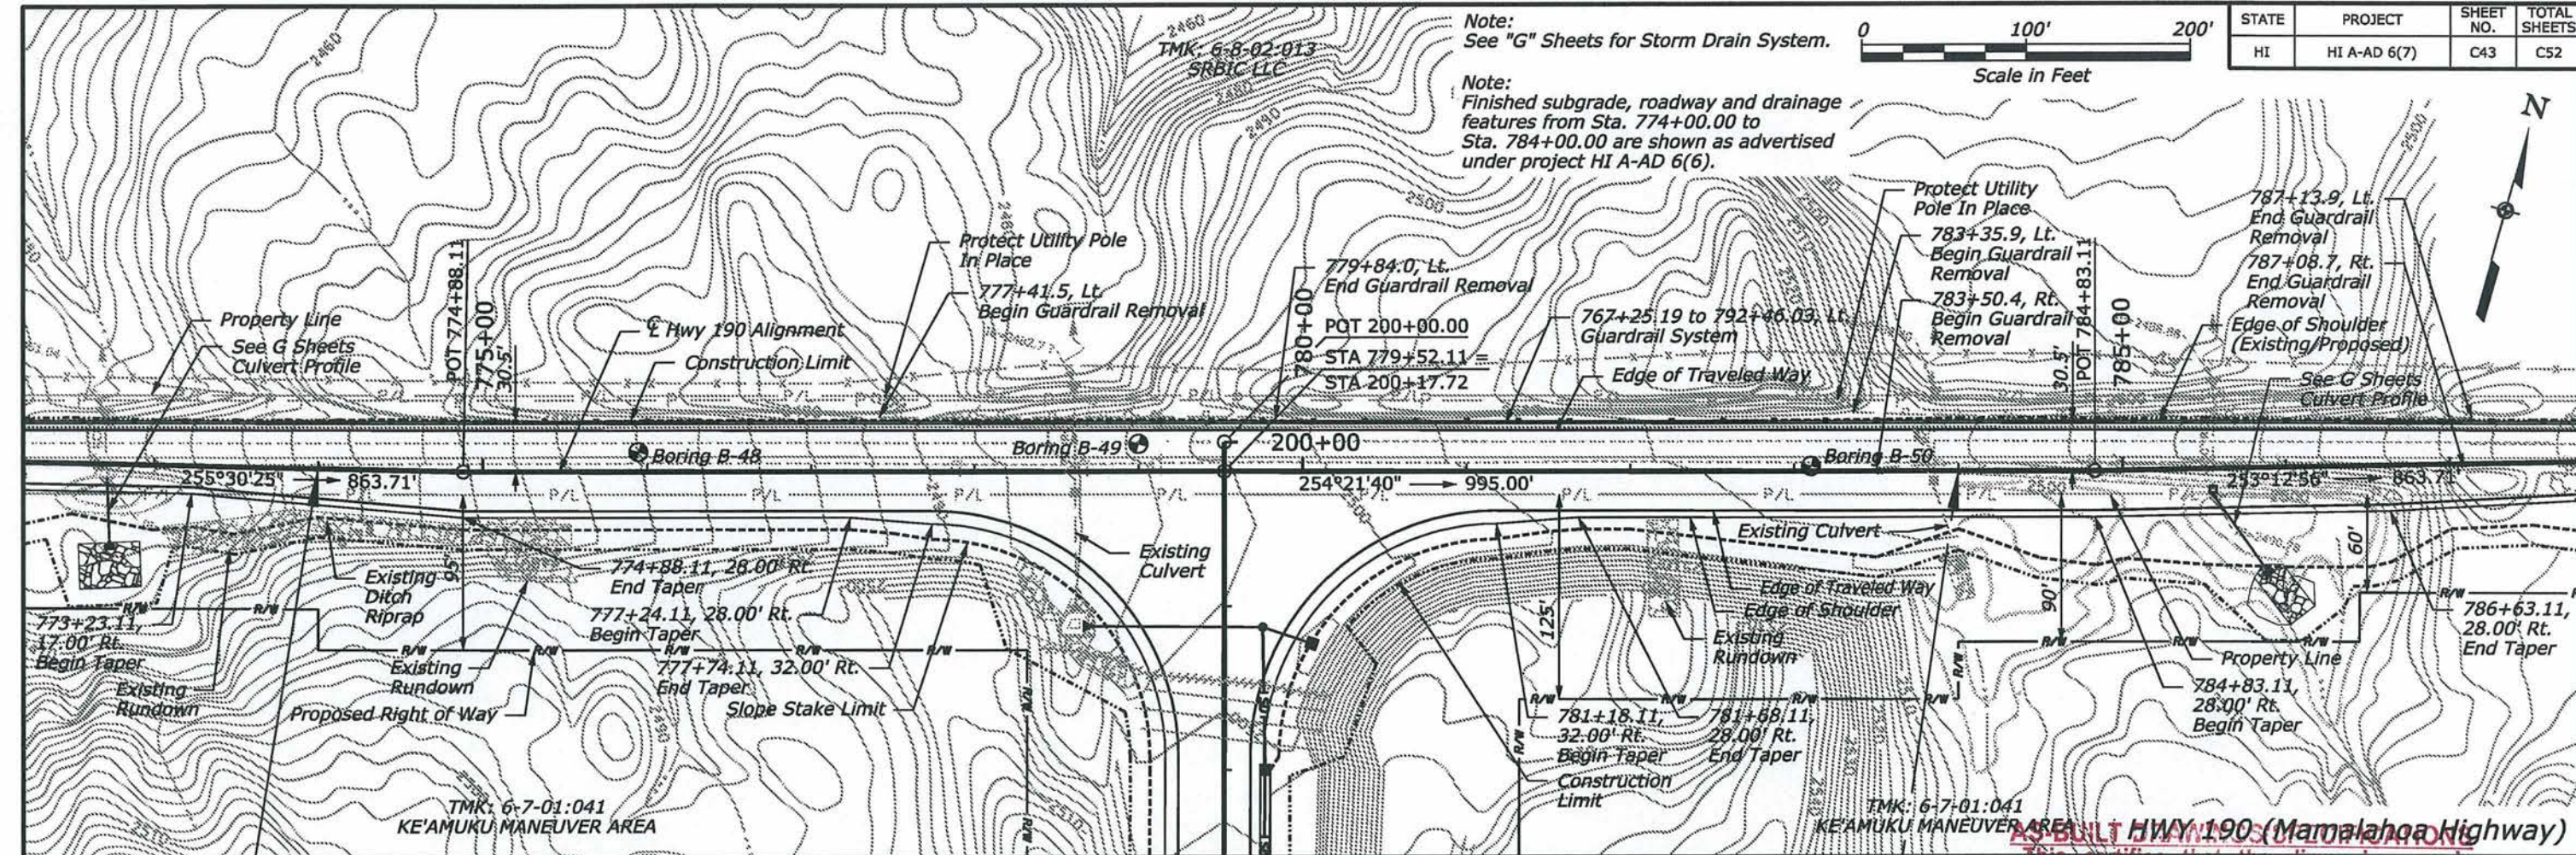


11/26/2012 6:59:37 AM C:\Saddle Road Revised Profile\HI SR 200(00)_pp43.dgn

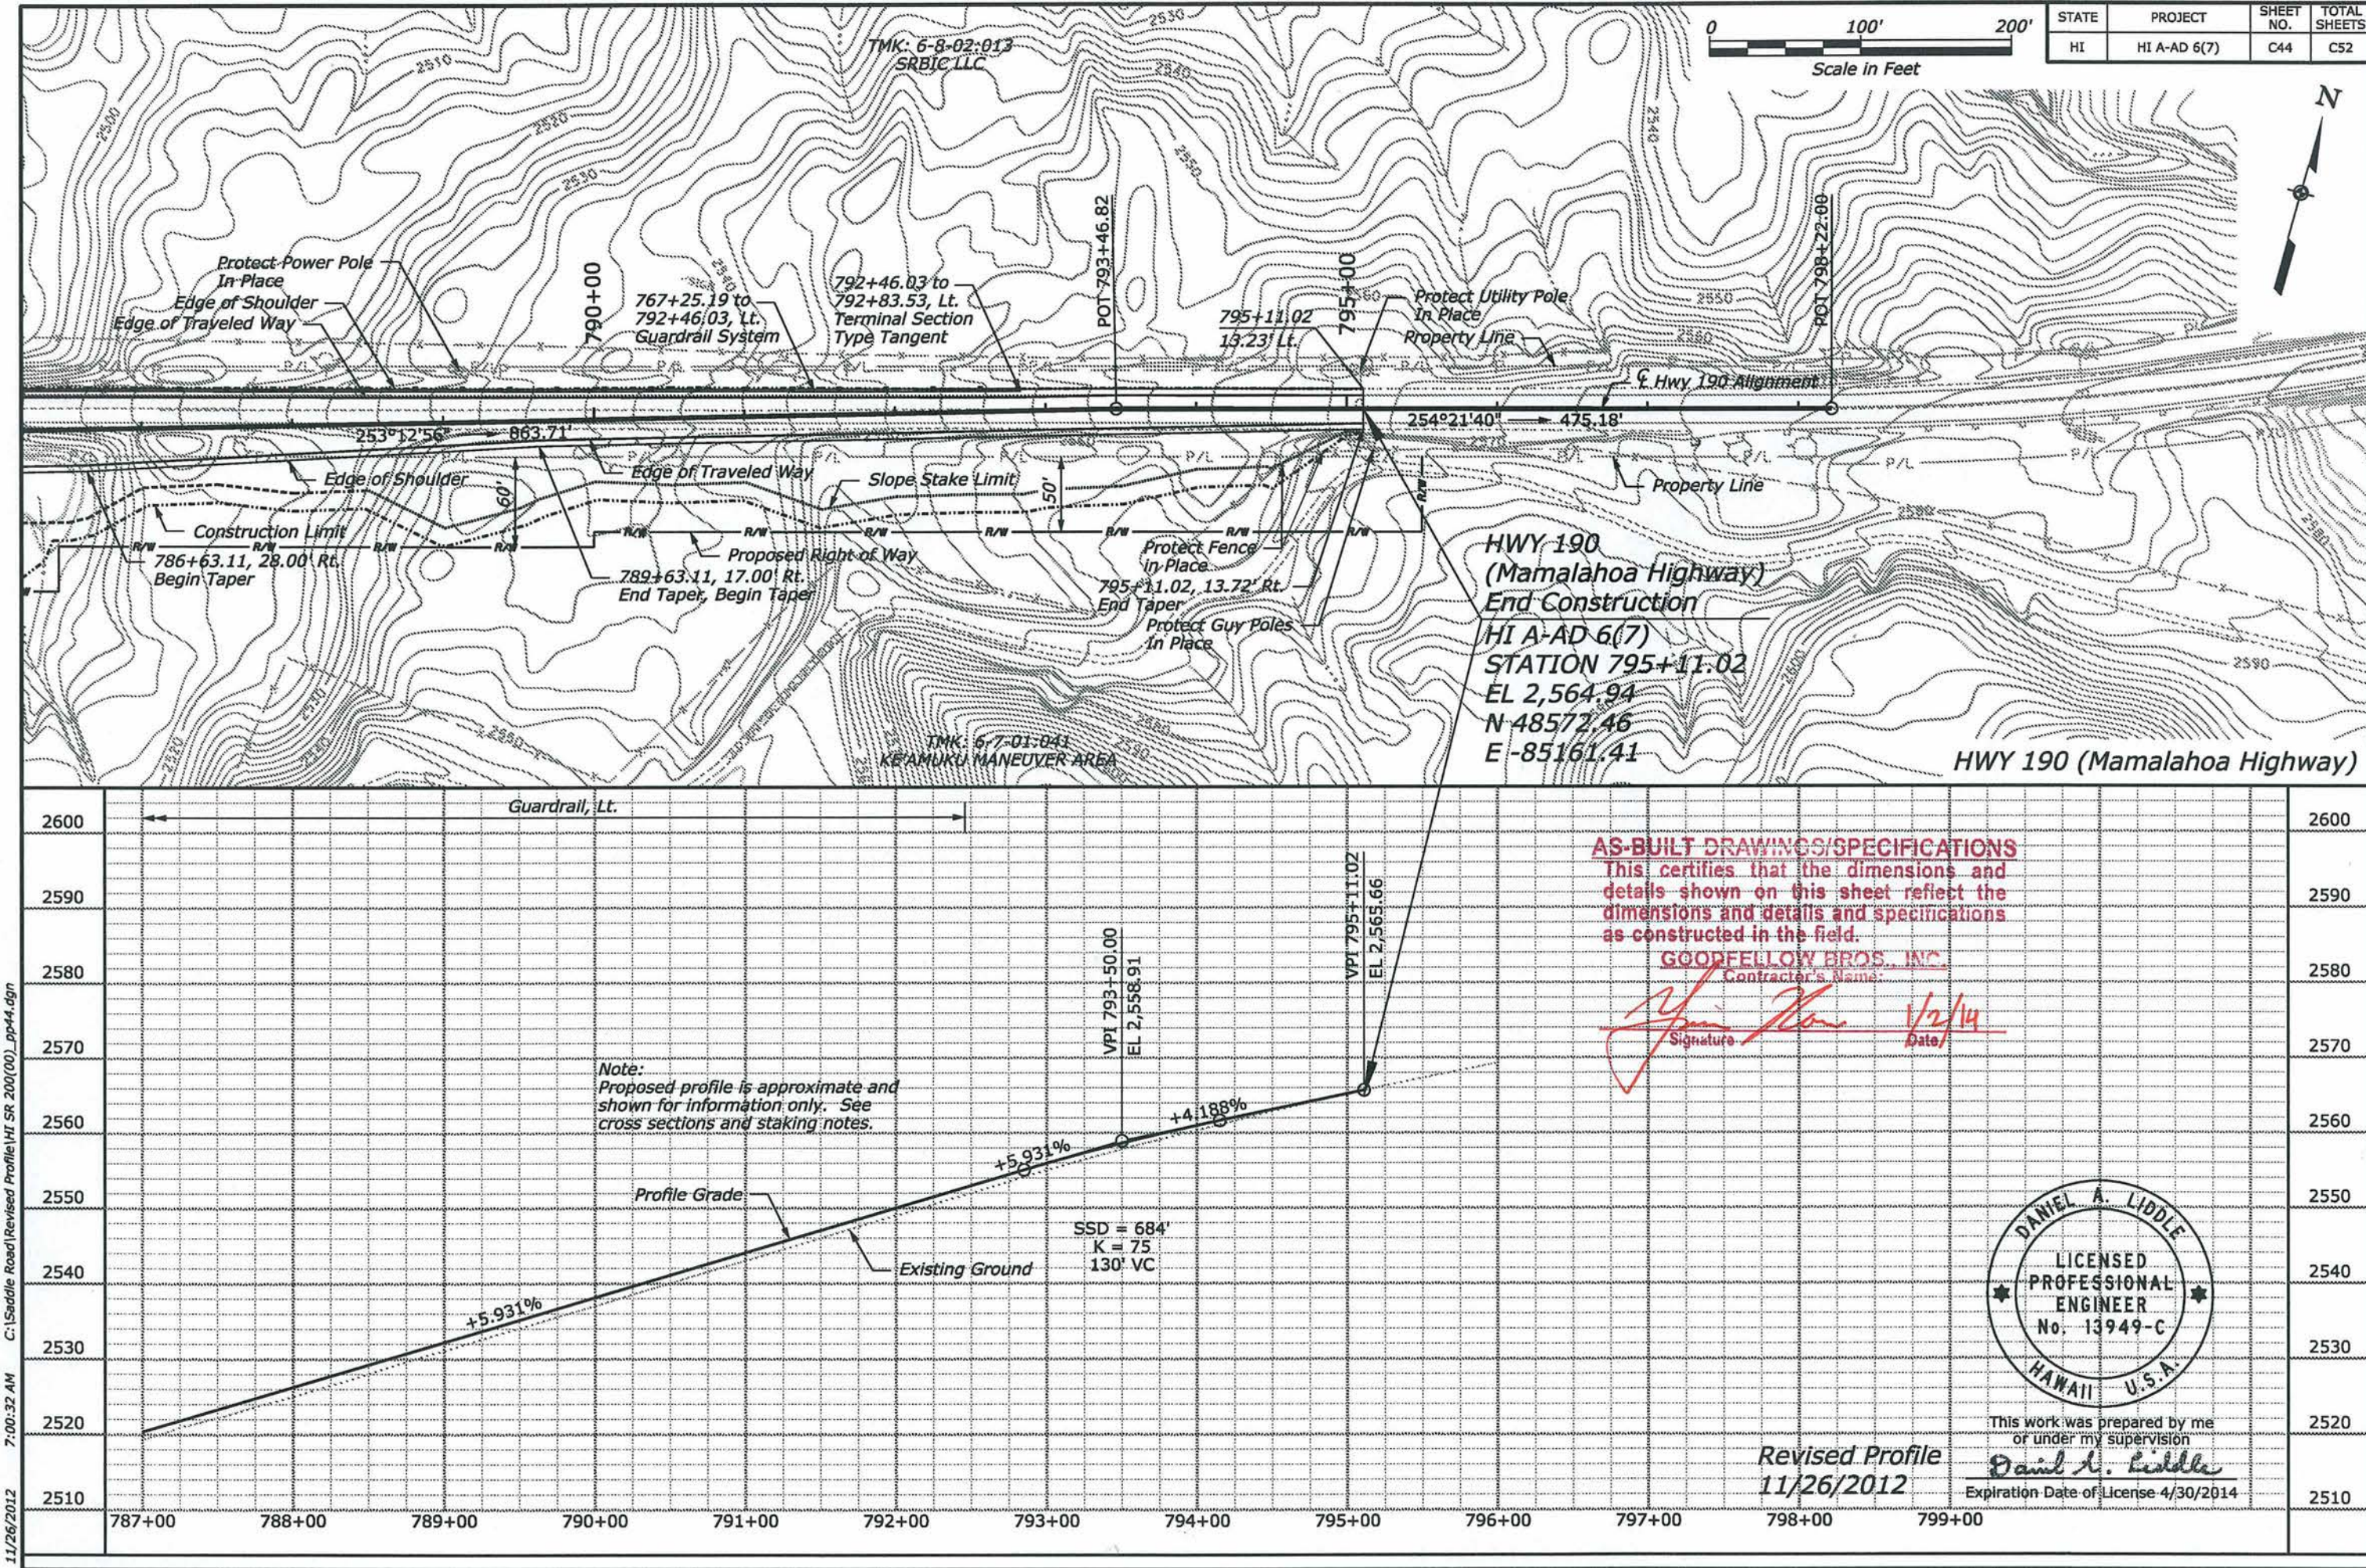

11/26/2012 7:00:32 AM C:\Saddle Road Revised Profile\HI SR 200(00)_pp44.dgn

Revised Profile
11/26/2012

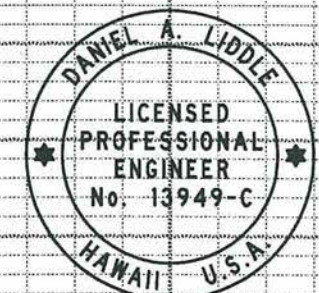

This work was prepared by me
or under my supervision
Daniel A. Liddle
Expiration Date of License 4/30/2014