


M:\2009\2009_057_001 ANA Saddle Road West Side Bid Pkg 2\IG Dwg\Contract Documents\Civil\Roadway\Sheets\HI SR 200(00)_ecp106.dgn
9/21/2011 1:49:02 PM

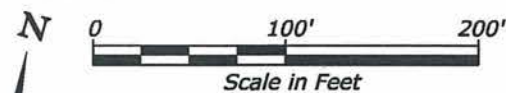

NOTE:

1. Erosion and sediment control devices not to scale.
2. Refer to the Conventional Plan Symbols and Abbreviations sheet for erosion and sediment control symbols.

STATE	PROJECT	SHEET NO.	TOTAL SHEETS
HI	HI A-AD 6(7)	E6	E17

TMK: 6-8-02:013

TMK: 6-7-02:013

HWY 190
(Mamalahoa Highway)
Begin Construction
HI A-AD 6(7)
STATION 763+62.54

Sediment Logs in Ditch
spaced at 150' intervals
(typ.), see Special 157-D

Sediment Logs in Ditch
spaced at 30' intervals
(typ.), see Special 157-D

AS-BUILT DRAWINGS/SPECIFICATIONS
This certifies that the dimensions and details shown on this sheet reflect the dimensions and details and specifications as constructed in the field.

GOODFELLOW-BROS., INC.
Contractor's Name

[Signature]
Signature
1/2/14
Date

See G Sheets for
Culvert Inlet Riprap
(typ.)

TMK: 6-7-01:041
KE'AMUKU MANEUVER AREA

TMK: 6-7-01:999

TMK: 6-7-01:041

STA 774+00.00
HWY 190 (Mamalahoa Highway)
End Subgrade and Finish Grade
Construction, Begin Finish
Grade Construction Only

TMK: 6-8-02:013
SRBIC LLC

Note:
Finished subgrade, roadway and drainage features from
Sta. 774+00.00 to Sta. 784+00.00 are shown as advertised
under project HI A-AD 6(6).

POT 200+00.00
STA 779+52.11 =
STA 200+17.72

200+00


Sediment logs placed
around drain inlets (typ.)

STA 784+00.00
HWY 190
(Mamalahoa Highway)
End Finish Grade Construction
Only, Begin Subgrade and
Finish Grade Construction

TMK: 6-7-01:041
KE'AMUKU MANEUVER AREA


U.S. DEPARTMENT OF TRANSPORTATION
FEDERAL HIGHWAY ADMINISTRATION
CENTRAL FEDERAL LANDS HIGHWAY DIVISION

**HWY 190 (MAMALAHOA HWY)
EROSION AND SEDIMENT
CONTROL PLAN
764+00 to 787+00**

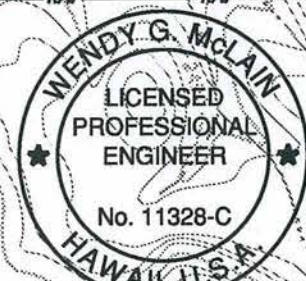

THIS WORK WAS PREPARED BY ME OR
UNDER MY SUPERVISION.


[Signature]
SIGNATURE
4/30/2012
EXPIRATION DATE
OF THE LICENSE

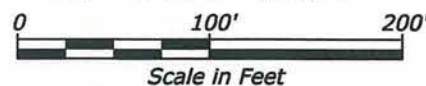

TMK: 6-7-01:041
KE'AMUKU MANEUVER AREA


M:\2009\2009_057.001 ANA Saddle Road West Side Bid Pkg 2\G Dwg\Contract Documents\Civil\Roadway\Sheets\E-150\HI SR 200(00).epc\07.dgn
9/21/2011 1:46:28 PM

TMK: 6-8-02:013
SRBIC LLC

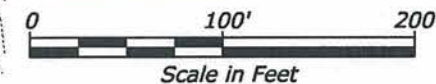

STATE	PROJECT	SHEET NO.	TOTAL SHEETS
HI	HI A-AD 6(7)	E7	E17

N

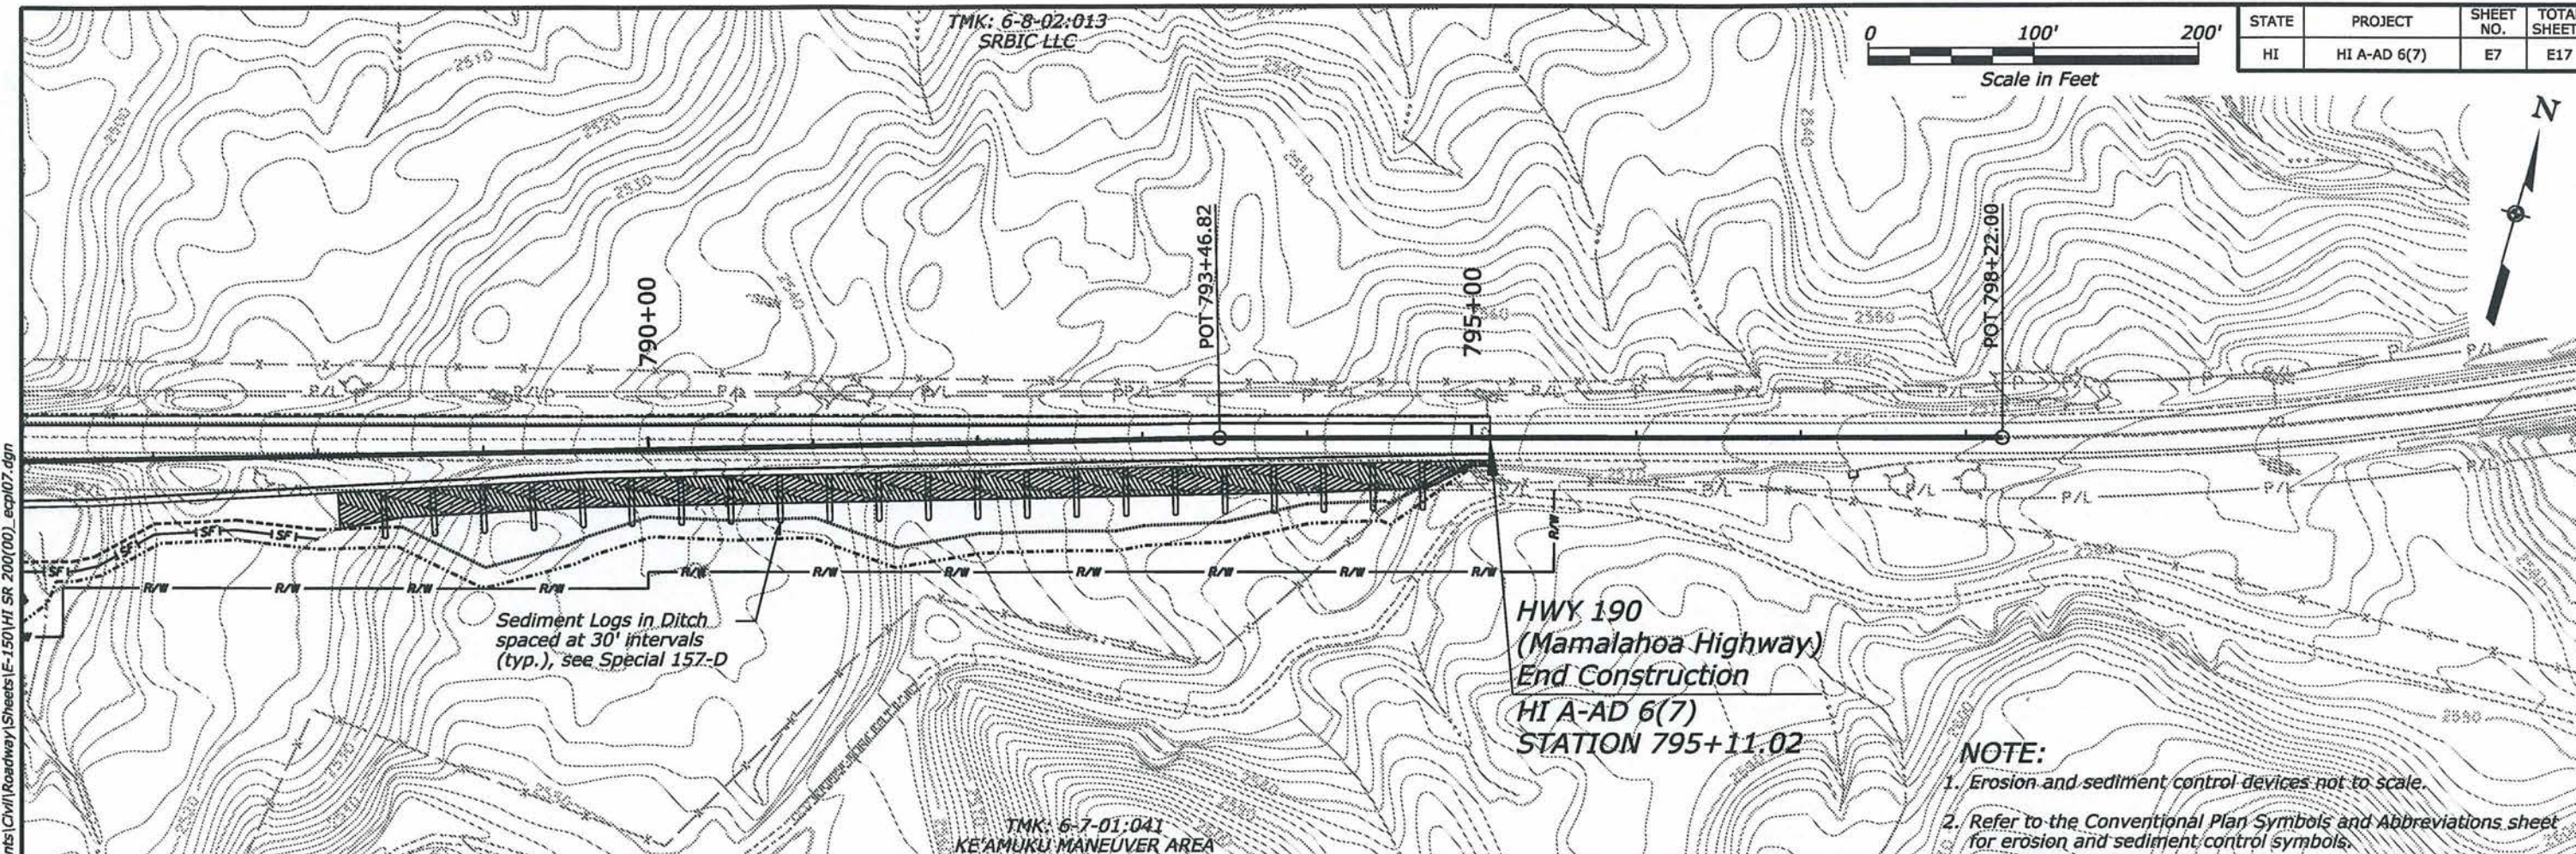

TMK: 6-7-01:041
KE'AMUKU MANEUVER AREA

AS-BUILT DRAWINGS/SPECIFICATIONS

This certifies that the dimensions and details shown on this sheet reflect the dimensions and details and specifications as constructed in the field.

GOODFELLOW BROS., INC.

Contractor's Name:

Yuri Kar 1/2/14
Signature Date



THIS WORK WAS PREPARED BY ME OR UNDER MY SUPERVISION.
Wendy G. McLain 4/30/2012
SIGNATURE EXPIRATION DATE OF THE LICENSE

U.S. DEPARTMENT OF TRANSPORTATION
FEDERAL HIGHWAY ADMINISTRATION
CENTRAL FEDERAL LANDS HIGHWAY DIVISION

**HWY 190 (MAMALAHOA HWY)
EROSION AND SEDIMENT
CONTROL PLAN
787+00 to 798+22**