




REGION	STATE	PROJECT	SHEET NO.	TOTAL SHEETS
	HI	HI A-AD 6(7)	S7	S16

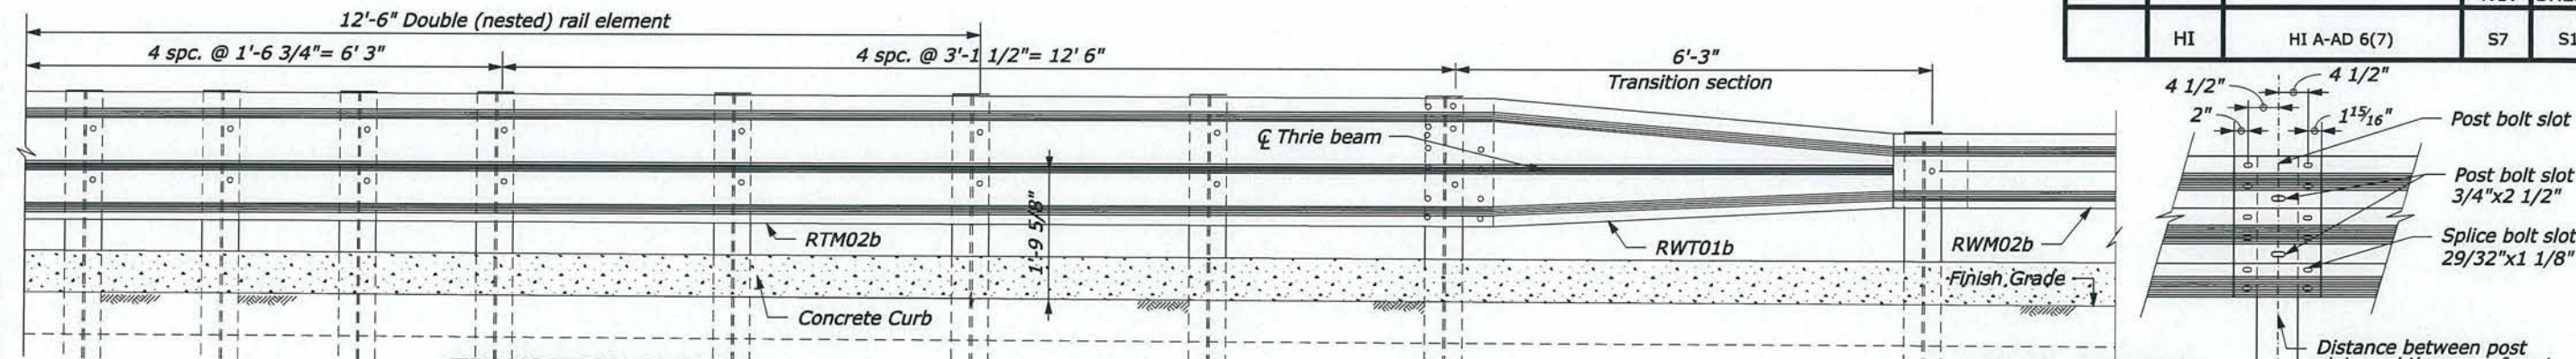

TRANSITION SECTION

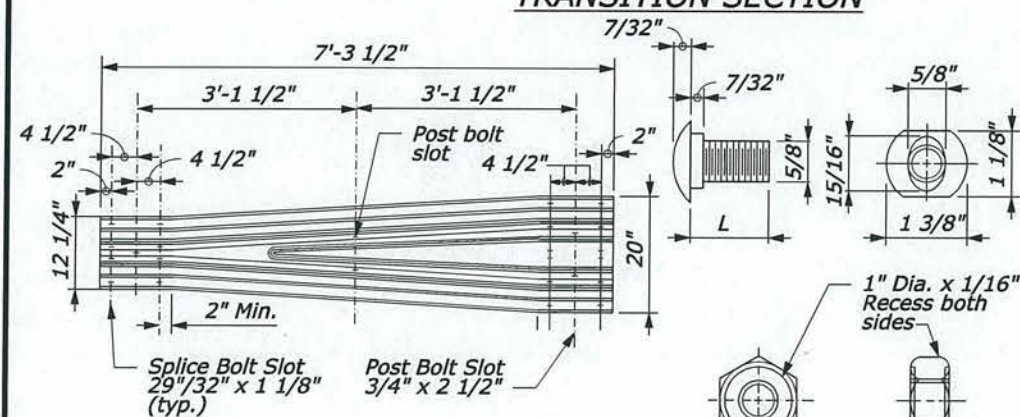

TRANSITION SECTION RWT01b

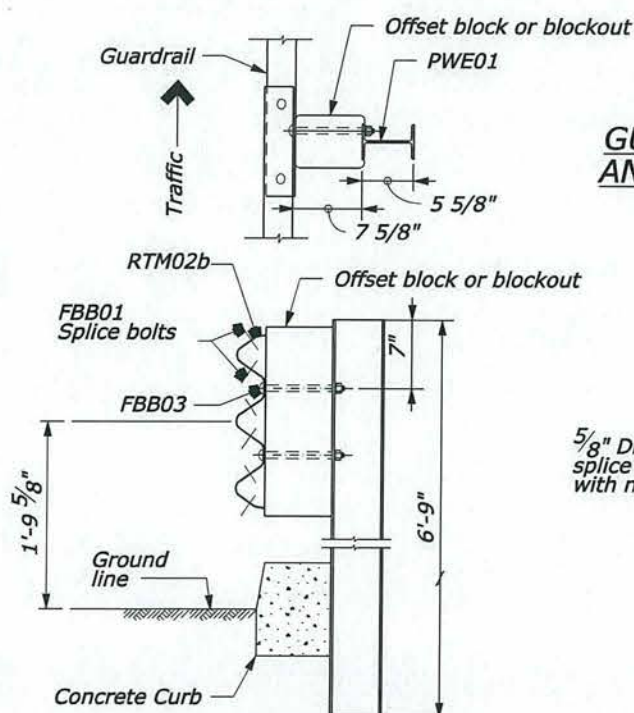


STRONG POST THRIE BEAM GUARDRAIL (SGR09a)

GUARDRAIL BOLTS AND RECESSED NUT


Designator	L
FBB01	1 3/8"
FBB02	2"
FBB03	10"

Post Bolt Slot - 3/4"x2 1/2" (Use at posts where splices do not occur)

BACKUP PLATE RT B01b

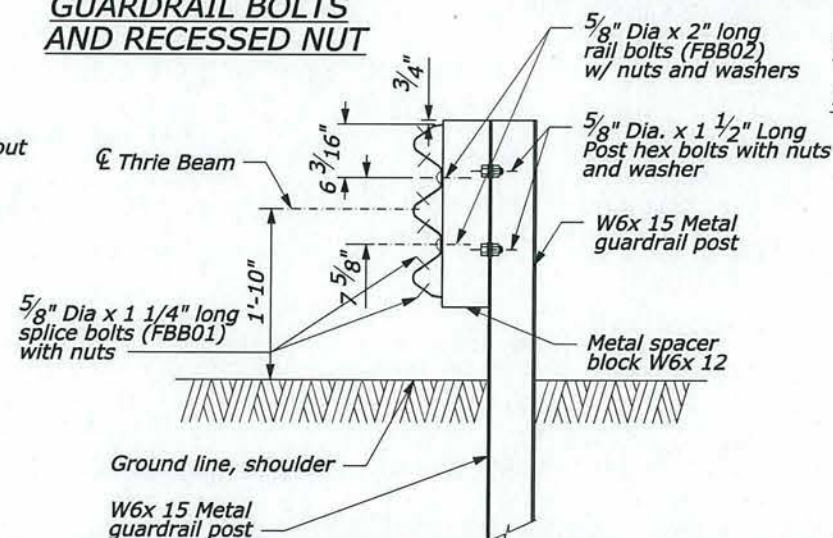

TYPICAL SECTION METAL GUARDRAIL ON METAL POST WITH METAL SPACER BLOCK

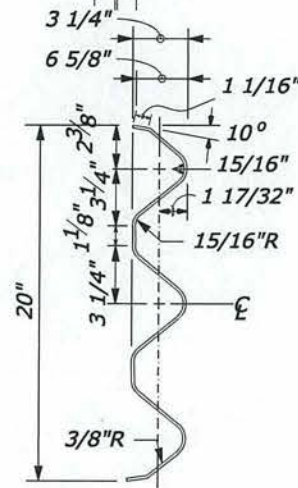

TYPICAL INSTALLATION OF REFLECTOR MARKER (RM-5)

AS-BUILT DRAWINGS/SPECIFICATIONS
This certifies that the dimensions and details shown on this sheet reflect the dimensions and details and specifications as constructed in the field.

GOODFELLOW BROS., INC.
Contractor's Name:



Signature: *[Signature]* 1/2/14




This work was prepared by me or under my supervision

Expiration Date License 4/30/2014

RAIL SPLICE

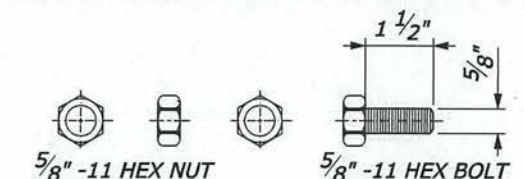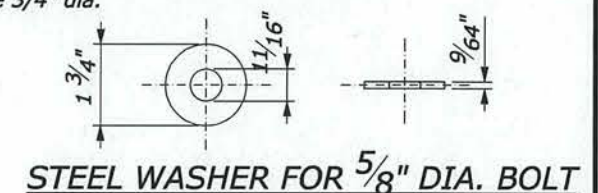

5/8" DIA. HEX BOLT AND NUT

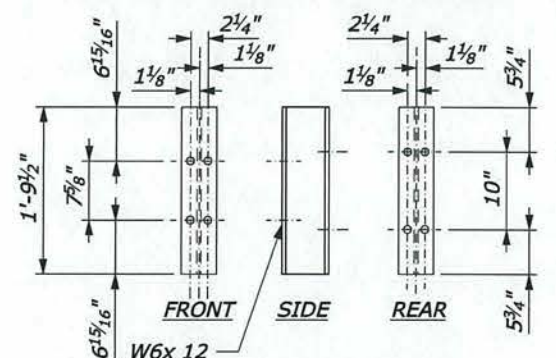

SPACER BLOCK DETAILS

U.S. DEPARTMENT OF TRANSPORTATION
FEDERAL HIGHWAY ADMINISTRATION
CENTRAL FEDERAL LANDS HIGHWAY DIVISION

METAL GUARDRAIL CONNECTION TO CONCRETE BARRIER

NO.	DATE	BY	REVISIONS	NO.	DATE	BY	REVISIONS	DESIGNED BY	DRAWN BY	CHECKED BY	SCALE	PROJECT TEAM LEADER	BRIDGE DRAWING	DATE	DRAWING NO.
								R. GARCIA	N. SARIO	B. HAYASHI	AS SHOWN		7 of 16	March 2013	-