


STATE	PROJECT	SHEET NO.	TOTAL SHEETS
HI	HI A-AD 6(7)	E12	E17

TMK: 6-7-01:041
KE'AMUKU MANEUVER AREA

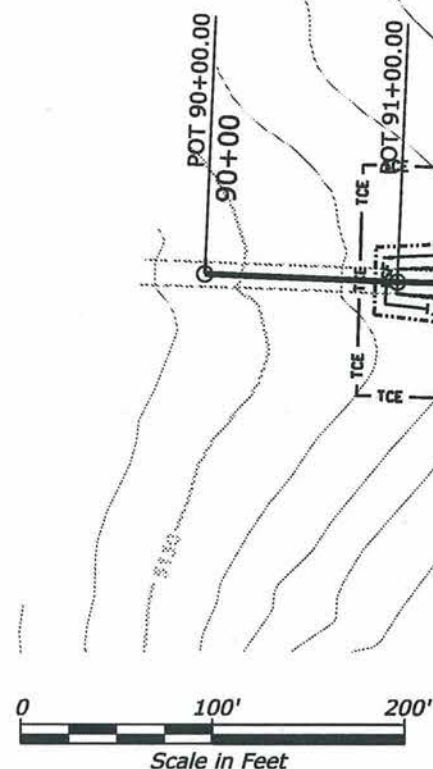

See C Sheets for
Run-down (typ.)

TMK: 6-7-01:041
KE'AMUKU MANEUVER AREA

NOTE:

1. Erosion and sediment control devices not to scale.
2. Refer to the Conventional Plan Symbols and Abbreviations sheet for erosion and sediment control symbols.

AS-BUILT DRAWINGS/SPECIFICATIONS

This certifies that the dimensions and details shown on this sheet reflect the dimensions and details and specifications as constructed in the field.

GOODFELLOW BROS., INC.

Contractor's Name:

[Signature] 1/2/14
Signature Date



THIS WORK WAS PREPARED BY ME OR UNDER MY SUPERVISION.
[Signature] 4/30/2012
SIGNATURE EXPIRATION DATE OF THE LICENSE

U.S. DEPARTMENT OF TRANSPORTATION
FEDERAL HIGHWAY ADMINISTRATION
CENTRAL FEDERAL LANDS HIGHWAY DIVISION

**MSR ROAD
EROSION AND SEDIMENT
CONTROL PLAN**

\\ssfm.local\dfsroot\dfsminiproj\2009\2009_057.001 ana saddle road west side bld pkg 2\g dwgs\contract documents\civil\roadway\sheet\150\HI SR 200(00)_epl12.dgn 9/21/2011 2:30:16 PM