


S:\Transport\100013746-SR\MyDes\Drawings\Sheets_Bid_Package_2\C-M_L_P8P\HI SR 200(00)_pp52.dgn
3/21/2012 9:01:39 AM

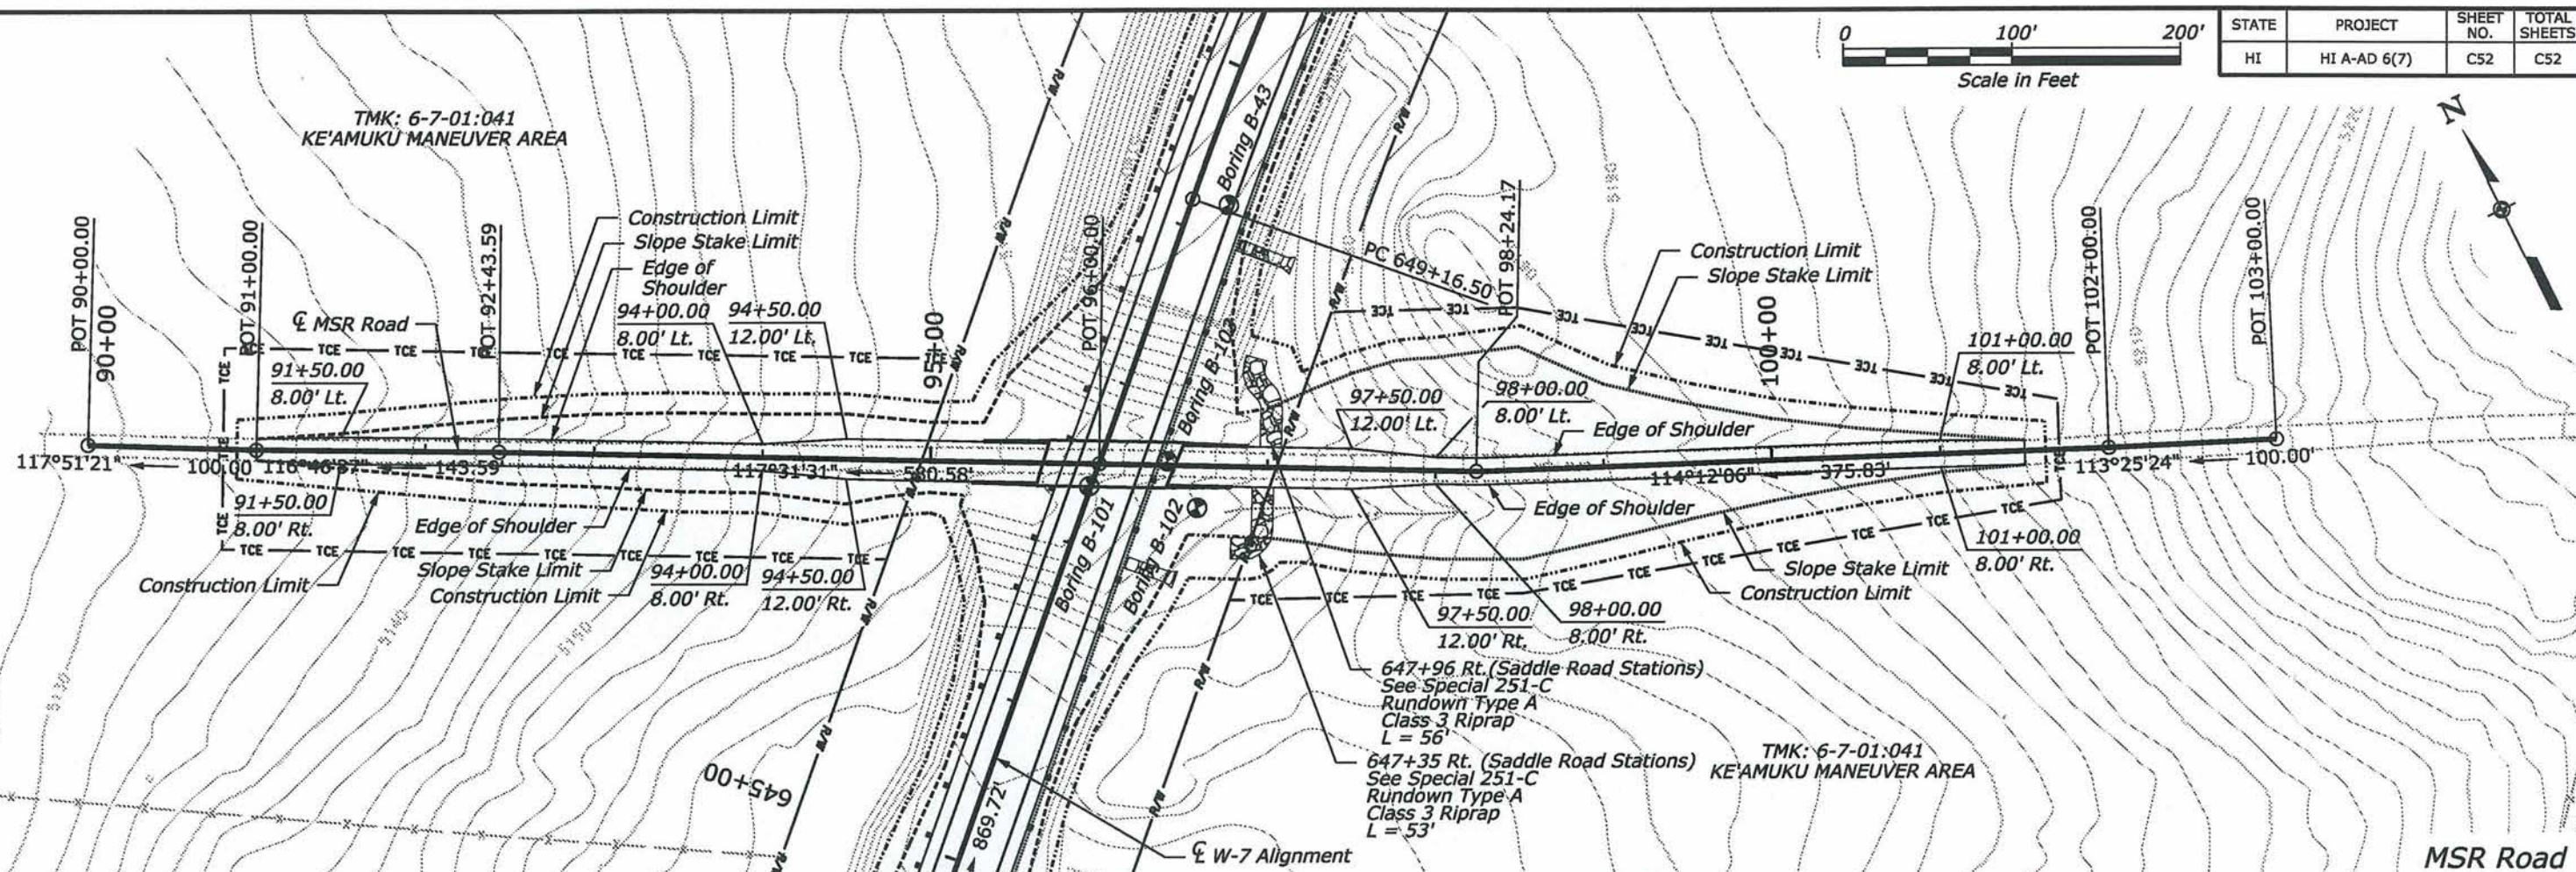

AS-BUILT DRAWINGS/SPECIFICATIONS
This certifies that the dimensions and details shown on this sheet reflect the dimensions and details and specifications as constructed in the field.

GOODFELLOW BROS., INC.
Contractor's Name:

Signature: *[Signature]*
Date: 1/2/14

Existing Ground

Profile Grade

K = 19
200' VC

K = 125
200' VC

SSD = 774'

K = 37
200' VC

SSD = 213'

K = 21
200' VC

K = 37
200' VC

K = 21
200' VC

K = 37
200' VC

K = 21
200' VC


K = 37
200' VC

K = 21
200' VC

K = 37
200' VC

K = 21
200' VC

K = 37
200' VC

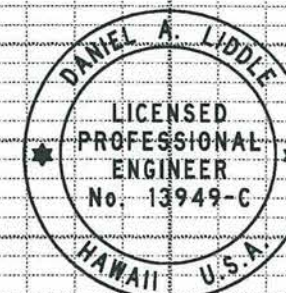

This work was prepared by me
or under my supervision
Daniel A. Liddle
Expiration Date of License 4/30/2014