


TMK: 4-4-15:008
State of Hawaii
(United States Of America) lease
Portion of G.L. S-3849
Portion of TRACT A-105
POHAKULOA TRAINING AREA

0 100' 200'
Scale in Feet

STATE	PROJECT	SHEET NO.	TOTAL SHEETS
HI	HI A-AD 6(7)	E8	E17

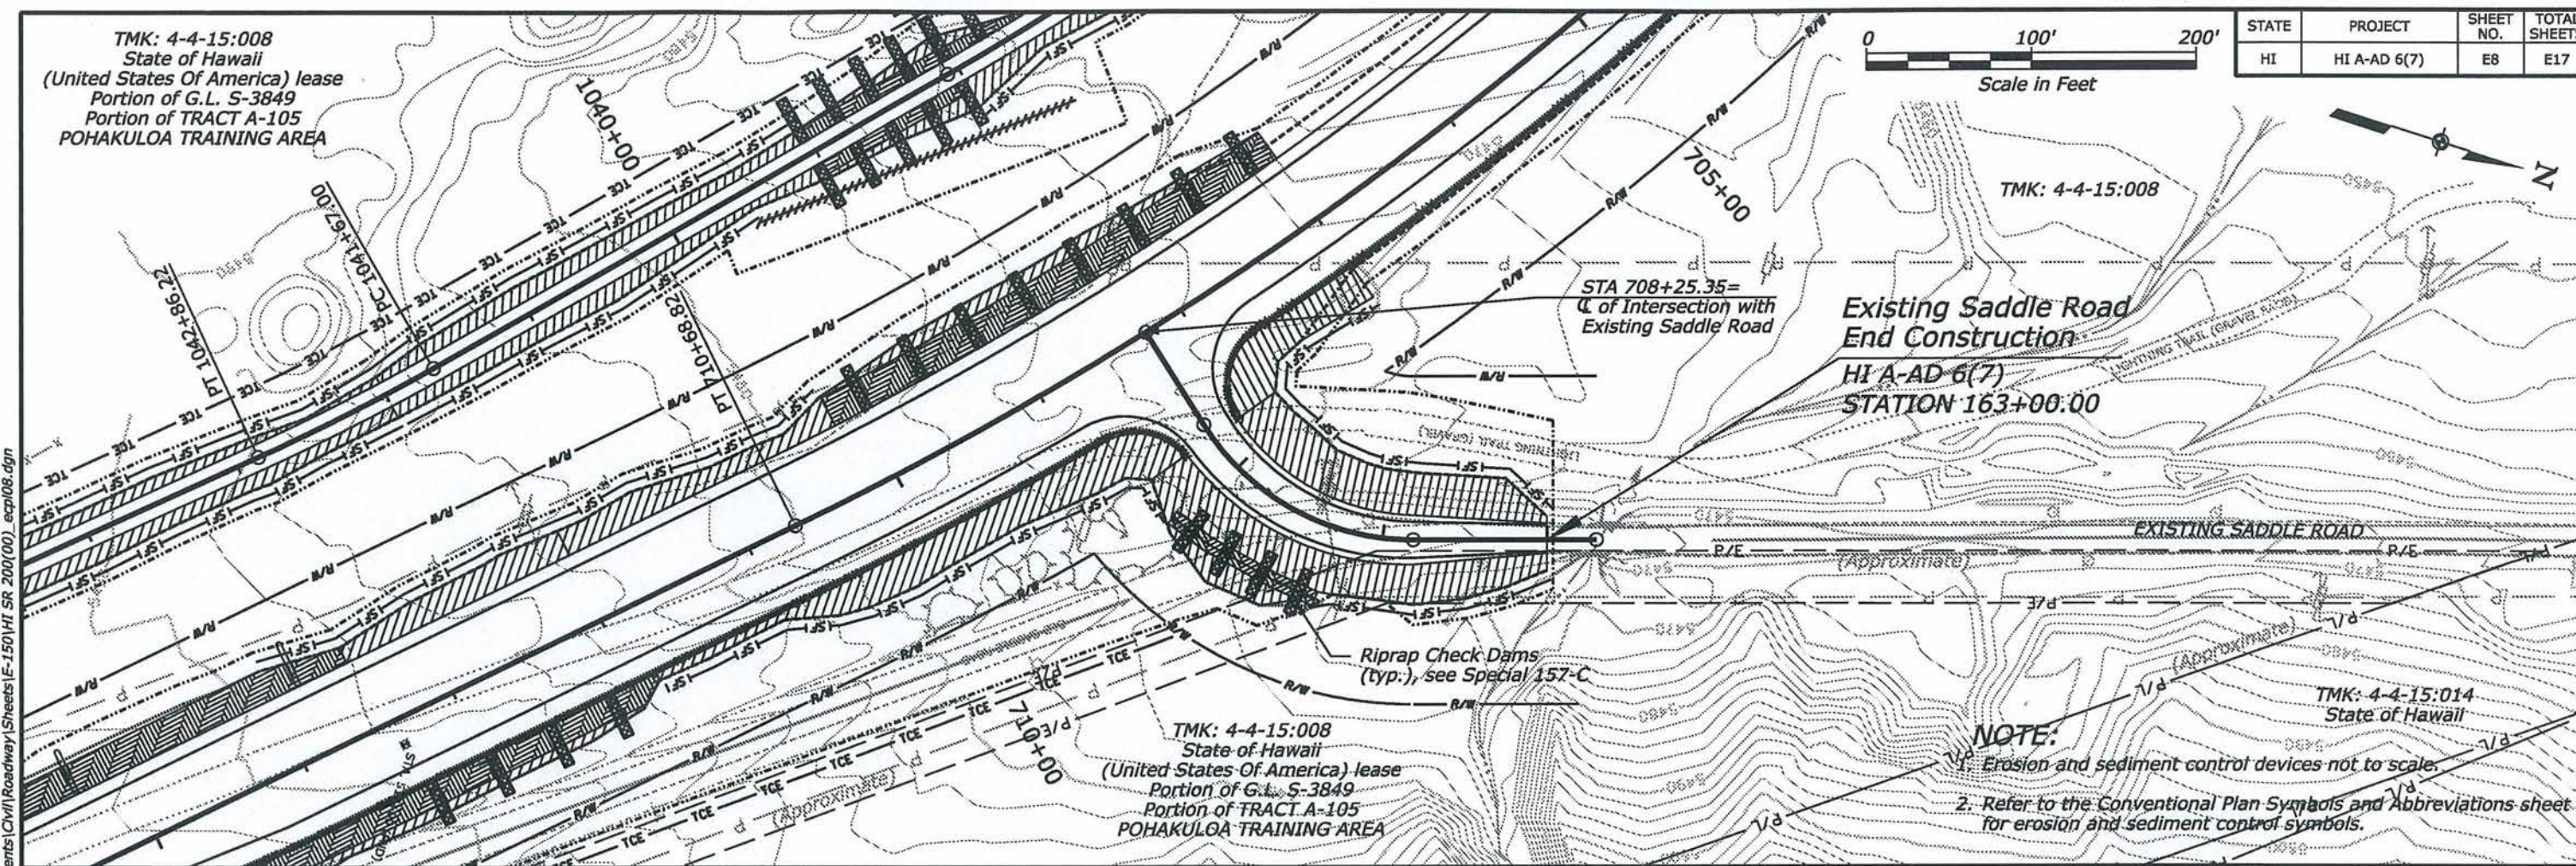

AS-BUILT DRAWINGS/SPECIFICATIONS

This certifies that the dimensions and details shown on this sheet reflect the dimensions and details and specifications as constructed in the field.

GOODFELLOW BROS., INC.

Contractor's Name:

[Signature] 1/2/14
Signature Date



THIS WORK WAS PREPARED BY ME OR UNDER MY SUPERVISION.
[Signature] 4/30/2012
SIGNATURE EXPIRATION DATE OF THE LICENSE

U.S. DEPARTMENT OF TRANSPORTATION
FEDERAL HIGHWAY ADMINISTRATION
CENTRAL FEDERAL LANDS HIGHWAY DIVISION

OLD SADDLE ROAD EROSION AND SEDIMENT CONTROL PLAN