

- 4" Double Yellow Center Stripe with Type D Markers *Pairs*
- 4" Double Yellow Median Stripe with Type H Markers
- 4" Yellow Center Stripe with Type D, H & J Markers
- Type A & C Markers
- 4" White Guide Line
- 4" White Line with Type A & C Markers
- 8" White Channelizing Line with Type C Markers
- 4" White Edge Line with Type C Markers
- Delineator




STATE	PROJECT	SHEET NO.	TOTAL SHEETS
HI	HI A-AD 6(7)	T9	T101



*Note: Centerline striping "Pass"/
"No Pass" zones adjusted by CO.*

*Bi-Directional
Arrows*

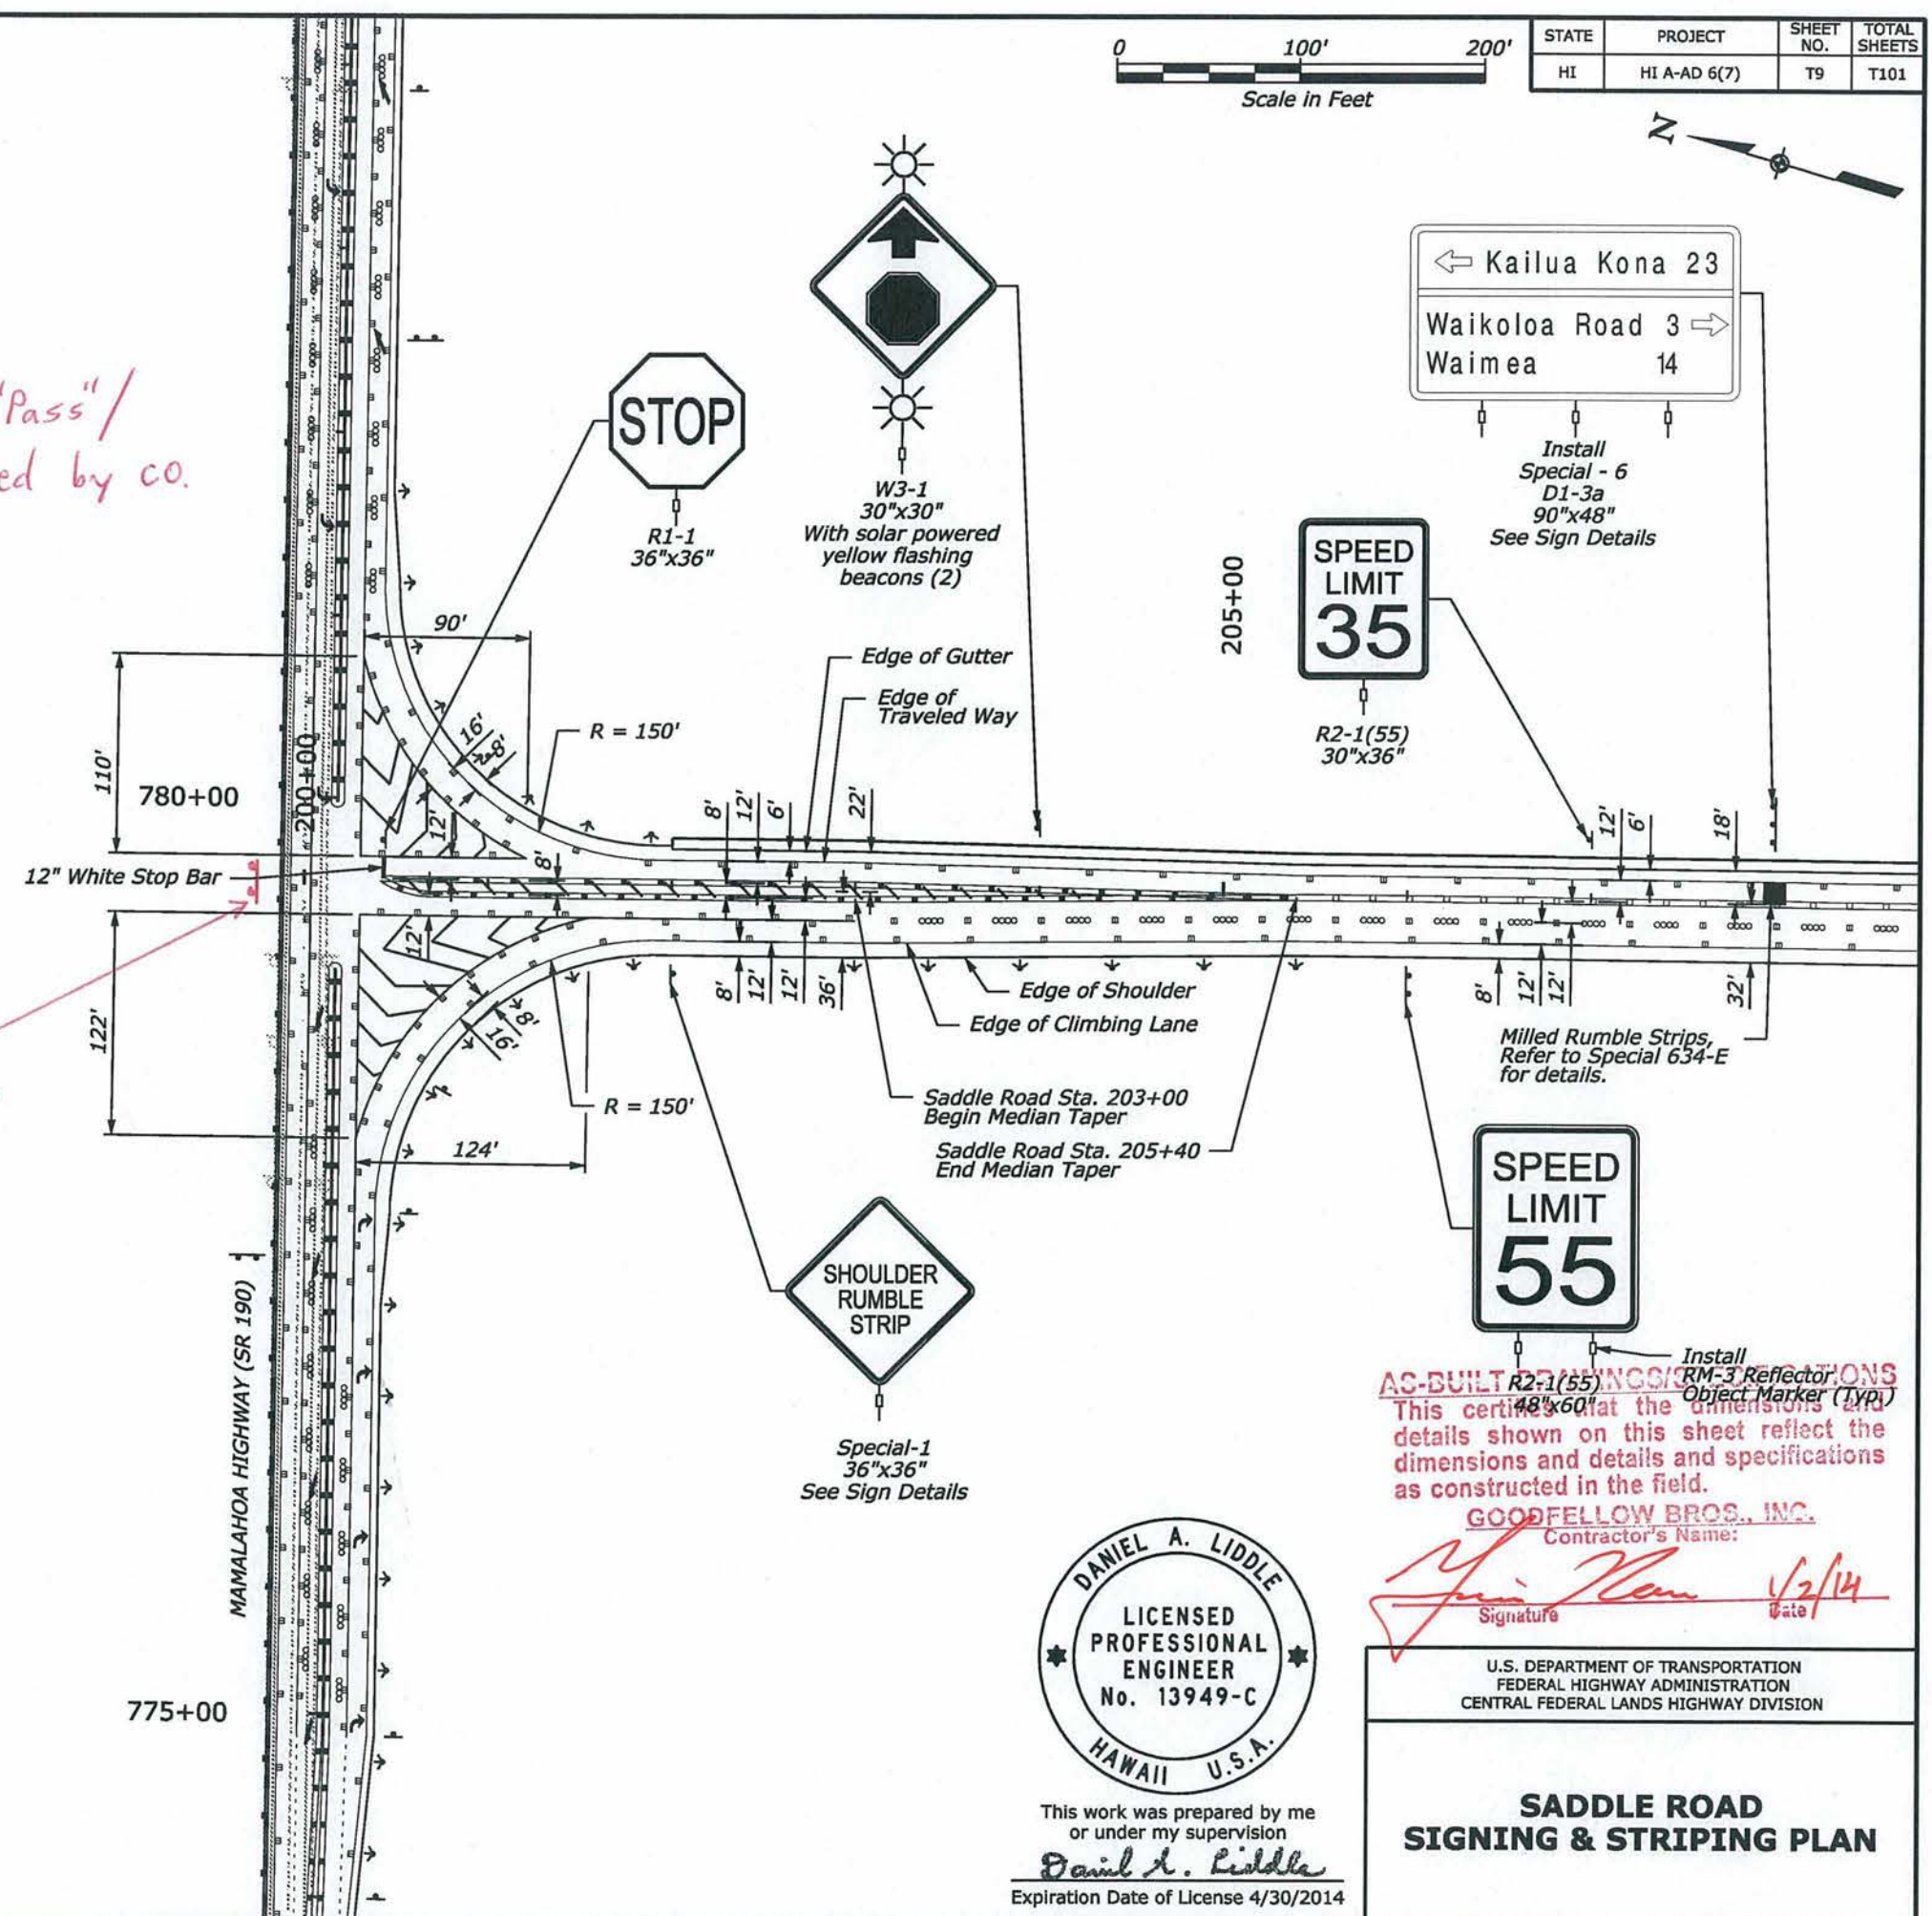

AS-BUILT DIMENSIONS
 This certifies that the dimensions and details shown on this sheet reflect the details shown on this sheet reflect the dimensions and details and specifications as constructed in the field.

GOODFELLOW BROS., INC.
 Contractor's Name:
[Signature] *4/2/14*
 Signature Date



This work was prepared by me or under my supervision
Daniel A. Liddle
 Expiration Date of License 4/30/2014


U.S. DEPARTMENT OF TRANSPORTATION
 FEDERAL HIGHWAY ADMINISTRATION
 CENTRAL FEDERAL LANDS HIGHWAY DIVISION

**SADDLE ROAD
 SIGNING & STRIPING PLAN**







3/28/2012 9:56:47 AM S:\Tranproj\100013746-SR\HwyDes\Roadway\Sheets_Bid_Package_2\1T-600\HI SR 200(00)_spm01.dgn

- Notes:
- Refer to sheet T50 for signing on Hwy 190.
 - Refer to Special 634-C for Deceleration and Acceleration lane marking details.
 - Place Delineators per MUTCD Part 3.

- 4" Double Yellow Center Stripe with Type D Markers
- 4" Double Yellow Median Stripe with Type H Markers
- 4" Yellow Center Stripe with Type D, H & J Markers
- Type A & C Markers
- 4" White Guide Line
- 4" White Line with Type A & C Markers
- 8" White Channelizing Line with Type C Markers
- 4" White Edge Line with Type C Markers
- Delineator

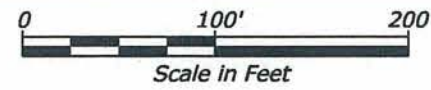

STATE	PROJECT	SHEET NO.	TOTAL SHEETS
HI	HI A-AD 6(7)	T10	T101

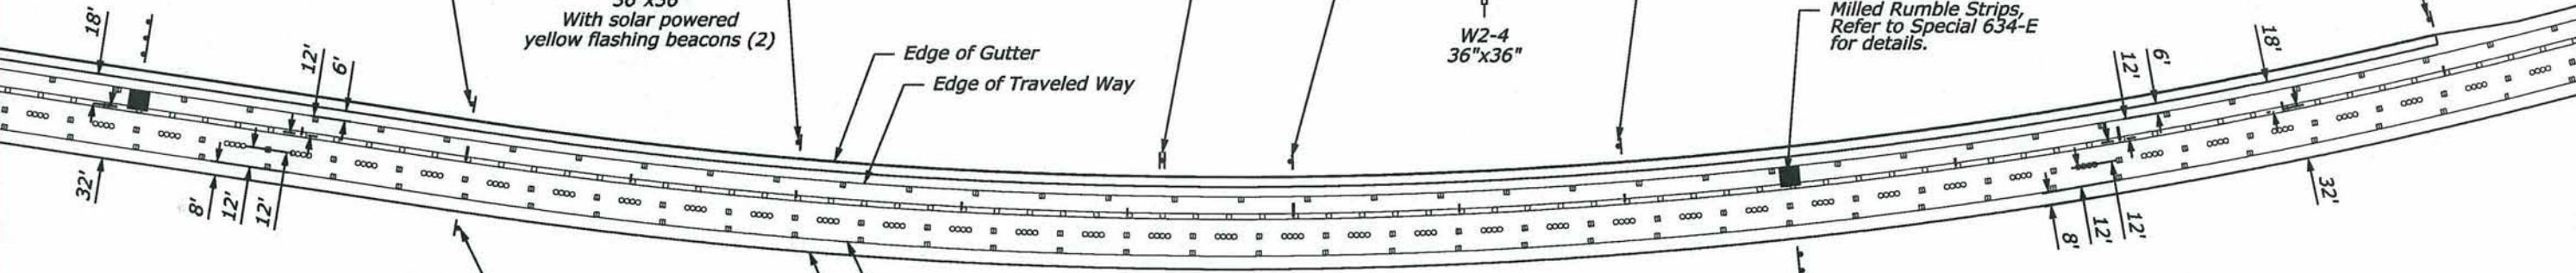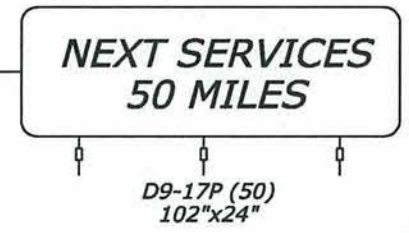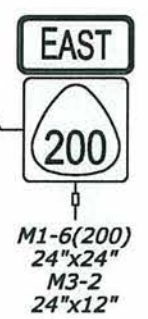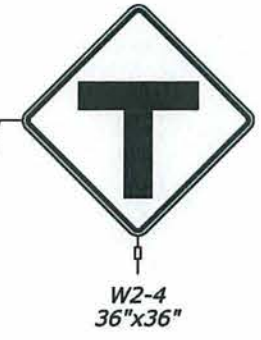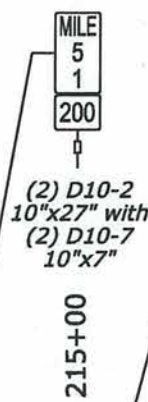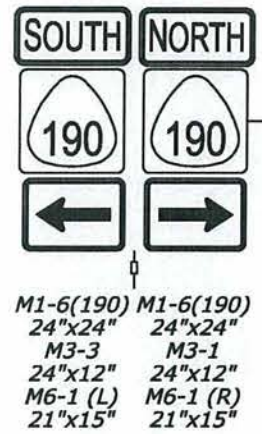

AS-BUILT DRAWINGS/SPECIFICATIONS
This certifies that the dimensions and details shown on this sheet reflect the dimensions and details and specifications as constructed in the field.

GOODFELLOW BROS., INC.
Contractor's Name:

[Signature] 1/2/14
Date







 


U.S. DEPARTMENT OF TRANSPORTATION
FEDERAL HIGHWAY ADMINISTRATION
CENTRAL FEDERAL LANDS HIGHWAY DIVISION



This work was prepared by me or under my supervision
Daniel A. Liddle
Expiration Date of License 4/30/2014


**SADDLE ROAD
SIGNING & STRIPING PLAN**

3/28/2012 9:57:31 AM S:\Tranproj\100013746-SR\HwyDes\Rowy\Sheets_Bid_Package_21T-600\HI SR 200(00)_sppm02.dgn

-  4" Double Yellow Center Stripe with Type D Markers
-  4" Double Yellow Median Stripe with Type H Markers
-  4" Yellow Center Stripe with Type D, H & J Markers
-  Type A & C Markers
-  4" White Guide Line
-  4" White Line with Type A & C Markers
-  8" White Channelizing Line with Type C Markers
-  4" White Edge Line with Type C Markers
-  Delineator



STATE	PROJECT	SHEET NO.	TOTAL SHEETS
HI	HI A-AD 6(7)	T11	T101

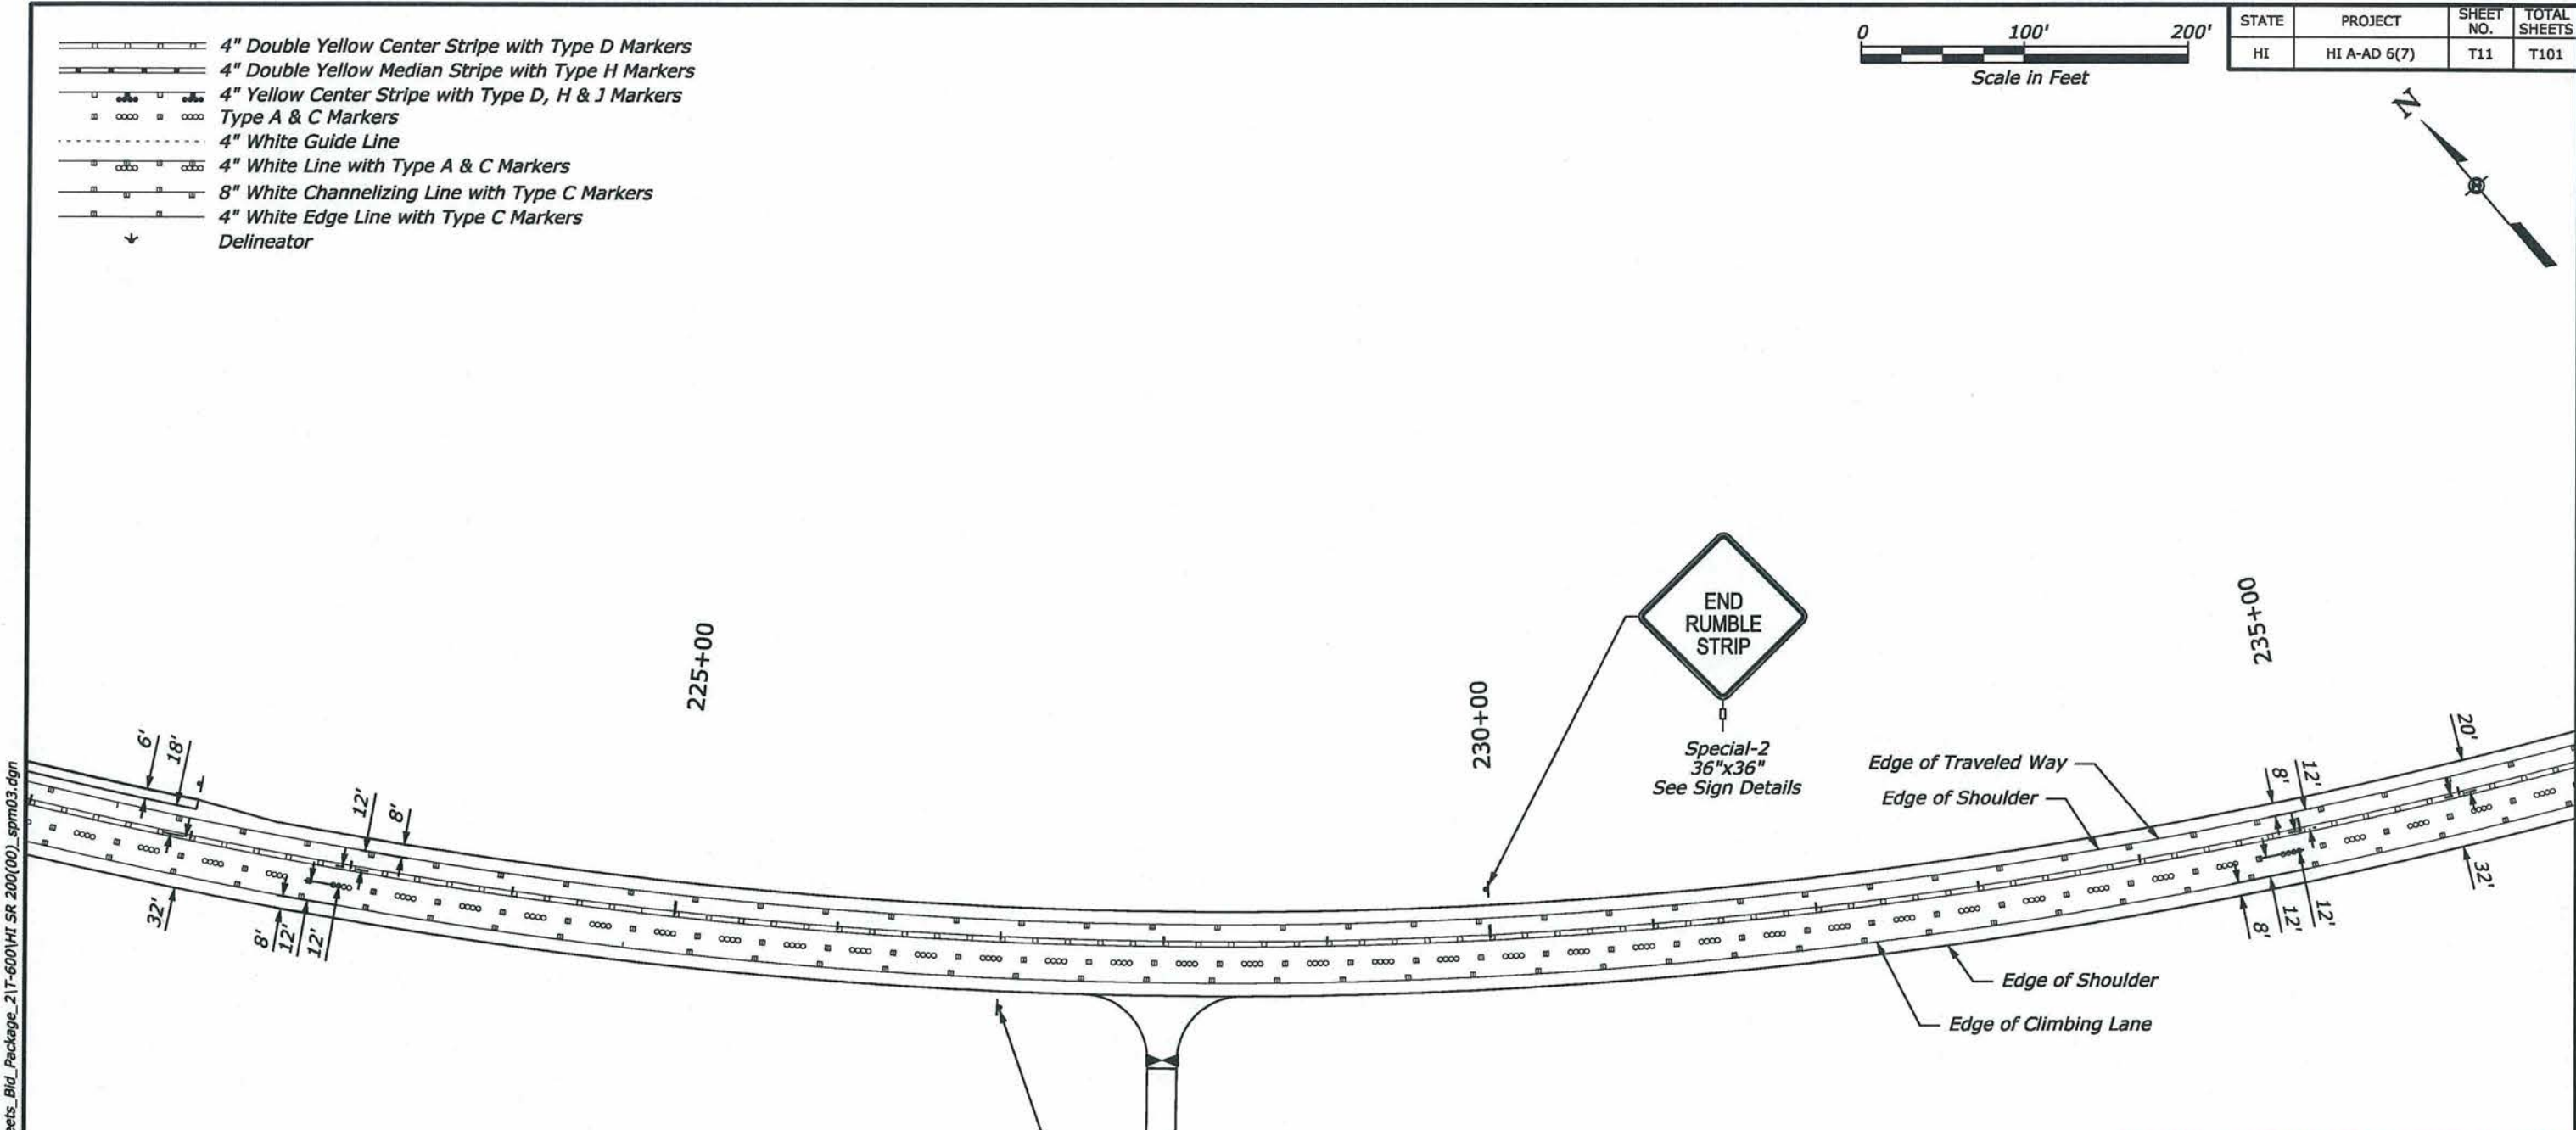


SLOWER TRAFFIC KEEP RIGHT
 R4-3
 24"x30"
 RM-3 Reflector Object Marker (Typ.)

END RUMBLE STRIP
 Special-2
 36"x36"
 See Sign Details

AS-BUILT DRAWINGS/SPECIFICATIONS
 This certifies that the dimensions and details shown on this sheet reflect the dimensions and details and specifications as constructed in the field.

GOODFELLOW BROS., INC.
 Contractor's Name:
John Kor 1/2/14
 Signature Date

 
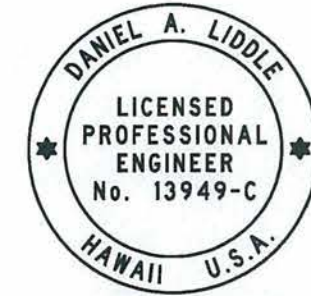 

 







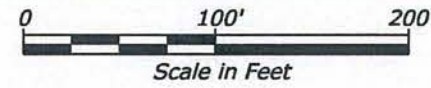
This work was prepared by me or under my supervision
Daniel A. Liddle
 Expiration Date of License 4/30/2014

U.S. DEPARTMENT OF TRANSPORTATION
 FEDERAL HIGHWAY ADMINISTRATION
 CENTRAL FEDERAL LANDS HIGHWAY DIVISION


**SADDLE ROAD
 SIGNING & STRIPING PLAN**

3/28/2012 9:58:32 AM S:\Tranproj\100013746-SR\HwyDes\Sheets_Bid_Package_2\T-600\HI SR 200(00)_spm03.dgn

-  4" Double Yellow Center Stripe with Type D Markers
-  4" Double Yellow Median Stripe with Type H Markers
-  4" Yellow Center Stripe with Type D, H & J Markers
-  Type A & C Markers
-  4" White Guide Line
-  4" White Line with Type A & C Markers
-  8" White Channelizing Line with Type C Markers
-  4" White Edge Line with Type C Markers
-  Delineator



STATE	PROJECT	SHEET NO.	TOTAL SHEETS
HI	HI A-AD 6(7)	T12	T101

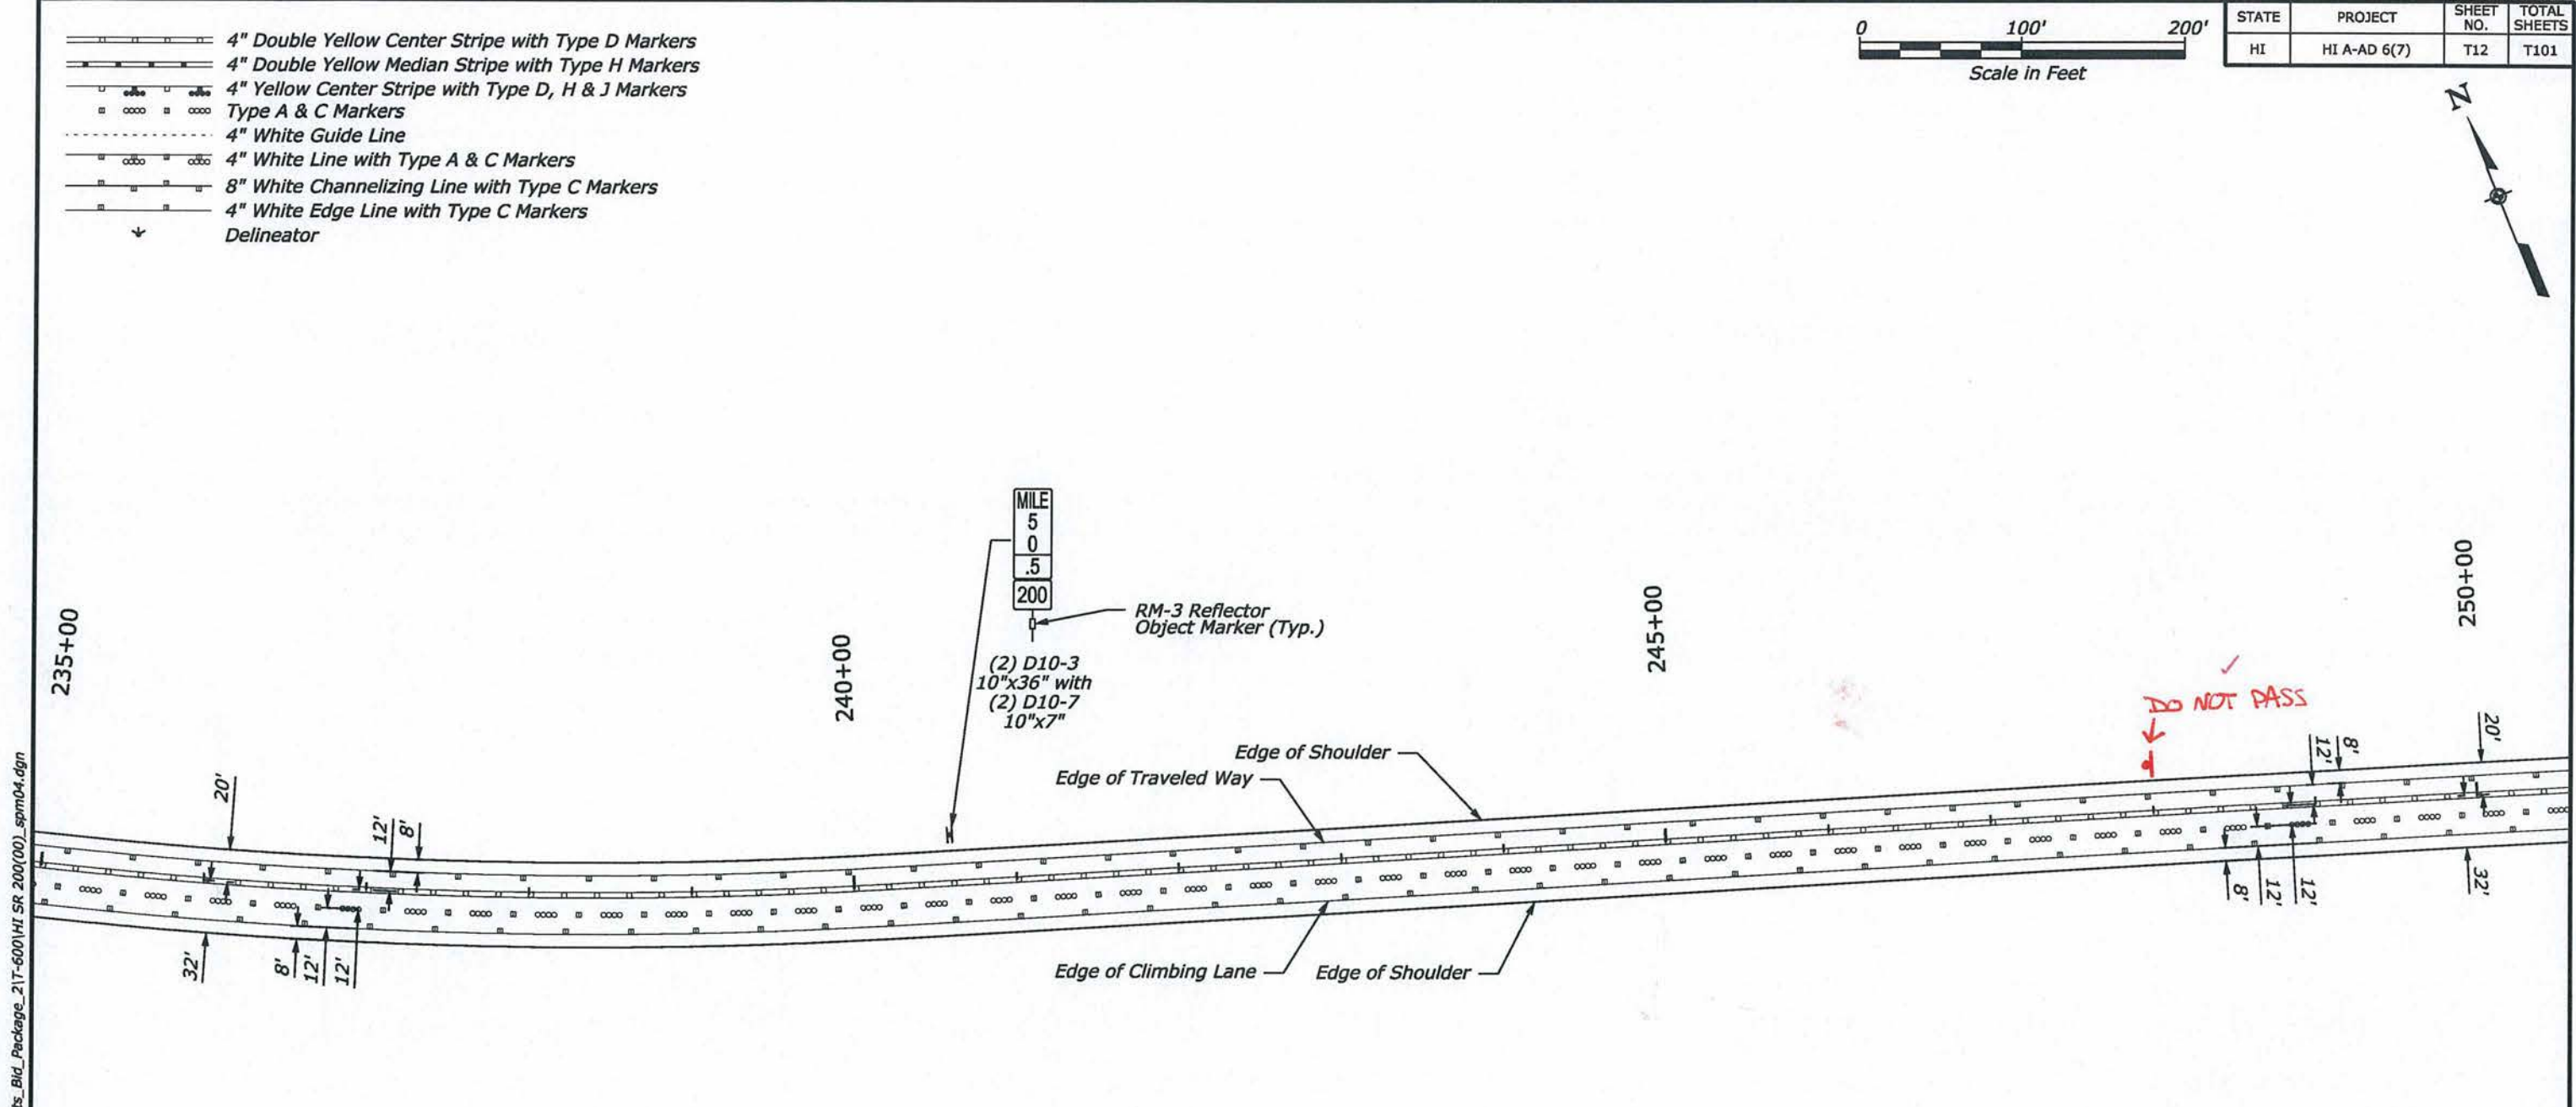

AS-BUILT DRAWINGS/SPECIFICATIONS
 This certifies that the dimensions and details shown on this sheet reflect the dimensions and details and specifications as constructed in the field.

GOODFELLOW BROS., INC.
 Contractor's Name:

[Signature]
 Signature 1/2/14
Date



This work was prepared by me or under my supervision
Daniel A. Liddle
 Expiration Date of License 4/30/2014


U.S. DEPARTMENT OF TRANSPORTATION
 FEDERAL HIGHWAY ADMINISTRATION
 CENTRAL FEDERAL LANDS HIGHWAY DIVISION

**SADDLE ROAD
 SIGNING & STRIPING PLAN**


3/28/2012 9:59:23 AM S:\Tranproj\100013746-SR(HwyDes)\Rwy\Sheets_Bld_Package_21T-600\HI SR 200(00)_spm04.dgn

3/29/2012 10:00:11 AM S:\Tranpro\100013746-SR\HwyDes\Road\Sheets_Bid_Package_2\T-600\HI SR 200(00)_sfrm05.dgn

- 4" Double Yellow Center Stripe with Type D Markers
- 4" Double Yellow Median Stripe with Type H Markers
- 4" Yellow Center Stripe with Type D, H & J Markers
- Type A & C Markers
- 4" White Guide Line
- 4" White Line with Type A & C Markers
- 8" White Channelizing Line with Type C Markers
- 4" White Edge Line with Type C Markers
- Delineator

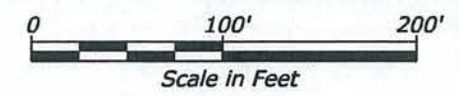


STATE	PROJECT	SHEET NO.	TOTAL SHEETS
HI	HI A-AD 6(7)	T13	T101

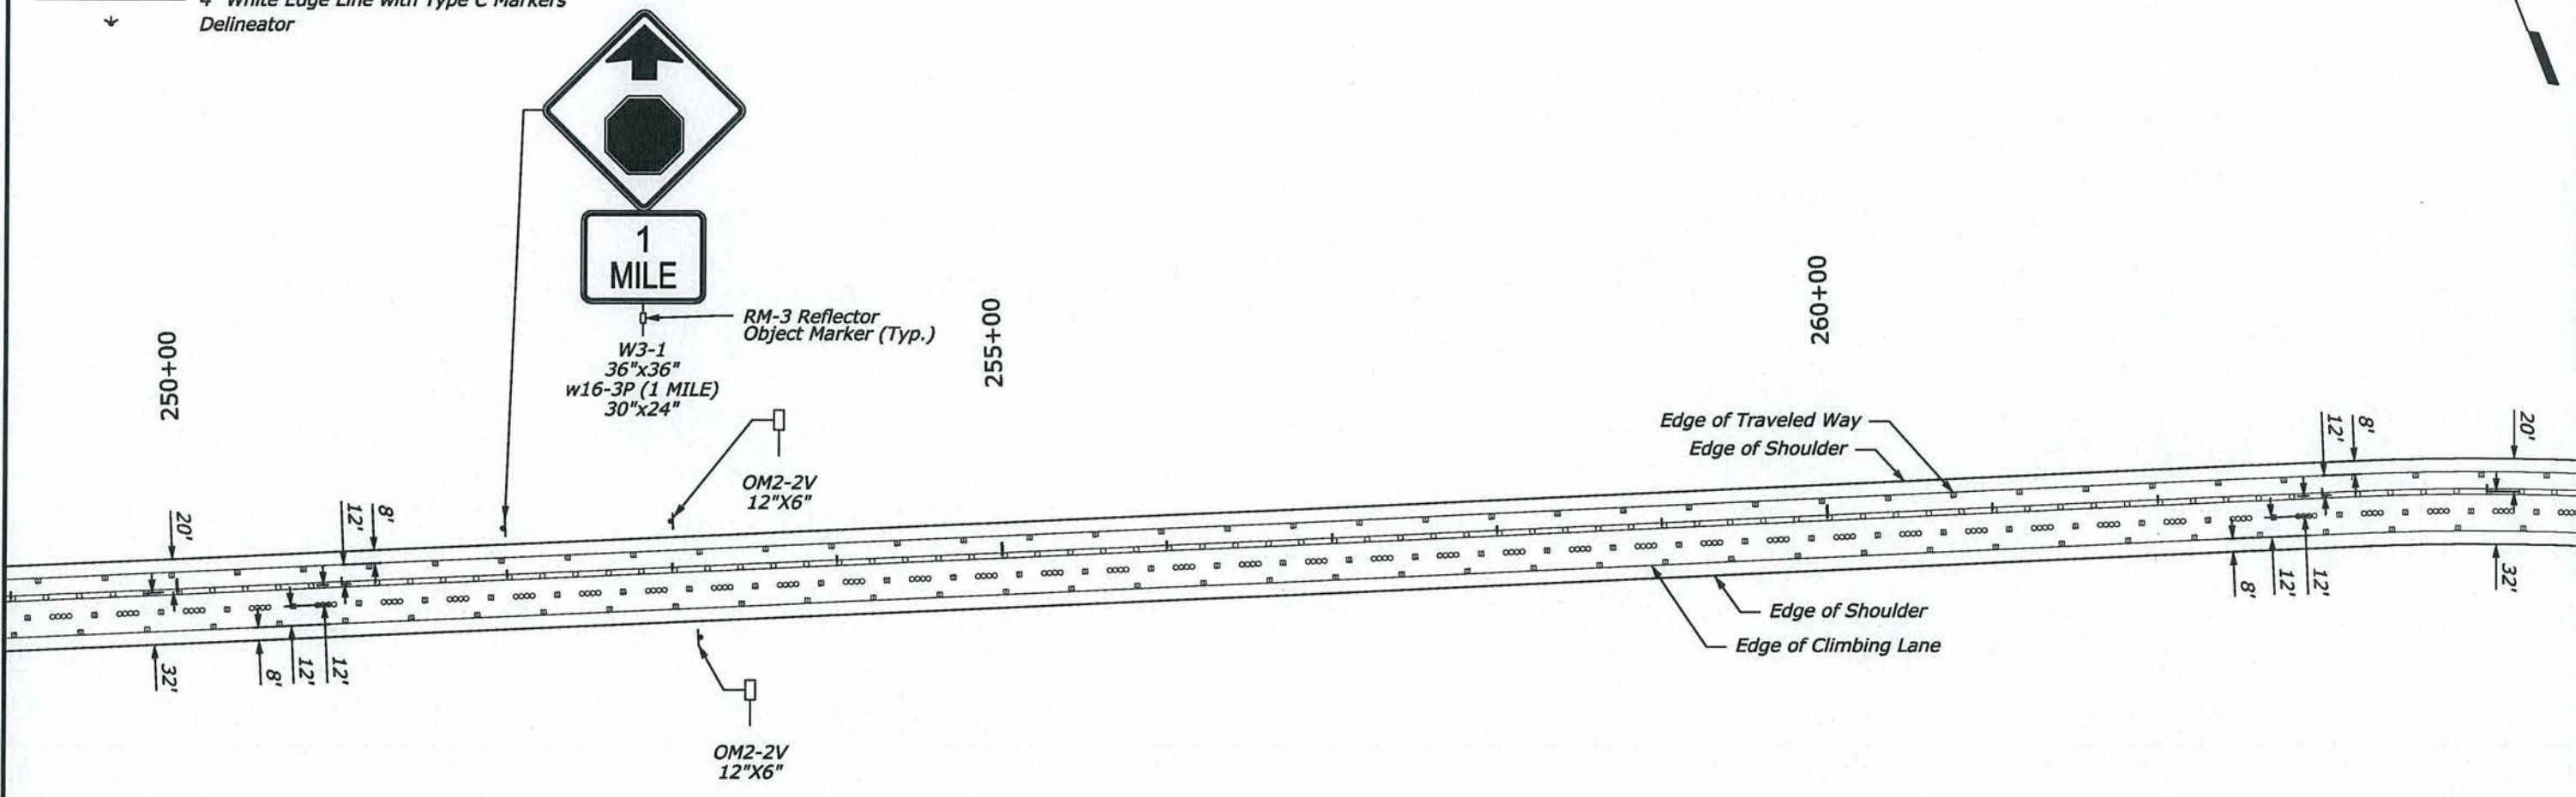

AS-BUILT DRAWINGS/SPECIFICATIONS
 This certifies that the dimensions and details shown on this sheet reflect the dimensions and details and specifications as constructed in the field.

GOODFELLOW BROS., INC.
 Contractor's Name:
[Signature] 1/2/14
 Signature Date

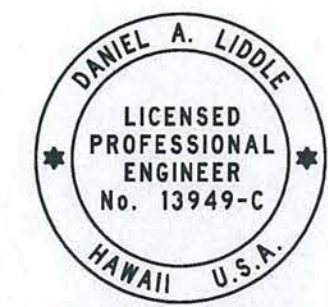


This work was prepared by me or under my supervision
David A. Liddle
 Expiration Date of License 4/30/2014


U.S. DEPARTMENT OF TRANSPORTATION
 FEDERAL HIGHWAY ADMINISTRATION
 CENTRAL FEDERAL LANDS HIGHWAY DIVISION

**SADDLE ROAD
 SIGNING & STRIPING PLAN**

- 4" Double Yellow Center Stripe with Type D Markers
- 4" Double Yellow Median Stripe with Type H Markers
- 4" Yellow Center Stripe with Type D, H & J Markers
- Type A & C Markers
- 4" White Guide Line
- 4" White Line with Type A & C Markers
- 8" White Channelizing Line with Type C Markers
- 4" White Edge Line with Type C Markers
- Delineator

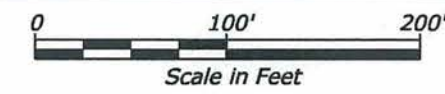

STATE	PROJECT	SHEET NO.	TOTAL SHEETS
HI	HI A-AD 6(7)	T14	T101

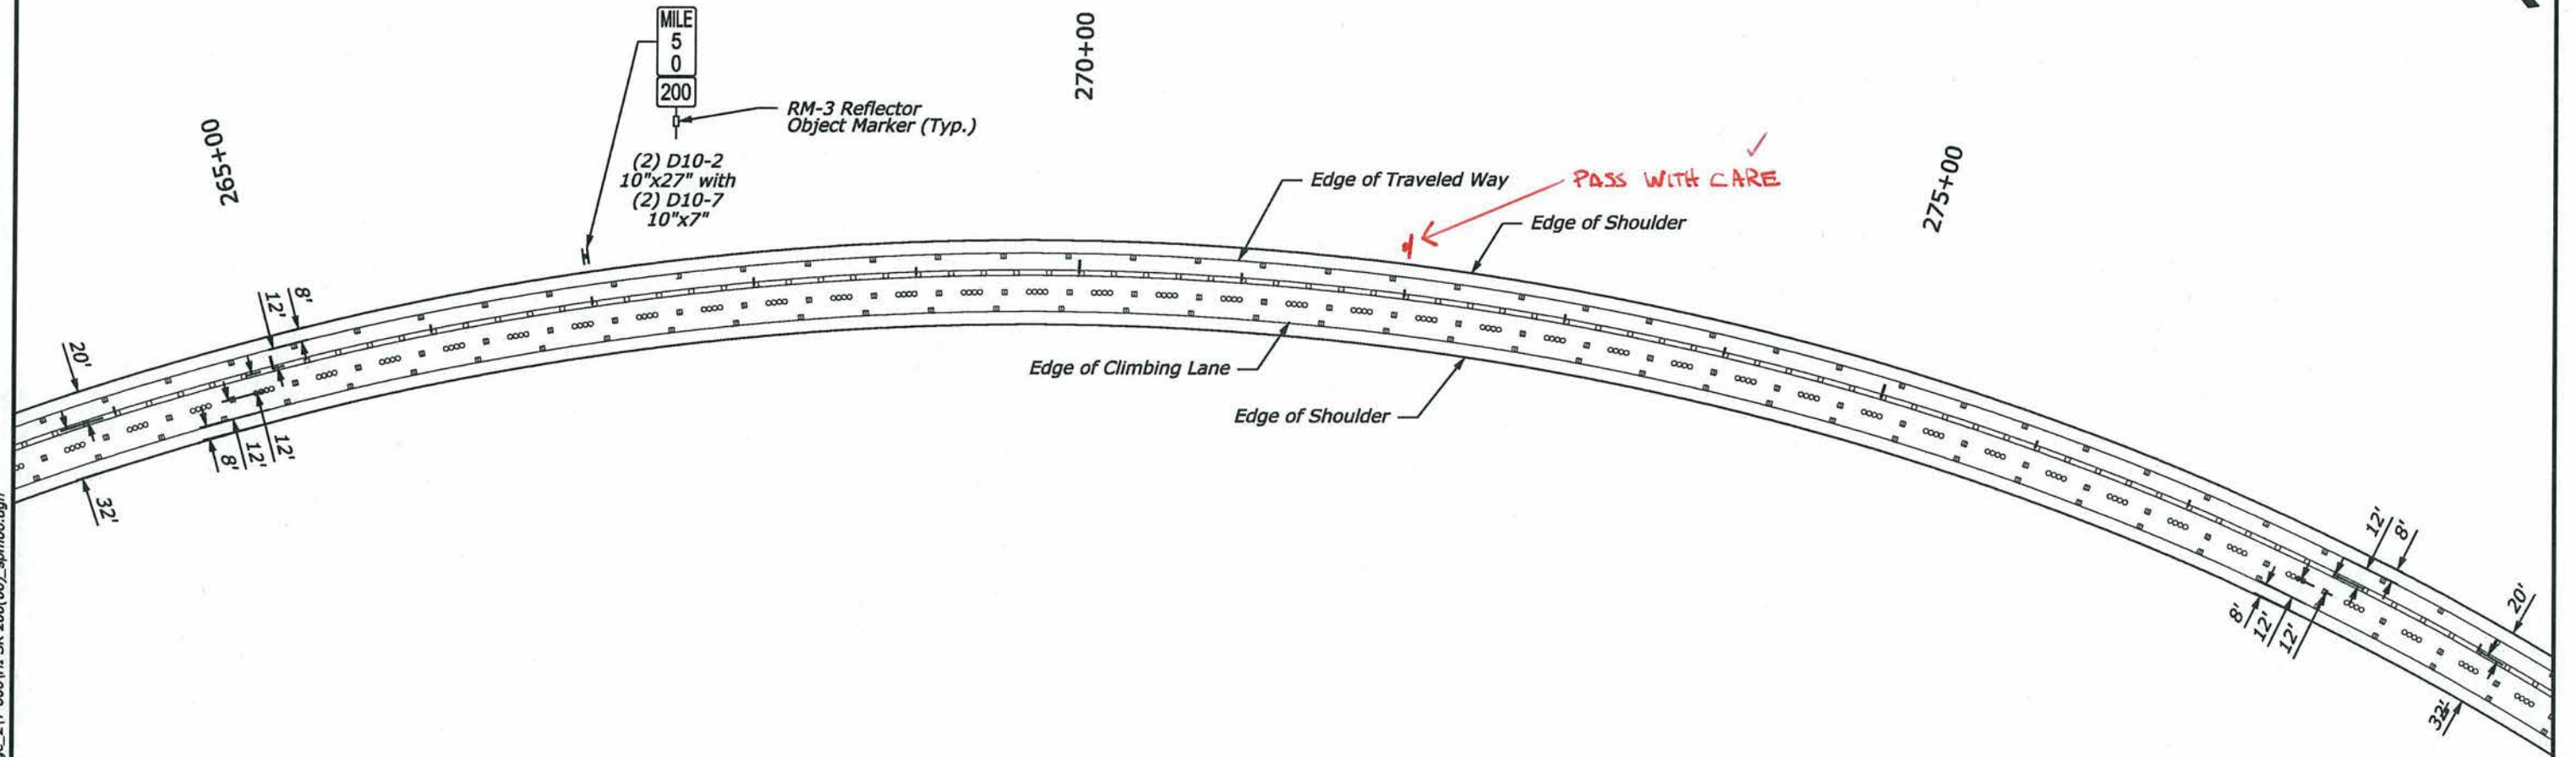

AS-BUILT DRAWINGS/SPECIFICATIONS
 This certifies that the dimensions and details shown on this sheet reflect the dimensions and details and specifications as constructed in the field.

GOODFELLOW BROS., INC.
 Contractor's Name:
Yun Han Signature 1/2/14 Date



This work was prepared by me or under my supervision
Daniel A. Liddle
 Expiration Date of License 4/30/2014


U.S. DEPARTMENT OF TRANSPORTATION
 FEDERAL HIGHWAY ADMINISTRATION
 CENTRAL FEDERAL LANDS HIGHWAY DIVISION

**SADDLE ROAD
 SIGNING & STRIPING PLAN**


3/24/2012 1:57:59 PM S:\Tranpro\100013746-SR\HwyDes\Sheets_Bld_Package_2\T-600\HI SR 200(00)_sppm06.dgn

S:\Tranpro\100013746-SR\HwyDes\Sheet\Sheets_Bid_Package_21T-600\HI SR 200(00)_spm07.dgn
3/24/2012 1:59:02 PM

- 4" Double Yellow Center Stripe with Type D Markers
- 4" Double Yellow Median Stripe with Type H Markers
- 4" Yellow Center Stripe with Type D, H & J Markers
- Type A & C Markers
- 4" White Guide Line
- 4" White Line with Type A & C Markers
- 8" White Channelizing Line with Type C Markers
- 4" White Edge Line with Type C Markers
- Delineator

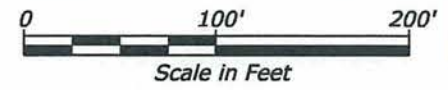


STATE	PROJECT	SHEET NO.	TOTAL SHEETS
HI	HI A-AD 6(7)	T15	T101

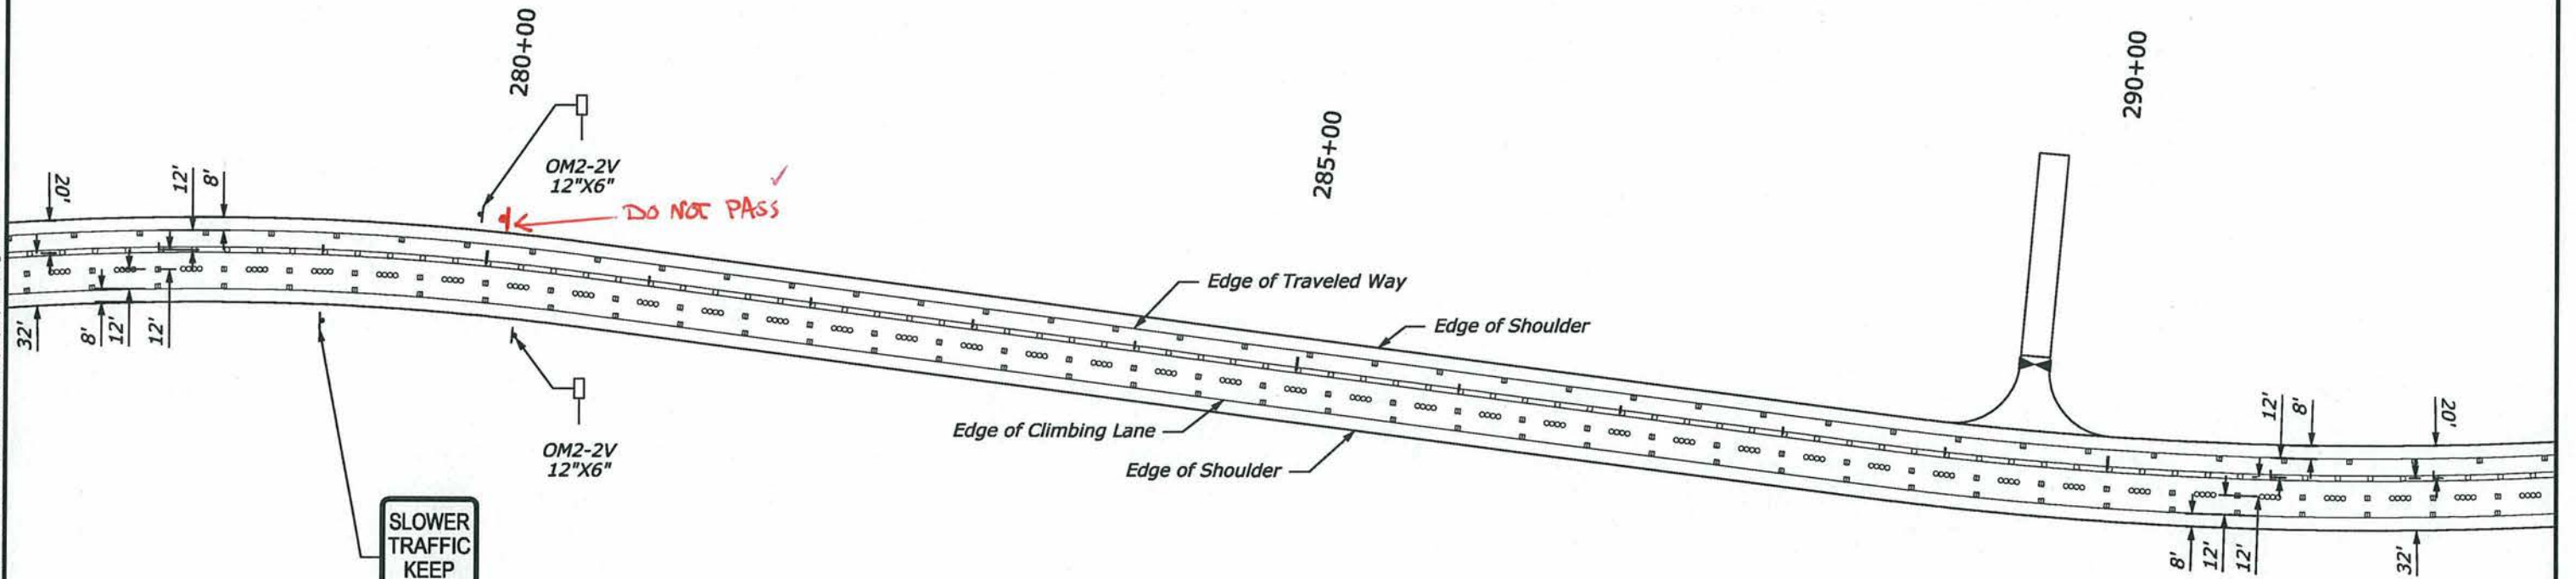

AS-BUILT DRAWINGS/SPECIFICATIONS
 This certifies that the dimensions and details shown on this sheet reflect the dimensions and details and specifications as constructed in the field.




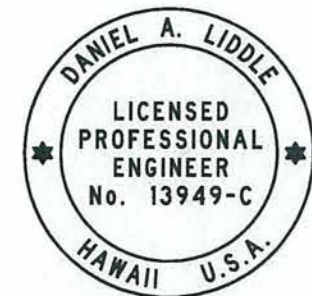





 GOODFELLOW BROS., INC.
 Contractor's Name:
Yun Han 4/2/14
 Signature Date




This work was prepared by me or under my supervision
Daniel A. Liddle
 Expiration Date of License 4/30/2014

U.S. DEPARTMENT OF TRANSPORTATION
 FEDERAL HIGHWAY ADMINISTRATION
 CENTRAL FEDERAL LANDS HIGHWAY DIVISION

**SADDLE ROAD
 SIGNING & STRIPING PLAN**

-  4" Double Yellow Center Stripe with Type D Markers
-  4" Double Yellow Median Stripe with Type H Markers
-  4" Yellow Center Stripe with Type D, H & J Markers
-  Type A & C Markers
-  4" White Guide Line
-  4" White Line with Type A & C Markers
-  8" White Channelizing Line with Type C Markers
-  4" White Edge Line with Type C Markers
-  Delineator

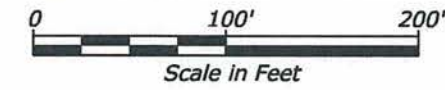


STATE	PROJECT	SHEET NO.	TOTAL SHEETS
HI	HI A-AD 6(7)	T16	T101



Relocated to
STA 309+00




3/24/2012 2:00:08 PM S:\Tranprof\100013746-SR\HwyDes\Roll\Sheets_Bld_Package_217-600\HI SR 200(00)_spmm08.dgn

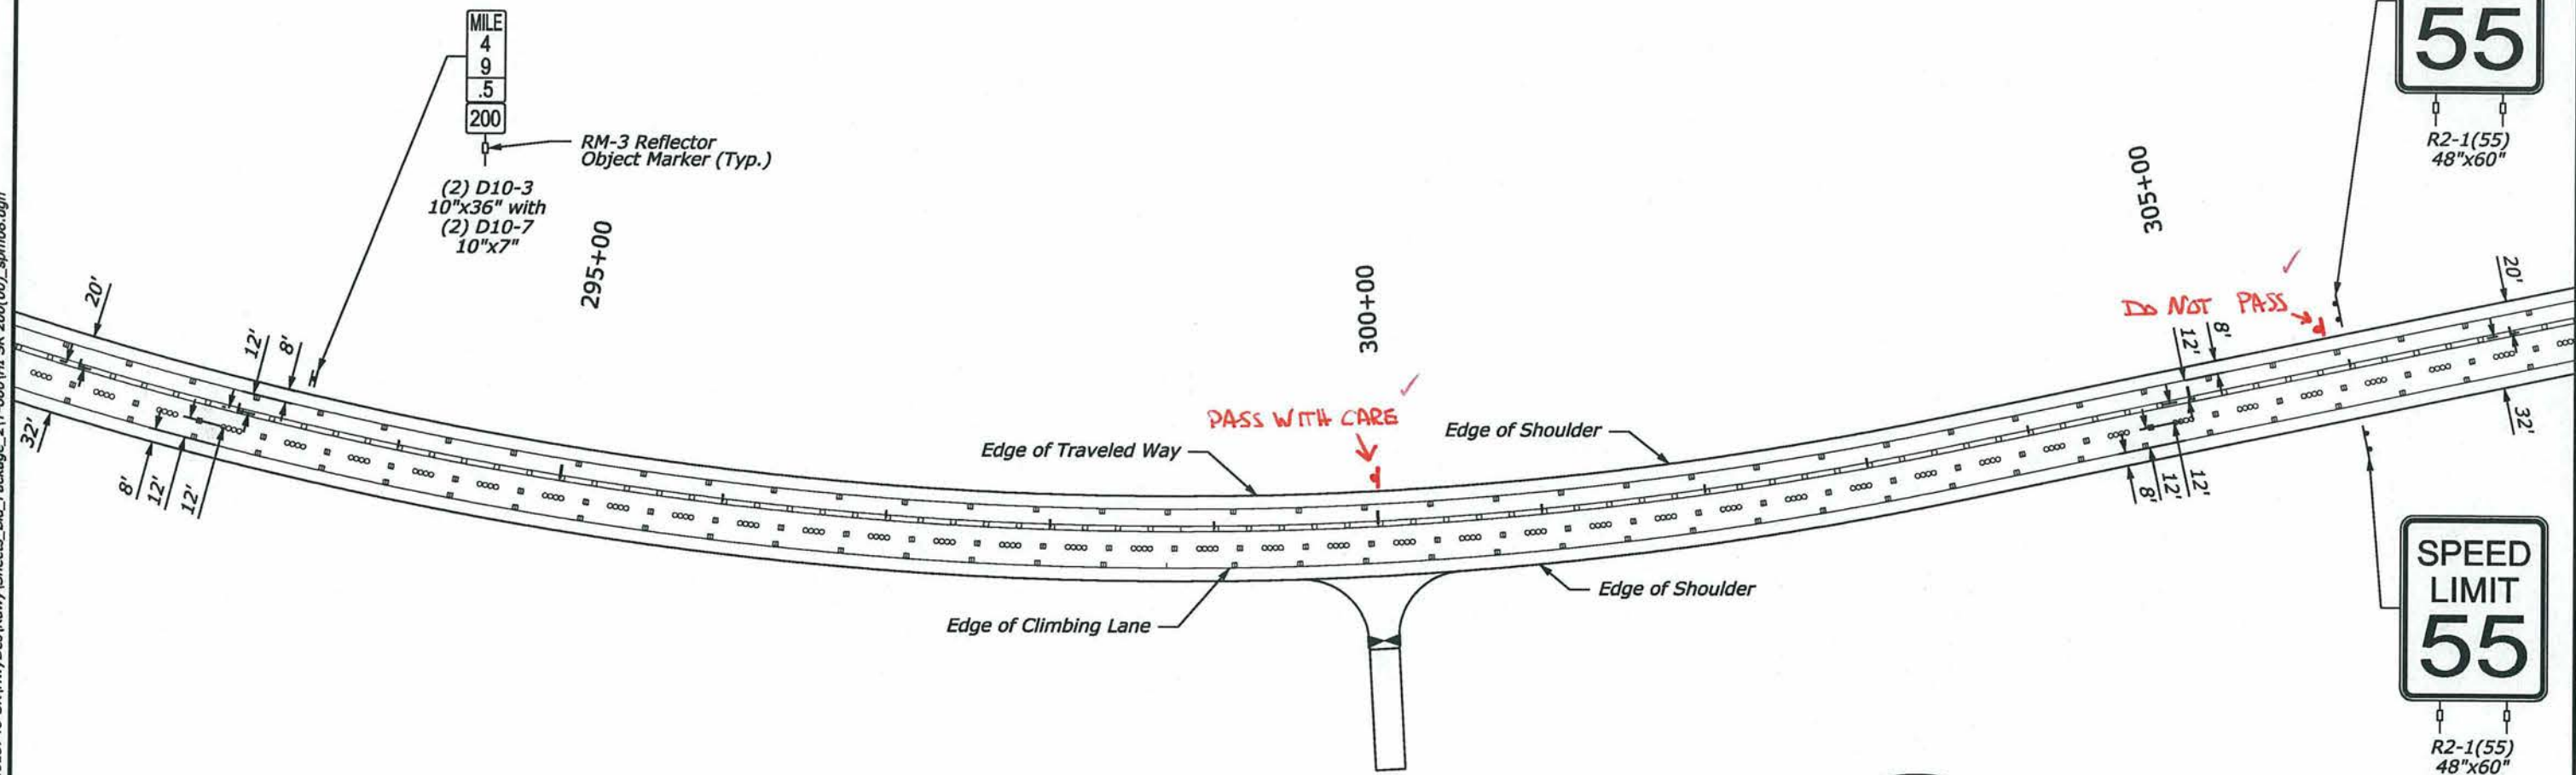

AS-BUILT DRAWINGS/SPECIFICATIONS
 This certifies that the dimensions and details shown on this sheet reflect the dimensions and details and specifications as constructed in the field.



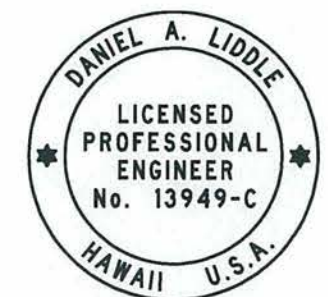


 



GOODFELLOW BROS., INC.
 Contractor's Name:
[Signature]
 Signature Date: 1/2/14




This work was prepared by me or under my supervision
Daniel A. Liddle
 Expiration Date of License 4/30/2014

U.S. DEPARTMENT OF TRANSPORTATION
 FEDERAL HIGHWAY ADMINISTRATION
 CENTRAL FEDERAL LANDS HIGHWAY DIVISION

**SADDLE ROAD
 SIGNING & STRIPING PLAN**


-  4" Double Yellow Center Stripe with Type D Markers
-  4" Double Yellow Median Stripe with Type H Markers
-  4" Yellow Center Stripe with Type D, H & J Markers
-  Type A & C Markers
-  4" White Guide Line
-  4" White Line with Type A & C Markers
-  8" White Channelizing Line with Type C Markers
-  4" White Edge Line with Type C Markers
-  Delineator

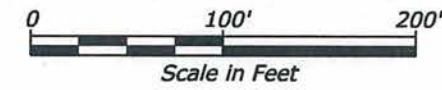

STATE	PROJECT	SHEET NO.	TOTAL SHEETS
HI	HI A-AD 6(7)	T17	T101




3/24/2012 2:01:06 PM S:\Tranproj\100013746-SR\HwyDes\rdwy\Sheets_Bid_Package_217-600\HI SR 200(00)_sprm09.dgn

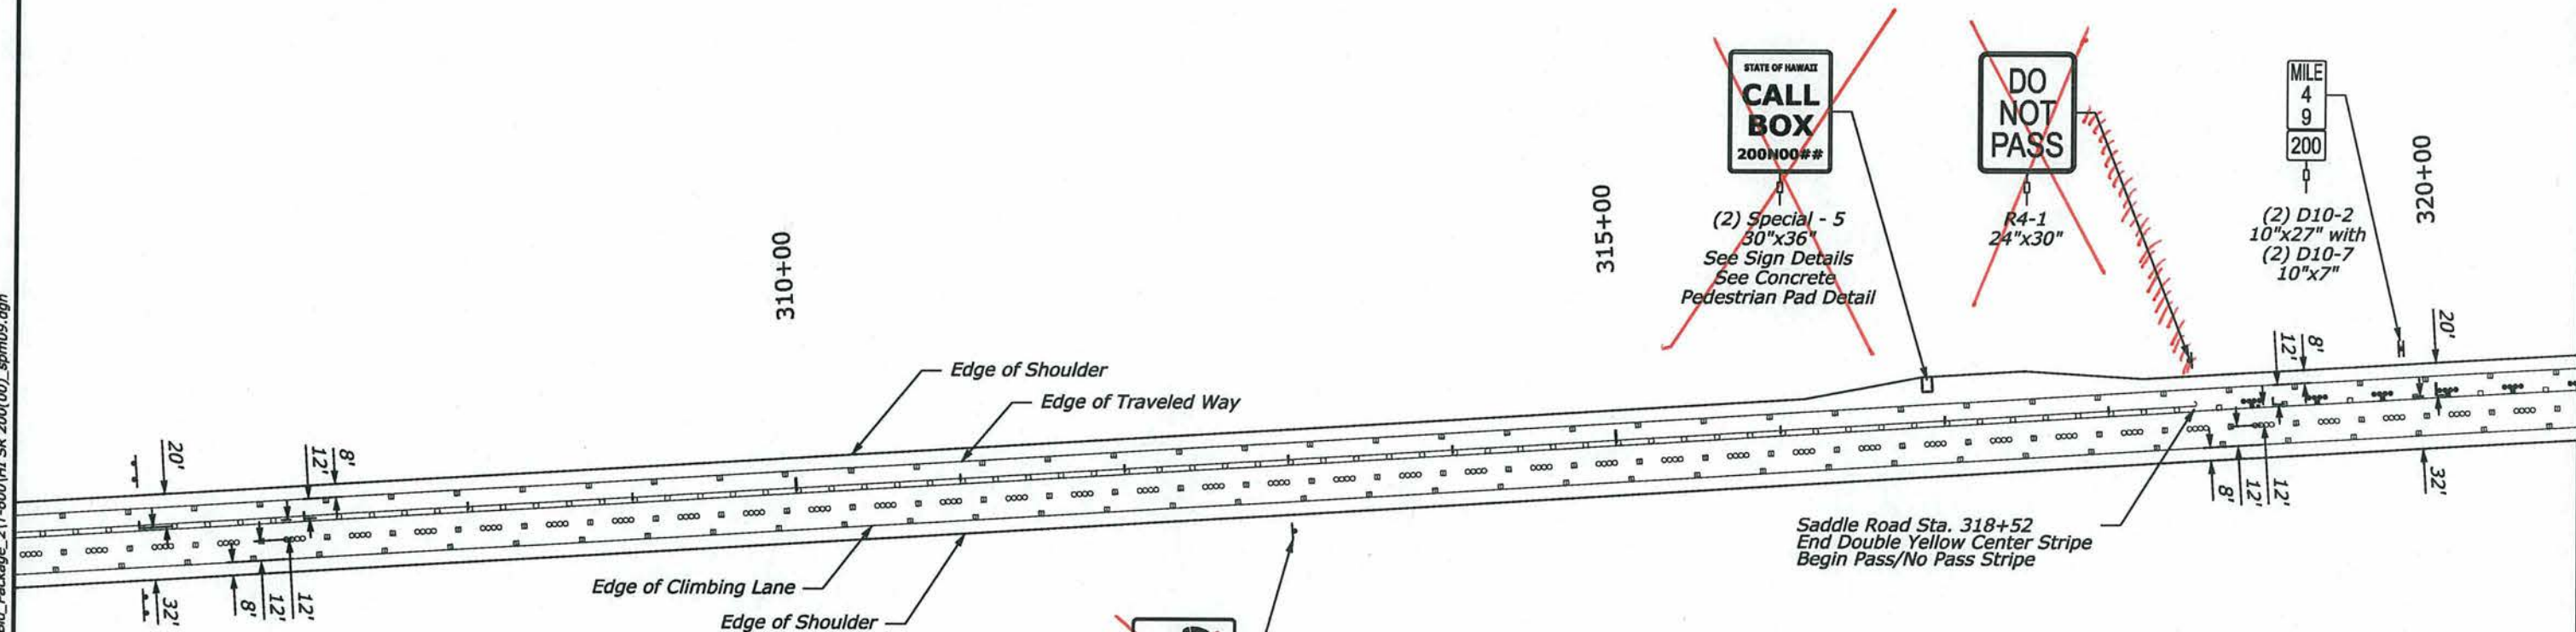

AS-BUILT DRAWINGS/SPECIFICATIONS
 This certifies that the dimensions and details shown on this sheet reflect the dimensions and details and specifications as constructed in the field.



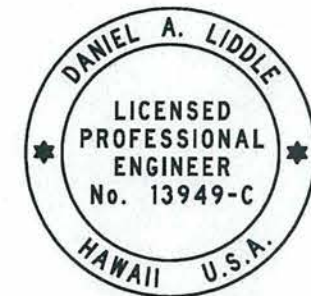


 



GOODFELLOW BROS., INC.
 Contractor's Name:
[Signature] Signature *1/2/14* Date




This work was prepared by me or under my supervision
Daniel A. Liddle
 Expiration Date of License 4/30/2014


U.S. DEPARTMENT OF TRANSPORTATION
 FEDERAL HIGHWAY ADMINISTRATION
 CENTRAL FEDERAL LANDS HIGHWAY DIVISION

**SADDLE ROAD
 SIGNING & STRIPING PLAN**

-  4" Double Yellow Center Stripe with Type D Markers
-  4" Double Yellow Median Stripe with Type H Markers
-  4" Yellow Center Stripe with Type D, H & J Markers
-  Type A & C Markers
-  4" White Guide Line
-  4" White Line with Type A & C Markers
-  8" White Channelizing Line with Type C Markers
-  4" White Edge Line with Type C Markers
-  Delineator

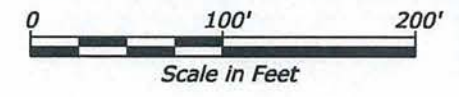

STATE	PROJECT	SHEET NO.	TOTAL SHEETS
HI	HI A-AD 6(7)	T18	T101

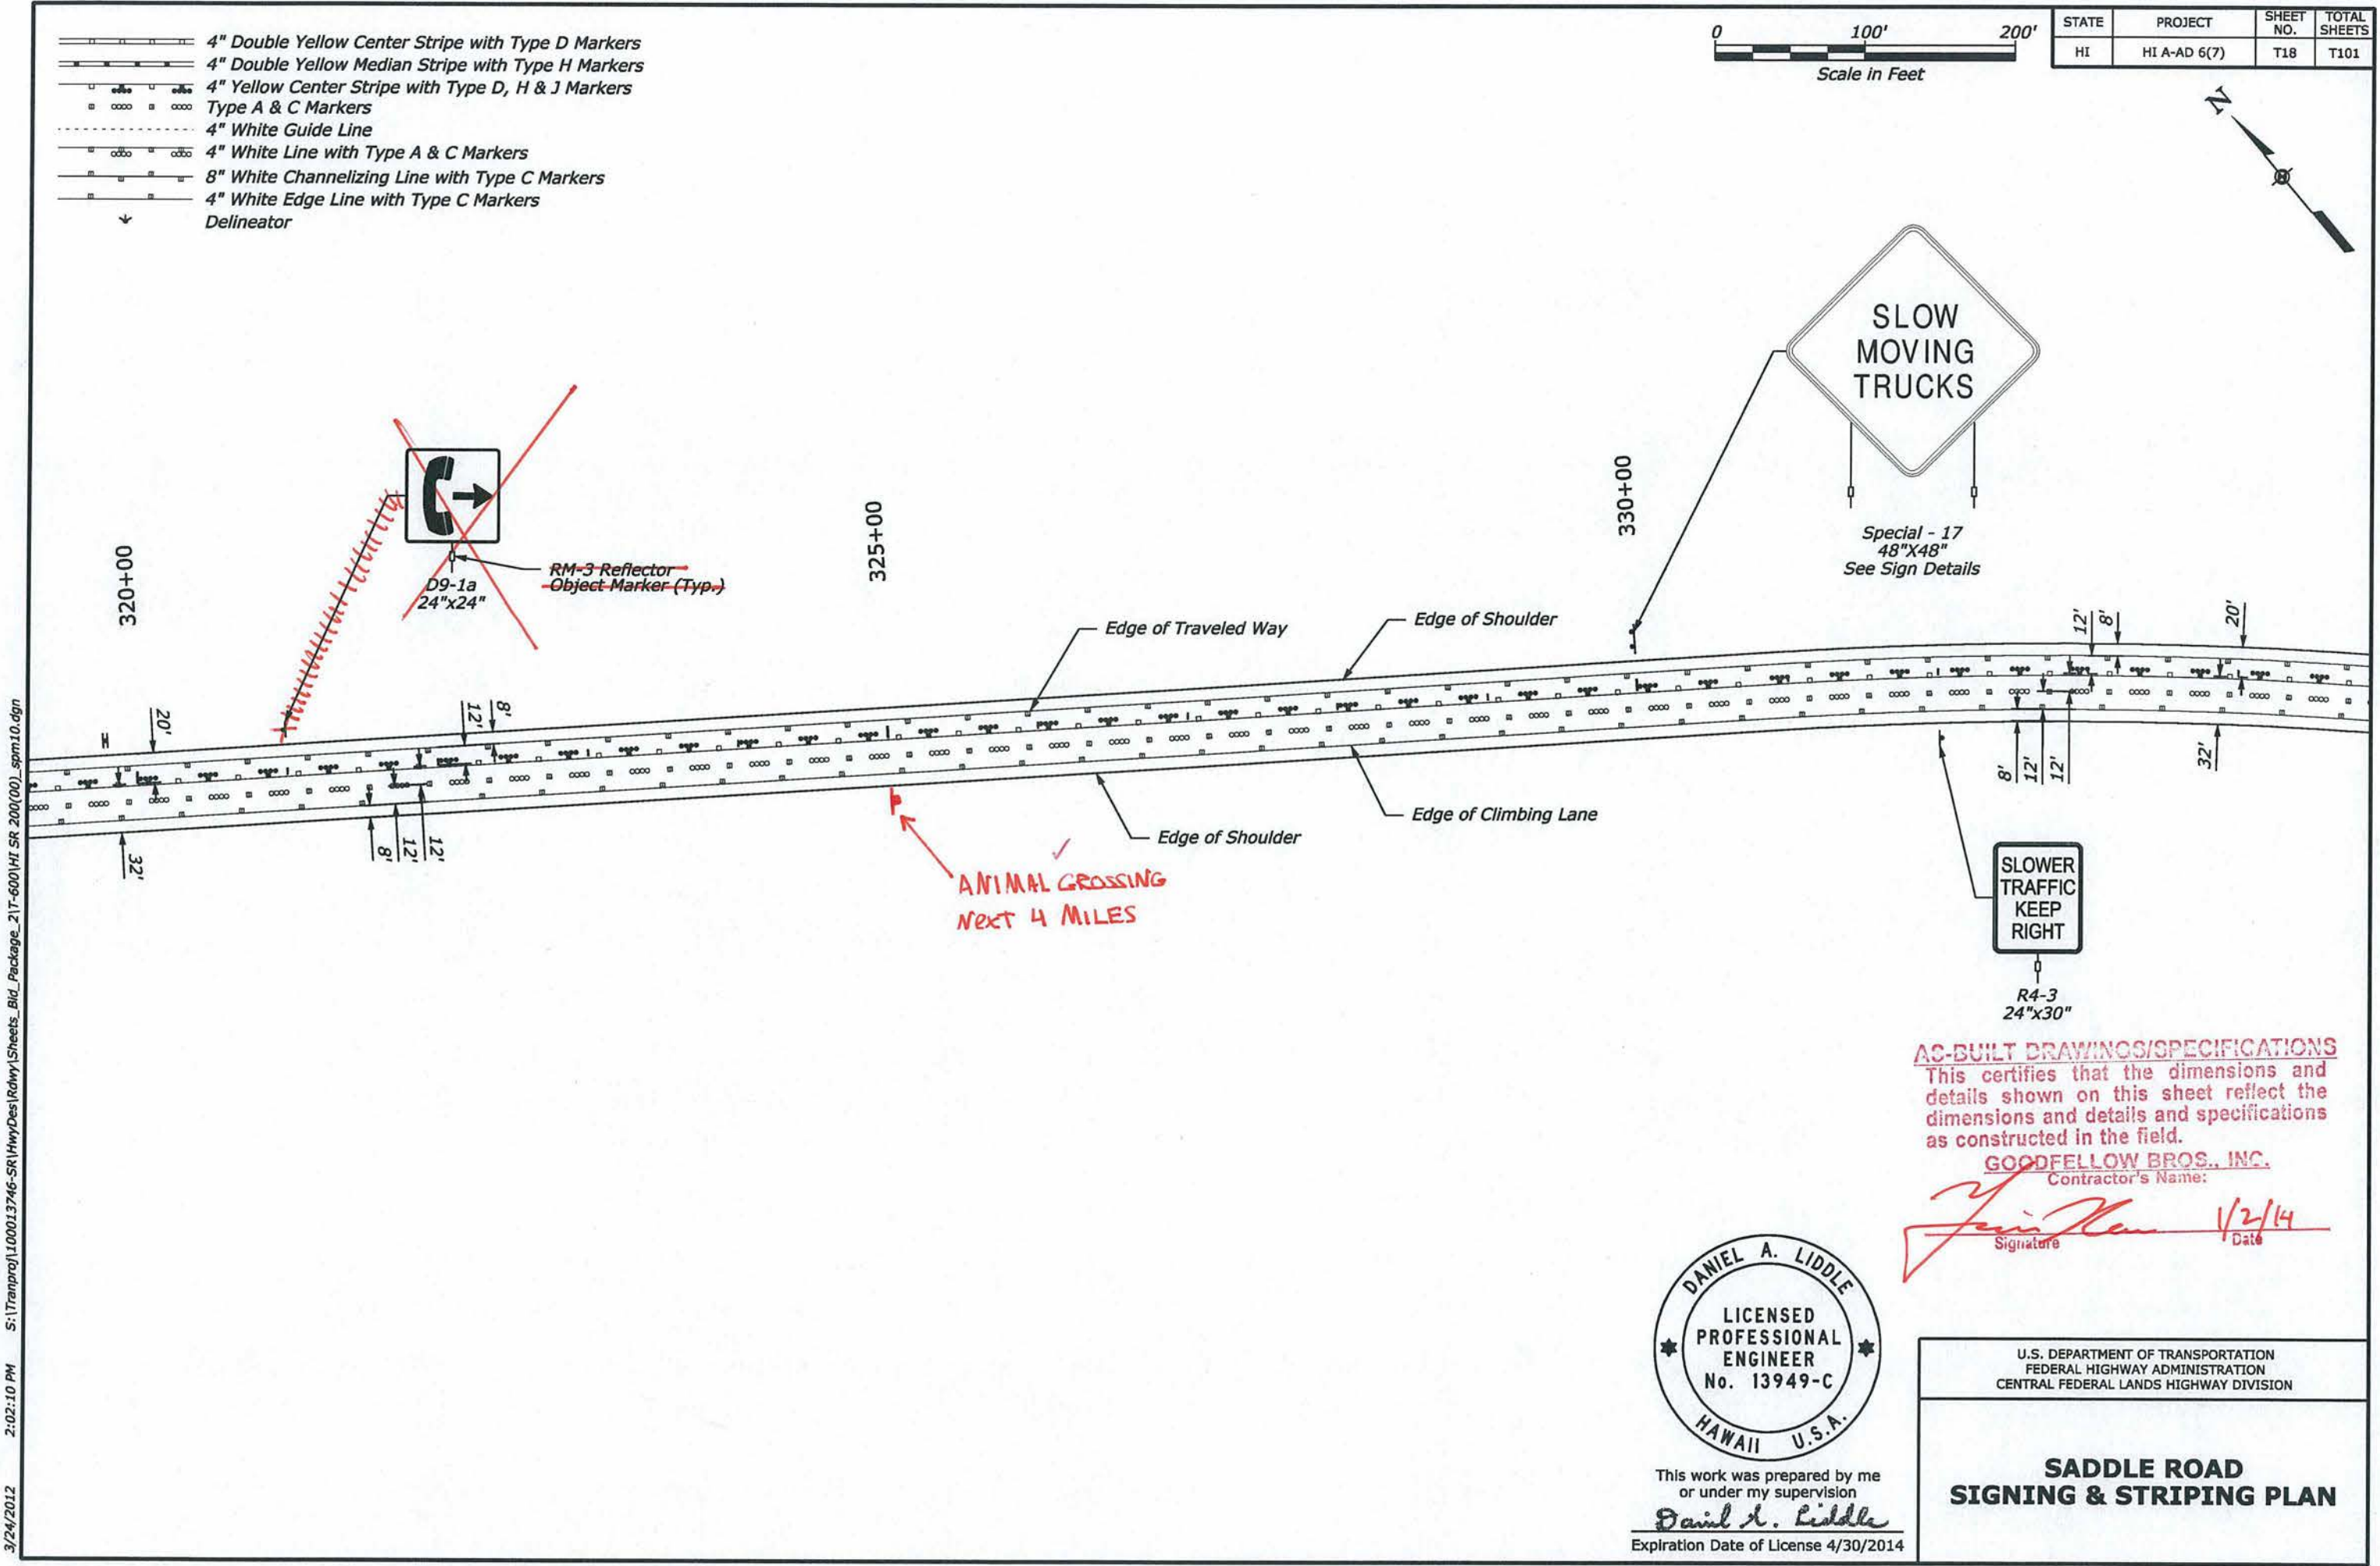

AS-BUILT DRAWINGS/SPECIFICATIONS
 This certifies that the dimensions and details shown on this sheet reflect the dimensions and details and specifications as constructed in the field.

GOODFELLOW BROS., INC.
 Contractor's Name:
[Signature] 1/2/14
 Signature Date












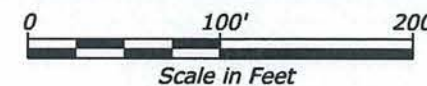
This work was prepared by me or under my supervision
Daniel A. Liddle
 Expiration Date of License 4/30/2014

U.S. DEPARTMENT OF TRANSPORTATION
 FEDERAL HIGHWAY ADMINISTRATION
 CENTRAL FEDERAL LANDS HIGHWAY DIVISION


**SADDLE ROAD
 SIGNING & STRIPING PLAN**

3/24/2012 2:02:10 PM S:\Tranpro\100013746-SR\HwyDes\Roadway\Sheets_Bid_Package_2\T-600\HI SR 200(00)_spm10.dgn

-  4" Double Yellow Center Stripe with Type D Markers
-  4" Double Yellow Median Stripe with Type H Markers
-  4" Yellow Center Stripe with Type D, H & J Markers
-  Type A & C Markers
-  4" White Guide Line
-  4" White Line with Type A & C Markers
-  8" White Channelizing Line with Type C Markers
-  4" White Edge Line with Type C Markers
-  Delineator




STATE	PROJECT	SHEET NO.	TOTAL SHEETS
HI	HI A-AD 6(7)	T19	T101

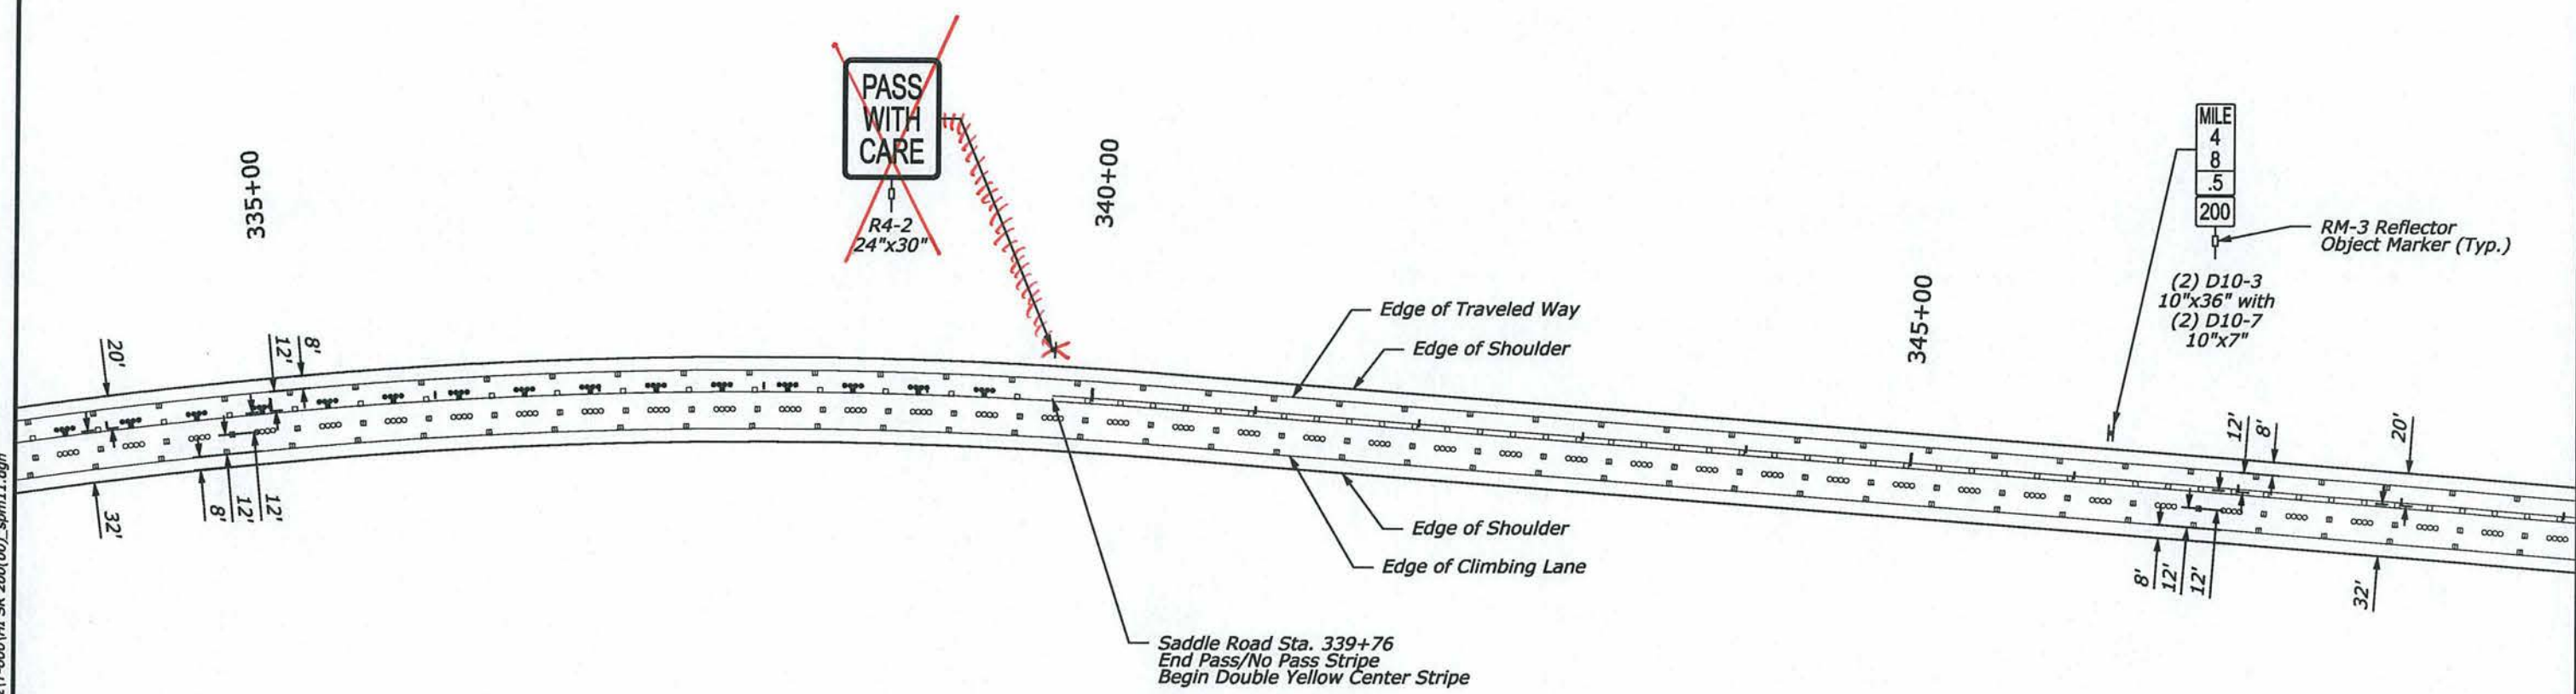

AS-BUILT DRAWINGS/SPECIFICATIONS
 This certifies that the dimensions and details shown on this sheet reflect the dimensions and details and specifications as constructed in the field.

GOODFELLOW BROS., INC.
 Contractor's Name:
[Signature] 1/2/14
 Signature Date

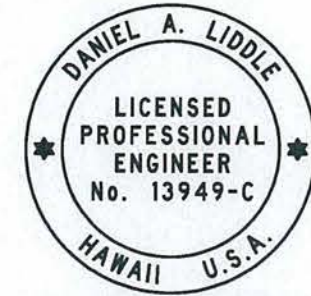











This work was prepared by me or under my supervision
Daniel A. Liddle
 Expiration Date of License 4/30/2014

U.S. DEPARTMENT OF TRANSPORTATION
 FEDERAL HIGHWAY ADMINISTRATION
 CENTRAL FEDERAL LANDS HIGHWAY DIVISION

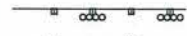**SADDLE ROAD
 SIGNING & STRIPING PLAN**

3/24/2012 2:03:12 PM S:\Tranproj\100013746-SR\HwyDes\Road\Sheets\Bld_Package_21T-600\HI SR 200(00)_spm11.dgn


-  4" Double Yellow Center Stripe with Type D Markers
-  4" Double Yellow Median Stripe with Type H Markers
-  4" Yellow Center Stripe with Type D, H & J Markers
-  Type A & C Markers
-  4" White Guide Line
-  4" White Line with Type A & C Markers
-  8" White Channelizing Line with Type C Markers
-  4" White Edge Line with Type C Markers
-  Delineator

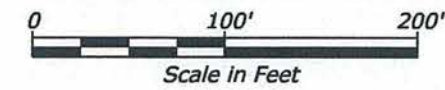

STATE	PROJECT	SHEET NO.	TOTAL SHEETS
HI	HI A-AD 6(7)	T20	T101




3/24/2012 2:04:19 PM S:\Tranproj\100013746-SR\HwyDes\Roadwy\Sheets_Bid_Package_21T-600\HI SR 200(00)_spm12.dgn

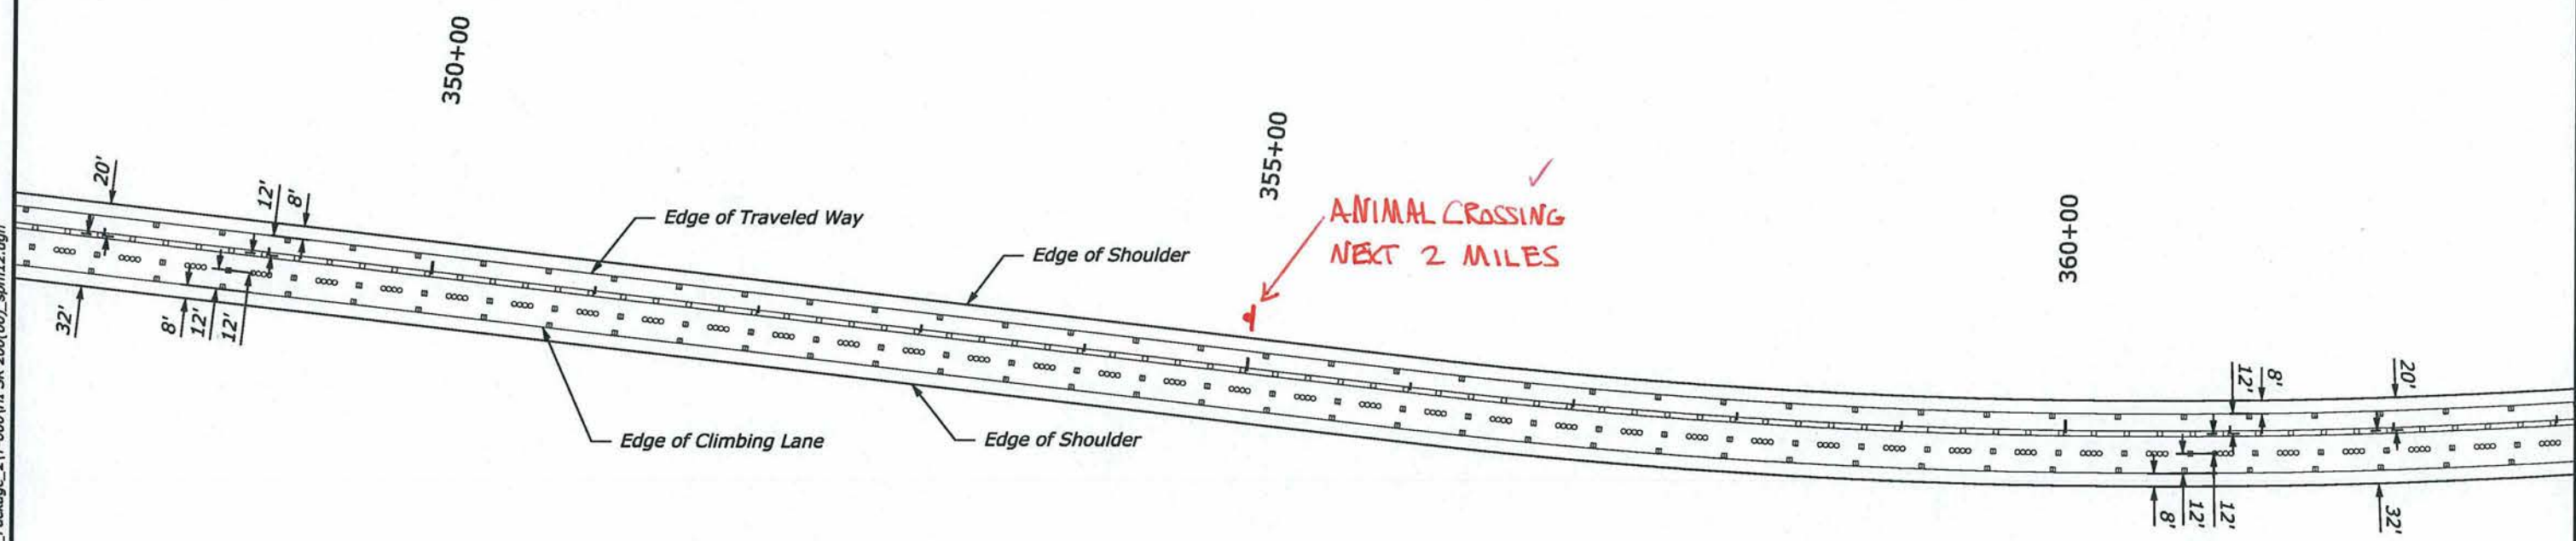

AS-BUILT DRAWINGS/SPECIFICATIONS
 This certifies that the dimensions and details shown on this sheet reflect the dimensions and details and specifications as constructed in the field.

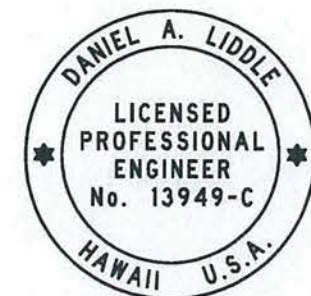


 

 



GOODFELLOW BROS., INC.
 Contractor's Name:
[Signature] 1/2/14
 Signature Date




This work was prepared by me or under my supervision
Daniel A. Liddle
 Expiration Date of License 4/30/2014

U.S. DEPARTMENT OF TRANSPORTATION
 FEDERAL HIGHWAY ADMINISTRATION
 CENTRAL FEDERAL LANDS HIGHWAY DIVISION

**SADDLE ROAD
 SIGNING & STRIPING PLAN**

-  4" Double Yellow Center Stripe with Type D Markers
-  4" Double Yellow Median Stripe with Type H Markers
-  4" Yellow Center Stripe with Type D, H & J Markers
-  Type A & C Markers
-  4" White Guide Line
-  4" White Line with Type A & C Markers
-  8" White Channelizing Line with Type C Markers
-  4" White Edge Line with Type C Markers
-  Delineator

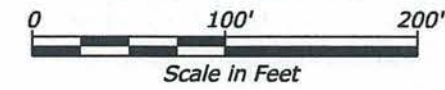

STATE	PROJECT	SHEET NO.	TOTAL SHEETS
HI	HI A-AD 6(7)	T21	T101




3/24/2012 2:05:28 PM S:\Tranproj\100013746-SR\HwyDes\rdwy\Sheets_Bid_Package_217-600\HI SR 200(00)_sppm13.dgn

365+00

370+00

375+00

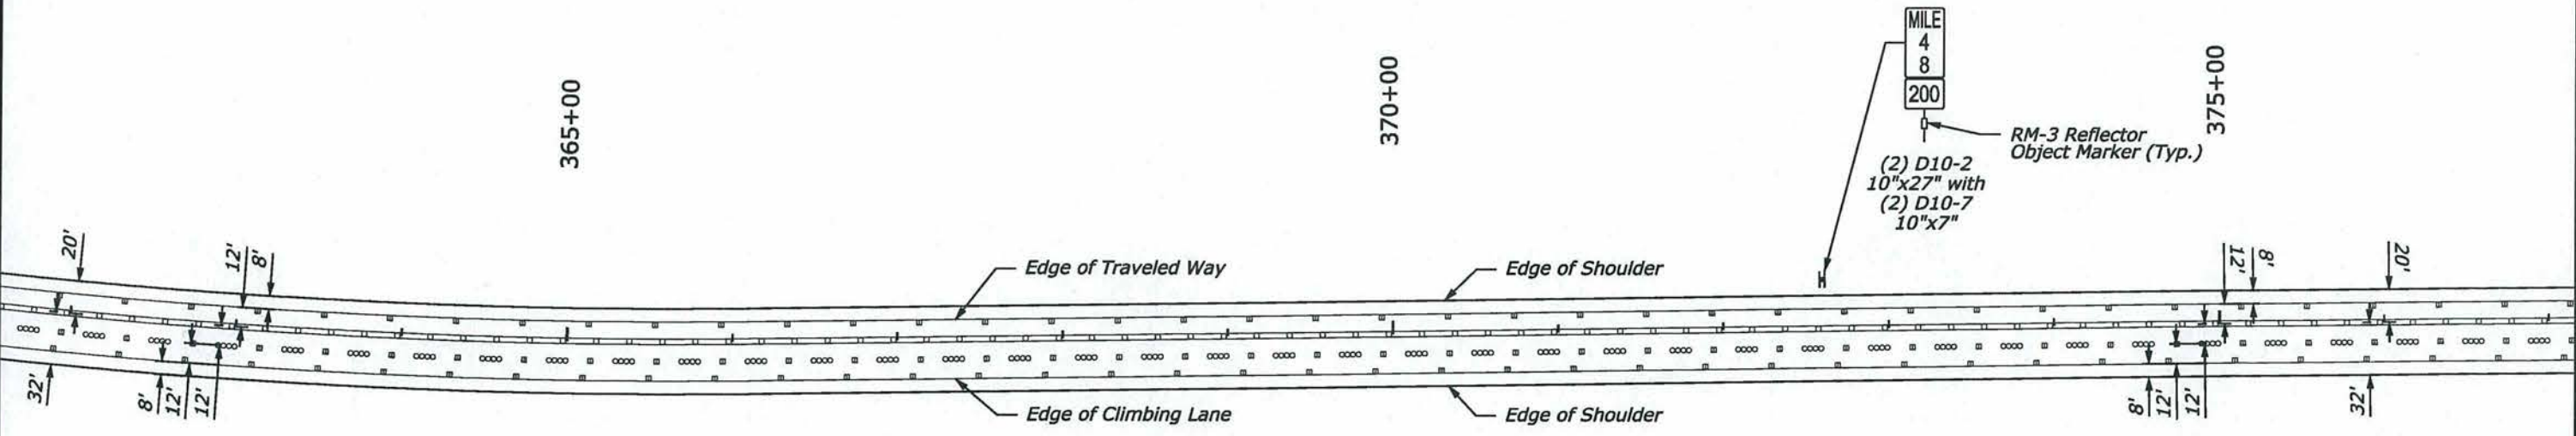

AS-BUILT DRAWINGS/SPECIFICATIONS

This certifies that the dimensions and details shown on this sheet reflect the dimensions and details and specifications as constructed in the field.

GOODFELLOW BROS., INC.
Contractor's Name:

 








[Signature] 1/2/14
Signature Date




This work was prepared by me or under my supervision
Daniel A. Liddle
Expiration Date of License 4/30/2014

  U.S. DEPARTMENT OF TRANSPORTATION
FEDERAL HIGHWAY ADMINISTRATION
CENTRAL FEDERAL LANDS HIGHWAY DIVISION

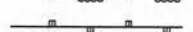**SADDLE ROAD
SIGNING & STRIPING PLAN**

-  4" Double Yellow Center Stripe with Type D Markers
-  4" Double Yellow Median Stripe with Type H Markers
-  4" Yellow Center Stripe with Type D, H & J Markers
-  Type A & C Markers
-  4" White Guide Line
-  4" White Line with Type A & C Markers
-  8" White Channelizing Line with Type C Markers
-  4" White Edge Line with Type C Markers
-  Delineator

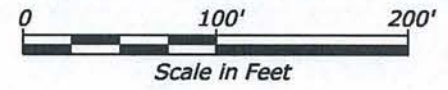

STATE	PROJECT	SHEET NO.	TOTAL SHEETS
HI	HI A-AD 6(7)	T22	T101




AS-BUILT DRAWINGS/SPECIFICATIONS
 This certifies that the dimensions and details shown on this sheet reflect the dimensions and details and specifications as constructed in the field.

GOODFELLOW BROS., INC.
 Contractor's Name:

Yairi N... 1/2/14
 Signature Date

S:\Trenproj\100013746-SR\HwyDes\Roadwy\Sheets_Bld_Package_21T-600\HI SR 200(00)_spm14.dgn 2:06:30 PM 3/24/2012

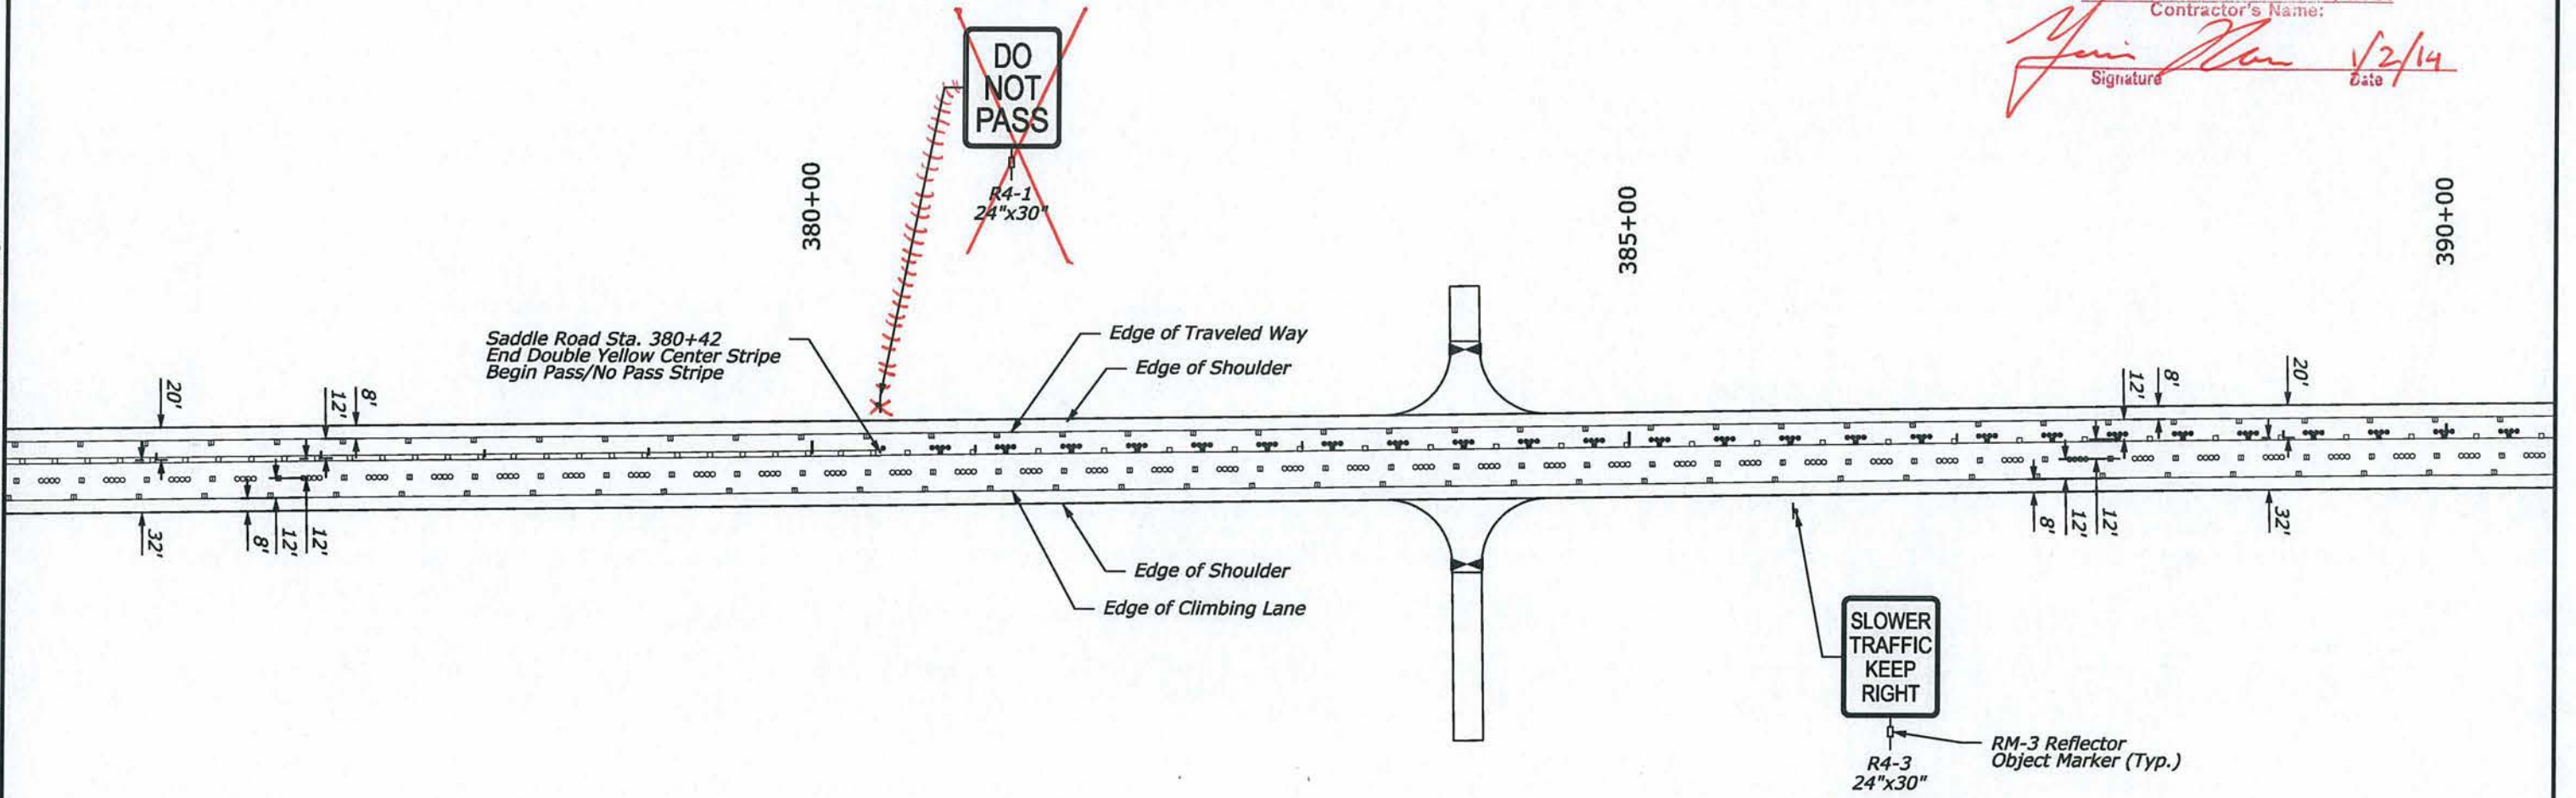










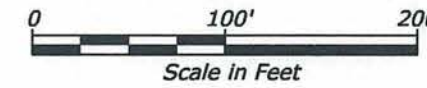
This work was prepared by me or under my supervision
Daniel A. Liddle
 Expiration Date of License 4/30/2014

U.S. DEPARTMENT OF TRANSPORTATION
 FEDERAL HIGHWAY ADMINISTRATION
 CENTRAL FEDERAL LANDS HIGHWAY DIVISION

**SADDLE ROAD
 SIGNING & STRIPING PLAN**

S:\Transport\100013746-SR\HwyDes\Sheets_Bid_Package_2\T-600\HI SR 200(00)_spm15.dgn 3/24/2012 2:07:36 PM

-  4" Double Yellow Center Stripe with Type D Markers
-  4" Double Yellow Median Stripe with Type H Markers
-  4" Yellow Center Stripe with Type D, H & J Markers
-  Type A & C Markers
-  4" White Guide Line
-  4" White Line with Type A & C Markers
-  8" White Channelizing Line with Type C Markers
-  4" White Edge Line with Type C Markers
-  Delineator



STATE	PROJECT	SHEET NO.	TOTAL SHEETS
HI	HI A-AD 6(7)	T23	T101




390+00

395+00


400+00

405+00

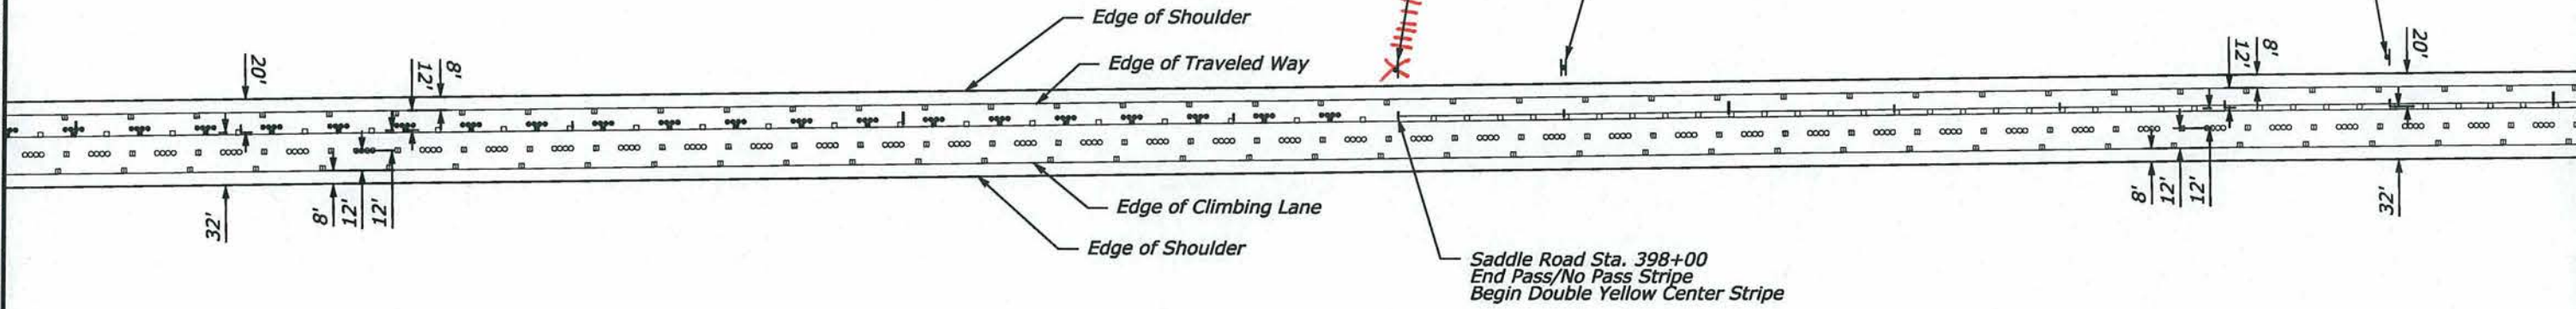

AS-BUILT DRAWINGS/SPECIFICATIONS
 This certifies that the dimensions and details shown on this sheet reflect the dimensions and details and specifications as constructed in the field.







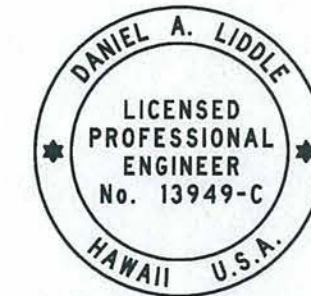


GOODFELLOW BROS., INC.
 Contractor's Name:
[Signature]
 Signature Date: *1/2/14*




This work was prepared by me or under my supervision
Daniel A. Liddle
 Expiration Date of License 4/30/2014

U.S. DEPARTMENT OF TRANSPORTATION
 FEDERAL HIGHWAY ADMINISTRATION
 CENTRAL FEDERAL LANDS HIGHWAY DIVISION

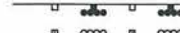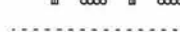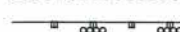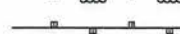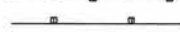**SADDLE ROAD
 SIGNING & STRIPING PLAN**

-  4" Double Yellow Center Stripe with Type D Markers
-  4" Double Yellow Median Stripe with Type H Markers
-  4" Yellow Center Stripe with Type D, H & J Markers
-  Type A & C Markers
-  4" White Guide Line
-  4" White Line with Type A & C Markers
-  8" White Channelizing Line with Type C Markers
-  4" White Edge Line with Type C Markers
-  Delineator

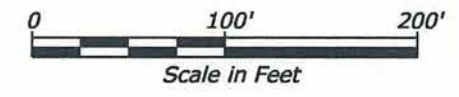

STATE	PROJECT	SHEET NO.	TOTAL SHEETS
HI	HI A-AD 6(7)	T24	T101



S:\Transport\100013746-SR\HwyDes\Roadway\Sheets_Bid_Package_2\T-600\HI SR 200(00)_spm16.dgn 2:08:44 PM 3/24/2012


405+00



R2-1(55)
48"x60"
RM-3 Reflector
Object Marker (Typ.)

410+00

415+00

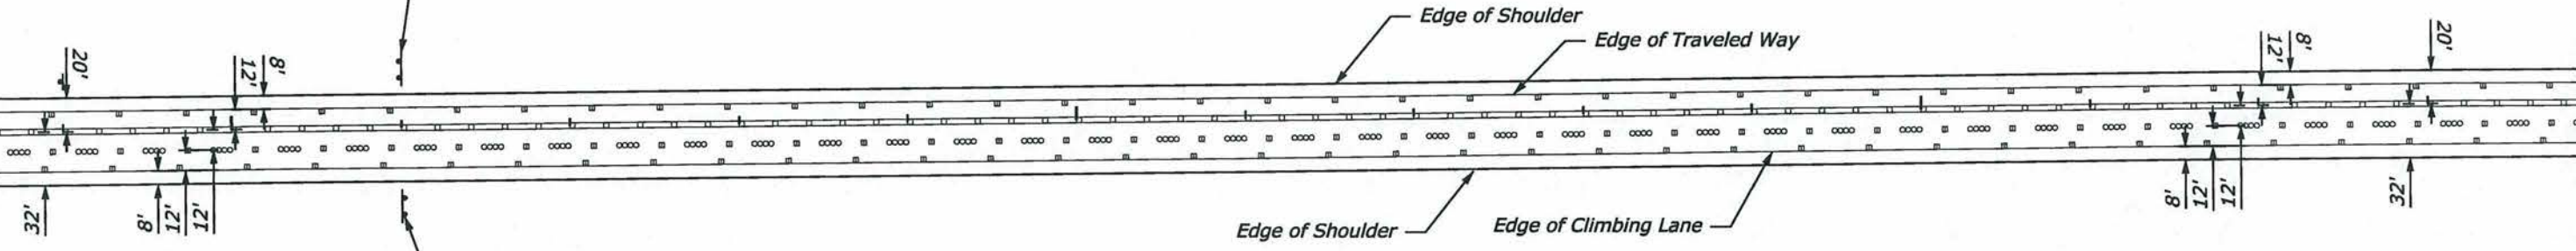

R2-1(55)
48"x60"

AS-BUILT DRAWINGS/SPECIFICATIONS
This certifies that the dimensions and details shown on this sheet reflect the dimensions and details and specifications as constructed in the field.

GOODFELLOW BROS., INC.
Contractor's Name:
Jim Nea / 2/14
Signature Date






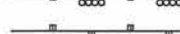





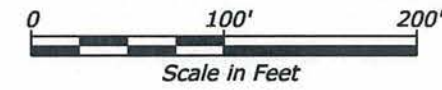
This work was prepared by me or under my supervision
Daniel A. Liddle
Expiration Date of License 4/30/2014

U.S. DEPARTMENT OF TRANSPORTATION
FEDERAL HIGHWAY ADMINISTRATION
CENTRAL FEDERAL LANDS HIGHWAY DIVISION

**SADDLE ROAD
SIGNING & STRIPING PLAN**

S:\Tranproj\100013746-SR Hwy Des\Drawings\Sheets_Bid_Package_21T-600\HI SR 200(00)_spm17.dgn 2:09:54 PM 3/24/2012

-  4" Double Yellow Center Stripe with Type D Markers
-  4" Double Yellow Median Stripe with Type H Markers
-  4" Yellow Center Stripe with Type D, H & J Markers
-  Type A & C Markers
-  4" White Guide Line
-  4" White Line with Type A & C Markers
-  8" White Channelizing Line with Type C Markers
-  4" White Edge Line with Type C Markers
-  Delineator



STATE	PROJECT	SHEET NO.	TOTAL SHEETS
HI	HI A-AD 6(7)	T25	T101



420+00

DO NOT PASS

R4-1
24"x30"

425+00

MILE
4
7
200

(2) D10-2
10"x27" with
(2) D10-7
10"x7"

RM-3 Reflector
Object Marker (Typ.)

430+00

Edge of Traveled Way
Edge of Shoulder

Saddle Road Sta. 423+30
End Double Yellow Center Stripe
Begin Pass/No Pass Stripe


Edge of Shoulder
Edge of Climbing Lane

AS-BUILT DRAWINGS/SPECIFICATIONS

This certifies that the dimensions and details shown on this sheet reflect the dimensions and details and specifications as constructed in the field.

GOODFELLOW BROS., INC.
Contractor's Name:

[Signature] 1/2/14
Signature Date

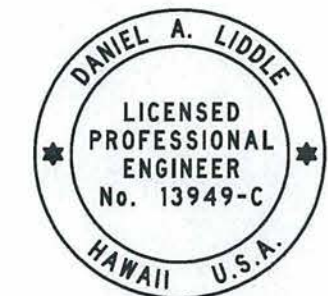


 

 





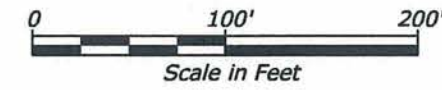
This work was prepared by me or under my supervision
Daniel A. Liddle
Expiration Date of License 4/30/2014

U.S. DEPARTMENT OF TRANSPORTATION
FEDERAL HIGHWAY ADMINISTRATION
CENTRAL FEDERAL LANDS HIGHWAY DIVISION

**SADDLE ROAD
SIGNING & STRIPING PLAN**


S:\Transport\100013746-SR\HwyDes\Drawings\Sheets_Bid_Package_21T-600\HI SR 200(00)_spm18.dgn 2:10:52 PM 3/24/2012

-  4" Double Yellow Center Stripe with Type D Markers
-  4" Double Yellow Median Stripe with Type H Markers
-  4" Yellow Center Stripe with Type D, H & J Markers
-  Type A & C Markers
-  4" White Guide Line
-  4" White Line with Type A & C Markers
-  8" White Channelizing Line with Type C Markers
-  4" White Edge Line with Type C Markers
-  Delineator




STATE	PROJECT	SHEET NO.	TOTAL SHEETS
HI	HI A-AD 6(7)	T26	T101




**STEEP DOWN
GRADES CONTINUE**
NEXT 4 MILES

*Special - 13
96"x48"
With solar powered
yellow flashing beacons (2)
See Sign Details*

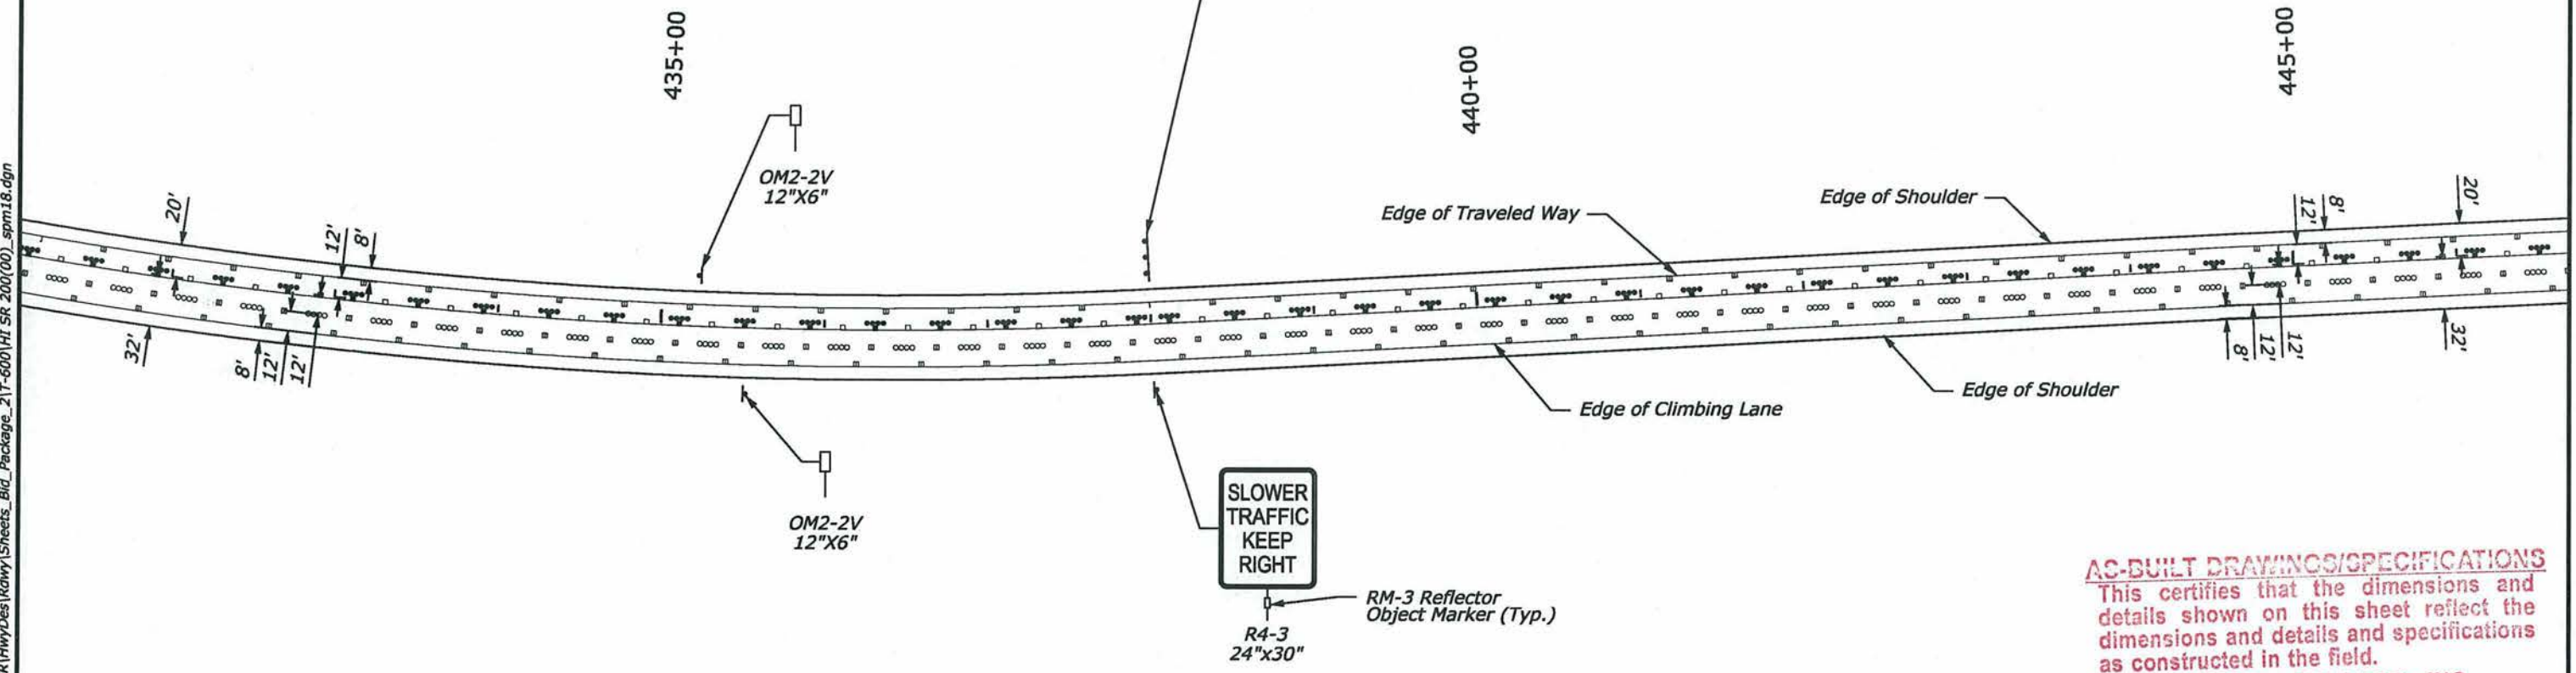

AS-BUILT DRAWINGS/SPECIFICATIONS
 This certifies that the dimensions and details shown on this sheet reflect the dimensions and details and specifications as constructed in the field.



 

 




GOODFELLOW BROS., INC.
 Contractor's Name:
Jim Kim / 2/14
 Signature Date




This work was prepared by me or under my supervision
Daniel A. Liddle
 Expiration Date of License 4/30/2014

U.S. DEPARTMENT OF TRANSPORTATION
 FEDERAL HIGHWAY ADMINISTRATION
 CENTRAL FEDERAL LANDS HIGHWAY DIVISION

**SADDLE ROAD
SIGNING & STRIPING PLAN**


-  4" Double Yellow Center Stripe with Type D Markers
-  4" Double Yellow Median Stripe with Type H Markers
-  4" Yellow Center Stripe with Type D, H & J Markers
-  Type A & C Markers
-  4" White Guide Line
-  4" White Line with Type A & C Markers
-  8" White Channelizing Line with Type C Markers
-  4" White Edge Line with Type C Markers
-  Delineator

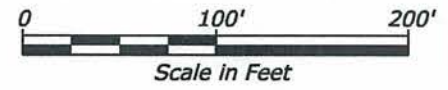

STATE	PROJECT	SHEET NO.	TOTAL SHEETS
HI	HI A-AD 6(7)	T27	T101



3/24/2012 2:12:06 PM S:\Transport\100013746-SR\HwyDes\Rowy\Sheets_Bld_Package_2\T-600\HI SR 200(00)_spm19.dgn

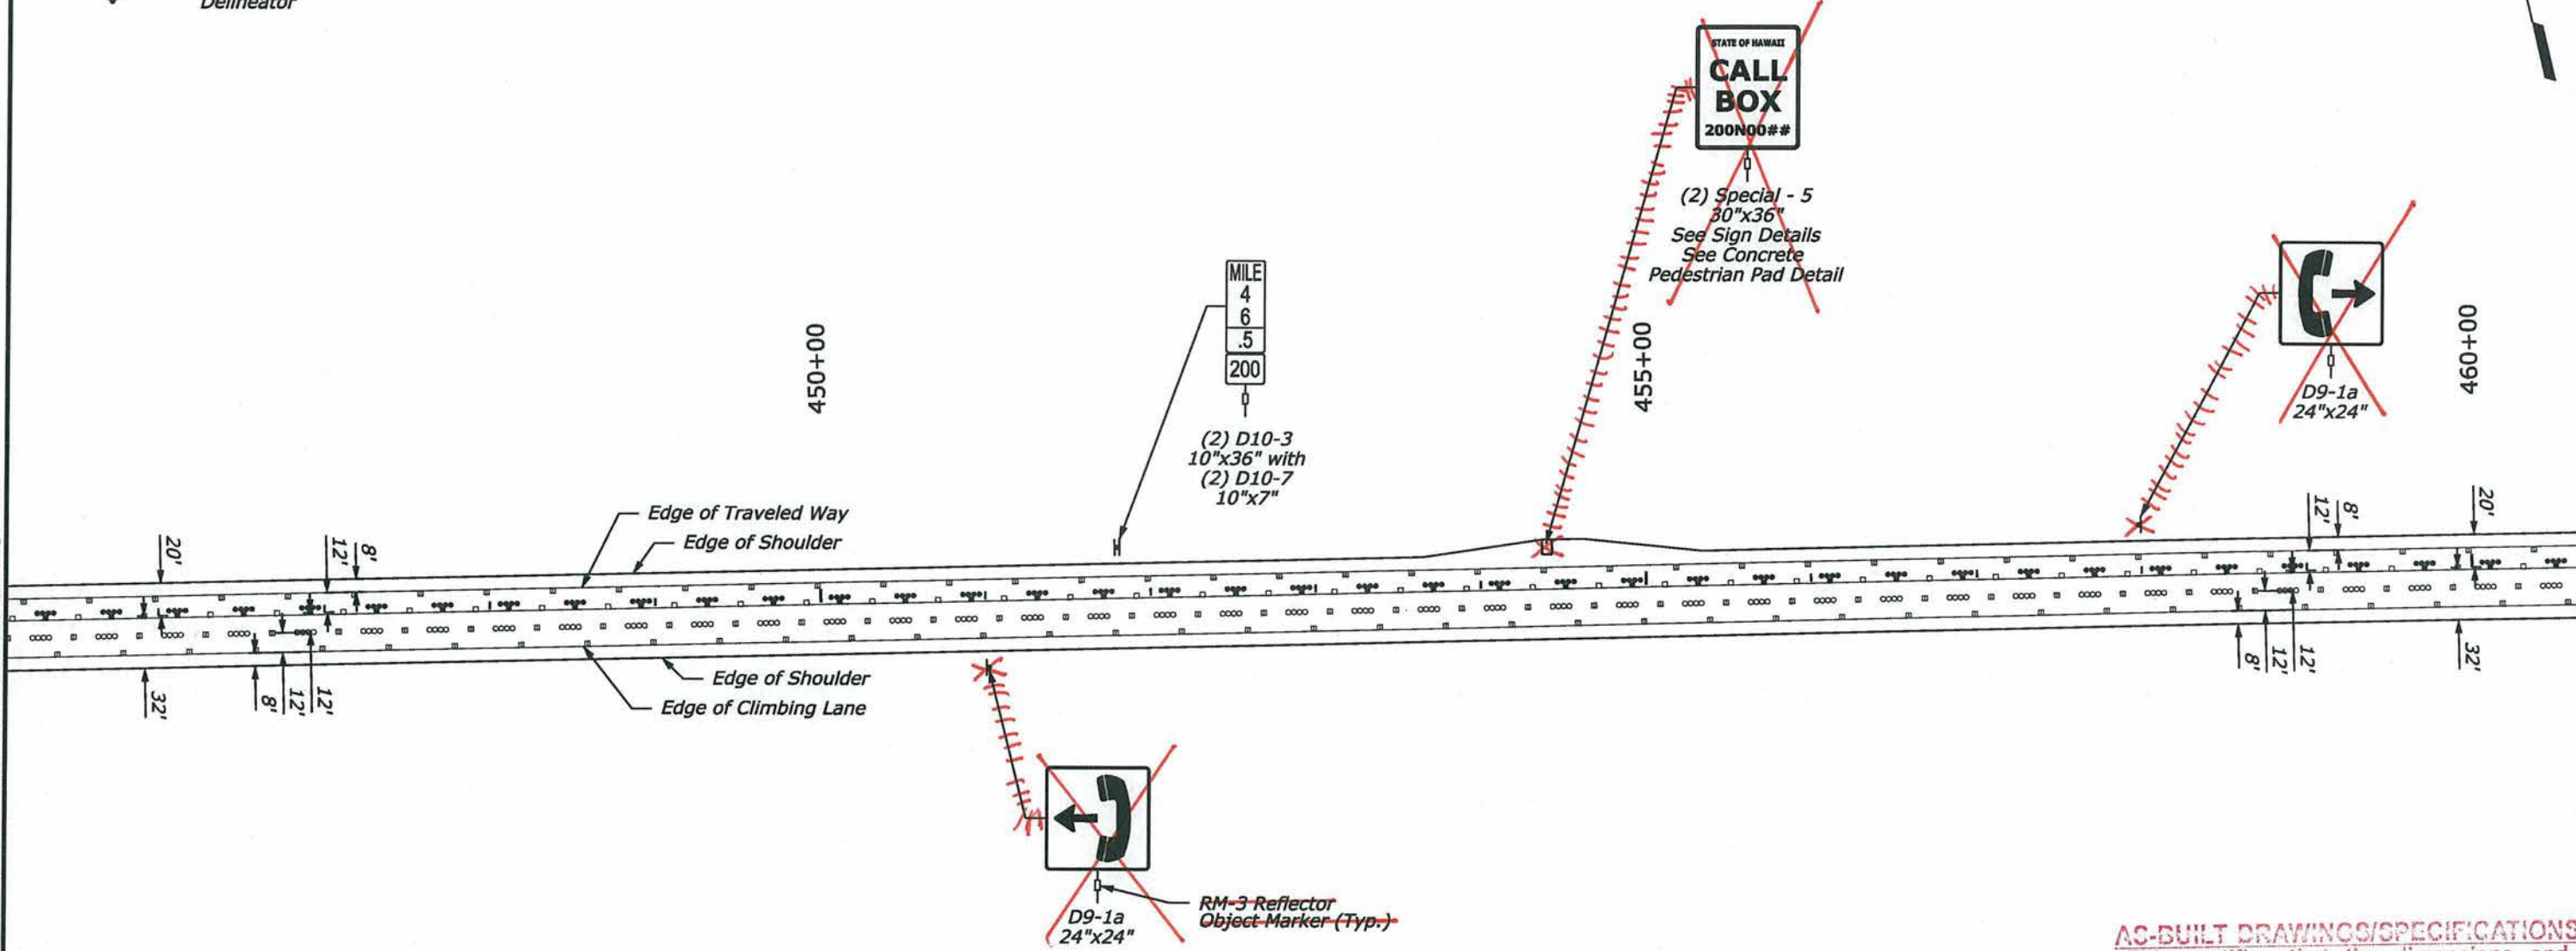

AS-BUILT DRAWINGS/SPECIFICATIONS
 This certifies that the dimensions and details shown on this sheet reflect the dimensions and details and specifications as constructed in the field.

GOODFELLOW BROS., INC.
 Contractor's Name:
[Signature] 1/2/14
 Signature Date






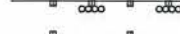

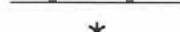



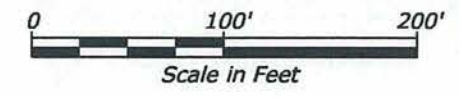
This work was prepared by me or under my supervision
Daniel A. Liddle
 Expiration Date of License 4/30/2014

U.S. DEPARTMENT OF TRANSPORTATION
 FEDERAL HIGHWAY ADMINISTRATION
 CENTRAL FEDERAL LANDS HIGHWAY DIVISION

**SADDLE ROAD
 SIGNING & STRIPING PLAN**

S:\Tranproj\100013746-SR\HwyDes\Roadway\Sheets_Bid_Package_2\T-600\HI SR 200(00)_spm20.dgn 3/24/2012 2:15:44 PM

-  4" Double Yellow Center Stripe with Type D Markers
-  4" Double Yellow Median Stripe with Type H Markers
-  4" Yellow Center Stripe with Type D, H & J Markers
-  Type A & C Markers
-  4" White Guide Line
-  4" White Line with Type A & C Markers
-  8" White Channelizing Line with Type C Markers
-  4" White Edge Line with Type C Markers
-  Delineator




STATE	PROJECT	SHEET NO.	TOTAL SHEETS
HI	HI A-AD 6(7)	T28	T101



460+00

465+00


470+00

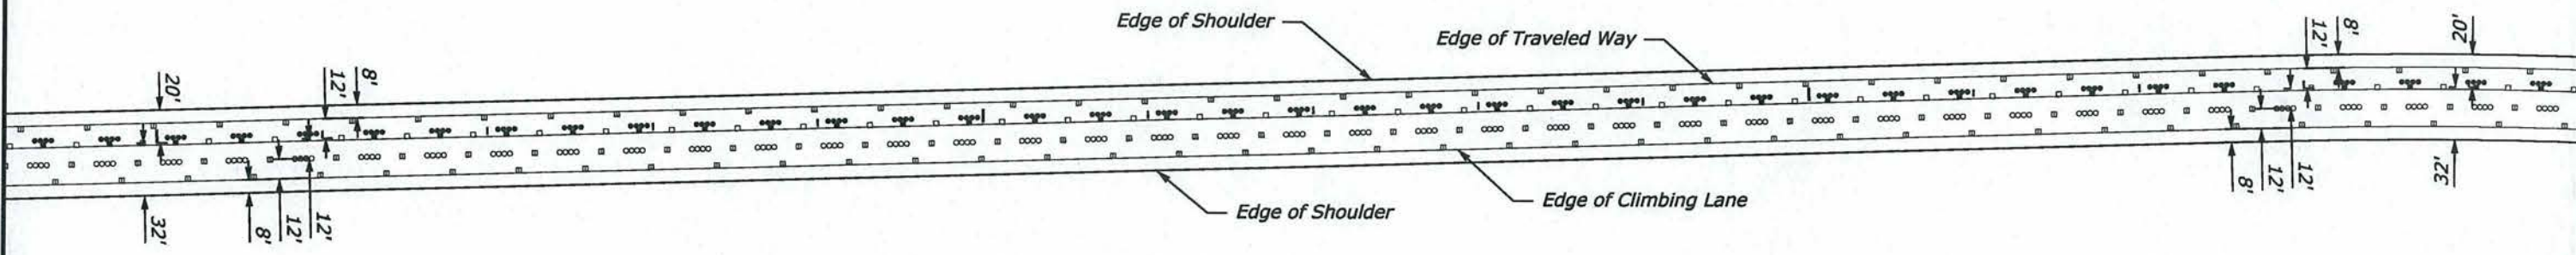

AS-BUILT DRAWINGS/SPECIFICATIONS
 This certifies that the dimensions and details shown on this sheet reflect the dimensions and details and specifications as constructed in the field.

GOODFELLOW BROS., INC.
 Contractor's Name:

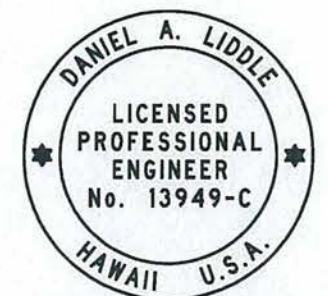


 





[Signature] 1/2/14
 Signature Date




This work was prepared by me or under my supervision
Daniel A. Liddle
 Expiration Date of License 4/30/2014


U.S. DEPARTMENT OF TRANSPORTATION
 FEDERAL HIGHWAY ADMINISTRATION
 CENTRAL FEDERAL LANDS HIGHWAY DIVISION

**SADDLE ROAD
 SIGNING & STRIPING PLAN**

-  4" Double Yellow Center Stripe with Type D Markers
-  4" Double Yellow Median Stripe with Type H Markers
-  4" Yellow Center Stripe with Type D, H & J Markers
-  Type A & C Markers
-  4" White Guide Line
-  4" White Line with Type A & C Markers
-  8" White Channelizing Line with Type C Markers
-  4" White Edge Line with Type C Markers
-  Delineator

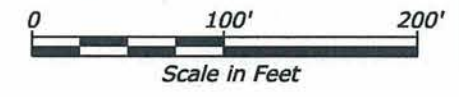

STATE	PROJECT	SHEET NO.	TOTAL SHEETS
HI	HI A-AD 6(7)	T29	T101

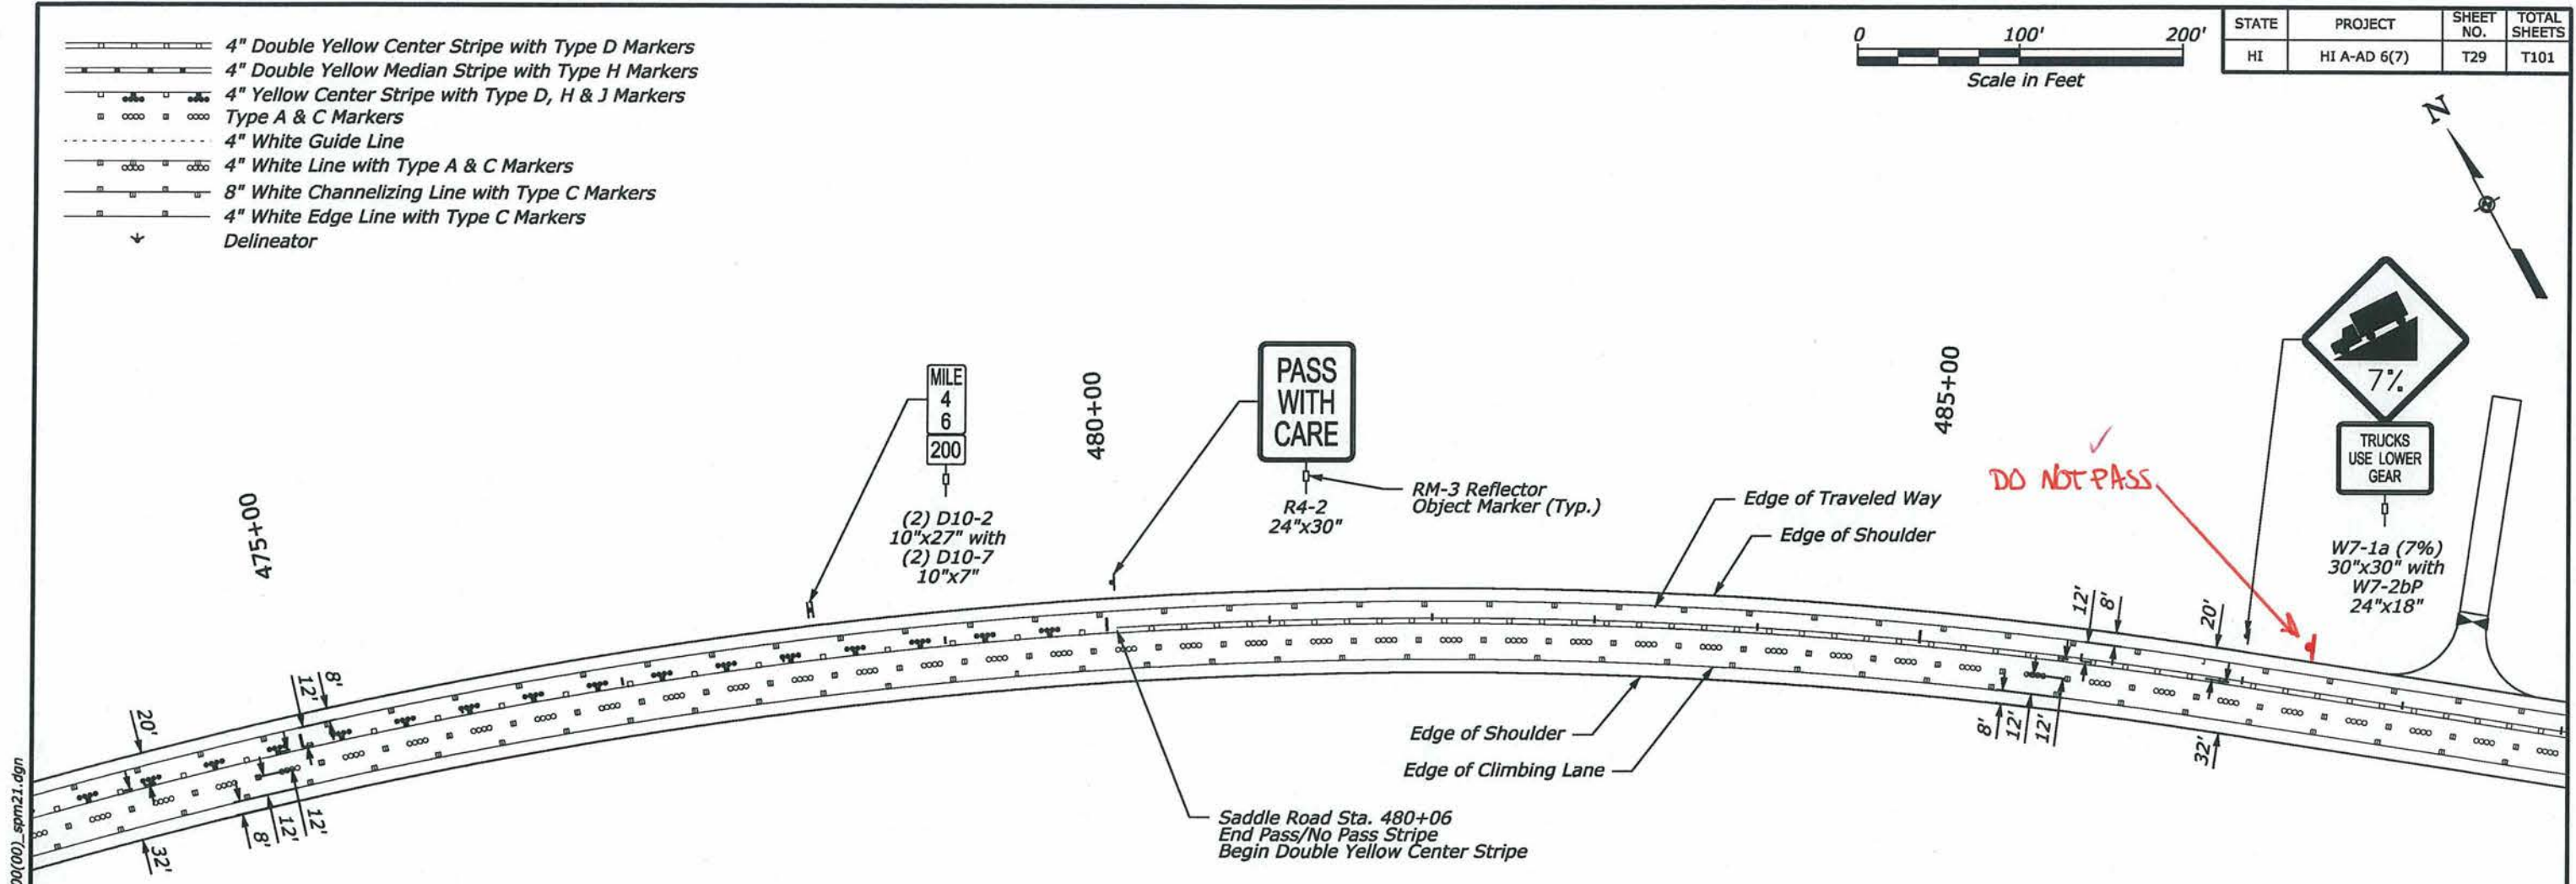

S:\Transport\100013746-SR\HwyDes\Roadwy\Sheets_Bid_Package_2\T-600\HI SR 200(00)_spm21.dgn 2:16:48 PM 3/24/2012

AS-BUILT DRAWINGS/SPECIFICATIONS
 This certifies that the dimensions and details shown on this sheet reflect the dimensions and details and specifications as constructed in the field.

GOODFELLOW BROS., INC.
 Contractor's Name:

 








[Signature] 1/2/14
 Signature Date




This work was prepared by me or under my supervision
Daniel A. Liddle
 Expiration Date of License 4/30/2014

 U.S. DEPARTMENT OF TRANSPORTATION
 FEDERAL HIGHWAY ADMINISTRATION
 CENTRAL FEDERAL LANDS HIGHWAY DIVISION

**SADDLE ROAD
 SIGNING & STRIPING PLAN**


-  4" Double Yellow Center Stripe with Type D Markers
-  4" Double Yellow Median Stripe with Type H Markers
-  4" Yellow Center Stripe with Type D, H & J Markers
-  Type A & C Markers
-  4" White Guide Line
-  4" White Line with Type A & C Markers
-  8" White Channelizing Line with Type C Markers
-  4" White Edge Line with Type C Markers
-  Delineator

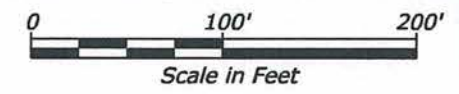

STATE	PROJECT	SHEET NO.	TOTAL SHEETS
HI	HI A-AD 6(7)	T30	T101



3/24/2012 2:17:48 PM S:\Tranpro\100013746-SR\HwyDes\rdwy\Sheets_Bid_Package_2\T-600\HI SR 200(00)\HI SR 200(00)_spm22.dgn

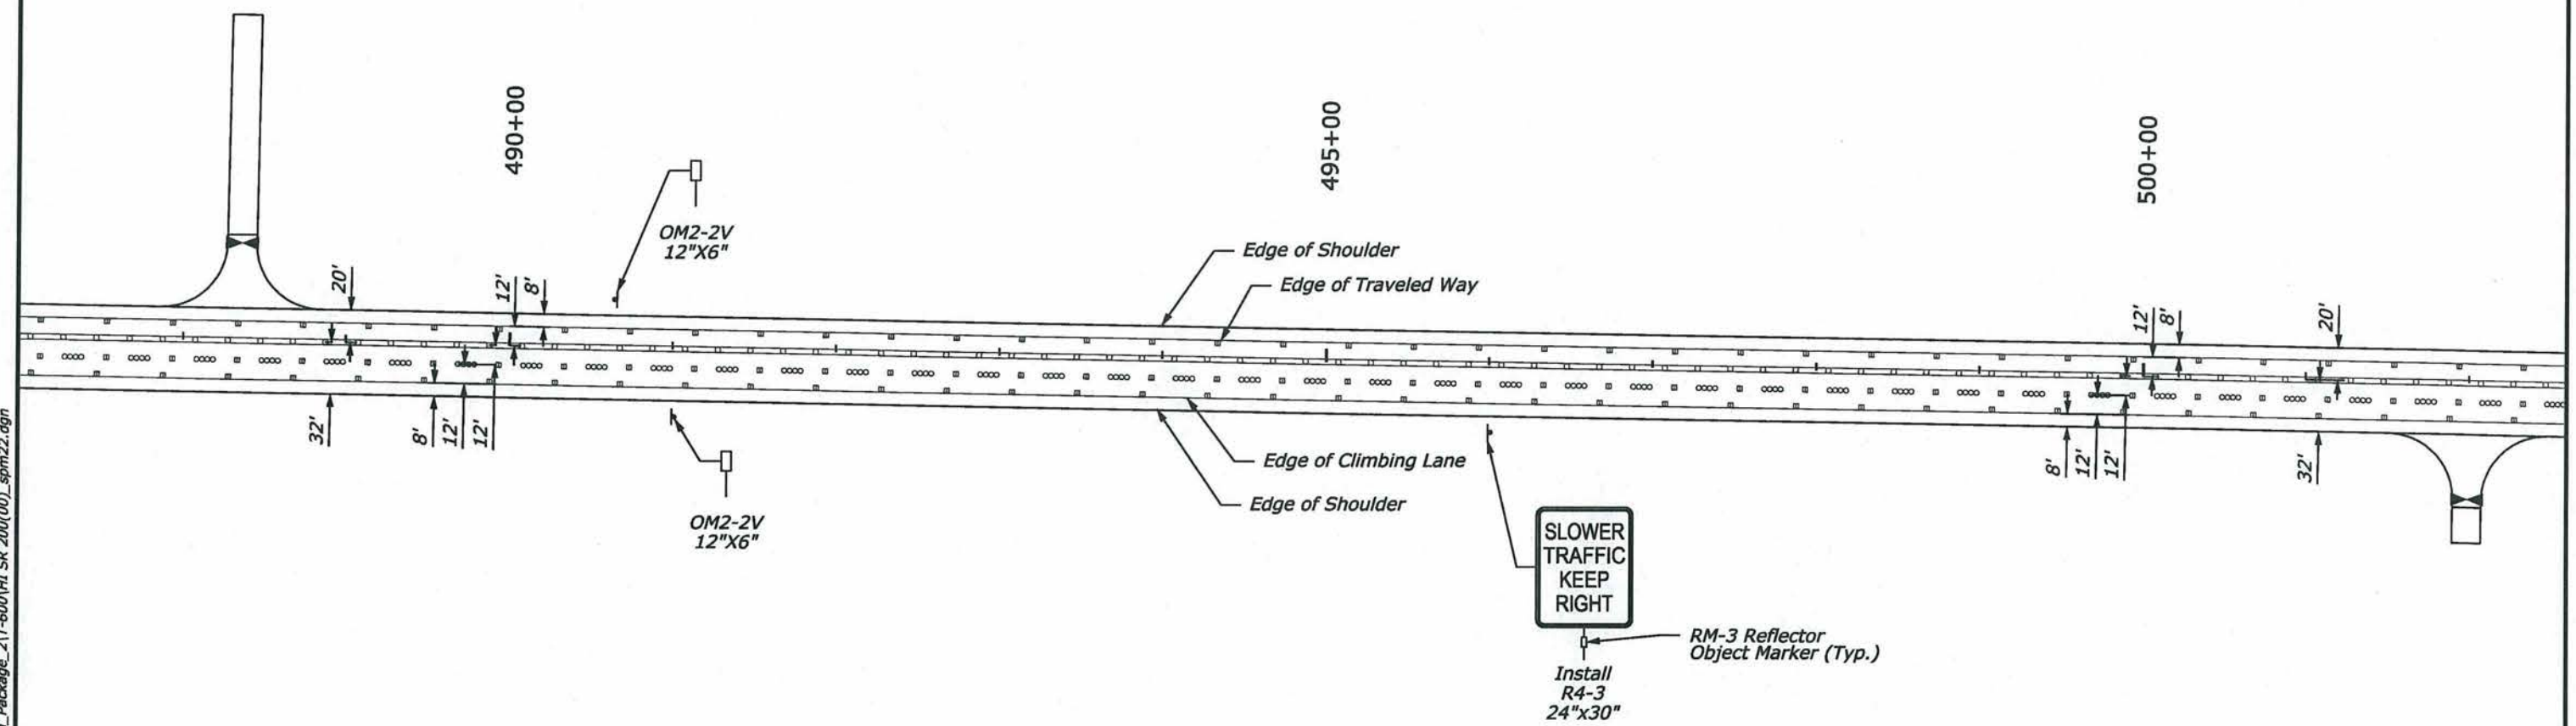

AS-BUILT DRAWINGS/SPECIFICATIONS
 This certifies that the dimensions and details shown on this sheet reflect the dimensions and details and specifications as constructed in the field.

GOODFELLOW BROS., INC.
 Contractor's Name:
 Signature
 1/2/14 Date




This work was prepared by me or under my supervision
Daniel A. Liddle
 Expiration Date of License 4/30/2014

U.S. DEPARTMENT OF TRANSPORTATION
 FEDERAL HIGHWAY ADMINISTRATION
 CENTRAL FEDERAL LANDS HIGHWAY DIVISION


**SADDLE ROAD
 SIGNING & STRIPING PLAN**

S:\Tranproj\100013746-SR\HwyDes\Sheets_Bid_Package_2\T-600\HI SR 200(00)_spm23.dgn 2:18:48 PM 3/24/2012

- 4" Double Yellow Center Stripe with Type D Markers
- 4" Double Yellow Median Stripe with Type H Markers
- 4" Yellow Center Stripe with Type D, H & J Markers
- Type A & C Markers
- 4" White Guide Line
- 4" White Line with Type A & C Markers
- 8" White Channelizing Line with Type C Markers
- 4" White Edge Line with Type C Markers
- Delineator

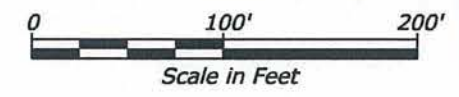


STATE	PROJECT	SHEET NO.	TOTAL SHEETS
HI	HI A-AD 6(7)	T31	T101

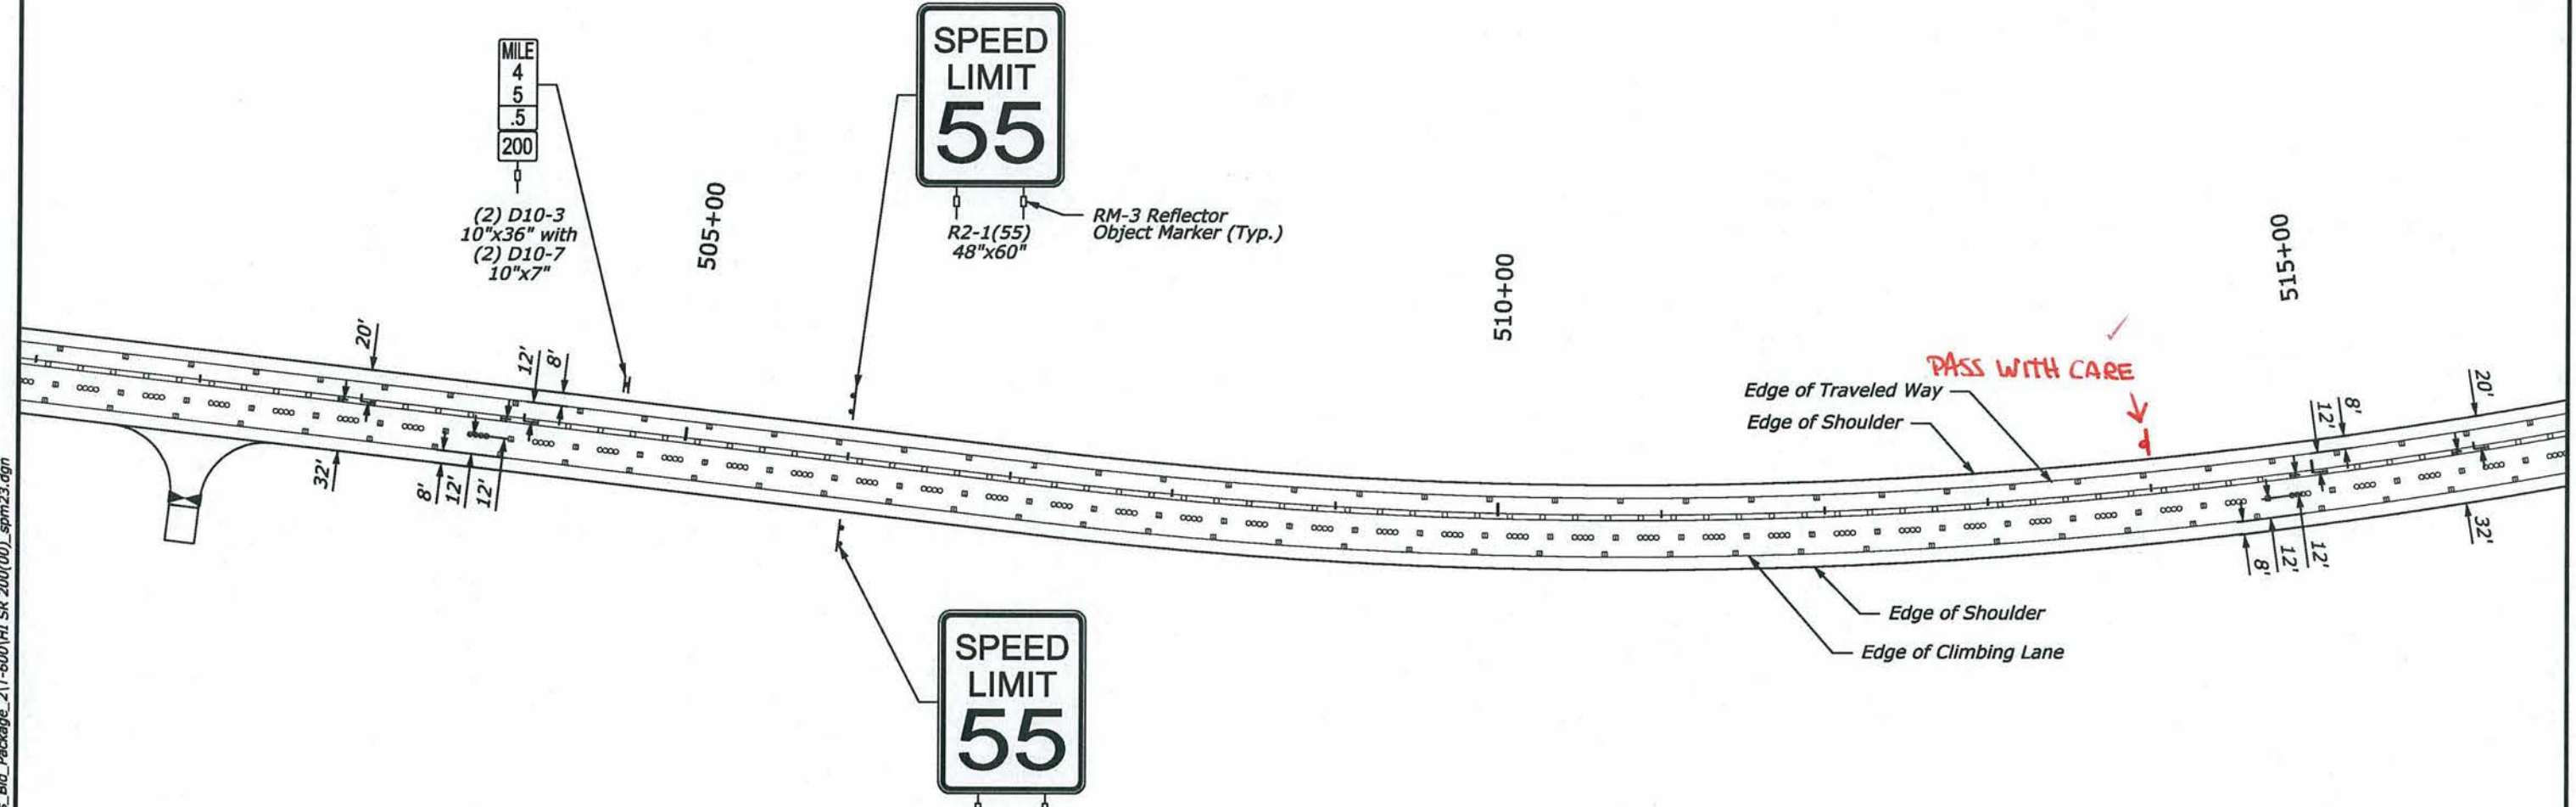

AS-BUILT DRAWINGS/SPECIFICATIONS
 This certifies that the dimensions and details shown on this sheet reflect the dimensions and details and specifications as constructed in the field.

GOODFELLOW BROS., INC.
 Contractor's Name:
Yun Han Signature 1/2/14 Date

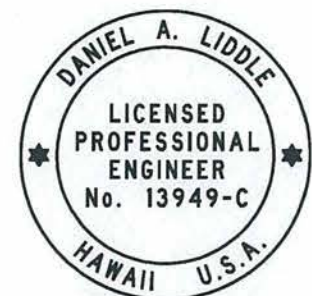



 


 



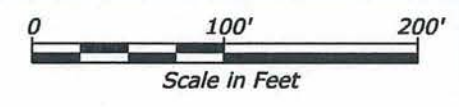
This work was prepared by me or under my supervision
Daniel A. Liddle
 Expiration Date of License 4/30/2014

U.S. DEPARTMENT OF TRANSPORTATION
 FEDERAL HIGHWAY ADMINISTRATION
 CENTRAL FEDERAL LANDS HIGHWAY DIVISION


**SADDLE ROAD
 SIGNING & STRIPING PLAN**

S:\Tranpro\100013746-SR\HwyDes\Road\Sheets_Bid_Package_2\T-600\HI SR 200(00)\HI SR 200(00)_spm24.dgn 3/24/2012 2:19:42 PM

-  4" Double Yellow Center Stripe with Type D Markers
-  4" Double Yellow Median Stripe with Type H Markers
-  4" Yellow Center Stripe with Type D, H & J Markers
-  Type A & C Markers
-  4" White Guide Line
-  4" White Line with Type A & C Markers
-  8" White Channelizing Line with Type C Markers
-  4" White Edge Line with Type C Markers
-  Delineator



STATE	PROJECT	SHEET NO.	TOTAL SHEETS
HI	HI A-AD 6(7)	T32	T101

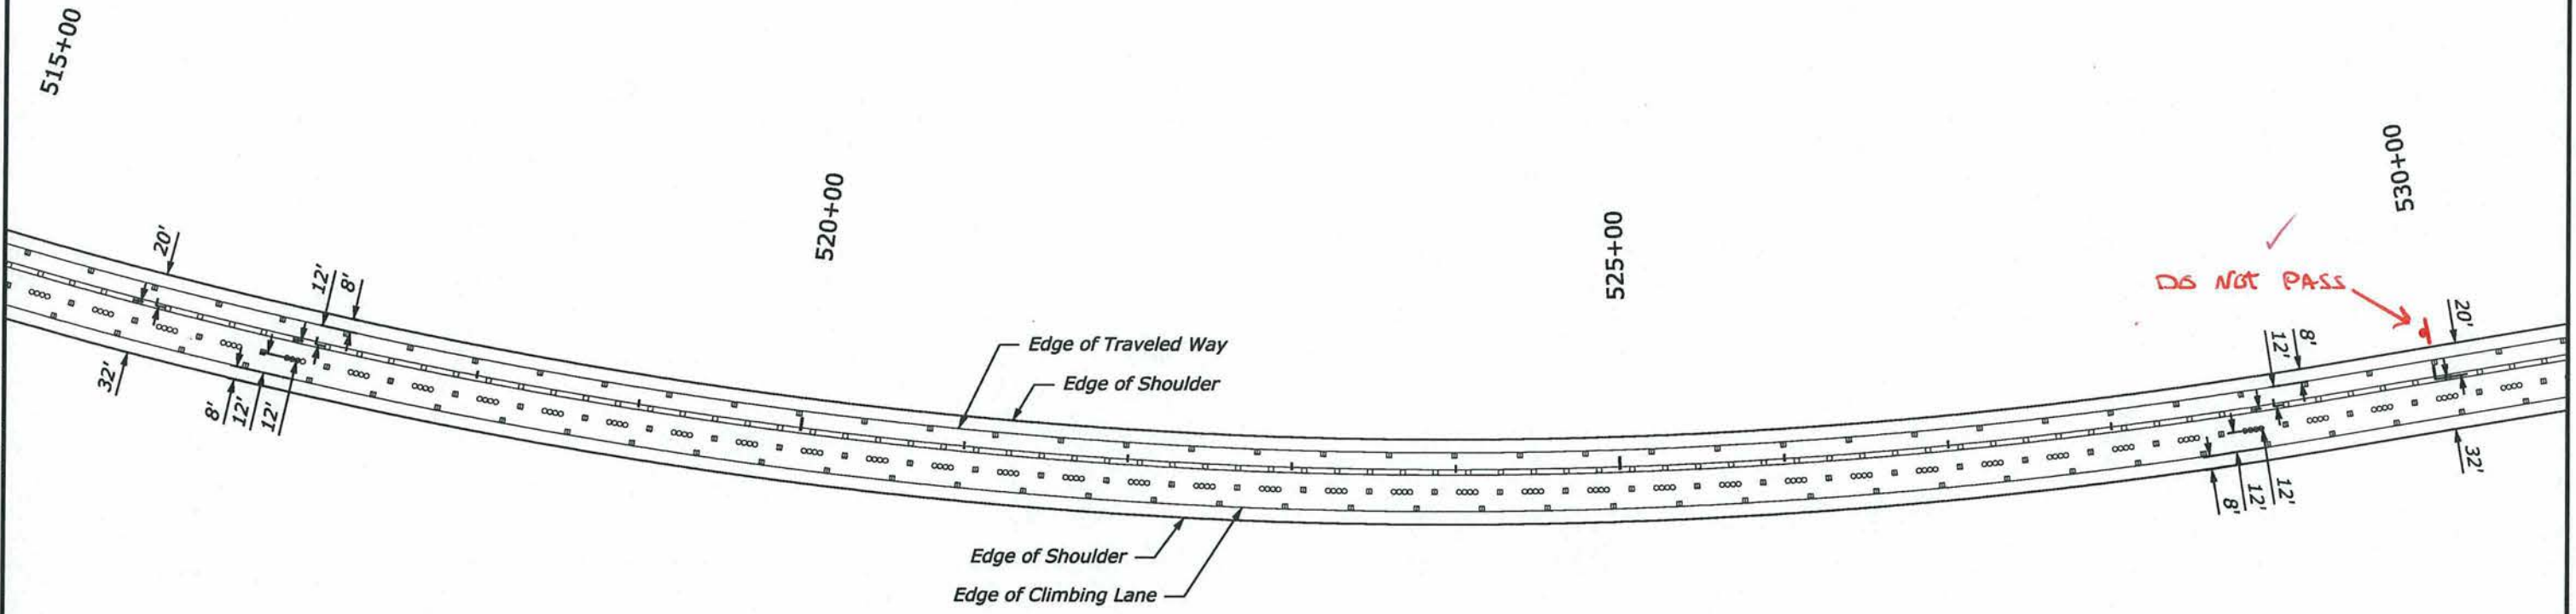

AS-BUILT DRAWINGS/SPECIFICATIONS
 This certifies that the dimensions and details shown on this sheet reflect the dimensions and details and specifications as constructed in the field.

GOODFELLOW BROS., INC.
 Contractor's Name:
[Signature] Signature 1/2/14 Date




This work was prepared by me or under my supervision
Daniel A. Liddle
 Expiration Date of License 4/30/2014


U.S. DEPARTMENT OF TRANSPORTATION
 FEDERAL HIGHWAY ADMINISTRATION
 CENTRAL FEDERAL LANDS HIGHWAY DIVISION

**SADDLE ROAD
 SIGNING & STRIPING PLAN**

- 4" Double Yellow Center Stripe with Type D Markers
- 4" Double Yellow Median Stripe with Type H Markers
- 4" Yellow Center Stripe with Type D, H & J Markers
- Type A & C Markers
- 4" White Guide Line
- 4" White Line with Type A & C Markers
- 8" White Channelizing Line with Type C Markers
- 4" White Edge Line with Type C Markers
- Delineator

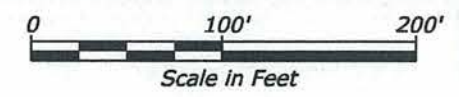


STATE	PROJECT	SHEET NO.	TOTAL SHEETS
HI	HI A-AD 6(7)	T33	T101

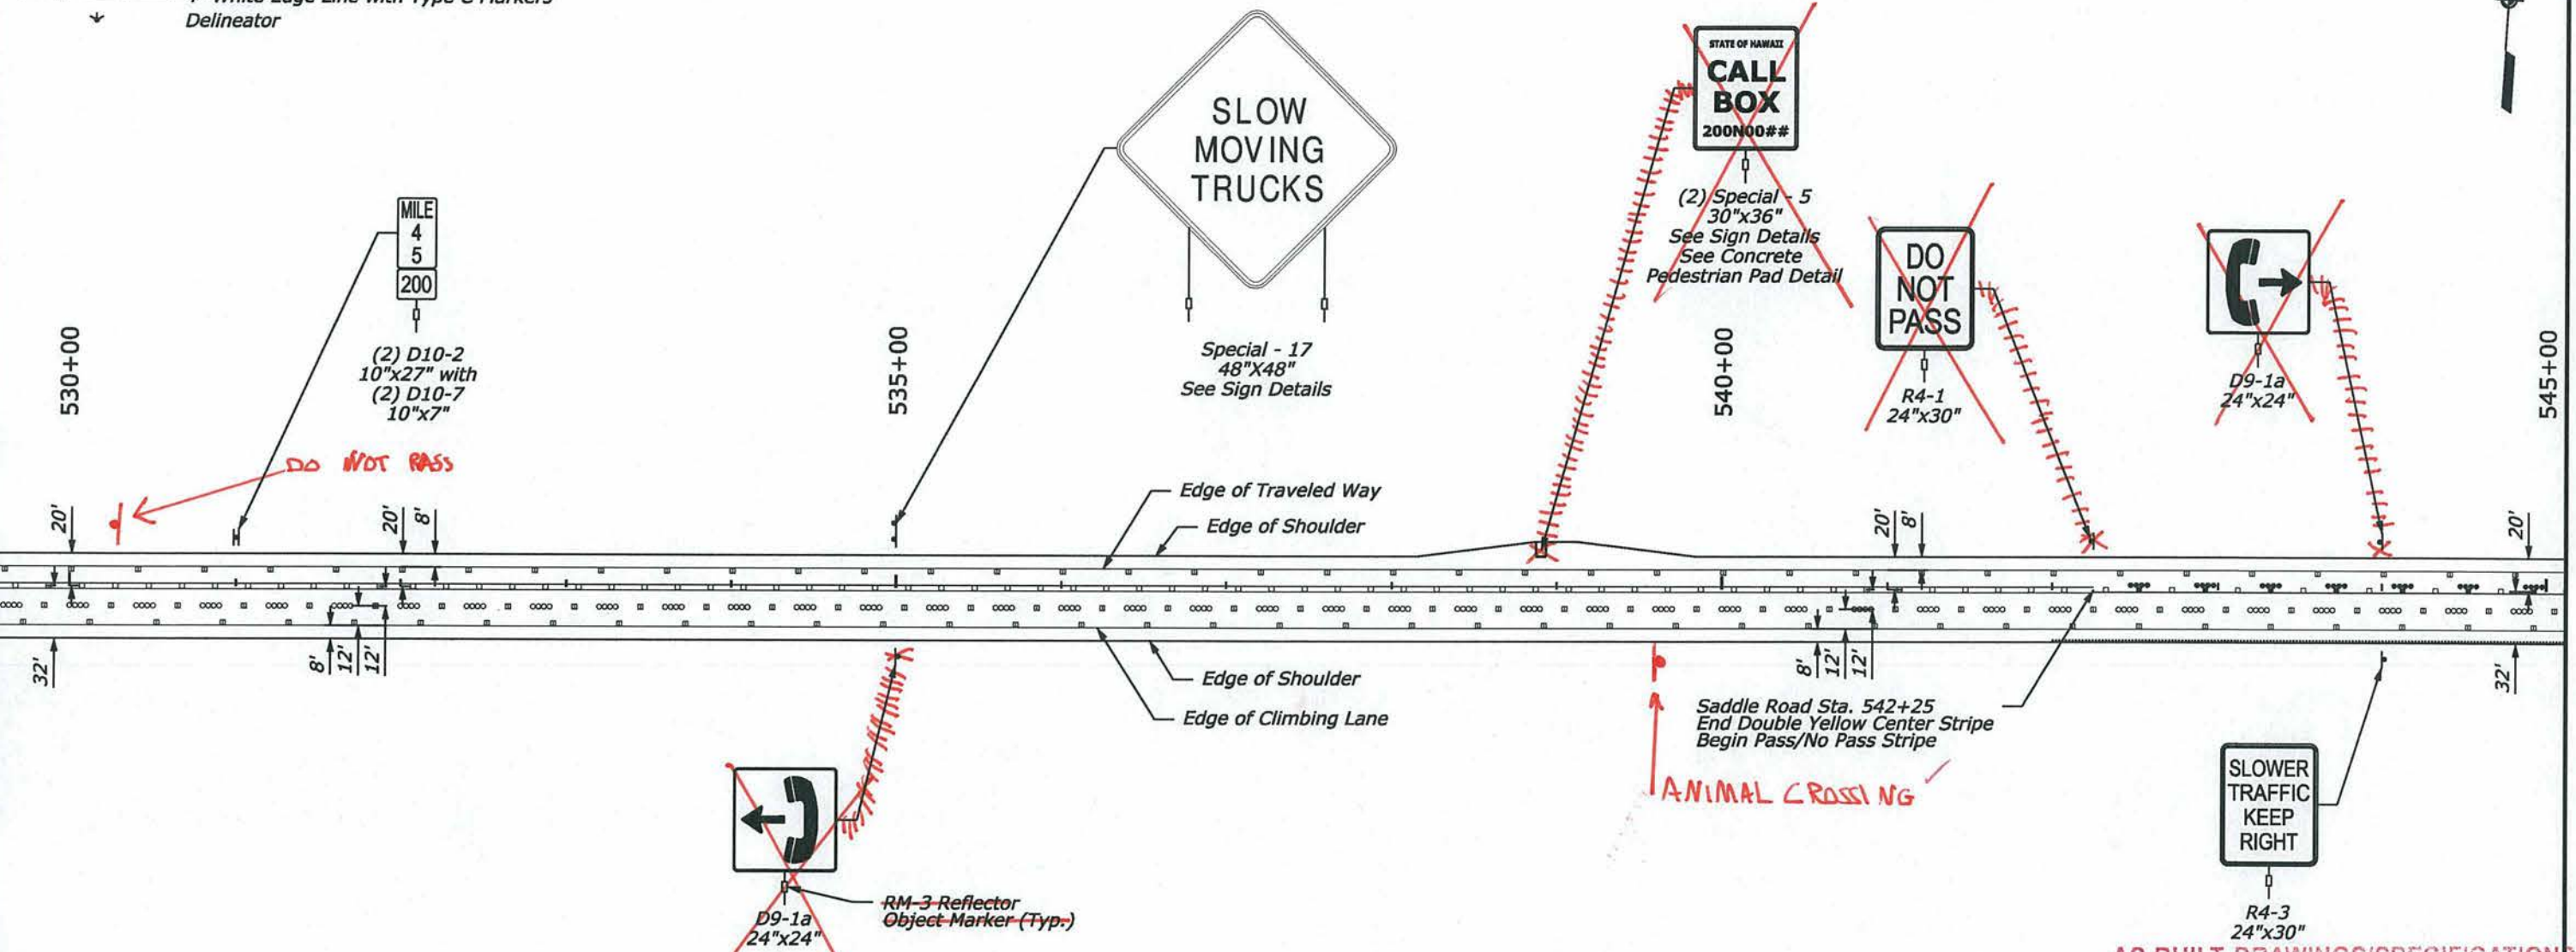

AS-BUILT DRAWINGS/SPECIFICATIONS
 This certifies that the dimensions and details shown on this sheet reflect the dimensions and details as constructed in the field.

GOODFELLOW BROS., INC.
 Contractor's Name:

[Signature] 1/2/14
 Signature Date

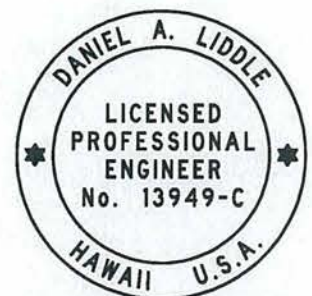




 





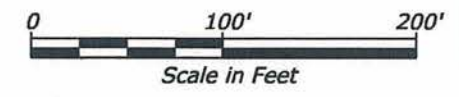
This work was prepared by me or under my supervision
Daniel A. Liddle
 Expiration Date of License 4/30/2014

U.S. DEPARTMENT OF TRANSPORTATION
 FEDERAL HIGHWAY ADMINISTRATION
 CENTRAL FEDERAL LANDS HIGHWAY DIVISION

**SADDLE ROAD
 SIGNING & STRIPING PLAN**

3/24/2012 2:21:05 PM S:\Tranpro\100013746-SR\HwyDes\Roadway\Sheets_Bid_Package_2\T-600\HI SR 200(00)_spm25.dgn


-  4" Double Yellow Center Stripe with Type D Markers
-  4" Double Yellow Median Stripe with Type H Markers
-  4" Yellow Center Stripe with Type D, H & J Markers
-  Type A & C Markers
-  4" White Guide Line
-  4" White Line with Type A & C Markers
-  8" White Channelizing Line with Type C Markers
-  4" White Edge Line with Type C Markers
-  Delineator



STATE	PROJECT	SHEET NO.	TOTAL SHEETS
HI	HI A-AD 6(7)	T34	T101



3/24/2012 2:22:14 PM S:\Tranpro\100013746-SR\HwyDes\Roadway\Sheets_Bid_Package_2\T-600\HI SR 200(00)_spm26.dgn

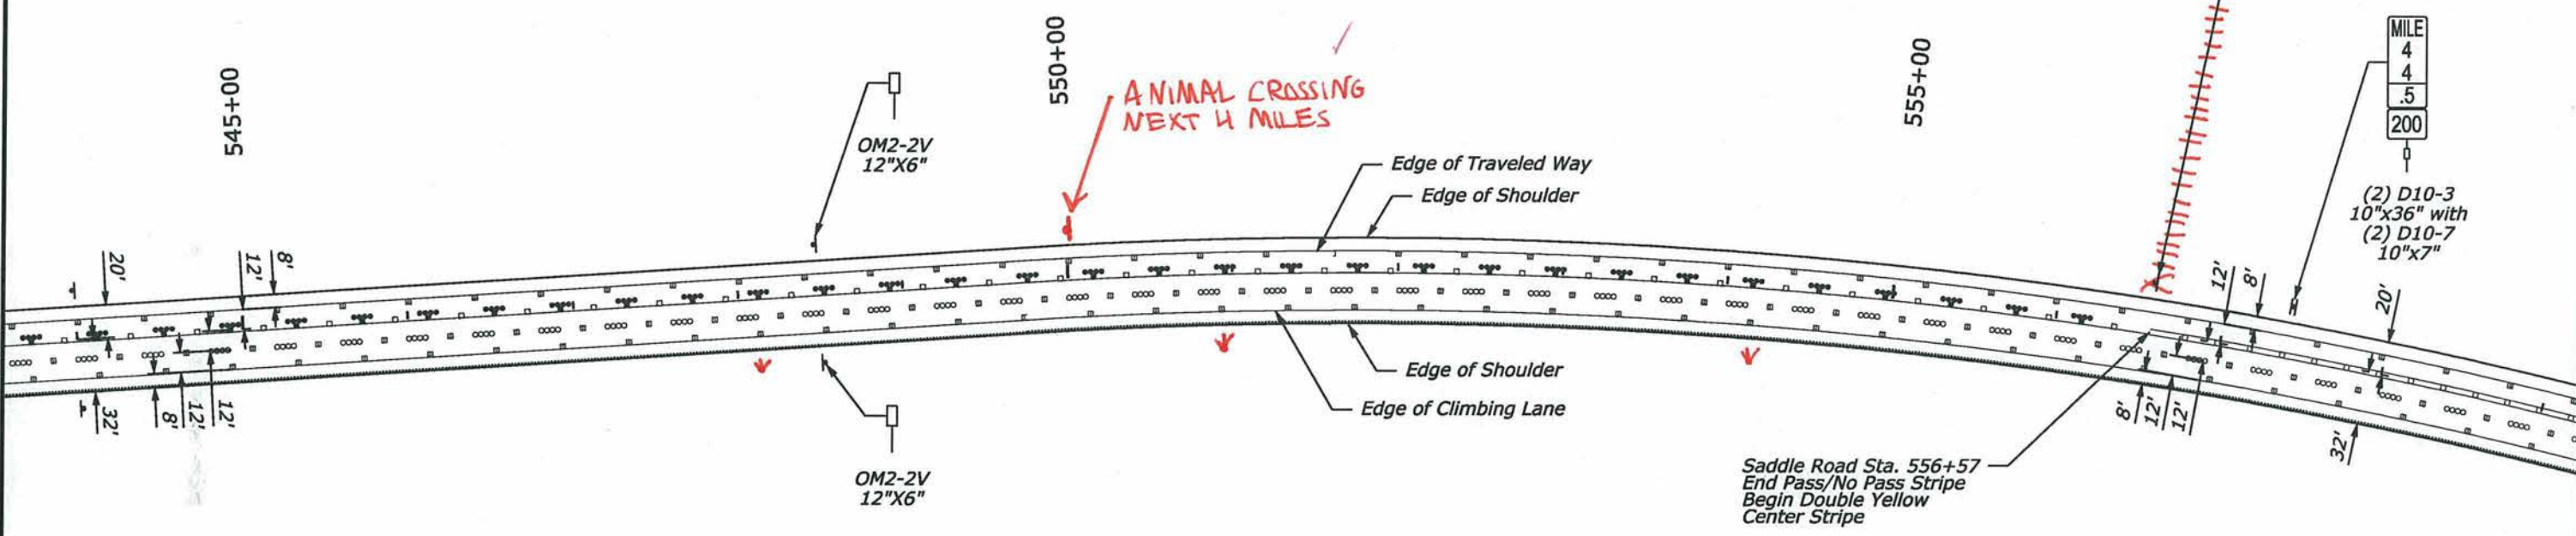

AS-BUILT DRAWINGS/SPECIFICATIONS
 This certifies that the dimensions and details shown on this sheet reflect the dimensions and details and specifications as constructed in the field.

GOODFELLOW BROS., INC.
 Contractor's Name:

[Signature] 1/2/14
 Signature Date




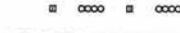
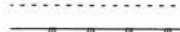







This work was prepared by me or under my supervision
Daniel A. Liddle
 Expiration Date of License 4/30/2014

U.S. DEPARTMENT OF TRANSPORTATION
 FEDERAL HIGHWAY ADMINISTRATION
 CENTRAL FEDERAL LANDS HIGHWAY DIVISION


**SADDLE ROAD
 SIGNING & STRIPING PLAN**

3/24/2012 2:23:23 PM S:\Tranpro\100013746-SR\HwyDes\rdwy\Sheets_Bid_Package_2\T-600\HI SR 200(00)_spm27.dgn

-  4" Double Yellow Center Stripe with Type D Markers
-  4" Double Yellow Median Stripe with Type H Markers
-  4" Yellow Center Stripe with Type D, H & J Markers
-  Type A & C Markers
-  4" White Guide Line
-  4" White Line with Type A & C Markers
-  8" White Channelizing Line with Type C Markers
-  4" White Edge Line with Type C Markers
-  Delineator

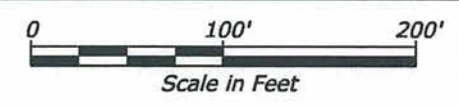


STATE	PROJECT	SHEET NO.	TOTAL SHEETS
HI	HI A-AD 6(7)	T35	T101

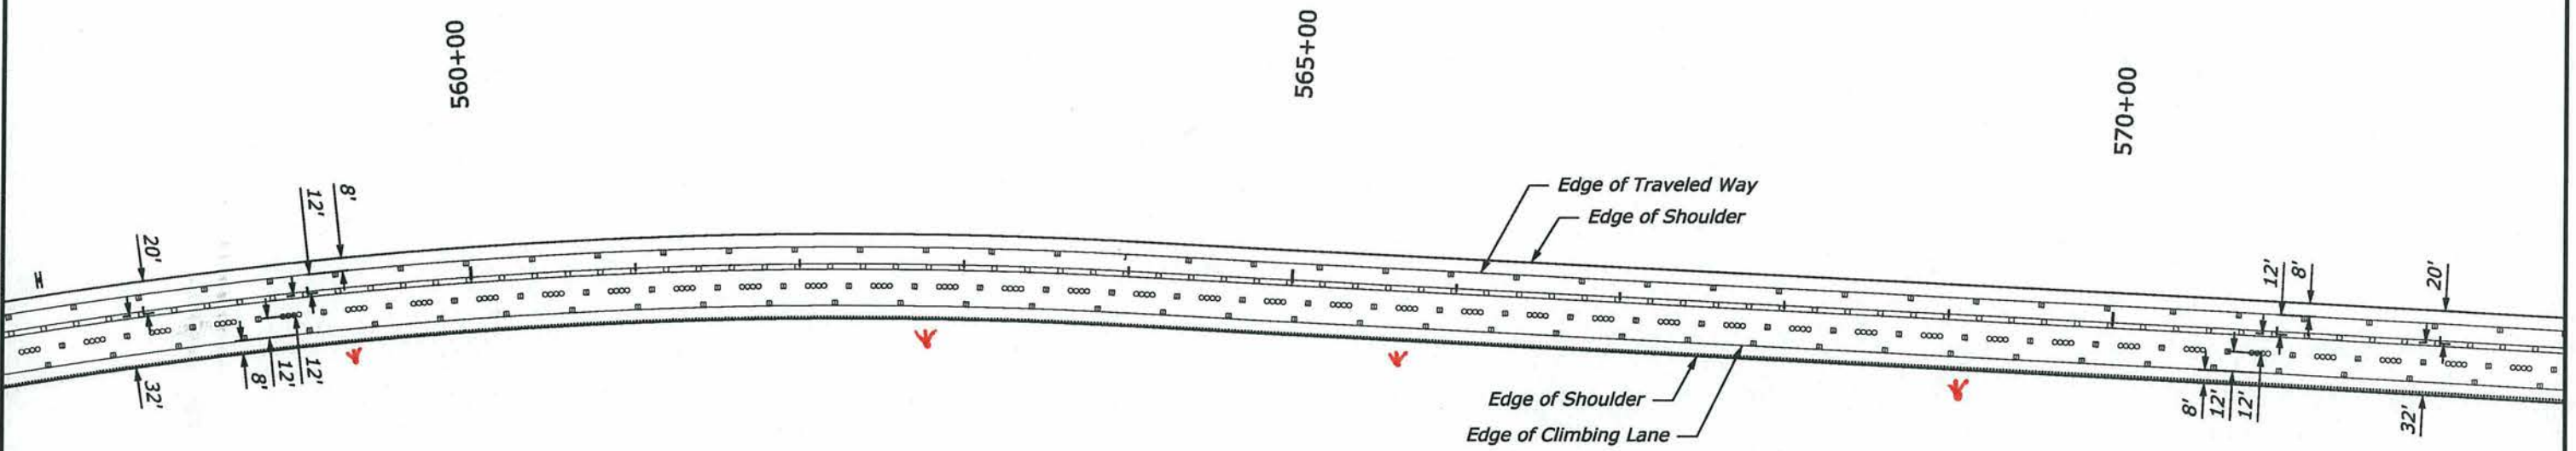

AS-BUILT DRAWINGS/SPECIFICATIONS
 This certifies that the dimensions and details shown on this sheet reflect the dimensions and details and specifications as constructed in the field.

GOODFELLOW BROS., INC.
 Contractor's Name:
Yun Han Signature 1/2/14 Date

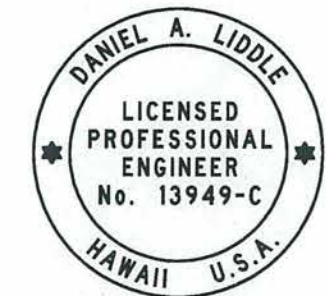


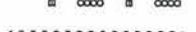
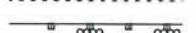
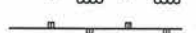





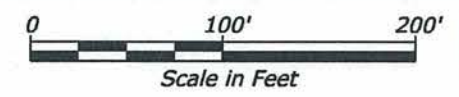
This work was prepared by me or under my supervision
Daniel A. Liddle
 Expiration Date of License 4/30/2014

U.S. DEPARTMENT OF TRANSPORTATION
 FEDERAL HIGHWAY ADMINISTRATION
 CENTRAL FEDERAL LANDS HIGHWAY DIVISION


**SADDLE ROAD
 SIGNING & STRIPING PLAN**

S:\Tranpro\100013746-SR\HwyDes\Sheets_Bid_Package_2\T-600\HI SR 200(00)_spm28.dgn
3/24/2012 2:24:21 PM

-  4" Double Yellow Center Stripe with Type D Markers
-  4" Double Yellow Median Stripe with Type H Markers
-  4" Yellow Center Stripe with Type D, H & J Markers
-  Type A & C Markers
-  4" White Guide Line
-  4" White Line with Type A & C Markers
-  8" White Channelizing Line with Type C Markers
-  4" White Edge Line with Type C Markers
-  Delineator




STATE	PROJECT	SHEET NO.	TOTAL SHEETS
HI	HI A-AD 6(7)	T36	T101

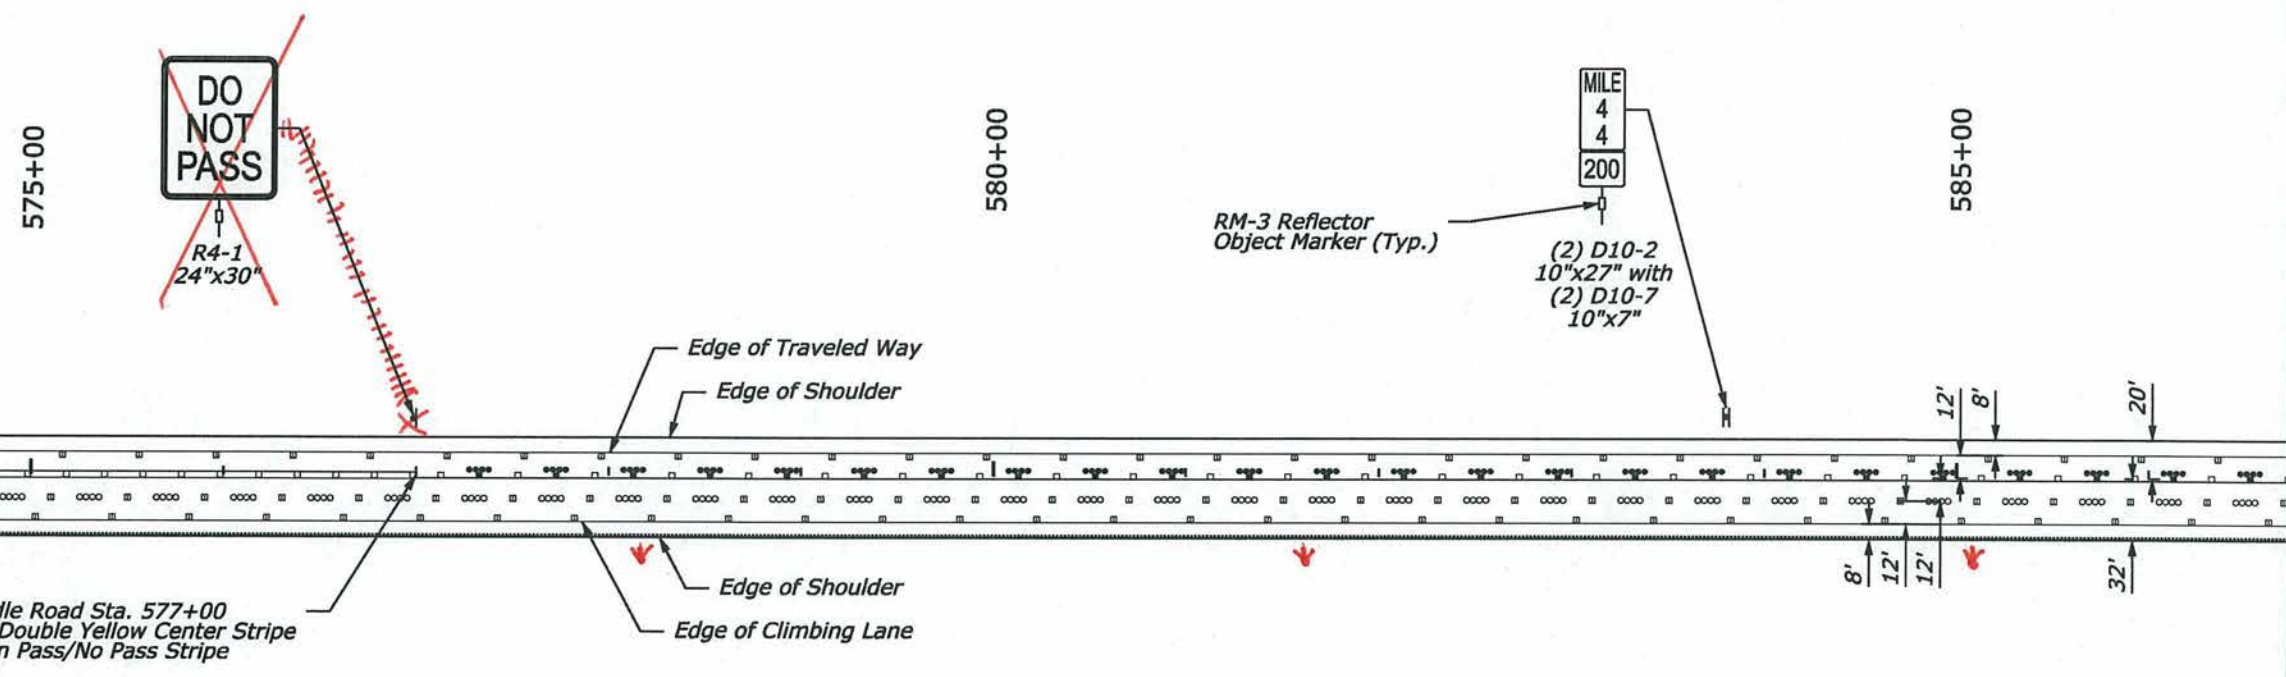

AS-BUILT DRAWINGS/SPECIFICATIONS
 This certifies that the dimensions and details shown on this sheet reflect the dimensions and details and specifications as constructed in the field.

GOODFELLOW BROS., INC.
 Contractor's Name:

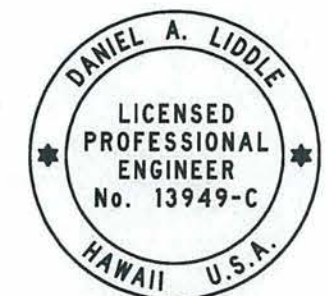


 





[Signature] 1/2/14
 Signature Date




This work was prepared by me or under my supervision
Daniel A. Liddle
 Expiration Date of License 4/30/2014

U.S. DEPARTMENT OF TRANSPORTATION
 FEDERAL HIGHWAY ADMINISTRATION
 CENTRAL FEDERAL LANDS HIGHWAY DIVISION

**SADDLE ROAD
 SIGNING & STRIPING PLAN**

-  4" Double Yellow Center Stripe with Type D Markers
-  4" Double Yellow Median Stripe with Type H Markers
-  4" Yellow Center Stripe with Type D, H & J Markers
-  Type A & C Markers
-  4" White Guide Line
-  4" White Line with Type A & C Markers
-  8" White Channelizing Line with Type C Markers
-  4" White Edge Line with Type C Markers
-  Delineator

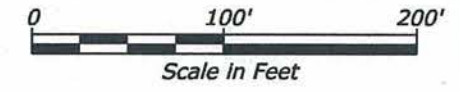


STATE	PROJECT	SHEET NO.	TOTAL SHEETS
HI	HI A-AD 6(7)	T37	T101



590+00

595+00

00+009

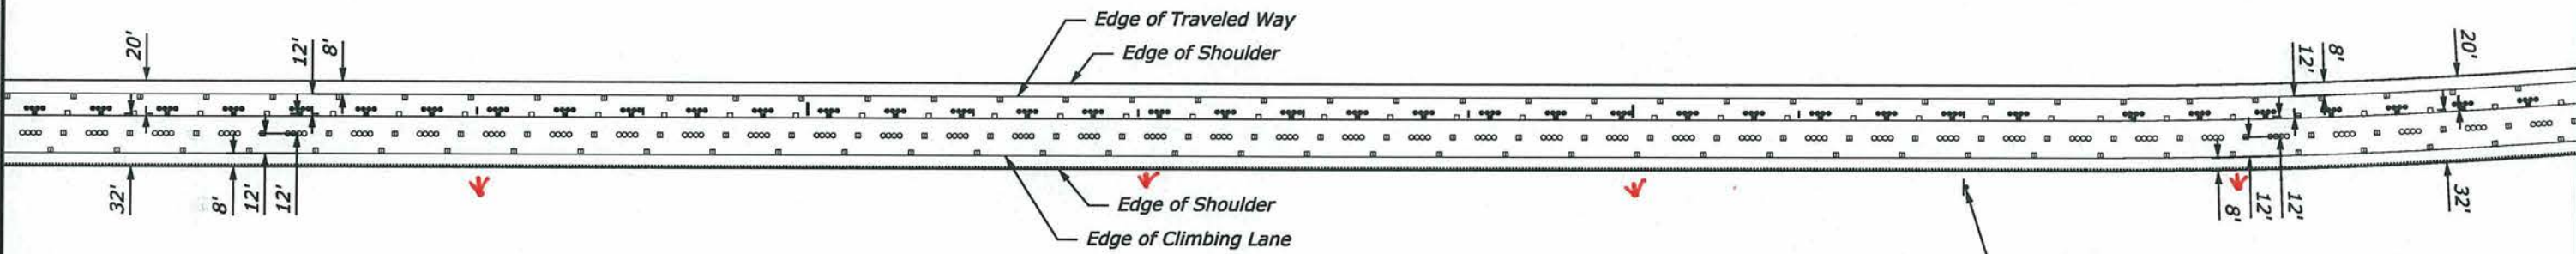


SLOWER
TRAFFIC
KEEP
RIGHT

RM-3 Reflector
R4-3 Object Marker (Typ.)
24"x30"

AS-BUILT SPECIFICATIONS
This certifies that the dimensions and details shown on this sheet reflect the dimensions and details and specifications as constructed in the field.

GOODFELLOW BROS., INC.
Contractor's Name:

[Signature]
Signature
1/2/14
Date

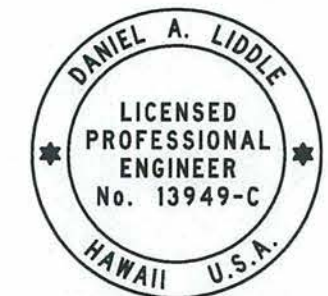










This work was prepared by me
or under my supervision
Daniel A. Liddle
Expiration Date of License 4/30/2014


U.S. DEPARTMENT OF TRANSPORTATION
FEDERAL HIGHWAY ADMINISTRATION
CENTRAL FEDERAL LANDS HIGHWAY DIVISION

**SADDLE ROAD
SIGNING & STRIPING PLAN**

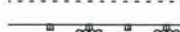
3/24/2012 2:25:17 PM S:\Tranproj\100013746-SR\HwyDes\Roadway\Sheets_Bid_Package_2\T-600\HI SR 200(00)_spm29.dgn

3/24/2012 2:26:16 PM S:\Tranpro\100013746-SR\HwyDes\Roadway\Sheets_Bld_Package_21T-600\HI SR 200(00)_spsm30.dgn

-  4" Double Yellow Center Stripe with Type D Markers
-  4" Double Yellow Median Stripe with Type H Markers
-  4" Yellow Center Stripe with Type D, H & J Markers
-  Type A & C Markers
-  4" White Guide Line
-  4" White Line with Type A & C Markers
-  8" White Channelizing Line with Type C Markers
-  4" White Edge Line with Type C Markers
-  Delineator

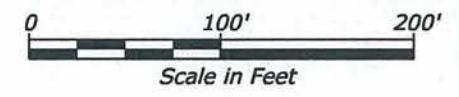


STATE	PROJECT	SHEET NO.	TOTAL SHEETS
HI	HI A-AD 6(7)	T38	T101

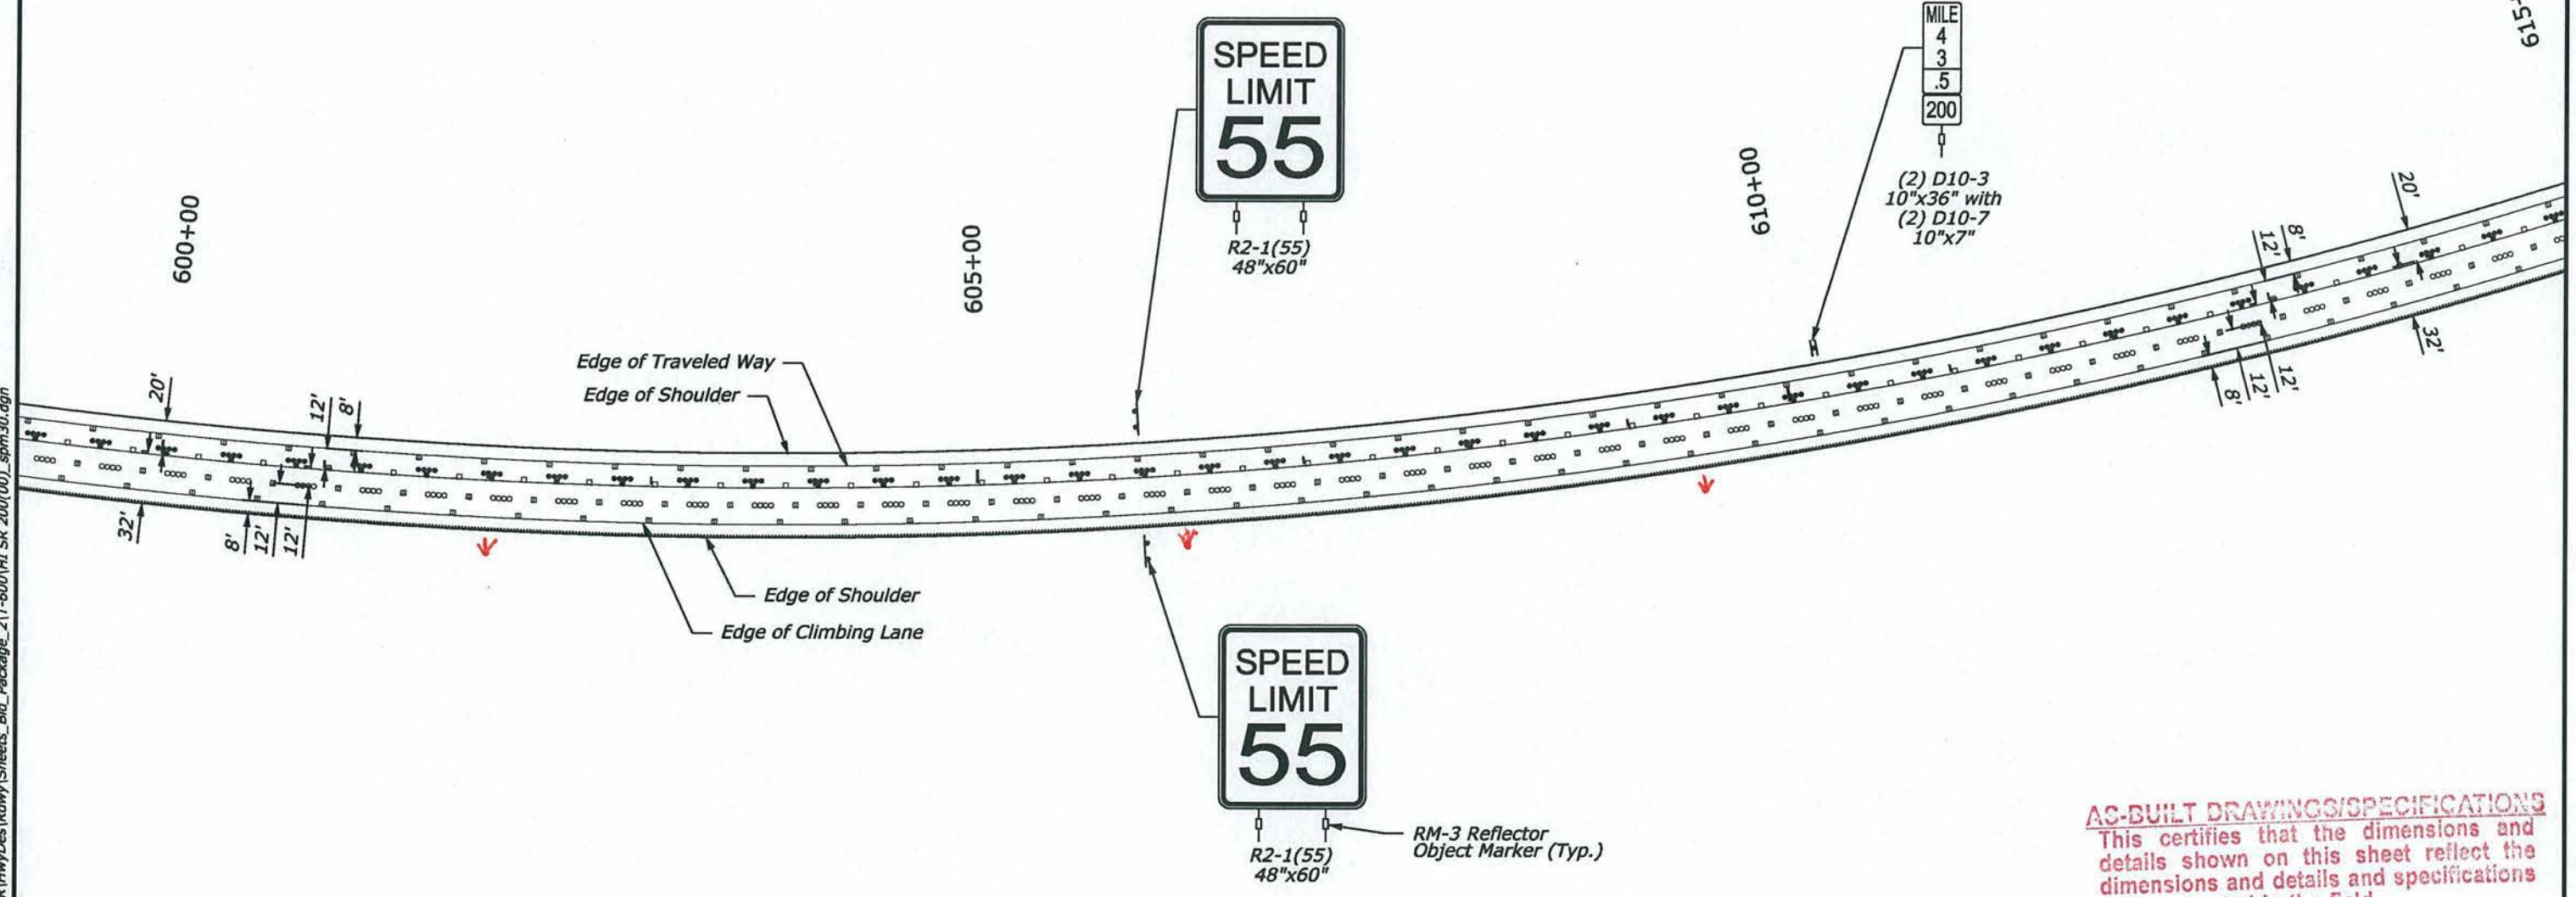

AS-BUILT DRAWINGS/SPECIFICATIONS
 This certifies that the dimensions and details shown on this sheet reflect the dimensions and details and specifications as constructed in the field.



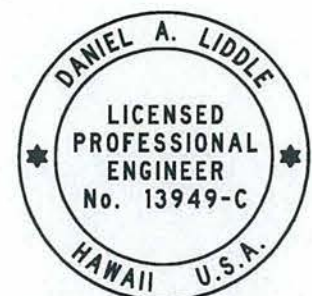






GOODFELLOW BROS., INC.
 Contractor's Name:
[Signature] 1/2/14
 Signature Date




This work was prepared by me or under my supervision
Daniel A. Liddle
 Expiration Date of License 4/30/2014


U.S. DEPARTMENT OF TRANSPORTATION
 FEDERAL HIGHWAY ADMINISTRATION
 CENTRAL FEDERAL LANDS HIGHWAY DIVISION

**SADDLE ROAD
 SIGNING & STRIPING PLAN**

-  4" Double Yellow Center Stripe with Type D Markers
-  4" Double Yellow Median Stripe with Type H Markers
-  4" Yellow Center Stripe with Type D, H & J Markers
-  Type A & C Markers
-  4" White Guide Line
-  4" White Line with Type A & C Markers
-  8" White Channelizing Line with Type C Markers
-  4" White Edge Line with Type C Markers
-  Delineator

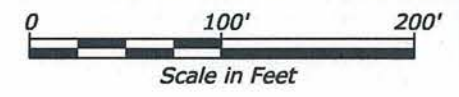

STATE	PROJECT	SHEET NO.	TOTAL SHEETS
HI	HI A-AD 6(7)	T39	T101

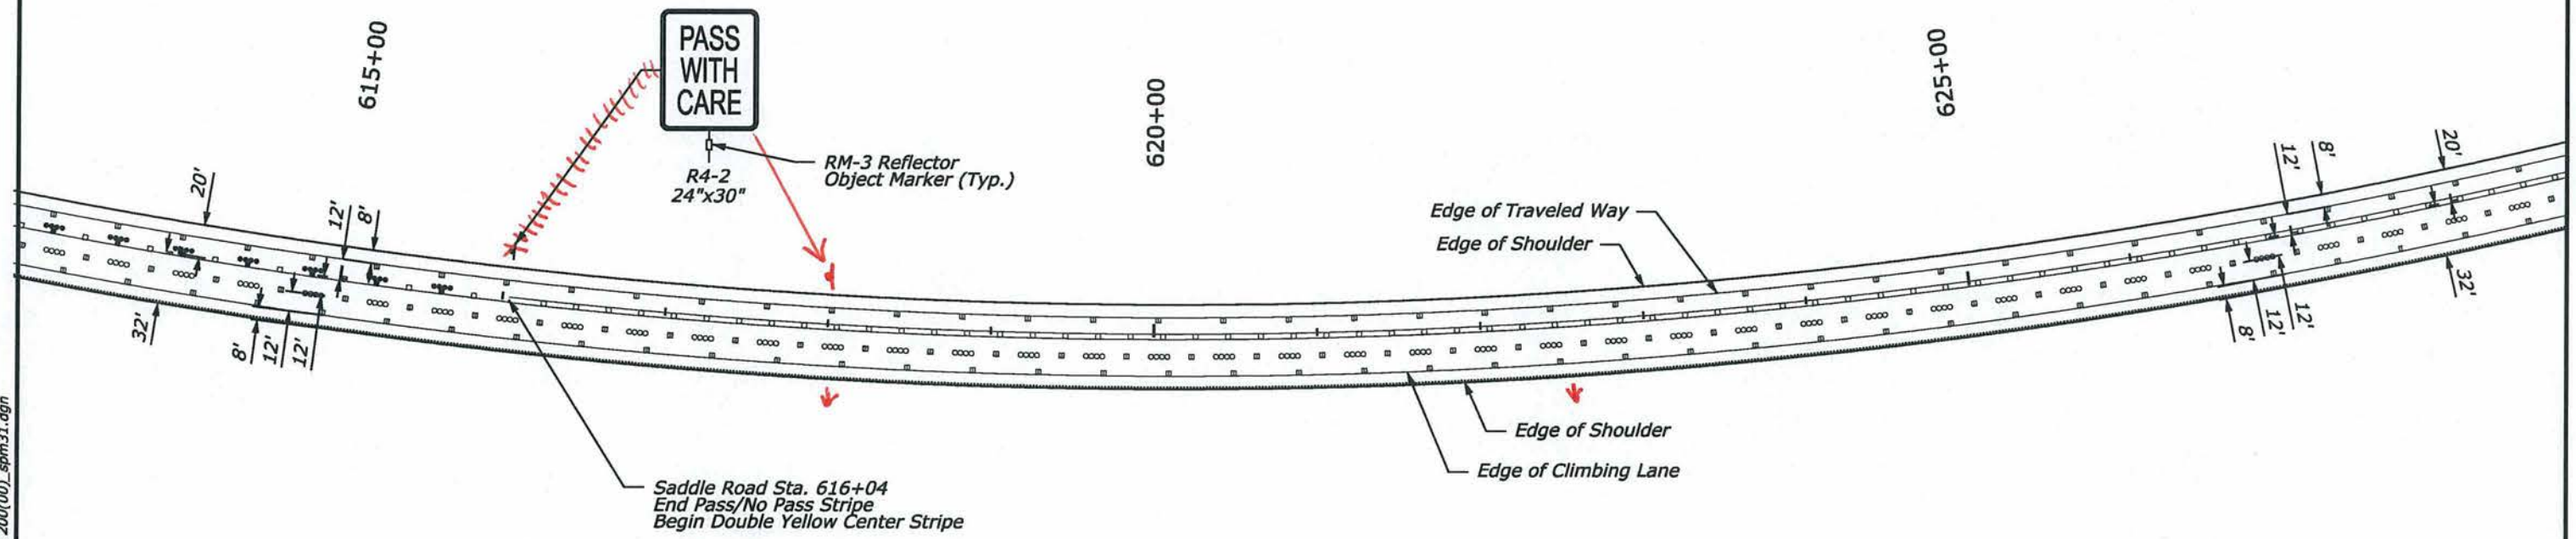


S:\Tranproj\100013746-SR\HwyDes\Roadwy\Sheets_Bid_Package_2\T-600\HI SR 200(00)_spsm31.dgn 2:27:18 PM 3/24/2012

AS-BUILT DRAWINGS/SPECIFICATIONS
 This certifies that the dimensions and details shown on this sheet reflect the dimensions and details and specifications as constructed in the field.



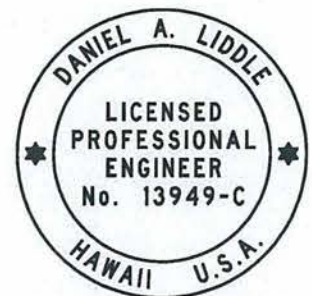


 



GOODFELLOW BROS., INC.
 Contractor's Name:


[Signature] 1/2/14
 U.S. DEPARTMENT OF TRANSPORTATION
 FEDERAL HIGHWAY ADMINISTRATION
 CENTRAL FEDERAL LANDS HIGHWAY DIVISION





This work was prepared by me or under my supervision
Daniel A. Liddle
 Expiration Date of License 4/30/2014

**SADDLE ROAD
 SIGNING & STRIPING PLAN**

-  4" Double Yellow Center Stripe with Type D Markers
-  4" Double Yellow Median Stripe with Type H Markers
-  4" Yellow Center Stripe with Type D, H & J Markers
-  Type A & C Markers
-  4" White Guide Line
-  4" White Line with Type A & C Markers
-  8" White Channelizing Line with Type C Markers
-  4" White Edge Line with Type C Markers
-  Delineator

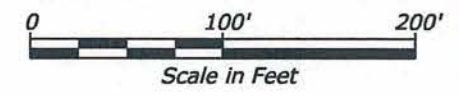


STATE	PROJECT	SHEET NO.	TOTAL SHEETS
HI	HI A-AD 6(7)	T40	T101

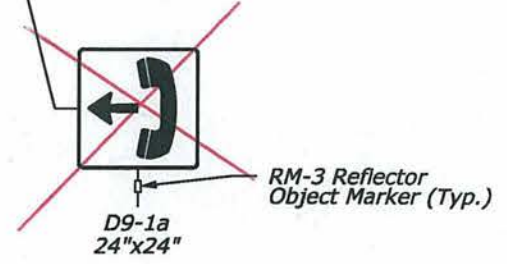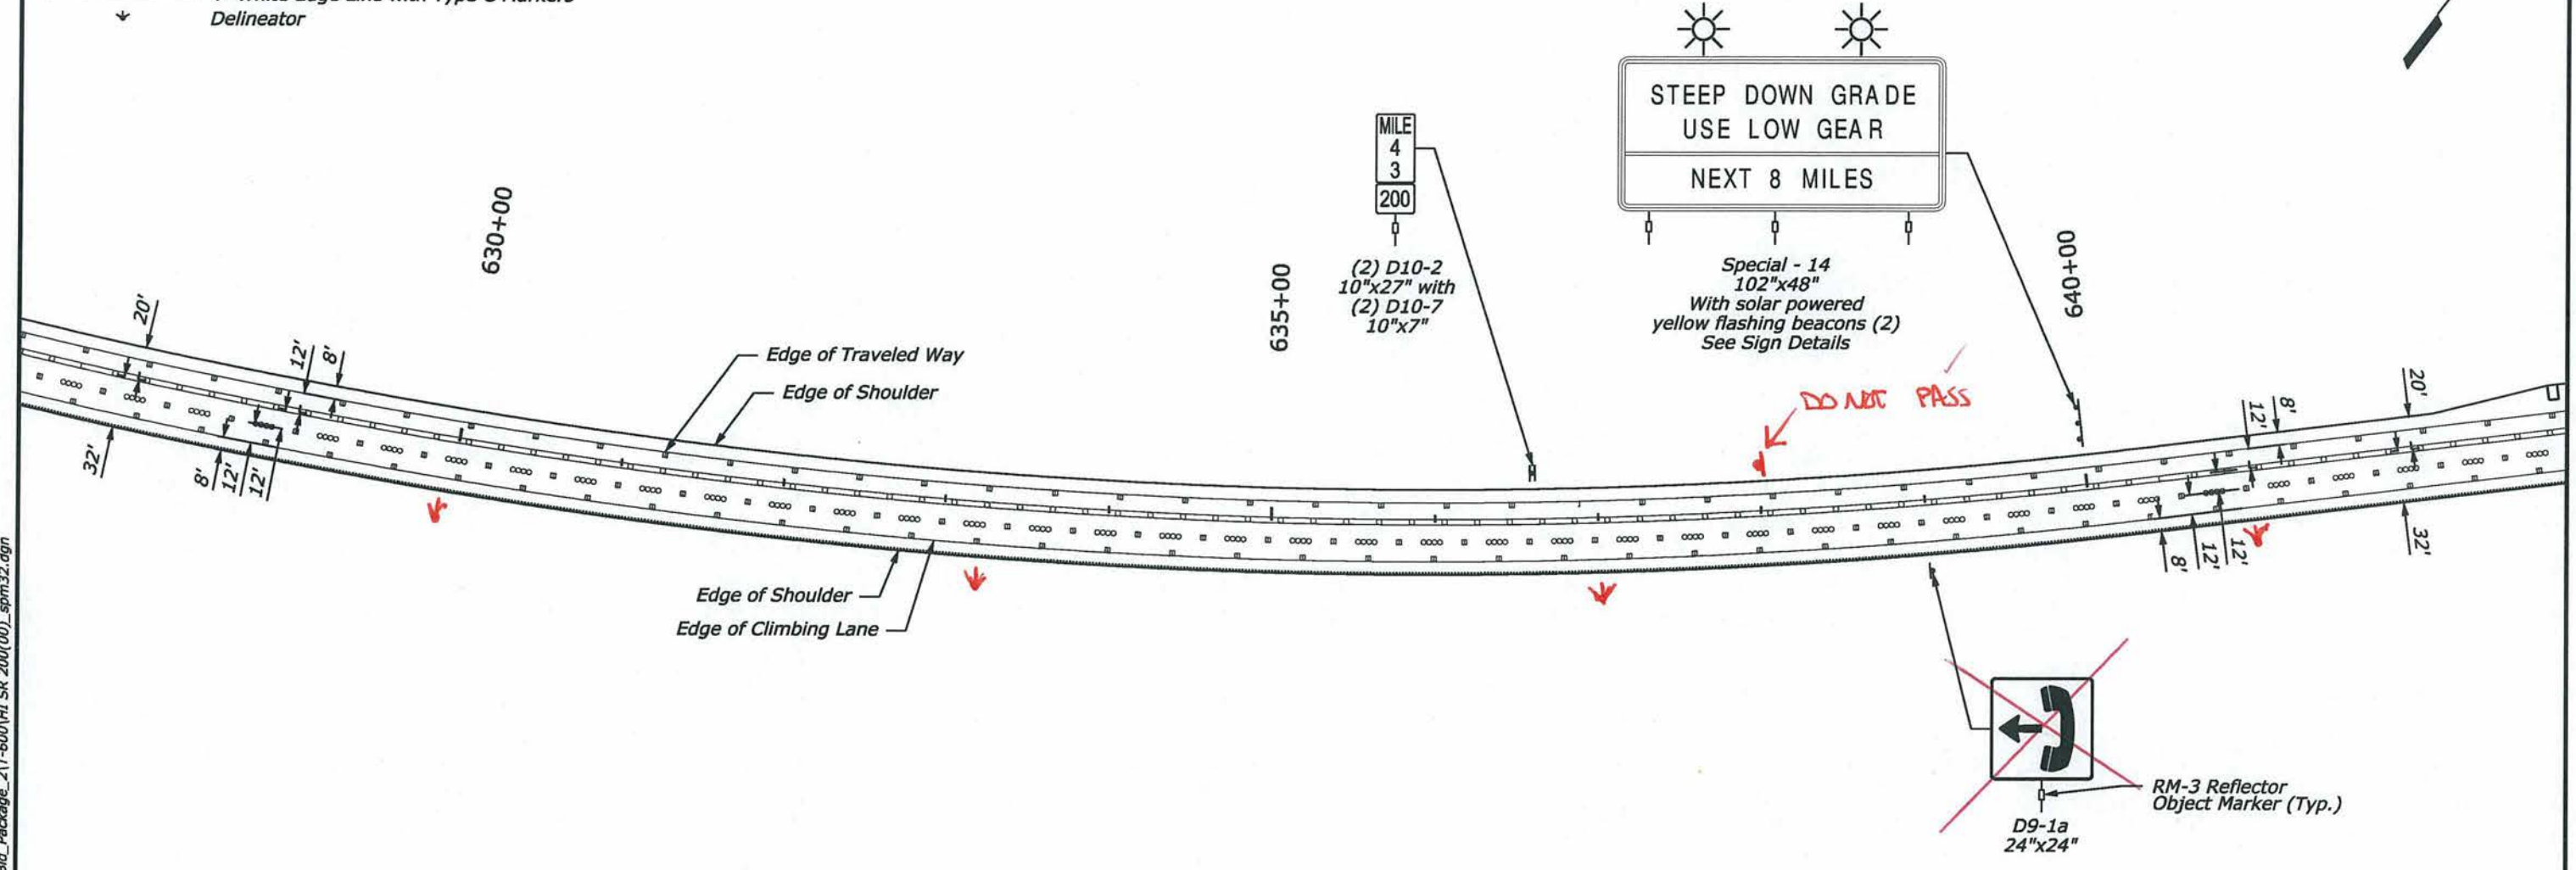

AS-BUILT DRAWINGS/SPECIFICATIONS
 This certifies that the dimensions and details shown on this sheet reflect the dimensions and details and specifications as constructed in the field.

GOODFELLOW BROS., INC.
 Contractor's Name:
[Signature] 1/2/14
 Signature Date

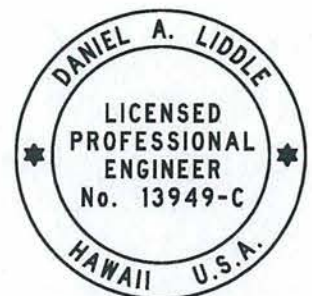


This work was prepared by me or under my supervision
Daniel A. Liddle
 Expiration Date of License 4/30/2014

U.S. DEPARTMENT OF TRANSPORTATION
 FEDERAL HIGHWAY ADMINISTRATION
 CENTRAL FEDERAL LANDS HIGHWAY DIVISION


**SADDLE ROAD
 SIGNING & STRIPING PLAN**

3/24/2012 2:28:19 PM S:\Tranproj\100013746-SR\HwyDes\Roadway\Sheets_Bid_Package_2\T-600\HI SR 200(00)_spm32.dgn

- 4" Double Yellow Center Stripe with Type D Markers
- 4" Double Yellow Median Stripe with Type H Markers
- 4" Yellow Center Stripe with Type D, H & J Markers
- Type A & C Markers
- 4" White Guide Line
- 4" White Line with Type A & C Markers
- 8" White Channelizing Line with Type C Markers
- 4" White Edge Line with Type C Markers
- Delineator

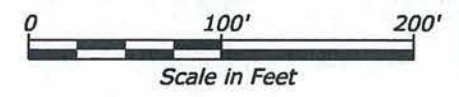


STATE	PROJECT	SHEET NO.	TOTAL SHEETS
HI	HI A-AD 6(7)	T41	T101

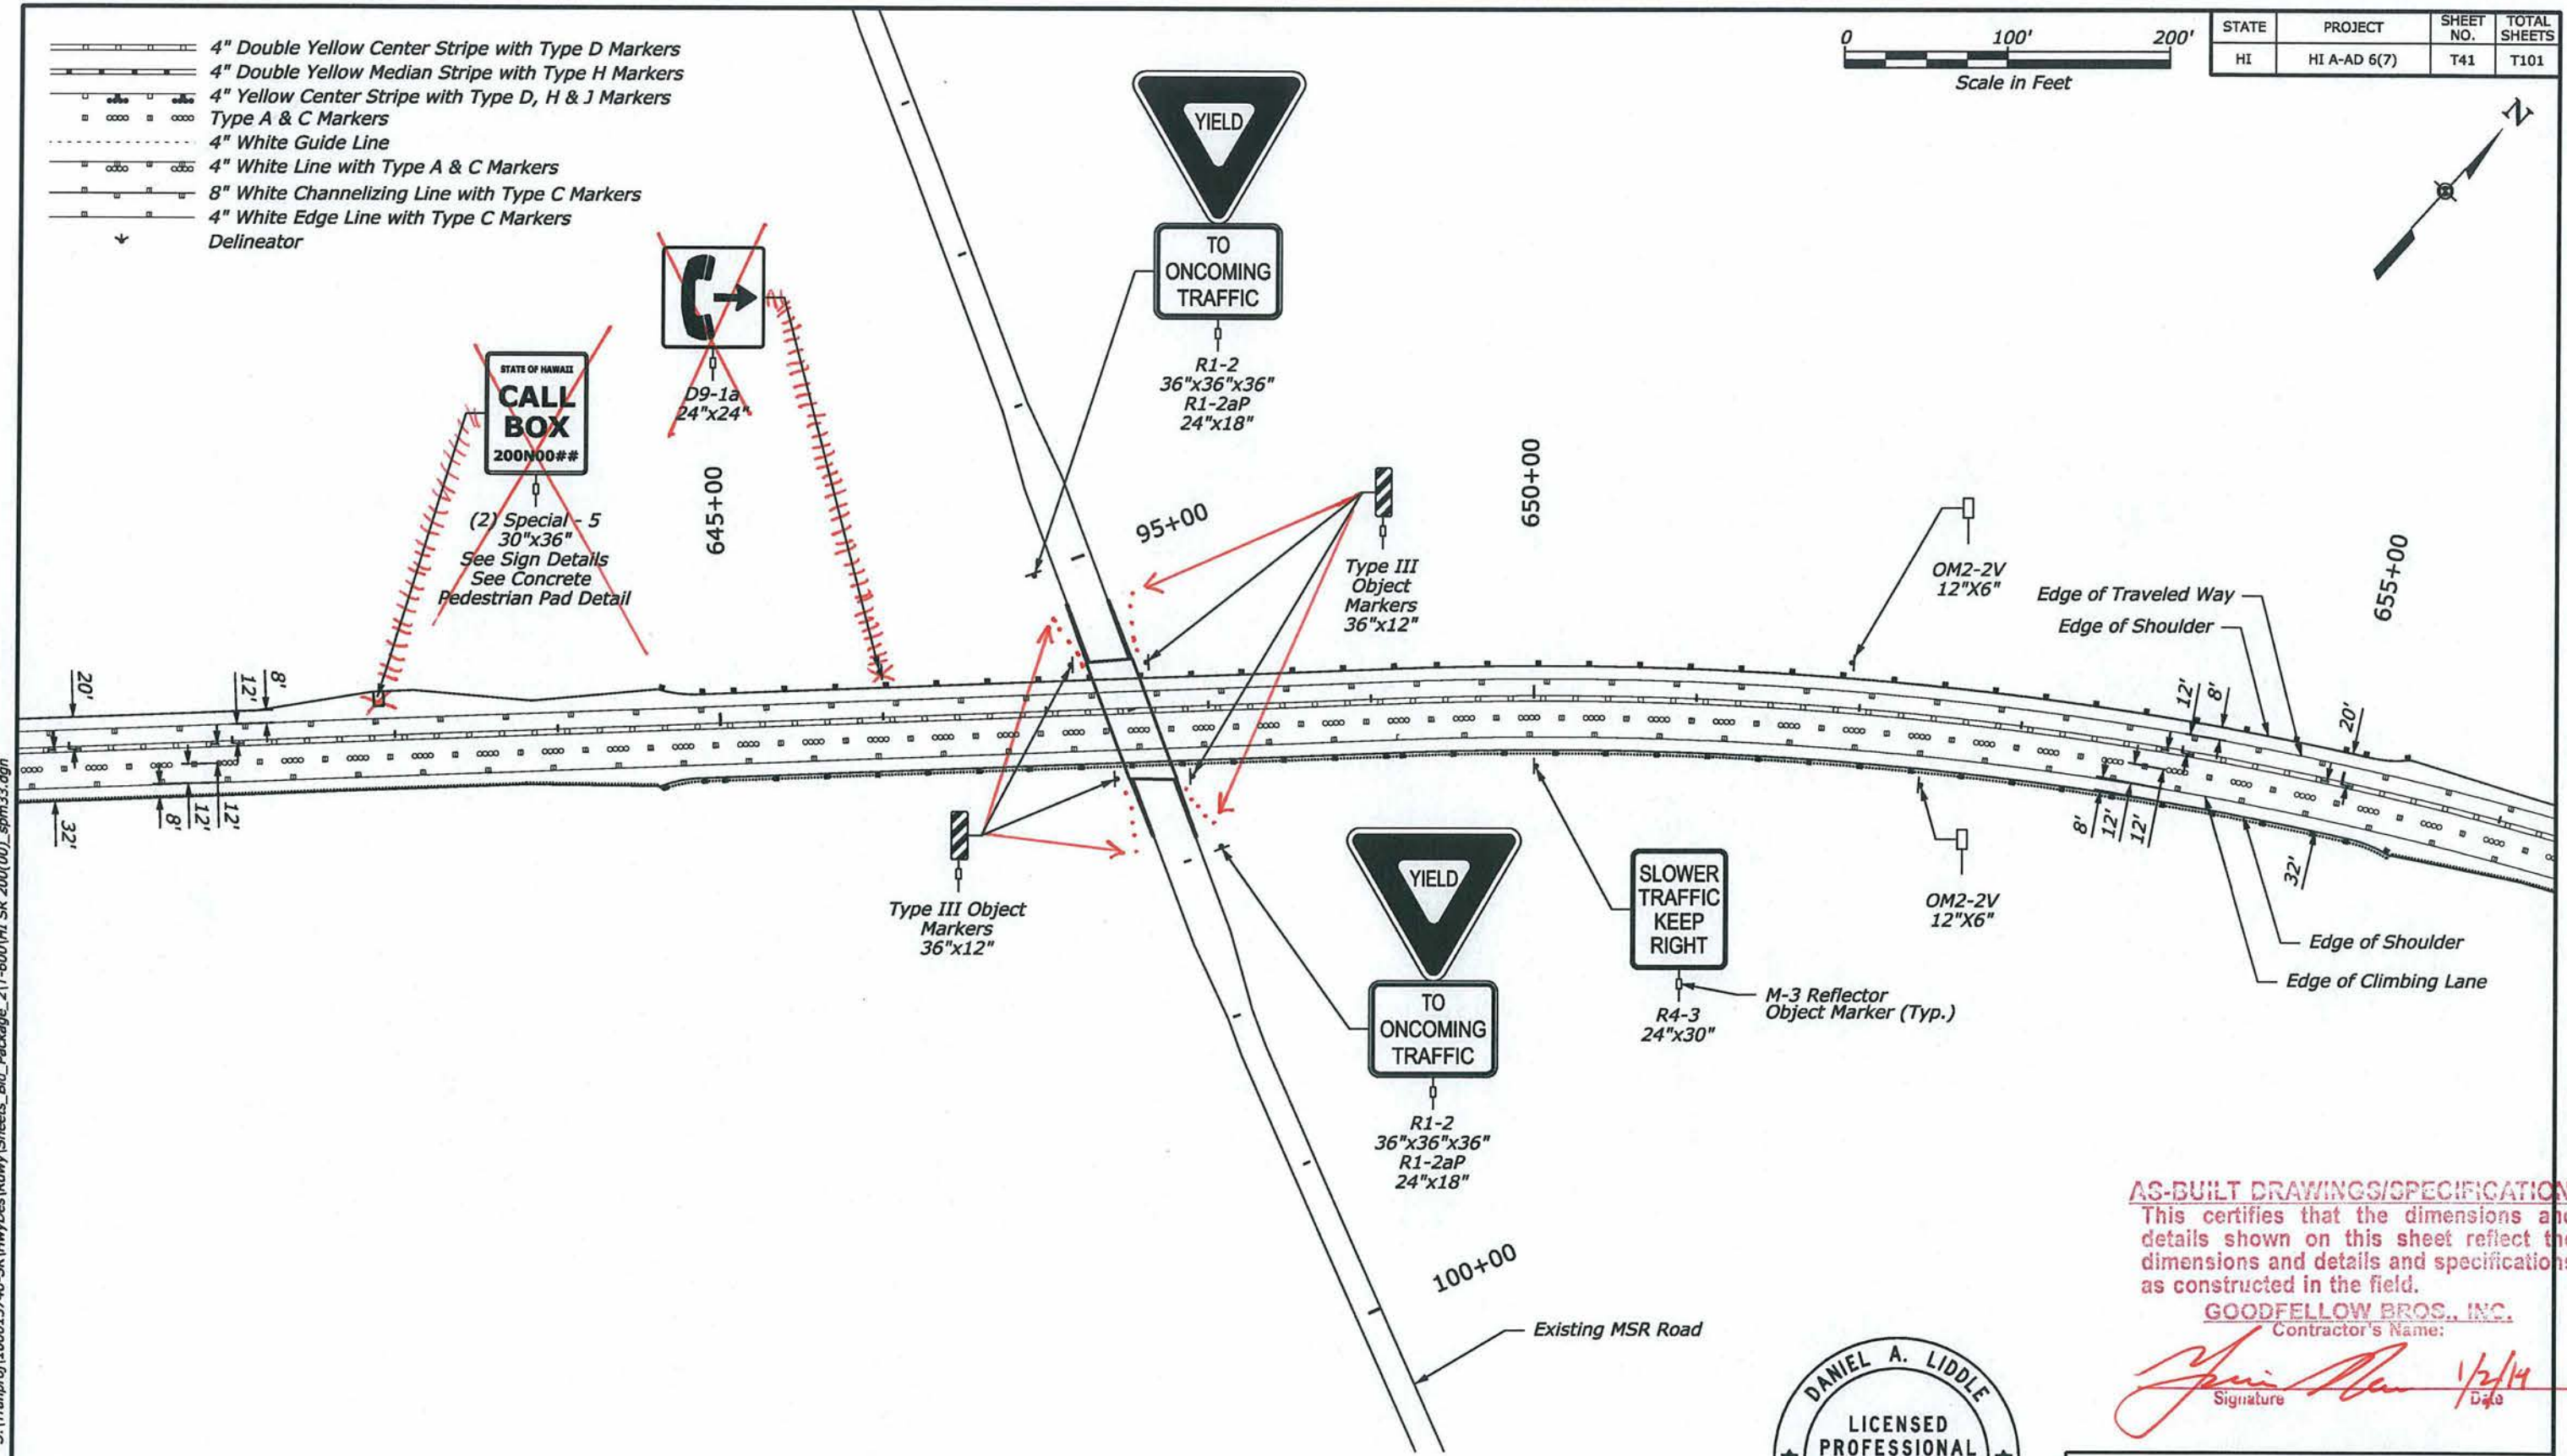

AS-BUILT DRAWINGS/SPECIFICATIONS
 This certifies that the dimensions and details shown on this sheet reflect the dimensions and details and specifications as constructed in the field.

GOODFELLOW BROS., INC.
 Contractor's Name:

[Signature] 1/2/14
 Signature Date

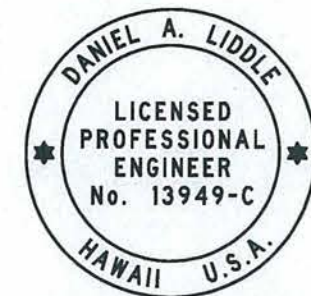


 







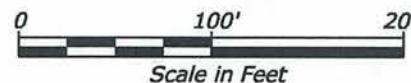
This work was prepared by me or under my supervision
Daniel A. Liddle
 Expiration Date of License 4/30/2014

U.S. DEPARTMENT OF TRANSPORTATION
 FEDERAL HIGHWAY ADMINISTRATION
 CENTRAL FEDERAL LANDS HIGHWAY DIVISION

**SADDLE ROAD
 SIGNING & STRIPING PLAN**

3/24/2012 2:29:18 PM S:\Transport\100013746-SR\HwyDes\Roadway\Sheets_Bid_Package_21T-600\HI SR 200(00)_spm33.dgn


-  4" Double Yellow Center Stripe with Type D Markers
-  4" Double Yellow Median Stripe with Type H Markers
-  4" Yellow Center Stripe with Type D, H & J Markers
-  Type A & C Markers
-  4" White Guide Line
-  4" White Line with Type A & C Markers
-  8" White Channelizing Line with Type C Markers
-  4" White Edge Line with Type C Markers
-  Delineator



STATE	PROJECT	SHEET NO.	TOTAL SHEETS
HI	HI A-AD 6(7)	T42	T101



3/24/2012 2:30:16 PM S:\Tranproj\100013746-SR\HwyDes\Roadwy\Sheets_Bid_Package_2\T-600\HI SR 200(00)_sppm34.dgn

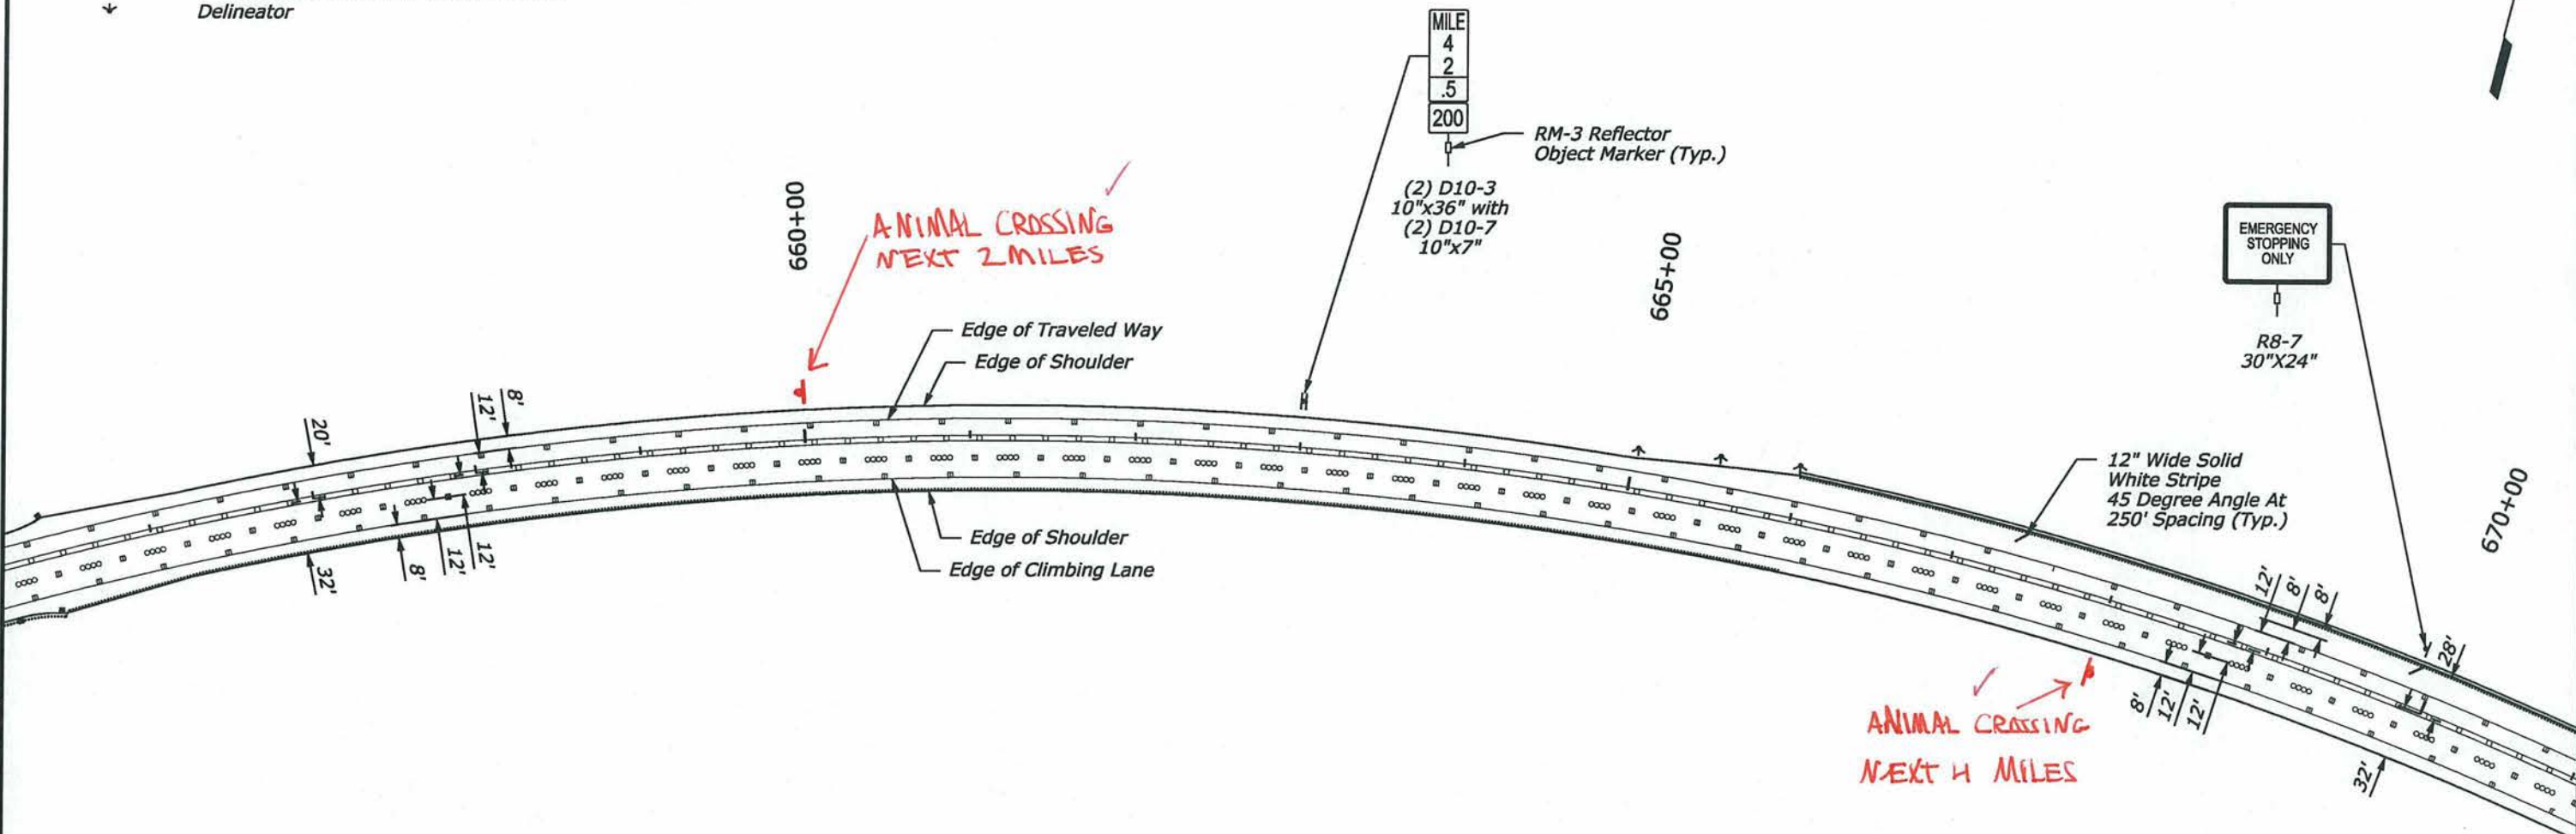


AS-BUILT DRAWINGS/SPECIFICATIONS


This certifies that the dimensions and details shown on this sheet reflect the dimensions and details and specifications as constructed in the field.

GOODFELLOW BROS., INC.
Contractor's Name:

[Signature] 1/2/14
Signature Date

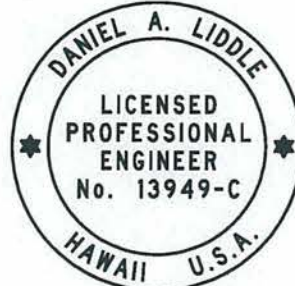



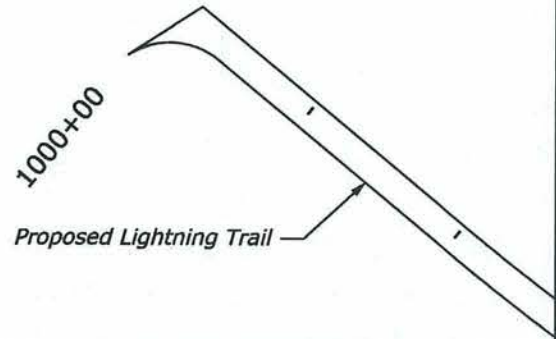


 



This work was prepared by me or under my supervision
Daniel A. Liddle
Expiration Date of License 4/30/2014




U.S. DEPARTMENT OF TRANSPORTATION
FEDERAL HIGHWAY ADMINISTRATION
CENTRAL FEDERAL LANDS HIGHWAY DIVISION

**SADDLE ROAD
SIGNING & STRIPING PLAN**

Notes:
- Refer to Special 633-A for Firebreak area striping details.


-  4" Double Yellow Center Stripe with Type D Markers
-  4" Double Yellow Median Stripe with Type H Markers
-  4" Yellow Center Stripe with Type D, H & J Markers
-  Type A & C Markers
-  4" White Guide Line
-  4" White Line with Type A & C Markers
-  8" White Channelizing Line with Type C Markers
-  4" White Edge Line with Type C Markers
-  Delineator

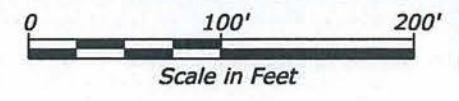

STATE	PROJECT	SHEET NO.	TOTAL SHEETS
HI	HI A-AD 6(7)	T43	T101



S:\Tranproj\100013746-SR\HwyDes\Roadway\Sheets_Bid_Package_2\T-600\HI SR 200(00)_spm35.dgn 3/24/2012 2:31:13 PM

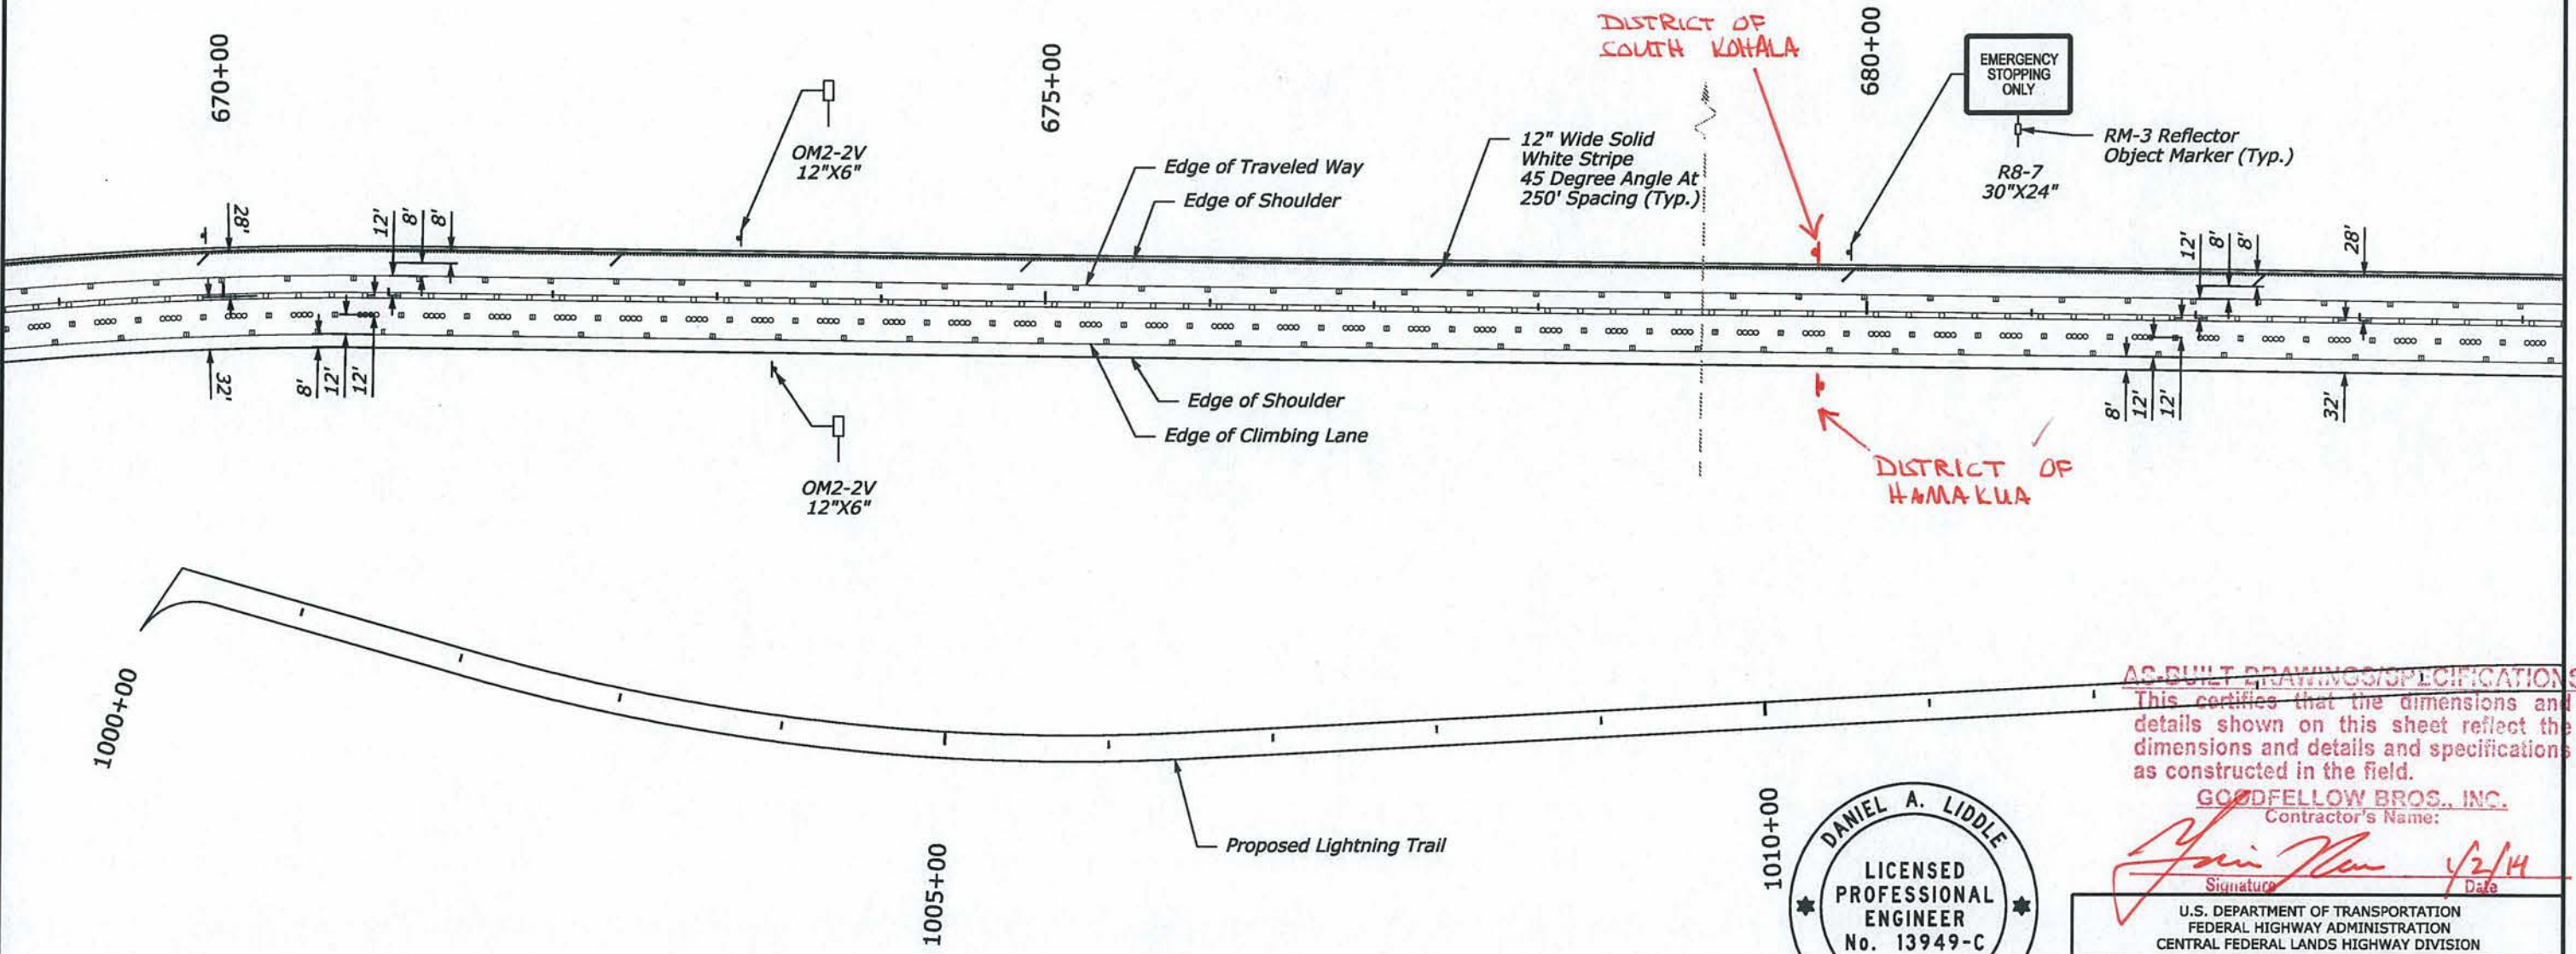


AS-BUILT DRAWINGS/SPECIFICATIONS
 This certifies that the dimensions and details shown on this sheet reflect the dimensions and details and specifications as constructed in the field.

GOODFELLOW BROS., INC.
 Contractor's Name:

[Signature] 4/2/14
Date

U.S. DEPARTMENT OF TRANSPORTATION
 FEDERAL HIGHWAY ADMINISTRATION
 CENTRAL FEDERAL LANDS HIGHWAY DIVISION

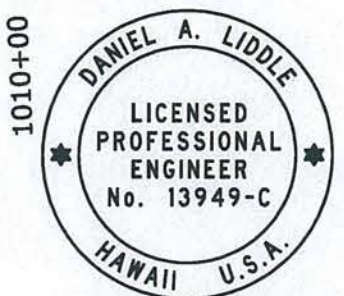


This work was prepared by me or under my supervision
Daniel A. Liddle
 Expiration Date of License 4/30/2014


**SADDLE ROAD
 SIGNING & STRIPING PLAN**

Notes:
 - Refer to Special 633-A for Firebreak area striping details.

- 4" Double Yellow Center Stripe with Type D Markers
- 4" Double Yellow Median Stripe with Type H Markers
- 4" Yellow Center Stripe with Type D, H & J Markers
- Type A & C Markers
- 4" White Guide Line
- 4" White Line with Type A & C Markers
- 8" White Channelizing Line with Type C Markers
- 4" White Edge Line with Type C Markers
- Delineator

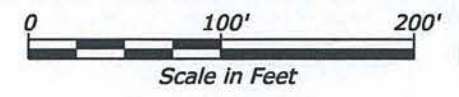

STATE	PROJECT	SHEET NO.	TOTAL SHEETS
HI	HI A-AD 6(7)	T44	T101

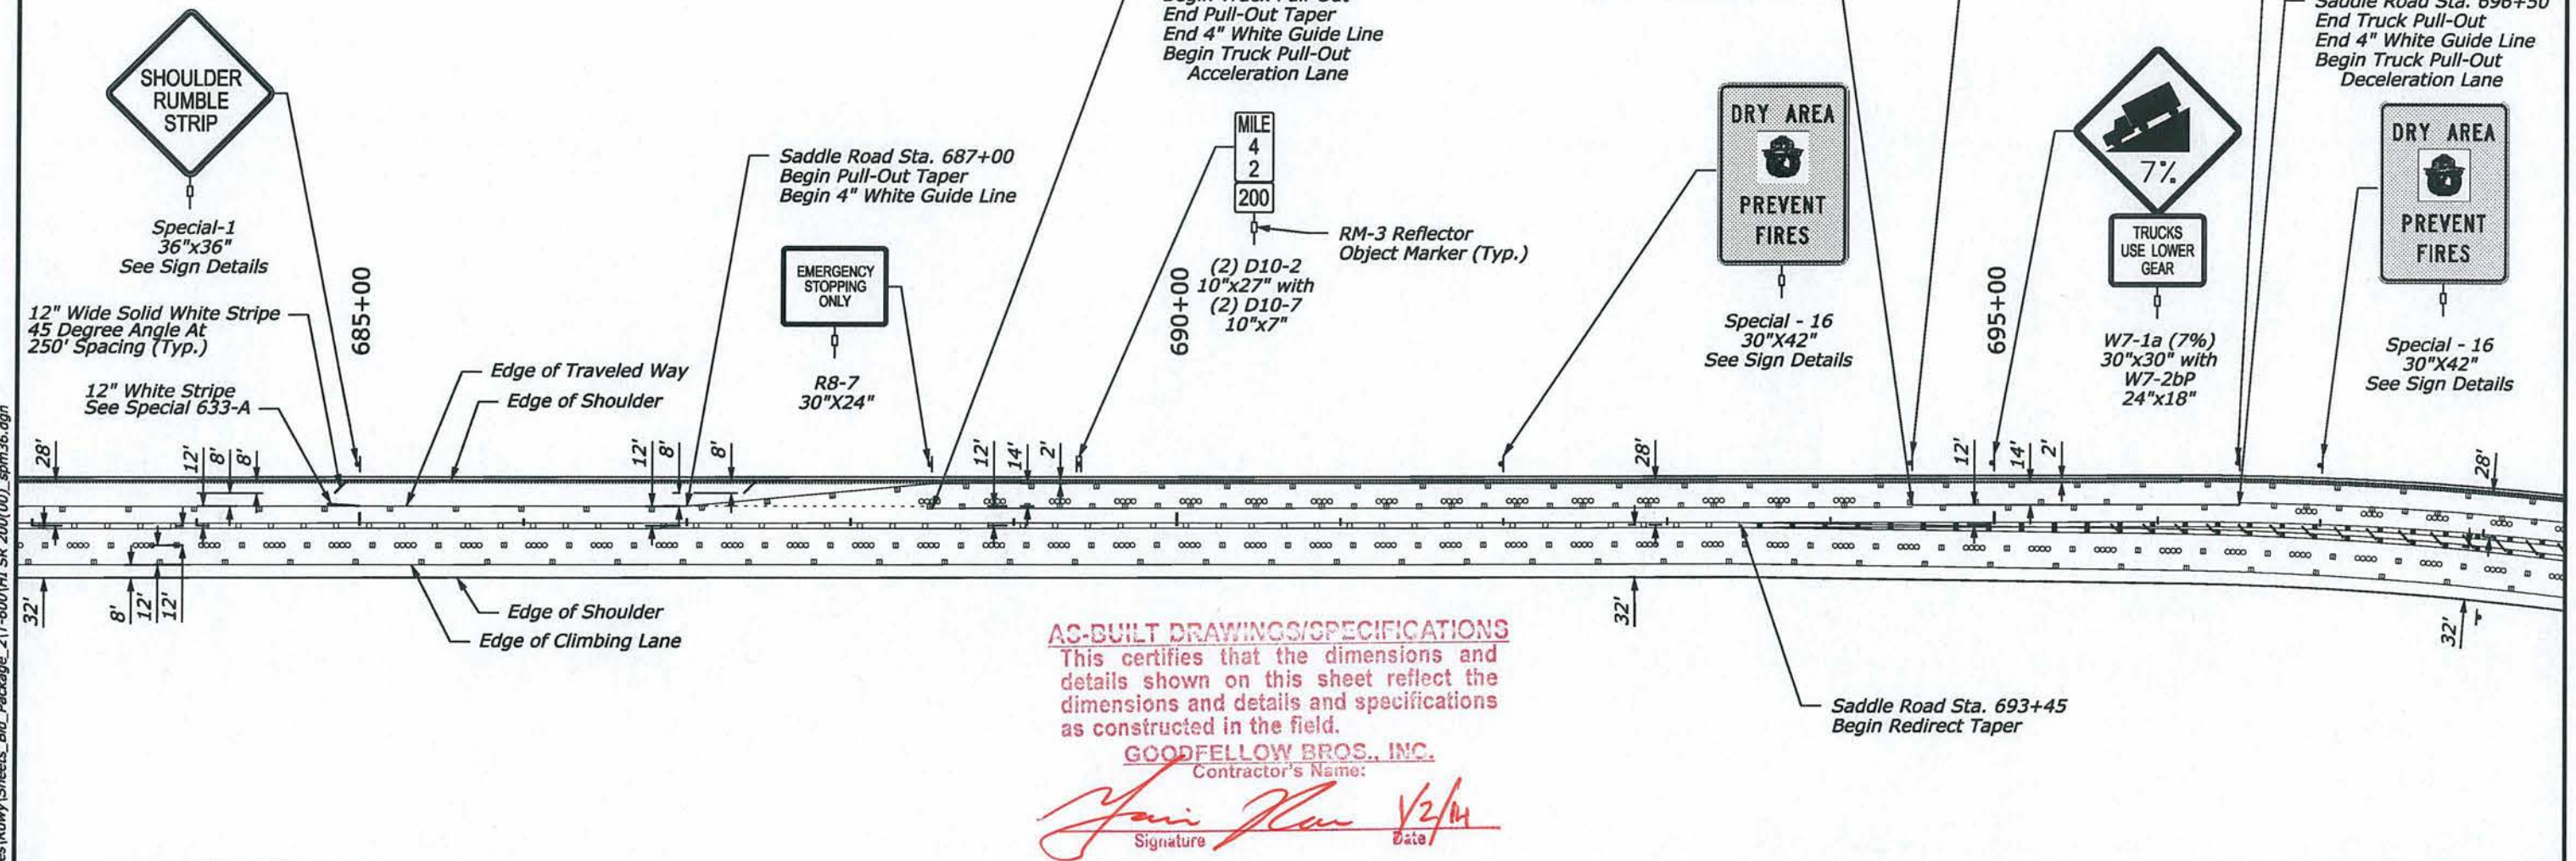

AS-BUILT DRAWINGS/SPECIFICATIONS
 This certifies that the dimensions and details shown on this sheet reflect the dimensions and details and specifications as constructed in the field.

GOODFELLOW BROS., INC.
 Contractor's Name:

Jani Han 1/2/14
 Signature Date



This work was prepared by me or under my supervision
Daniel A. Liddle
 Expiration Date of License 4/30/2014


U.S. DEPARTMENT OF TRANSPORTATION
 FEDERAL HIGHWAY ADMINISTRATION
 CENTRAL FEDERAL LANDS HIGHWAY DIVISION

**SADDLE ROAD
 SIGNING & STRIPING PLAN**


3/24/2012 2:32:12 PM S:\Tranproj\100013746-SR\HwyDes\Roadway\Sheets_Bid_Package_21T-600\HI SR 200(00)_spm36.dgn

Notes:
 - Refer to Special 633-A for Firebreak area striping details.

- 4" Double Yellow Center Stripe with Type D Markers
- 4" Double Yellow Median Stripe with Type H Markers
- 4" Yellow Center Stripe with Type D, H & J Markers
- Type A & C Markers
- 4" White Guide Line
- 4" White Line with Type A & C Markers
- 8" White Channelizing Line with Type C Markers
- 4" White Edge Line with Type C Markers
- Delineator

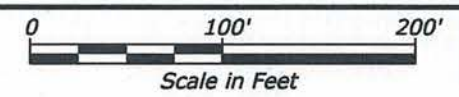

STATE	PROJECT	SHEET NO.	TOTAL SHEETS
HI	HI A-AD 6(7)	T45	T101

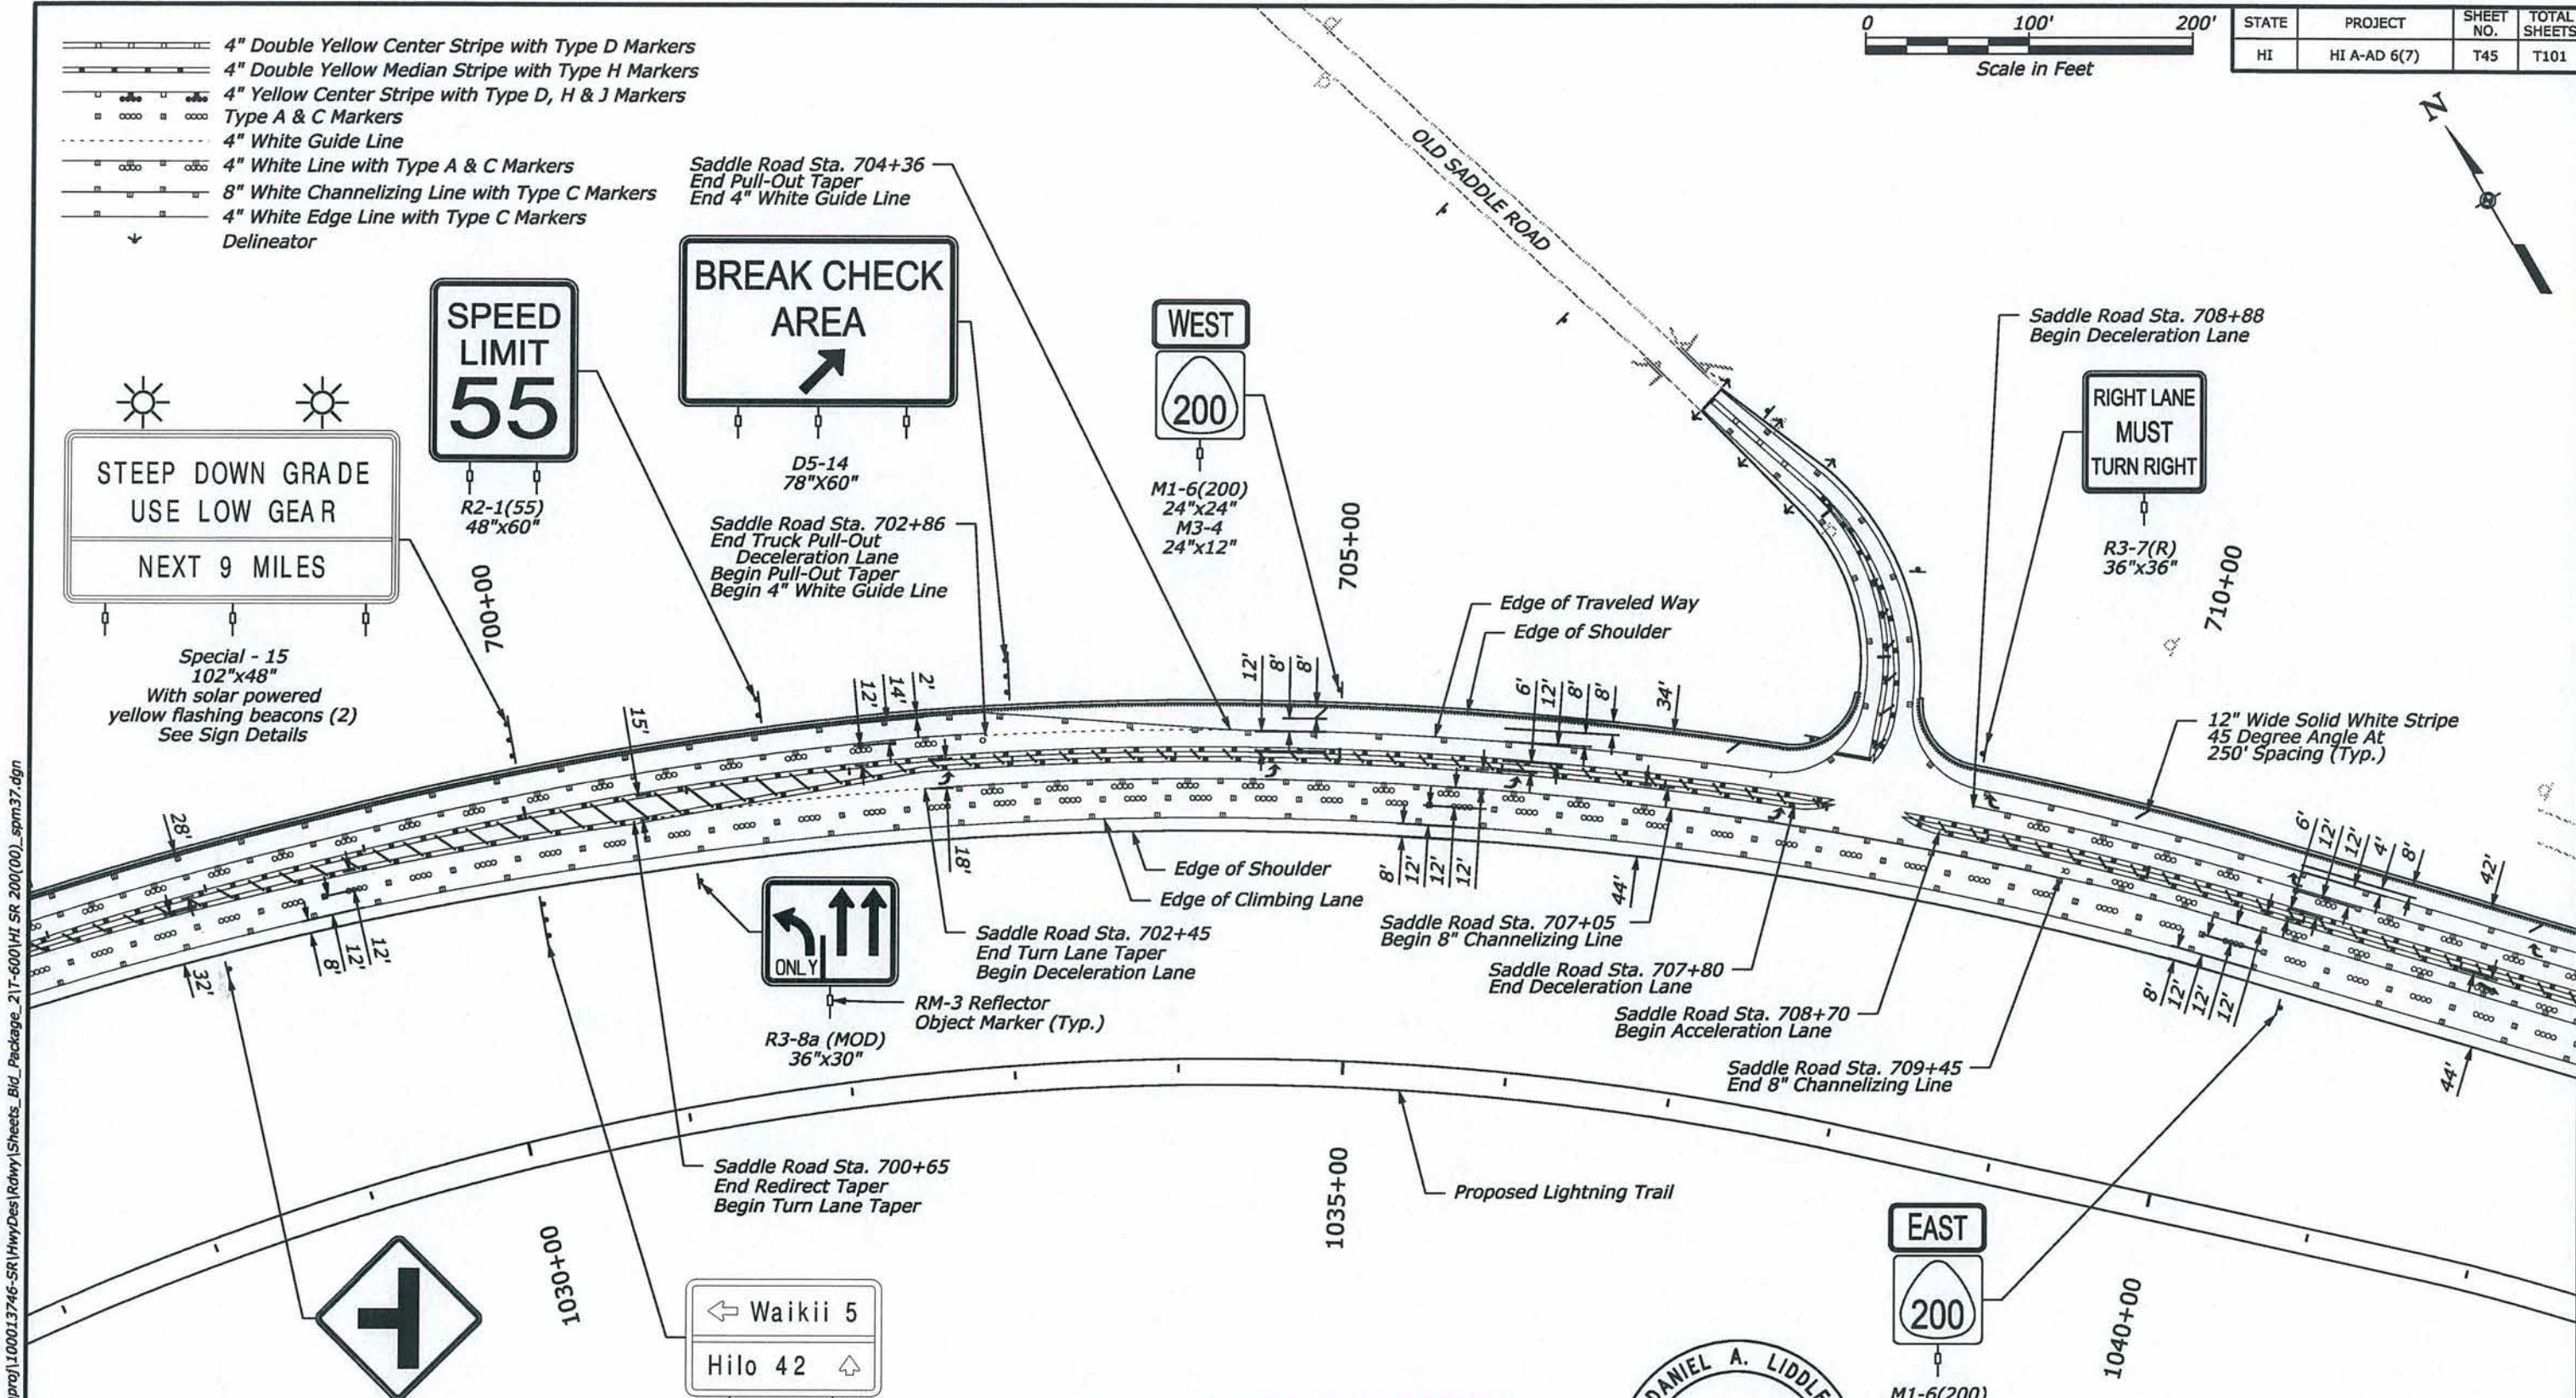


3/24/2012 2:33:10 PM S:\Tranpro\100013746-SR\HwyDes\Roadway\Sheets_Bid_Package_21T-600\HI SR 200(00)_spm37.dgn


Notes:
 - Refer to sheet T59 for signing on existing Saddle Road.
 - Refer to Special 633-A for Firebreak area striping details.

AS-BUILT DRAWINGS/SPECIFICATIONS
 This certifies that the dimensions and details shown on this sheet reflect the dimensions and details and specifications as constructed in the field.

GOODFELLOW BROS., INC.
 Contractor's Name:

 Signature Date: 1/2/14

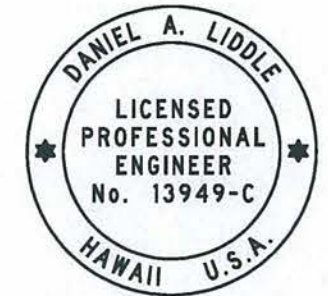


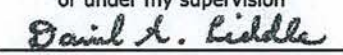This work was prepared by me or under my supervision

 Expiration Date of License 4/30/2014


U.S. DEPARTMENT OF TRANSPORTATION
 FEDERAL HIGHWAY ADMINISTRATION
 CENTRAL FEDERAL LANDS HIGHWAY DIVISION

**SADDLE ROAD
 SIGNING & STRIPING PLAN**

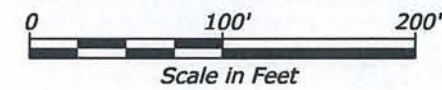- 4" Double Yellow Center Stripe with Type D Markers
- 4" Double Yellow Median Stripe with Type H Markers
- 4" Yellow Center Stripe with Type D, H & J Markers
- Type A & C Markers
- 4" White Guide Line
- 4" White Line with Type A & C Markers
- 8" White Channelizing Line with Type C Markers
- 4" White Edge Line with Type C Markers
- Delineator



STATE	PROJECT	SHEET NO.	TOTAL SHEETS
HI	HI A-AD 6(7)	T46	T101

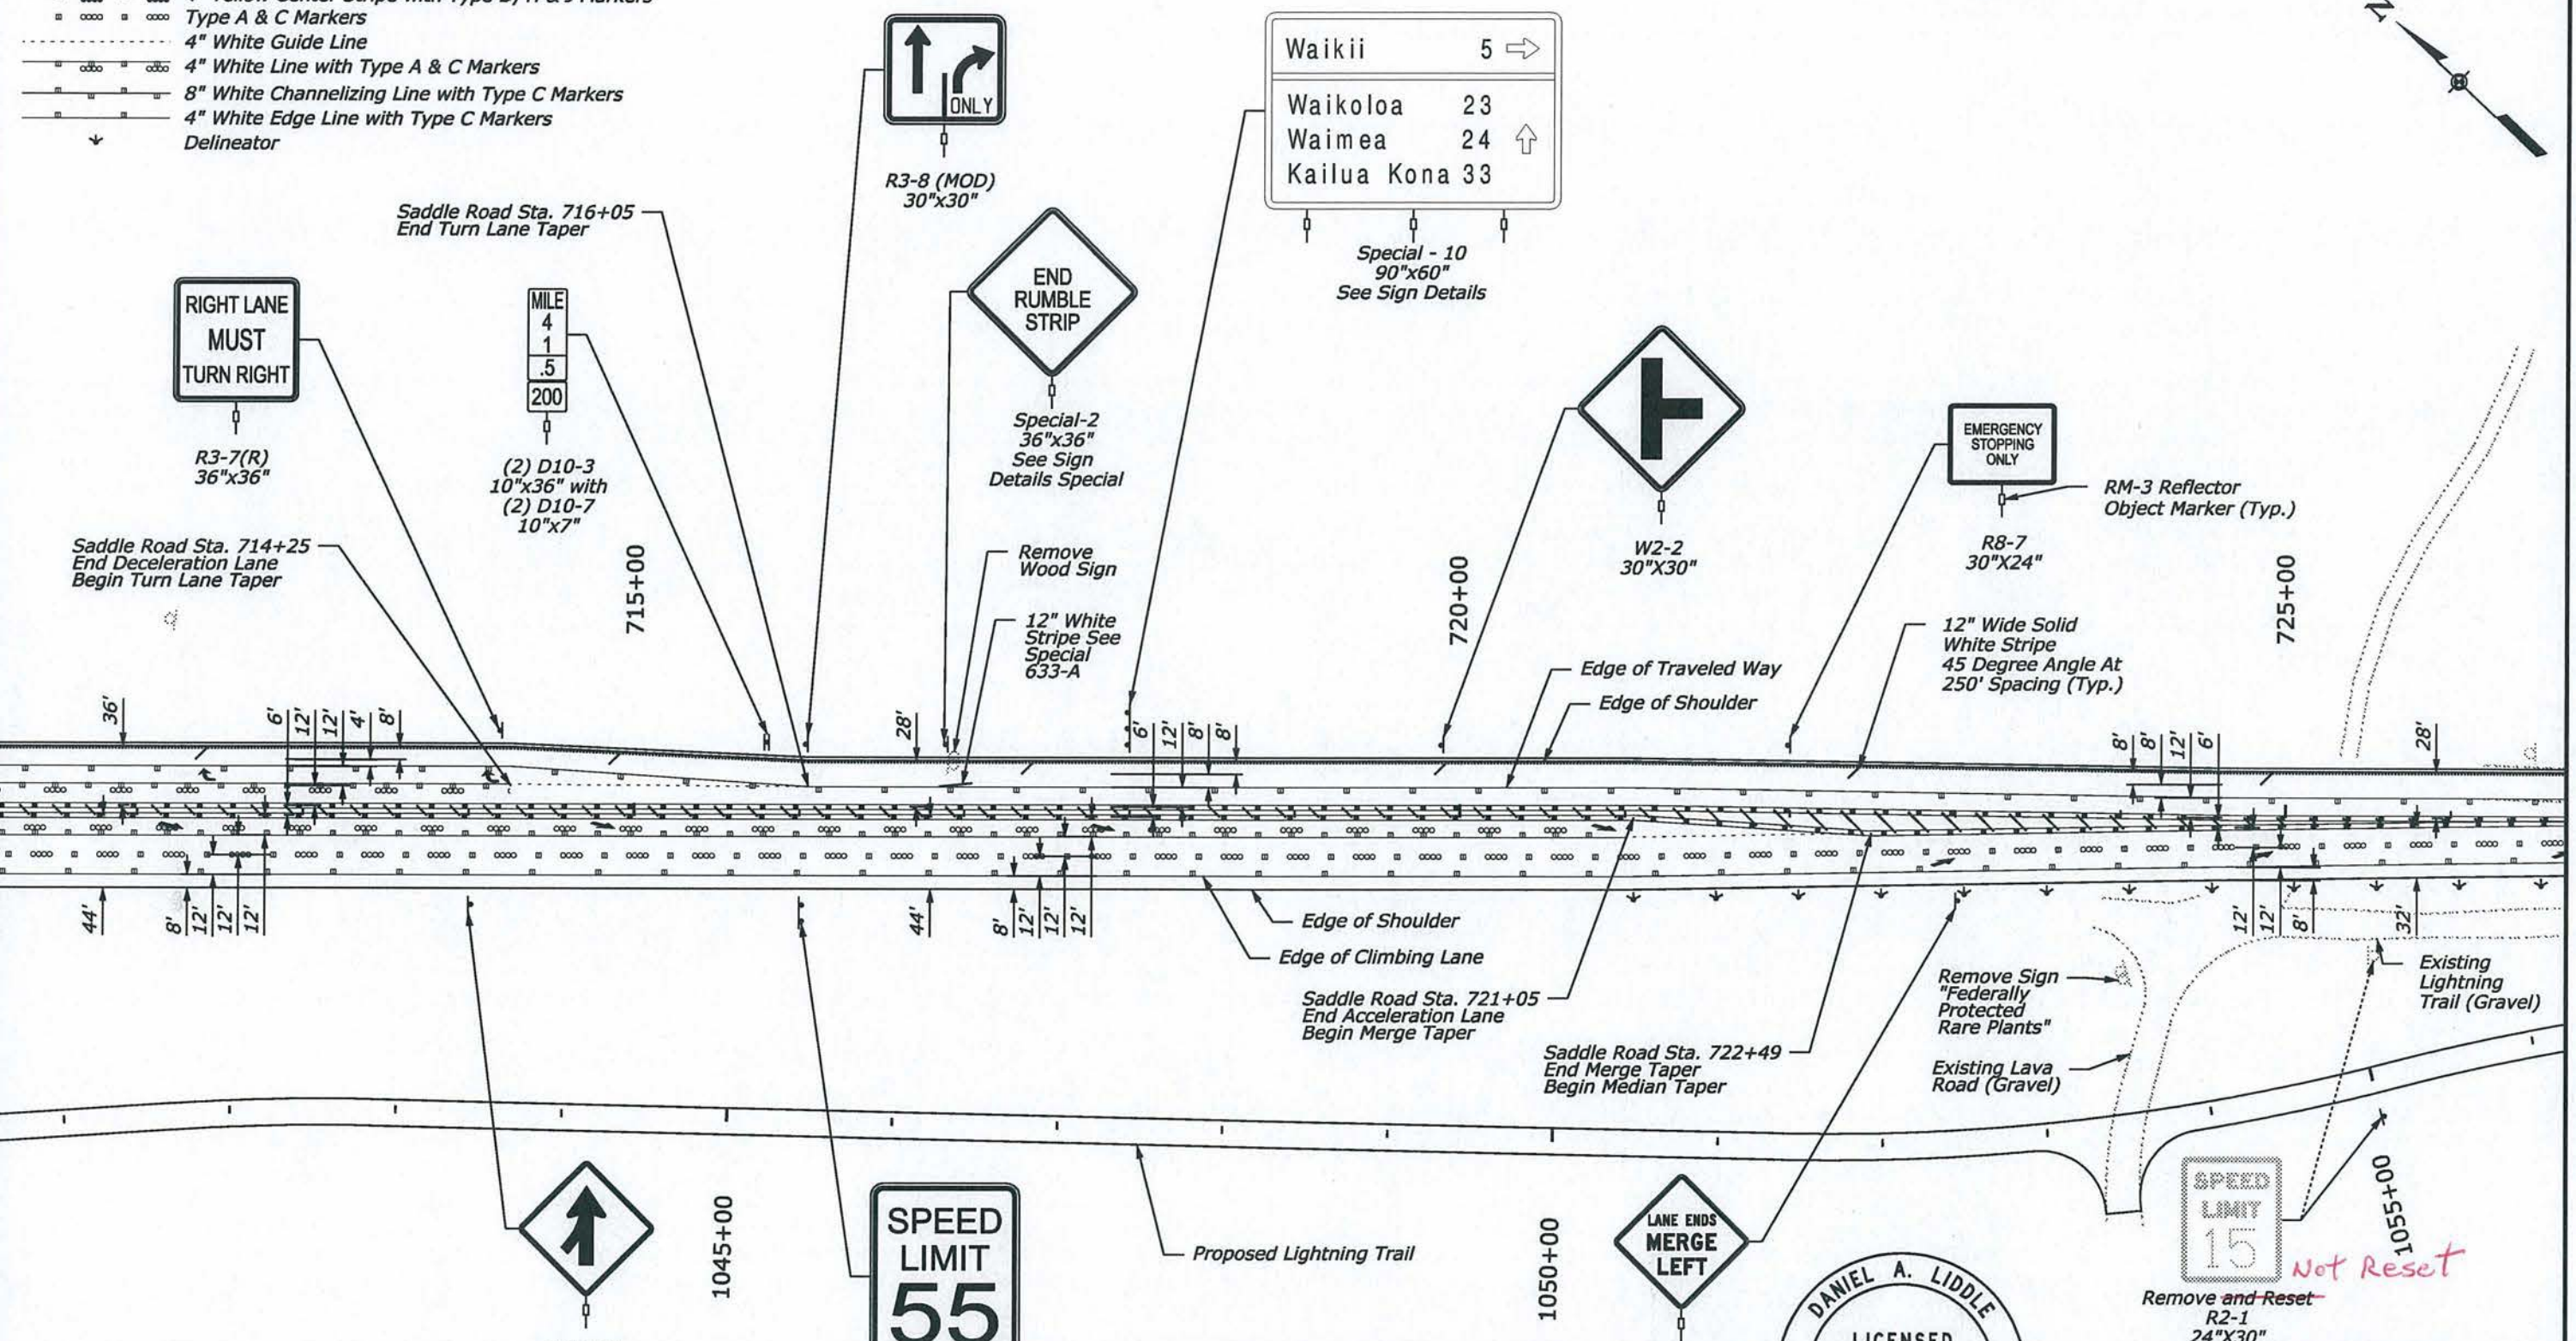

S:\Tranpro\100013746-SR\HwyDes\Sheets_Bld_Package_2\T-600\HI SR 200(00)_spm38.dgn 2:34:12 PM 3/24/2012

Notes:
- Refer to Special 633-A for Firebreak area striping details.

AS-BUILT DRAWINGS/SPECIFICATIONS
This certifies that the dimensions and details shown on this sheet reflect the dimensions and details and specifications as constructed in the field.
GOODFELLOW BROS., INC.
Contractor's Name:
[Signature]
Date: 1/2/14




This work was prepared by me or under my supervision
[Signature]
Expiration Date of License 4/30/2014

U.S. DEPARTMENT OF TRANSPORTATION
FEDERAL HIGHWAY ADMINISTRATION
CENTRAL FEDERAL LANDS HIGHWAY DIVISION

**SADDLE ROAD
SIGNING & STRIPING PLAN**

SPEED LIMIT 15
Remove and Reset R2-1 24"X30"
Not Reset

- 4" Double Yellow Center Stripe with Type D Markers
- 4" Double Yellow Median Stripe with Type H Markers
- 4" Yellow Center Stripe with Type D, H & J Markers
- Type A & C Markers
- 4" White Guide Line
- 4" White Line with Type A & C Markers
- 8" White Channelizing Line with Type C Markers
- 4" White Edge Line with Type C Markers
- Delineator

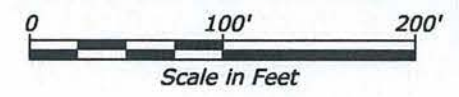

STATE	PROJECT	SHEET NO.	TOTAL SHEETS
HI	HI A-AD 6(7)	T47	T101



BRAKE

BREAK CHECK AREA
1/2 MILE

D5-13
84"X48"

12" Wide Solid White Stripe
45 Degree Angle At
250' Spacing (Typ.)



Remove W8-6

EMERGENCY STOPPING ONLY

R8-7
30"X24"

STATE OF HAWAII
CALL BOX
200N00##

(2) Special - 5
30"x36"
See Sign Details
See Concrete Pedestrian Pad Detail

RM-3 Reflector
Object Marker (Typ.)



D9-1a
24"X24"

EMERGENCY STOPPING ONLY

R8-7
30"X24"

Remove Sign

Saddle Road Sta. 731+40
Begin Merge Taper

Edge of Shoulder
Edge of Traveled Way

Saddle Road Sta. 737+40
End Merge Taper

Saddle Road Sta. 739+20
Begin Median Taper

Saddle Road Sta. 728+20
End Median Taper



D9-1a
24"X24"



W4-2(R)
36"X36"

1060+00

1065+00

Proposed Lightning Trail

1070+00

AS-BUILT DRAWINGS/SPECIFICATIONS

This certifies that the dimensions and details shown on this sheet reflect the dimensions and details and specifications as constructed in the field.

GOODFELLOW BROS., INC.
Contractor's Name:

[Signature]
Signature

1/2/14
Date



 








This work was prepared by me or under my supervision
Daniel A. Liddle
Expiration Date of License 4/30/2014


U.S. DEPARTMENT OF TRANSPORTATION
FEDERAL HIGHWAY ADMINISTRATION
CENTRAL FEDERAL LANDS HIGHWAY DIVISION

**SADDLE ROAD
SIGNING & STRIPING PLAN**

  Notes:
- Refer to Special 633-A for Firebreak area striping details.

3/24/2012 2:35:10 PM S:\Tranproj\100013746-SR\HwyDes\Sheets\Bid_Package_21T-600\HI SR 200(00)_spm39.dgn

-  4" Double Yellow Center Stripe with Type D Markers
-  4" Double Yellow Median Stripe with Type H Markers
-  4" Yellow Center Stripe with Type D, H & J Markers
-  Type A & C Markers
-  4" White Guide Line
-  4" White Line with Type A & C Markers
-  8" White Channelizing Line with Type C Markers
-  4" White Edge Line with Type C Markers
-  Delineator

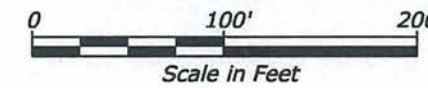


STATE	PROJECT	SHEET NO.	TOTAL SHEETS
HI	HI A-AD 6(7)	T48	T101



AS-BUILT DRAWINGS/SPECIFICATIONS
 This certifies that the dimensions and details shown on this sheet reflect the dimensions and details and specifications as constructed in the field.


GOODFELLOW BROS., INC.
 Contractor's Name:

[Signature]
 Signature
 1/2/14
 Date

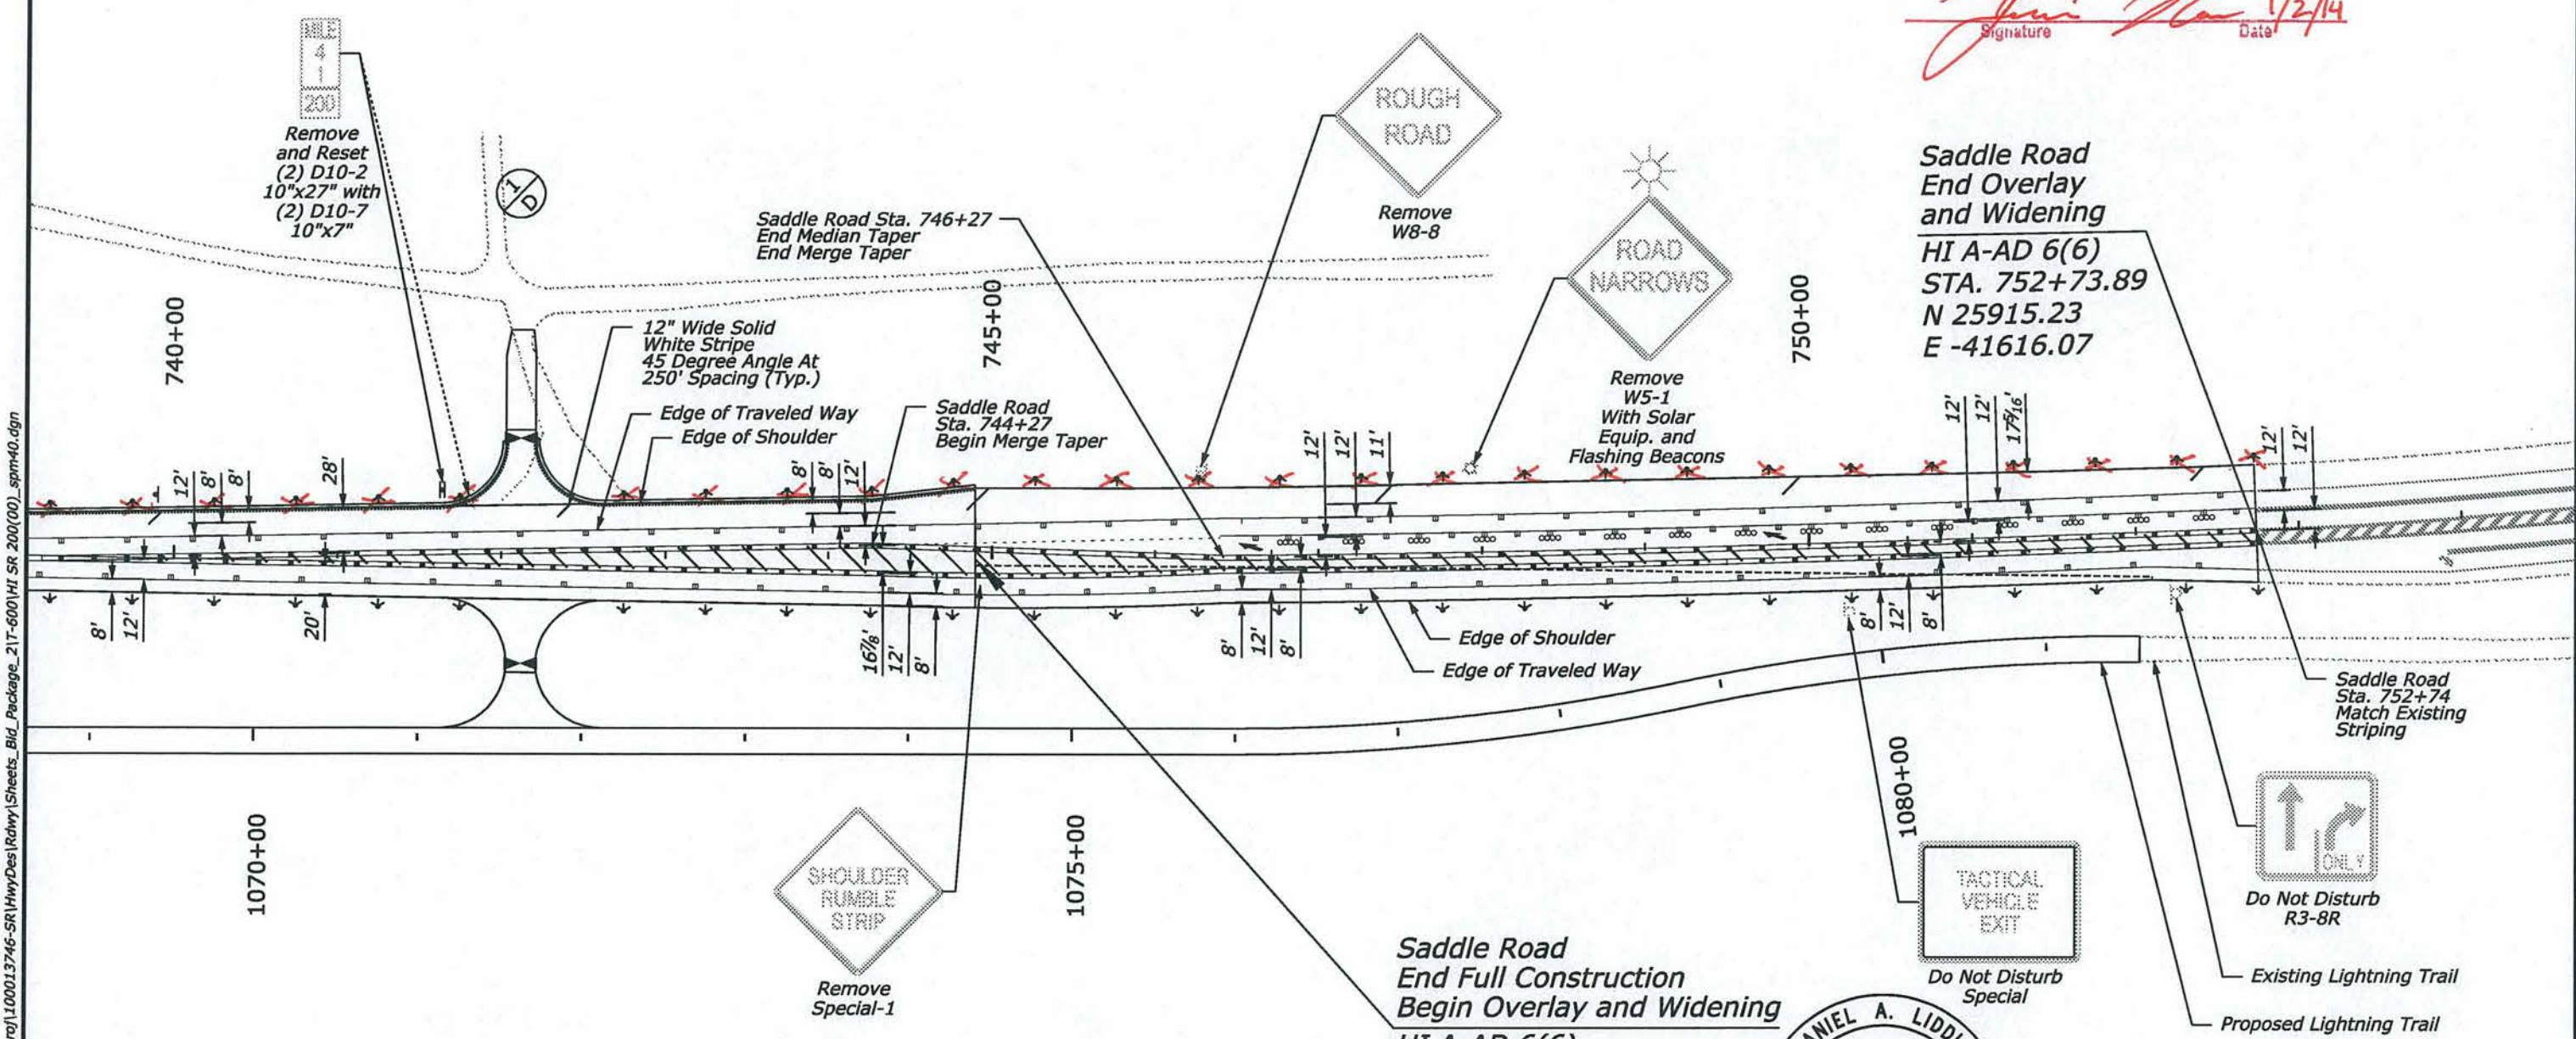

Saddle Road End Overlay and Widening
 HI A-AD 6(6)
 STA. 752+73.89
 N 25915.23
 E -41616.07

Saddle Road End Full Construction Begin Overlay and Widening
 HI A-AD 6(6)
 STATION 744+89.80
 EL 5,528.44
 N 26470.39
 E -42169.69

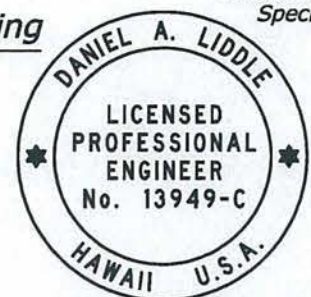

This work was prepared by me or under my supervision
Daniel A. Liddle
 Expiration Date of License 4/30/2014


U.S. DEPARTMENT OF TRANSPORTATION
 FEDERAL HIGHWAY ADMINISTRATION
 CENTRAL FEDERAL LANDS HIGHWAY DIVISION

SADDLE ROAD SIGNING & STRIPING PLAN


Notes:
 - Refer to Special 634-C for Deceleration and Acceleration lane marking details.
 - Refer to Special 633-A for Firebreak area striping details.

3/24/2012 2:36:11 PM S:\Tranprof\100013746-SR\HwyDes\Draws\Sheets_Bld_Package_217-600\HI SR 200(00)_spn40.dgn

- 4" Double Yellow Center Stripe with Type D Markers
- 4" Double Yellow Median Stripe with Type H Markers
- 4" Yellow Center Stripe with Type D, H & J Markers
- Type A & C Markers
- 4" White Guide Line
- 4" White Line with Type A & C Markers
- 8" White Channelizing Line with Type C Markers
- 4" White Edge Line with Type C Markers
- Delineator

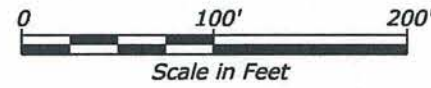


STATE	PROJECT	SHEET NO.	TOTAL SHEETS
HI	HI A-AD 6(7)	T49	T101

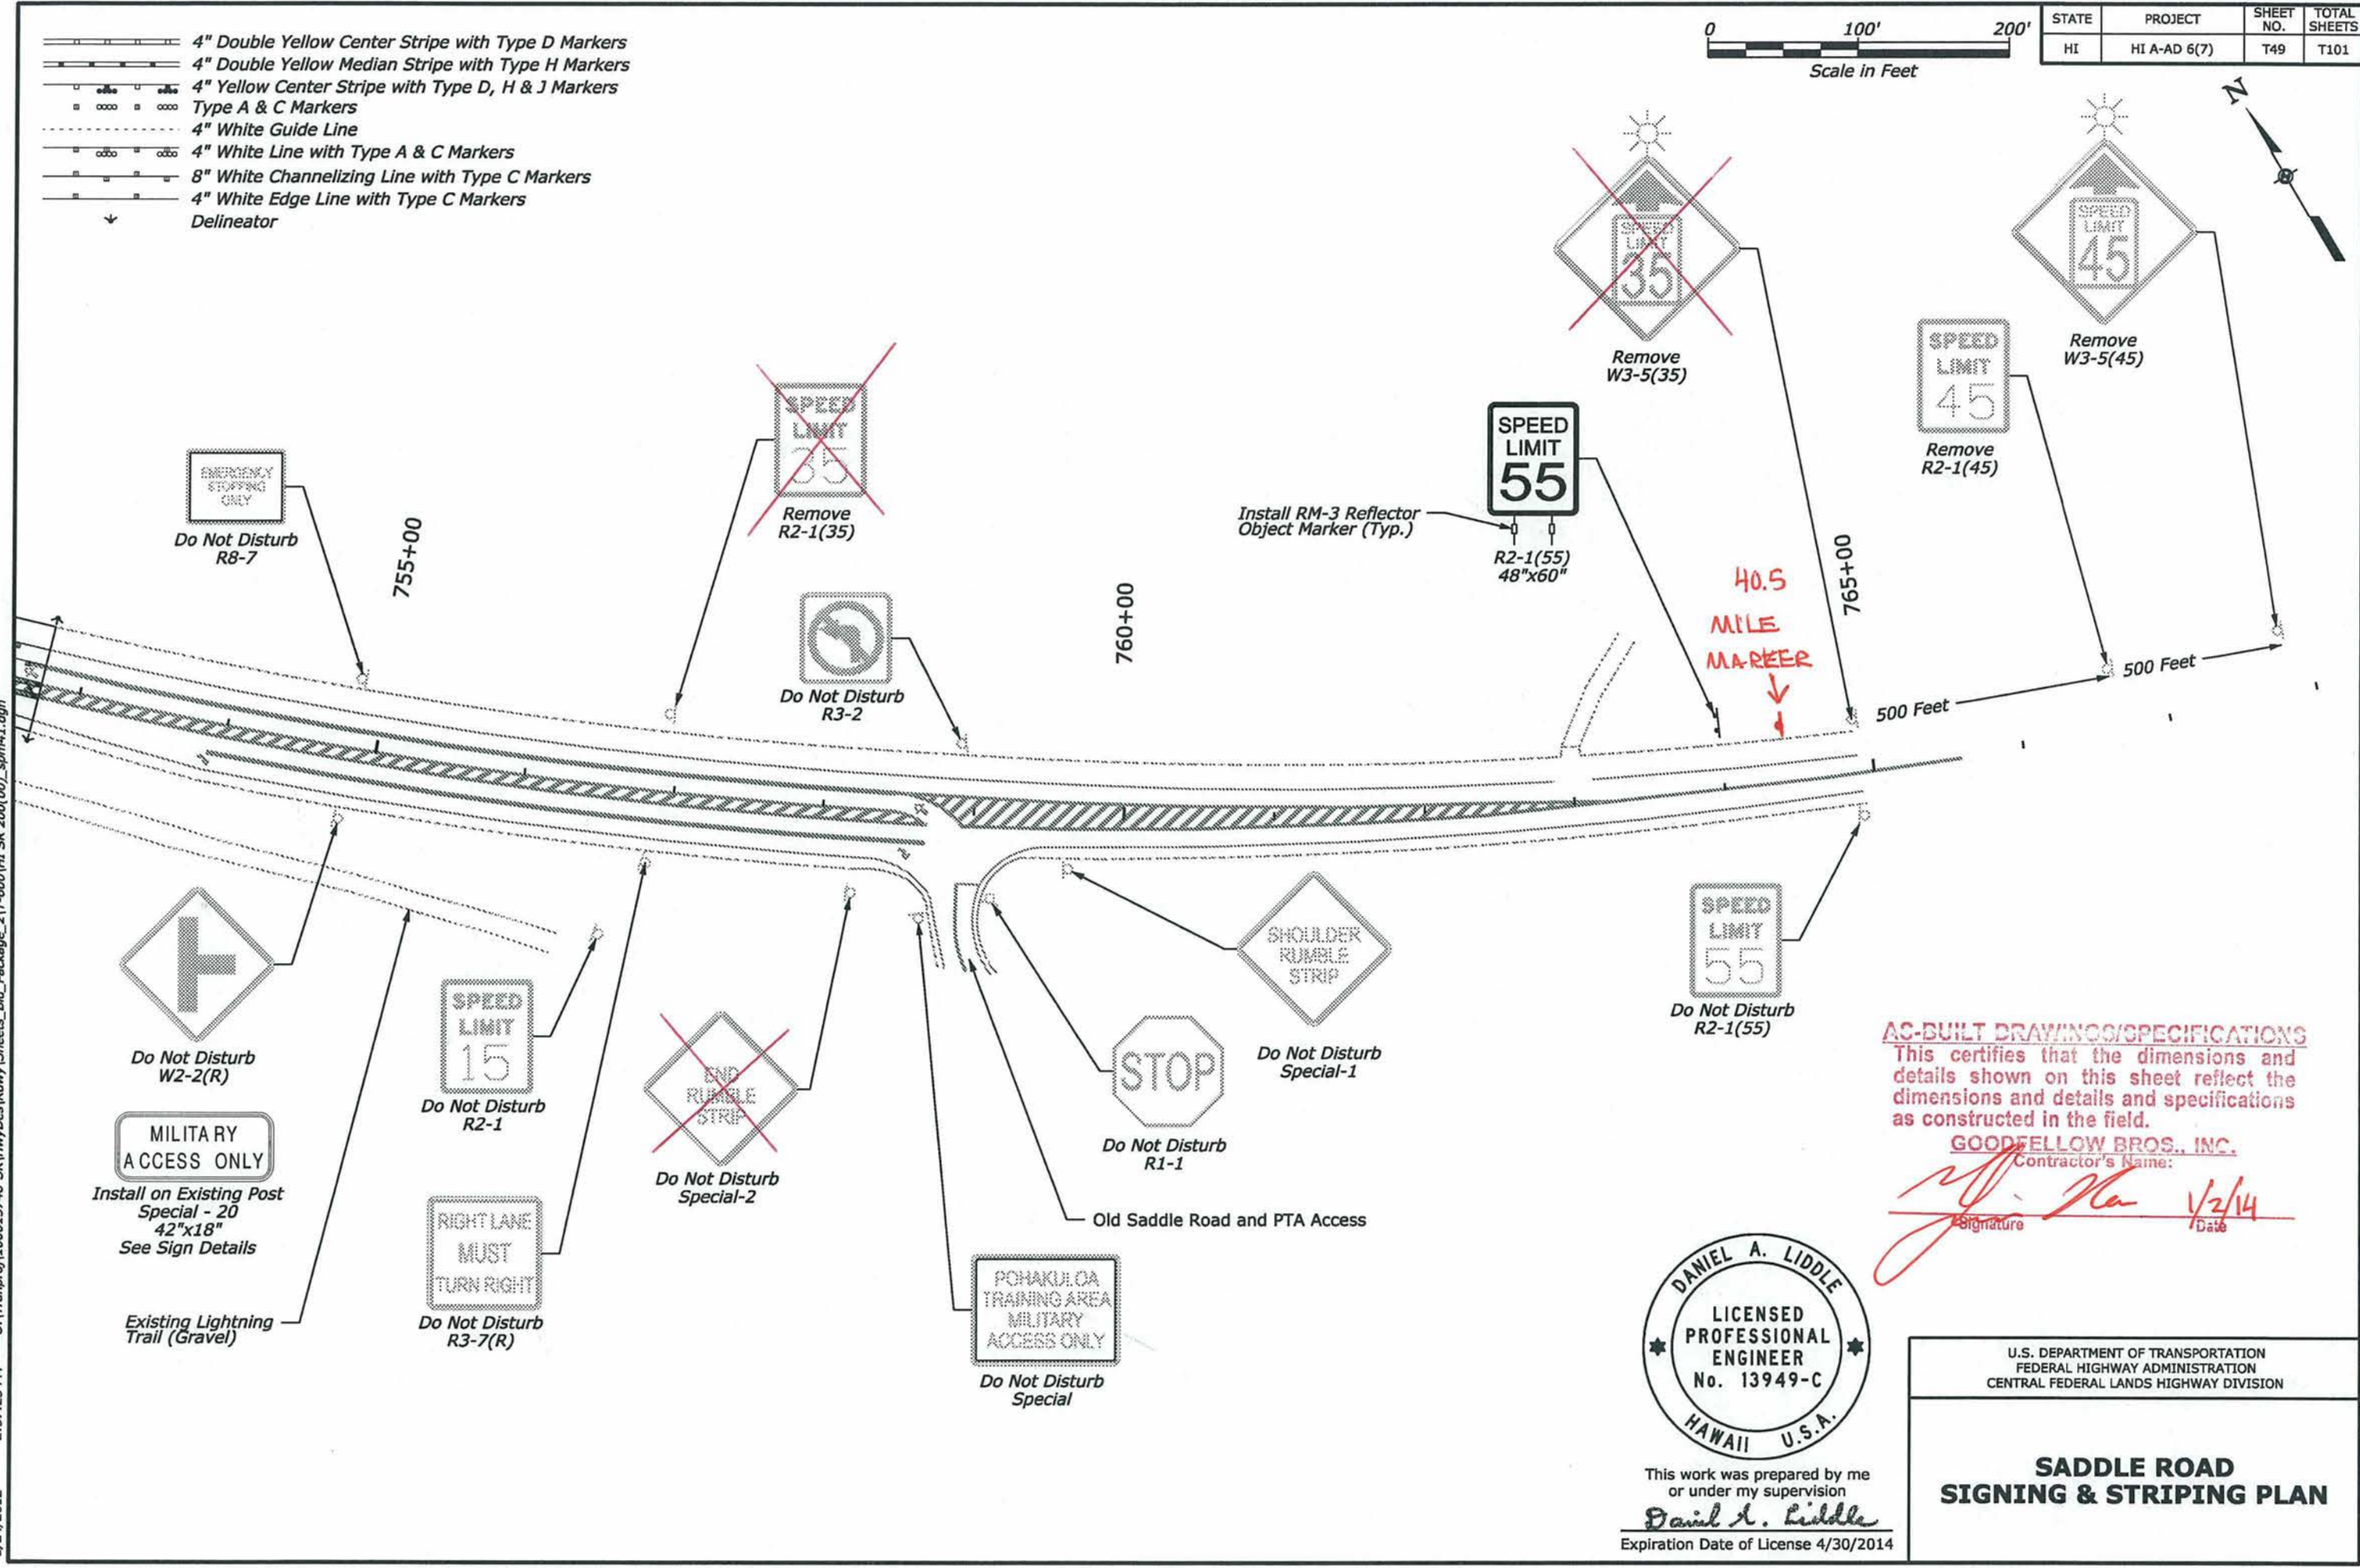

AS-BUILT DRAWINGS/SPECIFICATIONS
 This certifies that the dimensions and details shown on this sheet reflect the dimensions and details and specifications as constructed in the field.

GOODFELLOW BROS., INC.
 Contractor's Name:
[Signature] 1/2/14
 Signature Date

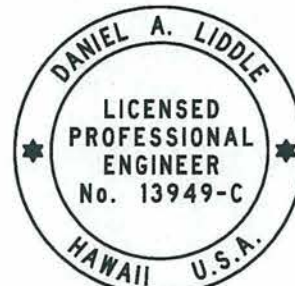

This work was prepared by me or under my supervision
Daniel A. Liddle
 Expiration Date of License 4/30/2014

U.S. DEPARTMENT OF TRANSPORTATION
 FEDERAL HIGHWAY ADMINISTRATION
 CENTRAL FEDERAL LANDS HIGHWAY DIVISION

**SADDLE ROAD
 SIGNING & STRIPING PLAN**

3/24/2012 2:37:23 PM S:\Tranproj\100013746-SR\HwyDes\Draws\Sheets_Bld_Package_217-600\HI SR 200(00)_sppm41.dgn