


STATE	PROJECT	SHEET NO.	TOTAL SHEETS
HI	HI A-AD 6(7)	A4	A22



TMK: 4-4-15:004
HI A-AD 6(7)
SADDLE ROAD
 708+25.35 =
OLD SADDLE ROAD
 160+00.00
END PROJECT
HI A-AD 6(7)
SADDLE ROAD
 (M.P. 40.80)
~~752+73.89~~
753+90
 To Hilo, HI
 ± 41 miles from
 end of project
 TMK: 4-4-15:014
 TMK: 4-4-15:008
 744+05.07 =
 0+00.00
HI A-AD 6(5)
COMPLETED 08/2009
 Edge of Keamuku
 Lava Flow

AS-BUILT DRAWINGS/SPECIFICATIONS
 This certifies that the dimensions and
 details shown on this sheet reflect the
 dimensions and details and specifications
 as constructed in the field.
GOODELOW BROS., INC.
 Contractor's Name:
[Signature]
 Signature
 1/2/14
 Date

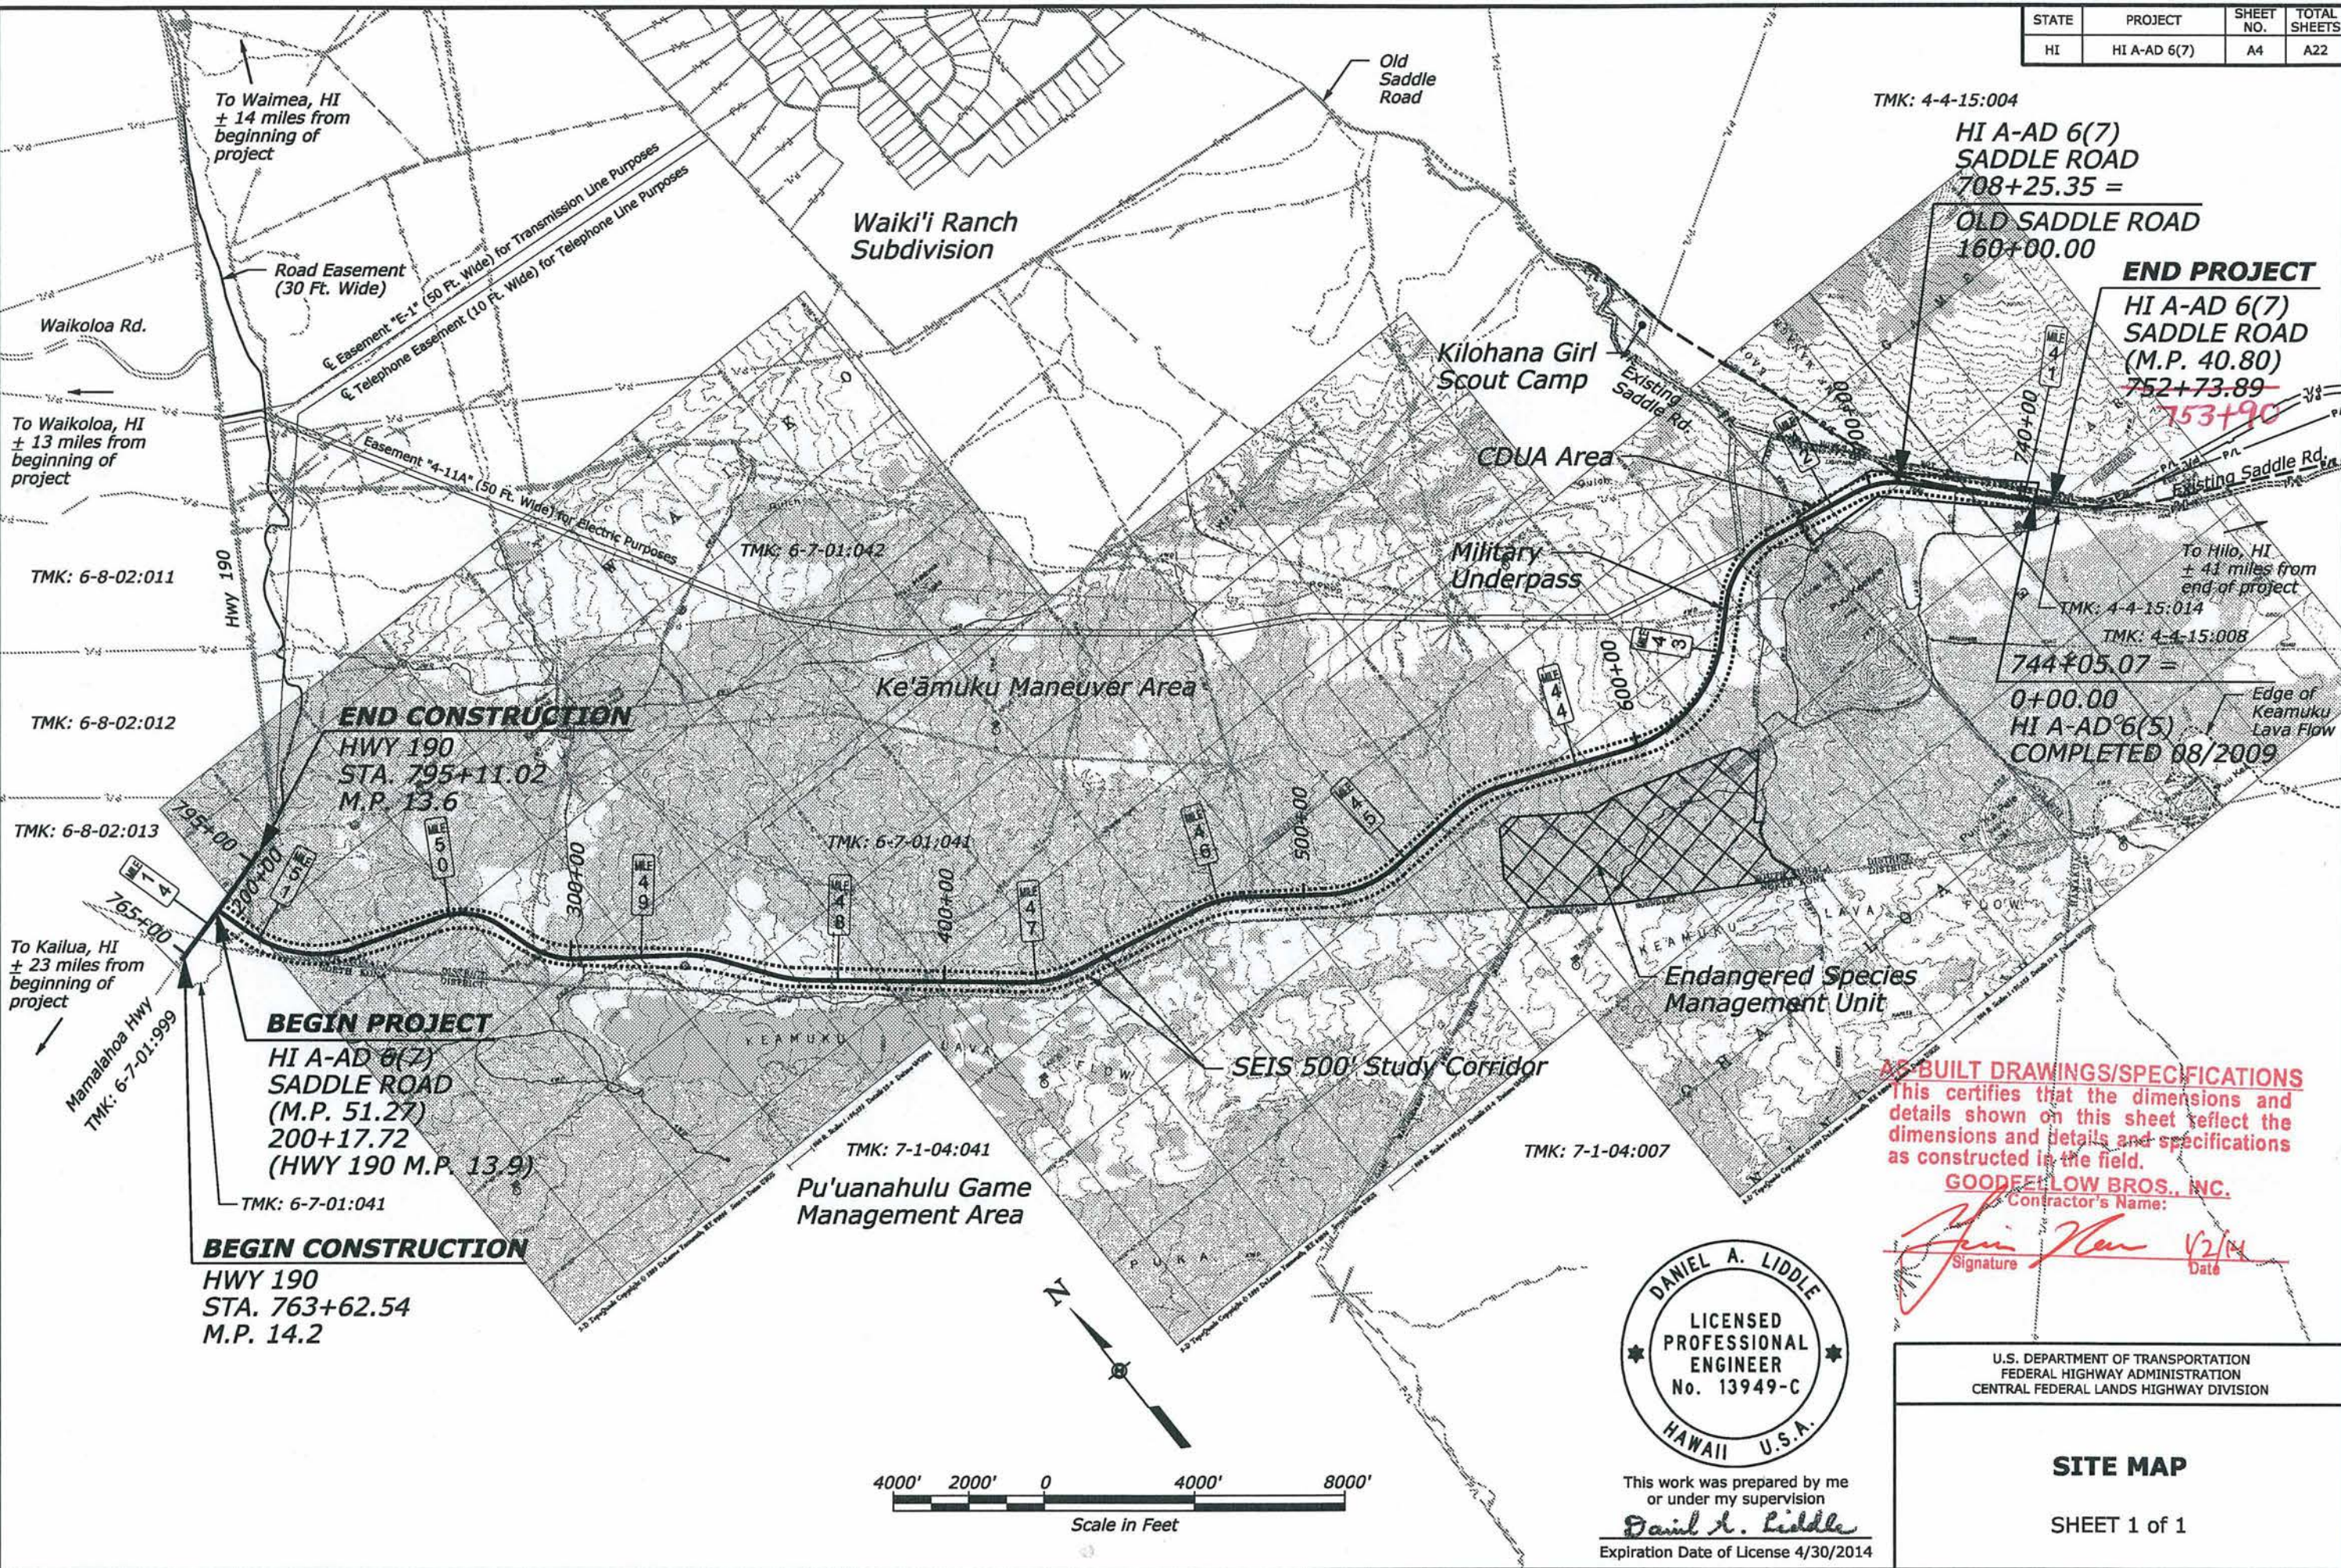

This work was prepared by me
 or under my supervision
Daniel A. Liddle
 Expiration Date of License 4/30/2014

U.S. DEPARTMENT OF TRANSPORTATION
 FEDERAL HIGHWAY ADMINISTRATION
 CENTRAL FEDERAL LANDS HIGHWAY DIVISION

SITE MAP

SHEET 1 of 1

S:\Transport\100013746-SR\HwyDes\dwg\Sheets_Bld_Package_2\A-Gen_Sht\HI SR 200(00)_PLA_SITE MAP.dgn
 3/20/2012 2:59:27 PM