

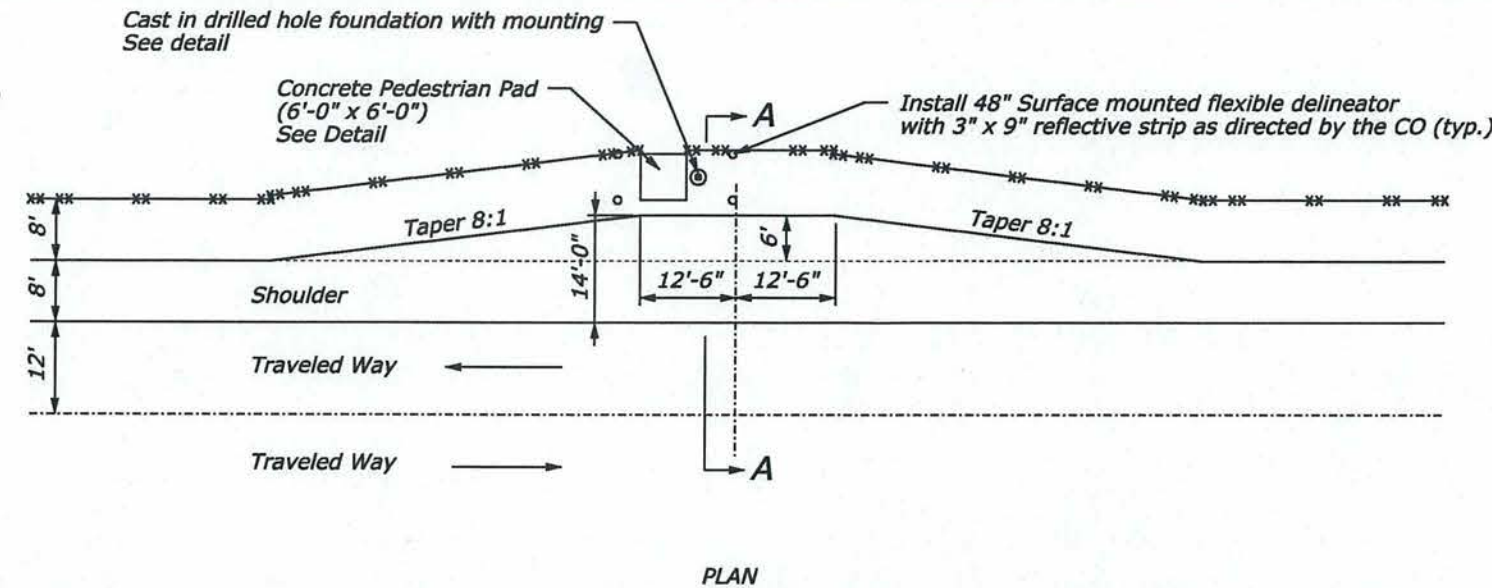
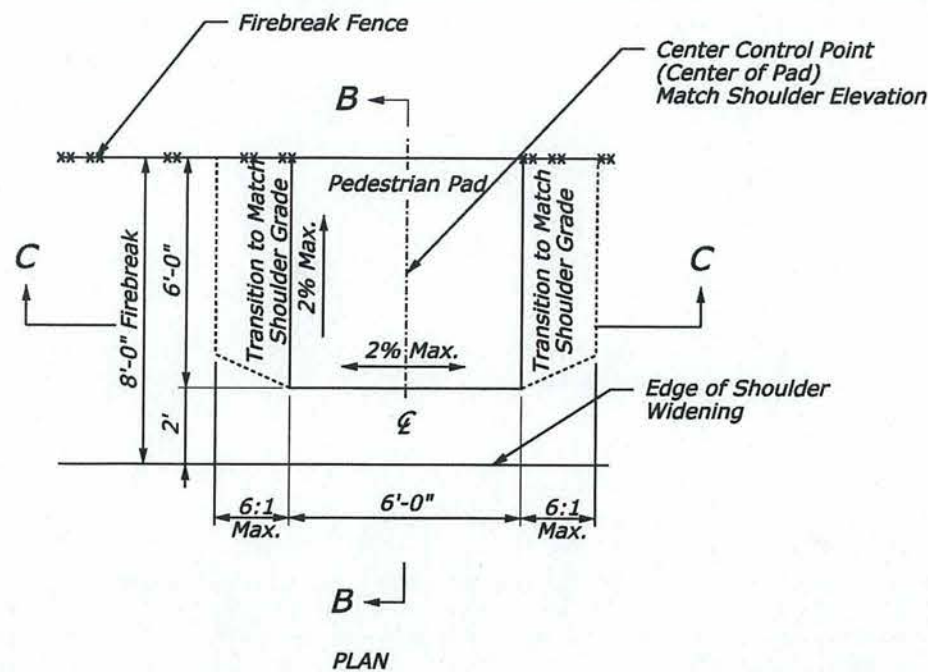


STATE	PROJECT	SHEET NO.	TOTAL SHEETS
HI	HI A-AD 6(7)	M1	M1

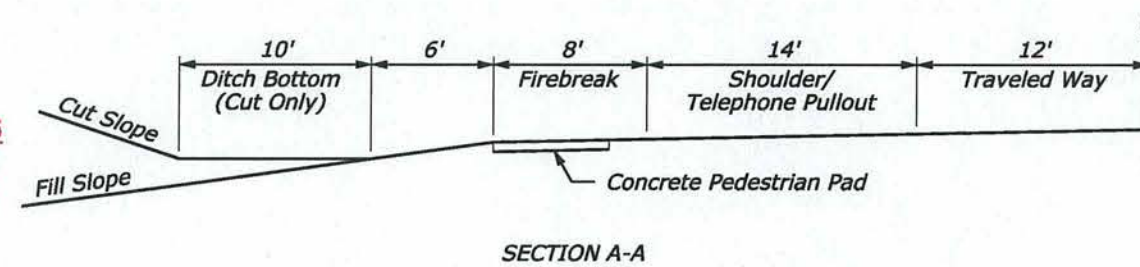


Notes:


1. Excavation, backfill, subbase, and welded wire fabric will be considered part of the concrete pad or hole foundation installation, and will not be measured for payment.
2. Use Class B concrete.
3. Complete backfill and adjacent surface improvements prior to installation of post.
4. Place 1/2" expansion joint material between the foundation and abutting concrete paving.

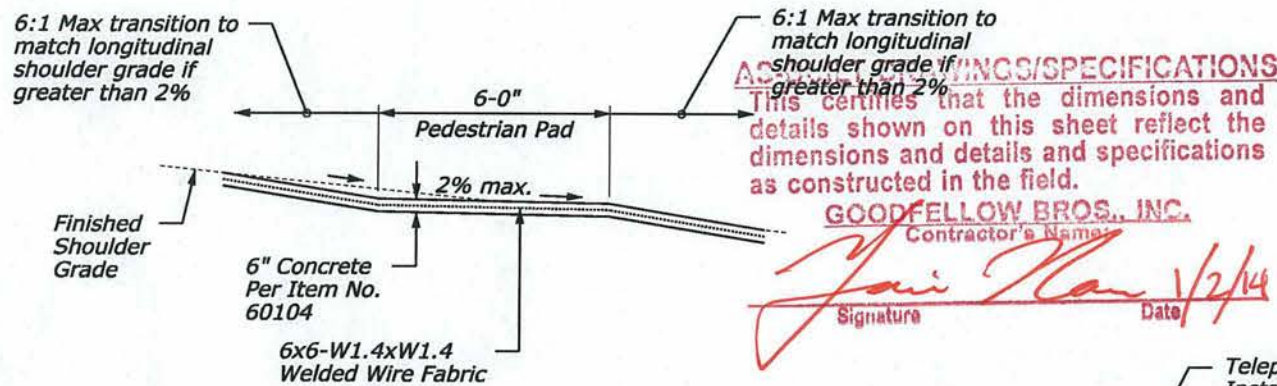


TELEPHONE PULLOUT AT FIREBREAK

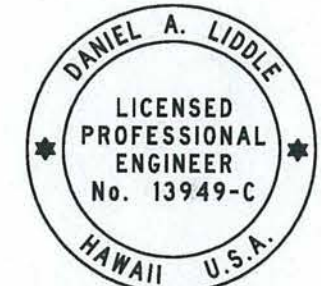

This work was prepared by me or under my supervision
Daniel A. Liddle
 Expiration Date of License 4/30/2014

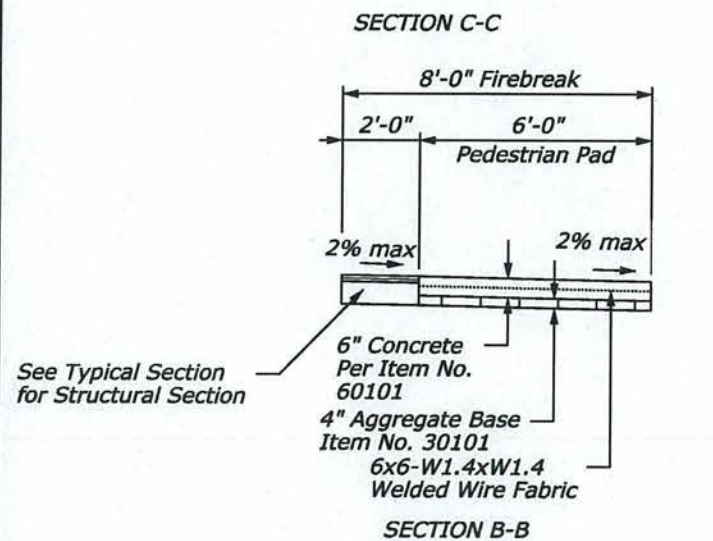


CONCRETE PEDESTRIAN PAD AT FIREBREAK FENCE

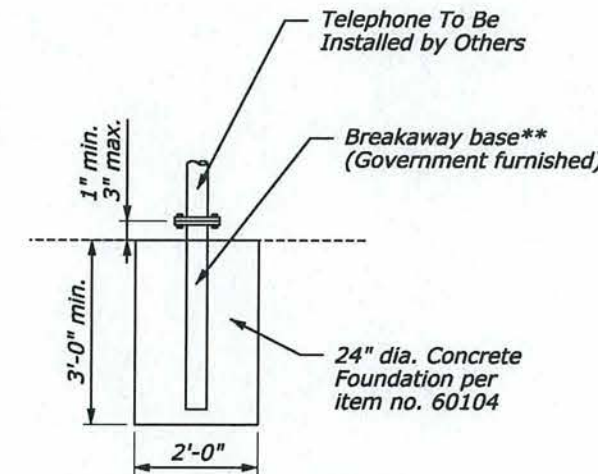


CAST IN DRILLED HOLE FOUNDATION

**Installation of breakaway base will not be measured for payment.

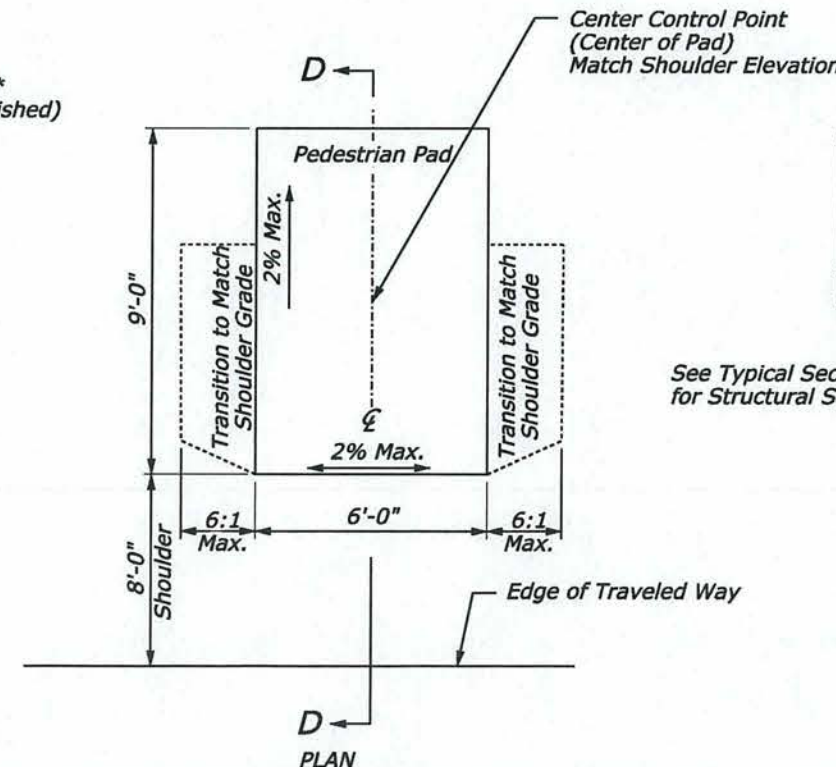

CONCRETE PEDESTRIAN PAD WITH NO FIREBREAK FENCE

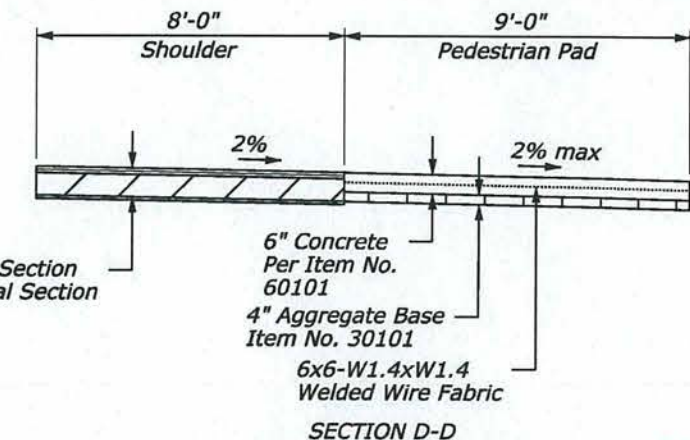

NOT INSTALLED

U.S. DEPARTMENT OF TRANSPORTATION
 FEDERAL HIGHWAY ADMINISTRATION
 CENTRAL FEDERAL LANDS HIGHWAY DIVISION
 U.S. CUSTOMARY SPECIAL

CONCRETE PEDESTRIAN PAD DETAILS

SPECIAL

601-01

NO SCALE