
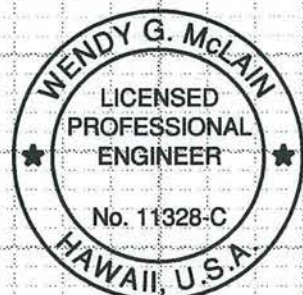


m:\2009\2009_057_001 ana saddle road west side bid pkg 21g dwgs\contract documents\civil\roadway\sheet\g-250\HI SR 200(00)_mp_dm_01.dgn
2:36:40 PM
9/21/2011

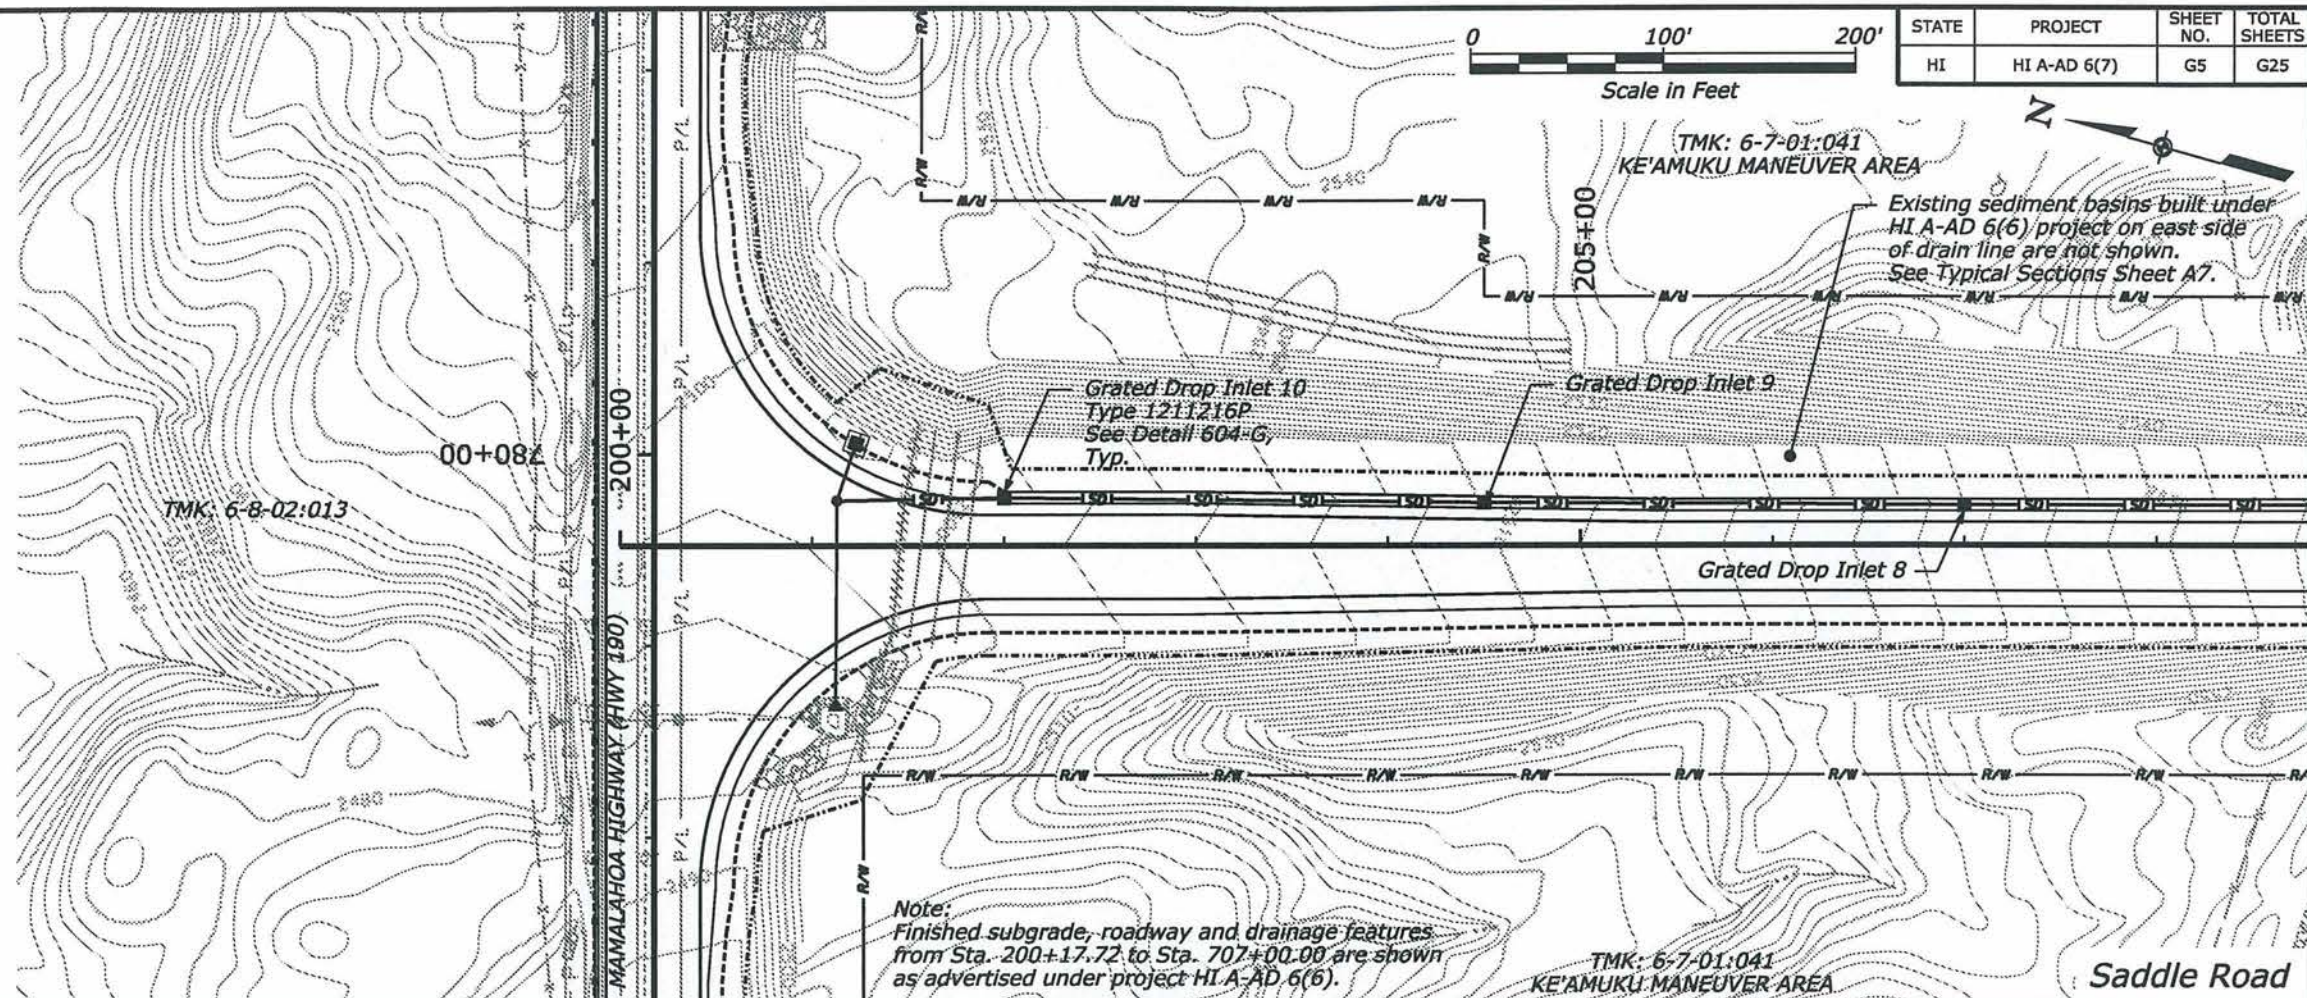


THIS WORK WAS PREPARED BY ME OR
UNDER MY SUPERVISION.
4/30/2012
EXPIRATION DATE
OF THE LICENSE


AS-BUILT DRAWINGS/SPECIFICATIONS
This certifies that the dimensions and
details shown on this sheet reflect the
dimensions and details and specifications
as constructed in the field.

GOODFELLOW BROS., INC.
Contractor's Name:


Signature: *[Signature]* Date: 1/2/14

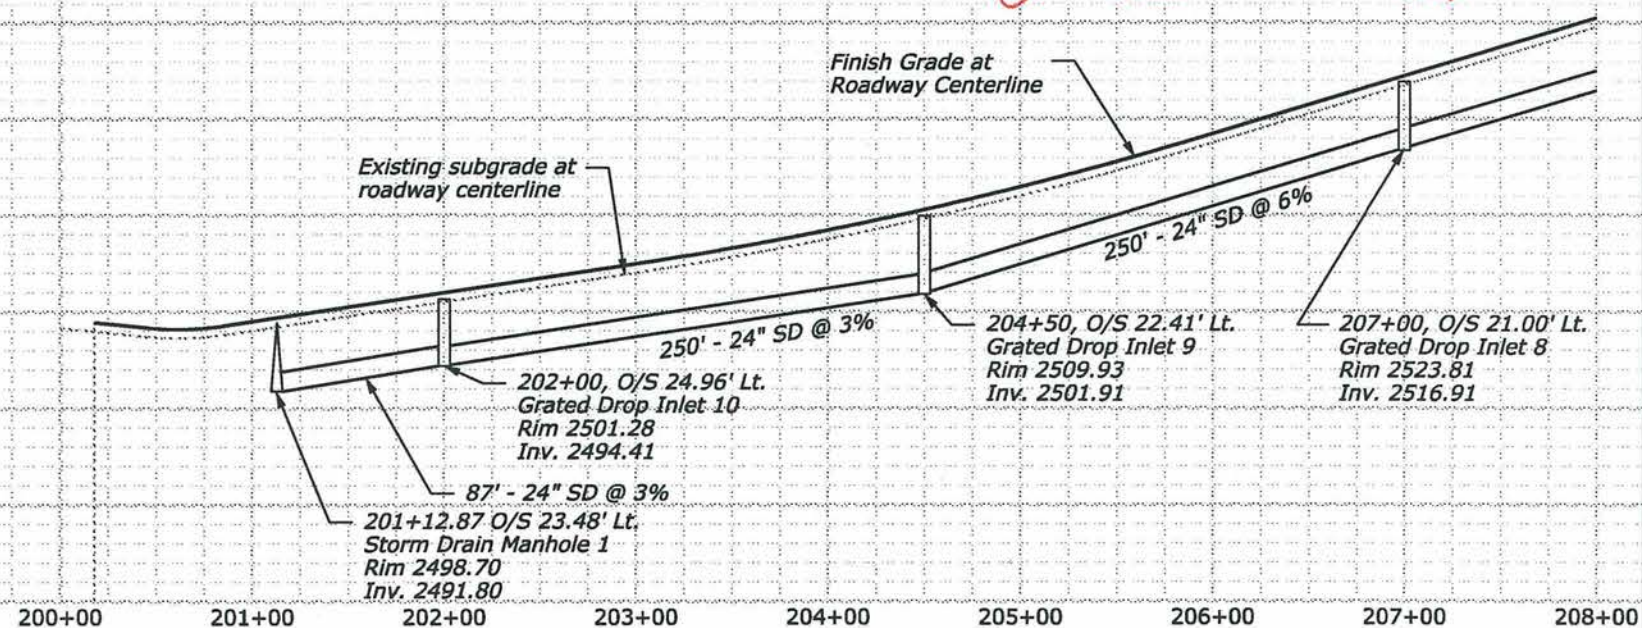

m:\2009\2009_057.001 ana saddle road west side bid pkg 21g dwgs\contract documents\civil\roadway\sheet g-250 HI SR 200(00).nwp dm. 02.dgn
9/21/2011 2:36:45 PM

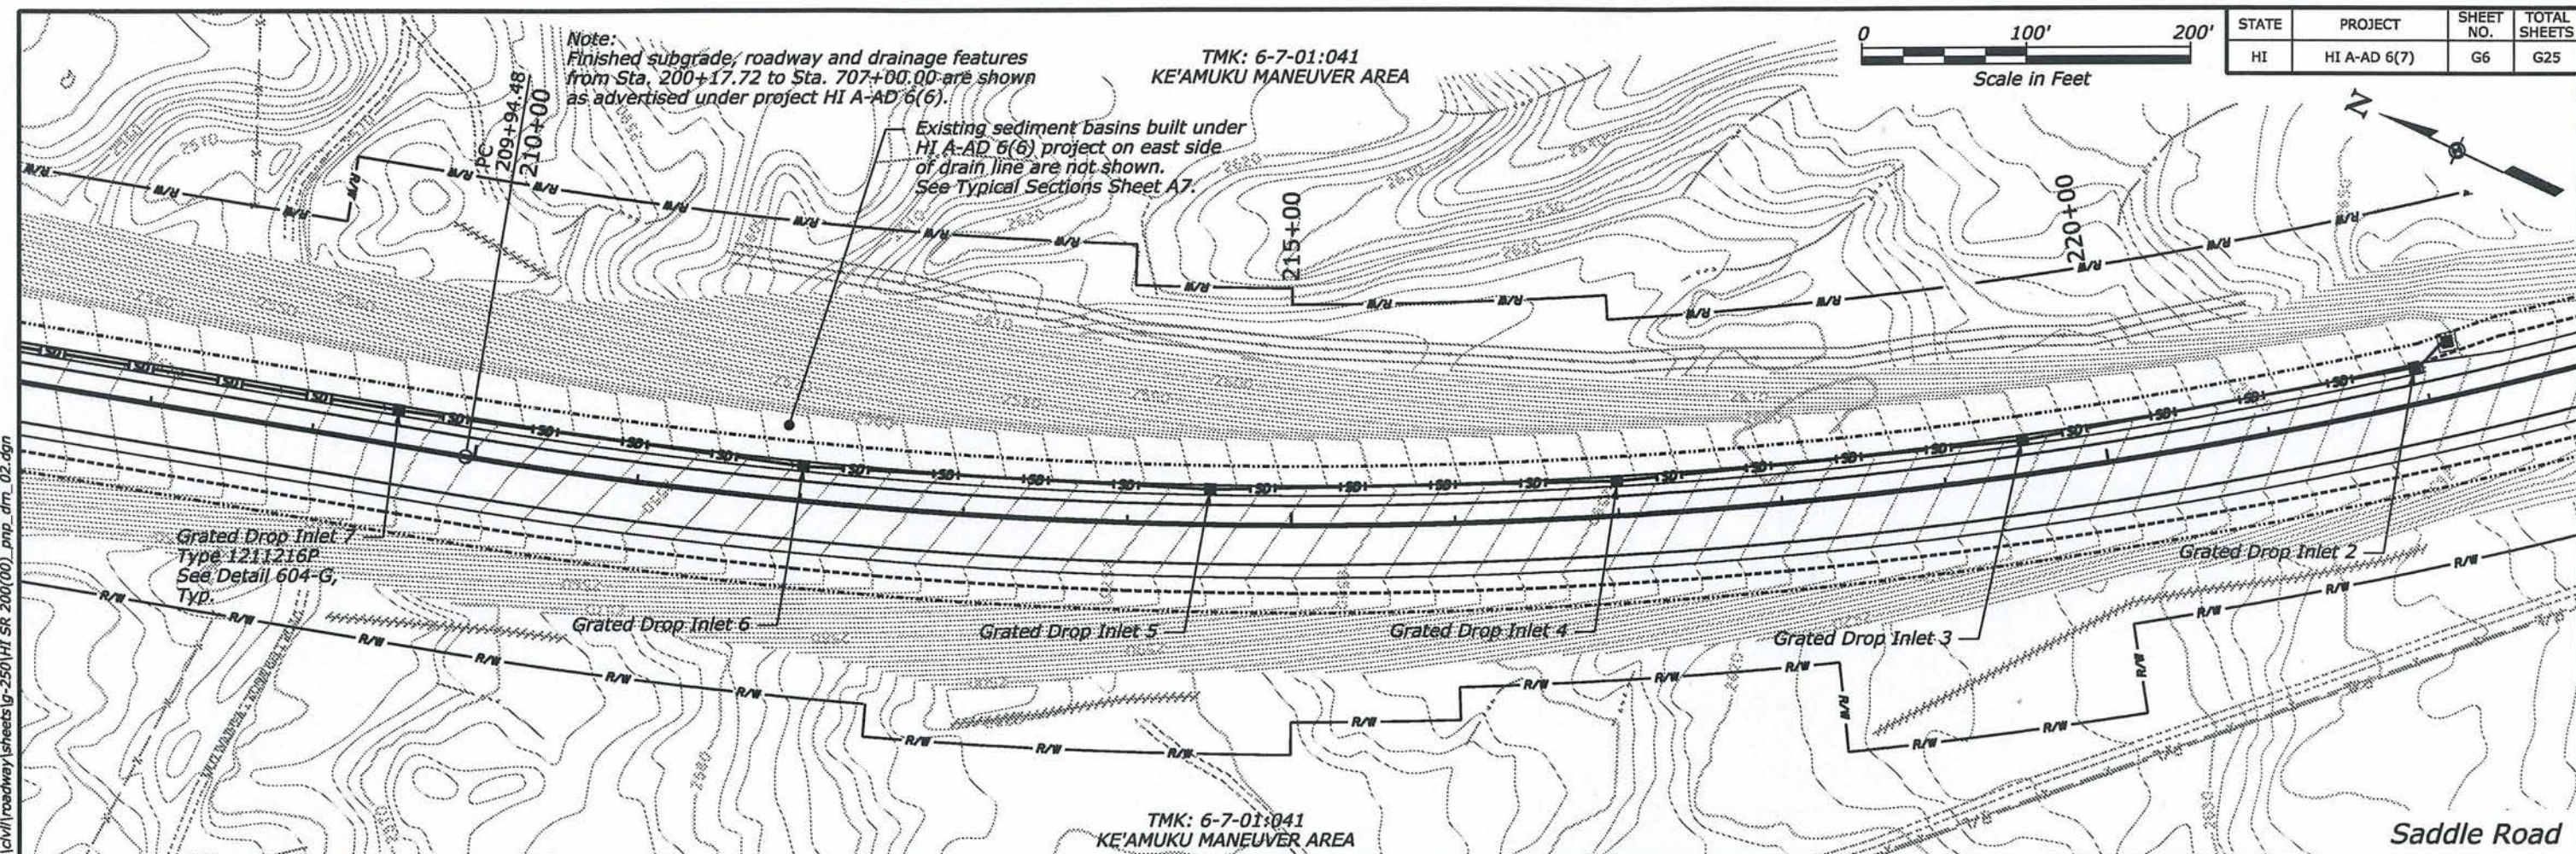

STATE	PROJECT	SHEET NO.	TOTAL SHEETS
HI	HI A-AD 6(7)	G6	G25

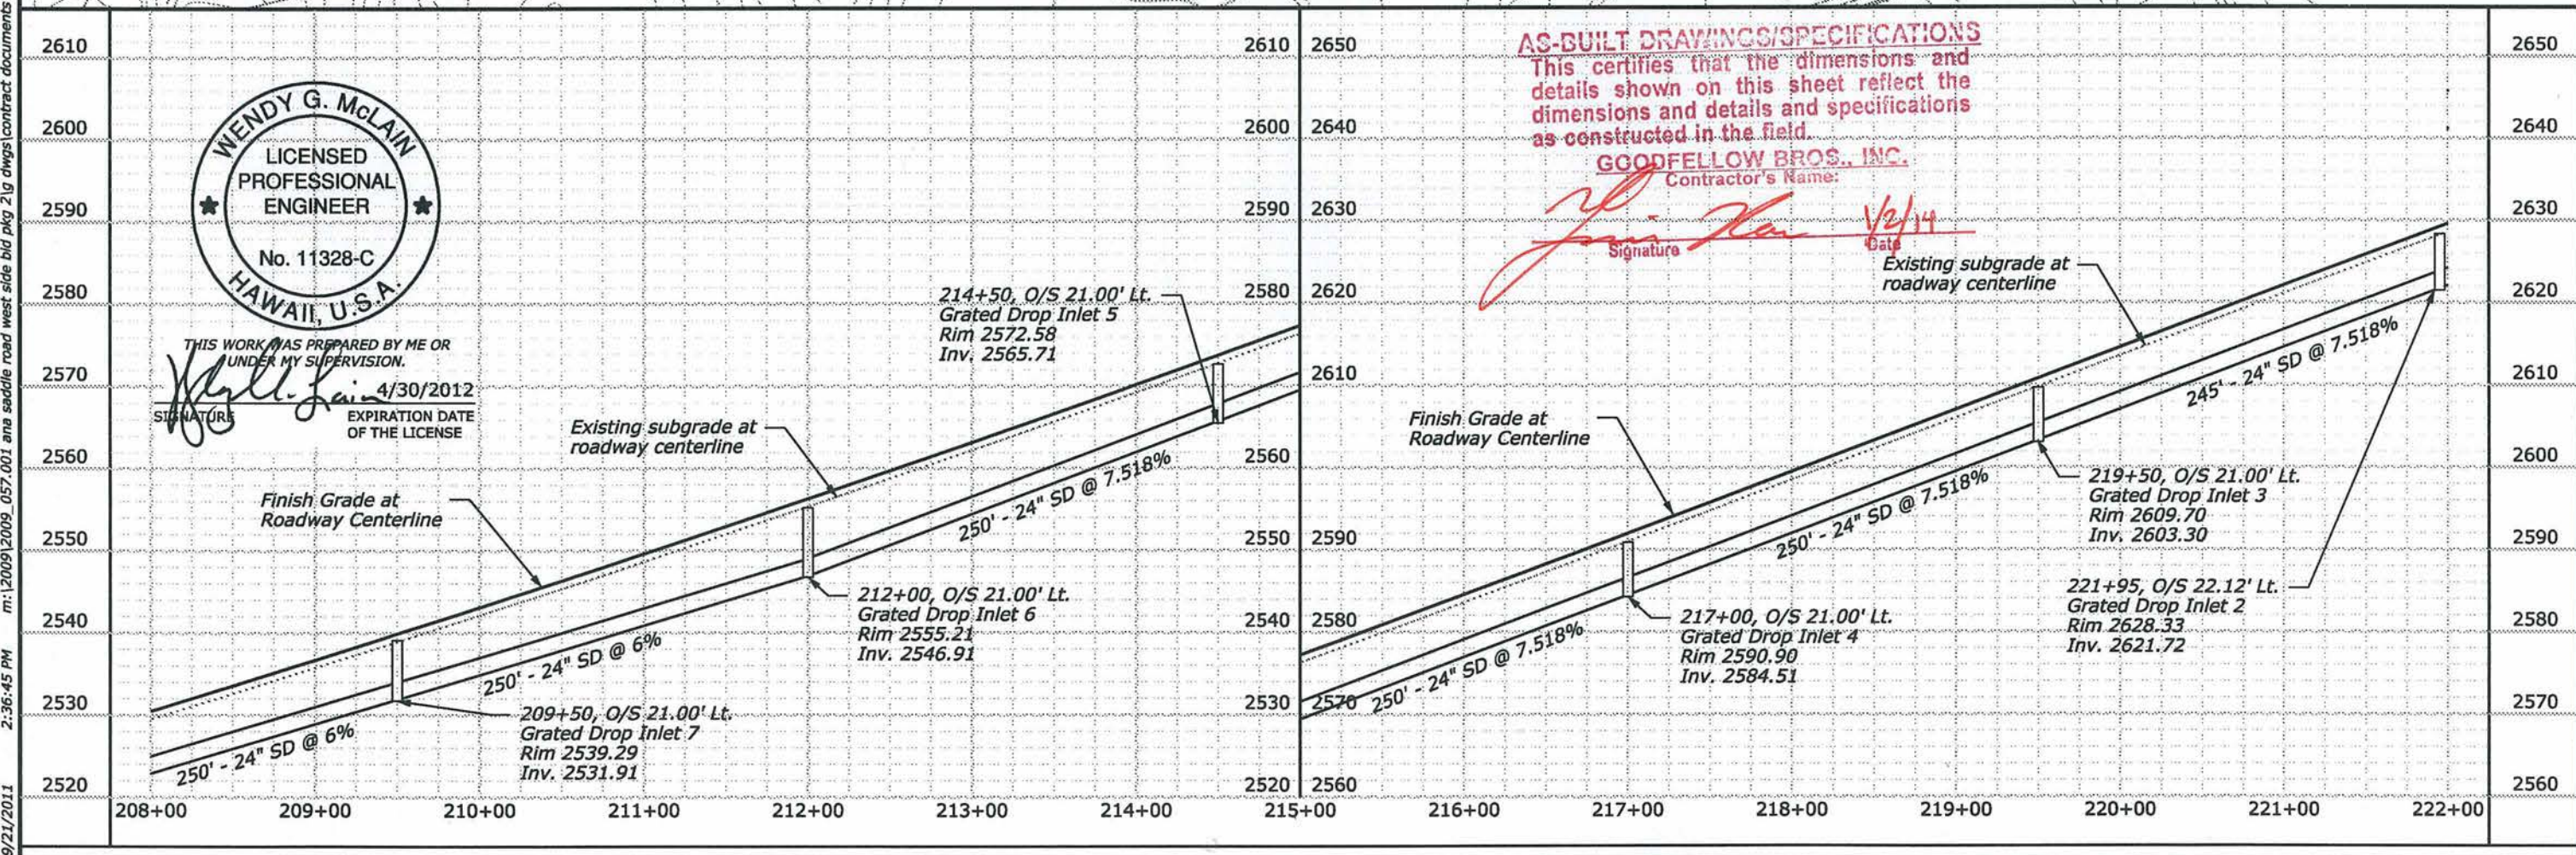

m:\2009\2009_057_001 ana saddle road west side bid pkg 2 lg dwgs contract documents\civil\roadway\sheet\G-250 HI SR 200(00).png dm_03.dgn
9/21/2011 2:36:52 PM

