

Rec'd 12/27/13

STATE	PROJECT	SHEET NO.	TOTAL SHEETS
HI	HI A-AD 6(7)	A1	A22

U.S. DEPARTMENT OF TRANSPORTATION FEDERAL HIGHWAY ADMINISTRATION

PLANS FOR PROPOSED HI A-AD 6(7) SADDLE ROAD - WEST SIDE DEFENSE ACCESS ROAD

AS-BUILT DRAWINGS/SPECIFICATIONS
This certifies that the dimensions and details shown on this sheet reflect the dimensions and details and specifications constructed in the field.

GOODFELLOW BROS., INC.
Contractor's Name:

[Signature] 1/2/14
Signature Date

SEE SHEET INDEX ON SHEET A2

Substantial Completion 09/03/13
All work Completed 11/18/13



This work was prepared by me or under my supervision
[Signature]
Expiration Date of License 4/30/2012

PLANS PREPARED BY:

ATKINS

FOR

U.S. DEPARTMENT OF TRANSPORTATION
FEDERAL HIGHWAY ADMINISTRATION
CENTRAL FEDERAL LANDS HIGHWAY DIVISION
DENVER, COLORADO



APPROVED:



[Signature]
DIRECTOR, HAWAII DEPARTMENT OF TRANSPORTATION

DATE: 11/01/11

APPROVED:

[Signature]
DIRECTOR OF ENGINEERING,
CENTRAL FEDERAL LANDS HIGHWAY DIVISION

DATE: 04 April 2012

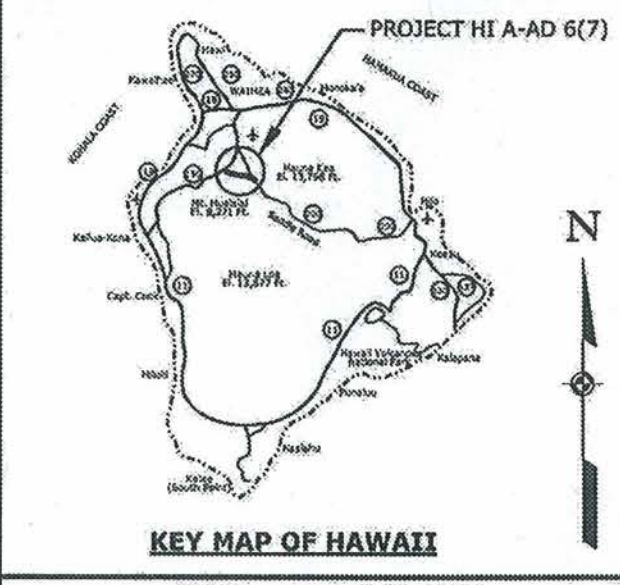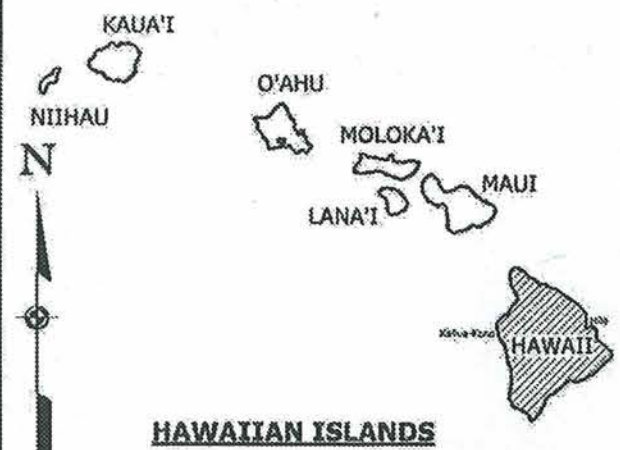

HAWAII COUNTY, HAWAII
LENGTH 10.47 miles

END CONSTRUCTION

HWY 190
STA. 795+11.02
M.P. 13.6

BEGIN CONSTRUCTION

HWY 190
STA. 763+62.54
M.P. 14.2

BEGIN PROJECT

HI A-AD 6(7)
SADDLE ROAD
STA. 200+17.72
M.P. 51.27

END PROJECT

HI A-AD 6(7)
SADDLE ROAD
STA. 752+73.89 - 753+90
M.P. 40.80

TYPE OF CONSTRUCTION:
Grading, Drainage, Bridge and
Hot Asphaltic Concrete Pavement

DESIGN DESIGNATIONS:

SADDLE ROAD - WEST SIDE HI A-AD 6(7)		Highway 190	
ADT (2011)	1700	ADT (2011)	7405
ADT (2031)	3600	ADT (2031)	9035
DHV	910	DHV	689
D	65/35	D	50/50
T	5%	T	5%
V	60 mph	V	50 mph
e(max)	8.0%	e(max)	N/A

U.S. CUSTOMARY DIMENSIONS:
Slopes are expressed as RISE:RUN

SPECIFICATIONS:
"STANDARD SPECIFICATIONS FOR CONSTRUCTION OF ROADS
AND BRIDGES ON FEDERAL HIGHWAY PROJECTS, FP-03,
U.S. CUSTOMARY UNITS"

CALL BEFORE YOU DIG:
Hawaii One-Call
1-866-423-7287



0 1 2 3
Scale in Miles

9/29/2011 2:34:29 PM S:\Transport\100013746-SR\HwyDes\Roadway\Sheets_Bld_Package_2\A-Gen_Sht\HI SR 200(00)_TITLE.dgn