


REGION	STATE	PROJECT	SHEET NO.	TOTAL SHEETS
	HI	HI A-AD 6(7)	S2	S16

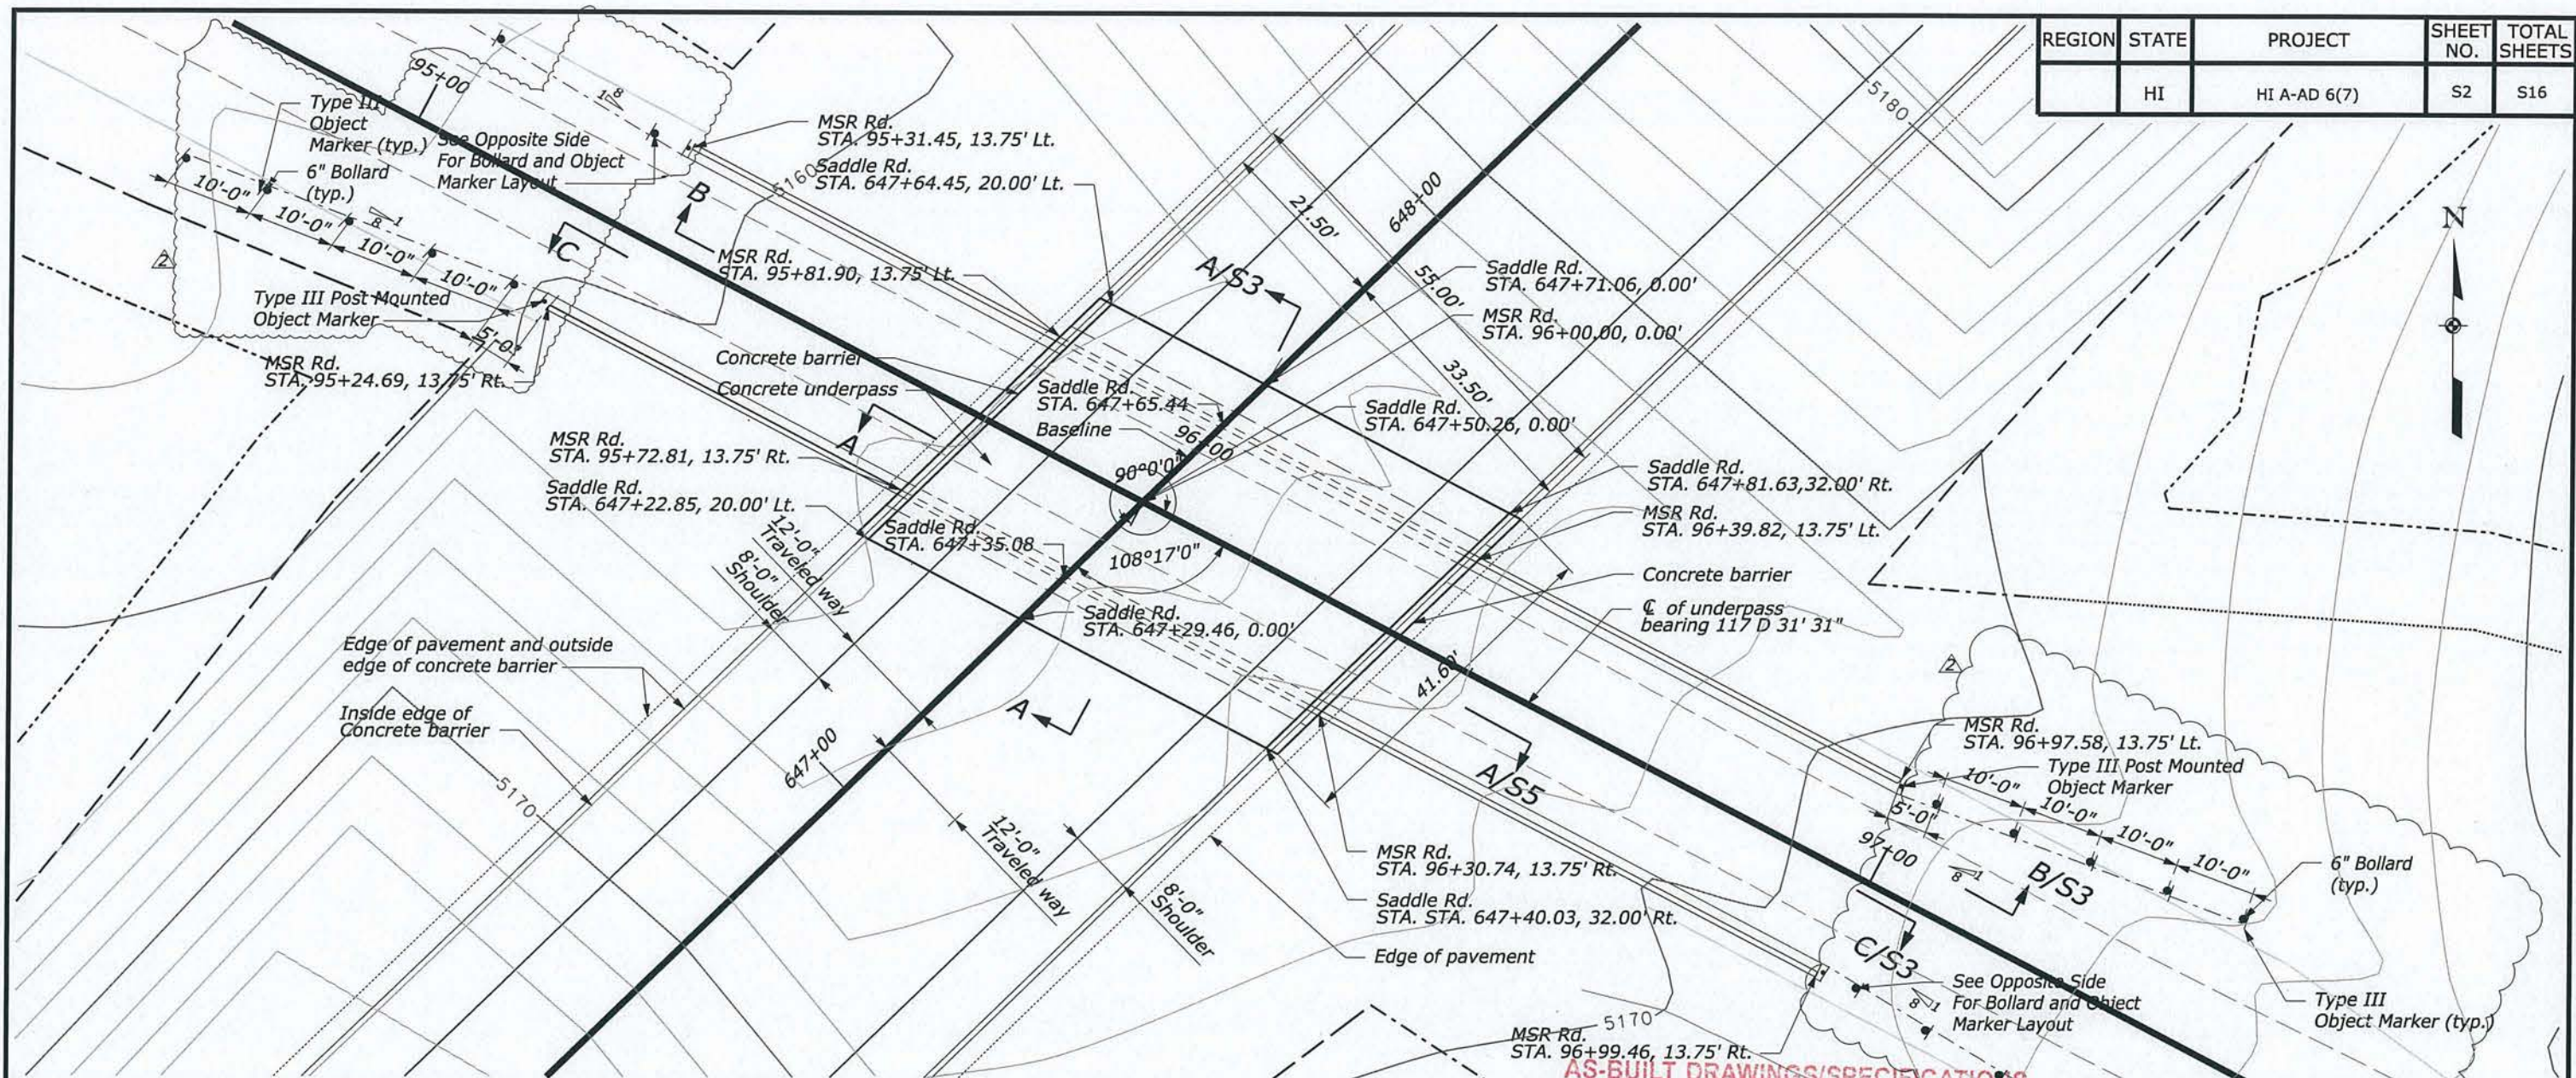

AS-BUILT DRAWINGS/SPECIFICATIONS
This certifies that the dimensions and details shown on this sheet reflect the dimensions and details and specifications as constructed in the field.

GOODFELLOW BROS., INC.
Contractor's Name:

Signature: *[Signature]* Date: 1/2/14



This work was prepared by me or under my supervision


Expiration Date License 4/30/2014

0 20' 40'
Scale in Feet

U.S. DEPARTMENT OF TRANSPORTATION
FEDERAL HIGHWAY ADMINISTRATION
CENTRAL FEDERAL LANDS HIGHWAY DIVISION

UNDERPASS LAYOUT PLAN

UNDERPASS DECK LAYOUT PLAN

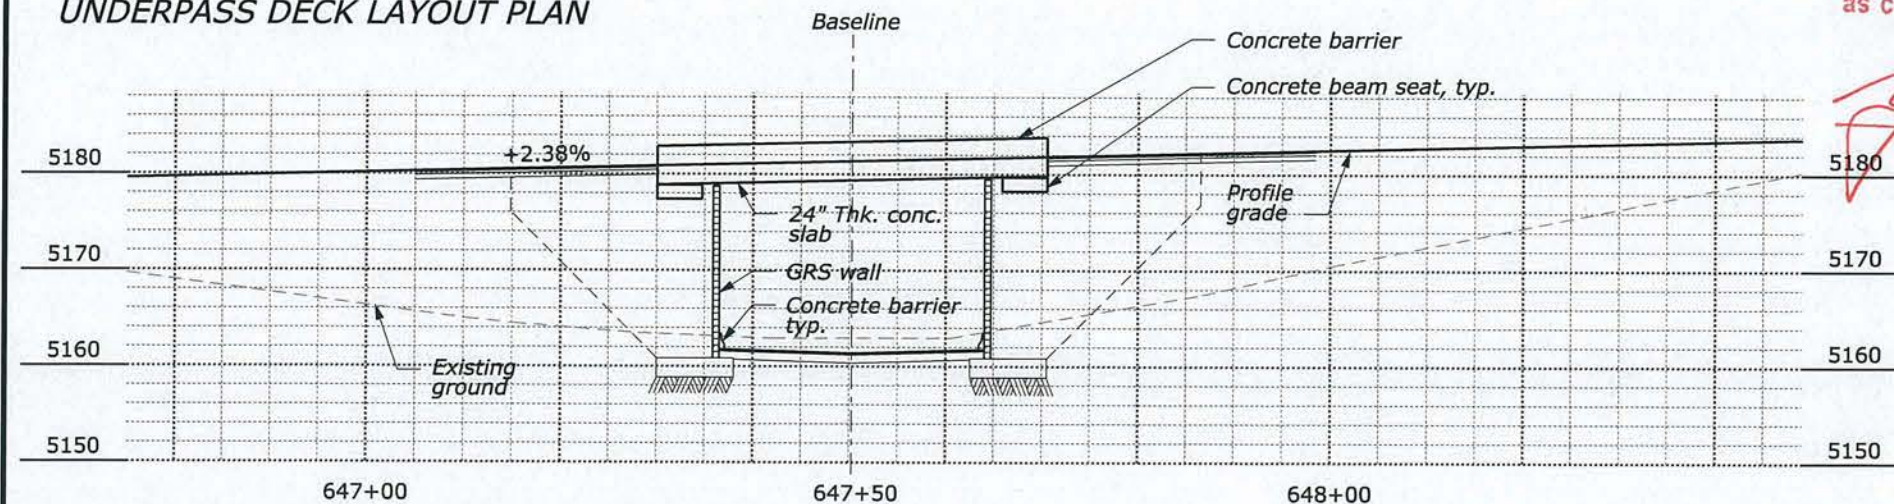

ROADWAY PROFILE GRADE DIAGRAM

NO.	DATE	BY	REVISIONS	NO.	DATE	BY	REVISIONS	DESIGNED BY	DRAWN BY	CHECKED BY	SCALE	PROJECT TEAM LEADER	BRIDGE DRAWING	DATE	DRAWING NO.
2	7/19/2013	NS	PCD-2 - DELETED CONCRETE BARRIER AND ADDED 6" BOLLARD					R. GARCIA	N. SARIO	B. HAYASHI	AS SHOWN		2 of 16	March 2013	