



## HEIGHT AND LATERAL LOCATION OF SIGN

### GENERAL NOTES



- Sign shall be installed in conformance with the latest edition of Federal Highway Administration Manual on Uniform Traffic Control Devices (MUTCD), as amended or supplemented by the contract documents.
- The minimum lateral and vertical clearances are guidelines and shall be exceeded whenever practical. Sign shall be installed as consistent as possible with other existing and new signs to create an overall coordinated appearance that best command road users' attention and respect.
- Unless otherwise shown, sign shall be vertically mounted at right angles to the direction of, and facing, the traffic that they are intended to serve. On curved alignment, the angle of placement should be determined by the direction of approaching traffic rather than by the roadway edge at the point where the sign is located.
- Sign with arrow denoting extent of restrictive zone, such as parking, shall be mounted 45 degrees to the line of traffic flow.
- Reference location sign may be moved in either direction as much as 50 feet when approved by the Engineer.

<p>The work was prepared by me or under my supervision and construction of this project will be under my observation.</p> <p><i>Bruce E. Meyers</i></p> <p>Expiration Date of License 3/15.</p>	<p>U.S. DEPARTMENT OF TRANSPORTATION FEDERAL HIGHWAY ADMINISTRATION CENTRAL FEDERAL LANDS HIGHWAY DIVISION</p> <p><b>HDOT STD PLAN TE-01</b></p> <p><b>SIGN HEIGHT AND LOCATION</b></p>
	<p>Scale: N/A</p> <p>Date: August 21, 2015</p>
	<p>SHEET No. 1 OF 1</p>
	<p>P17</p>

STATE	SADDLE ROAD PROJECT	SHEET NO.	TOTAL SHEETS
HI	HI SR 200(3)	P18	P40

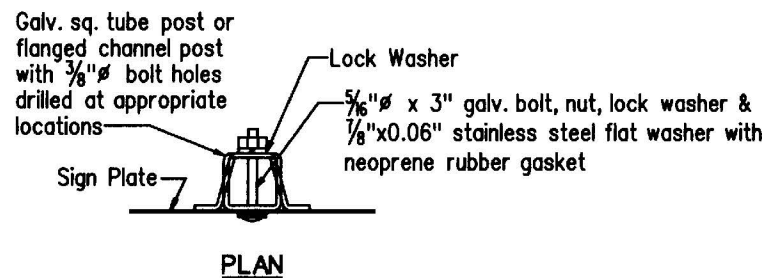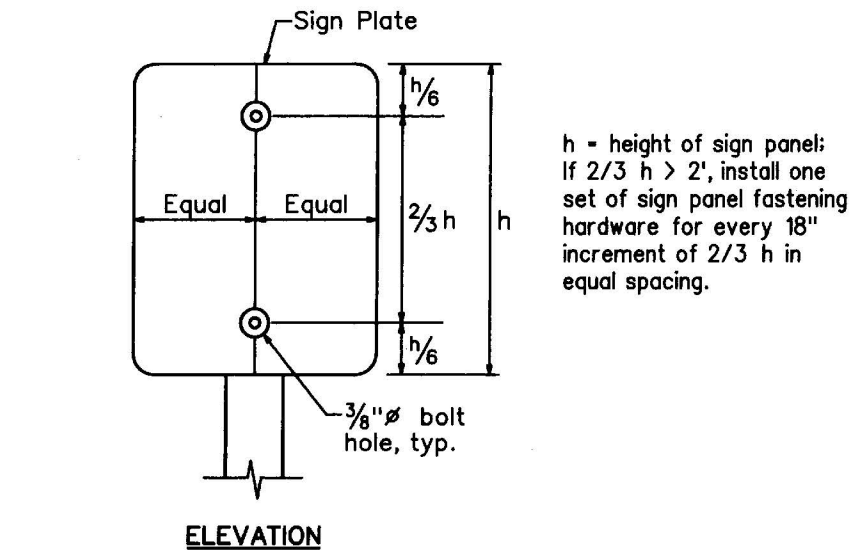

## POST MOUNTING INSTALLATION

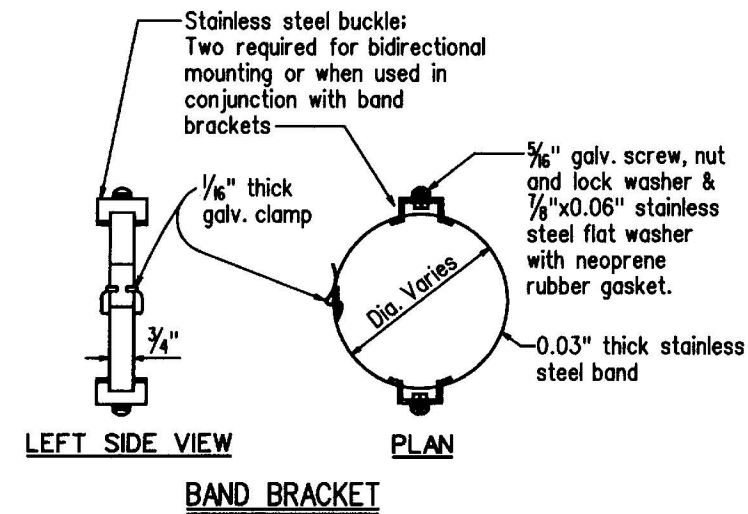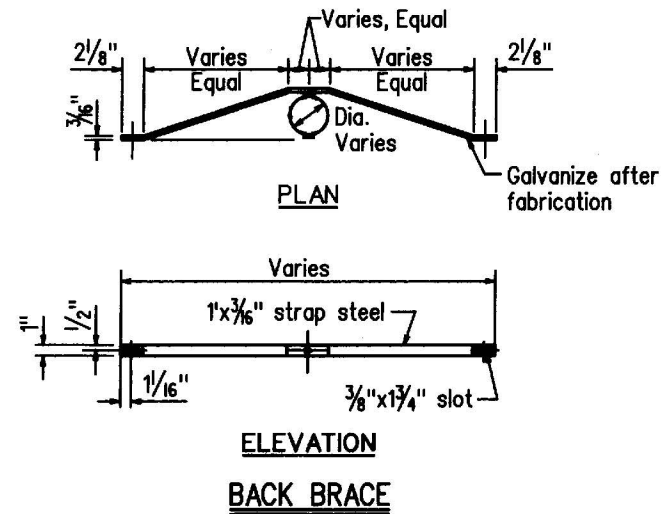

## POLE MOUNTING INSTALLATION


### GENERAL NOTES

- Sign message, color, size, shape and reference shall be in conformance with the latest edition of Federal Highway Administration Standard Highway Signs (SHS), as amended or supplemented by the contract documents.
- Sign post shall not exceed top of sign except where street name sign is attached above it. Where street name sign is required, sign post shall extend  $3/2"$  above top of sign to accommodate street name sign post cap.
- Unless otherwise shown, signs of unequal shape and size shall not be mounted back to back.
- Signs sharing same post(s) shall not be overlapped. Each sign shall have on its own a minimum of two sets of fastening hardware per post. Maintain 1" clearance between signs.
- Sign with lateral overhang more than 2' shall be installed with back brace or other support assembly approved by the Engineer.
- Sign may be mounted on highway lighting or traffic signal poles as follows:
  - Sign less than 10 square feet in area shall be installed with two sets of band brackets.
  - Sign between 10 and 28 square feet shall be installed with two sets of band brackets and back braces.
  - Sign larger than 28 square feet shall be reviewed and approved in writing by the Engineer prior to installation.
- Anchor base shall be required for all sign post installations in accordance with the related Standard Plans sign mounting details.
- Sign shall be installed with the required number of post(s), material and frame stiffeners in accordance with the related Standard Plans sign mounting details.

<p>The work was prepared by me or under my supervision and construction of this project will be under my observation.</p> <p><i>Bruce E. Meyers</i></p> <p>Expiration Date of License 2/15.</p>	U.S. DEPARTMENT OF TRANSPORTATION FEDERAL HIGHWAY ADMINISTRATION CENTRAL FEDERAL LANDS HIGHWAY DIVISION
	<b>HDOT STD PLAN TE-01A</b> <b>SIGN INSTALLATION</b>
	Scale: N/A Date: August 21, 2015
SHEET No. 1 OF 1	


GENERAL NOTES


1. **Design Specifications:**
- (A) Design shall conform w/ the latest AASHTO Standard Specifications for the Structural Supports for Highway Signs, Luminaires & Traffic Signals and its interim supplements and modifications by the Highways Division, Department of Transportation State of Hawaii.
- (B) Latest HDOT Memorandum with subject title "Design Criteria for Bridges and Structures."
2. **Loads:**
- (A) Basic Wind Speed: 105 mph.
- (B) Recurrence Interval of 10 years.
3. **Materials:**
- (A) Post shall conform to the Standard Specifications.
- (B) Post shall be zinc coated after fabrication in accordance with ASTM A-123.
- (C) All connection bolts shall be AASHTO M164 bolts and anchor bolts shall be AASHTO M314-105 bolt.
- (D) Lap splice nuts and bolts shall be M180, with an ultimate tensile strength of 180 ksi, min.
- (E) Aluminum members and surfaces in contact with structural steel shall be isolated with neoprene material as approved by the Engineer.
4. **General:**
- (A) See B-01, TE-01, TE-02B and TE-02C for additional information.
- (B) All accessories, fittings, connection details, and stiffener details (as required) shall be designed for the loads specified in the General Notes and submitted to the Engineer for approval 20 days prior to installation.
- (C) Alternate designs in accordance with the plans and specifications shall use the Service Load Design Method and shall be stamped by a registered engineer of the State of Hawaii in the related discipline and submitted to the Engineer for approval.
- (D) All sign support posts shall be outside of the clear zone or shielded by an appropriate traffic barrier system. The traffic barrier system shall be submitted to the Engineer for his approval.
- (E) The Contractor shall use templates while installing the anchor bolts. Anchor bolts shall be vertical.
- (F) Excavation and backfill costs shall be considered incidental to the cost of the sign foundation.
- (G) Sign post shall be punched their full length with  $\frac{3}{8}$ " holes on 1" centers.
- (H) Base post shall be punched with a minimum of thirty-six  $\frac{3}{8}$ " dia. holes on 1" centers with the first hole 1" from the top.
- (J) Base post shall be driven to a minimum embedment as shown on sheet TE-02C. The base post may protrude a maximum of 4" above the surrounding ground surface.
- (K) Base post damaged or deformed in the splice contact area shall be repaired or replaced at no additional cost to the State. Drive cap shall be used as required.

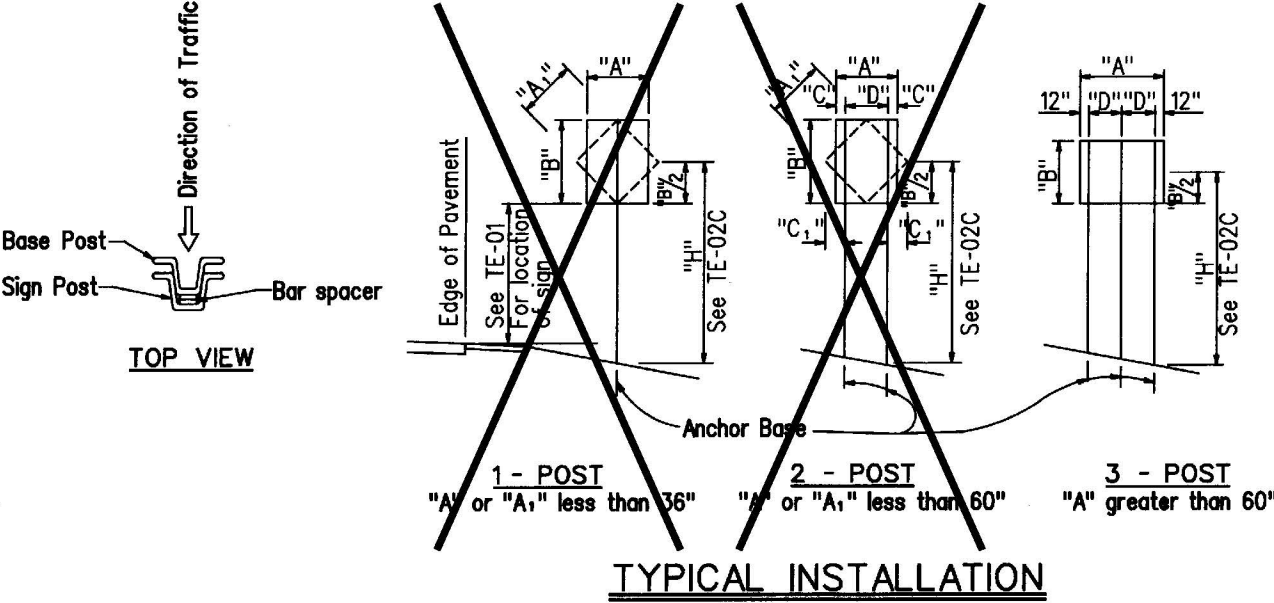

"A" or "A <sub>1</sub> "	"C"	"C <sub>1</sub> "
Less than 36"	6"	-
Greater than 36" and less than 48"	9"	19"
Greater than 48"	12"	24"


NOTE: Frame stiffeners are required when "D" is greater than 24". See General Notes.

 <p>The work was prepared by me or under my supervision and construction of this project will be under my observation.</p> <p><i>Bruce E. Meyers</i></p> <p>Expiration Date of License 4/15.</p>	<p>U.S. DEPARTMENT OF TRANSPORTATION FEDERAL HIGHWAY ADMINISTRATION CENTRAL FEDERAL LANDS HIGHWAY DIVISION</p> <p><b>HDOT STD PLAN TE-02A</b> <b>GALVANIZED FLANGED CHANNEL</b> <b>SIGN POST MOUNTING</b></p>	
	<p>Scale: N/A</p>	<p>Date: August 21, 2015</p>
	<p>SHEET No. 1 OF 1</p>	
	<p>P19</p>	

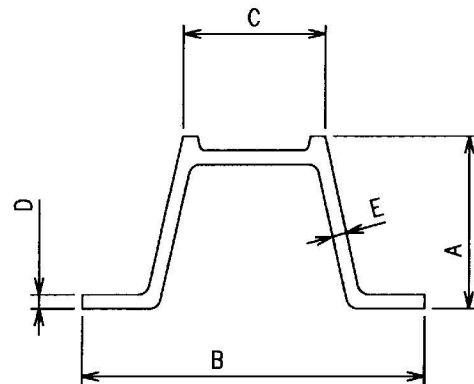


Post Size	Area (in <sup>2</sup> )	I (in <sup>4</sup> )	S (in <sup>3</sup> )	A (in.)	B (in.)	C (in.)	D (in.)	E (in.)
2.50 lbs./ft.	0.70	0.21	0.25	1.516	3.062	1.278	0.176	0.117
4.00 lbs./ft.	1.11	0.54	0.47	1.968	3.500	1.336	0.272	0.143

**Note**  
The contractor shall submit shop drawings and catalog cuts to the Engineer for approval.

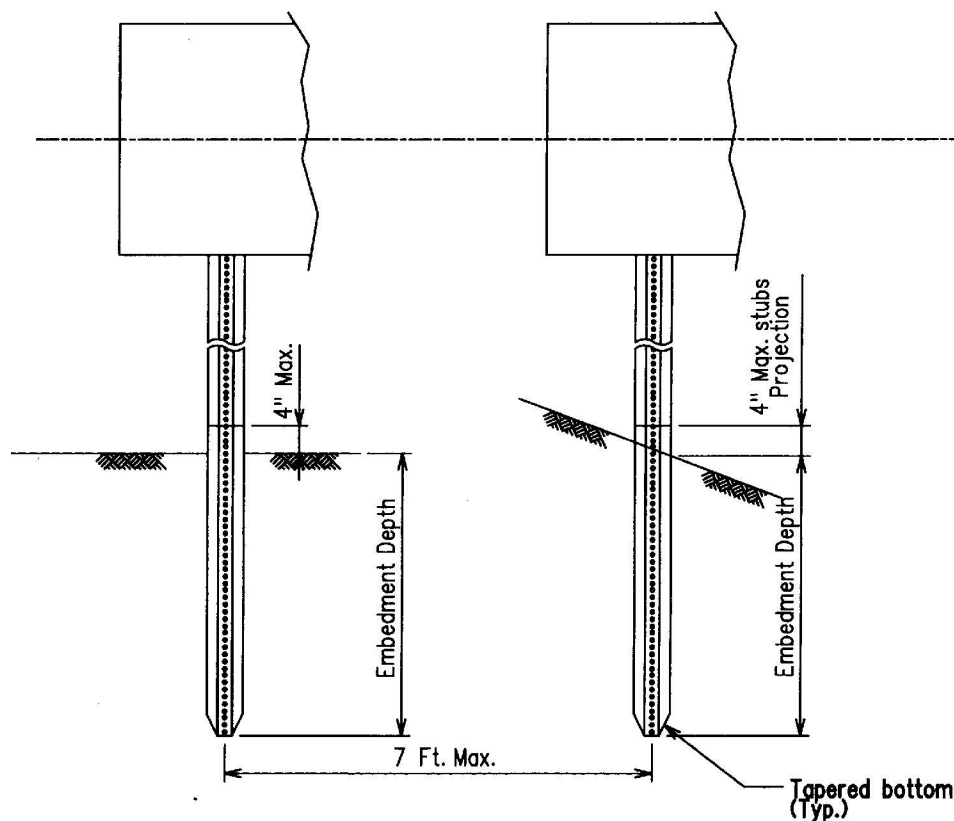


## EMBEDMENT DETAILS

**NOTE:**  
Three posts allowed within 7 feet swath.

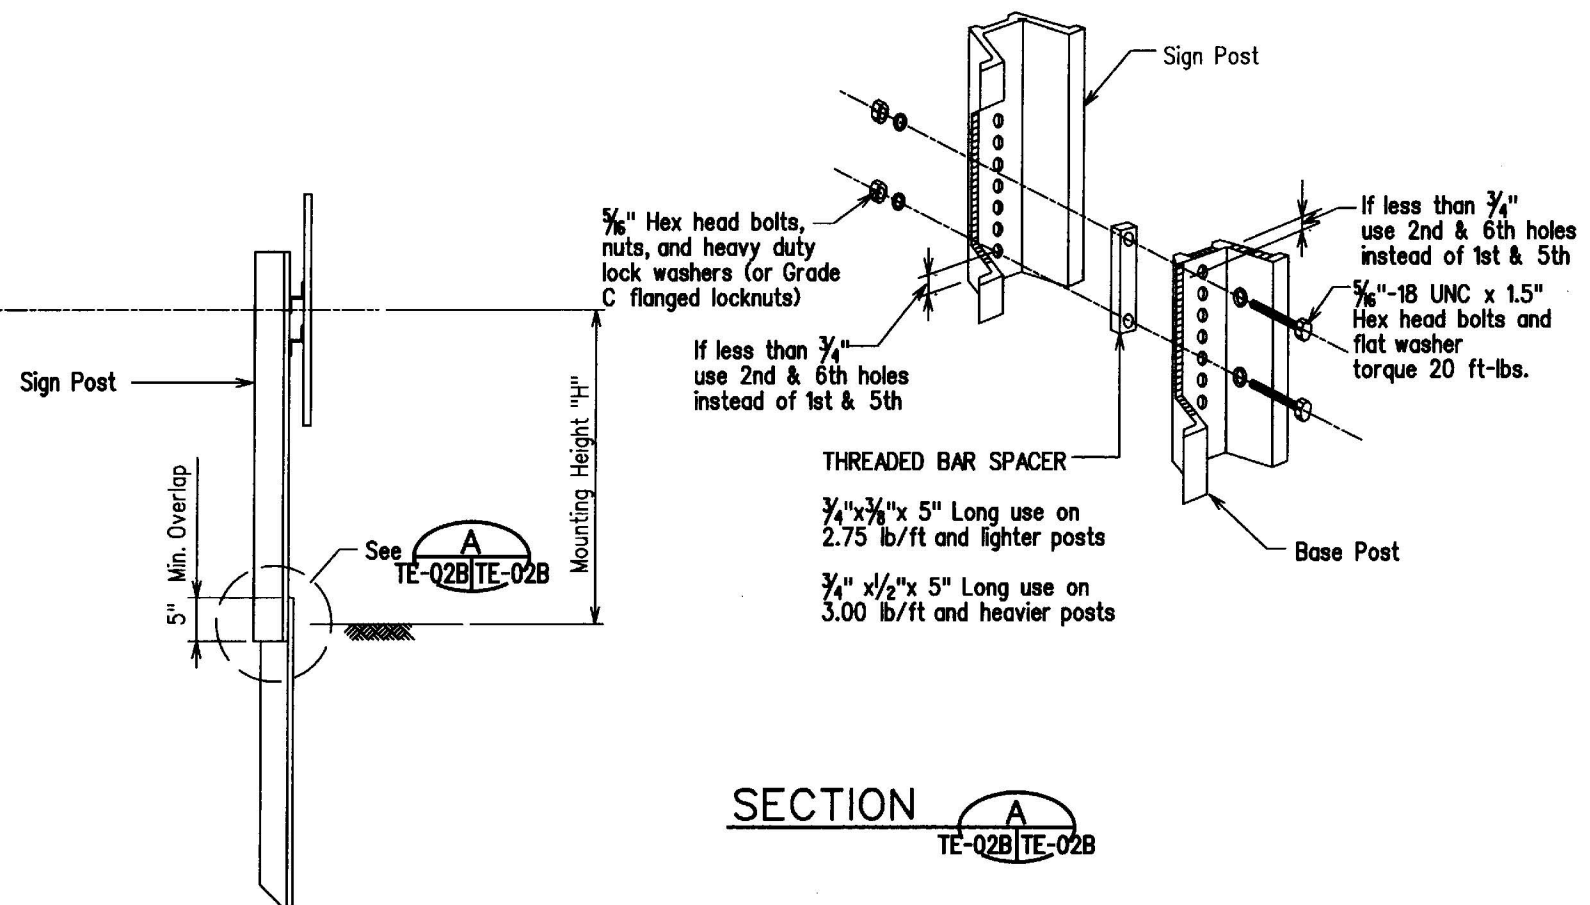

## SECTION A TE-02B TE-02B

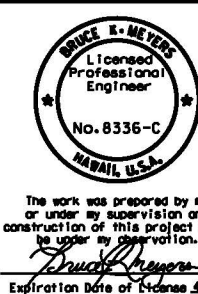

U.S. DEPARTMENT OF TRANSPORTATION FEDERAL HIGHWAY ADMINISTRATION CENTRAL FEDERAL LANDS HIGHWAY DIVISION	
<b>HDOT STD PLAN TE-02B</b> <b>GALVANIZED FLANGED CHANNEL</b> <b>SIGN POST MOUNTING</b>	
Scale: N/A	Date: August 21, 2015
SHEET No. 1 OF 1	



FLANGED CHANNEL: 1-POST INSTALLATION - STIFF CLAY												
Post Size W	"H" - Ground Level to Midpoint (ft.)											
	7		8		9		10		11		12	
	Sign Area (Sq.Ft.)	Embed. Depth (Ft.)	Sign Area (Sq.Ft.)	Embed. Depth (Ft.)	Sign Area (Sq.Ft.)	Embed. Depth (Ft.)	Sign Area (Sq.Ft.)	Embed. Depth (Ft.)	Sign Area (Sq.Ft.)	Embed. Depth (Ft.)	Sign Area (Sq.Ft.)	Embed. Depth (Ft.)
2.50 lbs./ft.	6	3.17	5	3.17	4	3.17	4	3.17	3	3.17	2	3.17
4.00 lbs./ft.	-	-	-	-	-	-	7	4	7	4	6	4

FLANGED CHANNEL: 1-POST INSTALLATION - SAND AND GRAVEL												
Post Size W	"H" - Ground Level to Midpoint (ft.)											
	7		8		9		10		11		12	
	Sign Area (Sq.Ft.)	Embed. Depth (Ft.)	Sign Area (Sq.Ft.)	Embed. Depth (Ft.)	Sign Area (Sq.Ft.)	Embed. Depth (Ft.)	Sign Area (Sq.Ft.)	Embed. Depth (Ft.)	Sign Area (Sq.Ft.)	Embed. Depth (Ft.)	Sign Area (Sq.Ft.)	Embed. Depth (Ft.)
2.50 lbs./ft.	6	6.5	5	6	4	5.5	4	5.5	3	5	2	4.5
4.00 lbs./ft.	-	-	-	-	-	-	7	7	7	7	6	7

FLANGED CHANNEL: 2-POST INSTALLATION - STIFF CLAY												
Post Size W	"H" - Ground Level to Midpoint (ft.)											
	7		8		9		10		11		12	
	Sign Area (Sq.Ft.)	Embed. Depth (Ft.)	Sign Area (Sq.Ft.)	Embed. Depth (Ft.)	Sign Area (Sq.Ft.)	Embed. Depth (Ft.)	Sign Area (Sq.Ft.)	Embed. Depth (Ft.)	Sign Area (Sq.Ft.)	Embed. Depth (Ft.)	Sign Area (Sq.Ft.)	Embed. Depth (Ft.)
2.50 lbs./ft.	11	3.17	10	3.17	9	3.17	8	3.17	7	3.17	6	3.17
4.00 lbs./ft.	25	3.17	22	3.17	20	3.17	18	3.17	16	3.17	14	3.17

FLANGED CHANNEL: 2-POST INSTALLATION - SAND AND GRAVEL												
Post Size W	"H" - Ground Level to Midpoint (ft.)											
	7		8		9		10		11		12	
	Sign Area (Sq.Ft.)	Embed. Depth (Ft.)	Sign Area (Sq.Ft.)	Embed. Depth (Ft.)	Sign Area (Sq.Ft.)	Embed. Depth (Ft.)	Sign Area (Sq.Ft.)	Embed. Depth (Ft.)	Sign Area (Sq.Ft.)	Embed. Depth (Ft.)	Sign Area (Sq.Ft.)	Embed. Depth (Ft.)
2.50 lbs./ft.	11	3.17	10	3.17	9	3.17	8	3.17	7	3.17	6	3.17
4.00 lbs./ft.	25	4	22	4	20	4	18	4	16	4	14	4

FLANGED CHANNEL: 3-POST INSTALLATION - STIFF CLAY												
Post Size W	"H" - Ground Level to Midpoint (ft.)											
	7		8		9		10		11		12	
	Sign Area (Sq.Ft.)	Embed. Depth (Ft.)	Sign Area (Sq.Ft.)	Embed. Depth (Ft.)	Sign Area (Sq.Ft.)	Embed. Depth (Ft.)	Sign Area (Sq.Ft.)	Embed. Depth (Ft.)	Sign Area (Sq.Ft.)	Embed. Depth (Ft.)	Sign Area (Sq.Ft.)	Embed. Depth (Ft.)
2.50 lbs./ft.	19	3.17	16	3.17	14	3.17	12	3.17	10	3.17	8	3.17
4.00 lbs./ft.	37	3.17	32	3.17	28	3.17	24	3.17	22	3.17	20	3.17

FLANGED CHANNEL: 3-POST INSTALLATION - SAND AND GRAVEL												
Post Size W	"H" - Ground Level to Midpoint (ft.)											
	7		8		9		10		11		12	
	Sign Area (Sq.Ft.)	Embed. Depth (Ft.)	Sign Area (Sq.Ft.)	Embed. Depth (Ft.)	Sign Area (Sq.Ft.)	Embed. Depth (Ft.)	Sign Area (Sq.Ft.)	Embed. Depth (Ft.)	Sign Area (Sq.Ft.)	Embed. Depth (Ft.)	Sign Area (Sq.Ft.)	Embed. Depth (Ft.)
2.50 lbs./ft.	19	3.17	16	3.17	14	3.17	12	3.17	10	3.17	8	3.17
4.00 lbs./ft.	37	3.17	32	3.17	28	3.17	24	3.17	22	3.17	20	3.17

- Notes:
- "H" dimension given in tables is the maximum Height "H" for the corresponding sign area.
  - Sign Area in tables is the maximum sign area for the corresponding "H".

POST EMBEDMENT DEPTH TABLES

BRUCE E. MEYERS

Licensed Professional Engineer

No. 8336-C

HAWAII, U.S.A.

The work was prepared by me or under my supervision and construction of this project will be under my observation.

Expiration Date of License 2/15.

U.S. DEPARTMENT OF TRANSPORTATION

FEDERAL HIGHWAY ADMINISTRATION

CENTRAL FEDERAL LANDS HIGHWAY DIVISION

HDOT STD PLAN TE-02C

**GALVANIZED FLANGED CHANNEL**


**SIGN POST MOUNTING**

Scale: N/A

Date: August 21, 2015

SHEET No. 1 OF 1


P21

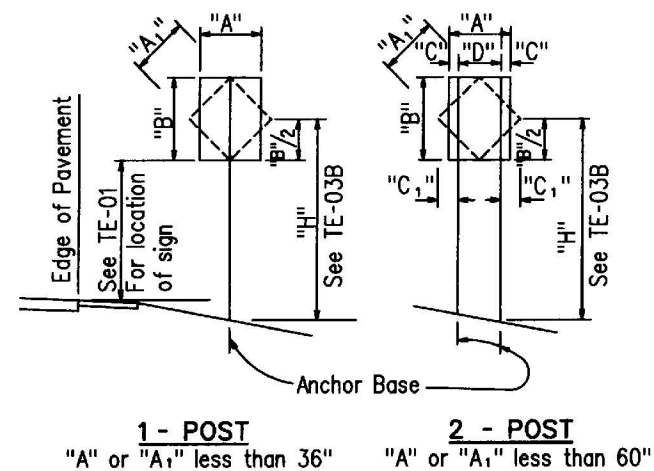

"A" or "A <sub>1</sub> "	"C"	"C <sub>1</sub> "
Less than 36"	6"	-
Greater than 36" and less than 48"	9"	19"
Greater than 48"	12"	24"

NOTE: Frame stiffeners are required when D is greater than 24" See General Notes.

### TYPICAL INSTALLATION

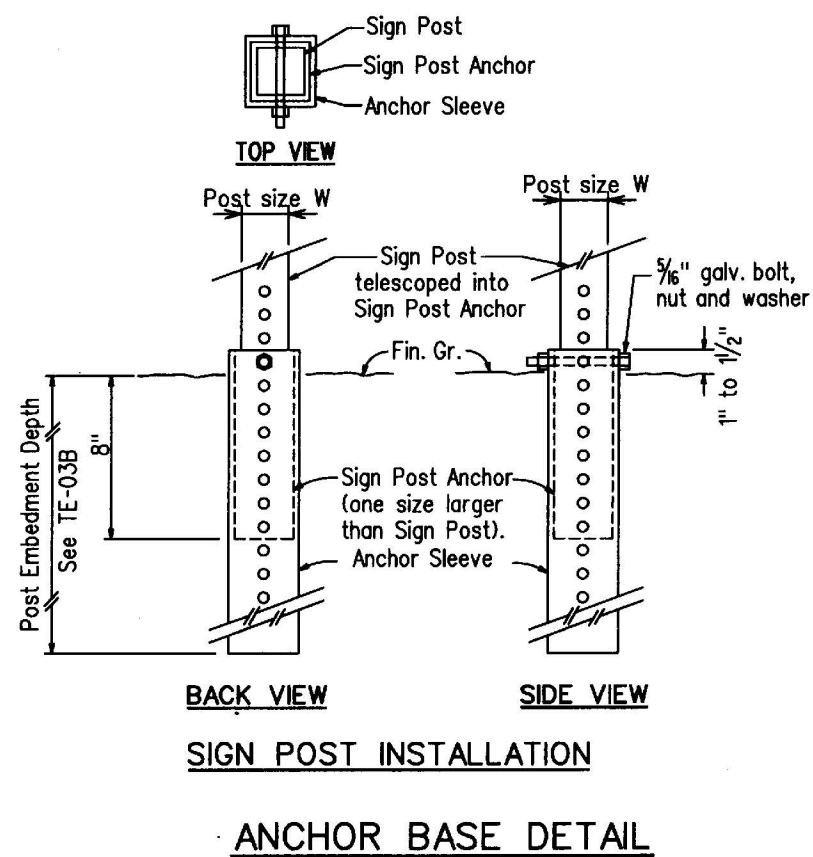

### GENERAL NOTES

#### 1. Design Specifications:

- Design shall conform w/ the latest AASHTO Standard Specifications for the Structural Supports for Highway Signs, Luminaires & Traffic Signals and its interim supplements and modifications by the Highways Division, Department of Transportation State of Hawaii.
- Latest HDOT Memorandum with subject title "Design Criteria for Bridges and Structures."

#### 2. Loads:

- Basic Wind Speed: 105 mph.
- Recurrence Interval of 10 years.

#### 3. Materials:

- Post shall conform to the Standard Specifications.
- Post shall be zinc coated after fabrication in accordance with ASTM A-123.
- All connection bolts shall be AASHTO M164 bolts and anchor bolts shall be AASHTO M314-105 bolt.
- Lap splice nuts and bolts shall be M180, with an ultimate tensile strength of 180 ksi, min.
- Aluminum members and surfaces in contact with structural steel shall be isolated with neoprene material as approved by the Engineer.

#### 4. General:

- See B-01, TE-01, and TE-03B for additional information.
- All posts shall be 12 gage unless otherwise specified or shown on the plans.
- Square tube posts shall be perforated with  $\frac{7}{16}$ "  $\phi$  holes, 1" o.c., 4 sides, along entire length of post.
- All accessories, fittings, connection details, and stiffener details (as required) shall be designed for the loads specified in the General Notes and submitted to the Engineer for approval 20 days prior to installation.
- Alternate designs in accordance with the plans and specifications shall use the Service Load Design Method and shall be stamped by a registered engineer of the State of Hawaii in the related discipline and submitted to the Engineer for approval.
- All sign support posts shall be outside of the clear zone or shielded by an appropriate traffic barrier system. The traffic barrier system shall be submitted to the Engineer for his approval.
- The Contractor shall use templates while installing the anchor bolts. Anchor bolts shall be vertical.
- Excavation and backfill costs shall be considered incidental to the cost of the sign foundation.

<p>The work was prepared by me or under my supervision and construction of this project will be under my observation.</p> <p><i>Bruce E. Meyers</i></p> <p>Expiration Date of License 3/15.</p>	<p>U.S. DEPARTMENT OF TRANSPORTATION FEDERAL HIGHWAY ADMINISTRATION CENTRAL FEDERAL LANDS HIGHWAY DIVISION</p> <p><b>HDOT STD PLAN TE-03A</b> <b>GALVANIZED SQUARE TUBE</b> <b>SIGN POST MOUNTING</b></p>	
	<p>Scale: N/A</p>	<p>Date: August 21, 2015</p>
	<p>SHEET No. 1 OF 1</p>	

SQUARE TUBE: 1-POST INSTALLATION - STIFF CLAY												
Post Size W	"H" = Ground Level to Midpoint (ft.)											
	7		8		9		10		11		12	
	Sign Area (Sq.Ft.)	Embed. Depth (Ft.)	Sign Area (Sq.Ft.)	Embed. Depth (Ft.)	Sign Area (Sq.Ft.)	Embed. Depth (Ft.)	Sign Area (Sq.Ft.)	Embed. Depth (Ft.)	Sign Area (Sq.Ft.)	Embed. Depth (Ft.)	Sign Area (Sq.Ft.)	Embed. Depth (Ft.)
2"	7.7	4.5	6.7	4	6.0	4	5.4	4	4.9	4	4.5	4
2 1/2"	-	-	-	-	-	-	-	-	9.6	4	8.8	4

SQUARE TUBE: 1-POST INSTALLATION - SAND AND GRAVEL												
Post Size W	"H" = Ground Level to Midpoint (ft.)											
	7		8		9		10		11		12	
	Sign Area (Sq.Ft.)	Embed. Depth (Ft.)	Sign Area (Sq.Ft.)	Embed. Depth (Ft.)	Sign Area (Sq.Ft.)	Embed. Depth (Ft.)	Sign Area (Sq.Ft.)	Embed. Depth (Ft.)	Sign Area (Sq.Ft.)	Embed. Depth (Ft.)	Sign Area (Sq.Ft.)	Embed. Depth (Ft.)
2"	7.7	4.5	6.7	4.5	6.0	4	5.4	4	4.9	4	4.5	4
2 1/2"	-	-	-	-	-	-	-	-	9.6	5	8.8	5

SQUARE TUBE: 2-POST INSTALLATION - STIFF CLAY												
Post Size W	"H" = Ground Level to Midpoint (ft.)											
	7		8		9		10		11		12	
	Sign Area (Sq.Ft.)	Embed. Depth (Ft.)	Sign Area (Sq.Ft.)	Embed. Depth (Ft.)	Sign Area (Sq.Ft.)	Embed. Depth (Ft.)	Sign Area (Sq.Ft.)	Embed. Depth (Ft.)	Sign Area (Sq.Ft.)	Embed. Depth (Ft.)	Sign Area (Sq.Ft.)	Embed. Depth (Ft.)
2"	17.4	3	15.2	3	13.5	3	12.2	3	11.0	3	10.1	3
2 1/2"	30.2	3	26.5	3	23.5	3	21.1	3	19.2	3	17.6	3

SQUARE TUBE: 2-POST INSTALLATION - SAND AND GRAVEL												
Post Size W	"H" = Ground Level to Midpoint (ft.)											
	7		8		9		10		11		12	
	Sign Area (Sq.Ft.)	Embed. Depth (Ft.)	Sign Area (Sq.Ft.)	Embed. Depth (Ft.)	Sign Area (Sq.Ft.)	Embed. Depth (Ft.)	Sign Area (Sq.Ft.)	Embed. Depth (Ft.)	Sign Area (Sq.Ft.)	Embed. Depth (Ft.)	Sign Area (Sq.Ft.)	Embed. Depth (Ft.)
2"	17.4	3	15.2	3	13.5	3	12.2	3	11.0	3	10.1	3
2 1/2"	30.2	4	26.5	4	23.5	4	21.1	4	19.2	4	17.6	4

POST EMBEDMENT DEPTH TABLES

- Notes:
- "H" dimension given in tables is the maximum Height "H" for the corresponding sign area.
  - Sign Area in tables is the maximum sign area for the corresponding "H".

M:\Mproj\Lenzie\Saddle East 11-6\sheets\shp023.dgn

BRUCE E. MEYERS

Licensed Professional Engineer

No. 8336-C

HAWAII, U.S.A.

The work was prepared by me or under my supervision and construction of this project will be under my observation.

*Bruce E. Meyers*

Expiration Date of License 3/15.

U.S. DEPARTMENT OF TRANSPORTATION

FEDERAL HIGHWAY ADMINISTRATION

CENTRAL FEDERAL LANDS HIGHWAY DIVISION

HDOT STD PLAN TE-03B

**GALVANIZED SQUARE TUBE**

**SIGN POST MOUNTING**






















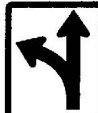










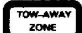




























Scale: N/A

Date: August 21, 2015

SHEET No. 1 OF 1


P23

STATE	SADDLE ROAD PROJECT	SHEET NO.	TOTAL SHEETS
HI	HI SR 200(3)	P24	P40

 <b>R1-1</b> 30"x30" <b>R1-1-A</b> 36"x36"	 <b>R1-2</b> 36"x36"x36" <b>R1-2-A</b> 48"x48"x48"	 <b>R2-1(50)</b> 24"x30" <b>R2-1(50)-A</b> 48"x60" <b>R2-1(50)-B</b> 36"x48"	 <b>R2-2(40)</b> 24"x24" <b>R2-2(40)-A</b> 48"x48"	 <b>R2-4a(50/40)</b> 24"x48" <b>R2-4a(50/40)-A</b> 48"x96"	 <b>R3-1</b> 24"x24" 24"x18" <b>R3-1-A</b> 48"x48" 48"x36"	 <b>R3-2</b> 24"x24" 24"x18" <b>R3-2-A</b> 48"x48" 48"x36"	 <b>R3-3</b> 24"x24" <b>R3-3-A</b> 48"x48"	 <b>R3-4</b> 24"x24" 24"x18" <b>R3-4-A</b> 48"x48" 48"x36"	 <b>R3-5(L)</b> 30"x36" <b>R3-5(L)-A</b> 48"x60"	 <b>R3-6(L)</b> 30"x36" <b>R3-6(L)-A</b> 48"x60"	 <b>R3-7(R)</b> 30"x30" <b>R3-7(R)-A</b> 48"x48"	
 <b>R3-8(L)</b> 30"x30" <b>R3-8(L)-A</b> 36"x36" <b>R3-8(L)-B</b> 48"x48"	 <b>R3-9a</b> 30"x36"	 <b>R4-1</b> 24"x30" <b>R4-1-A</b> 48"x60"	 <b>R4-2</b> 24"x30" <b>R4-2-A</b> 48"x60"	 <b>R4-3</b> 24"x30" <b>R4-3-A</b> 48"x60"	 <b>R4-5</b> 24"x30" <b>R4-5-A</b> 48"x60"	 <b>R4-6(500)</b> 24"x30" <b>R4-6(500)-A</b> 48"x60"	 <b>R4-7</b> 24"x30" 24"x18" <b>R4-7-A</b> 48"x60"	 <b>R4-8</b> 24"x30" 24"x18" <b>R4-8-A</b> 48"x60"	 <b>R5-1</b> 30"x30" <b>R5-1-A</b> 48"x48"	 <b>R5-1a</b> 36"x24"	 <b>R5-2</b> 24"x24" 24"x18"	
 <b>R5-4</b> 24"x30" <b>R5-4-A</b> 48"x60"	 <b>R5-6</b> 24"x24" 24"x18"	 <b>R6-1(R)</b> 36"x12"	 <b>R6-2(R)</b> 24"x30"	 <b>R7-1</b> 12"x18" <b>R7-1-A</b> 24"x30"	 <b>R7-4</b> 12"x18" <b>R7-4-A</b> 24"x30"	 <b>R7-107(R)</b> 12"x18"	 <b>R7-108</b> 12"x18"	 <b>R7-201</b> 12"x6" <b>R7-201-A</b> 24"x12"	 <b>R8-1</b> 24"x30" <b>R8-1-A</b> 48"x60"	 <b>R8-2</b> 24"x30" <b>R8-2-A</b> 48"x60"	 <b>R8-3</b> 24"x30" <b>R8-3-A</b> 48"x48"	
 <b>R8-4</b> 30"x24" <b>R8-4-A</b> 48"x36"	 <b>R8-5</b> 24"x30" <b>R8-5-A</b> 48"x60"	 <b>R8-6</b> 24"x30" <b>R8-6-A</b> 48"x60"	 <b>R8-7</b> 30"x24" <b>R8-7-A</b> 48"x36"	 <b>R9-1</b> 18"x24"	 <b>R9-2</b> 12"x18"	 <b>R9-3</b> 12"x18"	 <b>R9-4</b> 18"x24"	 <b>R10-1</b> 12"x18"	 <b>R10-2</b> 12"x18"	 <b>R10-3</b> 9"x12"	 <b>R10-4</b> 9"x12"	
 <b>R10-5</b> 24"x30"	 <b>R10-6</b> 24"x36"	 <b>R10-7</b> 24"x30"	 <b>R10-8</b> 24"x30"	 <b>R10-9</b> 24"x30"	 <b>R10-10</b> 24"x30"	 <b>R10-12</b> 24"x30"						
 <b>R10-17a</b> 30"x36"	 <b>R11-1</b> 24"x30"	 <b>R11-2</b> 48"x30"	 <b>R11-3(10)</b> 60"x30"	 <b>R11-4</b> 60"x30"	 <b>R12-1(10)</b> 24"x30"							

### GENERAL NOTES

- Sign details shall conform to the latest editions of FHWA publications "Manual of Uniform Traffic Control Devices for Streets and Highways," "Standard Alphabet for Highway Signs," and "Standard Highway Signs," and as amended.
- All regulatory signs shall be reflectorized unless otherwise specified.
- All regulatory signs shall have 3/8" bolt holes drilled at appropriate locations.
- Numerals in ( ) indicate numerals to be inserted for sign message. (R) or (L) indicates right or left.
- All signs shall be erected without educational plaques unless called for in the plans.



U.S. FEDERAL CENTRAL

HD

## GENERAL NOTES

- Sign details shall conform to the latest editions of FHWA publications "Manual on Uniform Traffic Control Devices for Streets and Highways," "Standard Alphabets for Highway Signs," and "Standard Highway Signs," and as amended.
- All regulatory signs shall be reflectorized unless otherwise specified.
- All regulatory signs shall have 3/8" bolt holes drilled at appropriate locations.
- Numerals in ( ) indicate numerals to be inserted for sign message. (R) or (L) indicates right or left.
- All signs shall be erected without educational plaques unless called for in the plans.



The work was prepared by me or under my supervision and construction of this project will be under my observation.  
*Bruce E. Meyers*  
Expiration Date of License 3/15.

U.S. DEPARTMENT OF TRANSPORTATION  
FEDERAL HIGHWAY ADMINISTRATION  
CENTRAL FEDERAL LANDS HIGHWAY DIVISION

## HDOT STD PLAN TE-04 REGULATORY SIGNS

Scale: N/A

Date: August 21, 2015

SHEET No. 1 OF 1



W1-1(R)  
30"x30"  
W1-1(R)-A  
48"x48"



W1-2(R)  
30"x30"  
W1-2(R)-A  
48"x48"



W1-3(R)  
30"x30"  
W1-3(R)-A  
48"x48"



W1-4(R)  
30"x30"  
W1-4(R)-A  
48"x48"



W1-5(R)  
30"x30"  
W1-5(R)-A  
48"x48"




W1-6  
48"x24"




W1-7  
48"x24"



W2-1  
30"x30"  
W2-1-A  
48"x48"

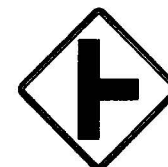

W2-2(R)  
30"x30"  
W2-2(R)-A  
48"x48"

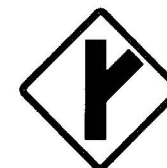

W2-3(R)  
30"x30"  
W2-3(R)-A  
48"x48"



W2-4  
30"x30"  
W2-4-A  
48"x48"




W2-5  
30"x30"  
W2-5-A  
48"x48"



STOP  
AHEAD  
W3-1  
36"x36"  
24"x18"  
W3-1-A  
48"x48"  
24"x18"



YIELD  
AHEAD  
W3-2  
36"x36"  
24"x18"  
W3-2-A  
48"x48"  
24"x18"

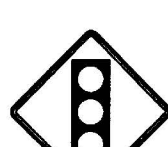

SIGNAL  
AHEAD  
W3-3  
36"x36"  
24"x18"  
W3-3-A  
48"x48"  
24"x18"



SPEED  
LIMIT  
25  
W3-5(25)  
36"x36"  
W3-5(25)-A  
48"x48"



MERGE  
W4-1(R)  
36"x36"  
24"x18"  
W4-1(R)-A  
48"x48"  
24"x18"



W4-2(R)  
36"x36"  
W4-2(R)-A  
48"x48"



ROAD  
NARROWS  
W5-1  
36"x36"  
W5-1-A  
48"x48"



NARROW  
BRIDGE  
W5-2  
36"x36"  
W5-2-A  
48"x48"



ONE LANE  
BRIDGE  
W5-3  
36"x36"  
W5-3-A  
48"x48"



DIVIDED  
HIGHWAY  
W6-1  
36"x36"  
24"x18"  
W6-1-A  
48"x48"  
24"x18"



DIVIDED  
HIGHWAY  
ENDS  
W6-2  
36"x36"  
24"x18"  
W6-2-A  
48"x48"  
24"x18"



TWO WAY  
TRAFFIC  
W6-3  
36"x36"  
24"x18"  
W6-3-A  
48"x48"  
24"x18"



HILL  
W7-1  
30"x30"  
24"x18"  
W7-1-A  
48"x48"  
24"x18"



USE LOW  
GEAR  
W7-2  
24"x18"  
BUMP  
W8-1  
30"x30"  
W8-1-A  
36"x36"  
W8-1-B  
48"x48"



DIP  
W8-2  
30"x30"  
W8-2-A  
36"x36"  
W8-2-B  
48"x48"



PAVEMENT  
ENDS  
W8-3  
36"x36"  
W8-3-A  
48"x48"



SOFT  
SHOULDER  
W8-4  
30"x30"  
W8-4-A  
36"x36"



SLIPPERY  
WHEN WET  
W8-5  
30"x30"  
24"x18"  
W8-5-A  
48"x48"  
24"x18"



RIGHT  
LANE  
ENDS  
W9-1(R)  
30"x30"  
W9-1(R)-A  
36"x36"  
W9-1(R)-B  
48"x48"



LANE ENDS  
MERGE  
LEFT  
W9-2(L)  
36"x36"  
W9-2(L)-A  
48"x48"




W10-1  
36" Diameter



BIKE  
XING  
W11-1  
30"x30"  
24"x18"  
W11-1-A  
36"x36"  
24"x18"  
W11-1-B  
48"x48"



AHEAD  
W11-2  
36"x36"  
W11-2-A  
48"x48"  
W16-9p  
24"x12"  
W16-9p-A  
30"x18"  
W16-9p-B  
36"x24"

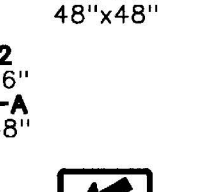

W16-7p(L)  
24"x12"  
W16-7p(L)-A  
30"x18"



CATTLE  
XING  
W11-4  
30"x30"  
24"x18"  
W11-4-A  
36"x36"  
W11-4-B  
48"x48"  
24"x18"



FARM  
MACHINERY  
W11-5  
30"x30"  
24"x18"  
W11-5-A  
36"x36"  
24"x18"  
W11-5-B  
48"x48"

## GENERAL NOTES


1. Sign details shall conform to the latest editions of FHWA publications "Manual on Uniform Traffic Control Devices for Streets and Highways," "Standard Alphabets for Highway Signs" and "Standard Highway Signs", and as amended.
2. All warning signs shall be reflectorized unless otherwise specified.
3. All warning signs shall have 3/8" bolt holes drilled at appropriate locations.
4. Numerals in ( ) indicate numerals to be inserted for sign message. (R) or (L) indicates right or left.
5. Signs prefixed with "CW" on the plans shall indicate orange and black construction signs and shall be reflectorized.



W12-1  
36"x36"  
W12-1-A  
48"x48"



12'-6"  
LOW  
CLEARANCE  
W12-2(12'-6")  
36"x36"  
24"x18"  
W12-2(12'-6")-A  
48"x48"  
24"x18"

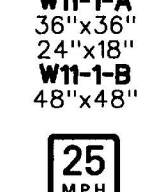

25  
M.P.H.  
W13-1(25)  
18"x18"  
W13-1(25)-A  
24"x24"



EXIT  
25  
M.P.H.  
W13-2(25)  
48"x60"




RAMP  
25  
M.P.H.  
W13-3(25)  
48"x60"



DEAD  
END  
W14-1  
30"x30"  
W14-1-A  
36"x36"



NO  
PASSING  
ZONE  
W14-3  
36"x48"x48"  
W14-3-A  
48"x64"x64"

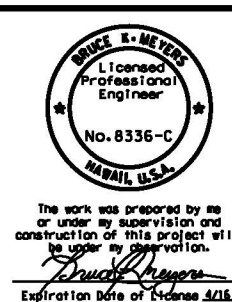

U.S. DEPARTMENT OF TRANSPORTATION FEDERAL HIGHWAY ADMINISTRATION CENTRAL FEDERAL LANDS HIGHWAY DIVISION	
HDOT STD PLAN TE-05 <b>WARNING SIGNS</b>	
Scale: N/A	Date: August 21, 2015
SHEET No. 1 OF 1	





R2-5a  
24"x30"  
R2-5a-A  
48"x60"



R2-10  
24"x30"

4"Ser.D  
4"Ser.D  
3"Ser.D  
5"Ser.C



R3-9b  
24"x36"



R5-8  
30"x24"

4"Ser.B



R7-107a  
12"x30"



R7-8  
12"x18"  
R7-8-A  
24"x30"



1/2" 4"Ser.C

R8-3a  
24"x24"  
24"x18"  
R8-3a-A  
48"x48"  
24"x18"



R9-3a  
18"x18"  
18"x12"  
R9-3a-A  
24"x24"  
24"x18"



R9-3b(R)  
18"x12"



R9-3b(L)  
18"x12"




R10-11a  
24"x30"




R16-2  
24"x30"

4"Ser.C

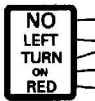


R16-3  
18"x24"

4"Ser.D  
3"Ser.D  
2"Ser.D  
3"Ser.D

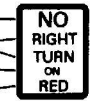

R16-4  
18"x24"

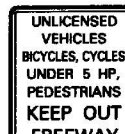

R16-5  
36"x42"

3"Ser.C

4"Ser.E


## GENERAL NOTES

- Sign details shall conform to the latest editions of the following FHWA publications:
  - "Standard Alphabets for Highway Signs," and as amended.
  - "Standard Highway Signs," and as amended.
  - "Manual on Uniform Traffic Control Devices for Streets and Highways," and as amended.
- All signs shall be reflectorized with reflective sheeting, unless otherwise specified.
- All signs shall have 3/8" bolt holes drilled at appropriate locations.
- Numerals in ( ) indicate numerals to be inserted for sign message. (R) or (L) indicates right or left.
- Signs prefixed with "CW" on the plans shall indicate orange and black construction signs, and shall be reflectorized with reflective sheeting.
- All signs shall be erected without educational plaques unless called for in the plans.



R16-6  
24"x30"

8"Ser.F

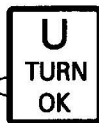

R16-7  
24"x30"

5"Ser.D



R18-1  
24"x18"

4"Ser.C



W1-8(R)  
18"x24"  
W1-8(R)-A  
30"x36"  
W1-8(R)-B  
36"x48"




W3-4  
48"x48"

6"Ser.C



W4-3(R)  
36"x36"  
W4-3(R)-A  
48"x48"

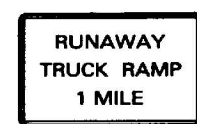


W7-4  
78"x48"



W7-4b  
78"x60"



W8-6  
30"x30"  
W8-6-A  
36"x36"  
W8-6-B  
48"x48"

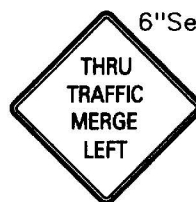

W4-7(L)  
48"x48"

6"Ser.E



W11-7  
36"x36"  
24"x18"  
W11-7-A  
48"x48"  
24"x18"



W11-8  
36"x36"  
24"x18"  
W11-8-A  
48"x48"  
24"x18"



W11-9  
36"x36"  
W11-9-A  
48"x48"




W14-2  
30"x30"



W14-4  
36"x36"  
W14-4-A  
48"x48"



W15-1  
36"x36"

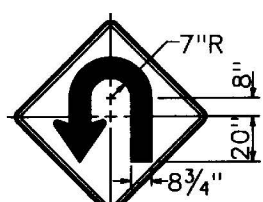

W17-2(L)  
60"x60"

7"R  
8 3/4"



W18-1  
48"x60"

8"Ser.E



CW16-1(1/2)  
60"x60"

8"Ser.E




W16-9p  
24"x12"  
W16-9p-A  
30"x18"  
W16-9p-B  
36"x24"

S1-1  
36"x36"  
S1-1-A  
48"x48"



S3-1  
30"x30"  
S3-1-A  
36"x36"

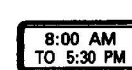

S4-1  
24"x10"




S4-2  
24"x10"



S4-3  
24"x8"



S4-4  
24"x10"

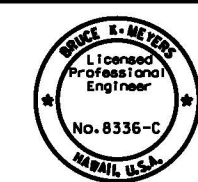

The work was prepared by me or under my supervision and construction of this project will be under my observation.  
*Bruce E. Meyers*  
Expiration Date of License 2/15

U.S. DEPARTMENT OF TRANSPORTATION  
FEDERAL HIGHWAY ADMINISTRATION  
CENTRAL FEDERAL LANDS HIGHWAY DIVISION


HDOT STD PLAN TE-06  
**MISCELLANEOUS SIGNS**

Scale: N/A


Date: August 21, 2015

SHEET No. 1 OF 1



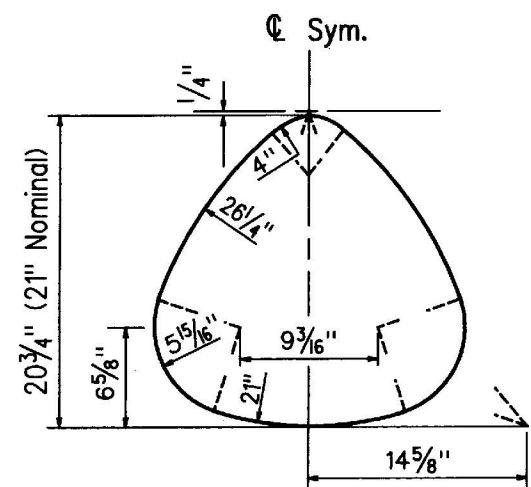

STATE ROUTE MARKER DETAIL

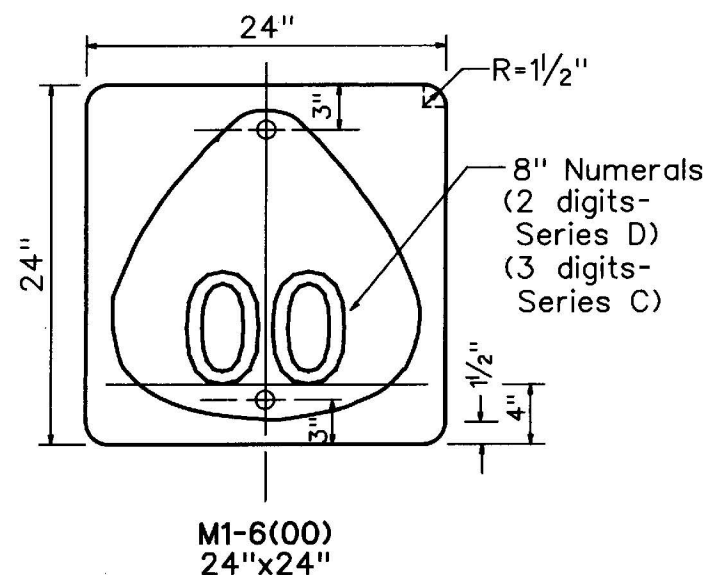


STATE ROUTE MARKER



M2-1  
21"x15"




M6-3  
21"x15"

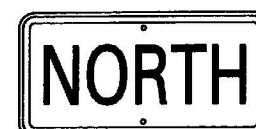

M3-1 24"x12"  
M3-1-A 36"x18"




M5-1(L)  
21"x15"

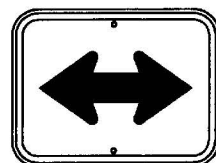


M6-4  
21"x15"



M4-1  
24"x12"

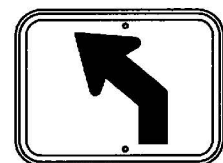

M5-2(L)  
21"x15"

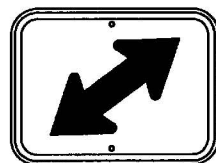


M6-5(R)  
21"x15"



M4-2  
24"x12"




M4-3  
24"x12"

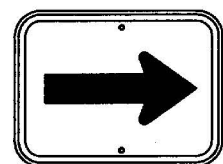

M6-1(R)  
21"x15"




M6-6(R)  
21"x15"

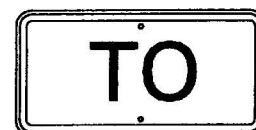


M4-5  
24"x12"



M4-7  
24"x12"

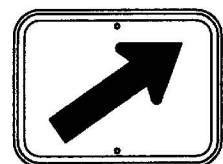


M6-2(R)  
21"x15"

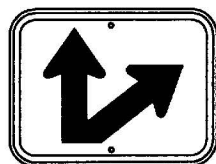

M6-7(R)  
21"x15"



M4-6  
24"x12"

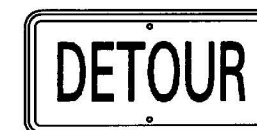

M4-8  
24"x12"

GENERAL NOTES

1. Marker details shall conform to the latest editions of FHWA publications "Manual on Uniform Traffic Control Devices for Streets and Highways", "Standard Alphabets for Highway Signs" and "Standard Highway Signs" and as amended.
2. All markers shall be reflectorized unless otherwise specified.
3. All markers shall have 3/8" bolt holes drilled at appropriate locations.
4. Numerals in ( ) indicate numerals to be inserted for marker message. (R) or (L) indicates right or left.
5. Sign message of Cardinal Direction Marker (M3 series) shall be denoted by the following:

M3-1: NORTH  
M3-2: EAST  
M3-3: SOUTH  
M3-4: WEST

6. Markers prefixed with "IM" on the plans shall have a white legend on a blue background.

AUXILIARY MARKERS



The work was prepared by me or under my supervision and construction of this project will be under my observation.  
*Bruce E. Meyers*  
Expiration Date of License 3/15.

U.S. DEPARTMENT OF TRANSPORTATION  
FEDERAL HIGHWAY ADMINISTRATION  
CENTRAL FEDERAL LANDS HIGHWAY DIVISION


HDOT STD PLAN TE-11  
STATE ROUTE MARKER  
AND AUXILIARY MARKERS

Scale: N/A

Date: August 21, 2015

SHEET No. 1 OF 1

MARKER SIZE	MULTIPLY DIMENTIONS BY	NUMERAL SIZE
		2 Digit-Series D 3 Digit-Series C
21"	1.3	8"
32"	2.0	12"
42"	2.63	16"

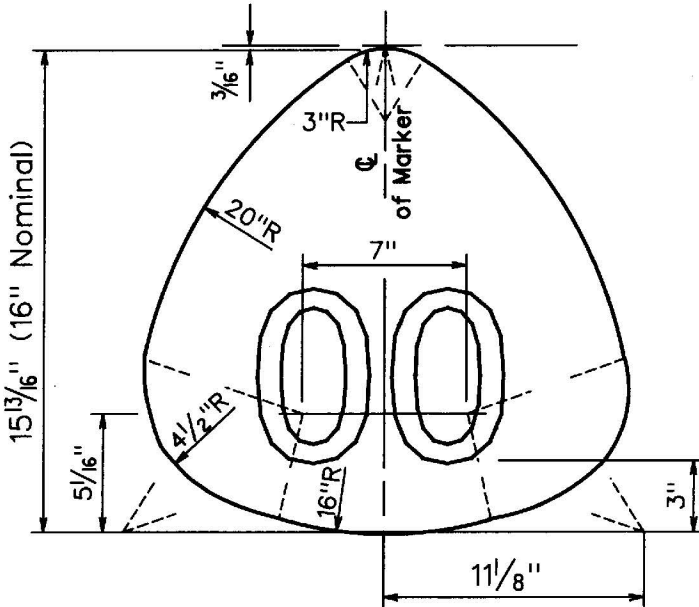


STATE ROUTE MARKER  
FOR GUIDE SIGNS

NOTE:

1. State Route Markers on Guide signs shall have black numerals on a white reflectorized background mounted on a flat aluminum cut-out.
2. Numerals shall conform to the latest editions of FHWA publication "Standard Alphabets for Highway Signs" and as amended.
3. Cut-outs shall be fastened on sign panel with aluminum blind rivets. See Standard Specificaitons.


RADII FOR SIGNS		
Least Dimension of Sign	W	R
2'-0" to 4'-6"	2"	3"
4'-9" to 5' 6"	2"	6"
5'-9" to 7'-6"	2"	9"
7'-9" and greater	2"	12"

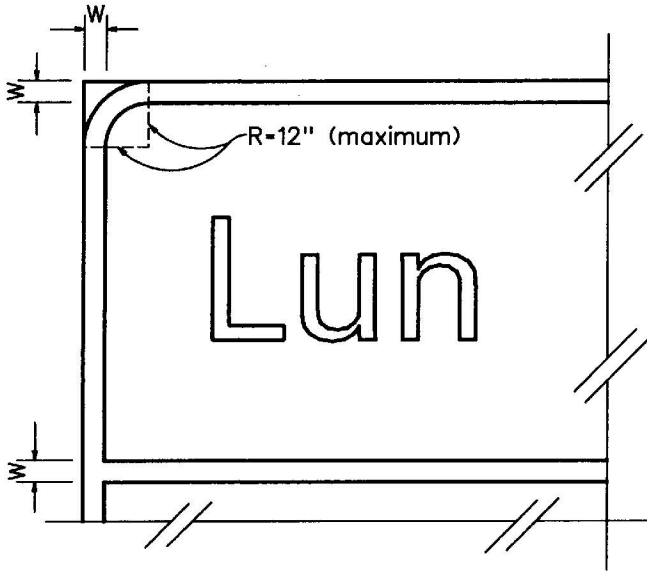

BORDER DETAIL  
FOR GUIDE SIGNS


NOTE:

1. Area outside corner radius need not be trimmed.
2. All borders shall be white reflectorized cut-outs.
3. All Guide signs shall have borders.

 <p>The work was prepared by me or under my supervision and construction of this project will be under my observation. <i>Bruce E. Meyers</i> Expiration Date of License 2/15.</p>	<p>U.S. DEPARTMENT OF TRANSPORTATION FEDERAL HIGHWAY ADMINISTRATION CENTRAL FEDERAL LANDS HIGHWAY DIVISION</p>
	<p><b>HDOT STD PLAN TE-12</b> <b>STATE ROUTE MARKER AND</b> <b>BORDER DET FOR GUIDE SIGNS</b></p>
	<p>Scale: N/A Date: August 21, 2015</p>

SHEET No. 1 OF 1


STATE	SADDLE ROAD PROJECT	SHEET NO.	TOTAL SHEETS
HI	HI SR 200(3)	P29	P40

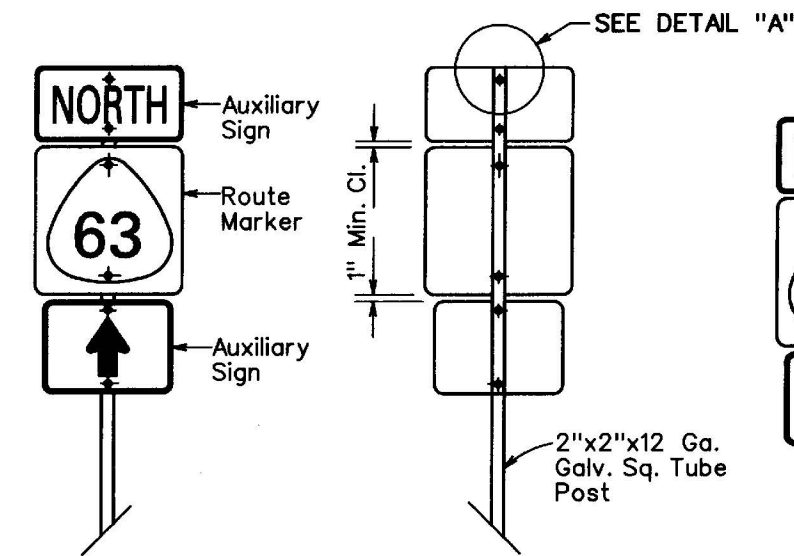

FRONT VIEW

BACK VIEW


TYPE "A" ASSEMBLY

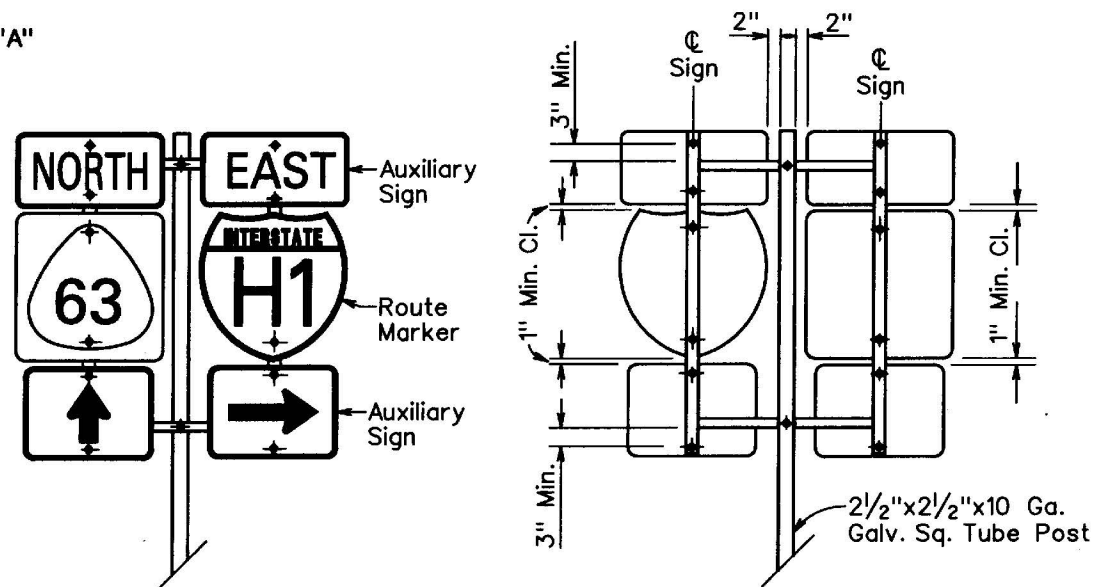

FRONT VIEW


BACK VIEW

TYPE "B" ASSEMBLY

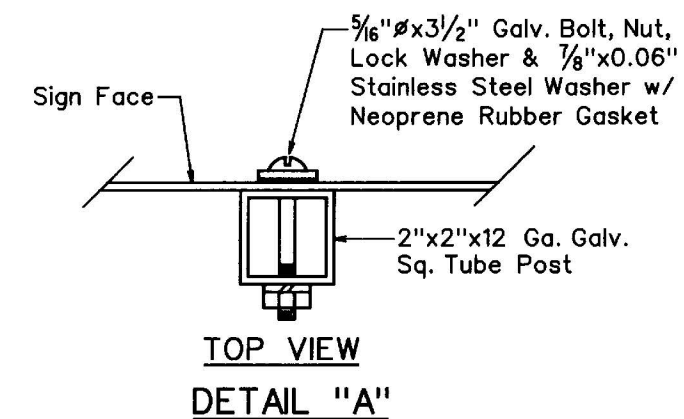


TOP VIEW

DETAIL "A"

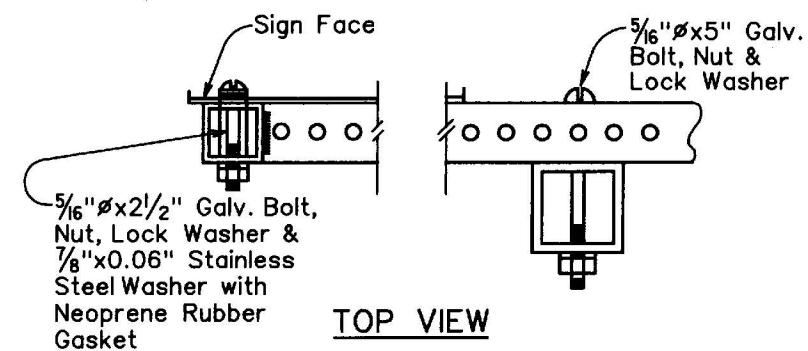

TOP VIEW

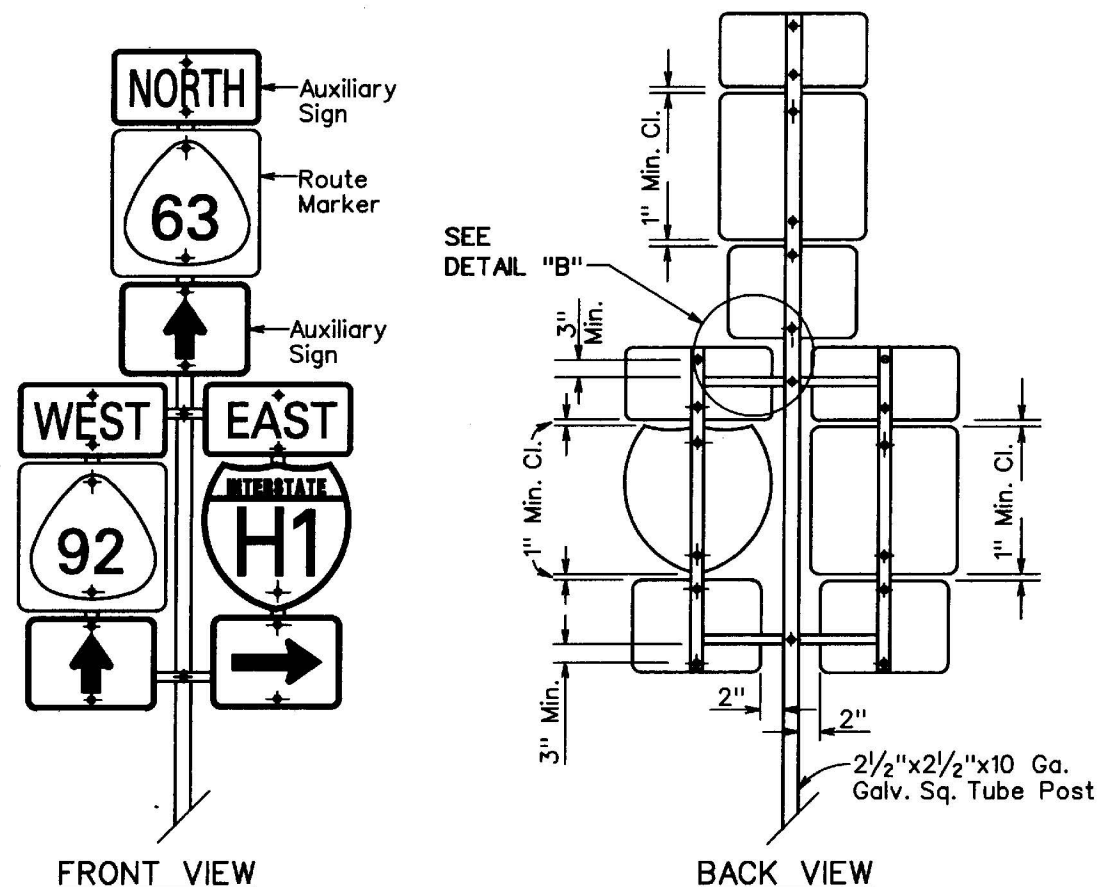


FRONT VIEW

BACK VIEW

TYPE "B" ASSEMBLY

In lieu of Welds an approved bolted Post Fitting may be substituted

1 1/2"x1 1/2"x12 Ga. Galv. Sq. Tube Post Frame

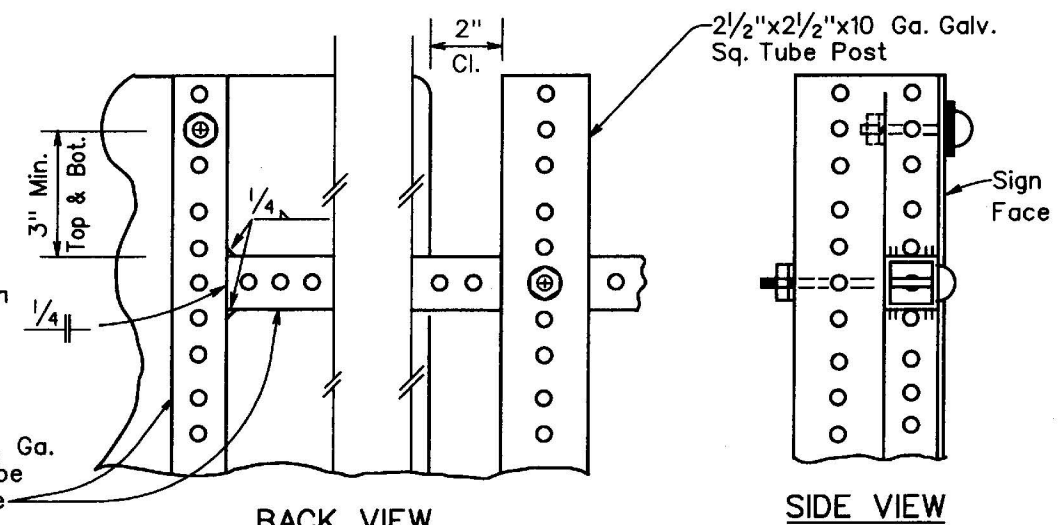

BACK VIEW

SIDE VIEW











DETAIL "B"



The work was prepared by me or under my supervision and construction of this project will be under my observation.  
*Bruce E. Meyers*  
 Expiration Date of License 3/15.

U.S. DEPARTMENT OF TRANSPORTATION FEDERAL HIGHWAY ADMINISTRATION CENTRAL FEDERAL LANDS HIGHWAY DIVISION	
<b>HDOT STD PLAN TE-12A</b>	
<b>ROUTE SIGN ASSEMBLIES</b>	
Scale: N/A	Date: August 21, 2015
SHEET No. 1 OF 1	

STATE	SADDLE ROAD PROJECT	SHEET NO.	TOTAL SHEETS
HI	HI SR 200(3)	P30	P40

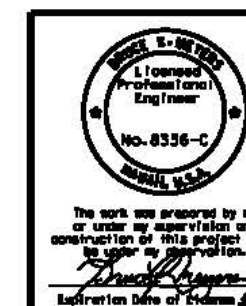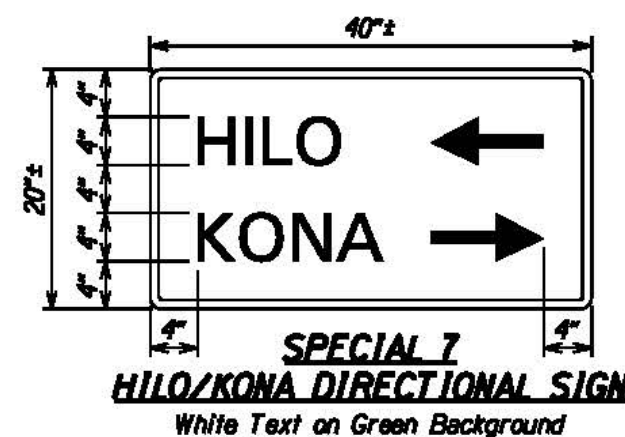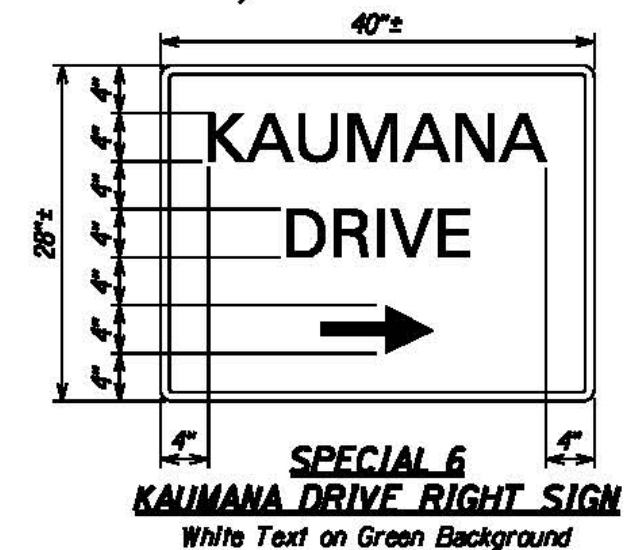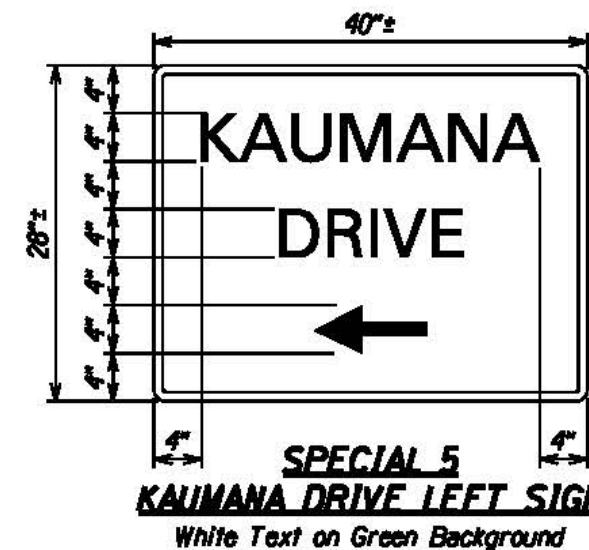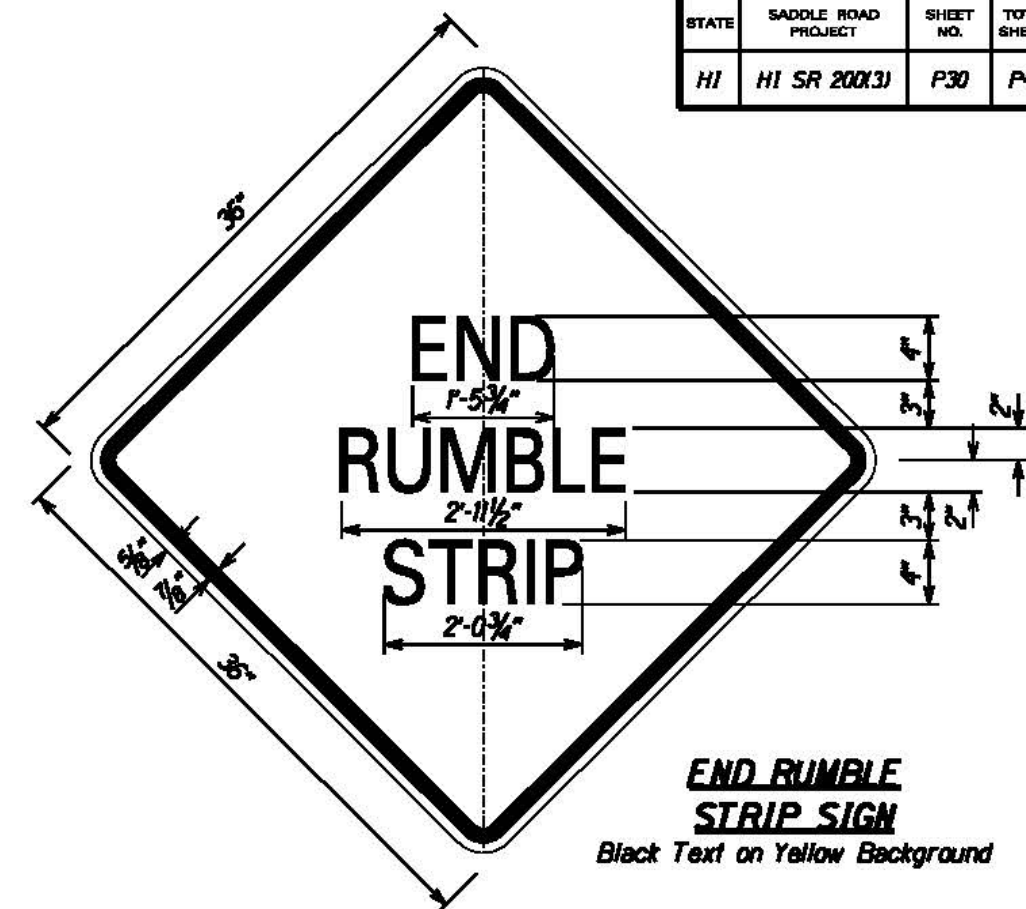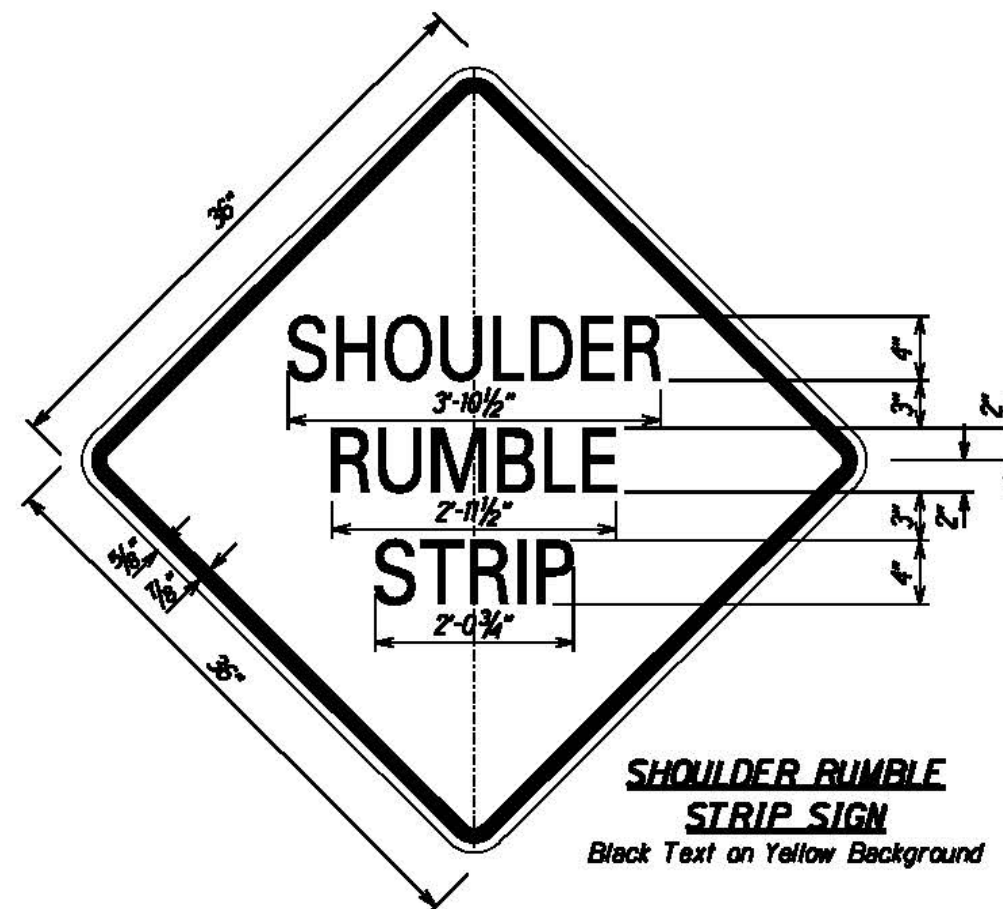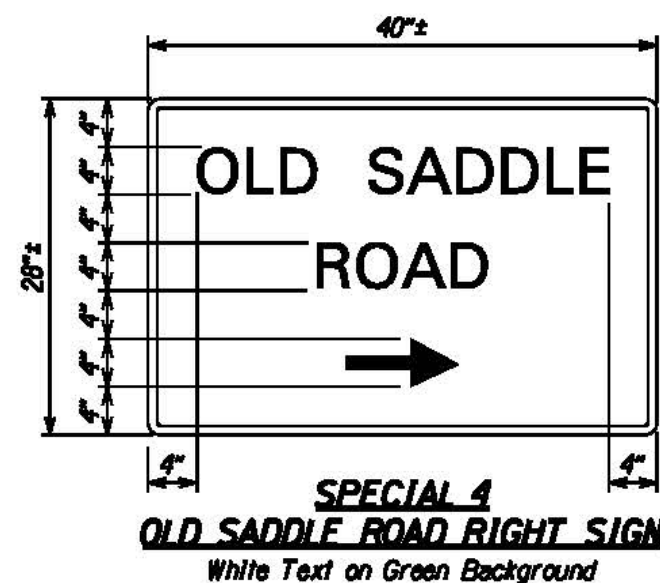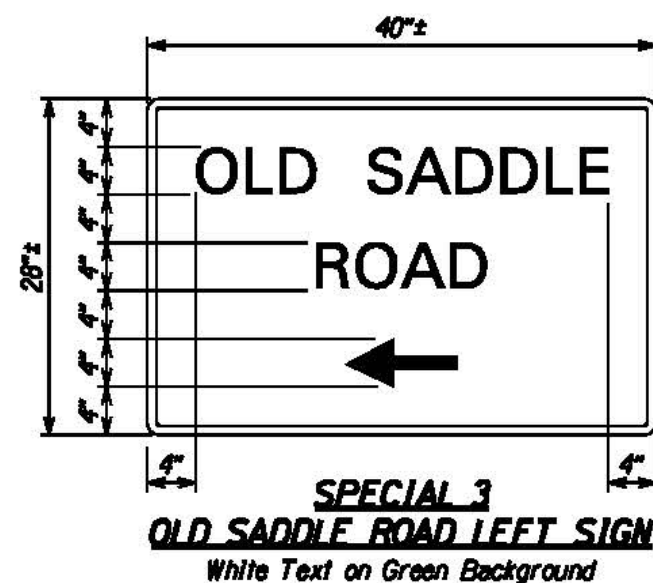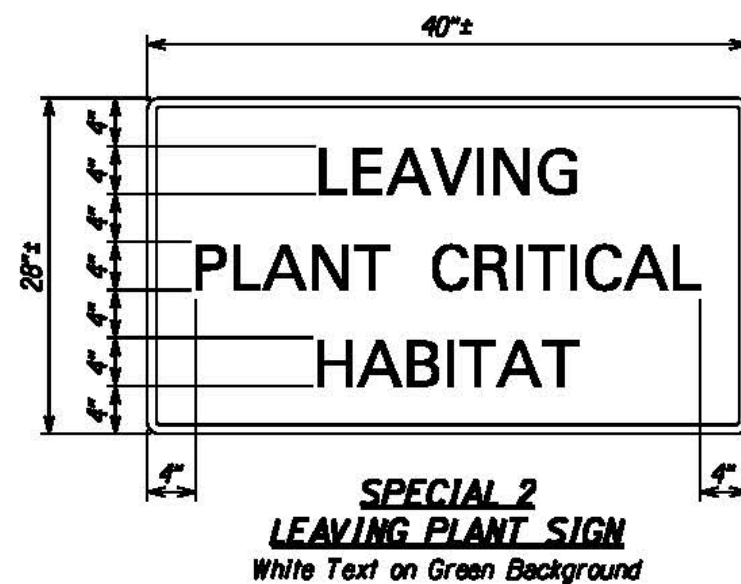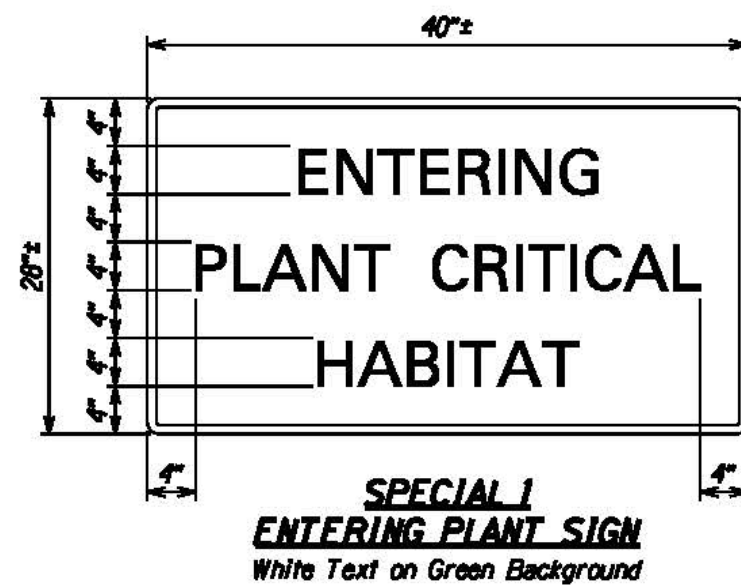


U.S. DEPARTMENT OF TRANSPORTATION FEDERAL HIGHWAY ADMINISTRATION CENTRAL FEDERAL LANDS HIGHWAY DIVISION	
<b>SADDLE ROAD SIGN DETAILS</b>	
Scale: N.T.S.	Date: August 21, 2015
SHEET No. 1 OF 2	

STATE	SADDLE ROAD PROJECT	SHEET NO.	TOTAL SHEETS
HI	HI SR 200(3)	P31	P40

# SIGN NOTES


- Letter Size:
  - Use series "E" when letters are all uppercase.
  - User series "E" (M) when initial uppercase letter is used in conjunction with lowercase letters.
- All signs shall conform to Section 633 of the Special Contract Requirements and the latest editions and amendments of the following FHWA publications:
  - "Manual on Uniform Traffic Control Devices for Streets and Highways" (MUTCD 2003)
  - "Standard Highway Signs"
- Borders, messages, arrows, symbols and shield shall conform to details as shown on the plans and as specified in the MUTCD.
- Sign messages are as indicated on the plan.
- All panels are Retroreflective in accordance with Section 718 of the Special Contract Requirements. Minimum width of panels are 2 ft. Abutting edges of panels are in only one direction if vertical abutting edges are used. No horizontal abutting edges are allowed and vice versa.
- Contractor submits all sign splicing details to the Contracting Officer for approval. All backing for signs 4 feet by 6 feet or less are of one sheet.
- Backing for all new Regulatory and Warning Signs are not spliced.
- Final locations of all signs are approved by the Contracting Officer prior to any installation work.
- Existing signs that are to be replaced, are not removed until new signs are installed as replacements, or the messages are no longer necessary.
- Existing signs not shown on these plans are to remain as posted unless otherwise directed by the Contracting Officer. Removal and disposal of existing signs and/or posts as designated on these plans are incidental to the various signing items.
- Removal of Existing Delineators and Posts are considered incidental to the various signing items.
- All Destination, Street Name, and Non-Standard Signs, that are removed and installed at the same or new location, are identical to the existing sign in size and text. The Contractor submits Shop Drawings to the Contracting Officer for approval prior to fabricating the sign.
- All 3-post signs are installed on flanged channel posts. All 1 & 2-post signs are installed on square tubing.
- Mount Sign Posts with RM-3 reflector markers as directed in the field by the Contracting Officer.
- Shoulder Rumble Strip signs shall be installed 50 feet before the first rumble strip depression. End Rumble Strip signs shall be installed 50 feet beyond the last rumble strip depression.
- Use 4" series C letters black legend on retroreflectorized yellow background.

 <p>The work was prepared by me or under my supervision and construction of this project will be under my supervision.</p> <p><i>David S. Mendenhall</i></p> <p>Expiration Date of License 2016.</p>	U.S. DEPARTMENT OF TRANSPORTATION FEDERAL HIGHWAY ADMINISTRATION CENTRAL FEDERAL LANDS HIGHWAY DIVISION
	<h2>SADDLE ROAD SIGN NOTES</h2>
	Scale: N.T.S. <span style="float: right;">Date: August 21, 2015</span>
SHEET No. 2 OF 2	

U:\proj\Lenzie\Saddle East II-6\sheet\shp03.dgn








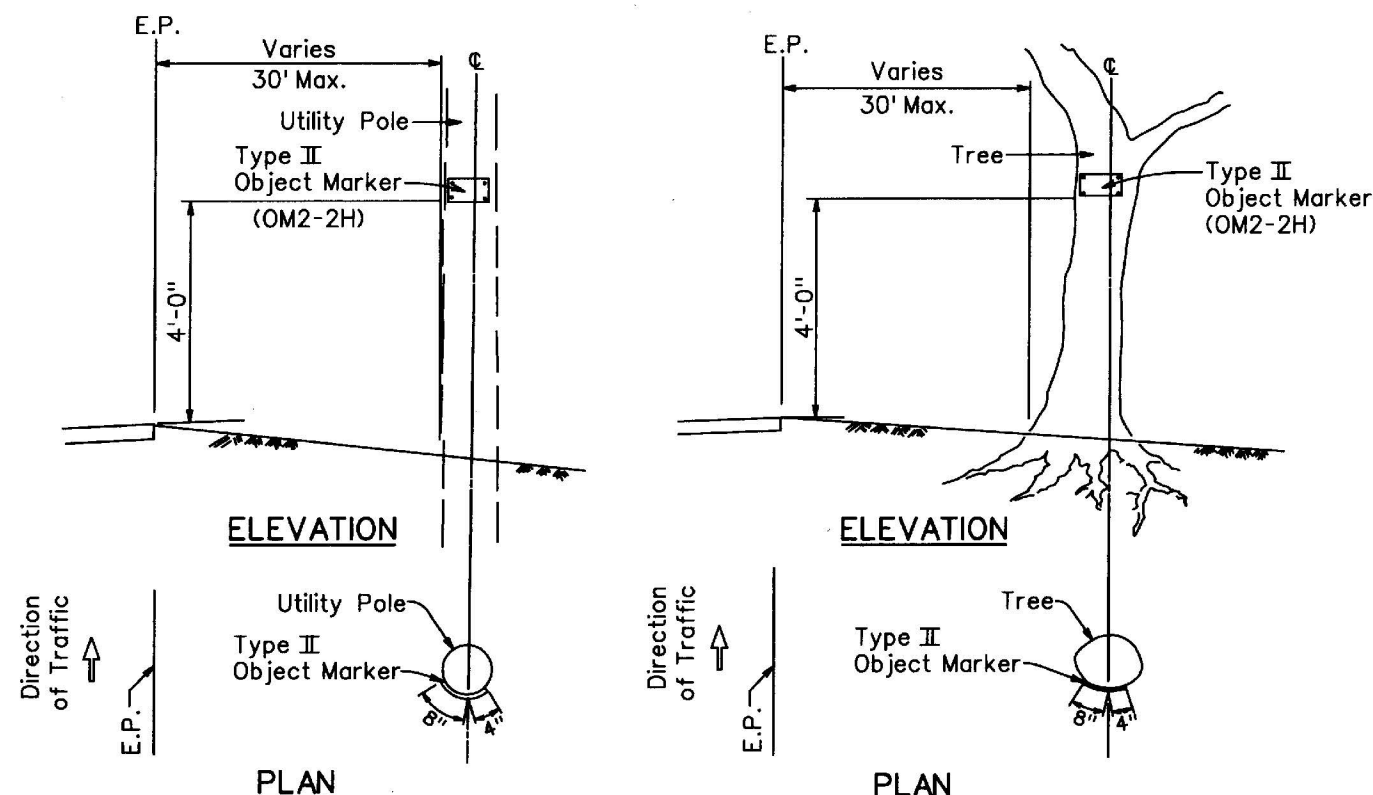


**TYPICAL TYPE II OBJECT MARKER MOUNTING DETAIL**

### GENERAL NOTES

- All objects (utility poles or trees) that are within the State highway right of way and within 30 feet of the roadway edge of pavement shall be marked as directed by the Engineer.
- The Contractor shall prepare the mounting surface of each object as directed by the Engineer and place the Type II Object Marker as shown on this plan.
- Type II Object Markers shall be mounted on utility poles and trees with 1 3/4" galv. roofing nails (4 ea.).
- Branches of trees which obscure the object markers shall be trimmed. (Payment shall be incidental to Type II Object Markers as shown in the proposal.)
- Type II Object Markers for utility poles and trees, etc., shall be made of amber reflective sheeting material overlayed on 0.020" aluminum sheeting.
- Objects such as concrete posts, concrete or rock walls and boxes, metal posts (greater than 2" in diameter), or metal boxes shall be marked with post mounted object markers. Post mounted Type II Object Markers shall conform to the following requirements:
  - It shall consist of amber reflective sheeting material overlayed on 0.063" thick sheet aluminum backing of the dimensions shown on the plans.
  - It shall be mounted on either metal posts or flexible delineator posts with 1/4"x2" galv. bolts, nuts and washers. Metal posts shall be galvanized and shall be either 1/2"x1/2", 12 gauge square tube posts or 1.12 lbs. per ft. flanged channel posts.

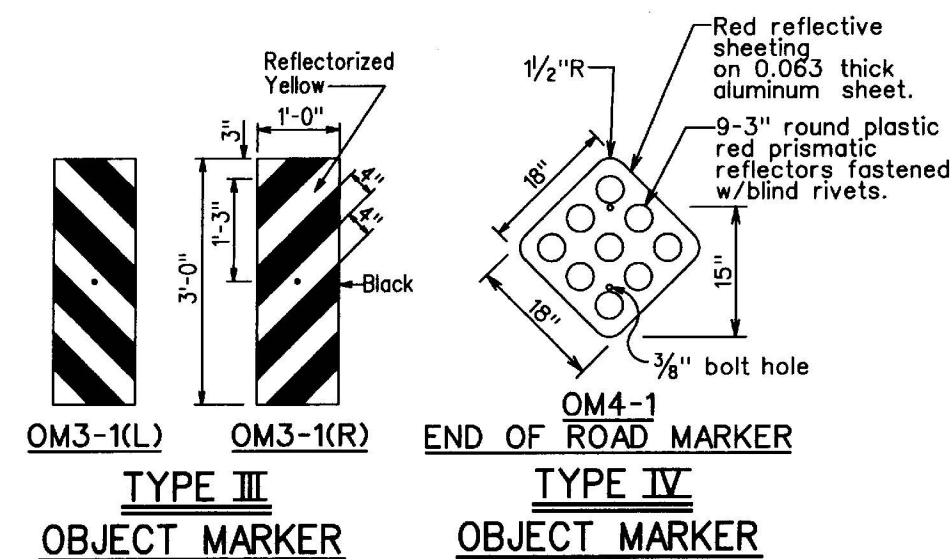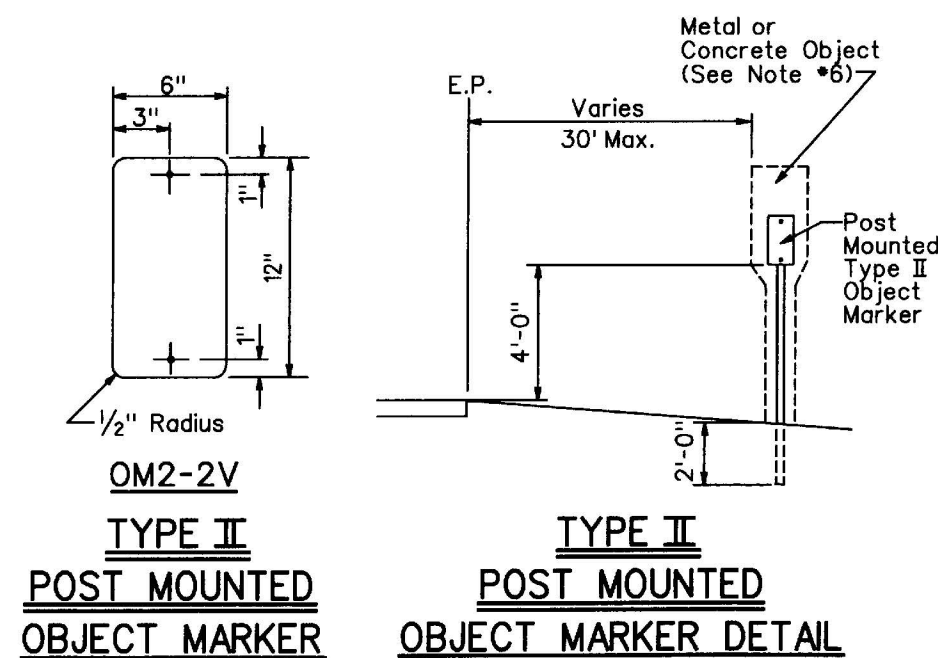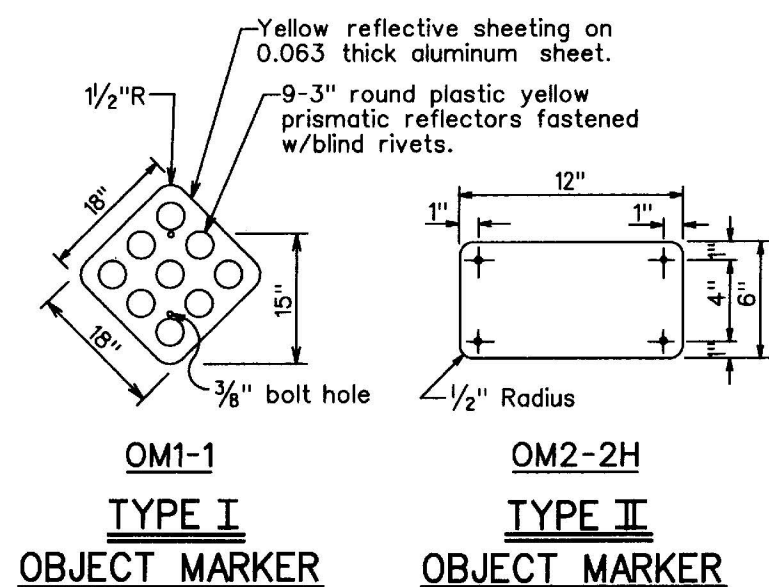


<p>The work was prepared by me or under my supervision and construction of this project will be under my observation.</p> <p><i>Bruce E. Meyers</i></p> <p>Expiration Date of License 2/15</p>	U.S. DEPARTMENT OF TRANSPORTATION FEDERAL HIGHWAY ADMINISTRATION CENTRAL FEDERAL LANDS HIGHWAY DIVISION
	<b>HDOT STD PLAN TE-15</b> <b>OBJECT MARKERS</b>
	Scale: N/A Date: August 21, 2015 SHEET No. 1 OF 1

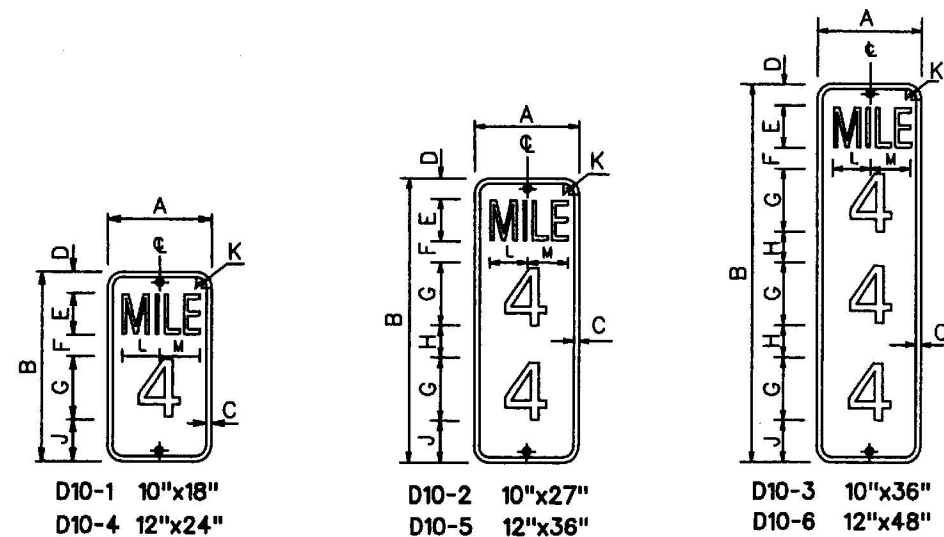


### MILEPOST MARKER PLATE DETAILS

MILEPOST PLATE SCHEDULE (INCHES)														
NAME	SIZE	A	B	C	D	E	F	G	H	J	K	L	M	LETTER SERIES
D10-1	10x18	10	18	1/2	2	4	2	6	-	4	1 1/2	3 3/8	3 3/8	B
D10-4	12x24	12	24	1/2	3	4	3	10	-	4	1 1/2	4 3/8	4 3/8	C
D10-2	10x27	10	27	1/2	2	4	2	6	3	4	1 1/2	3 3/8	3 3/8	B
D10-5	12x36	12	36	1/2	3	4	3	10	3	3	1 1/2	4 3/8	4 3/8	C
D10-3	10x36	10	36	1/2	2	4	2	6	3	4	1 1/2	3 3/8	3 3/8	B
D10-6	12x48	12	48	1/2	3	4	3	10	2 1/2	3	1 1/2	4 3/8	4 3/8	C

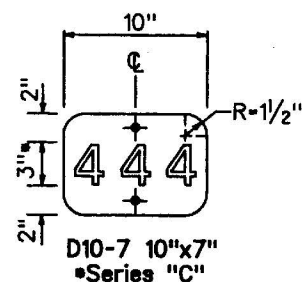


### HIGHWAY ROUTE NUMBER PLATE DETAIL

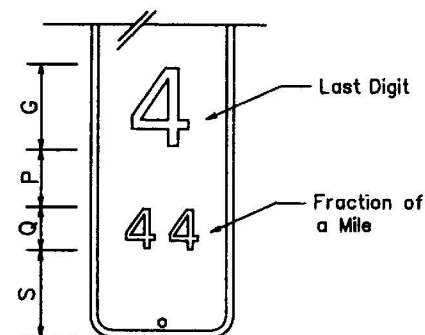


### MILEPOST MARKER FRACTION DETAIL


MILEPOST PLATE SCHEDULE WITH FRACTION OF A MILE						
NAME	SIZE	G	P	Q	S	NUMERAL SERIES
D10-1a	10"x27"	6"	4"	3"	6"	C
D10-4a	12"x36"	10"	4"	5"	7"	C
D10-2a	10"x36"	6"	4"	3"	6"	C
D10-5a	12"x48"	10"	4"	5"	6"	C
D10-3a	10"x45"	6"	4"	3"	6"	C
D10-6a	10"x60"	10"	4"	5"	6"	C

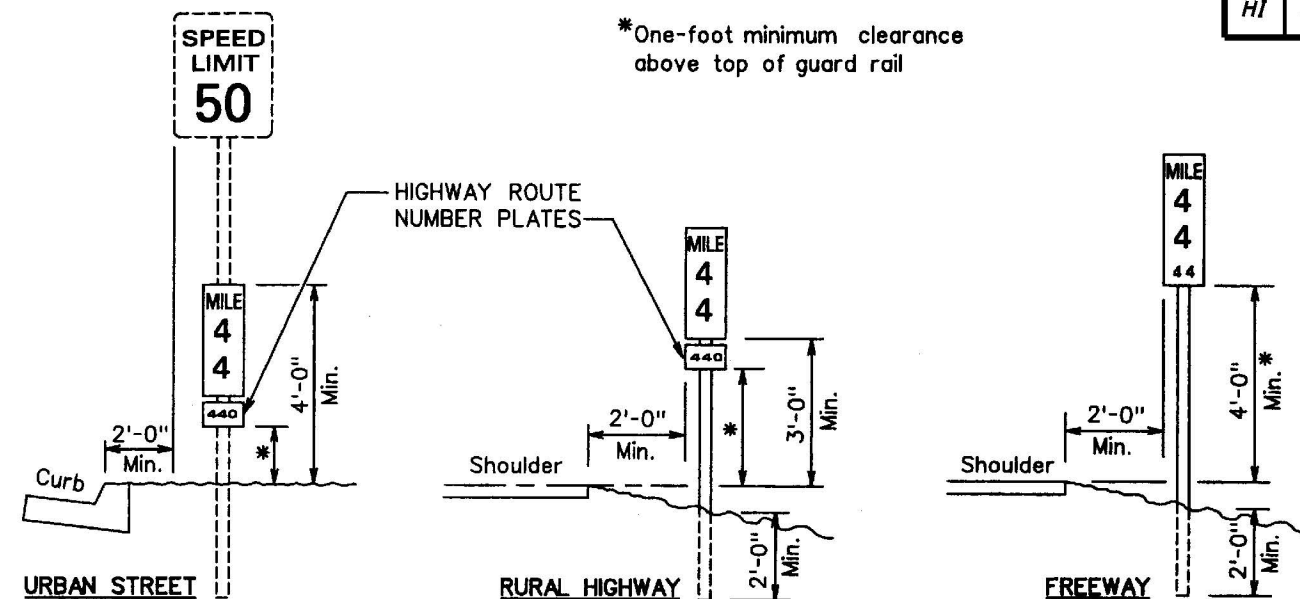

### TYPICAL ROADSIDE INSTALLATION

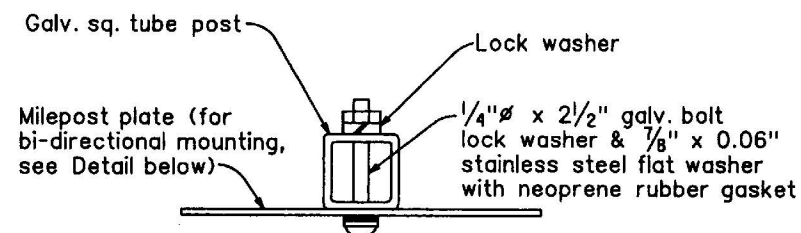

### GALVANIZED SQUARE TUBE POST

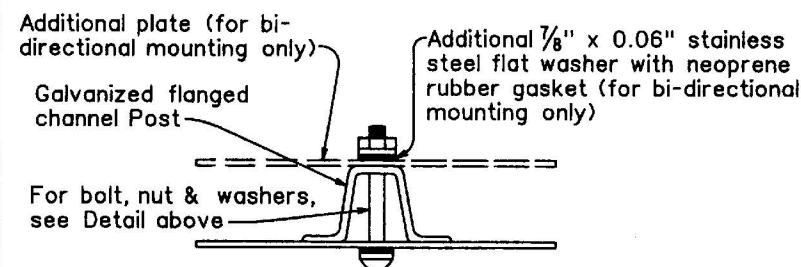

### GALVANIZED FLANGED CHANNEL POST







### TYPICAL MOUNTING DETAILS

### GENERAL NOTES

- Milepost marker and highway route number plates shall conform to the latest editions of the following FHWA publications:
  - "Standard Alphabets for Highway Signs" and as amended
  - "Standard Highway Signs" and as amended
  - "Manual on Uniform Traffic Control Devices for Streets and Highways" and as amended
- Milepost markers and highway route numbers shall be completely reflectorized w/reflective sheeting as follows:
  - Milepost markers shall have white legends and border on a green background
  - Highway route numbers shall have black numerals on a white background
- The plate backings for milepost markers and highway route numbers shall conform to the requirements for standard highway signs. The plates shall have 3/8" bolt holes drilled at appropriate locations.
- Highway route number plates shall be used in conjunction w/milepost marker plates on all roadways, except interstate freeways. Fabrication and installation costs of highway route number plates shall be considered incidental to the milepost marker assembly.
- Milepost markers shall be installed on all roadways as follows:
  - One milepost on each side of multi-lane roadways
  - Back-to-back mileposts on one side of 2-lane roadways (right side of roadway in direction of increasing mileage)

<p>The work was prepared by me or under my supervision and construction of this project will be under my observation.</p> <p><i>Bruce E. Meyers</i></p> <p>Expiration Date of License 2/15</p>	<p>U.S. DEPARTMENT OF TRANSPORTATION FEDERAL HIGHWAY ADMINISTRATION CENTRAL FEDERAL LANDS HIGHWAY DIVISION</p>
	<p><b>HDOT STD PLAN TE-16</b></p> <p><b>MILE POSTS</b></p>
	<p>Scale: N/A</p> <p>Date: August 21, 2015</p> <p>SHEET No. 1 OF 1</p>

STATE	SADDLE ROAD PROJECT	SHEET NO.	TOTAL SHEETS
HI	HI SR 200(3)	P35	P40

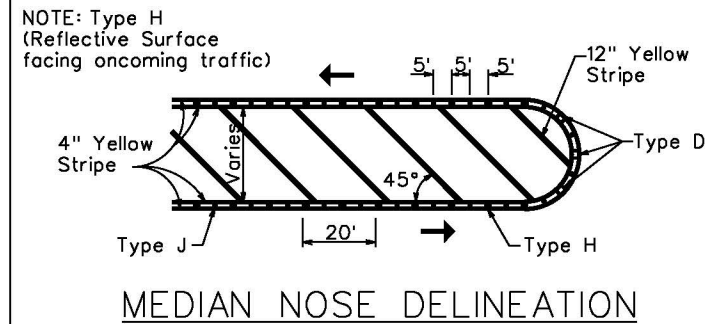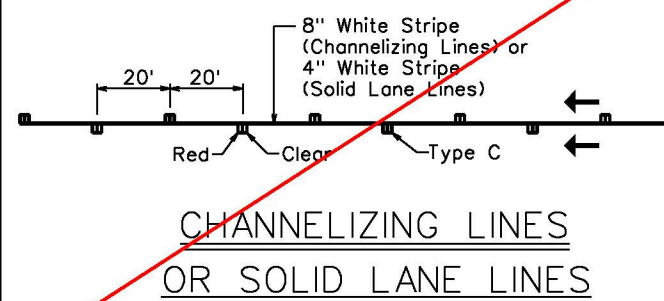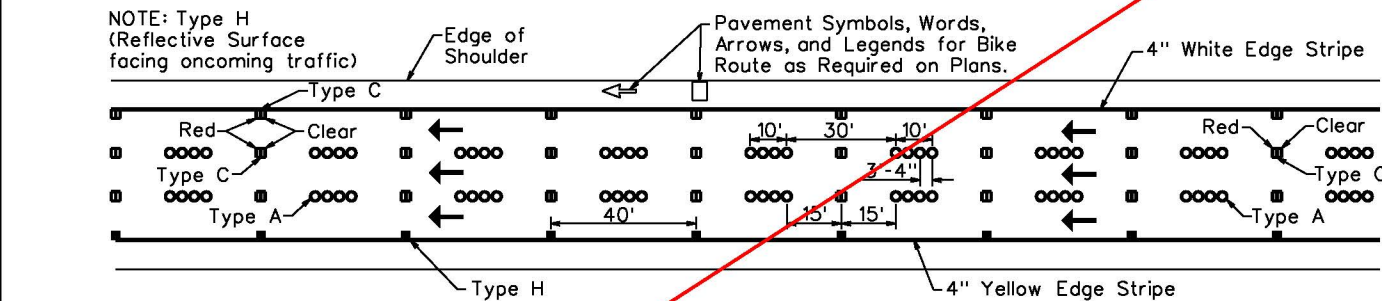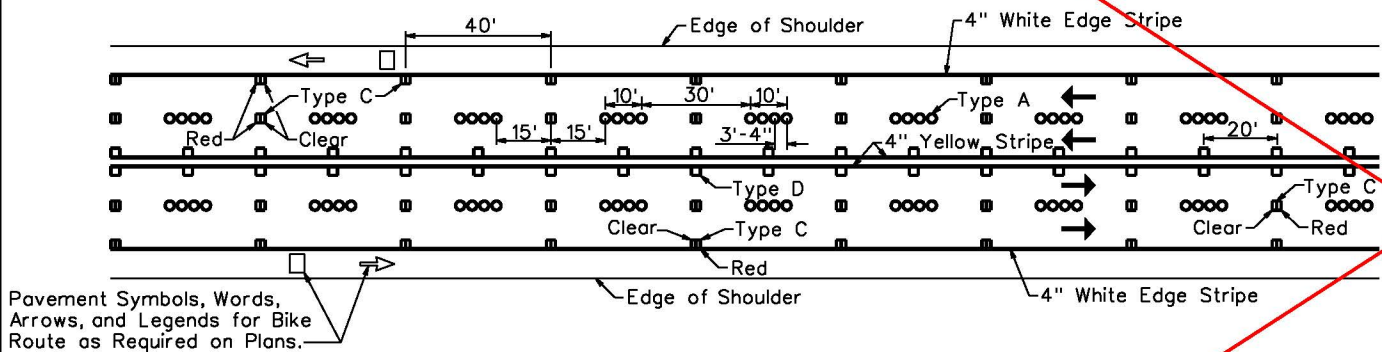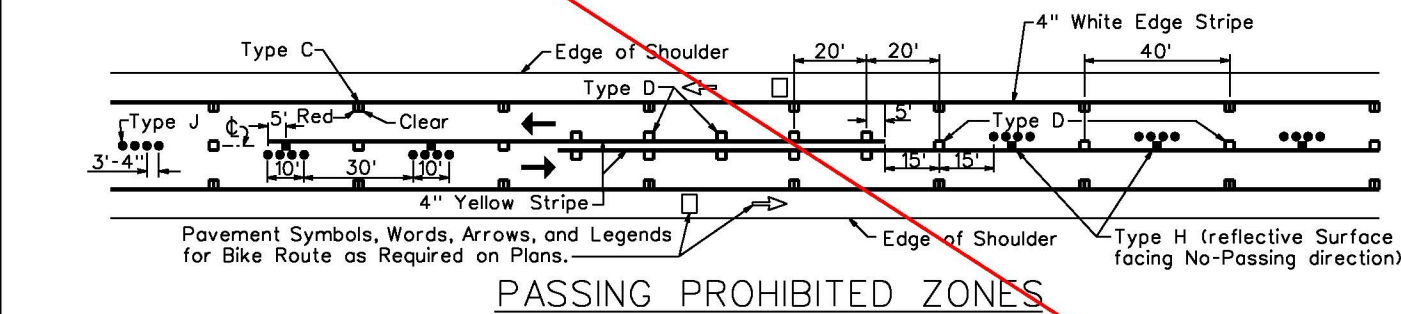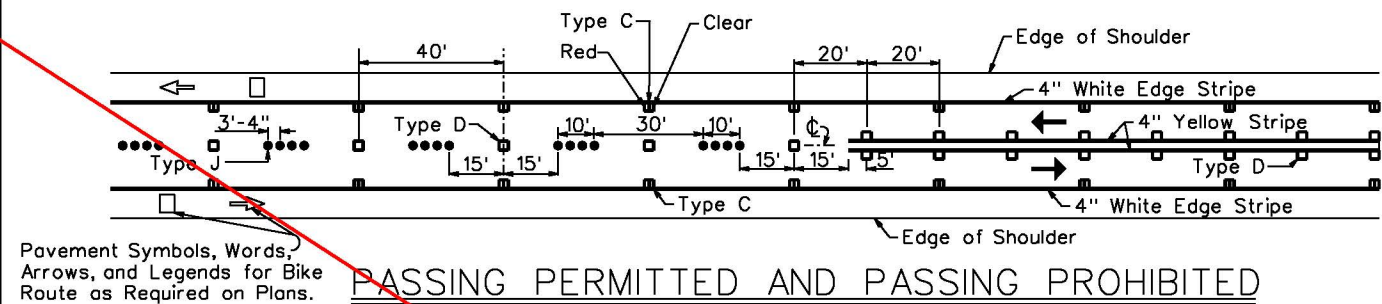


TWO - LANE

MULTI - LANE

DIVIDED HIGHWAY AND FREEWAY

MISCELLANEOUS

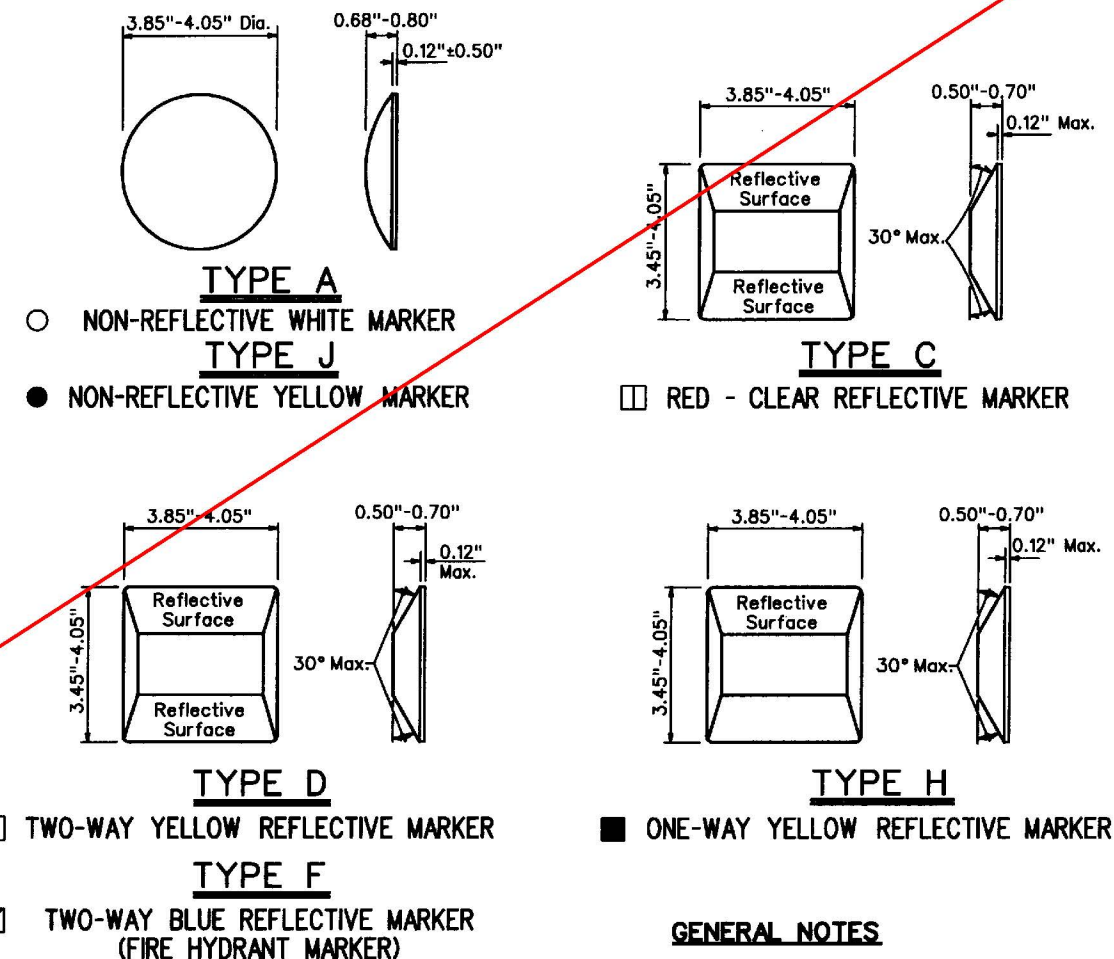

- GENERAL NOTES**
1. Pavement marking and striping shall conform to the latest "Manual on Uniform Traffic Control Devices for Streets and Highways" and as amended.
  2. Layout and installation of pavement marking and striping shall be done by the Contractor. The Contractor shall check the layouts with the Engineer prior to performing work.
  3. Edge lines shall not be continued through intersections and shall not be broken for driveways unless otherwise shown or directed.

The work was prepared by me or under my supervision and construction of this project will be under my observation.

*Bruce E. Meyers*  
Expiration Date of License 2/15

U.S. DEPARTMENT OF TRANSPORTATION  
FEDERAL HIGHWAY ADMINISTRATION  
CENTRAL FEDERAL LANDS HIGHWAY DIVISION

**(SPECIAL) HDOT STD PLAN TE-26  
RAISED PAVEMENT MARKERS  
AND STRIPING**

Scale: N/A Date: August 21, 2015


SHEET No. 1 OF 1

M:\Mproj\Lenzie\Saddle East 11-6\sheet\shp035.dgn




Revised 03/15/18

STATE	SADDLE ROAD PROJECT	SHEET NO.	TOTAL SHEETS
HI	HI SR 200(3)	P35	P40

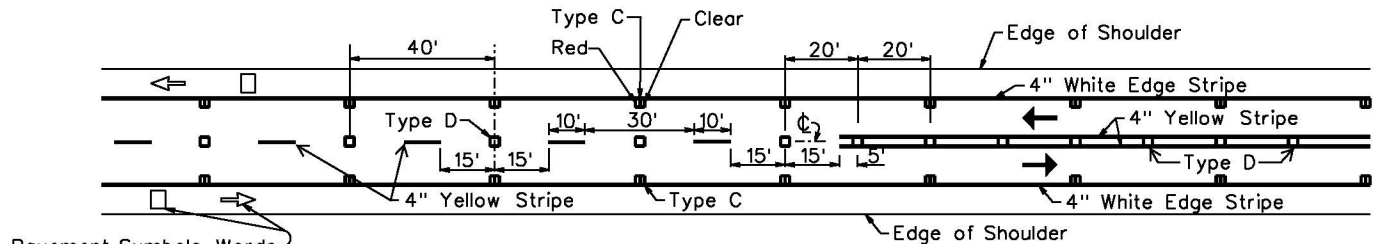


Pavement Symbols, Words, Arrows, and Legends for Bike Route as Required on Plans.

### PASSING PERMITTED AND PASSING PROHIBITED

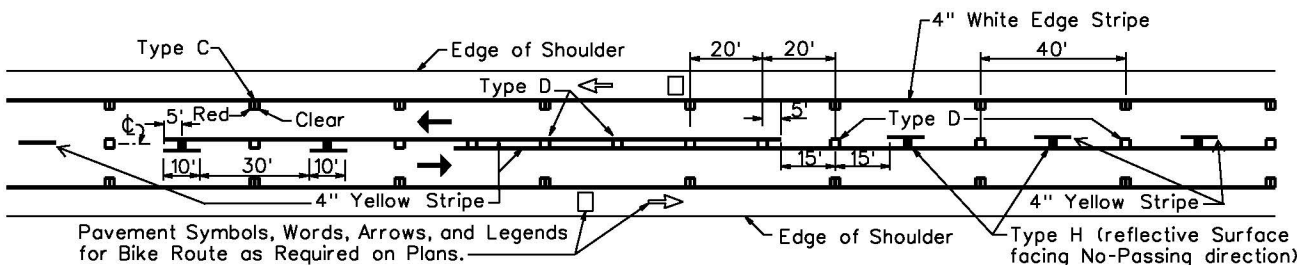


Pavement Symbols, Words, Arrows, and Legends for Bike Route as Required on Plans.

### PASSING PROHIBITED ZONES

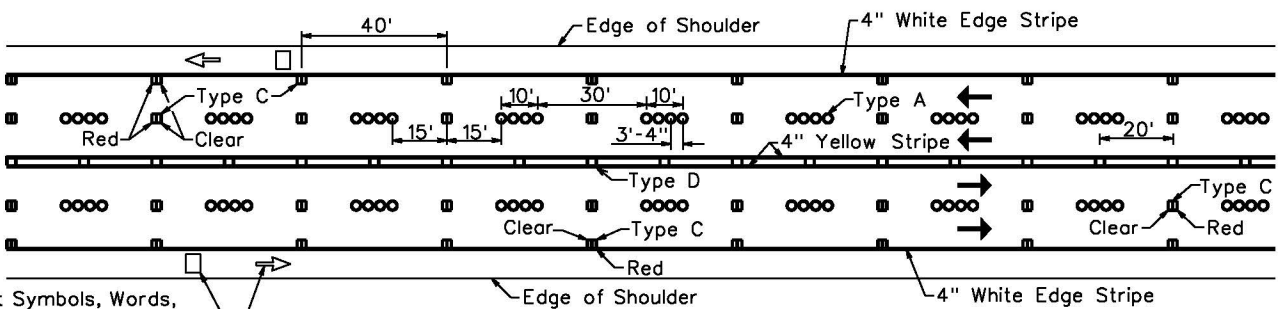


Pavement Symbols, Words, Arrows, and Legends for Bike Route as Required on Plans.

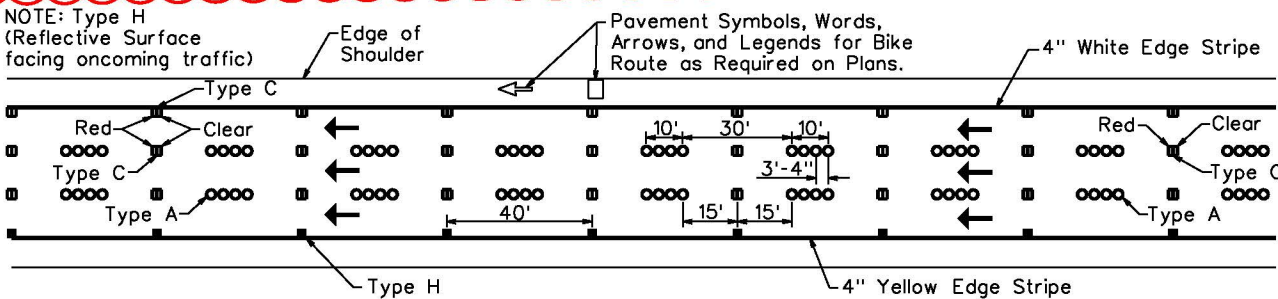


NOTE: Type H (Reflective Surface facing oncoming traffic)

Pavement Symbols, Words, Arrows, and Legends for Bike Route as Required on Plans.

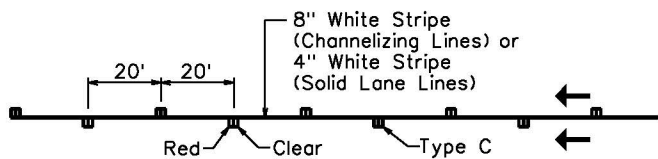

### CHANNELIZING LINES OR SOLID LANE LINES

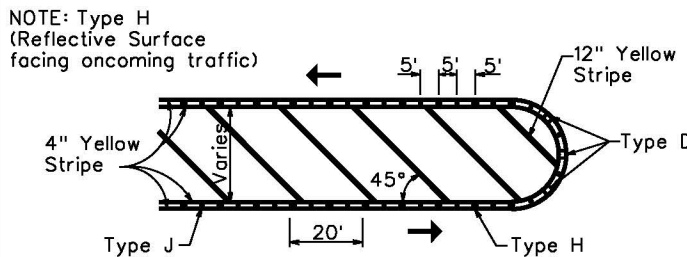


### MEDIAN NOSE DELINEATION

TWO - LANE


MULTI - LANE

DIVIDED HIGHWAY AND FREEWAY


MISCELLANEOUS

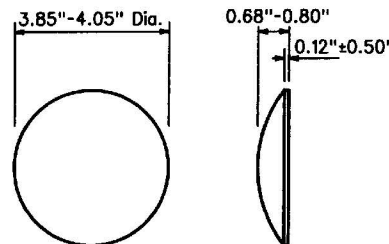

- NON-REFLECTIVE WHITE MARKER
- NON-REFLECTIVE YELLOW MARKER

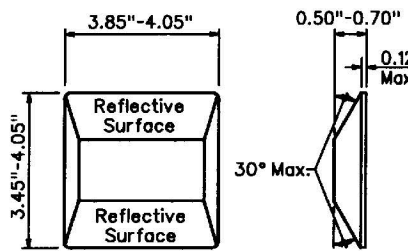

- TWO-WAY YELLOW REFLECTIVE MARKER
- TWO-WAY BLUE REFLECTIVE MARKER (FIRE HYDRANT MARKER)

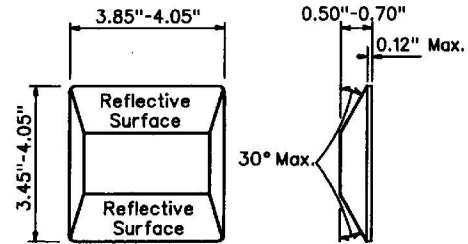

- RED - CLEAR REFLECTIVE MARKER
- ONE-WAY YELLOW REFLECTIVE MARKER

### GENERAL NOTES

- Pavement marking and striping shall conform to the latest "Manual on Uniform Traffic Control Devices for Streets and Highways" and as amended.
- Layout and installation of pavement marking and striping shall be done by the Contractor. The Contractor shall check the layouts with the Engineer prior to performing work.
- Edge lines shall not be continued through intersections and shall not be broken for driveways unless otherwise shown or directed.
- STA 1545+00 to Mamalahoa Highway: Verify and document existing pavement markings (passing and non-passing zones) prior to removal. Replace in-kind.




U.S. DEPARTMENT OF TRANSPORTATION  
FEDERAL HIGHWAY ADMINISTRATION  
CENTRAL FEDERAL LANDS HIGHWAY DIVISION


**(SPECIAL) HDOT STD PLAN TE-26  
RAISED PAVEMENT MARKERS  
AND STRIPING**

Scale: N/A Date: August 21, 2015


SHEET No. 1 OF 1

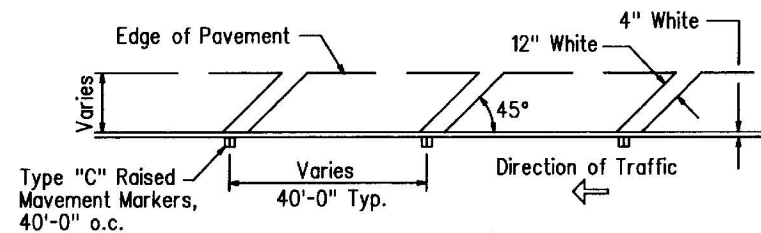


TRANSVERSE RIGHT SHOULDER MARKING

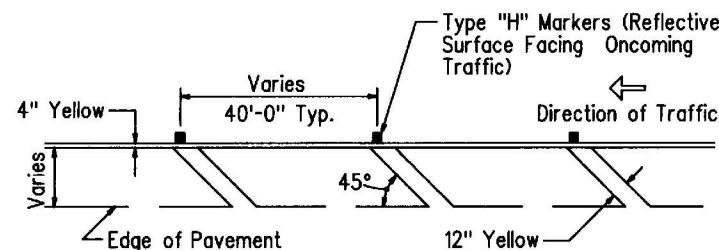


TRANSVERSE LEFT SHOULDER MARKING

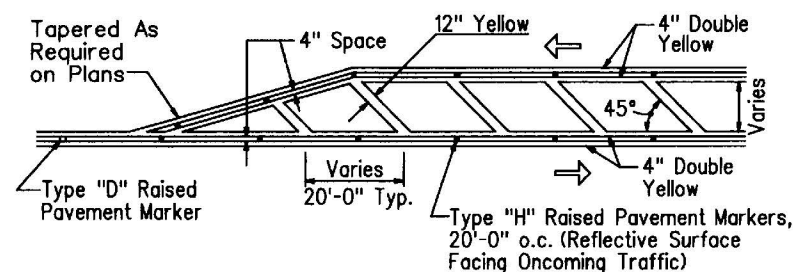

TRANSVERSE MEDIAN MARKING

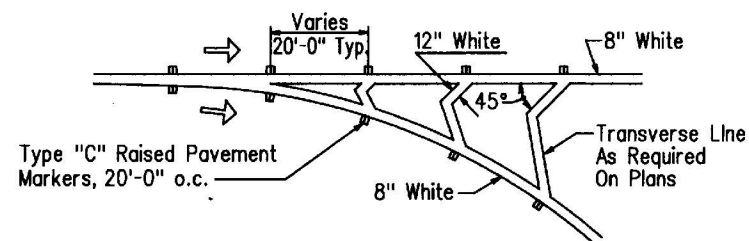


CHANNELIZING ISLAND

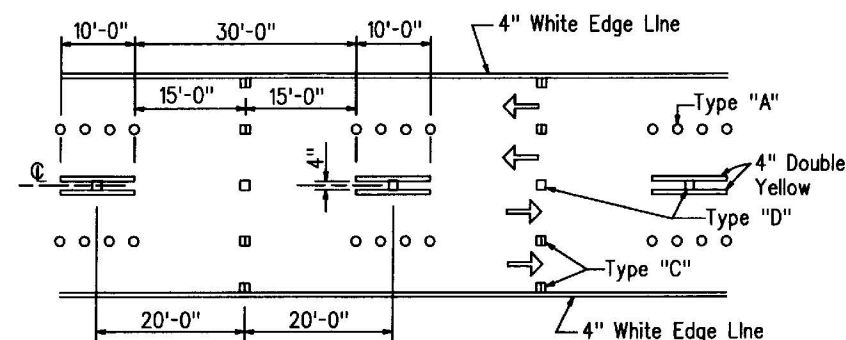

NOTE: Traffic Cone Usage Required


MULTI-LANE  
REVERSIBLE LANES

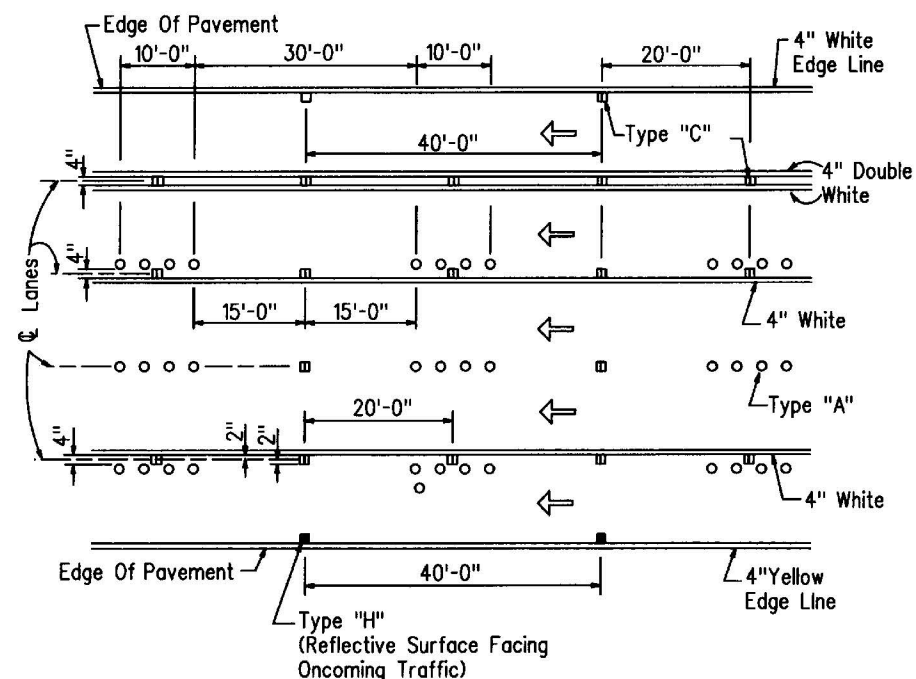


MULTI-LANE  
LANE CHANGE RESTRICTION ZONES

## GENERAL NOTES

- Pavement marking and striping shall conform to the latest edition of the "Manual on Uniform Traffic Control Devices for Streets and Highways" by the FHWA and as amended.
- Layout of pavement markings and striping shall be done by the Contractor. The Contractor shall check layout of markings and striping with the Engineer prior to performing work.
- For additional pavement marking details, see Standard Plan TE-26, TE-28 and TE-29.

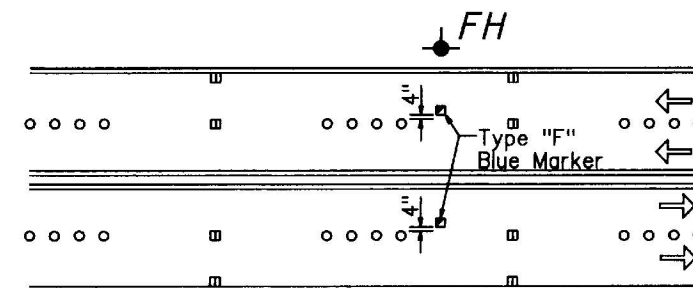

FIRE HYDRANT MARKER LOCATION

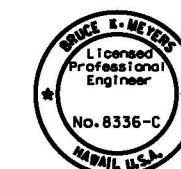

The work was prepared by me or under my supervision and construction of this project will be under my observation.

*Bruce E. Meyers*

Expiration Date of License 2/15.

U.S. DEPARTMENT OF TRANSPORTATION  
FEDERAL HIGHWAY ADMINISTRATION  
CENTRAL FEDERAL LANDS HIGHWAY DIVISION



**HDOT STD PLAN TE-27**  
**RAISED PAVEMENT MARKERS**  
**AND STRIPING**

Scale: N/A


Date: August 21, 2015

SHEET No. 1 OF 1


STATE	SADDLE ROAD PROJECT	SHEET NO.	TOTAL SHEETS
HI	HI SR 200(3)	P37	P40

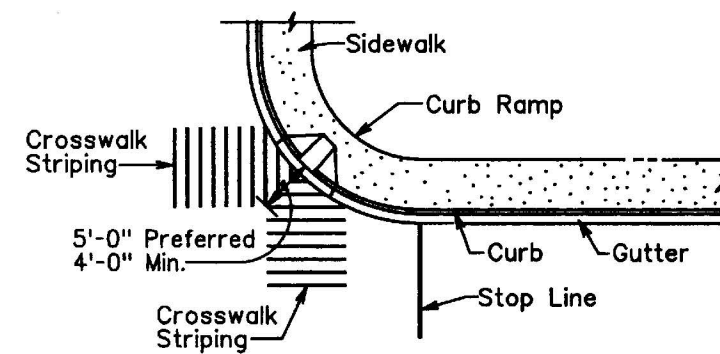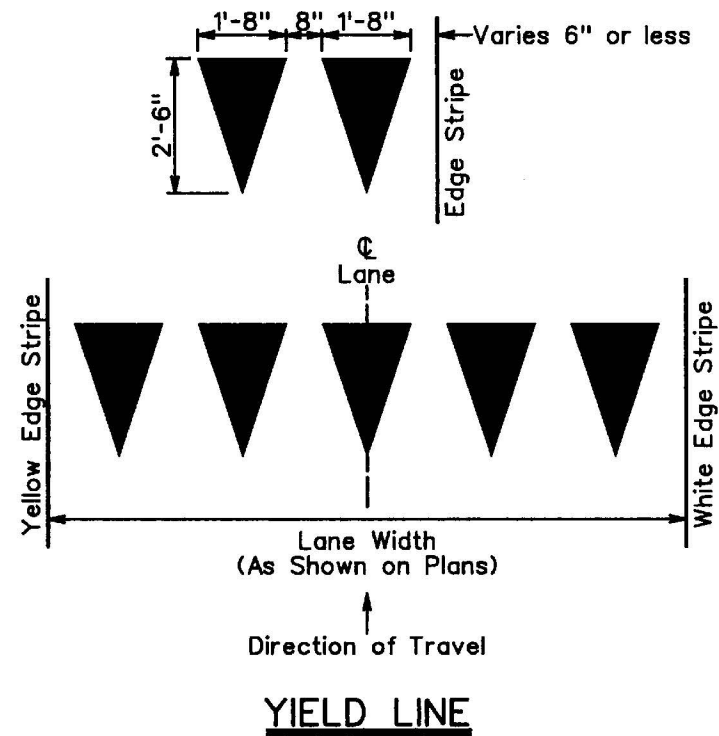

TYPICAL CROSSWALK STRIPING  
AT DIAGONAL CURB RAMP

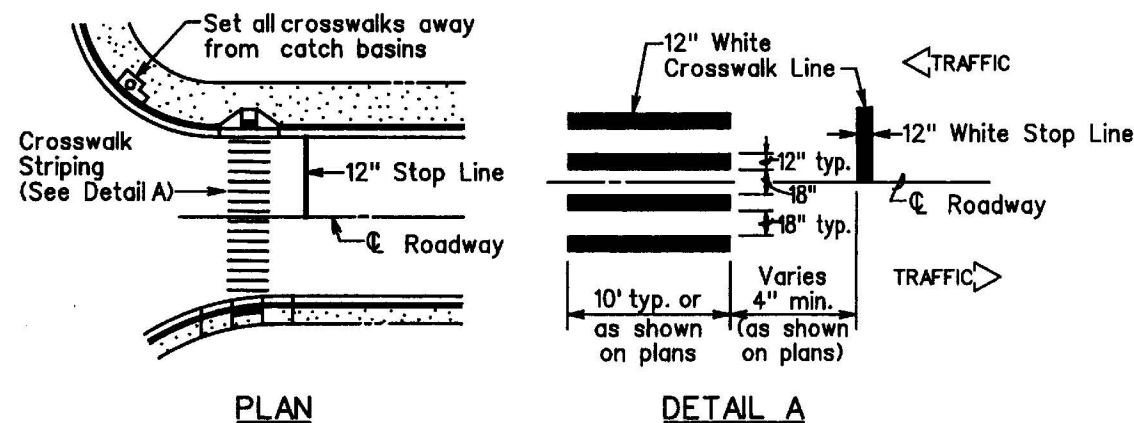

PEDESTRIAN CROSSWALK

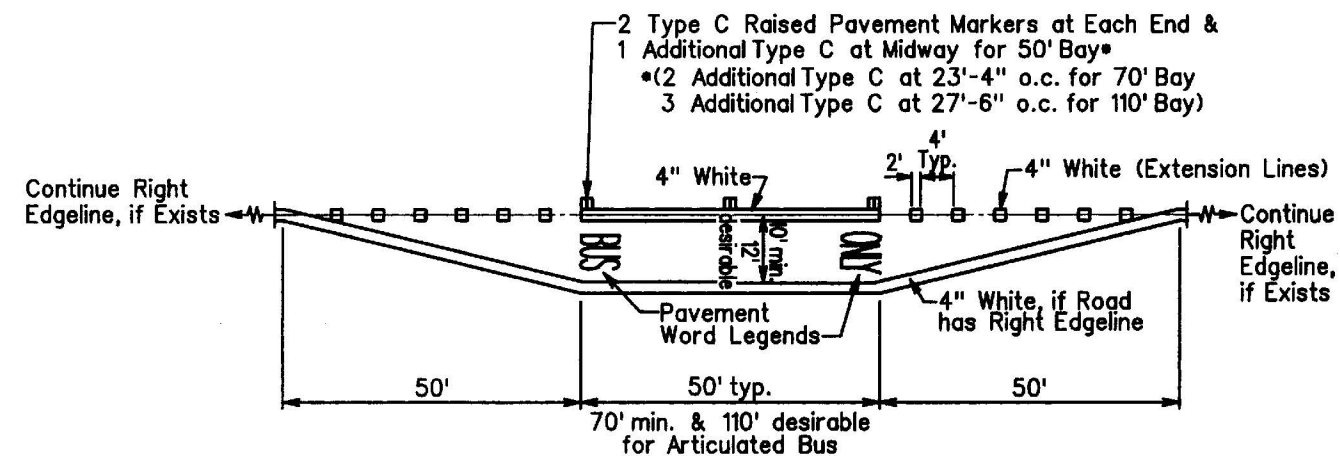

BUS BAY

M:\Mproj\Lenzie\Saddle East 11-6\sheet\shp037.dgn

BRUCE E. MEYERS  
Licensed Professional Engineer  
No. 8336-C  
HAWAII, U.S.A.

The work was prepared by me or under my supervision and construction of this project will be under my observation.  
*Bruce E. Meyers*  
Expiration Date of License 2/15.

U.S. DEPARTMENT OF TRANSPORTATION  
FEDERAL HIGHWAY ADMINISTRATION  
CENTRAL FEDERAL LANDS HIGHWAY DIVISION

**HDOT STD PLAN TE-28A**  
**MISCELLANEOUS**  
**PAVEMENT MARKINGS**

Scale: N/A Date: August 21, 2015


SHEET No. 1 OF 1



STATE	SADDLE ROAD PROJECT	SHEET NO.	TOTAL SHEETS
HI	HI SR 200(3)	P38	P40


## GENERAL NOTES

- Pavement markings and striping shall conform to the latest edition of the "Manual on Uniform Traffic Control Devices for Streets and Highways" by the FHWA and as amended.
- Layout of pavement markings and striping shall be done by the Contractor. The Contractor shall check layout of markings and striping with the Engineer prior to performing work.
- For additional pavement marking details, see Standard Plan TE-26, TE-27 & TE-28.

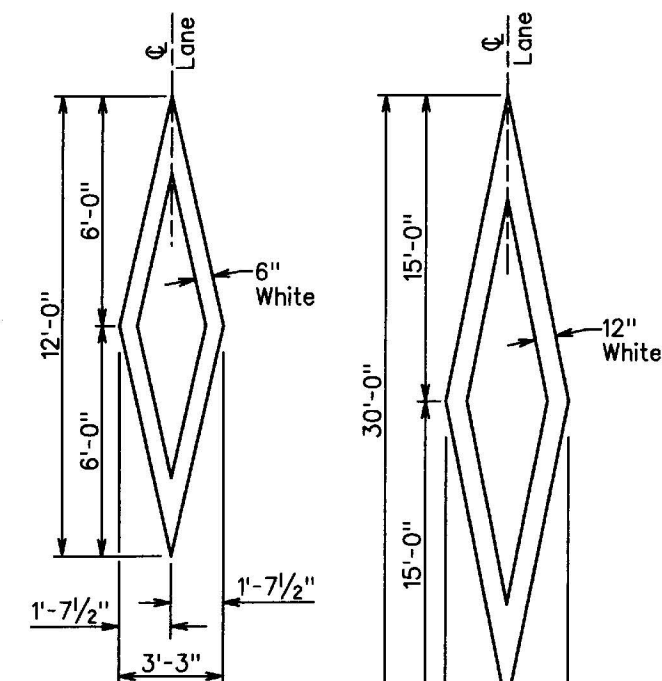


**STANDARD  
HOV LANE  
DIAMOND**

**ELONGATED  
HOV LANE  
DIAMOND**

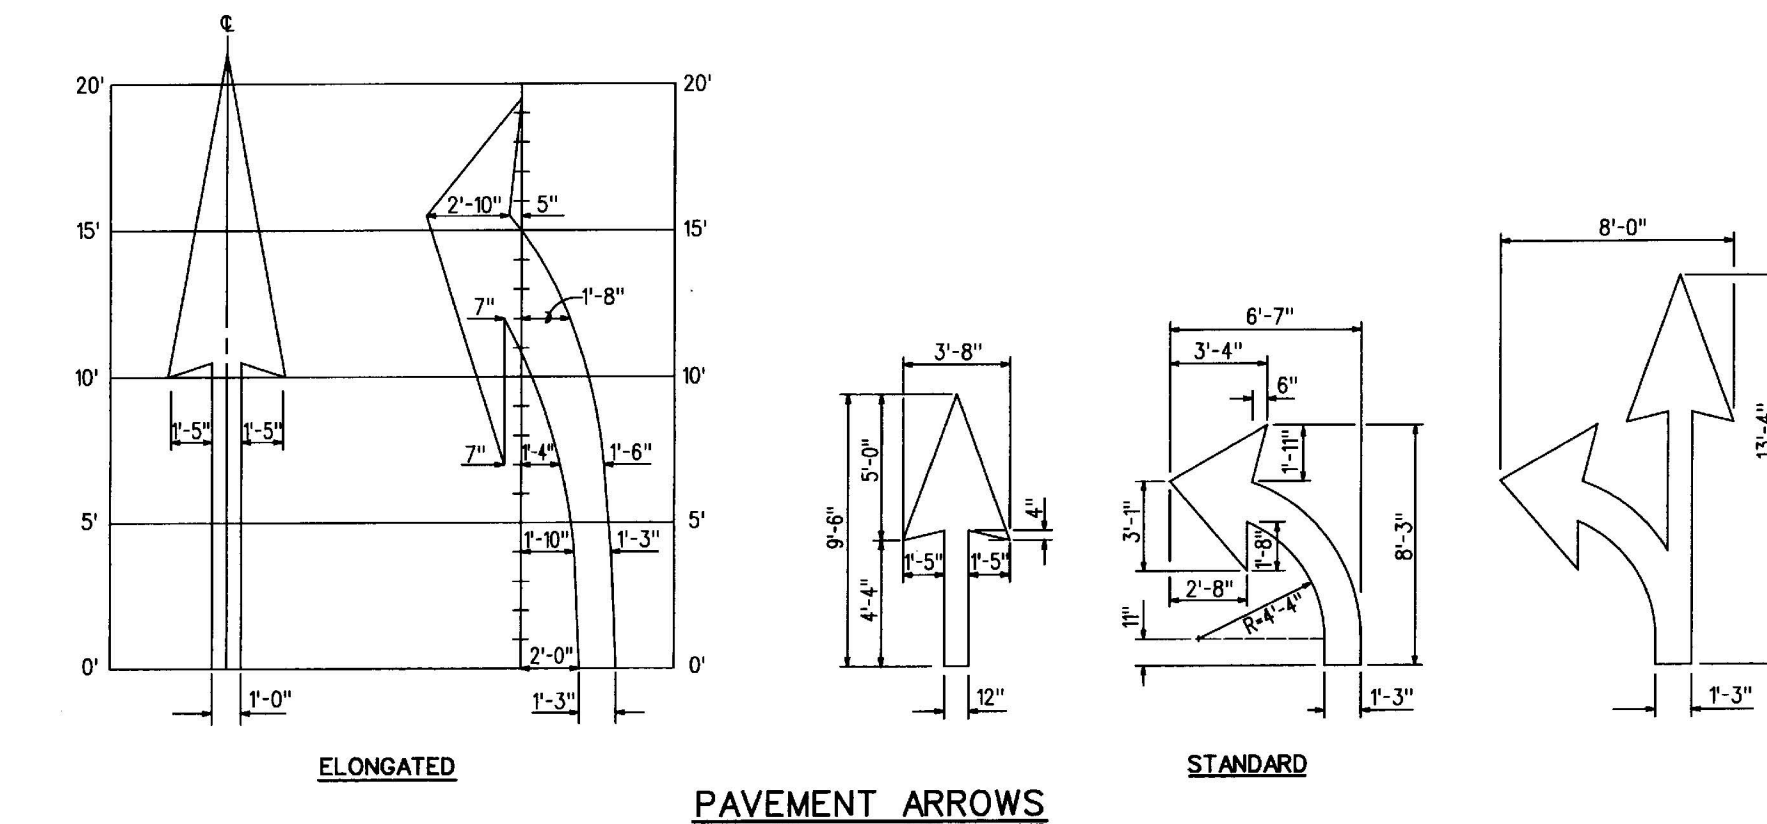

**PAVEMENT ARROWS**

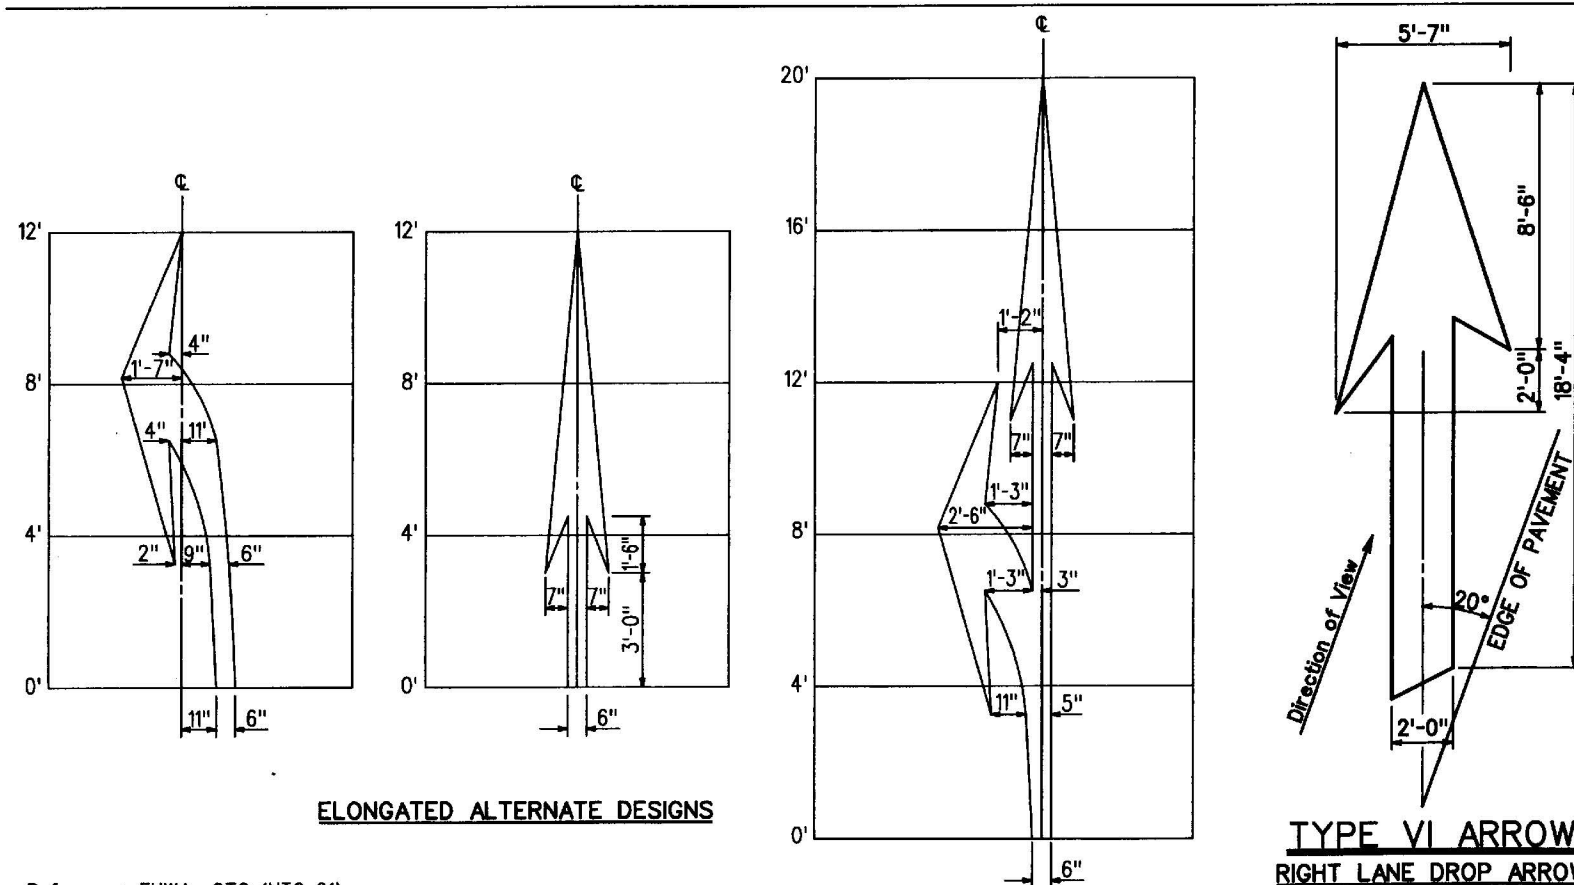




**TYPE VI ARROW  
RIGHT LANE DROP ARROW  
(FOR LEFT LANE DROP,  
USE MIRROR IMAGE)**

Reference: FHWA -OTO-(HTO-21)  
September, 1988

**PAVEMENT ARROWS**

<p>The work was prepared by me or under my supervision and construction of this project will be under my observation.</p> <p><i>Bruce E. Meyers</i></p> <p>Expiration Date of License 2/15.</p>	U.S. DEPARTMENT OF TRANSPORTATION FEDERAL HIGHWAY ADMINISTRATION CENTRAL FEDERAL LANDS HIGHWAY DIVISION	
	<b>HDOT STD PLAN TE-29 PAVEMENT ARROWS AND SYMBOLS</b>	
	Scale: N/A	Date: August 21, 2015
SHEET No. 1 OF 1		

STATE	SADDLE ROAD PROJECT	SHEET NO.	TOTAL SHEETS
HI	HI SR 200(3)	P39	P40

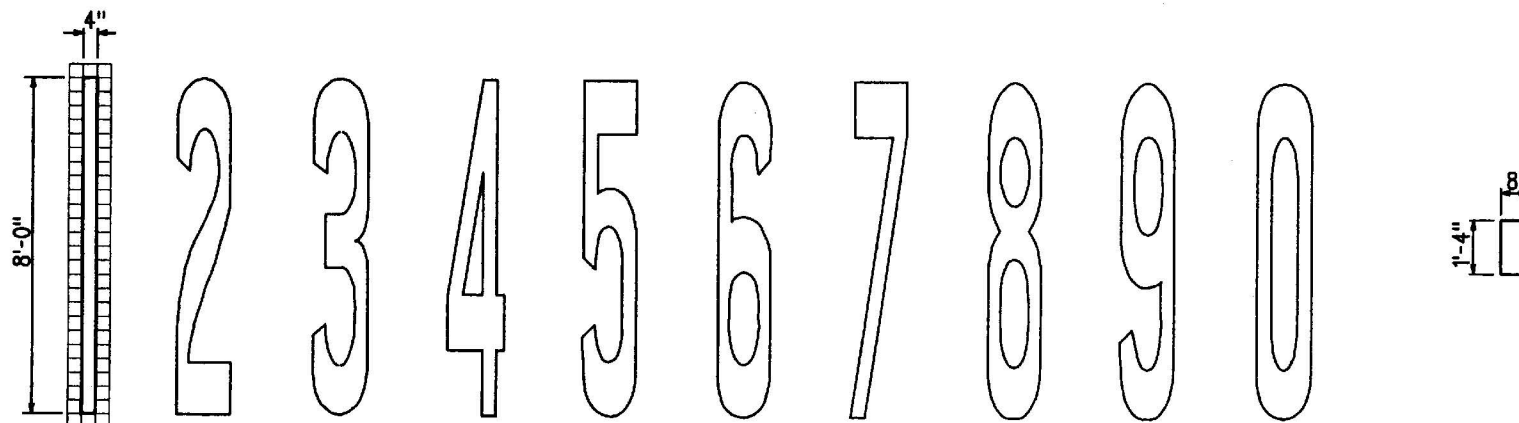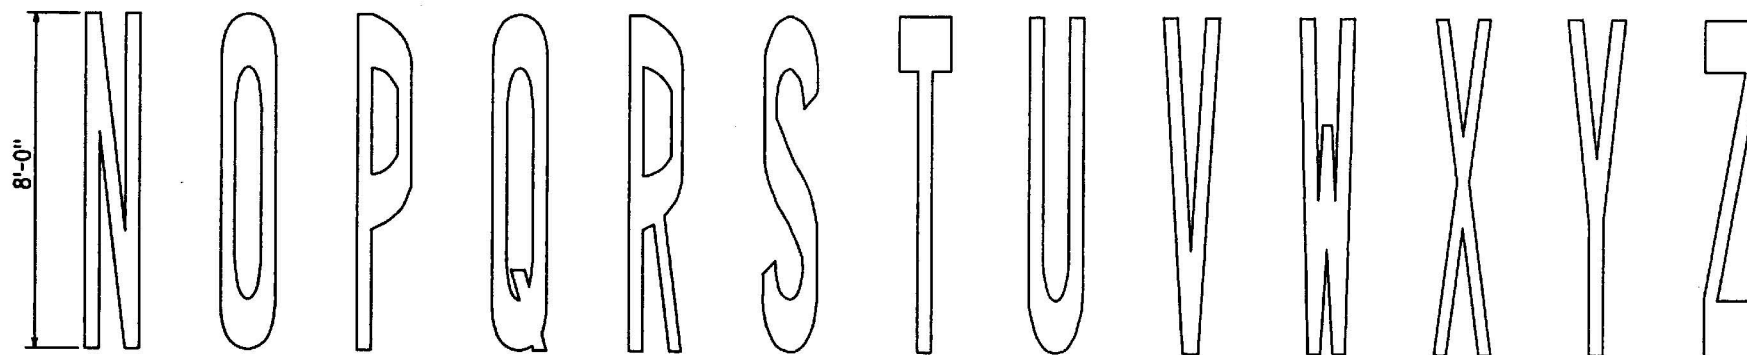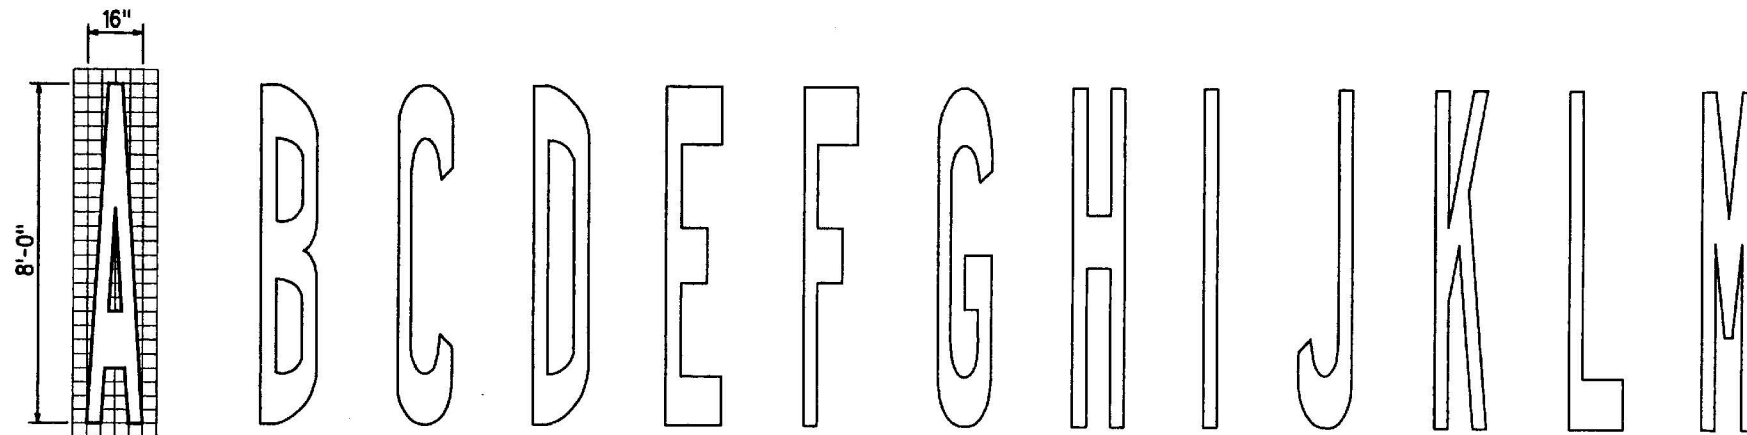

### GENERAL NOTES

- Pavement marking alphabets, numbers and symbols shall conform to Federal Highway Administration Manual on Uniform Traffic Control Devices (MUTCD) and Standard Highway Signs (SHS), and as amended on this sheet.
- Characters shall be based on a 24 units high and 4 units wide grid system. Each grid shall be equivalent to 4" in length. Typical height and width of each character shall respectively be 8' high and 1'-4" wide.
 


Exceptions:

  - Letter "I" and number "1" shall be only 1 unit wide.
  - Dashed symbol shall be 4 units high and 2 units wide.










Horizontal strokes shall be 4 units high. Vertical strokes are 1 unit wide.

- The space between characters in a word shall be 1 unit.
- Color of all pavement messages shall be white.
- Pavement message shall be best centered longitudinally within the lane.
- When applicable to bike lane without sufficient lane width, pavement marking alphabets, numbers and symbols shall be narrowed in accordance with MUTCD Part 9 Traffic Controls for Bicycle Facilities.
- Minor variations in dimensions may be allowed when approved by the Engineer.
- Unless otherwise approved by the Engineer, only the following standard pavement messages may be used:

BIKE LANE  
 BUS ONLY  
 HOV (High Occupancy Vehicle)  
 LEFT TURN ONLY  
 PED XING  
 RIGHT TURN ONLY  
 SCHOOL XING  
 SHLDR LANE  
 SIGNAL AHEAD  
 STOP  
 STOP AHEAD  
 YIELD AHEAD

 <p>The work was prepared by me or under my supervision and construction of this project will be under my observation.</p> <p><i>Bruce E. Meyers</i></p> <p>Expiration Date of License 2/15.</p>	U.S. DEPARTMENT OF TRANSPORTATION FEDERAL HIGHWAY ADMINISTRATION CENTRAL FEDERAL LANDS HIGHWAY DIVISION	
	<b>HDOT STD PLAN TE-30</b> <b>PAVEMENT ALPHABETS,</b> <b>NUMBERS &amp; SYMBOLS</b>	
	Scale: N/A	Date: August 21, 2015
SHEET No. 1 OF 1		

STATE	SADDLE ROAD PROJECT	SHEET NO.	TOTAL SHEETS
HI	HI SR 200(3)	P40	P40

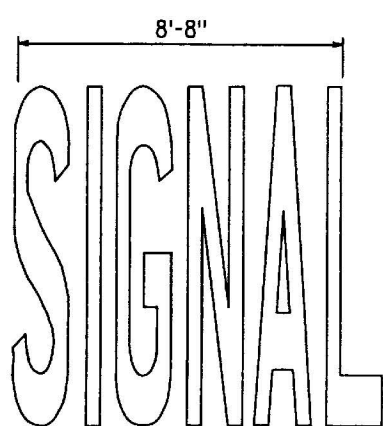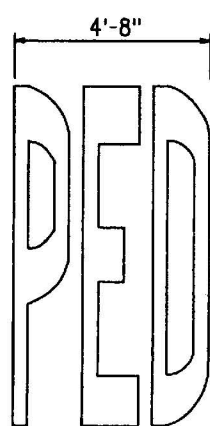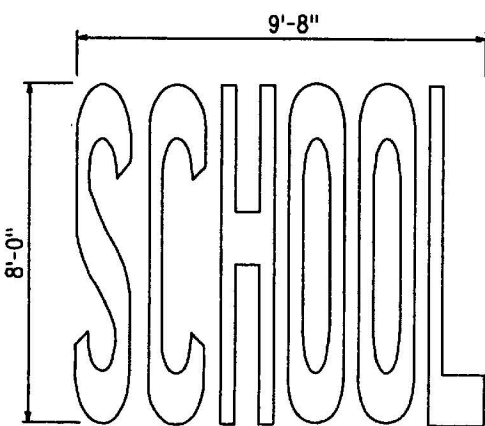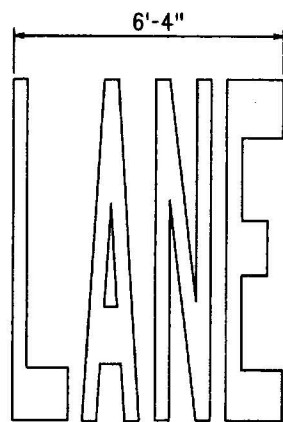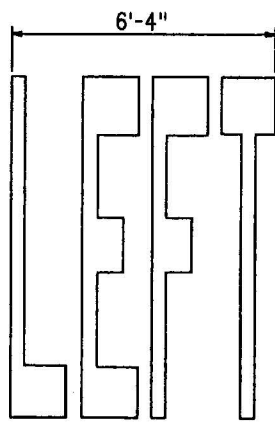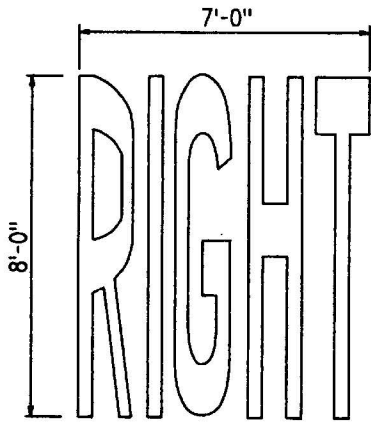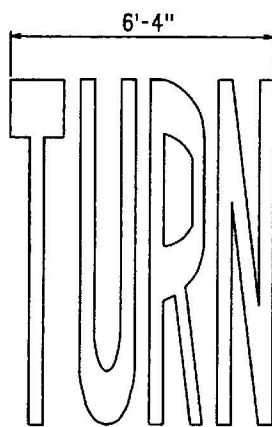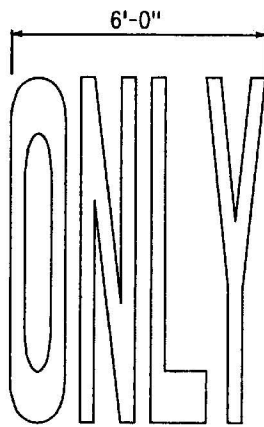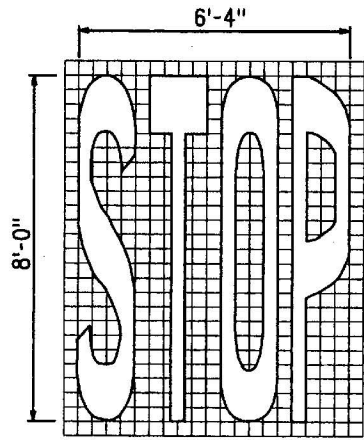

**GENERAL NOTES**

1. All messages not shown must be approved by the Engineer prior to installation.
2. The space between characters in a message shall be 1 grid unit unless otherwise shown or directed.
3. All pavement messages shall be white in color.



The work was prepared by me or under my supervision and construction of this project will be under my observation.  
*Bruce E. Meyers*  
Expiration Date of License 2/15.

U.S. DEPARTMENT OF TRANSPORTATION  
FEDERAL HIGHWAY ADMINISTRATION  
CENTRAL FEDERAL LANDS HIGHWAY DIVISION

**HDOT STD PLAN TE-31**  
**PAVEMENT ALPHABETS,**  
**NUMBERS & SYMBOLS**

Scale: N/A Date: August 21, 2015

SHEET No. 1 OF 1