


STATE	SADDLE ROAD PROJECT	SHEET NO.	TOTAL SHEETS
HI	HI SR 200(3)	L12	L27

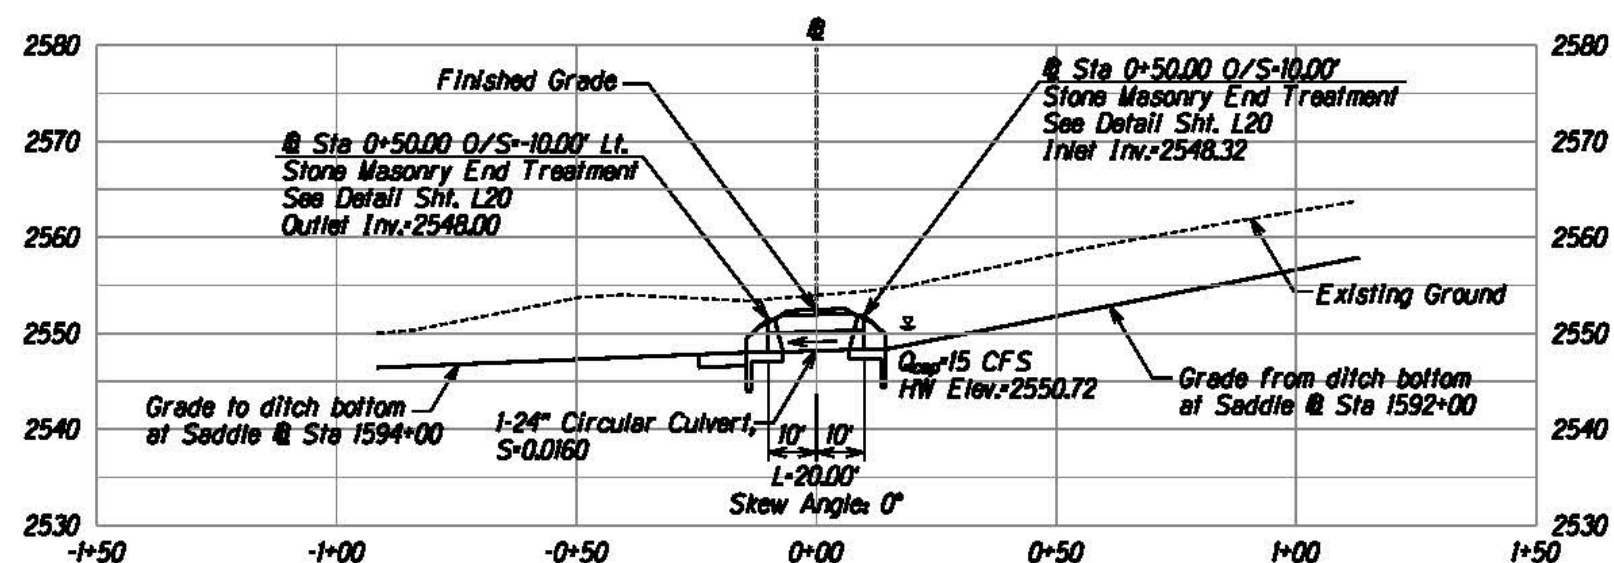


Hawaii Conference Foundation Access Road, Right

@ Sta 0+50

Scale: Horz. 1"=40'

Vert. 1"=20'

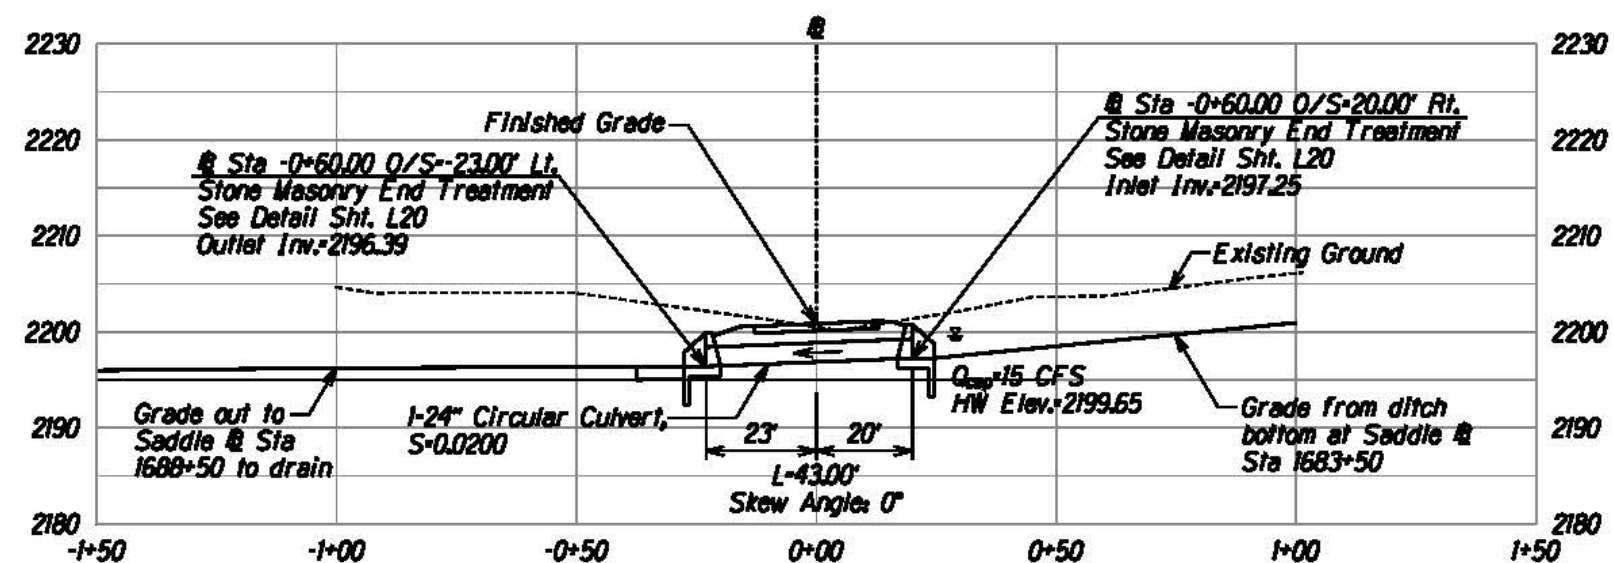

Arlie & Company Access Road, Left

@ Sta -0+60

Scale: Horz. 1"=40'

Vert. 1"=20'



The work was prepared by me or under my supervision and construction of this project will be under my supervision.
David S. M.
 Expiration Date of License 2016.

U.S. DEPARTMENT OF TRANSPORTATION
 FEDERAL HIGHWAY ADMINISTRATION
 CENTRAL FEDERAL LANDS HIGHWAY DIVISION


APPROACH ROAD CULVERT PROFILE

Scale: As Noted

Date: August 21, 2015


SHEET No. 1 OF 6

U:\proj\Lennie\Saddle East II-6\sheet\sh1012.dgn

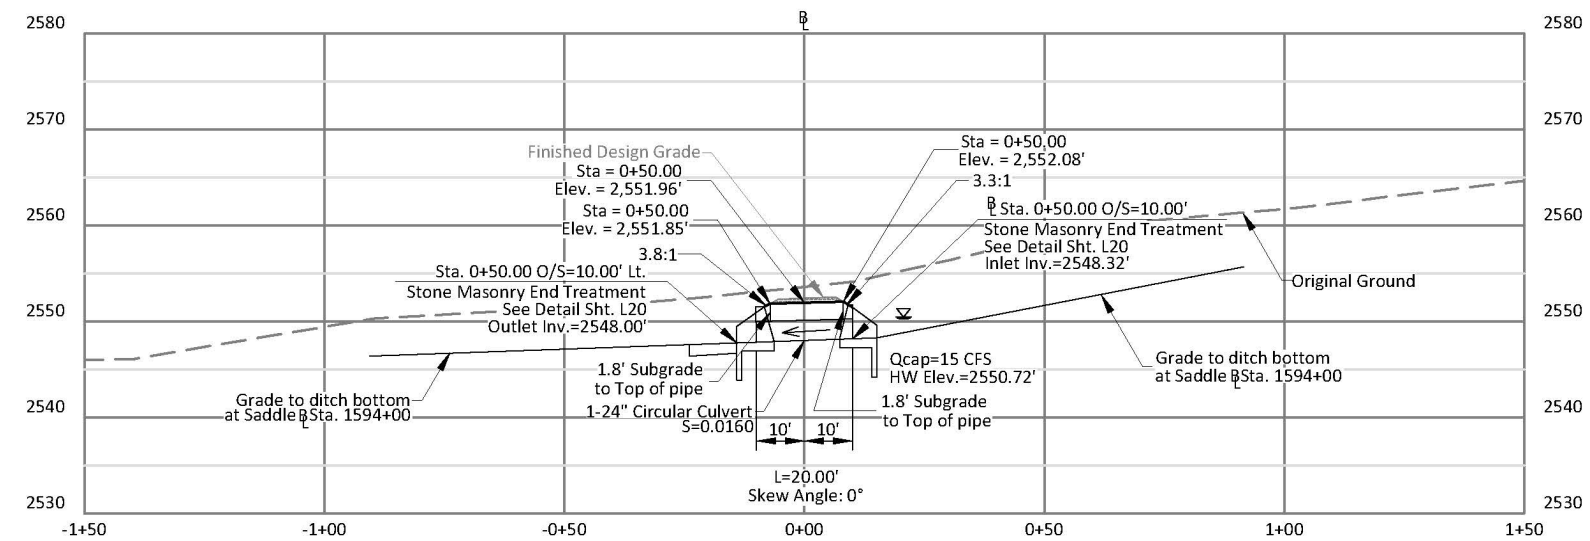

HAWAII CONFERENCE FOUNDATION ACCESS ROAD, RIGHT

STA. 0+50

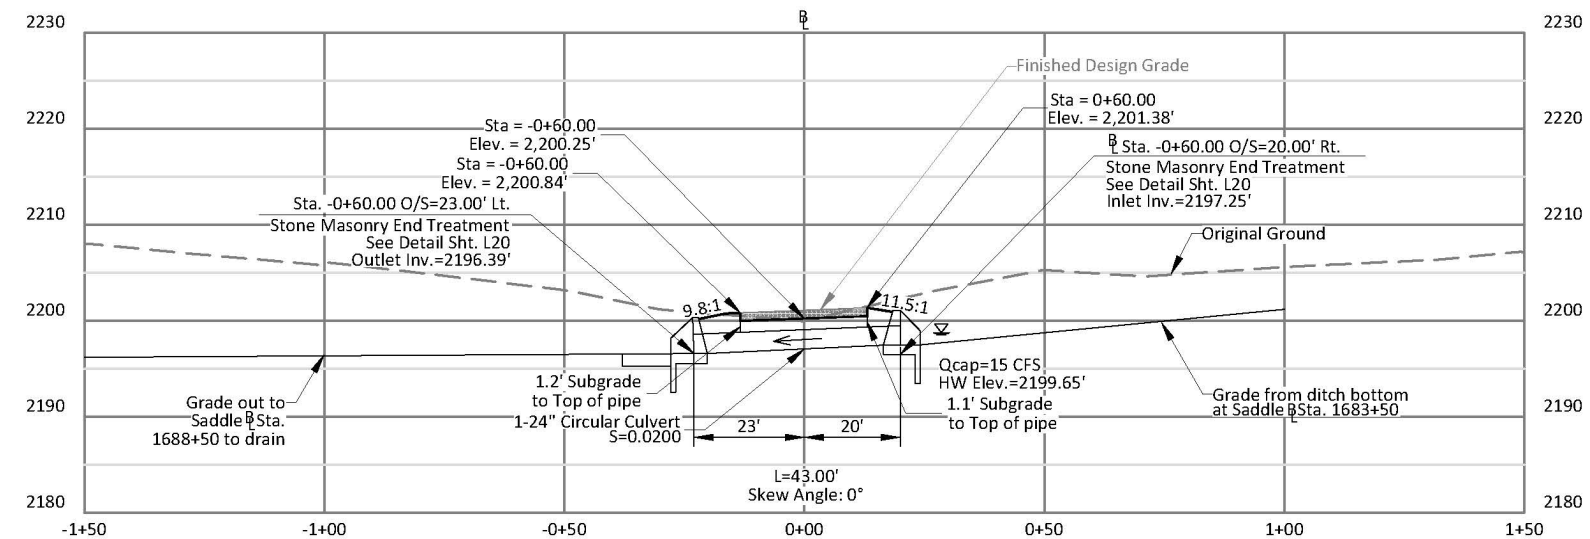

ARLIE & COMPANY ACCESS ROAD, LEFT

STA. 0+60

NOTES:
Prepare culvert subgrade as shown on sheet L27.
Station and offset labels are based on centerline of road alignment.
Elevations shown are to final design grade unless otherwise noted.

CONFIDENTIALITY NOTES:

The information contained in this exhibit is legally privileged and confidential information intended only for the use of the recipients. If you are not the intended recipients, you are hereby notified that any use, dissemination, distribution or copying of this information is strictly prohibited.

REVISIONS:



**WILLIAM H. SMITH
& ASSOCIATES, INC.**
SURVEYORS ENGINEERS PLANNERS
550 EAST SECOND NORTH
GREEN RIVER, WY 82935
PHONE: 307-875-3638
FAX: 307-875-3639
www.whtsmithpc.com

DRAWN BY: MJH
SCALE: 1"=40'H & 20'V
DATE: 06/01/2016


CHECKED BY: BLM
JOB NO: 2016025
SHEET 1 OF 6



**APPROACH ROAD
CULVERT PROFILE**

✓


STATE	SADDLE ROAD PROJECT	SHEET NO.	TOTAL SHEETS
HI	HI SR 200(3)	L13	L27

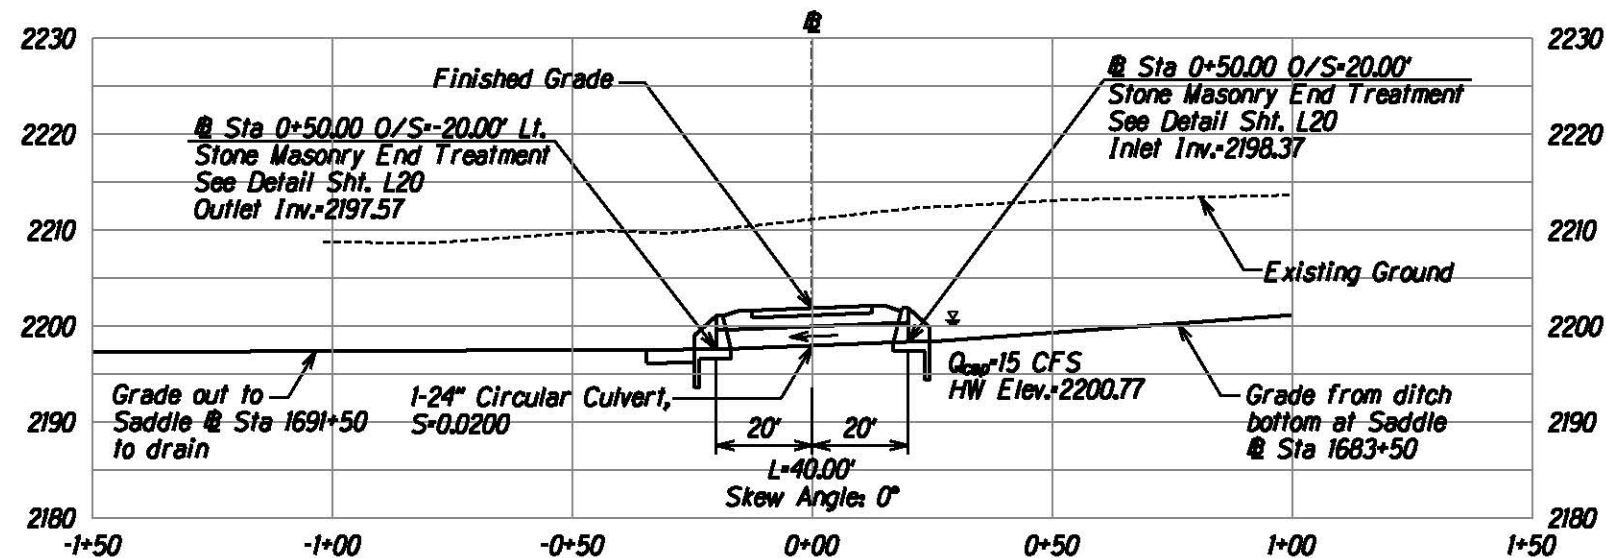

Arlie & Company Access Road, Right

Sta 0+50
Scale: Horz. 1"=40'
Vert. 1"=20'

Culvert
relocated to
1686+25

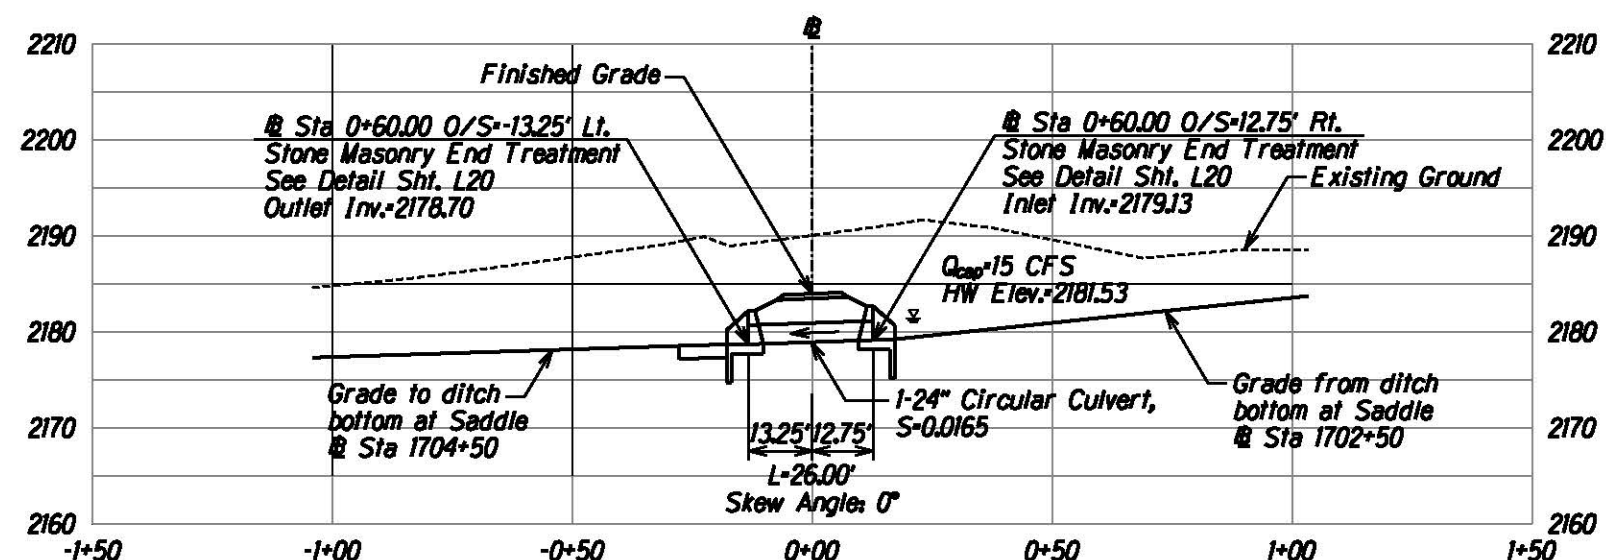

State Forest Reserve Access Road No. 3

Sta 0+60
Scale: Horz. 1"=40'
Vert. 1"=20'



The work was prepared by me
or under my supervision and
construction of this project will
be under my observation.
Bruce E. Meyers
Expiration Date of License 2/15



U.S. DEPARTMENT OF TRANSPORTATION
FEDERAL HIGHWAY ADMINISTRATION
CENTRAL FEDERAL LANDS HIGHWAY DIVISION

APPROACH ROAD CULVERT PROFILE

Scale: As Noted Date: August 21, 2015

SHEET No. 2 OF 6

STATE	SADDLE ROAD PROJECT	SHEET NO.	TOTAL SHEETS
HI	HI SR 200(3)	L4	L27

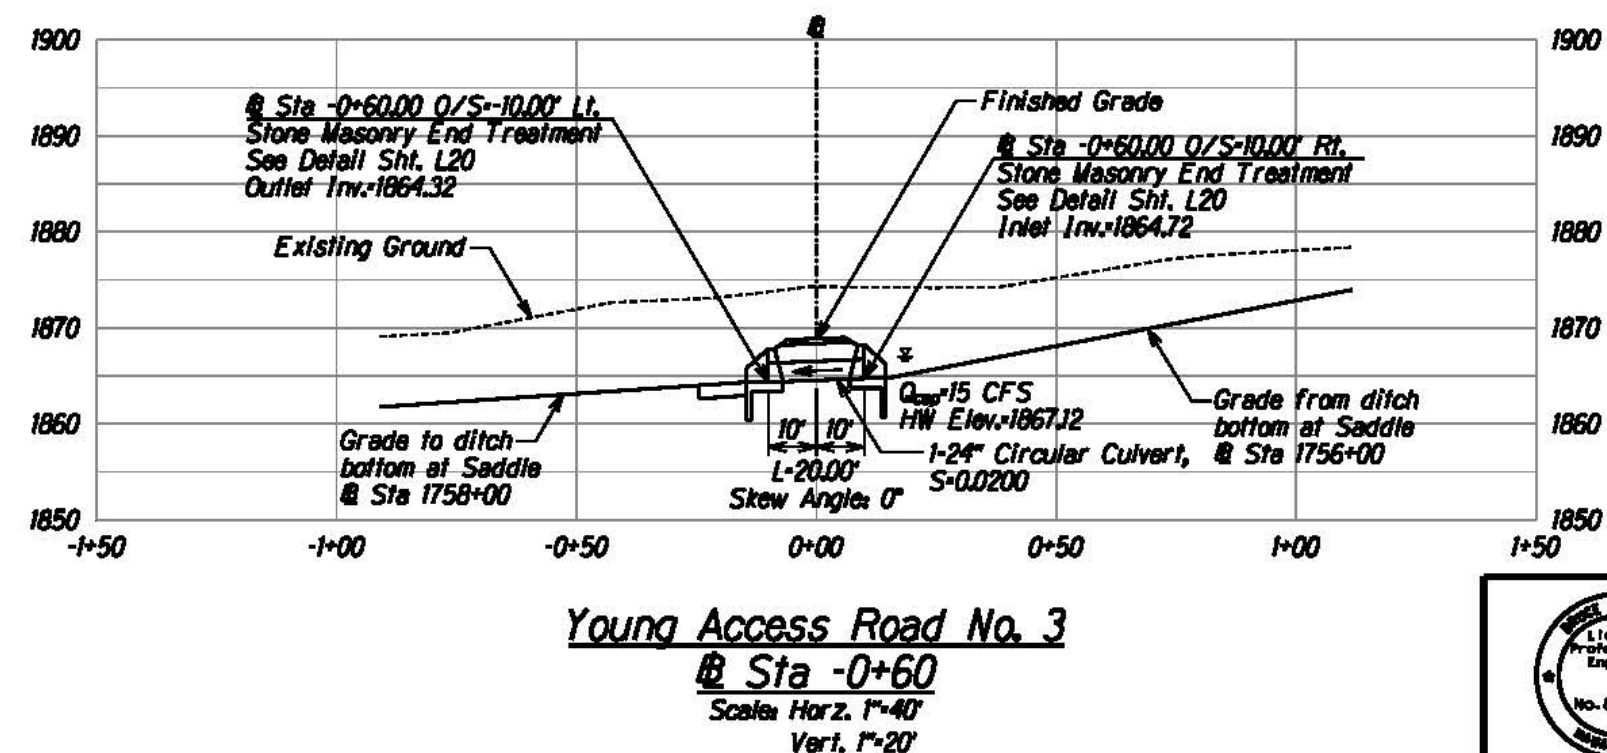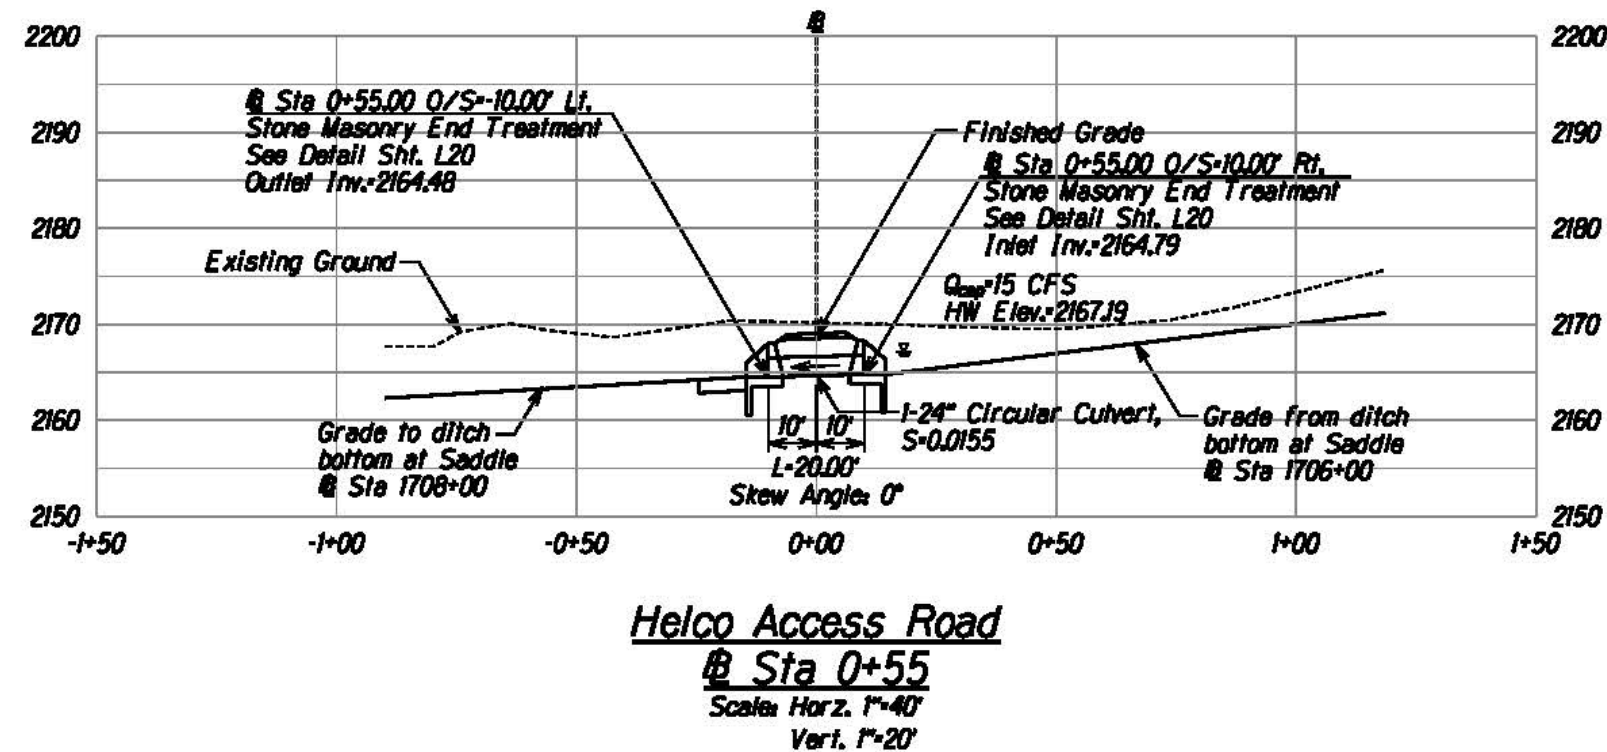

The work was prepared by me or under my supervision and construction of this project will be under my supervision.
 David S. M.
 Expiration Date of License 2016.


U.S. DEPARTMENT OF TRANSPORTATION
 FEDERAL HIGHWAY ADMINISTRATION
 CENTRAL FEDERAL LANDS HIGHWAY DIVISION

APPROACH ROAD CULVERT PROFILE

Scale: As Noted


Date: August 21, 2015

SHEET No. 3 OF 6

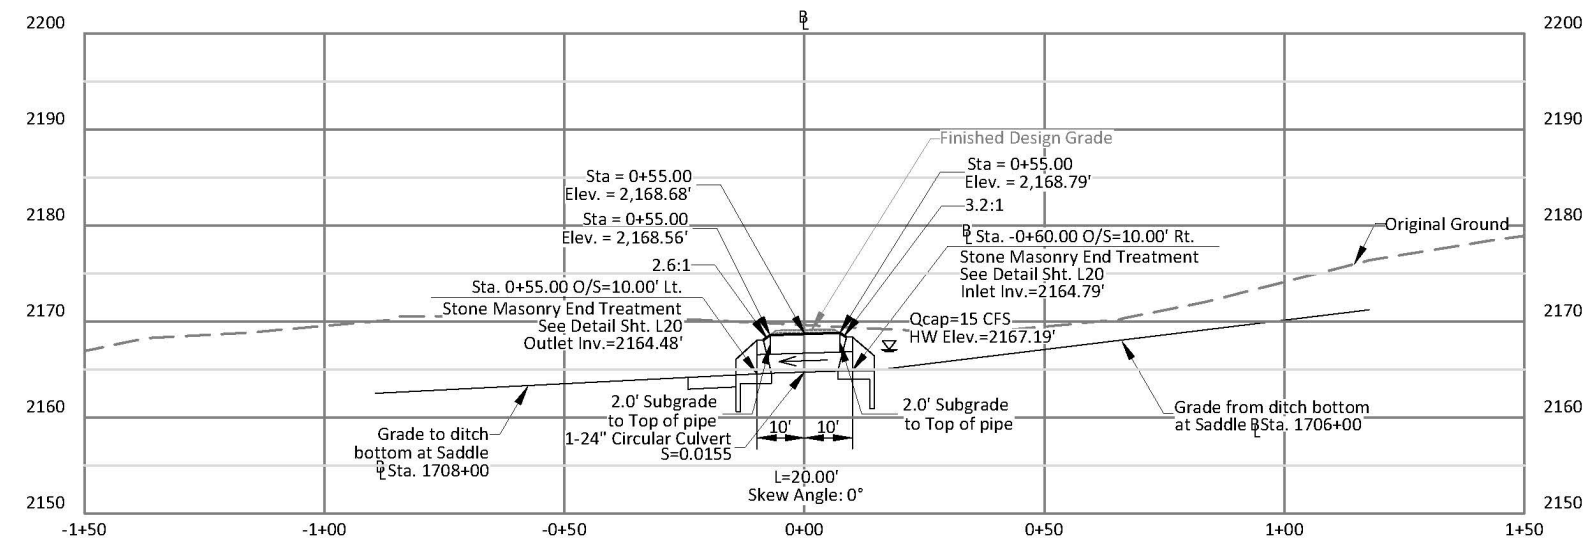

HELCO ACCESS ROAD

STA. 0+55

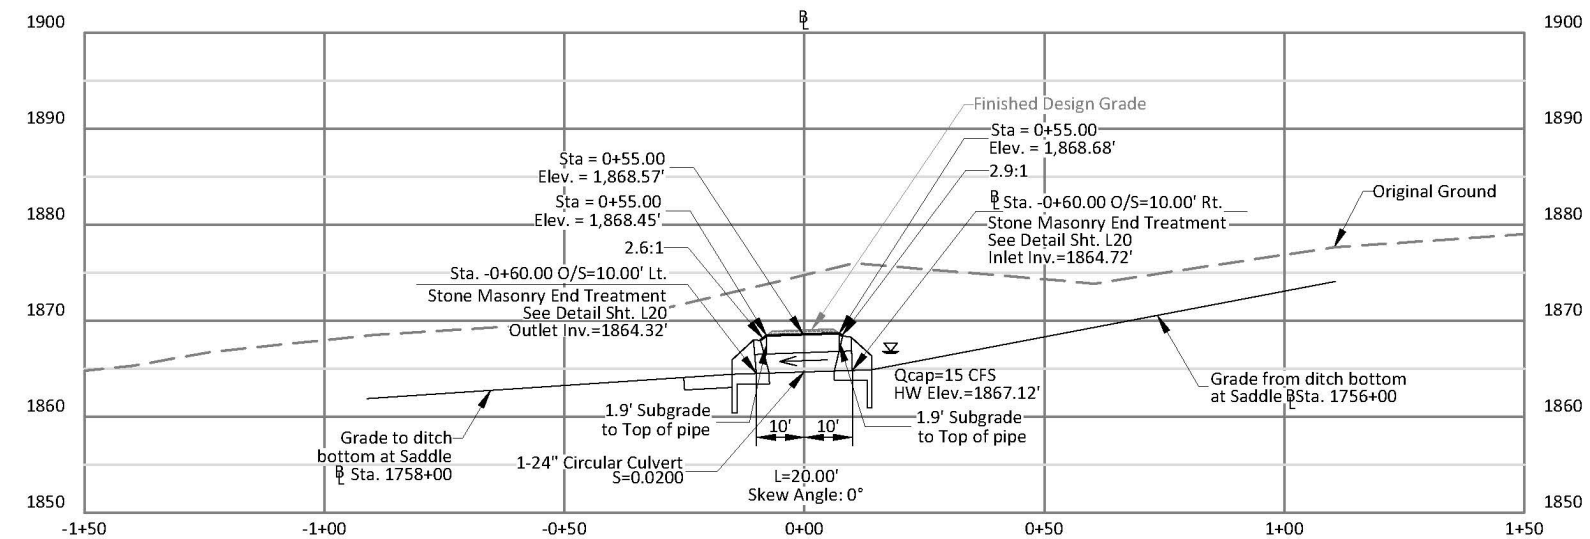

YOUNG ACCESS ROAD NO. 3

STA. -0+60

NOTES:
Prepare culvert subgrade as shown on sheet L27.
Station and offset labels are based on centerline of road alignment.
Elevations shown are to final design grade unless otherwise noted.

CONFIDENTIALITY NOTES:

The information contained in this exhibit is legally privileged and confidential information intended only for the use of the recipients. If you are not the intended recipients, you are hereby notified that any use, dissemination, distribution or copying of this information is strictly prohibited.

REVISIONS:



**WILLIAM H. SMITH
& ASSOCIATES, INC.**
SURVEYORS ENGINEERS PLANNERS
550 EAST SECOND NORTH PHONE: 307-875-3638
GREEN RIVER, WY 82935 FAX: 307-875-3639
www.wsmithpc.com



DRAWN BY: MJH	CHECKED BY: BLM
SCALE: 1"=40'H & 20'V	JOB NO: 2016025
DATE: 06/01/2016	SHEET 3 OF 6



**APPROACH ROAD
CULVERT PROFILE**

✓

STATE	SADDLE ROAD PROJECT	SHEET NO.	TOTAL SHEETS
HI	HI SR 200(3)	L15	L27

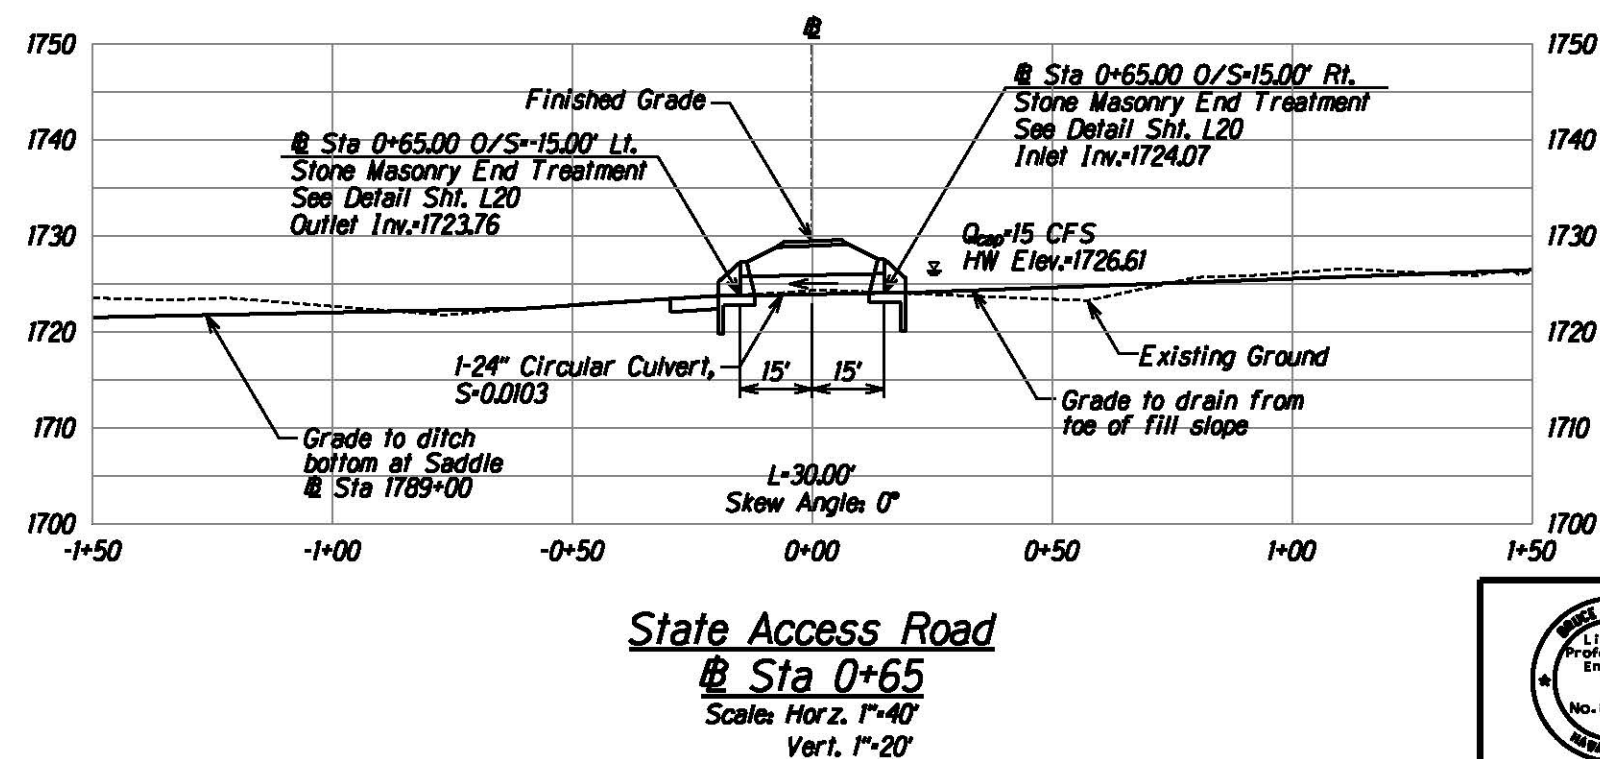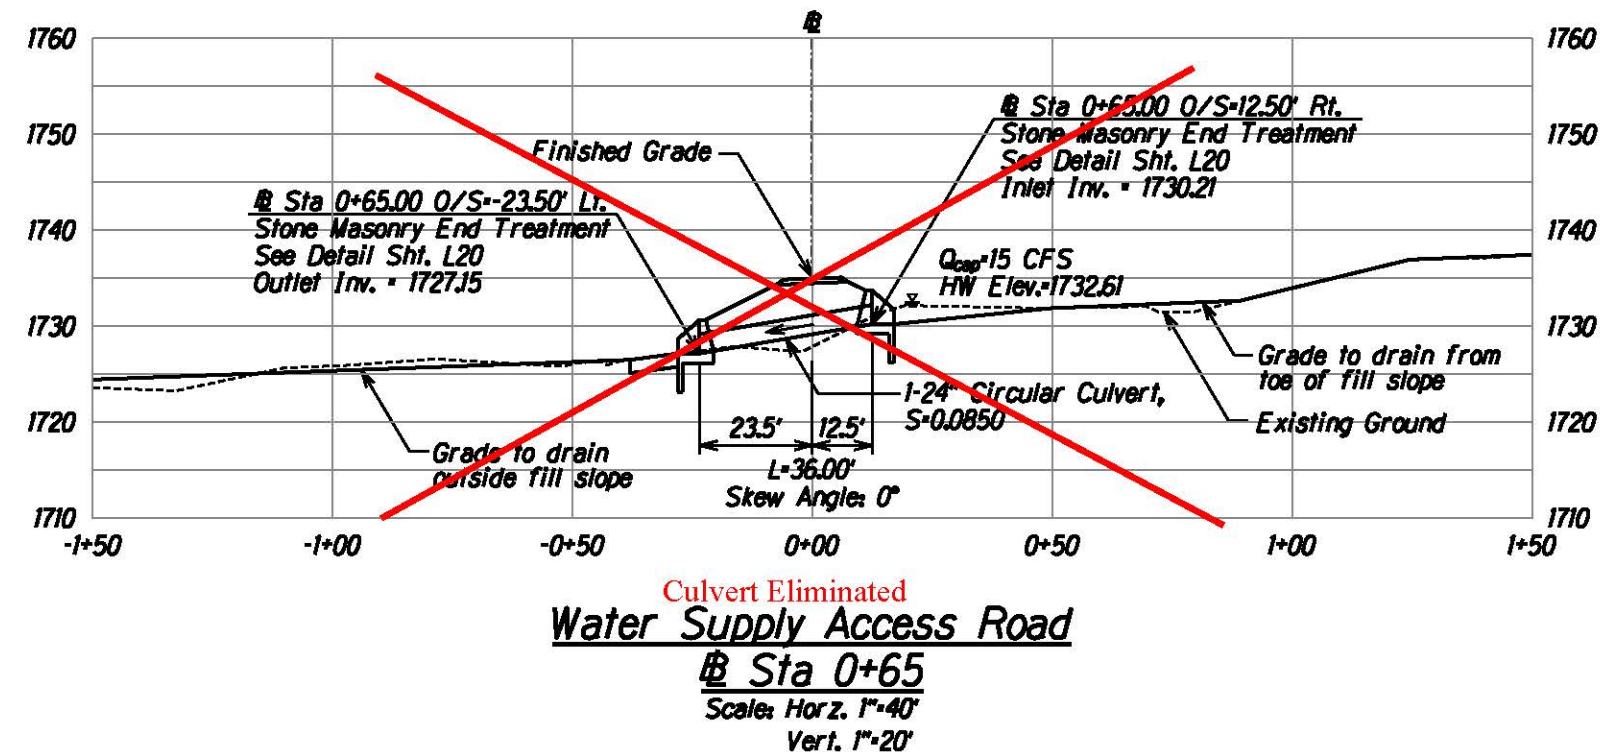

The work was prepared by me or under my supervision and construction of this project will be under my observation.
Bruce E. Meyers
Expiration Date of License 2/16

U.S. DEPARTMENT OF TRANSPORTATION
FEDERAL HIGHWAY ADMINISTRATION
CENTRAL FEDERAL LANDS HIGHWAY DIVISION



APPROACH ROAD CULVERT PROFILE

Scale: As Noted

Date: August 21, 2015

SHEET No. 4 OF 6

STATE	SADDLE ROAD PROJECT	SHEET NO.	TOTAL SHEETS
HI	HI SR 200(3)	L16	L27

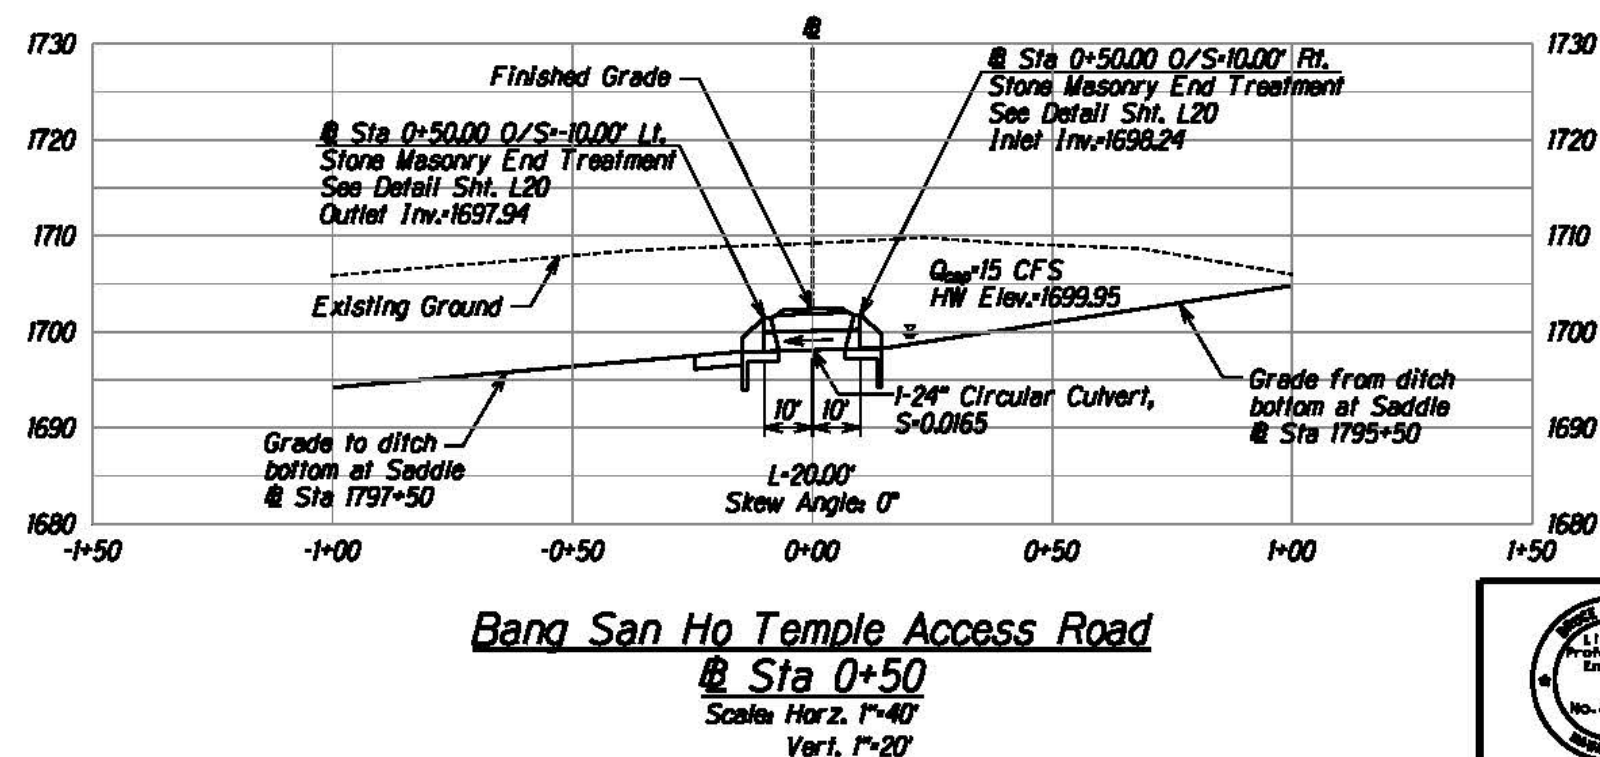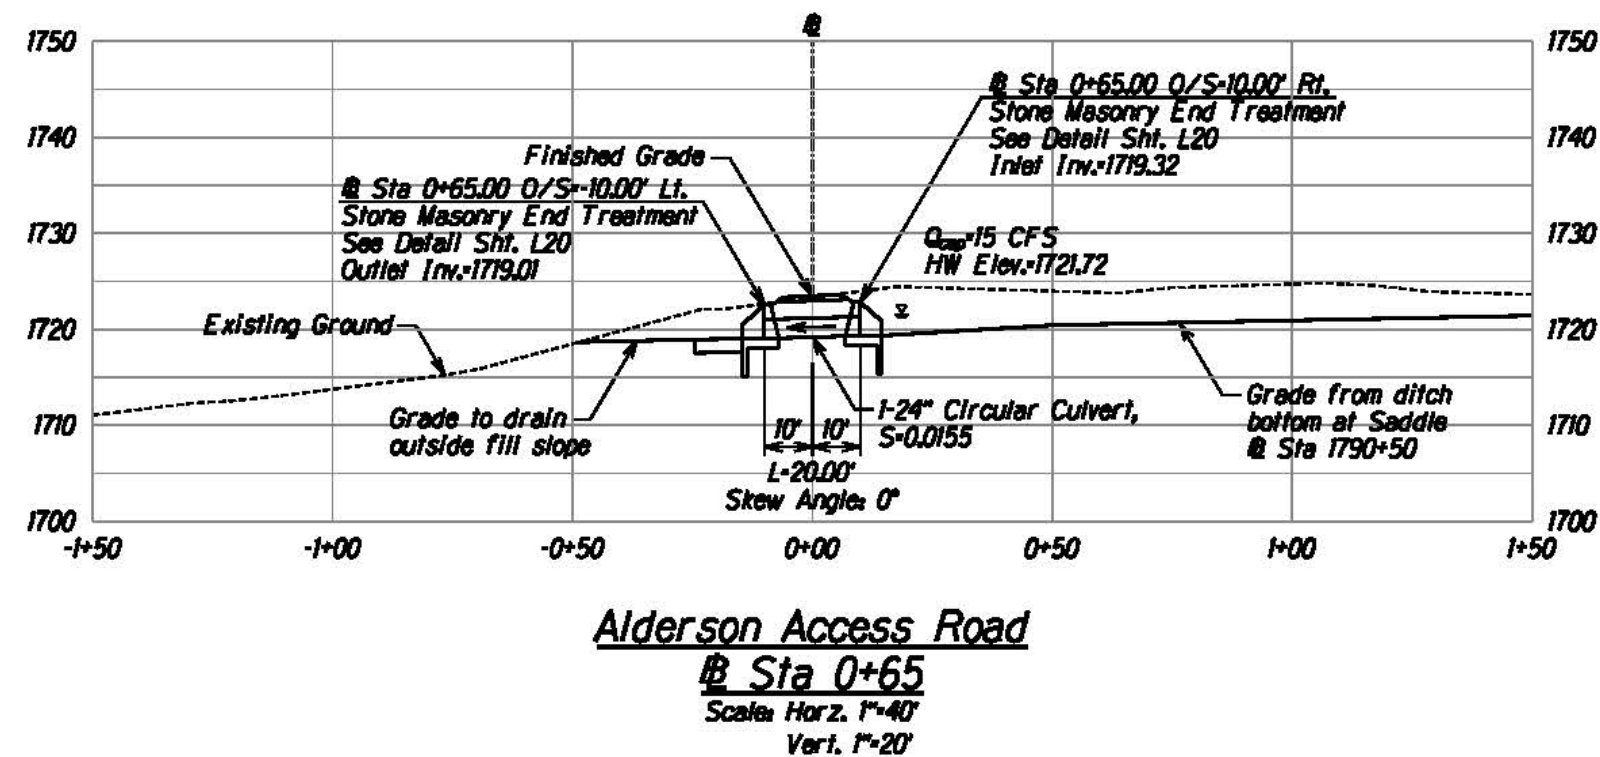

The work was prepared by me or under my supervision and construction of this project will be under my supervision.
 Signature: [Signature]
 Expiration Date of License: 2018

U.S. DEPARTMENT OF TRANSPORTATION
 FEDERAL HIGHWAY ADMINISTRATION
 CENTRAL FEDERAL LANDS HIGHWAY DIVISION


**APPROACH ROAD
 CULVERT PROFILE**

Scale: As Noted

Date: August 21, 2015


SHEET No. 5 OF 6

L16

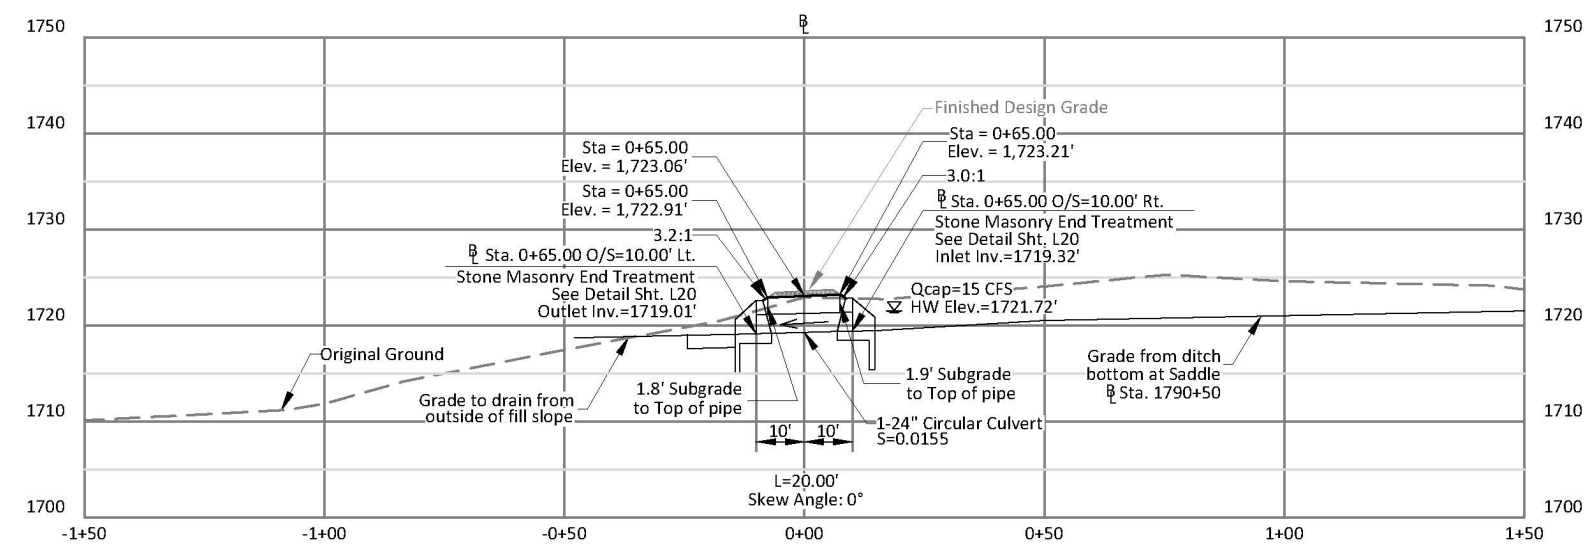

ALDERSON ACCESS ROAD

STA. 0+65

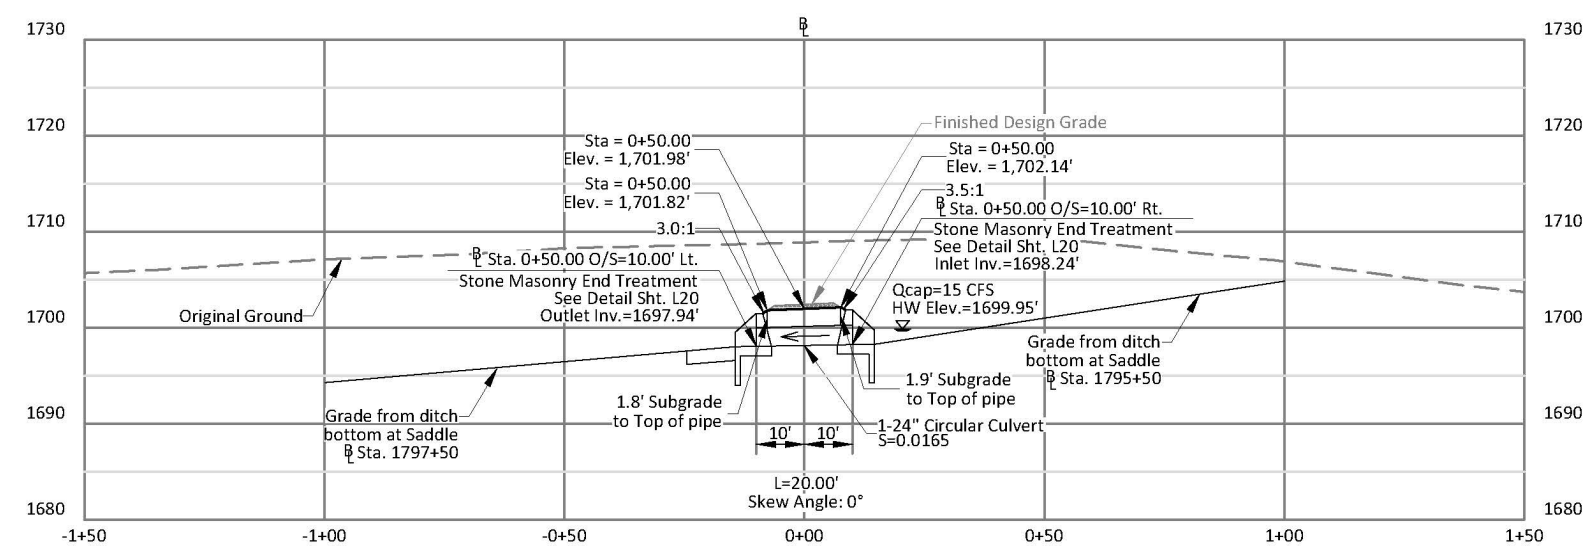

BANG SAN HO TEMPLE ACCESS ROAD

STA. 0+50

NOTES:
Prepare culvert subgrade as shown on sheet L27.
Station and offset labels are based on centerline of road alignment.
Elevations shown are to final design grade unless otherwise noted.

CONFIDENTIALITY NOTES:
The information contained in this exhibit is legally privileged and confidential information intended only for the use of the recipients. If you are not the intended recipients, you are hereby notified that any use, dissemination, distribution or copying of this information is strictly prohibited.

REVISIONS:	



**WILLIAM H. SMITH
& ASSOCIATES, INC.**
SURVEYORS ENGINEERS PLANNERS
550 EAST SECOND NORTH
GREEN RIVER, WY 82935
www.whtsmthpc.com

DRAWN BY: MJH	CHECKED BY: TMW
SCALE: 1"=40'H & 20'V	JOB NO: 2016025
DATE: 06/01/2016	SHEET 5 OF 6



ROADRUNNER
SURVEYING & CONSTRUCTION STAKING

**APPROACH ROAD
CULVERT PROFILE**



Z:\DATA\2016025 - Roadrunner Surveying\HIGWAY 200 SADDLE ROAD\PROFILES.dwg