


STATE	SADDLE ROAD PROJECT	SHEET NO.	TOTAL SHEETS
HI	HI SR 200(3)	F16	F20

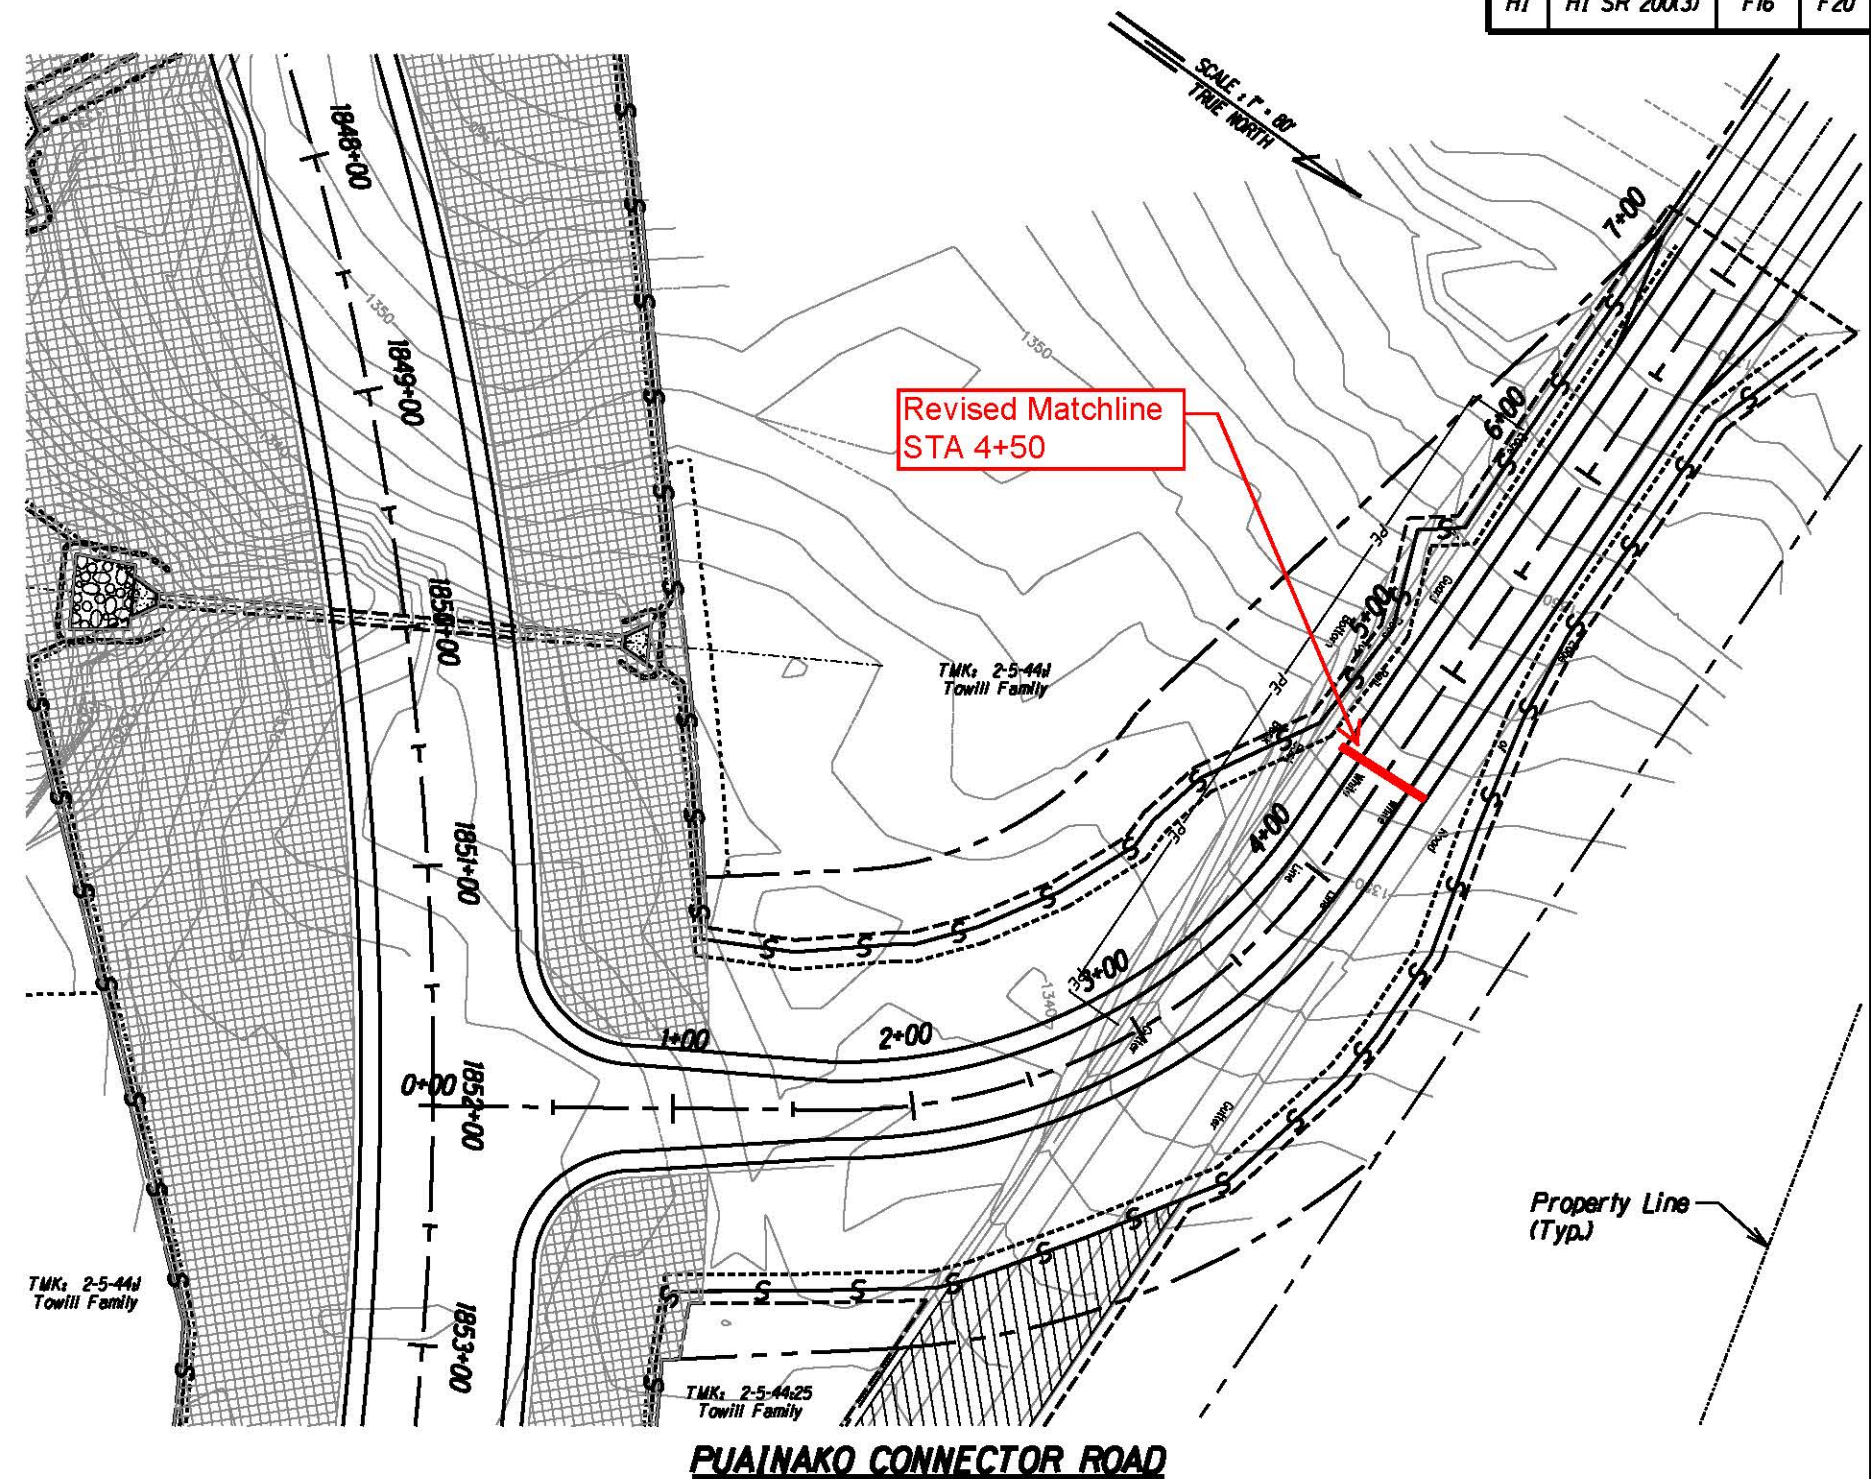

- Right of Way
- Construction Fence
- Construction Limits
- Sediment Control Logs (as directed by CO, typ.)
- Silt Fence
- Toe of Fill Slope
- Top of Cut Slope

- Mortared Riprap
- Pavement Obliteration
- Placed Riprap, Class 1
- Placed Riprap, Class 3
- Roll-on Erosion Control Product, Type 2B Mulch


The work was prepared by me or under my supervision and construction of this project will be under my observation.
Bruce E. Meyers
Expiration Date of License 2018

U.S. DEPARTMENT OF TRANSPORTATION
FEDERAL HIGHWAY ADMINISTRATION
CENTRAL FEDERAL LANDS HIGHWAY DIVISION

EROSION CONTROL PLAN
CONN ROADS FOR EXISTING
SADDLE & PUA'NAKO ROADS

Scale: 1"=80'
Date: August 21, 2015

SHEET No. 16 OF 16

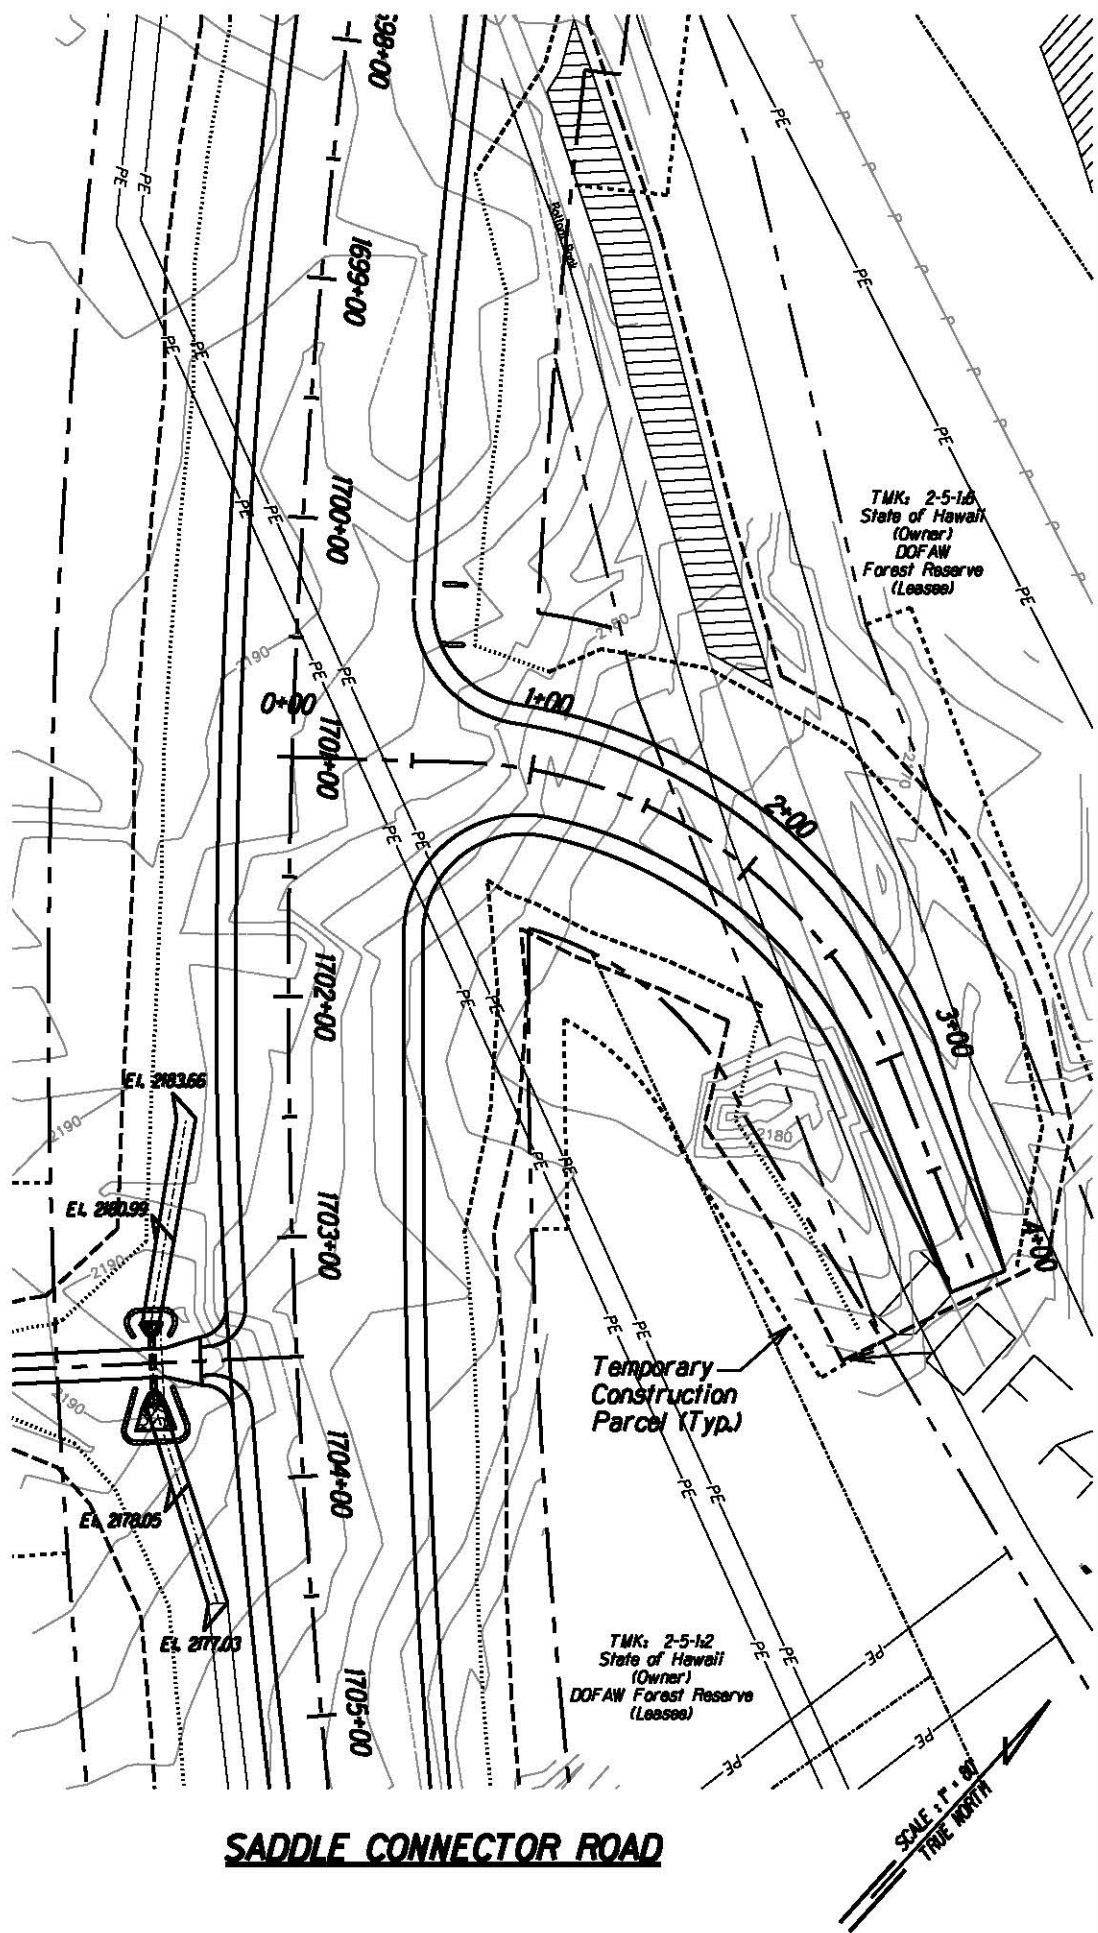

M:\proj\Lenzie\Saddle East 11-6\sheet\shfr016.dgn