

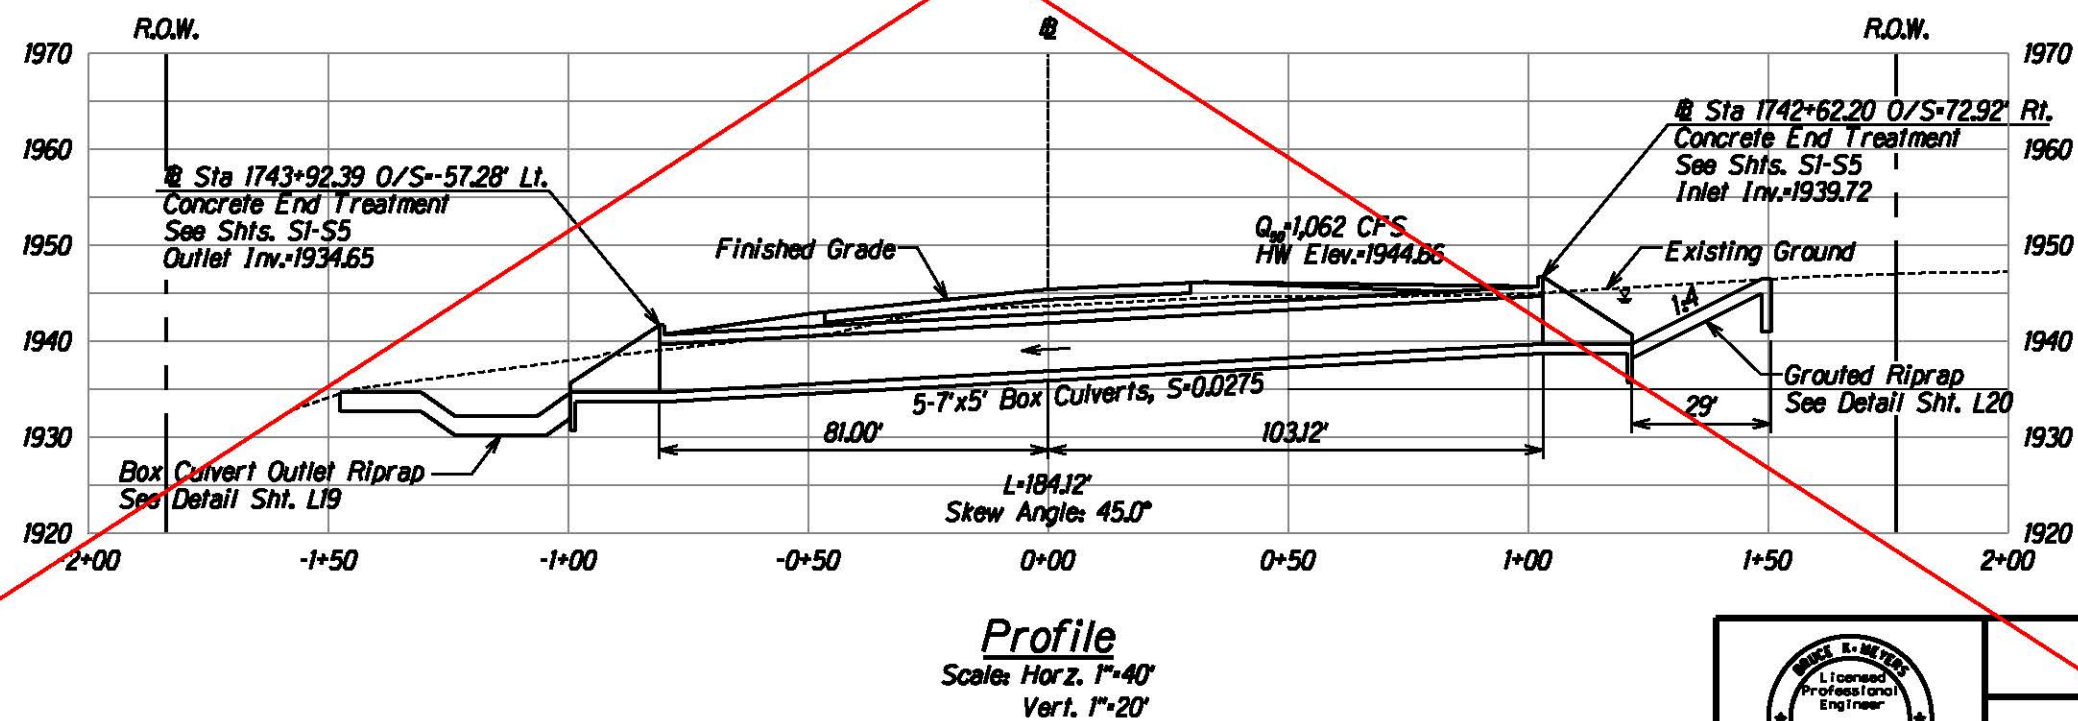


STATE	SADDLE ROAD PROJECT	SHEET NO.	TOTAL SHEETS
HI	HI SR 200(3)	L1	L27

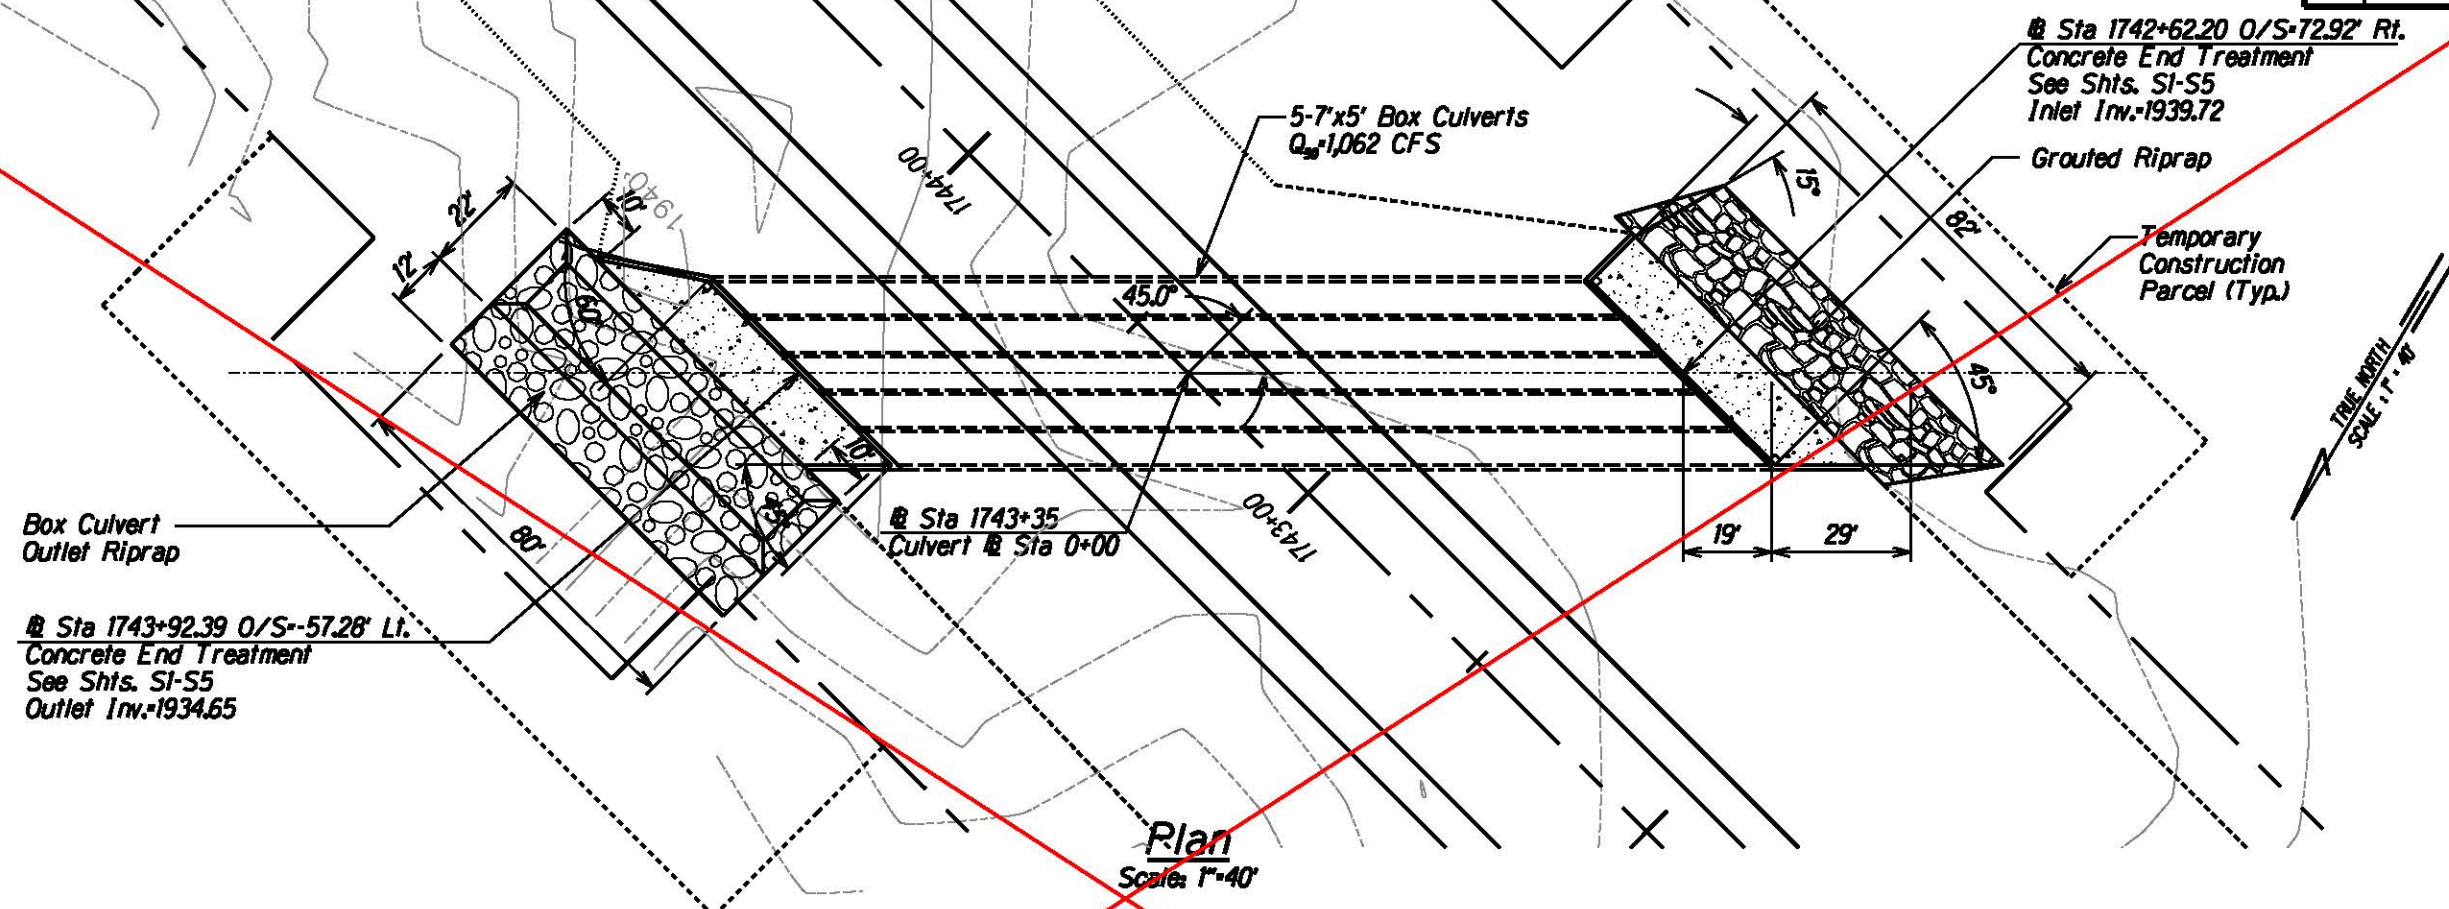

Note:
Prepare culvert subgrade as shown on sheet L27.

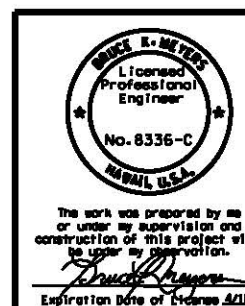



U.S. DEPARTMENT OF TRANSPORTATION
FEDERAL HIGHWAY ADMINISTRATION
CENTRAL FEDERAL LANDS HIGHWAY DIVISION

CULVERT NO. 1 @ STA 1743+35
PLAN & PROFILE


Scale: As Noted Date: August 21, 2015

SHEET No. 1 OF 11

STATE	SADDLE ROAD PROJECT	SHEET NO.	TOTAL SHEETS
HI	HI SR 200(3)	L1	L27

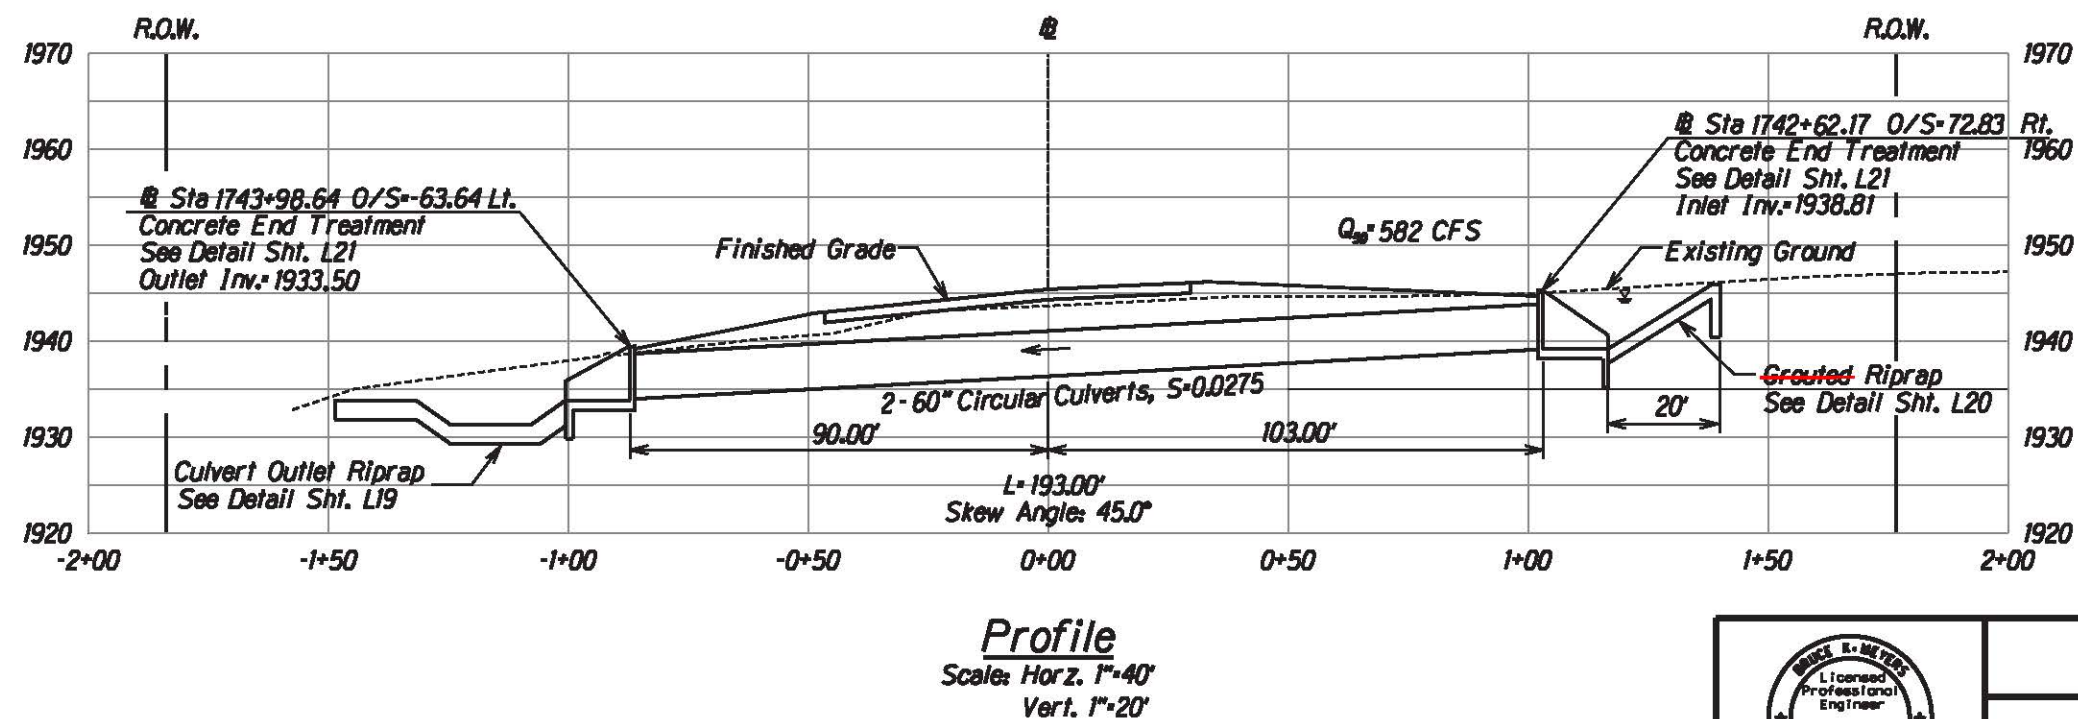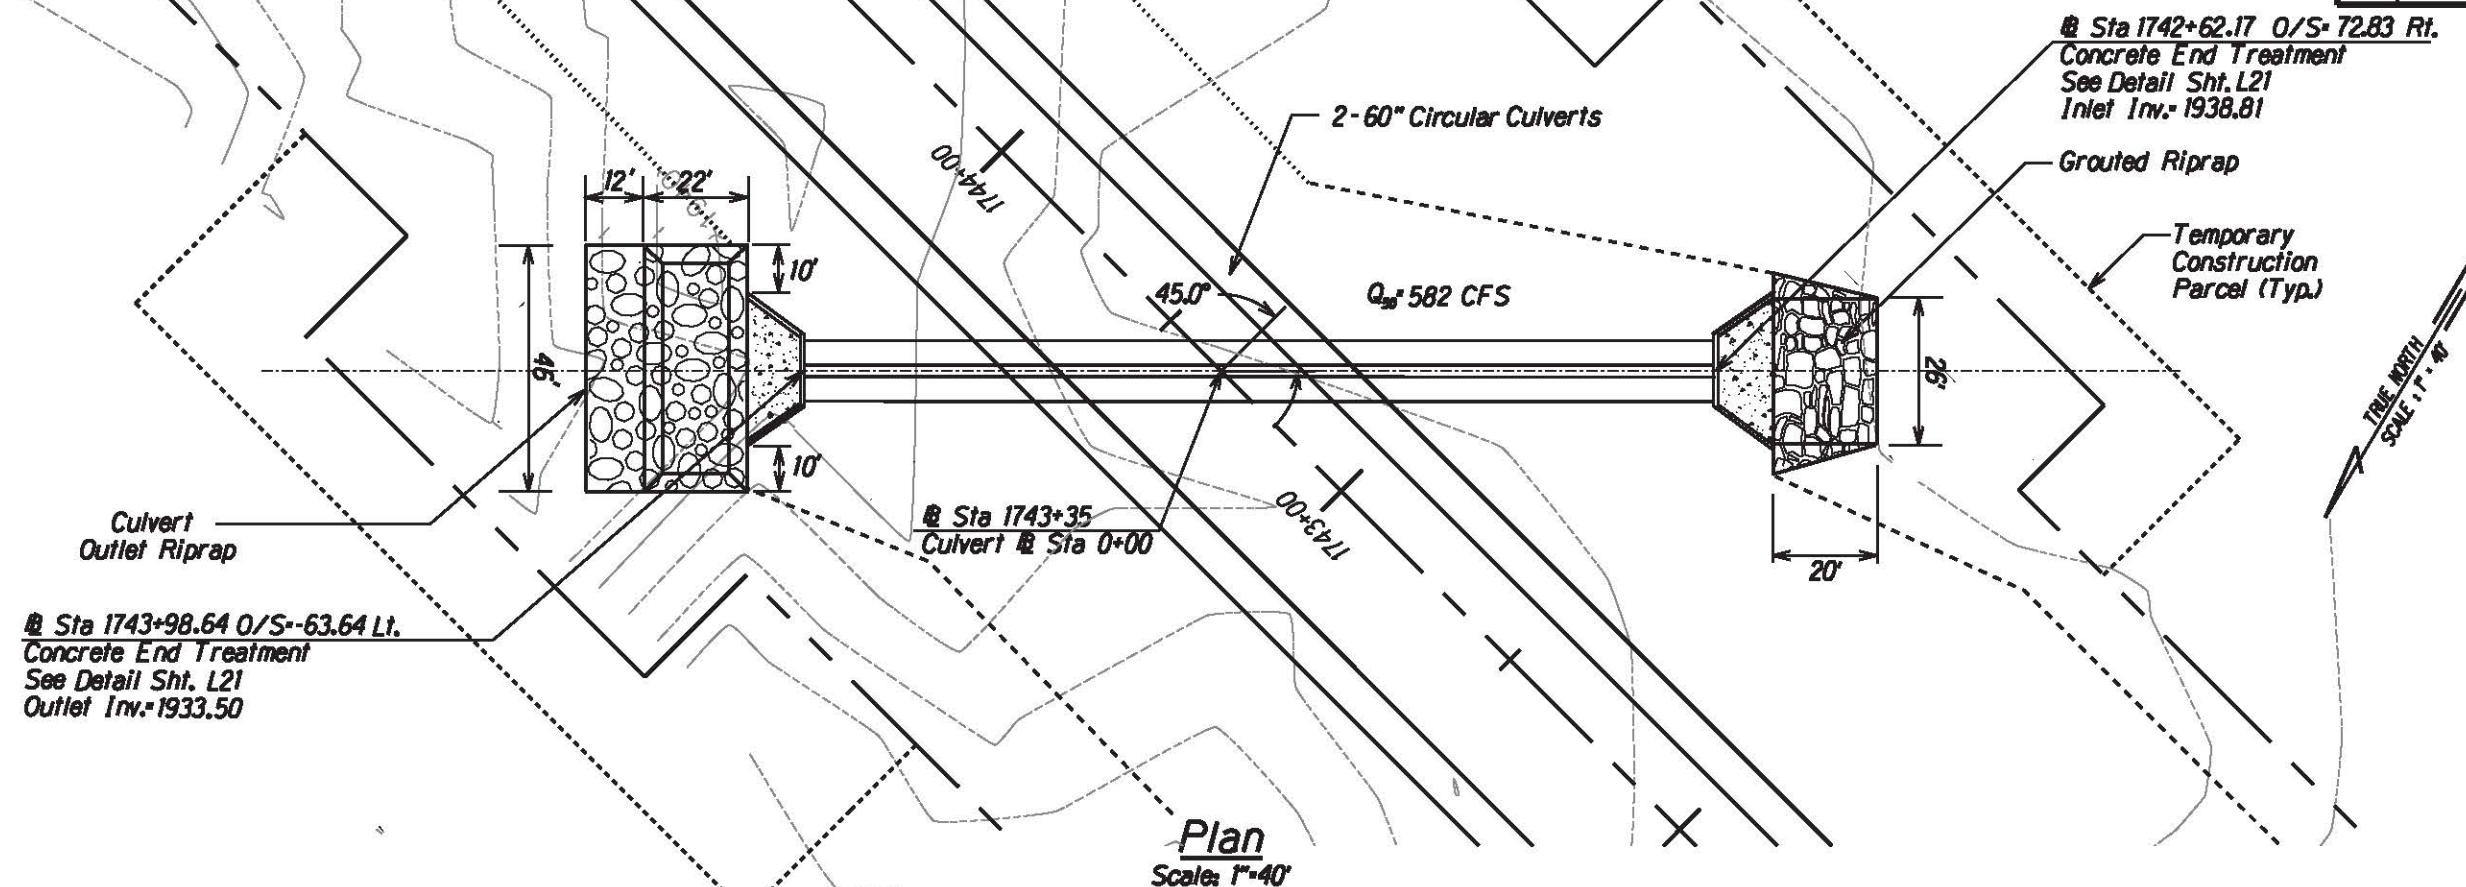

Note:
Prepare culvert subgrade as shown on sheet L27.

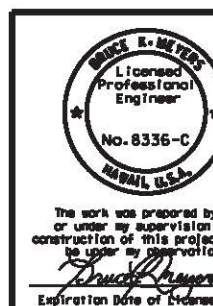

U.S. DEPARTMENT OF TRANSPORTATION FEDERAL HIGHWAY ADMINISTRATION CENTRAL FEDERAL LANDS HIGHWAY DIVISION	
CULVERT NO. 1 @ STA 1743+35 PLAN & PROFILE	
Scale: As Noted	Date: August 21, 2015
SHEET No. 1 OF 11	

STATE	SADDLE ROAD PROJECT	SHEET NO.	TOTAL SHEETS
HI	HI SR 200(3)	L2	L27


Sta 1771+74.49 O/S-79.34' Lt.
Concrete End Treatment
See Shts. SI-S4 & S6
Outlet Inv.=1763.82

Box Culvert
Outlet Riprap


Sta 1771+25
Culvert Sta 0+00

Sta 1770+78.69 O/S-74.30' Rt.
Concrete End Treatment
See Shts. SI-S4 & S6
Inlet Inv.=1778.31

Temporary
Construction
Parcel (Typ.)

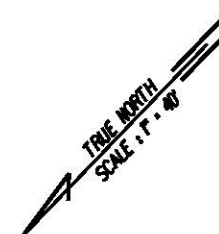

Plan
Scale: 1"=40'

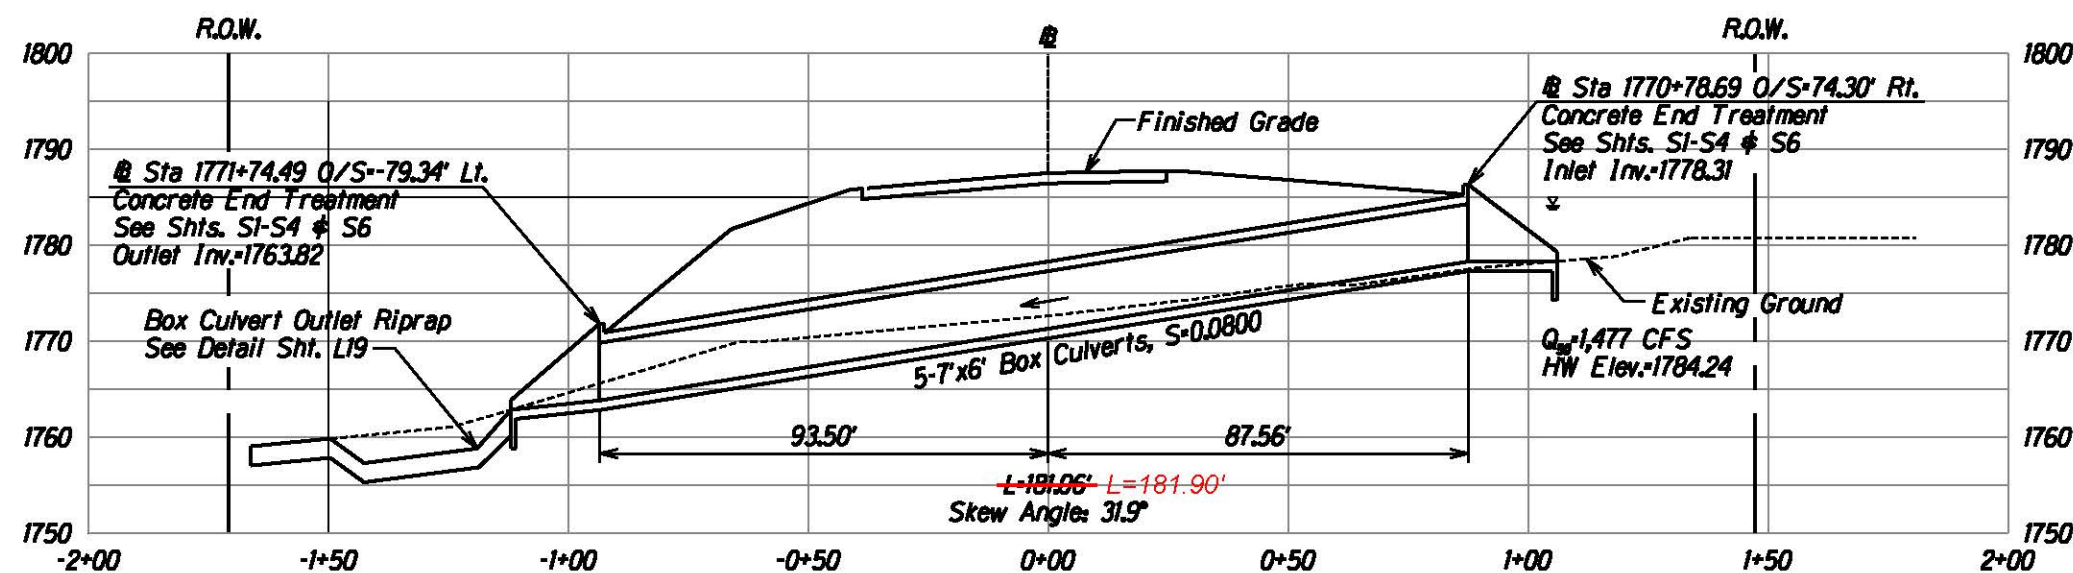

Profile
Scale: Horz. 1"=40'
Vert. 1"=20'

Note:
Prepare culvert subgrade as shown on sheet L27.



The work was prepared by me
or under my supervision and
construction of this project will
be under my observation.
Bruce E. Meyers
Expiration Date of License 2018.

U.S. DEPARTMENT OF TRANSPORTATION
FEDERAL HIGHWAY ADMINISTRATION
CENTRAL FEDERAL LANDS HIGHWAY DIVISION


CULVERT NO. 2 @ STA 1771+25
PLAN & PROFILE

Scale: As Noted



Date: August 21, 2015

SHEET No. 2 OF 11

CULVERT NO. 2

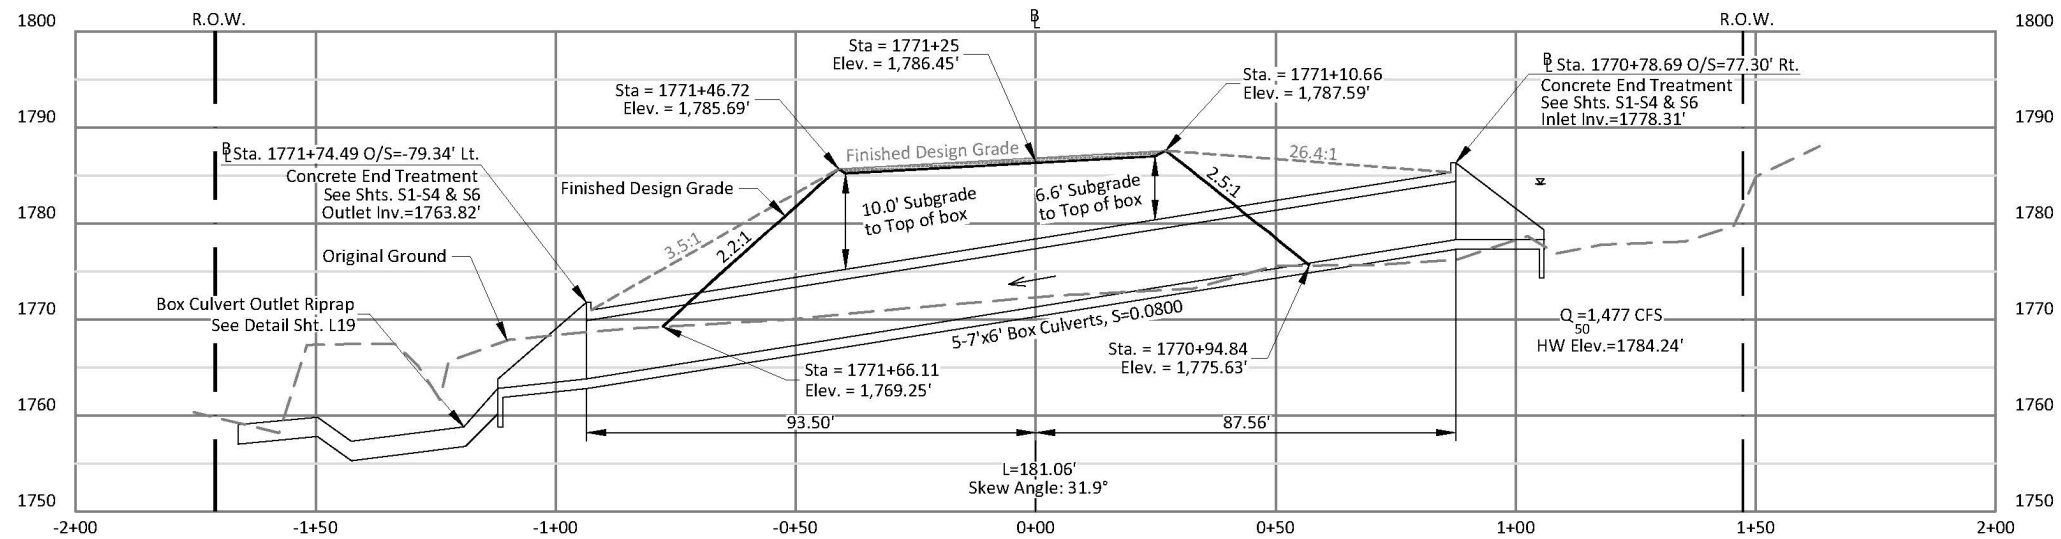

STA.1771+25

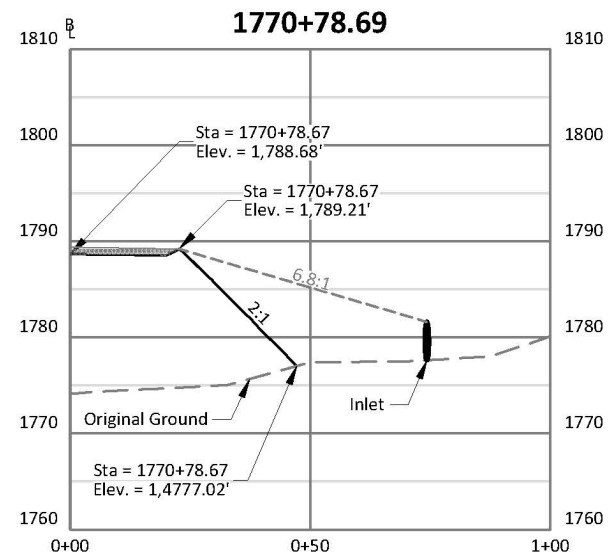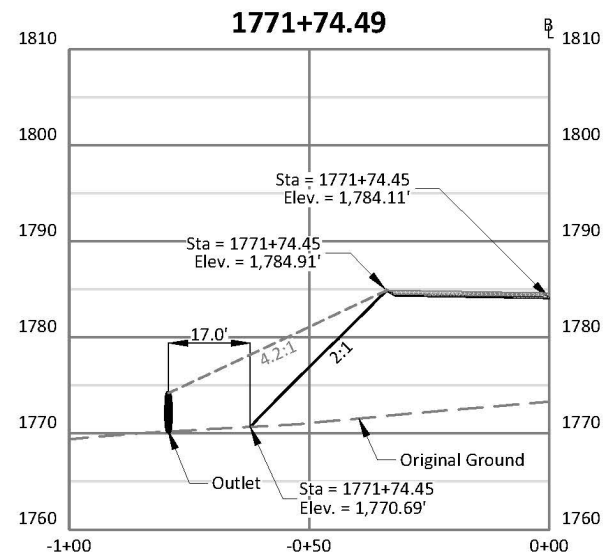

STA.1771+25

NOTES:
Prepare culvert subgrade as shown on sheet L27.
Station and offset labels are based on centerline of road alignment.
Elevations shown are to final design grade unless otherwise noted.

CONFIDENTIALITY NOTES:

The information contained in this exhibit is legally privileged and confidential information intended only for the use of the recipients. If you are not the intended recipients, you are hereby notified that any use, dissemination, distribution or copying of this information is strictly prohibited.

REVISIONS:



WILLIAM H. SMITH
& ASSOCIATES, INC.
SURVEYORS ENGINEERS PLANNERS
550 EAST SECOND NORTH
GREEN RIVER, WY 82935
PHONE: 307-875-3638
FAX: 307-875-3639
www.whtsmithpc.com


DRAWN BY: BLM
SCALE: 1"=40'H & 20'V
DATE: 05/20/2016

CHECKED BY: RAW
JOB NO: 2016025
SHEET 1 OF 1




CULVERT NO. 2
STA. 1771+25 PROFILE

STATE	SADDLE ROAD PROJECT	SHEET NO.	TOTAL SHEETS
HI	HI SR 200(3)	L3	L27

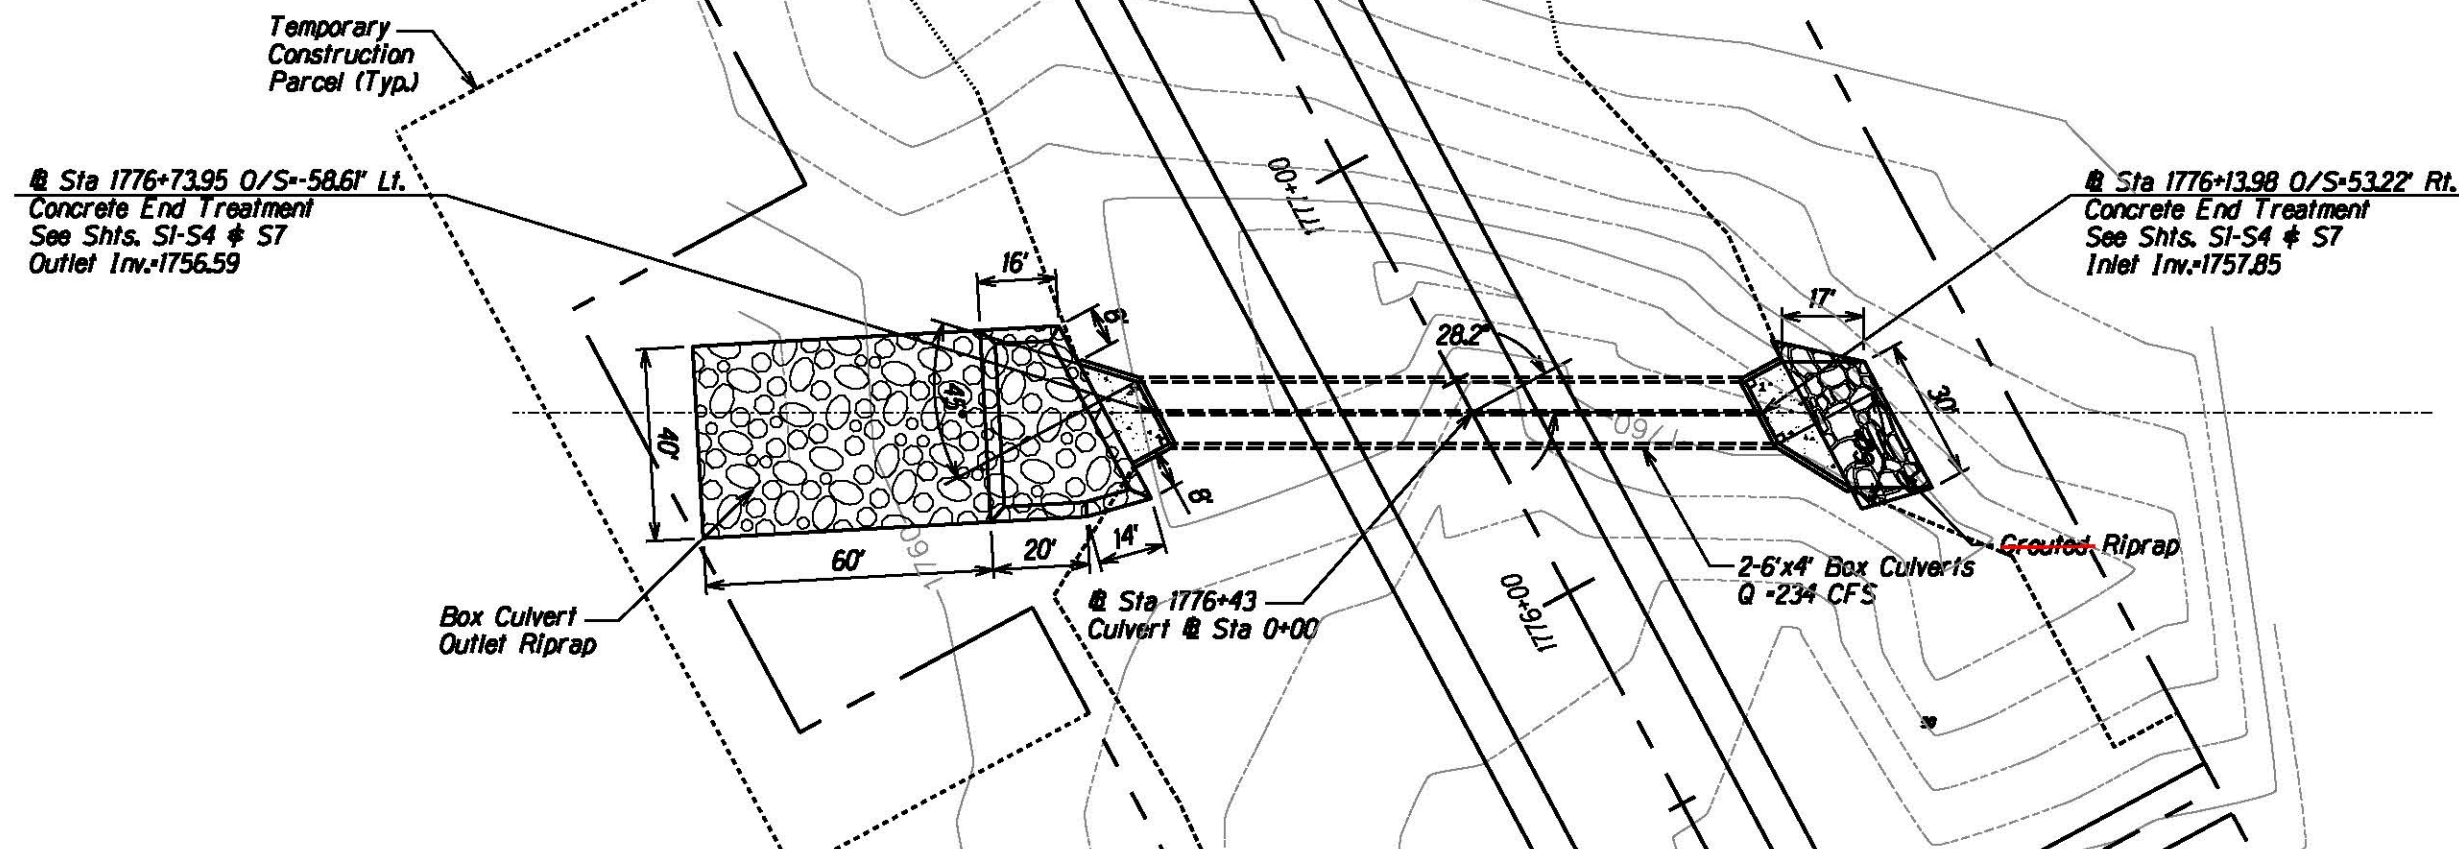


Plan
Scale: 1"=40'

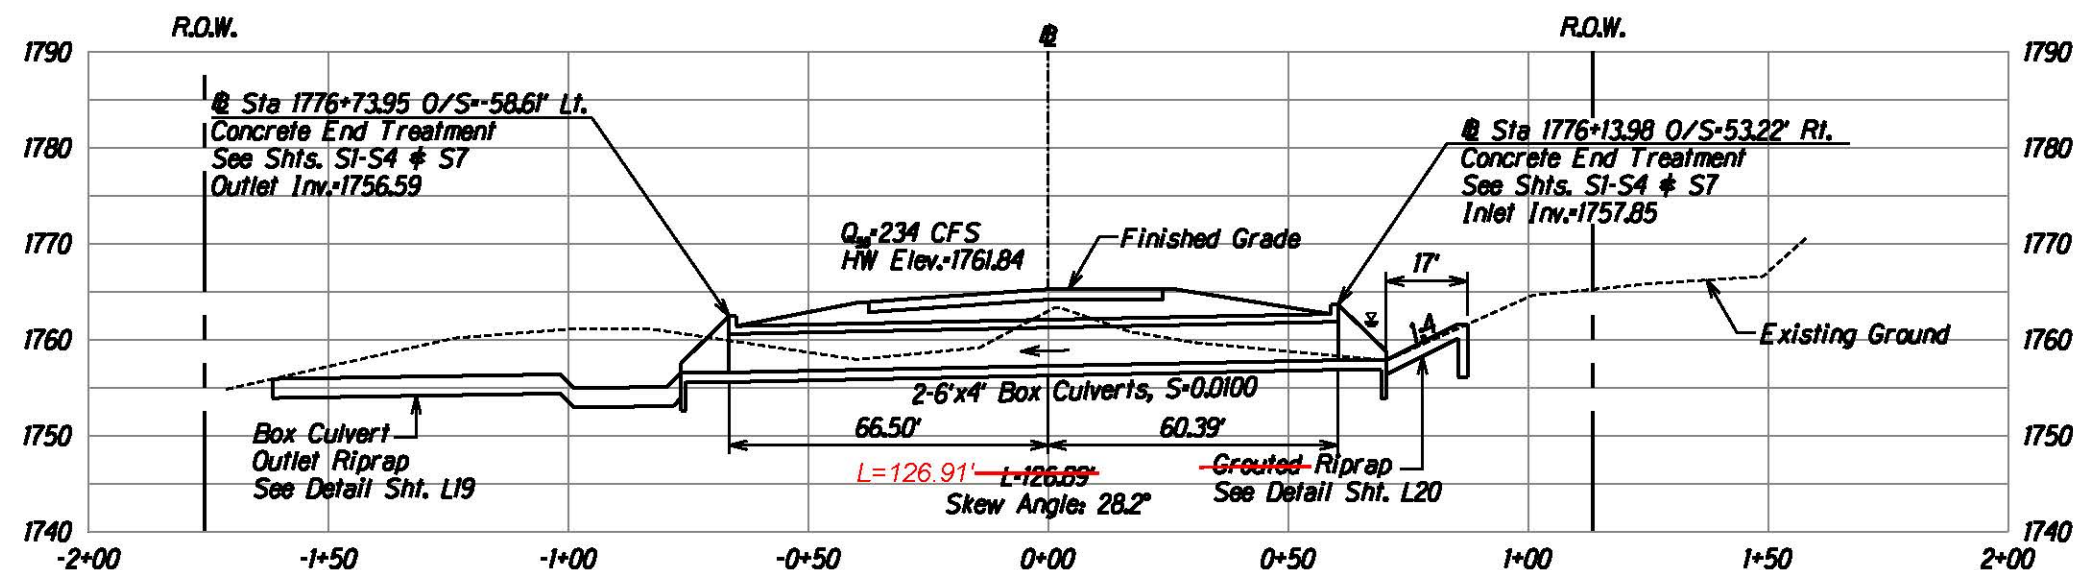

Profile
Scale: Horz. 1"=40'
Vert. 1"=20'

Note:
Prepare culvert subgrade as shown on sheet L27.

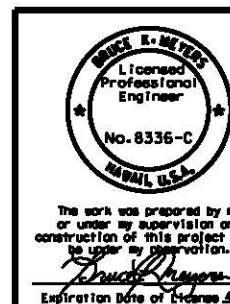


U.S. DEPARTMENT OF TRANSPORTATION
FEDERAL HIGHWAY ADMINISTRATION
CENTRAL FEDERAL LANDS HIGHWAY DIVISION

**CULVERT NO. 3 @ STA 1776+43
PLAN & PROFILE**



Scale: As Noted Date: August 21, 2015

SHEET No. 3 OF 11

CULVERT NO. 3

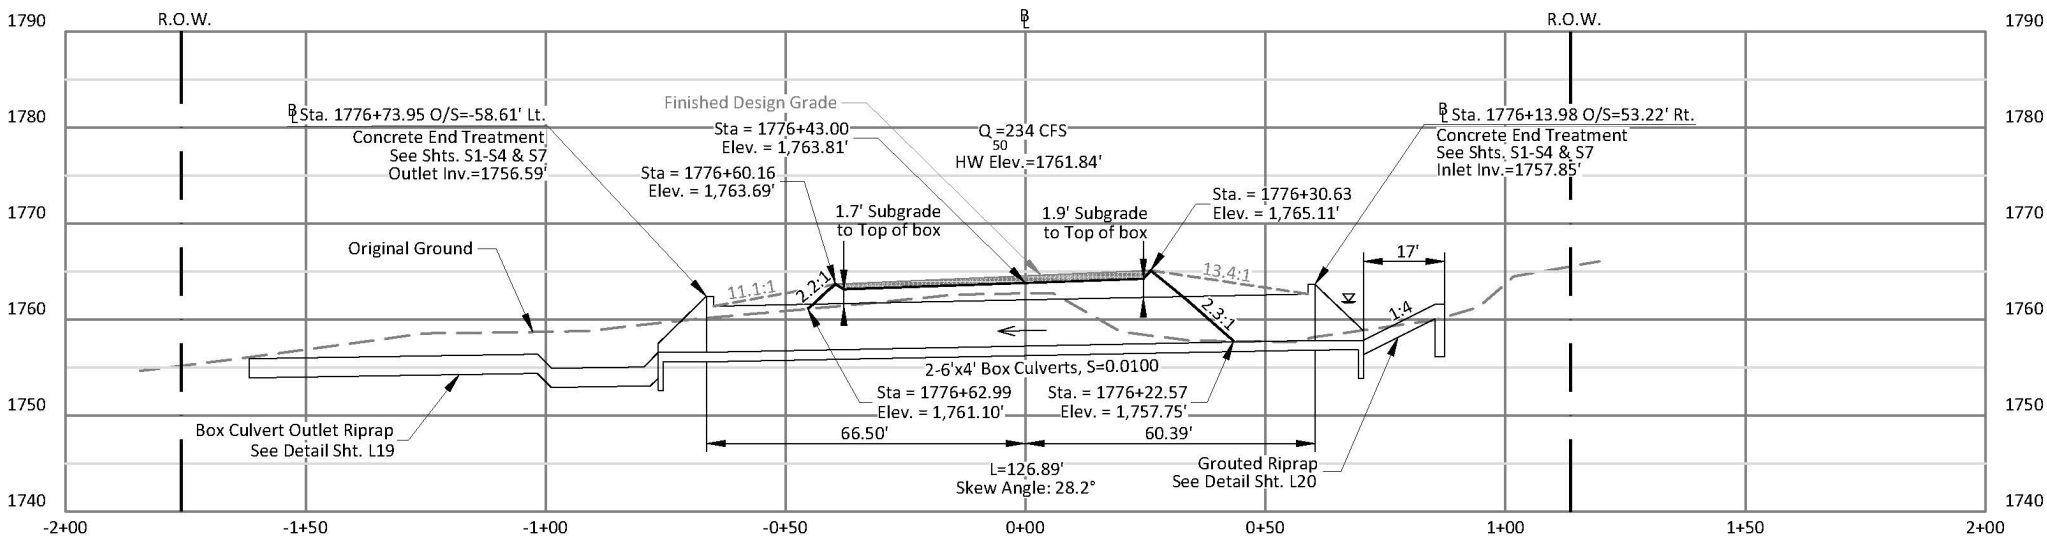

STA.1776+43

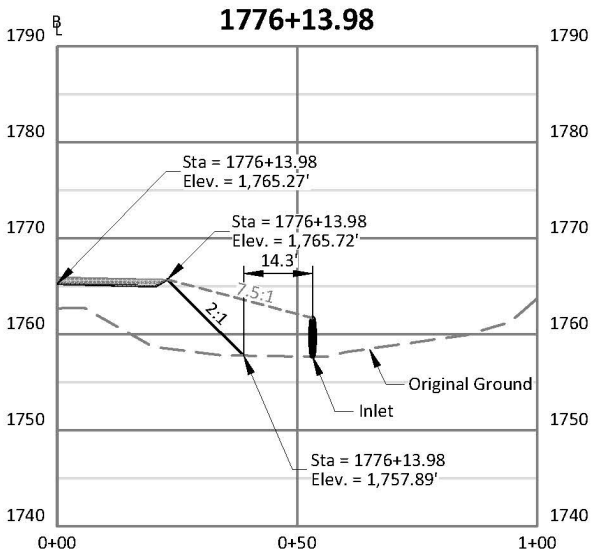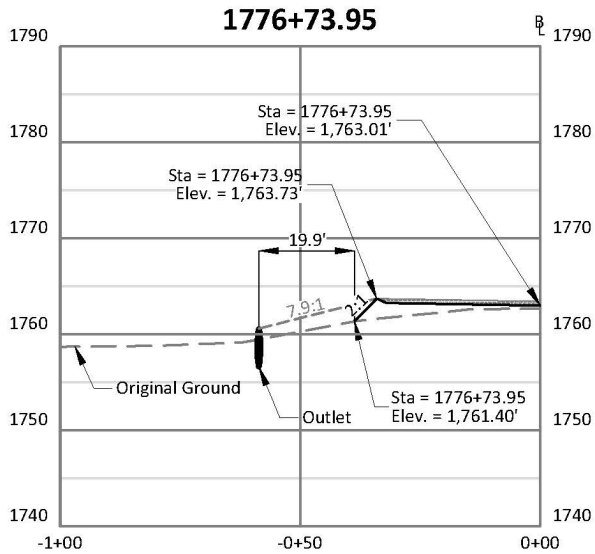

STA.1776.43

NOTES:
Prepare culvert subgrade as shown on sheet L27.
Station and offset labels are based on centerline of road alignment.
Elevations shown are to final design grade unless otherwise noted.

CONFIDENTIALITY NOTES:
The information contained in this exhibit is legally privileged and confidential information intended only for the use of the recipients. If you are not the intended recipients, you are hereby notified that any use, dissemination, distribution or copying of this information is strictly prohibited.

REVISIONS:



WILLIAM H. SMITH
& ASSOCIATES, INC.
SURVEYORS ENGINEERS PLANNERS
550 EAST SECOND NORTH
GREEN RIVER, WY 82935
PHONE: 307-875-3638
FAX: 307-875-3639
www.whtsmithpc.com

DRAWN BY: BLM
SCALE: 1"=40'H & 20'V
DATE: 05/23/2016



CHECKED BY: TMW
JOB NO: 2016025
SHEET 1 OF 1




CULVERT NO. 3
STA. 1776+43 PROFILE

STATE	SADDLE ROAD PROJECT	SHEET NO.	TOTAL SHEETS
HI	HI SR 200(3)	L4	L27

@ Sta 1795+04.39 O/S-98.95' Lt.
Concrete End Treatment
See Shits. SI-S4 & S8
Outlet Inv.=1684.14

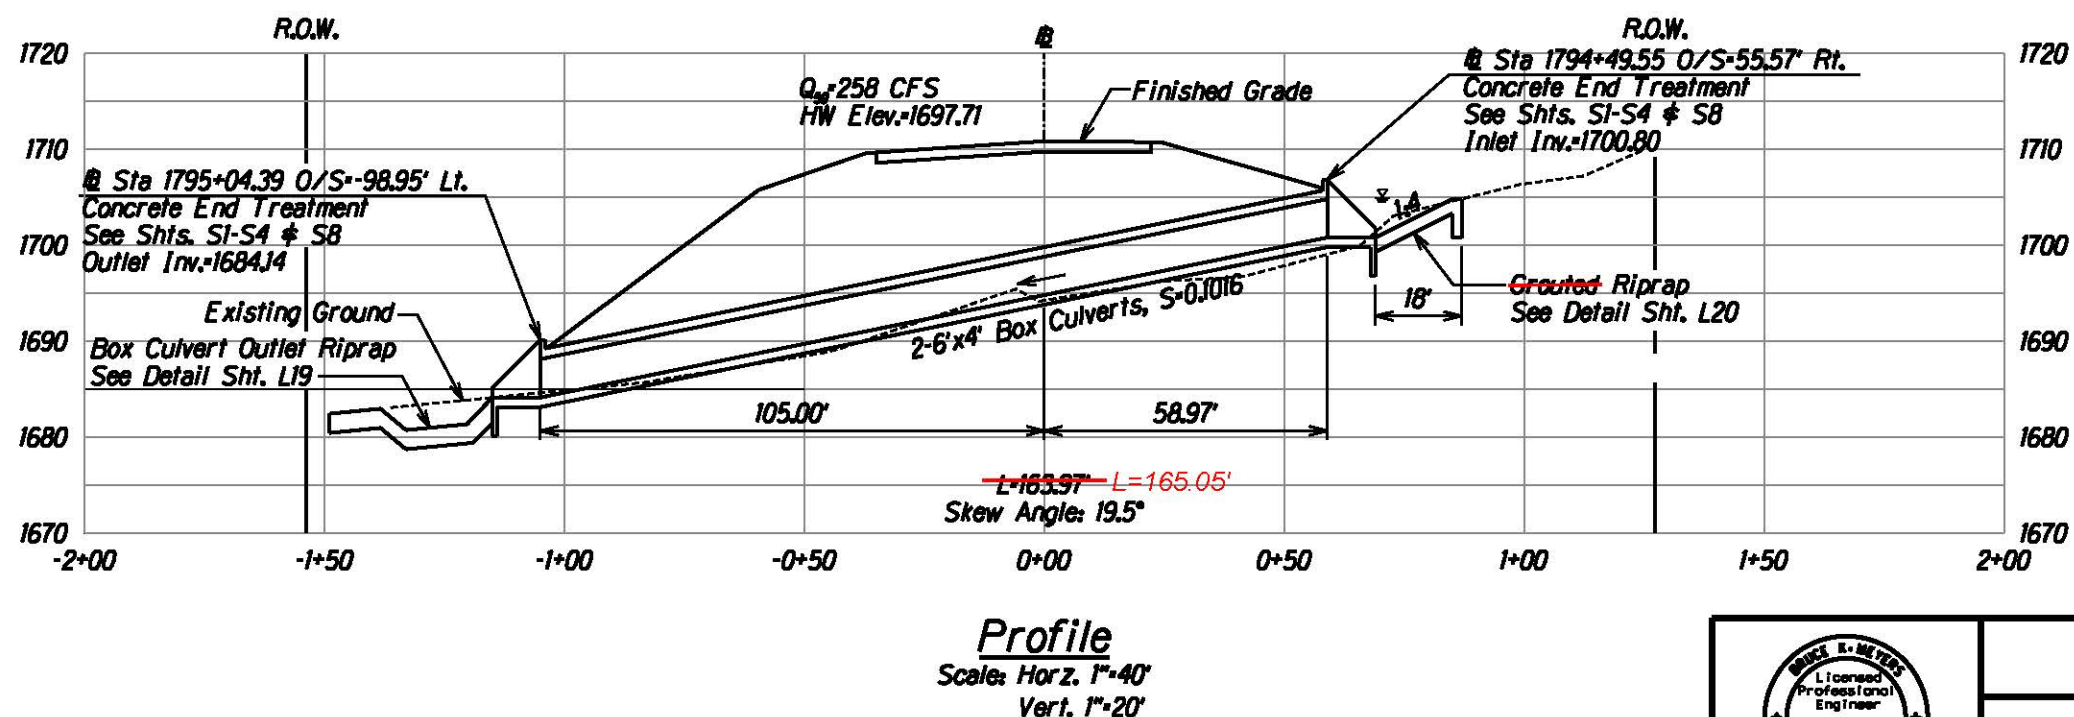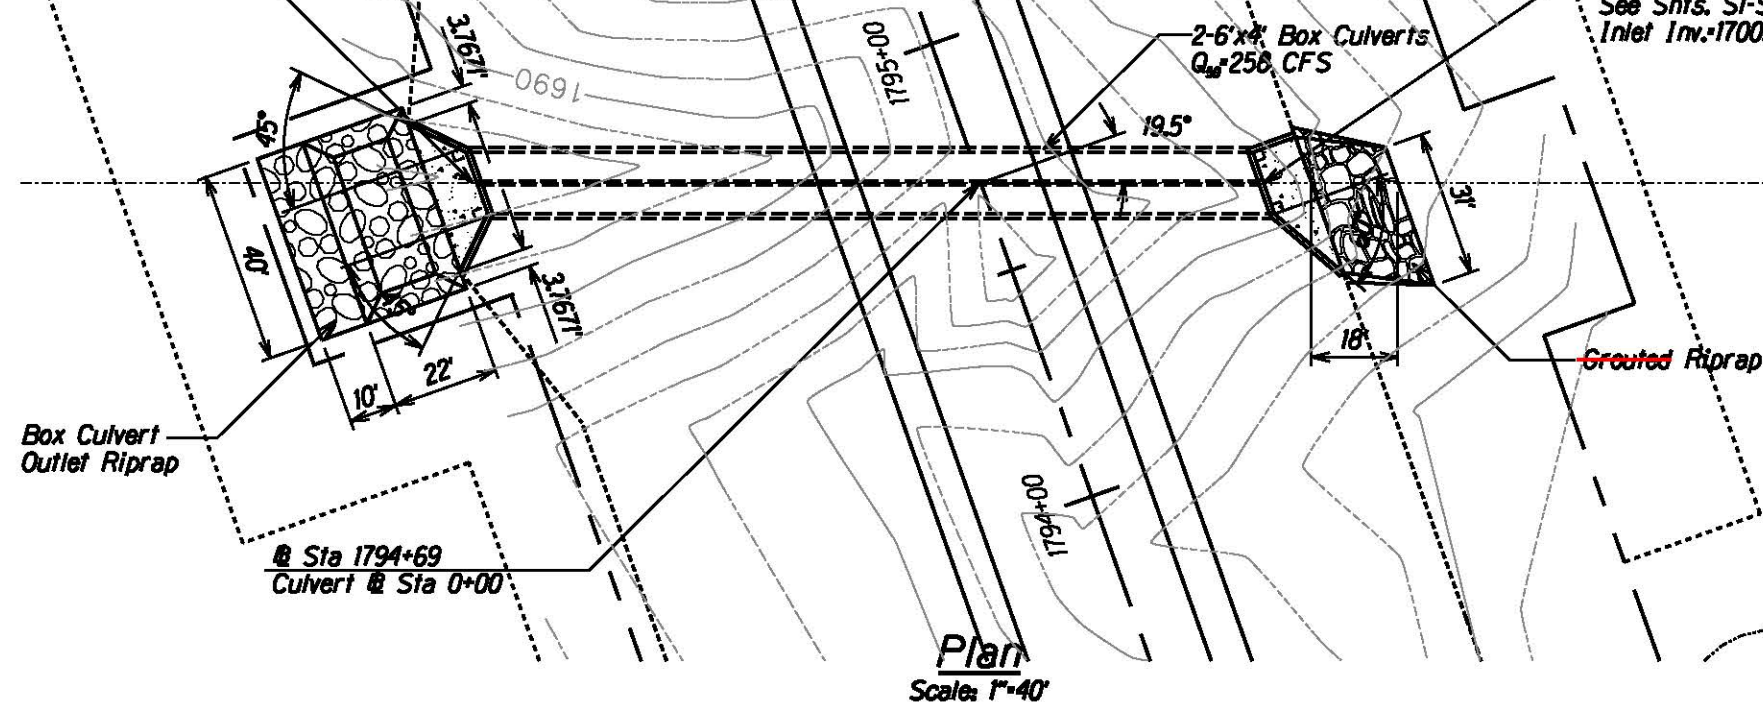

Note:
Prepare culvert subgrade as shown on sheet L27.

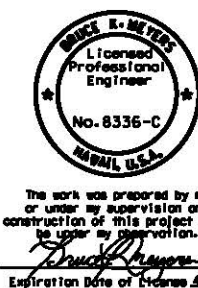


U.S. DEPARTMENT OF TRANSPORTATION
FEDERAL HIGHWAY ADMINISTRATION
CENTRAL FEDERAL LANDS HIGHWAY DIVISION



CULVERT NO. 4 @ STA 1794+69
PLAN & PROFILE

Scale: As Noted
Date: August 21, 2015
SHEET No. 4 OF 11

CULVERT NO. 4

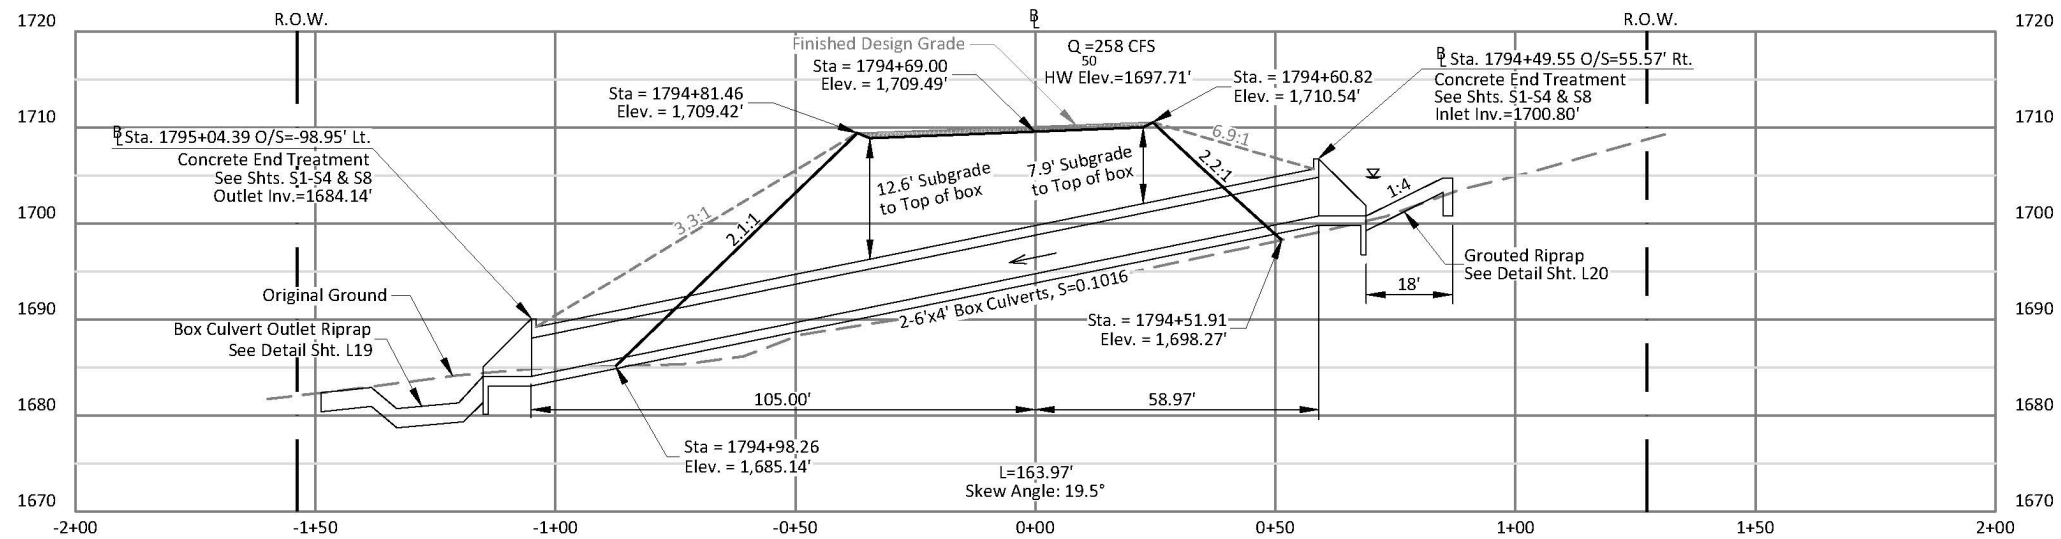

STA. 1794+69

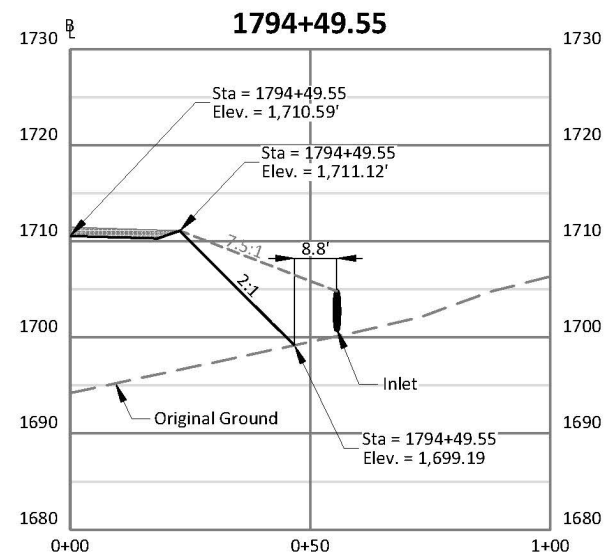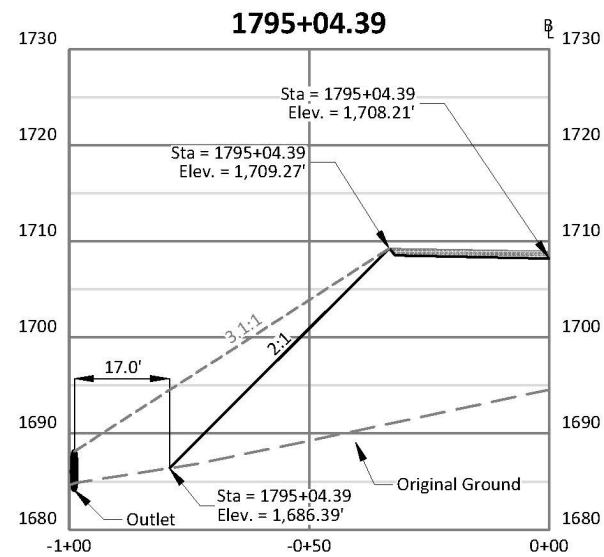

STA. 1794+69

NOTES:
Prepare culvert subgrade as shown on sheet L27.
Station and offset labels are based on centerline of road alignment.
Elevations shown are to final design grade unless otherwise noted.

CONFIDENTIALITY NOTES:

The information contained in this exhibit is legally privileged and confidential information intended only for the use of the recipients. If you are not the intended recipients, you are hereby notified that any use, dissemination, distribution or copying of this information is strictly prohibited.

REVISIONS:



WILLIAM H. SMITH
& ASSOCIATES, INC.
SURVEYORS ENGINEERS PLANNERS
550 EAST SECOND NORTH
GREEN RIVER, WY 82935
PHONE: 307-875-3638
FAX: 307-875-3639
www.wsmithhpc.com



DRAWN BY: BLM
SCALE: 1"=40'H & 20'V
DATE: 05/23/2016

CHECKED BY: TMW
JOB NO: 2016025
SHEET 1 OF 1



CULVERT NO. 4
STA. 1794+69 PROFILE

STATE	SADDLE ROAD PROJECT	SHEET NO.	TOTAL SHEETS
HI	HI SR 200(3)	L5	L27

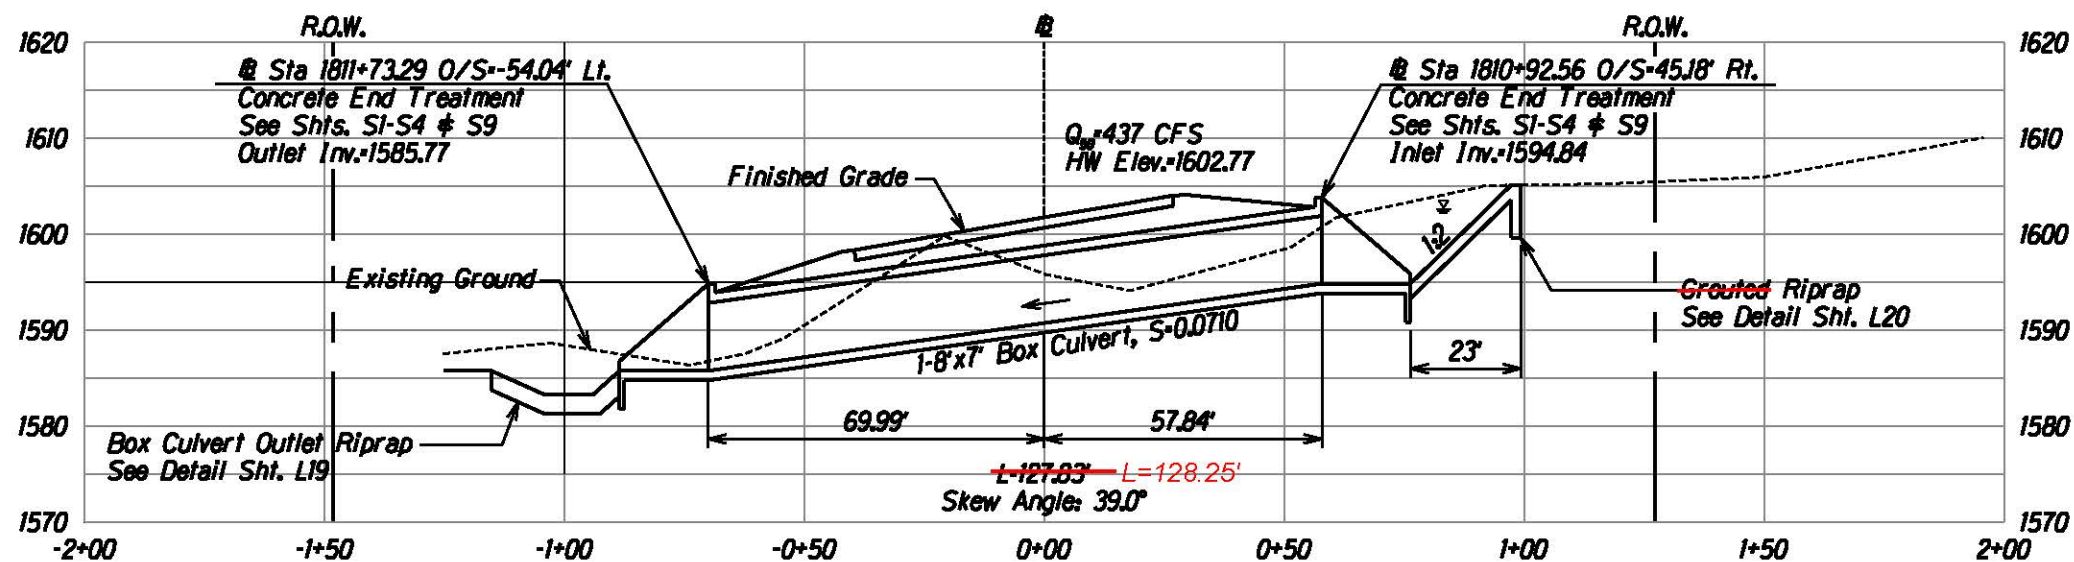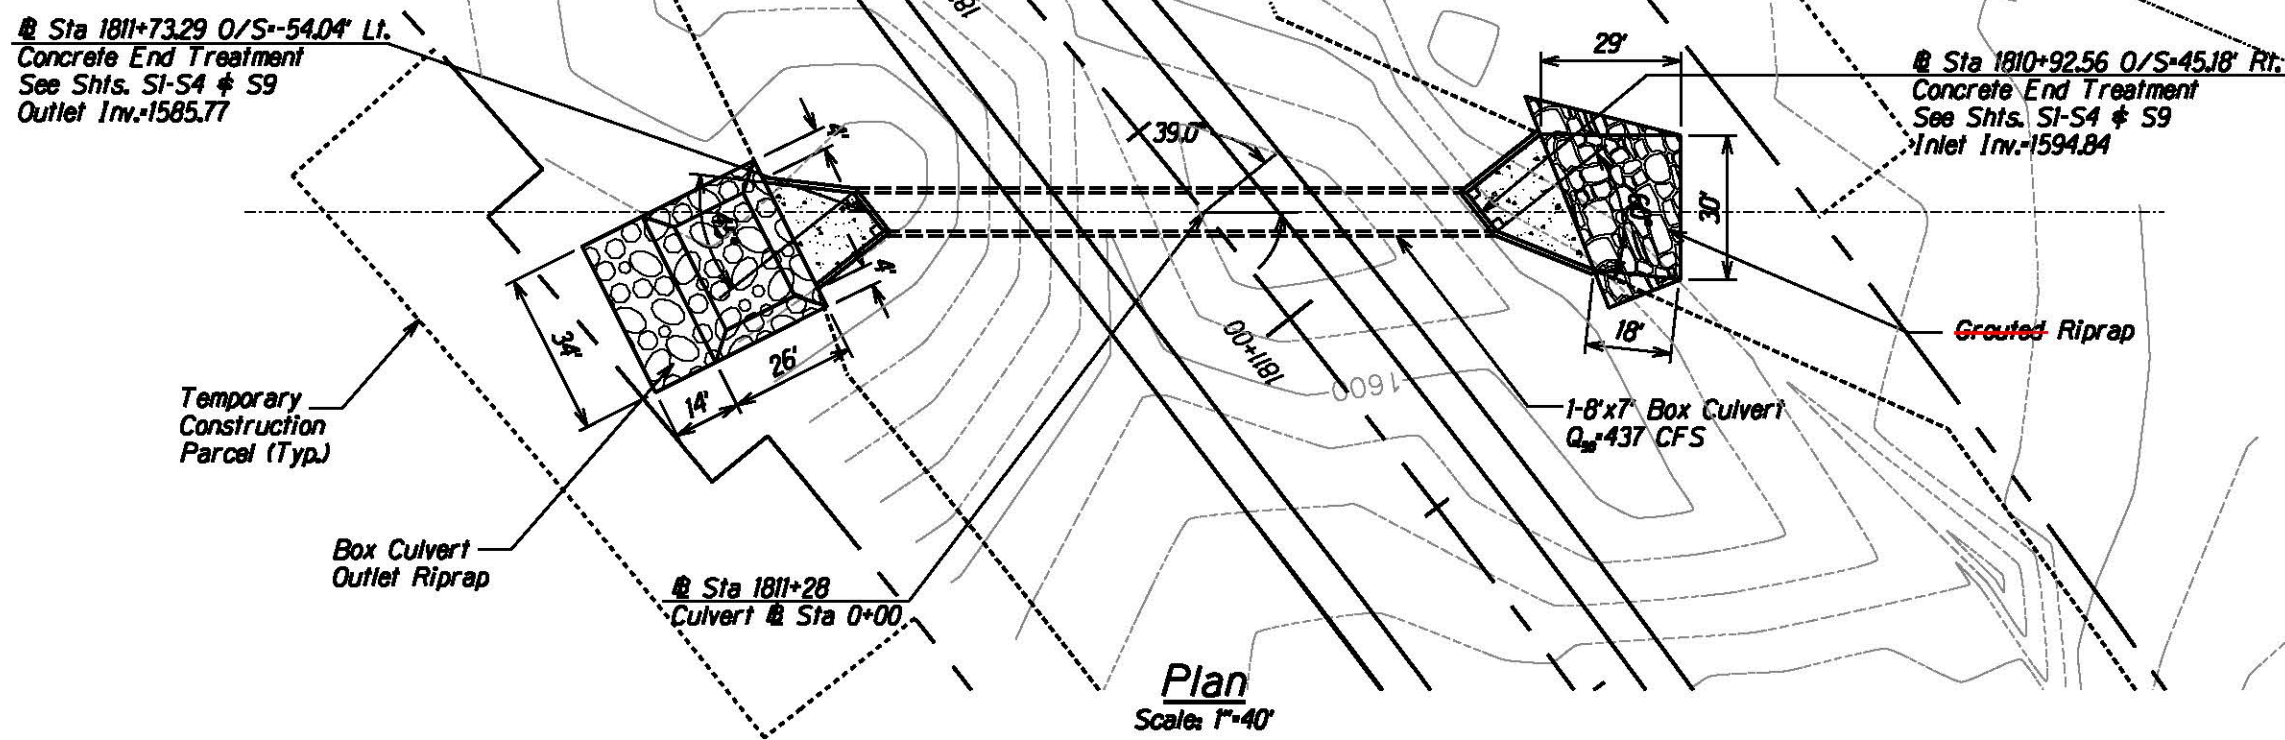

Profile
Scale: Horz. 1"=40'
Vert. 1"=20'

Note:
Prepare culvert subgrade as shown on sheet L27.





U.S. DEPARTMENT OF TRANSPORTATION
 FEDERAL HIGHWAY ADMINISTRATION
 CENTRAL FEDERAL LANDS HIGHWAY DIVISION

CULVERT NO. 5 @ STA 1811+28
PLAN & PROFILE

Scale: As Noted
 Date: August 21, 2015
 SHEET No. 5 OF 11

STATE	SADDLE ROAD PROJECT	SHEET NO.	TOTAL SHEETS
HI	HI SR 200(3)	L6	L27

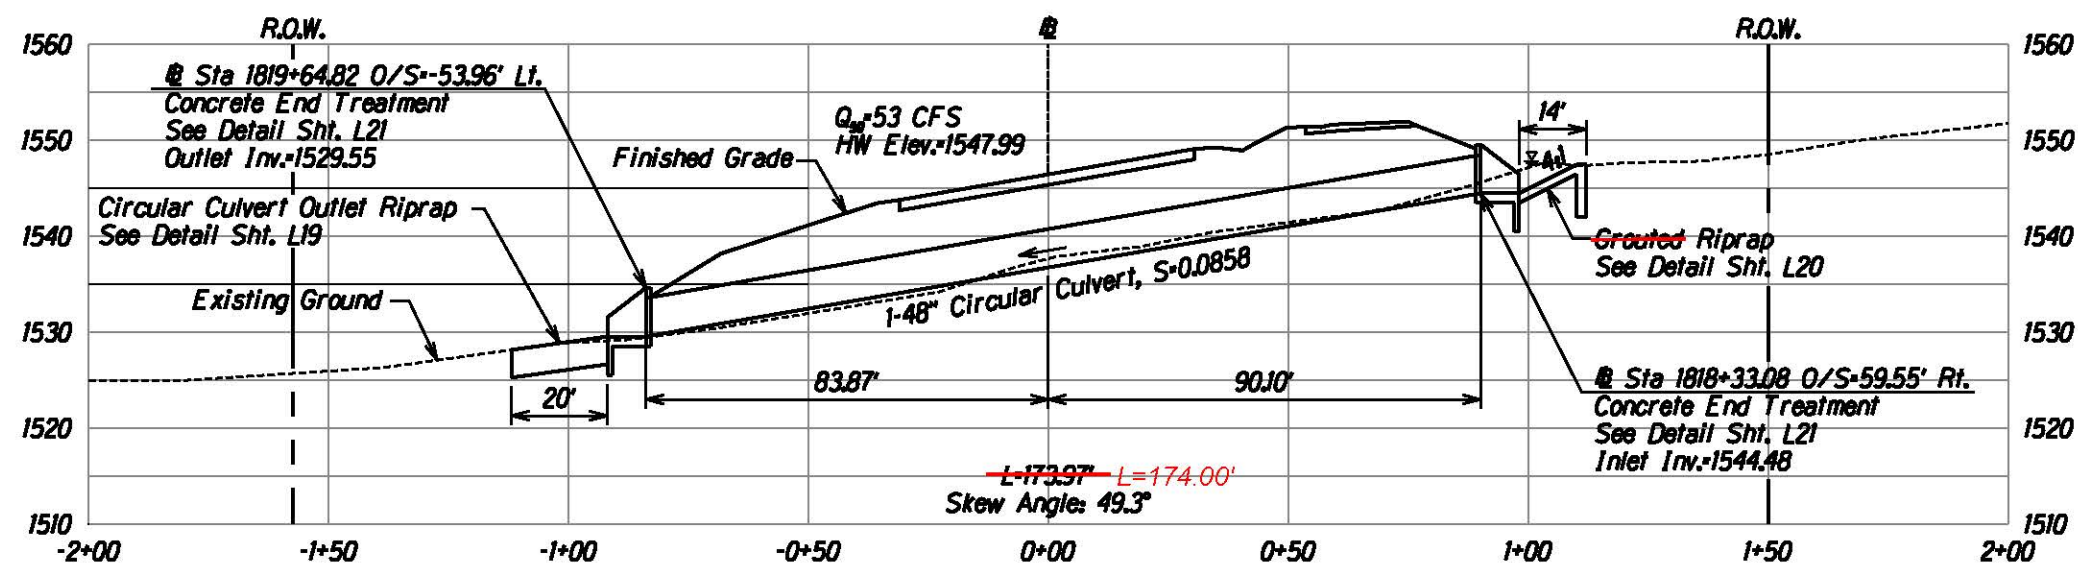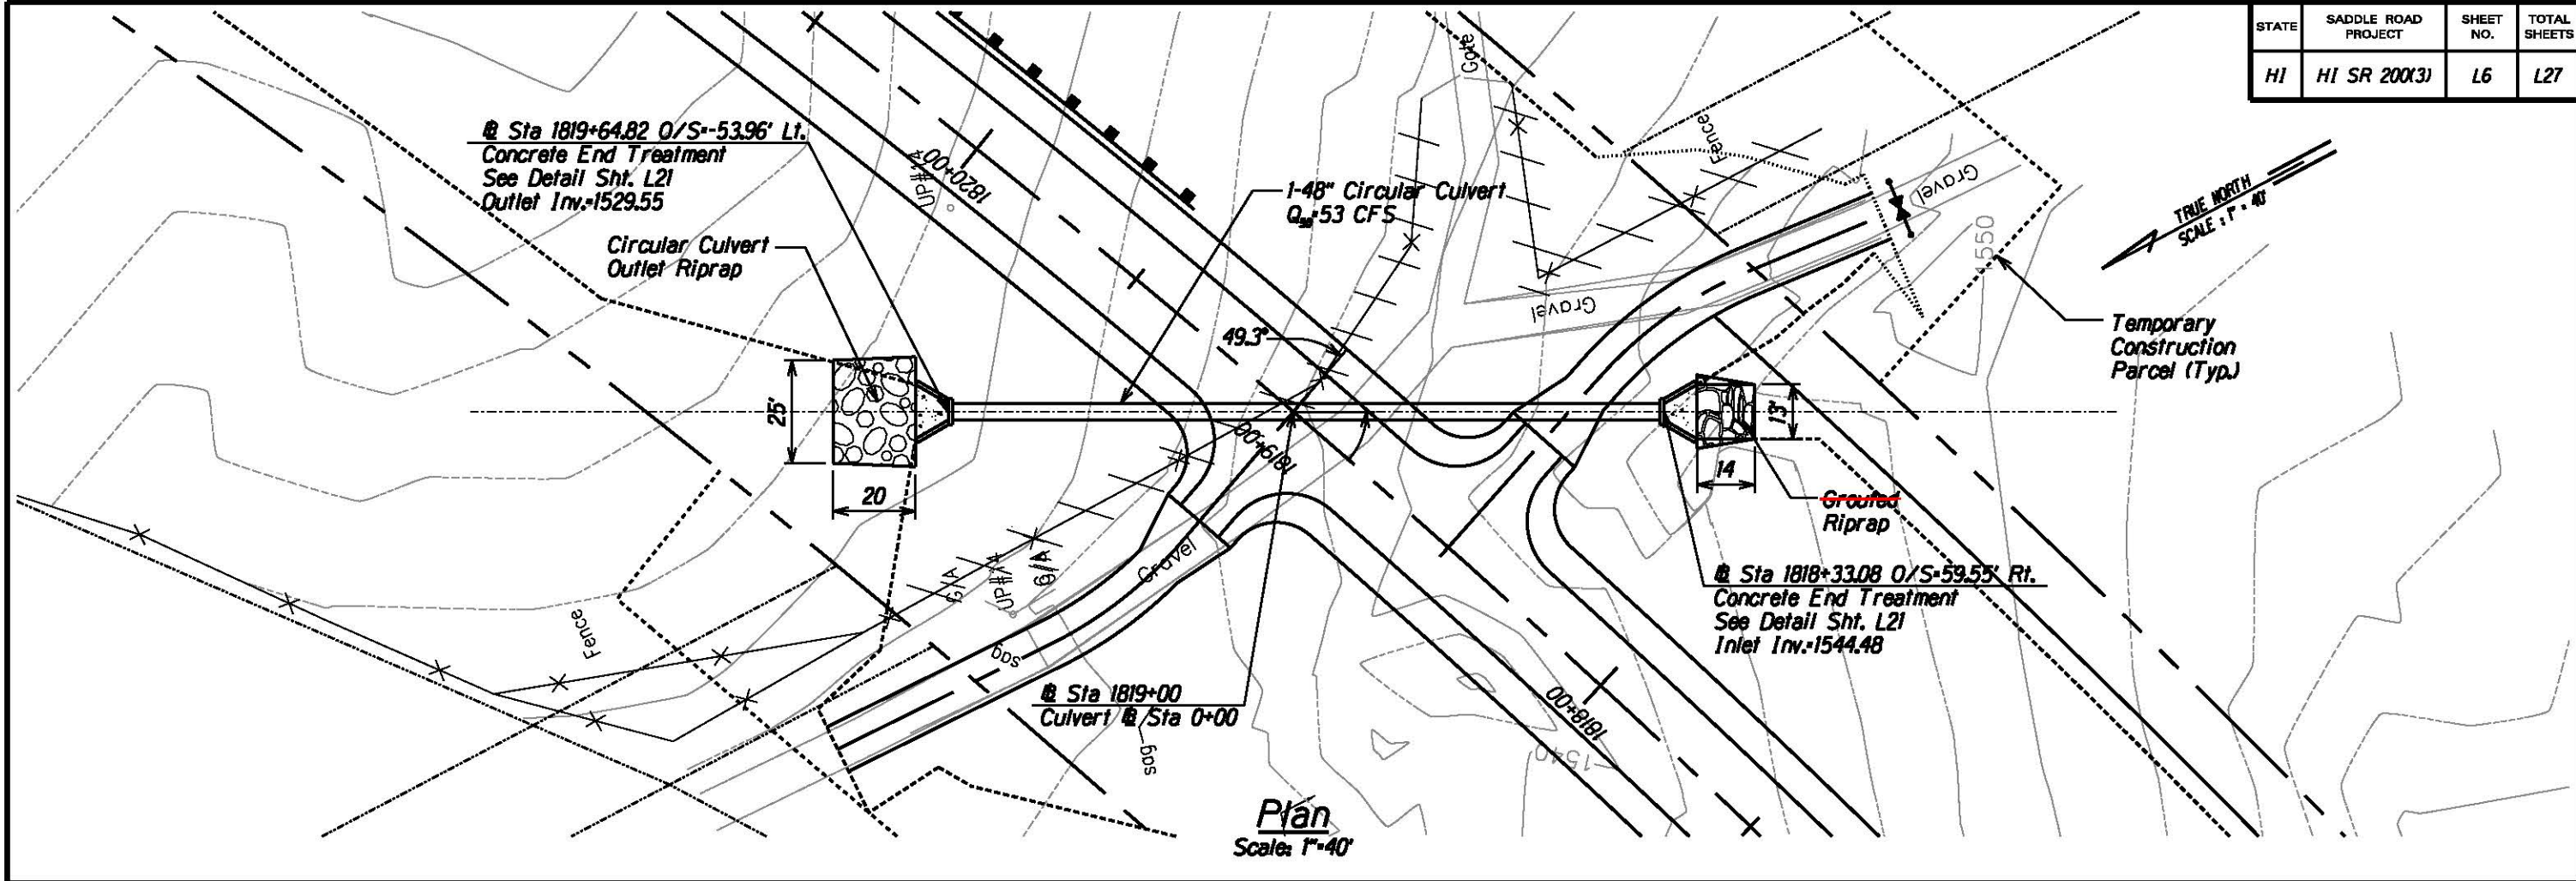

Note:
Prepare culvert subgrade as shown on sheet L27.

BRUCE E. MEYERS
Licensed Professional Engineer
No. 8336-C
HAWAII, U.S.A.

The work was prepared by me or under my supervision and construction of this project will be under my observation.
Bruce E. Meyers
Expiration Date of License 2018.



U.S. DEPARTMENT OF TRANSPORTATION
FEDERAL HIGHWAY ADMINISTRATION
CENTRAL FEDERAL LANDS HIGHWAY DIVISION

CULVERT NO. 6 @ STA 1819+00
PLAN & PROFILE

Scale: As Noted Date: August 21, 2015

SHEET No. 6 OF 11

STATE	SADDLE ROAD PROJECT	SHEET NO.	TOTAL SHEETS
HI	HI SR 200(3)	L7	L27

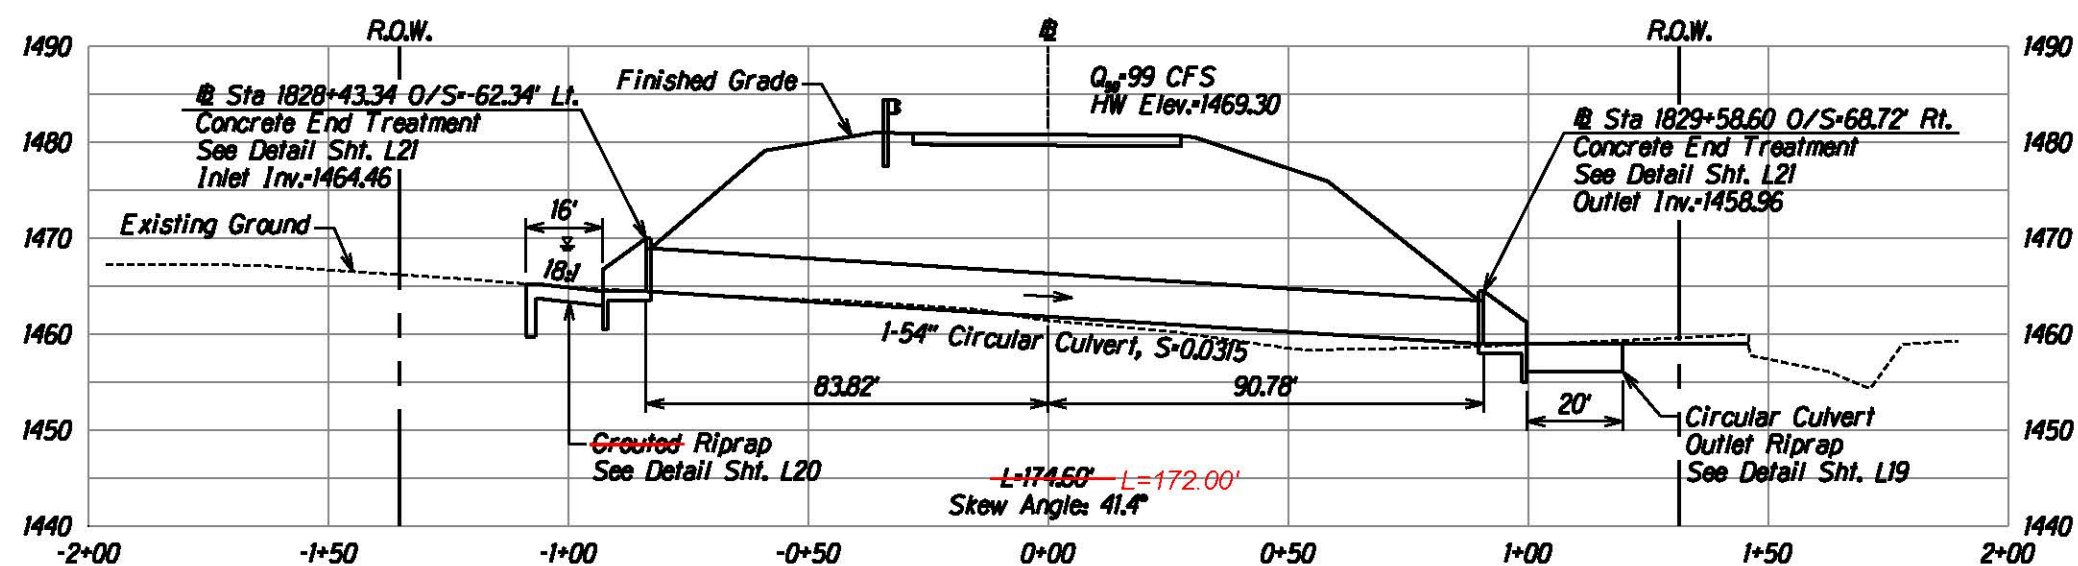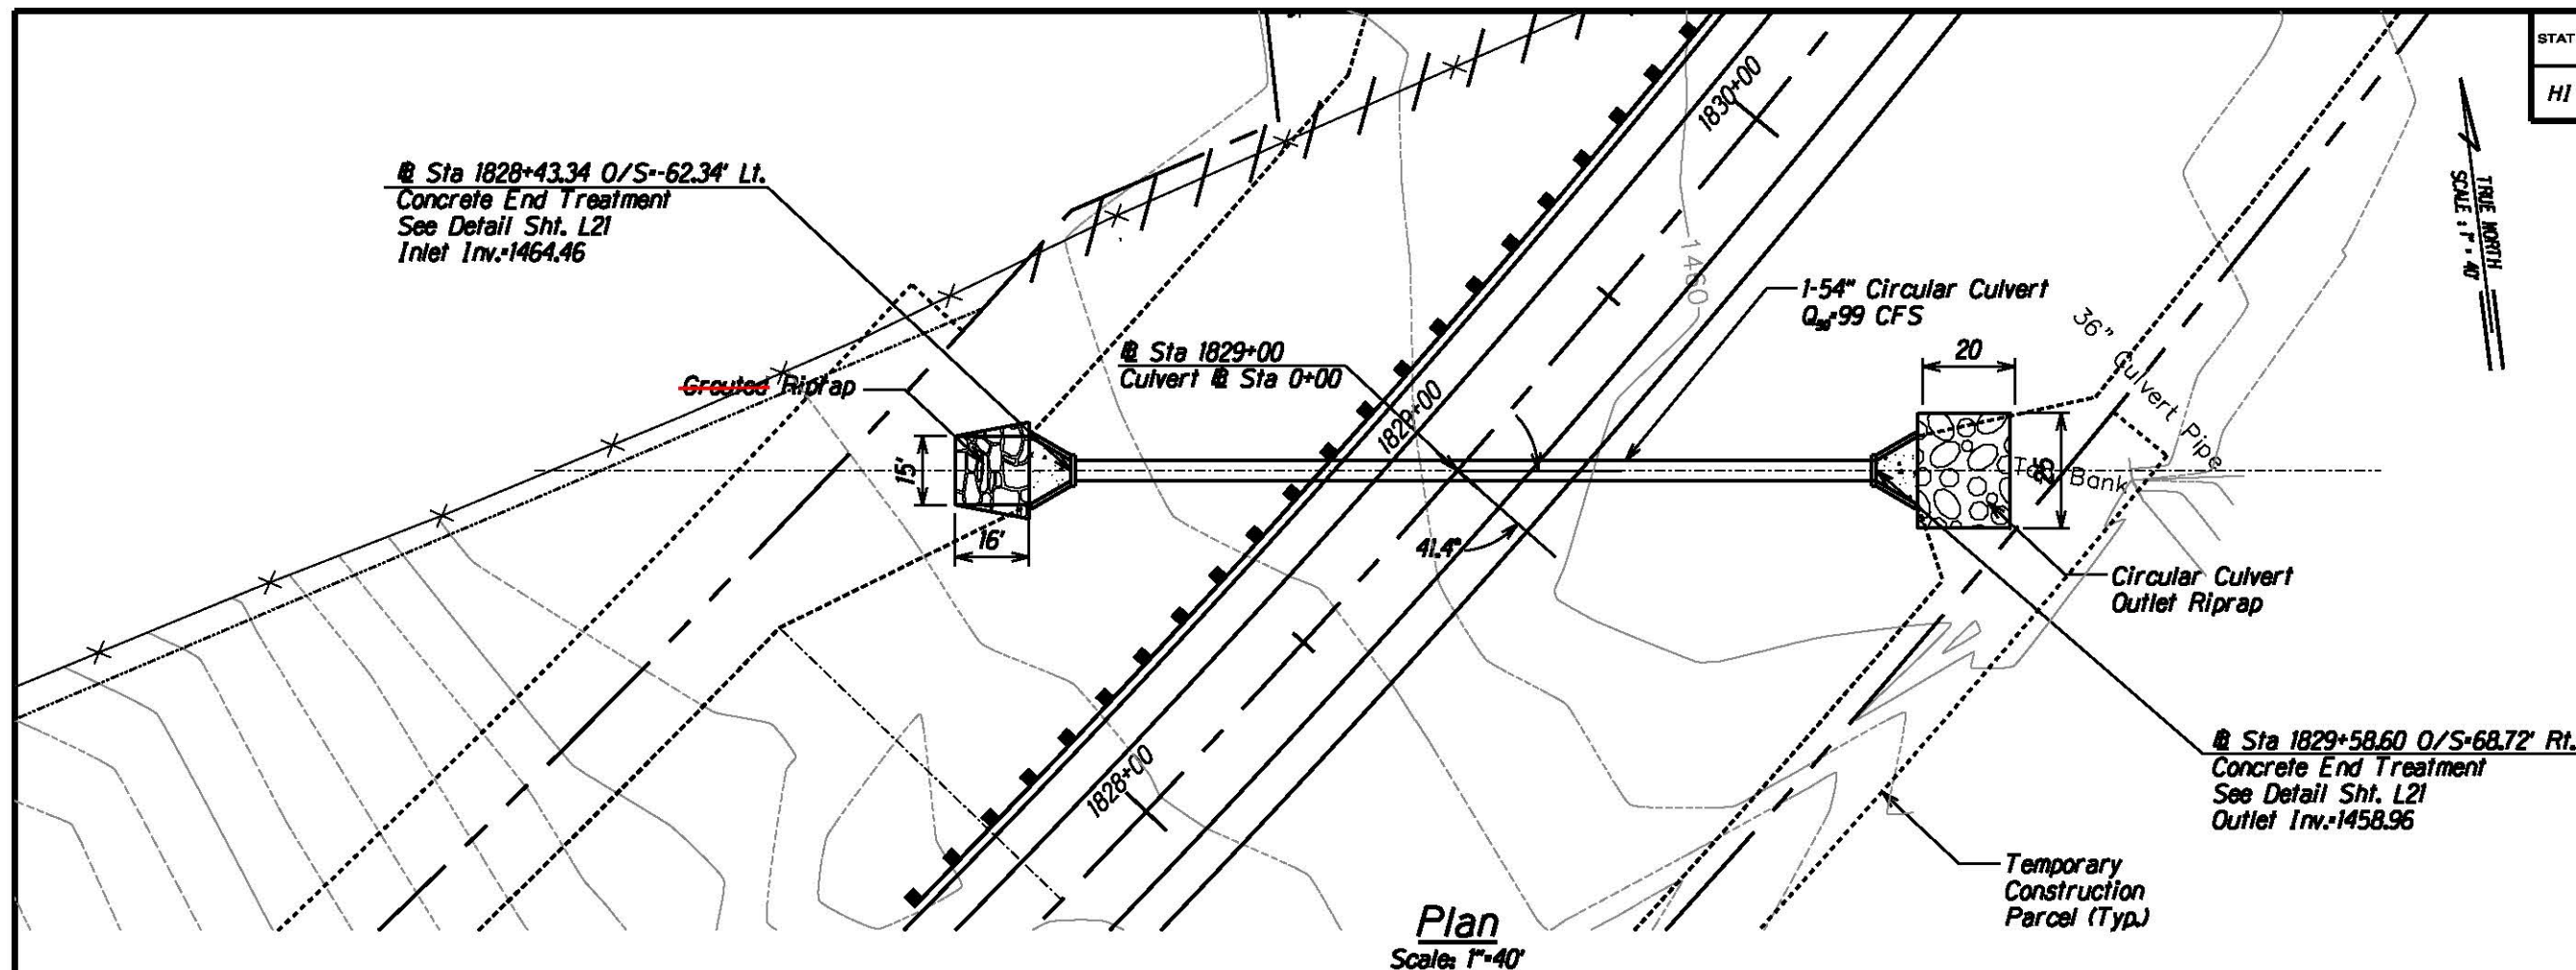

Note:
Prepare culvert subgrade as shown on sheet L27.






U.S. DEPARTMENT OF TRANSPORTATION
FEDERAL HIGHWAY ADMINISTRATION
CENTRAL FEDERAL LANDS HIGHWAY DIVISION

**CULVERT NO. 7 @ STA 1829+00
PLAN & PROFILE**

Scale: As Noted Date: August 21, 2015

SHEET No. 7 OF 11

CULVERT NO. 7

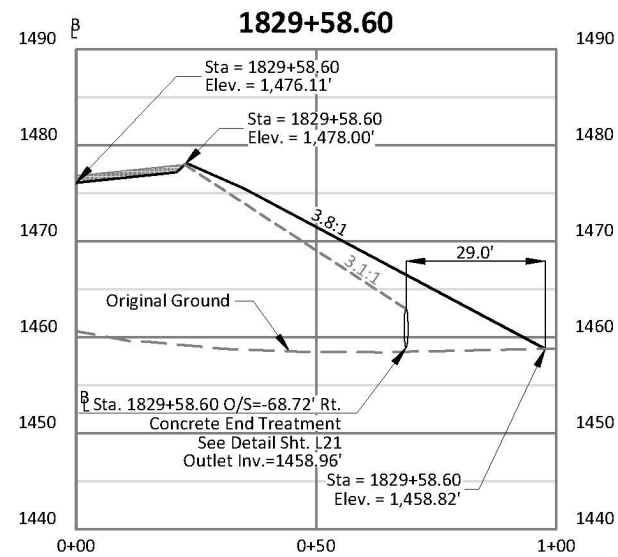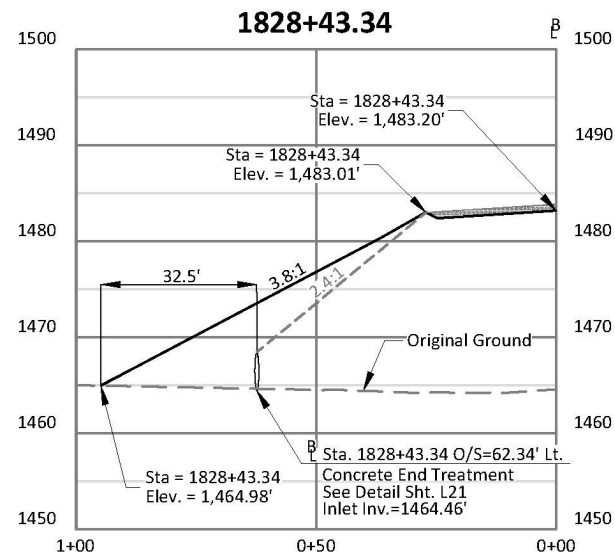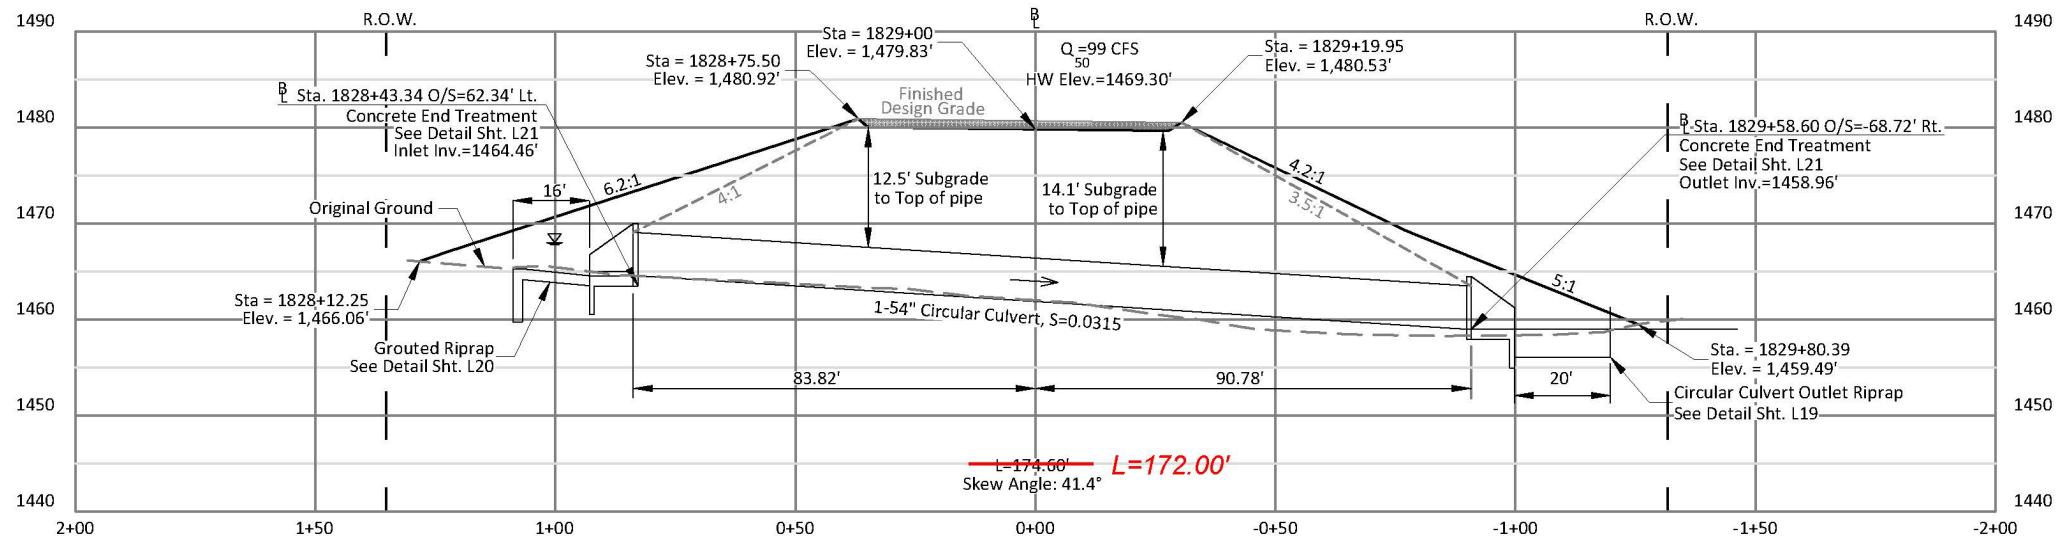

NOTES:
Prepare culvert subgrade as shown on sheet L27.
Station and offset labels are based on centerline of road alignment.
Elevations shown are to final design grade unless otherwise noted.

CONFIDENTIALITY NOTES:

The information contained in this exhibit is legally privileged and confidential information intended only for the use of the recipients. If you are not the intended recipients, you are hereby notified that any use, dissemination, distribution or copying of this information is strictly prohibited.

REVISIONS:



WILLIAM H. SMITH
& ASSOCIATES, INC.
SURVEYORS ENGINEERS PLANNERS
550 EAST SECOND NORTH
GREEN RIVER, WY 82935
PHONE: 307-875-3638
FAX: 307-875-3639
www.whtsmithpc.com



DRAWN BY: BLM
SCALE: 1"=40'H & 20"V
DATE: 06/02/2016

CHECKED BY: TMW
JOB NO: 2016025
SHEET 1 OF 1



CULVERT NO. 7
STA. 1829+00 PROFILE

STATE	SADDLE ROAD PROJECT	SHEET NO.	TOTAL SHEETS
HI	HI SR 200(3)	L9	L27

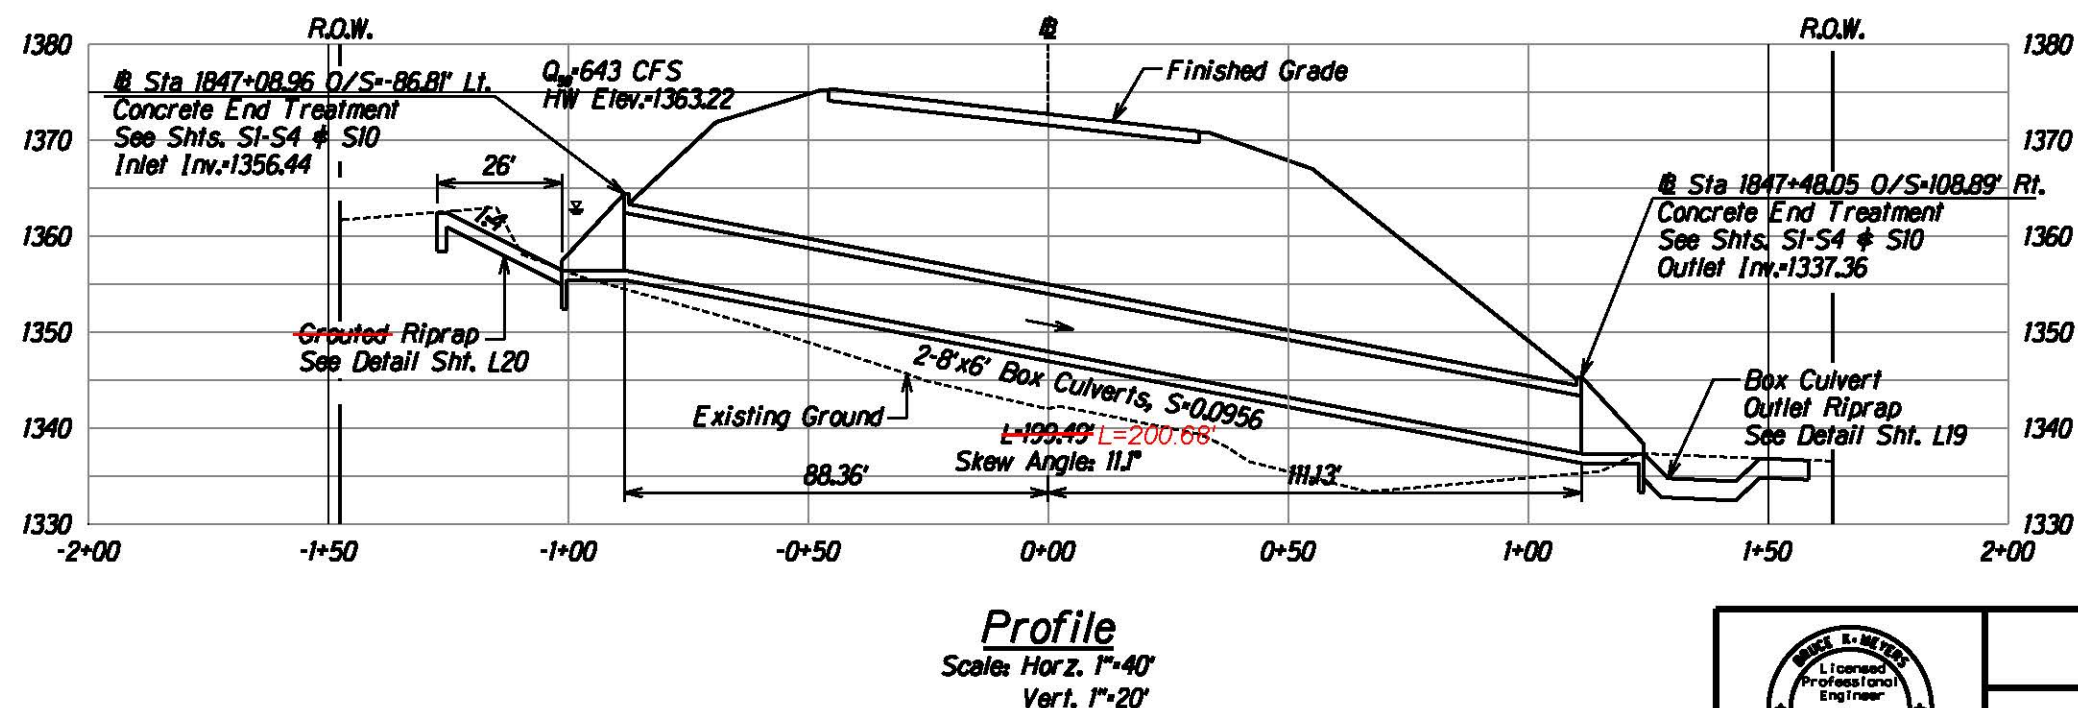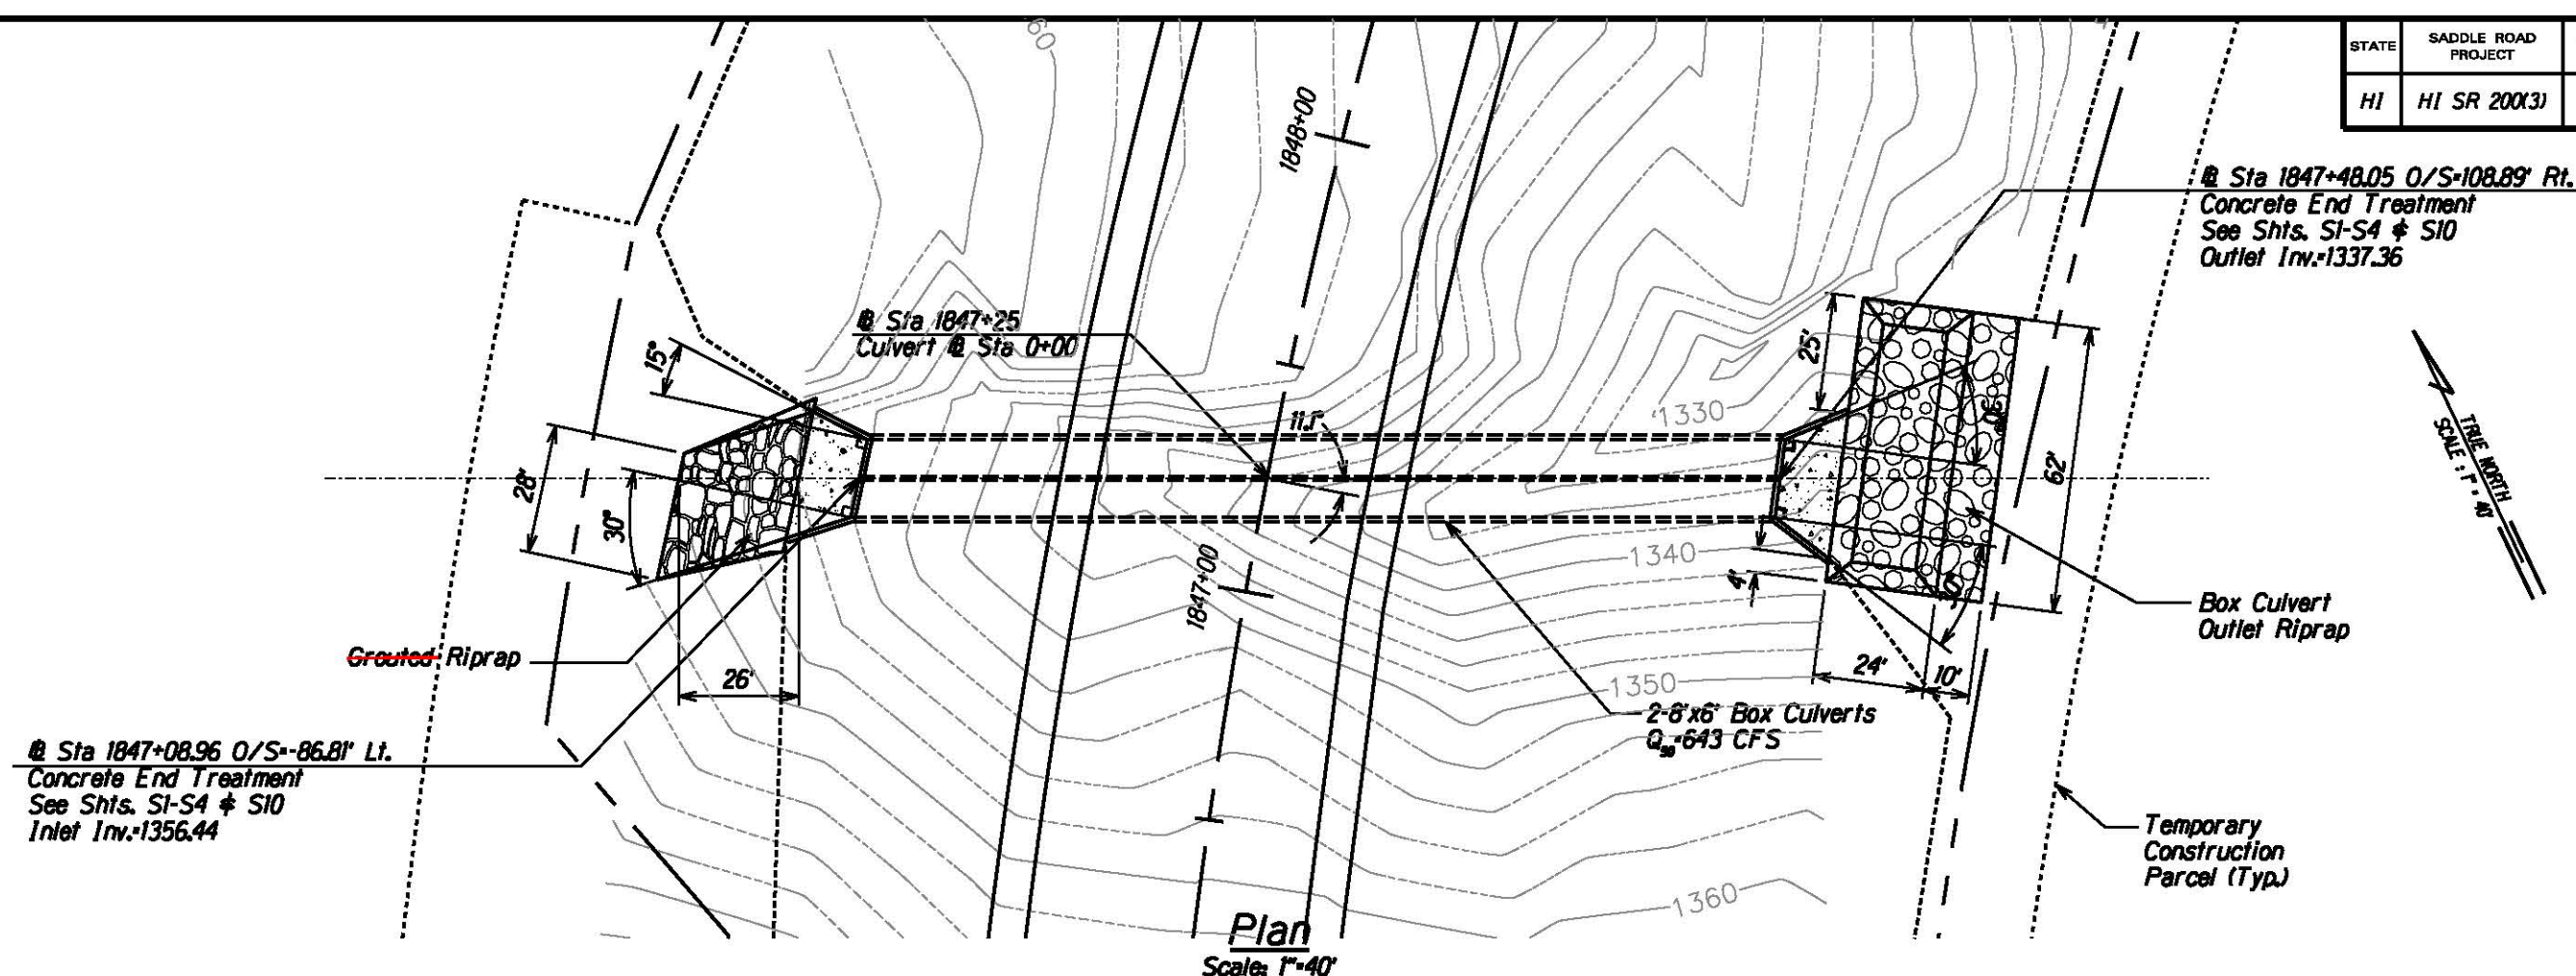

Note:
Prepare culvert subgrade as shown on sheet L27.





U.S. DEPARTMENT OF TRANSPORTATION
FEDERAL HIGHWAY ADMINISTRATION
CENTRAL FEDERAL LANDS HIGHWAY DIVISION

CULVERT NO. 9 @ STA 1847+25
PLAN & PROFILE

Scale: As Noted Date: August 21, 2015

SHEET No. 9 OF 11

STATE	SADDLE ROAD PROJECT	SHEET NO.	TOTAL SHEETS
HI	HI SR 200(3)	L10	L27

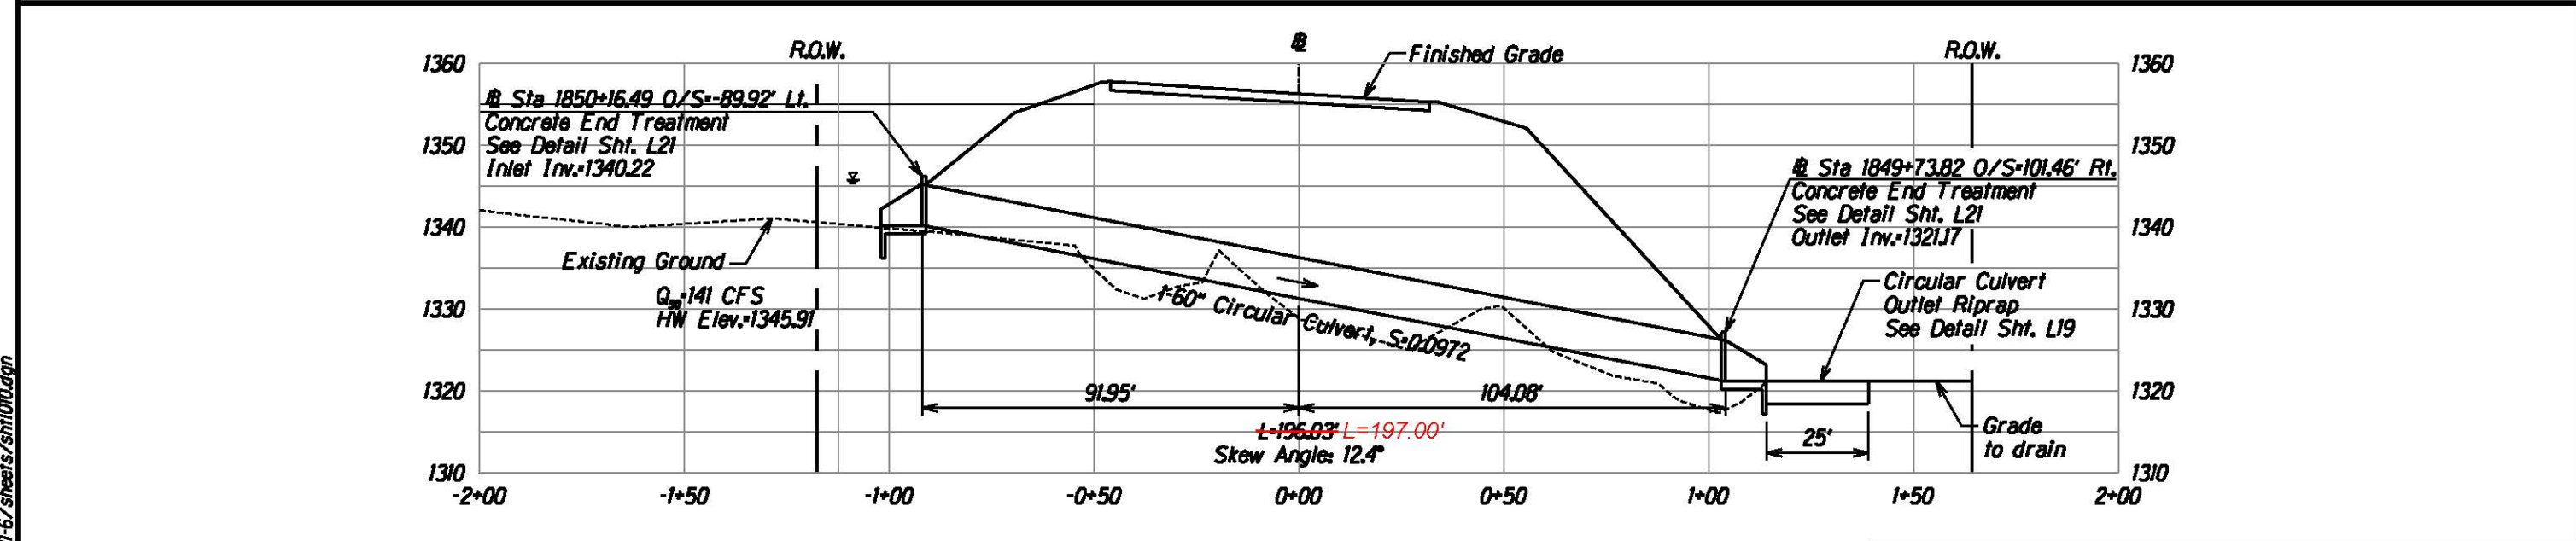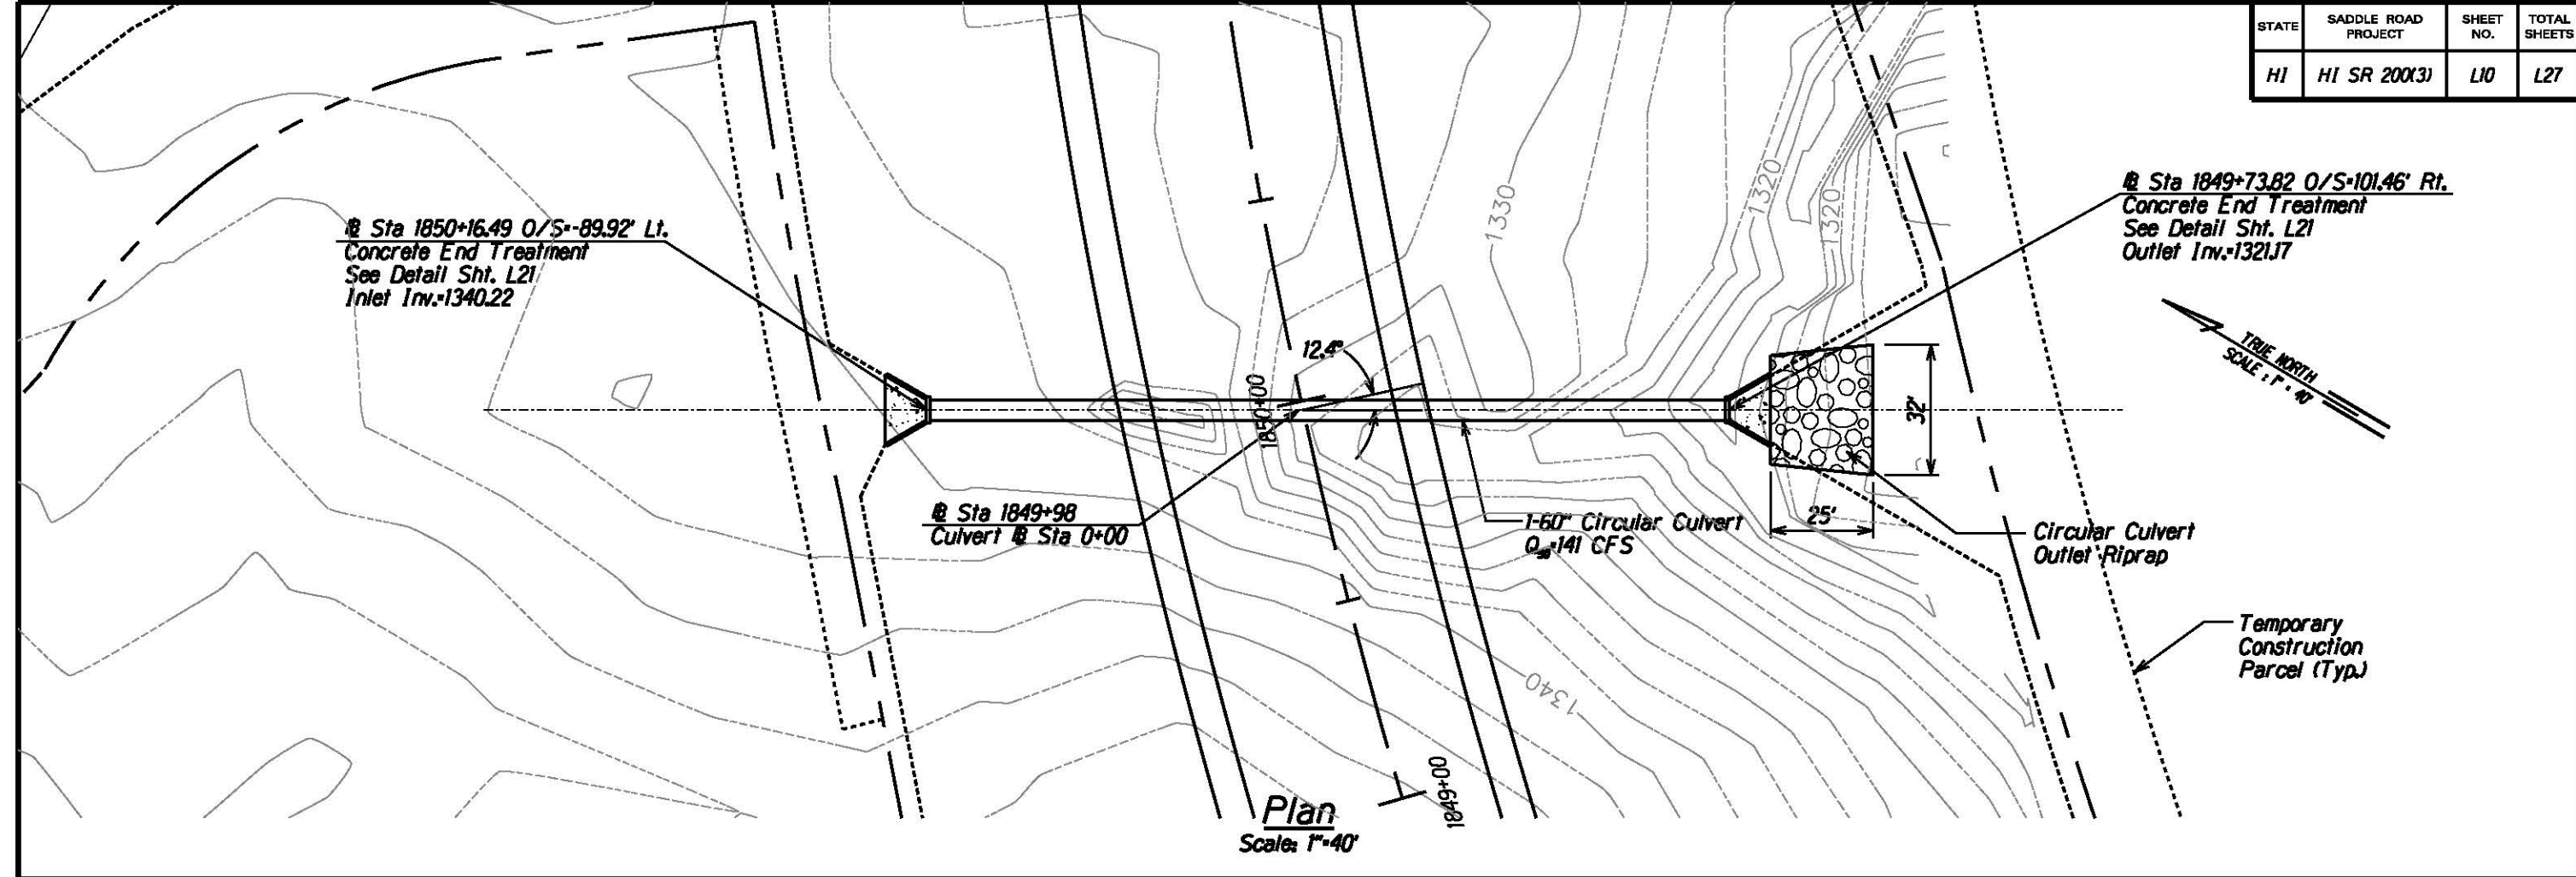

Profile
Scale: Horz. 1"=40'
Vert. 1"=20'

Note:
Prepare culvert subgrade as shown on sheet L27.

BRUCE E. MEYERS

Licensed Professional Engineer

No. 8336-C

HAWAII, U.S.A.

The work was prepared by me or under my supervision and construction of this project will be under my observation.

Bruce E. Meyers

Expiration Date of License 2018.




U.S. DEPARTMENT OF TRANSPORTATION
FEDERAL HIGHWAY ADMINISTRATION
CENTRAL FEDERAL LANDS HIGHWAY DIVISION

CULVERT NO. 10 @ STA 1849+98
PLAN & PROFILE

Scale: As Noted
Date: August 21, 2015

SHEET No. 10 OF 11

CULVERT NO. 10

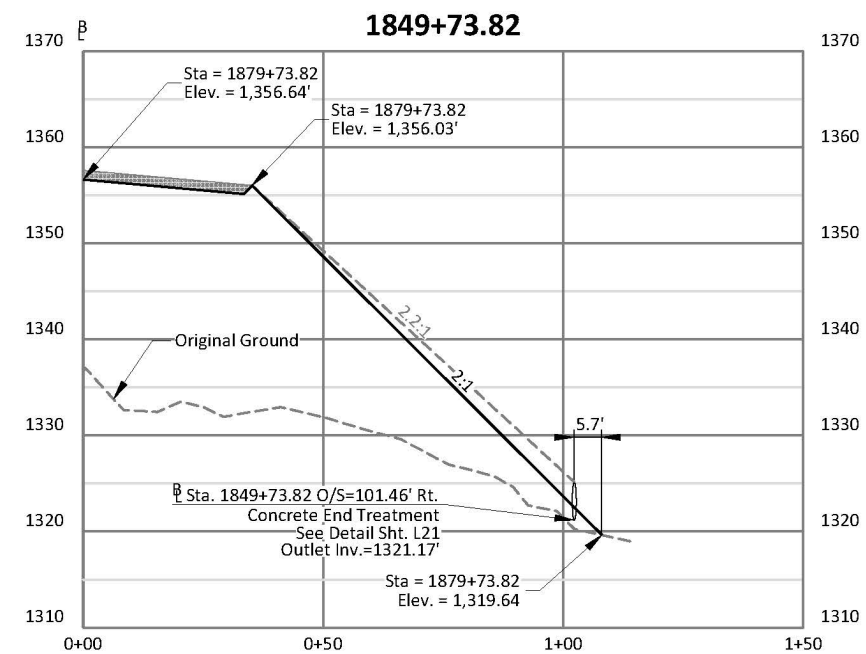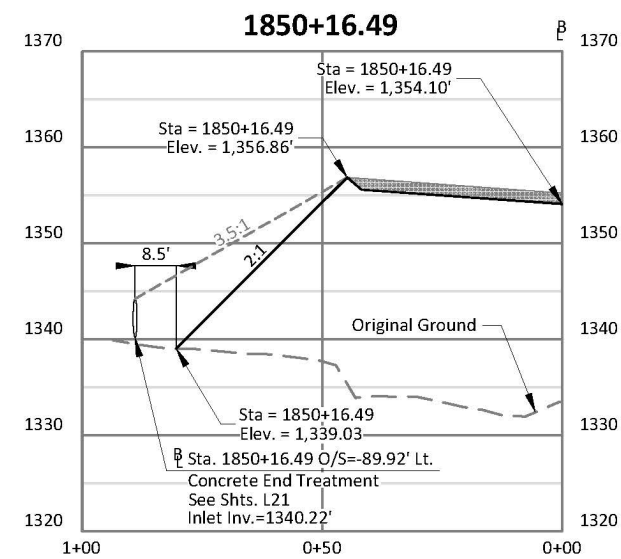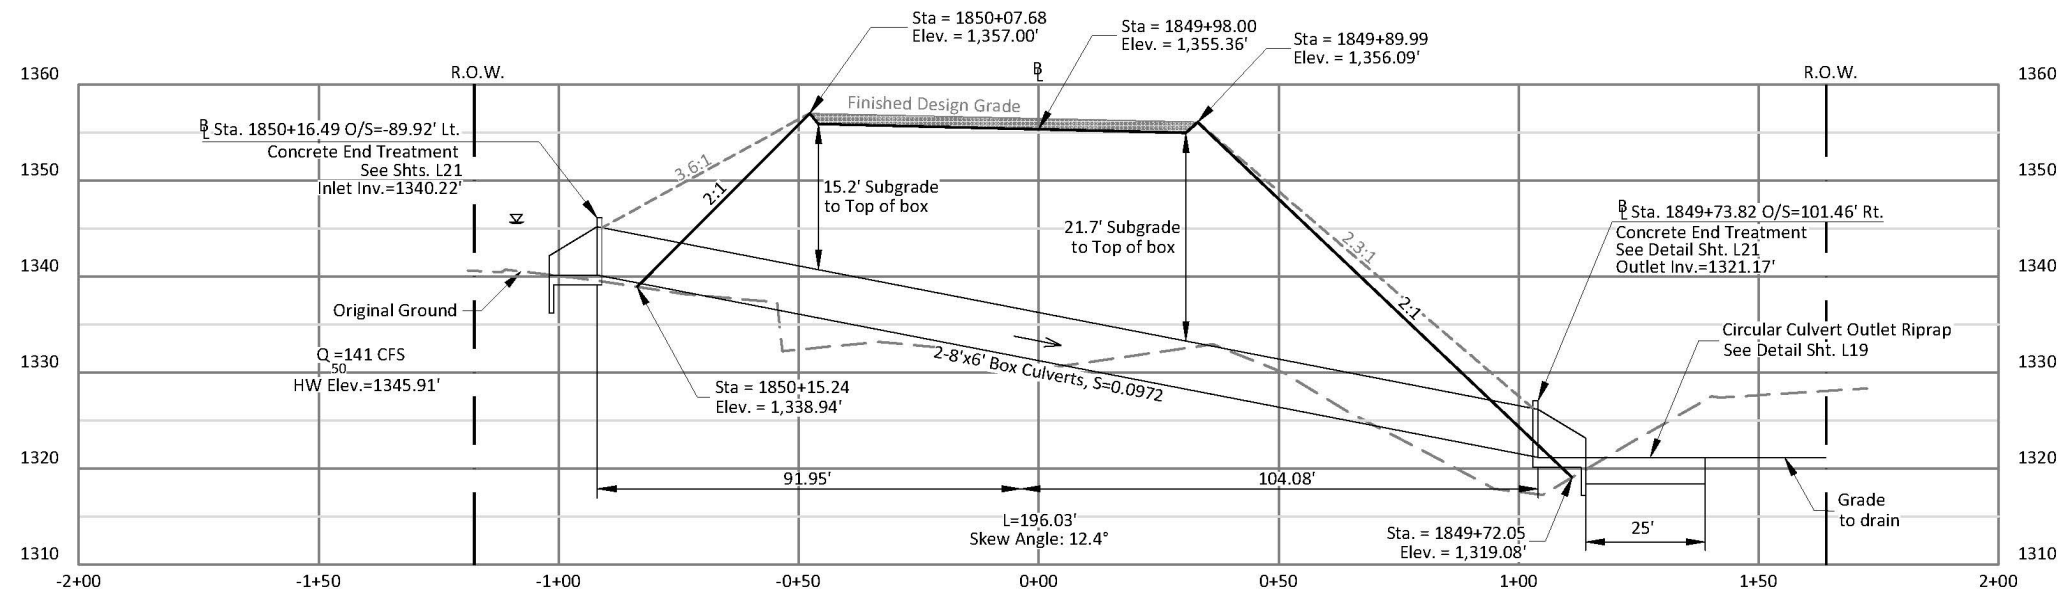

NOTES:
Prepare culvert subgrade as shown on sheet L27.
Station and offset labels are based on centerline of road alignment.
Elevations shown are to final design grade unless otherwise noted.

CONFIDENTIALITY NOTES:
The information contained in this exhibit is legally privileged and confidential information intended only for the use of the recipients. If you are not the intended recipients, you are hereby notified that any use, dissemination, distribution or copying of this information is strictly prohibited.

REVISIONS:



WILLIAM H. SMITH
& ASSOCIATES, INC.
SURVEYORS ENGINEERS PLANNERS
550 EAST SECOND NORTH
GREEN RIVER, WY 82935
PHONE: 307-875-3638
FAX: 307-875-3639
www.whtsmthpc.com

DRAWN BY: BLM
SCALE: 1"=40'H & 20'V
DATE: 06/02/2016
CHECKED BY: TMW
JOB NO: 2016025
SHEET 1 OF 1





CULVERT NO. 10
STA. 1849+98 PROFILE

STA. 1849+98

STA. 1849+98

STATE	SADDLE ROAD PROJECT	SHEET NO.	TOTAL SHEETS
HI	HI SR 200(3)	L11	L27

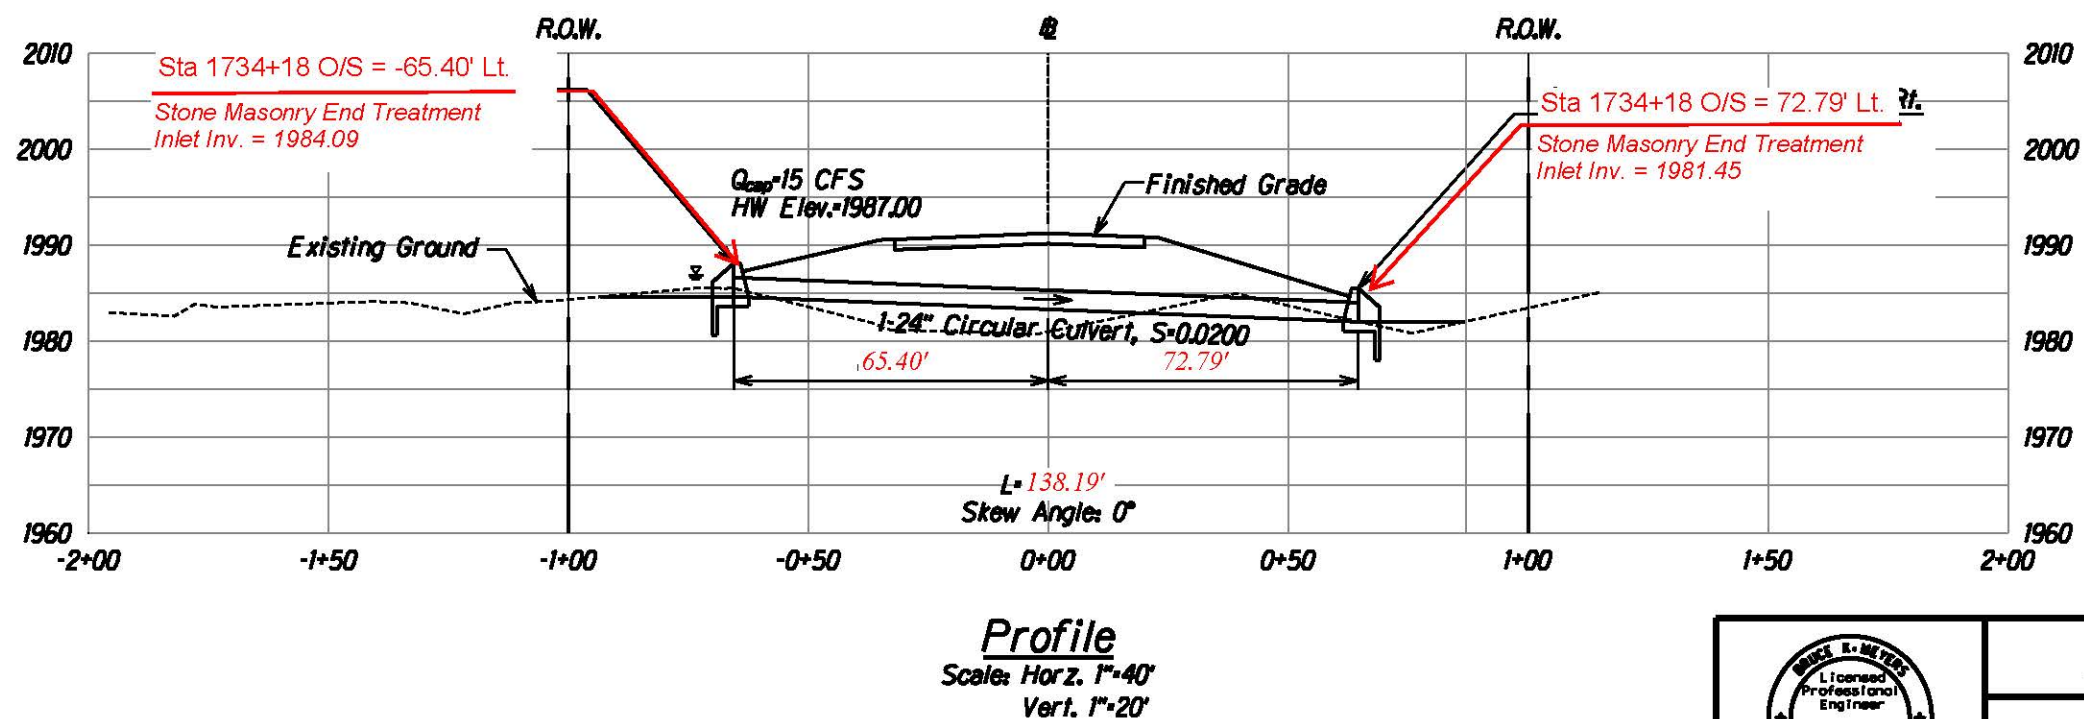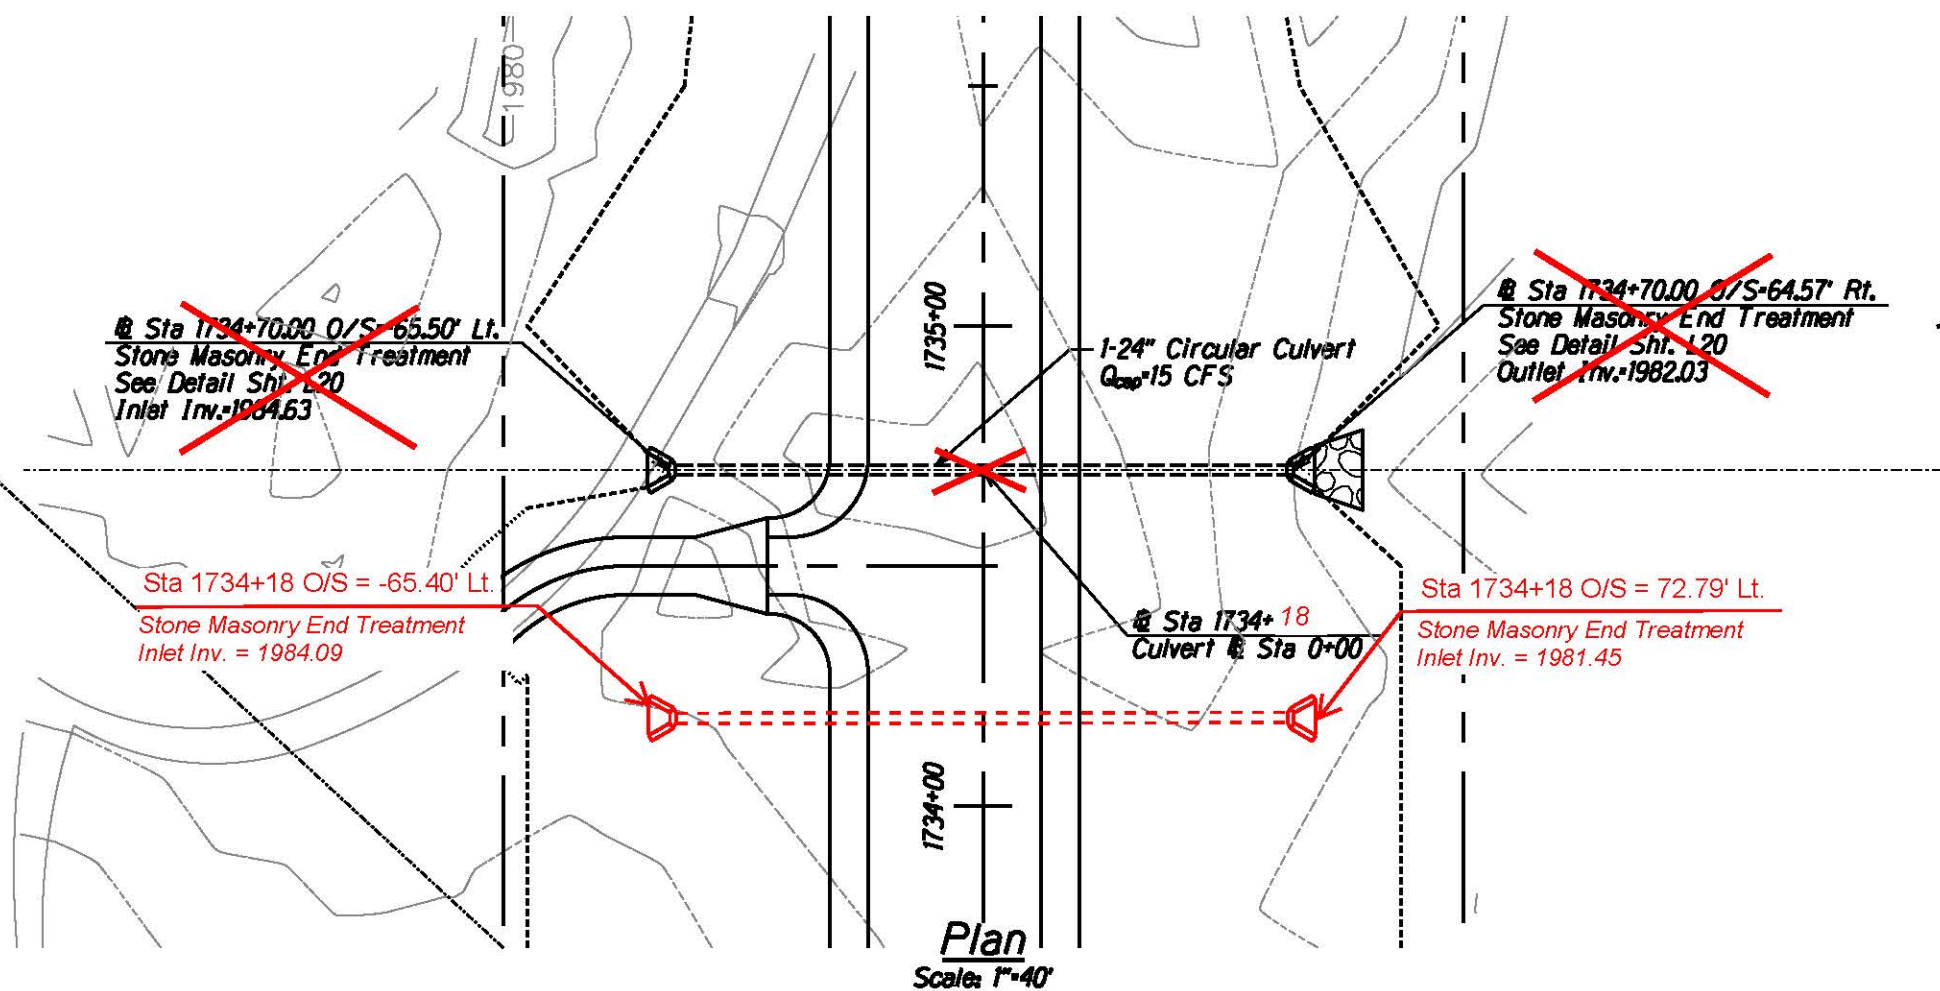

Note:
Prepare culvert subgrade as shown on sheet L27.

The work was prepared by me or under my supervision and construction of this project will be under my observation.
Bruce E. Meyers
 Expiration Date of License 2018.

U.S. DEPARTMENT OF TRANSPORTATION
 FEDERAL HIGHWAY ADMINISTRATION
 CENTRAL FEDERAL LANDS HIGHWAY DIVISION

RELIEF
CULVERT NO. 1 @ STA 1734+18
PLAN & PROFILE

Scale: As Noted Date: August 21, 2015

SHEET No. 11 OF 11