
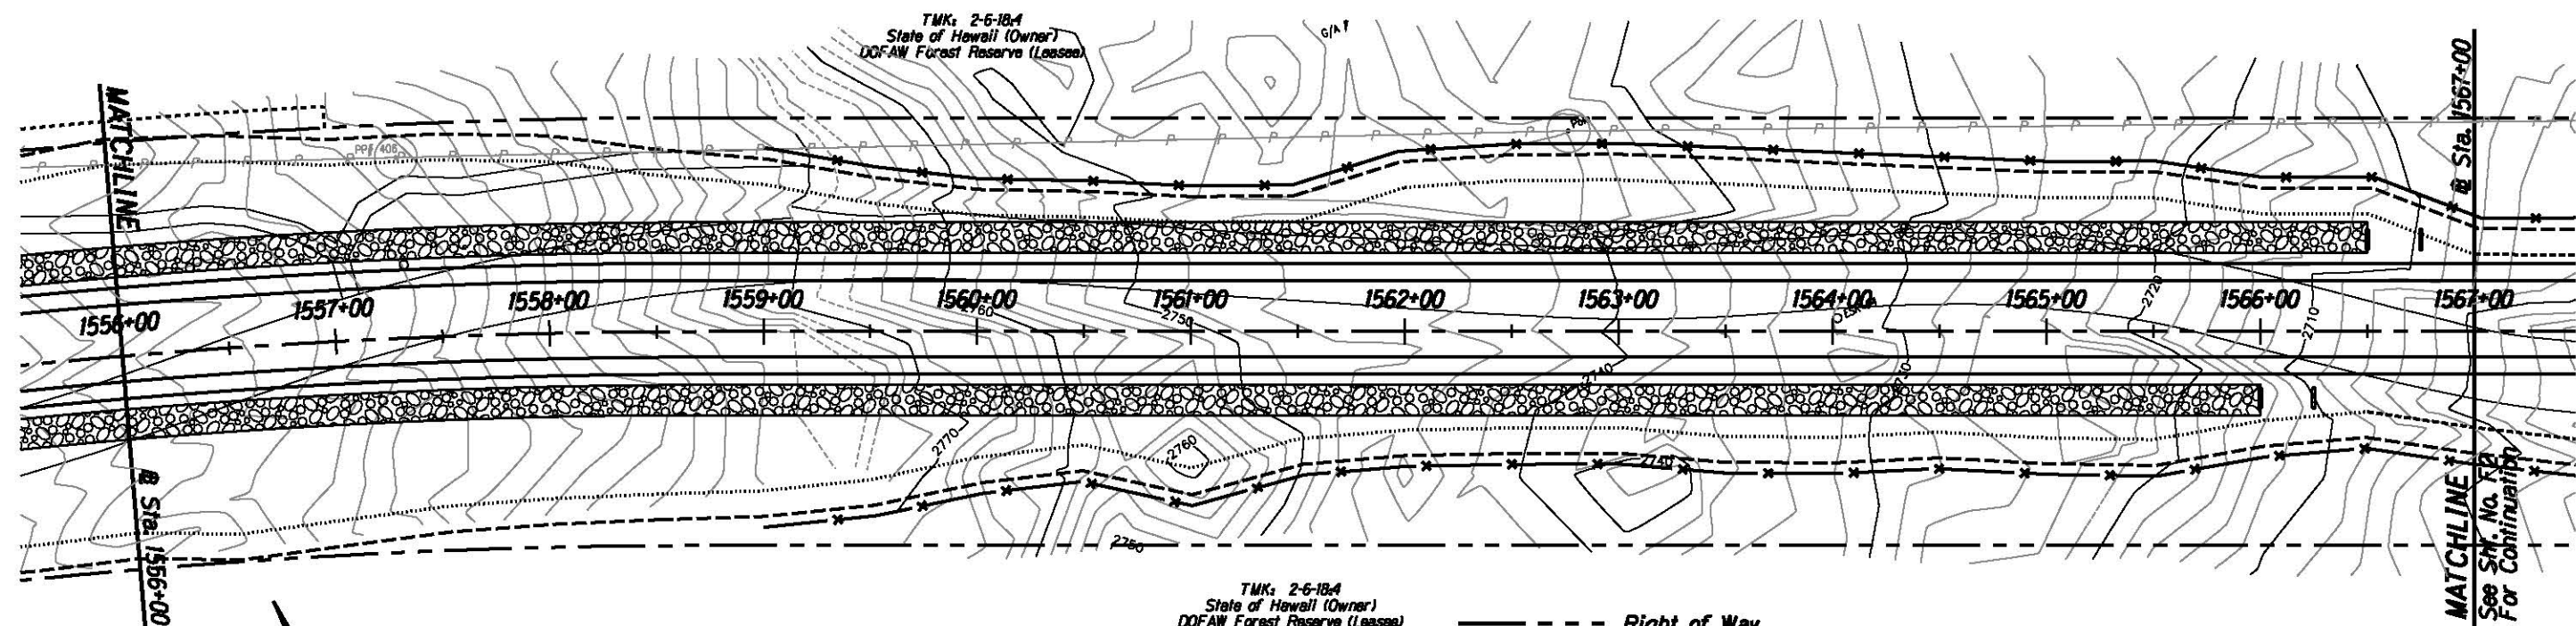


STATE	SADDLE ROAD PROJECT	SHEET NO.	TOTAL SHEETS
HI	HI SR 200(3)	F1	F20

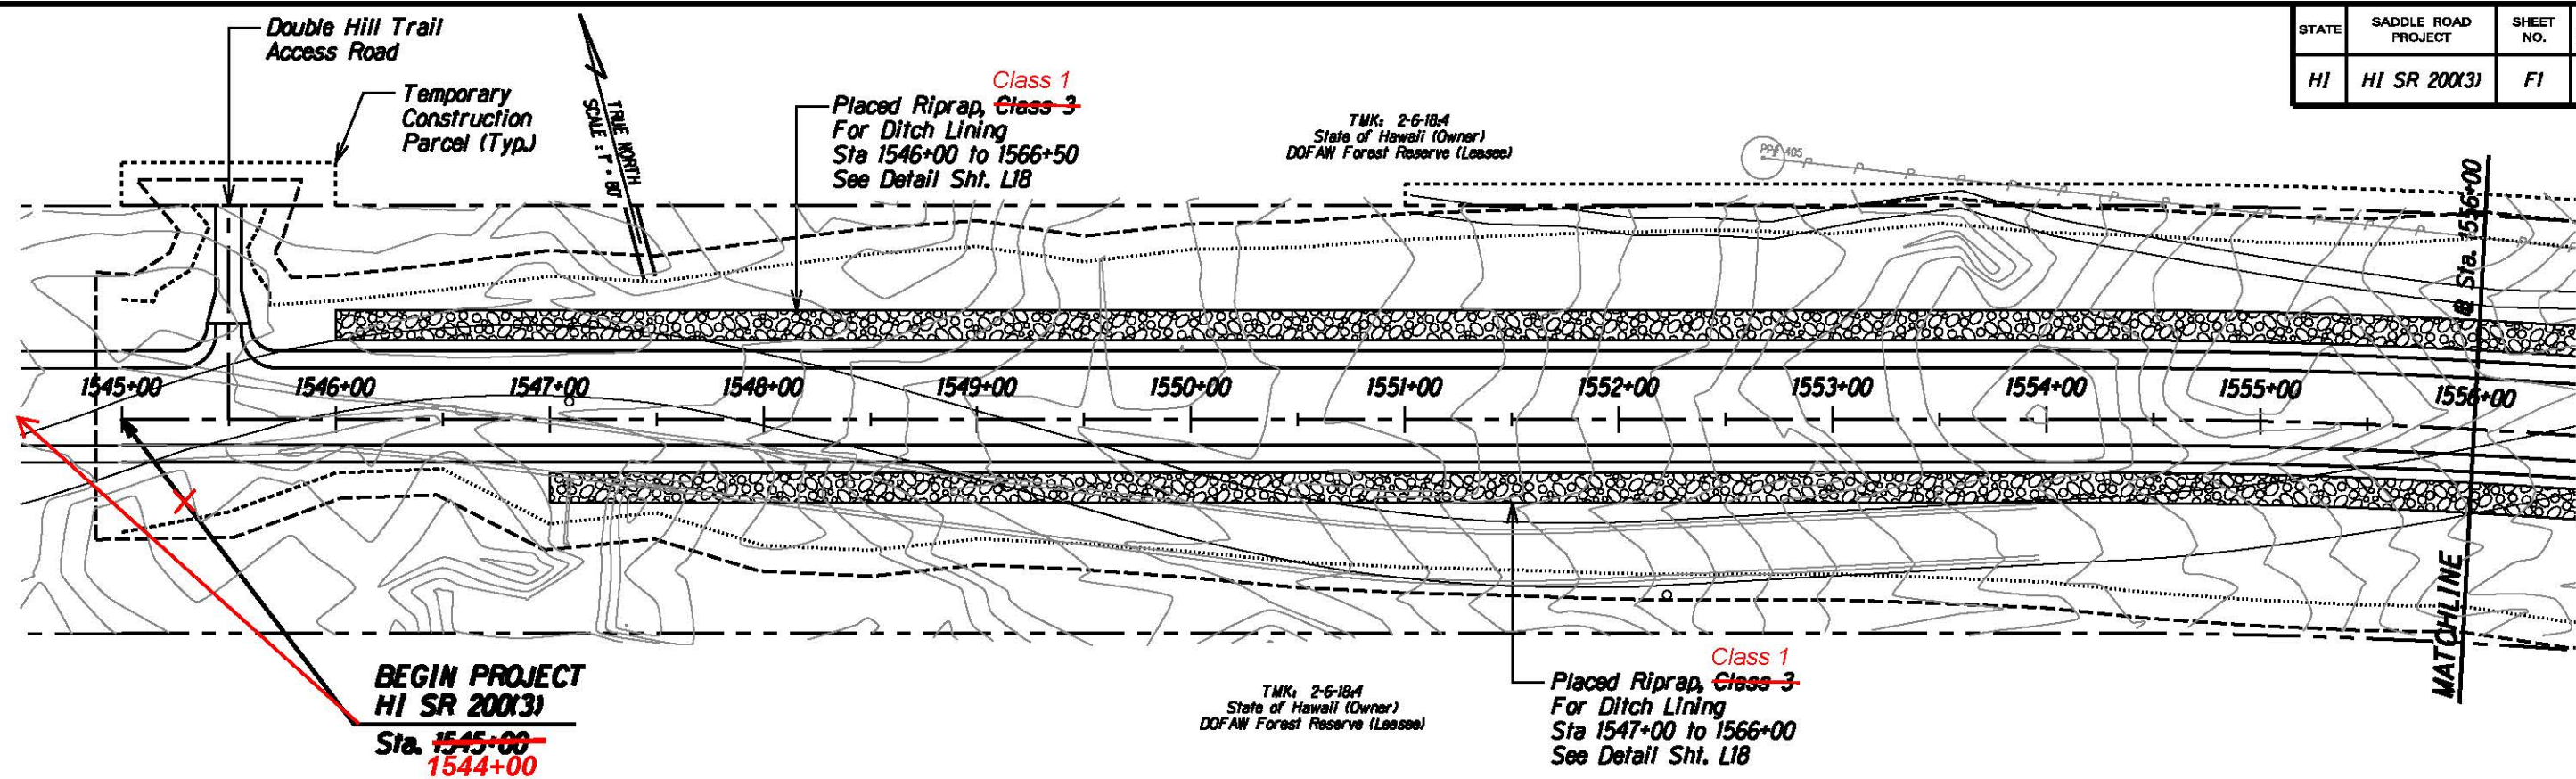

- Mortared Riprap
- Roadway Obliteration
- Placed Riprap, ~~Class 3~~ ^{Class 1}
- Rolled Erosion Control Product, Type 3B ^{Mulch}

- Right of Way
- Construction Fence
- Construction Limits
- Sediment Control Logs
- Silt Fence
- Toe of Fill Slope
- Top of Cut Slope

The work was prepared by me or under my supervision and construction of this project will be under my observation.
Bruce E. Meyers
Expiration Date of License 2018

U.S. DEPARTMENT OF TRANSPORTATION
FEDERAL HIGHWAY ADMINISTRATION
CENTRAL FEDERAL LANDS HIGHWAY DIVISION



EROSION CONTROL PLAN
@ STA 1545+00 - 1567+00

Scale: 1"=80' Date: August 21, 2015

SHEET No. 1 OF 16

M:\Mproj\Lenzie\Saddle East 11-6\sheet\shft001.dgn

STATE	SADDLE ROAD PROJECT	SHEET NO.	TOTAL SHEETS
HI	HI SR 200(3)	F2	F20

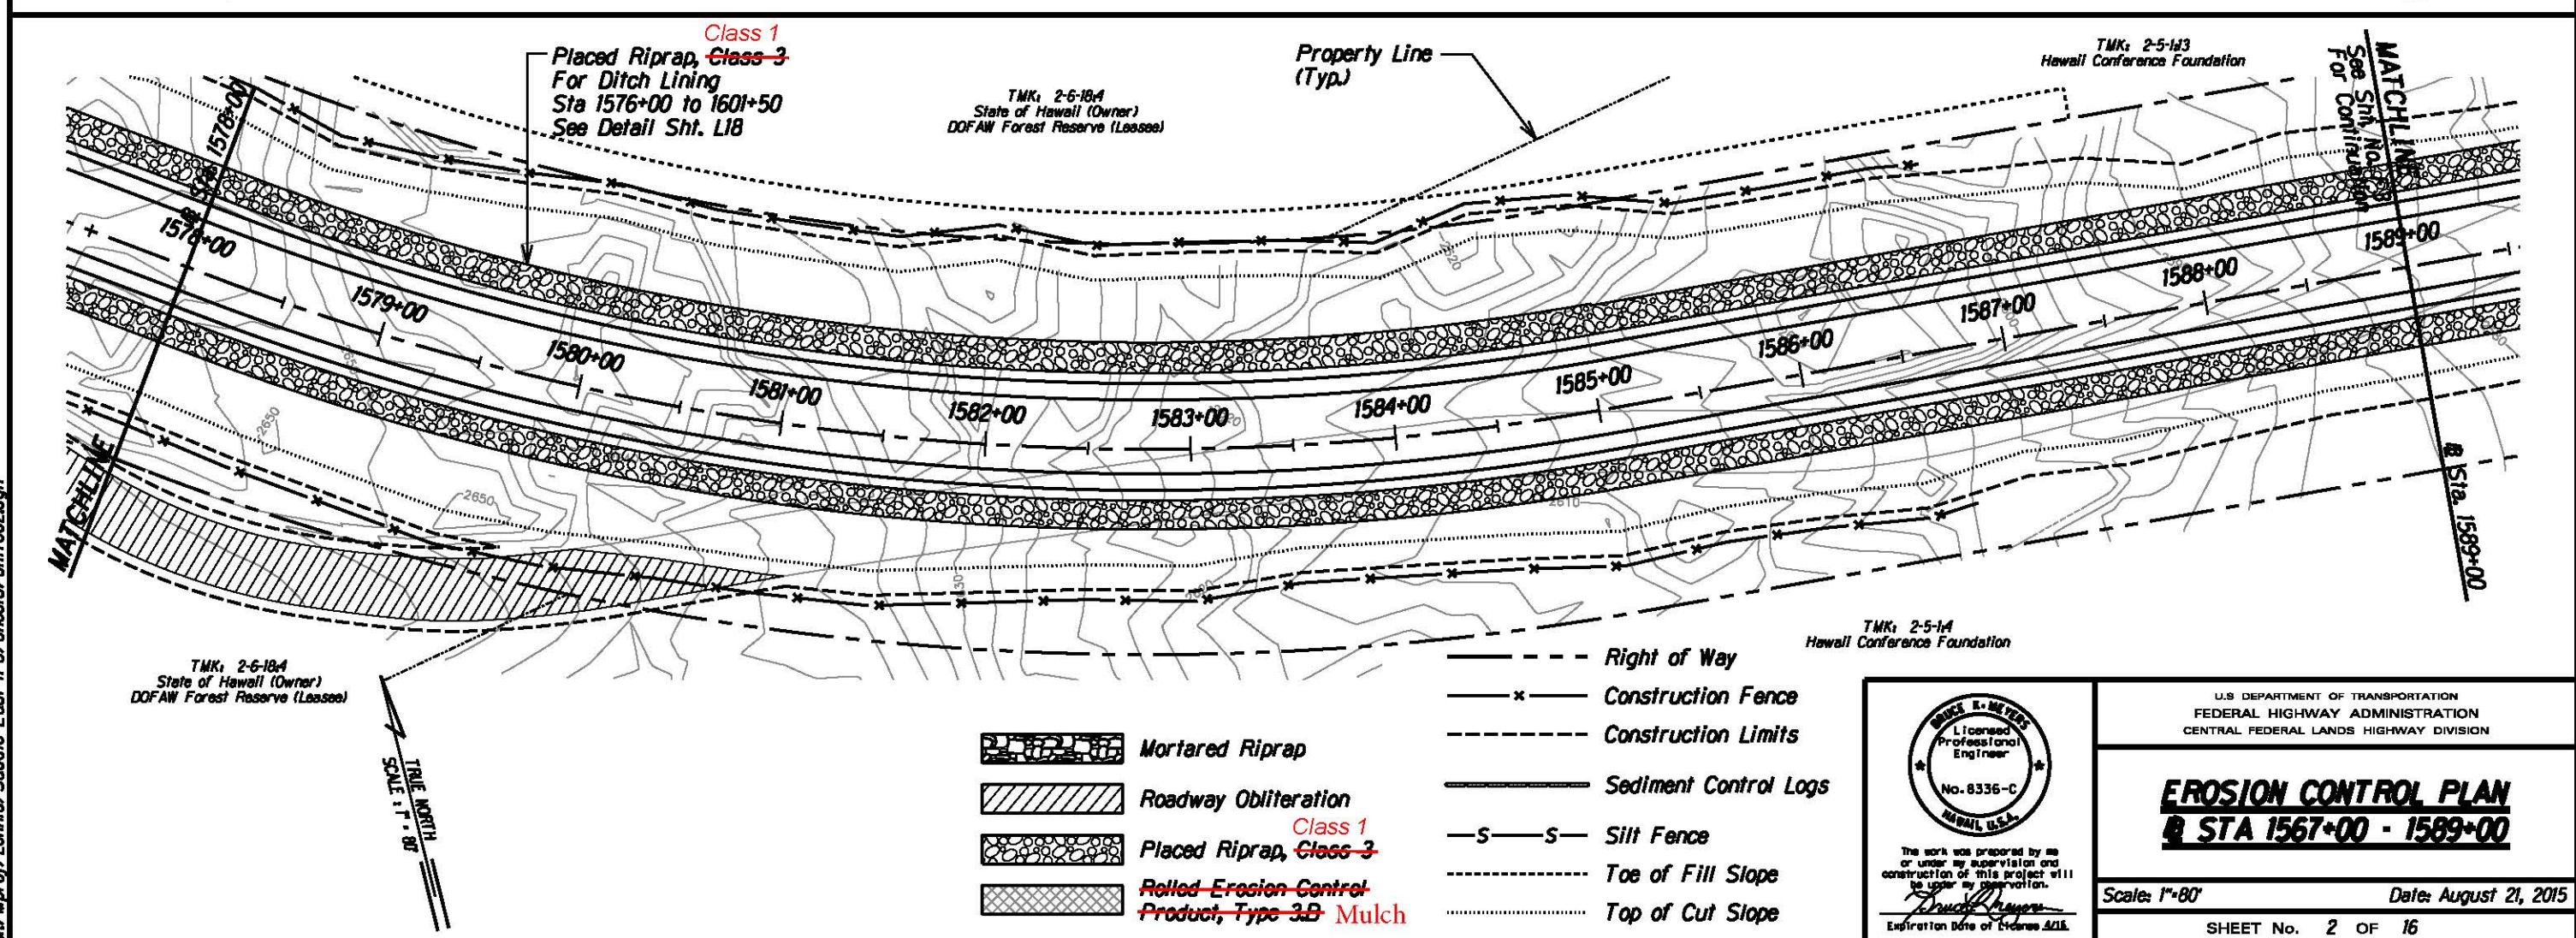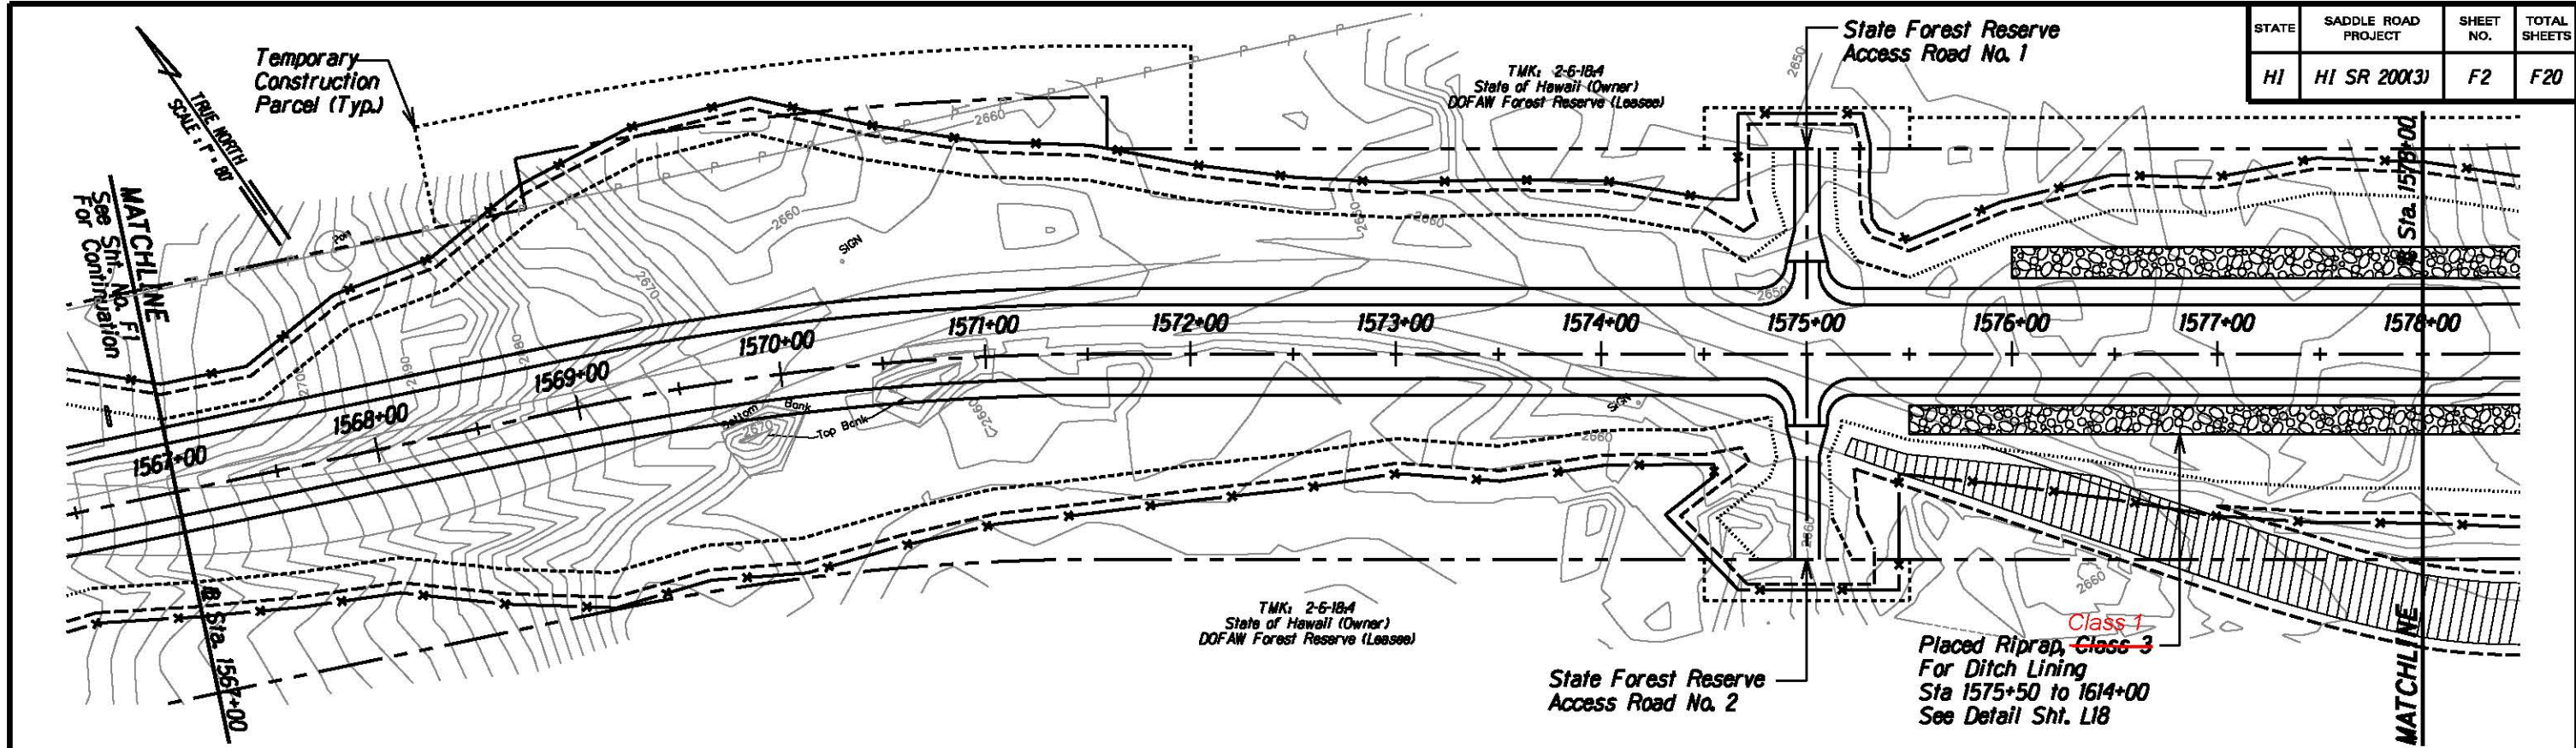

- Mortared Riprap
- Roadway Obliteration
- Placed Riprap, ~~Class 3~~
- ~~Rolled Erosion Control Product, Type 3B Mulch~~

- Right of Way
- Construction Fence
- Construction Limits
- Sediment Control Logs
- Silt Fence
- Toe of Fill Slope
- Top of Cut Slope

The work was prepared by me or under my supervision and construction of this project will be under my supervision.
Bruce E. Meyers
 Expiration Date of License 2018



U.S. DEPARTMENT OF TRANSPORTATION
 FEDERAL HIGHWAY ADMINISTRATION
 CENTRAL FEDERAL LANDS HIGHWAY DIVISION

EROSION CONTROL PLAN
@ STA 1567+00 - 1589+00

Scale: 1"=80' Date: August 21, 2015
 SHEET No. 2 OF 16

M:\Mproj\Lenzie\Saddle East 11-6\sheet\shfr002.dgn

STATE	SADDLE ROAD PROJECT	SHEET NO.	TOTAL SHEETS
HI	HI SR 200(3)	F3	F20

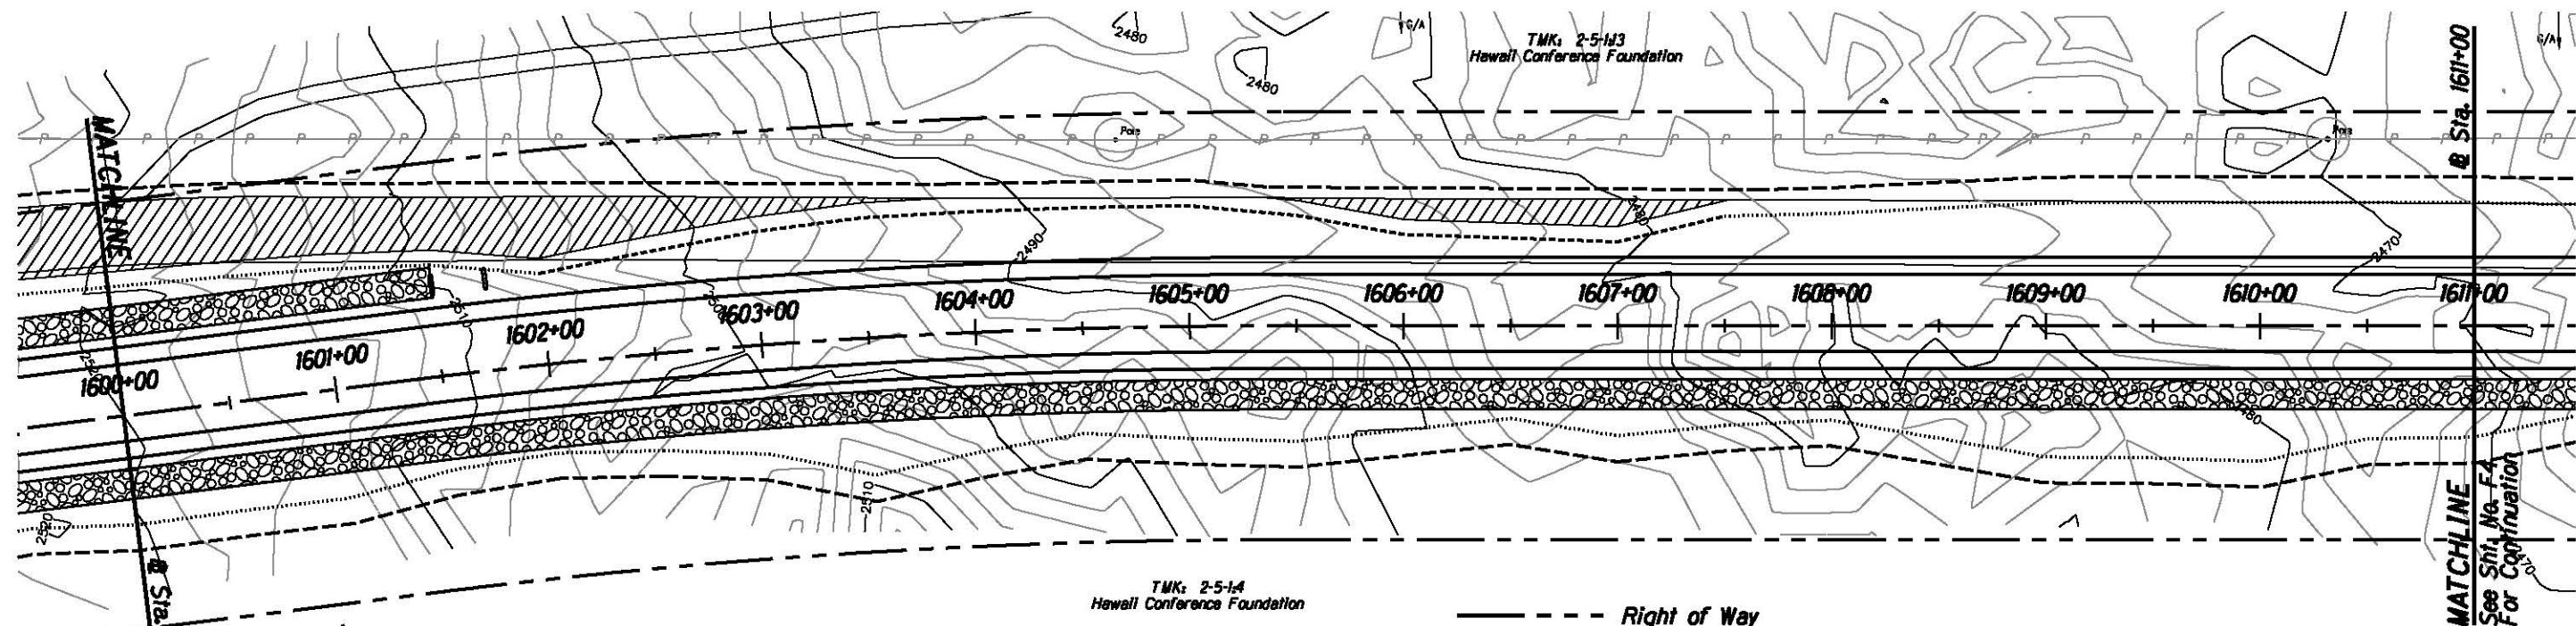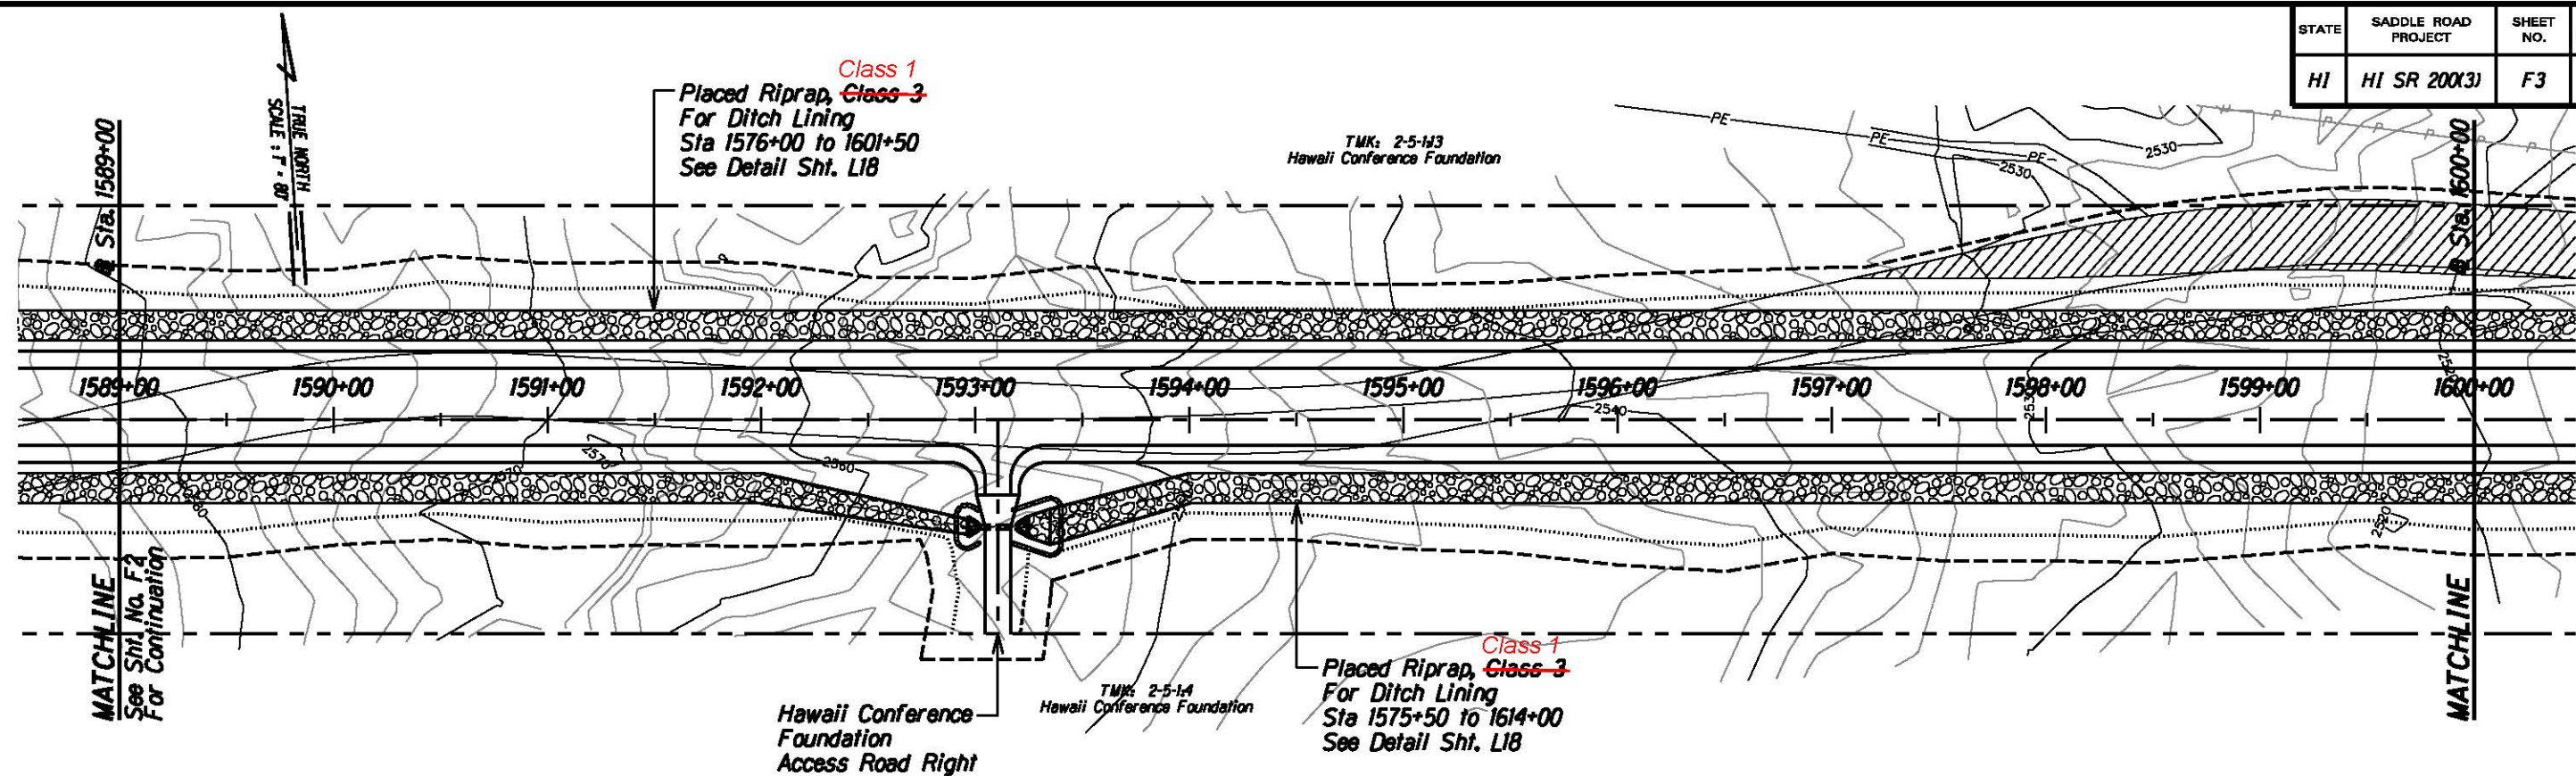

- Mortared Riprap
- Roadway Obliteration
- Placed Riprap, ~~Class 3~~ ^{Class 1}
- ~~Roller Erosion Control Product, Type 3B~~ ^{Mulch}

- Right of Way
- Construction Fence
- Construction Limits
- Sediment Control Logs
- Silt Fence
- Toe of Fill Slope
- Top of Cut Slope

BRUCE E. MEYERS
Licensed Professional Engineer
No. 8336-C
HAWAII, U.S.A.

The work was prepared by me or under my supervision and construction of this project will be under my observation.

Bruce Meyers
Expiration Date of License 2018.

U.S. DEPARTMENT OF TRANSPORTATION
FEDERAL HIGHWAY ADMINISTRATION
CENTRAL FEDERAL LANDS HIGHWAY DIVISION



EROSION CONTROL PLAN
@ STA 1589+00 - 1611+00

Scale: 1"=80' Date: August 21, 2015

SHEET No. 3 OF 16

M:\Mproj\Lenzie\Saddle East 11-6\sheet\shfr003.dgn

STATE	SADDLE ROAD PROJECT	SHEET NO.	TOTAL SHEETS
HI	HI SR 200(3)	F4	F20

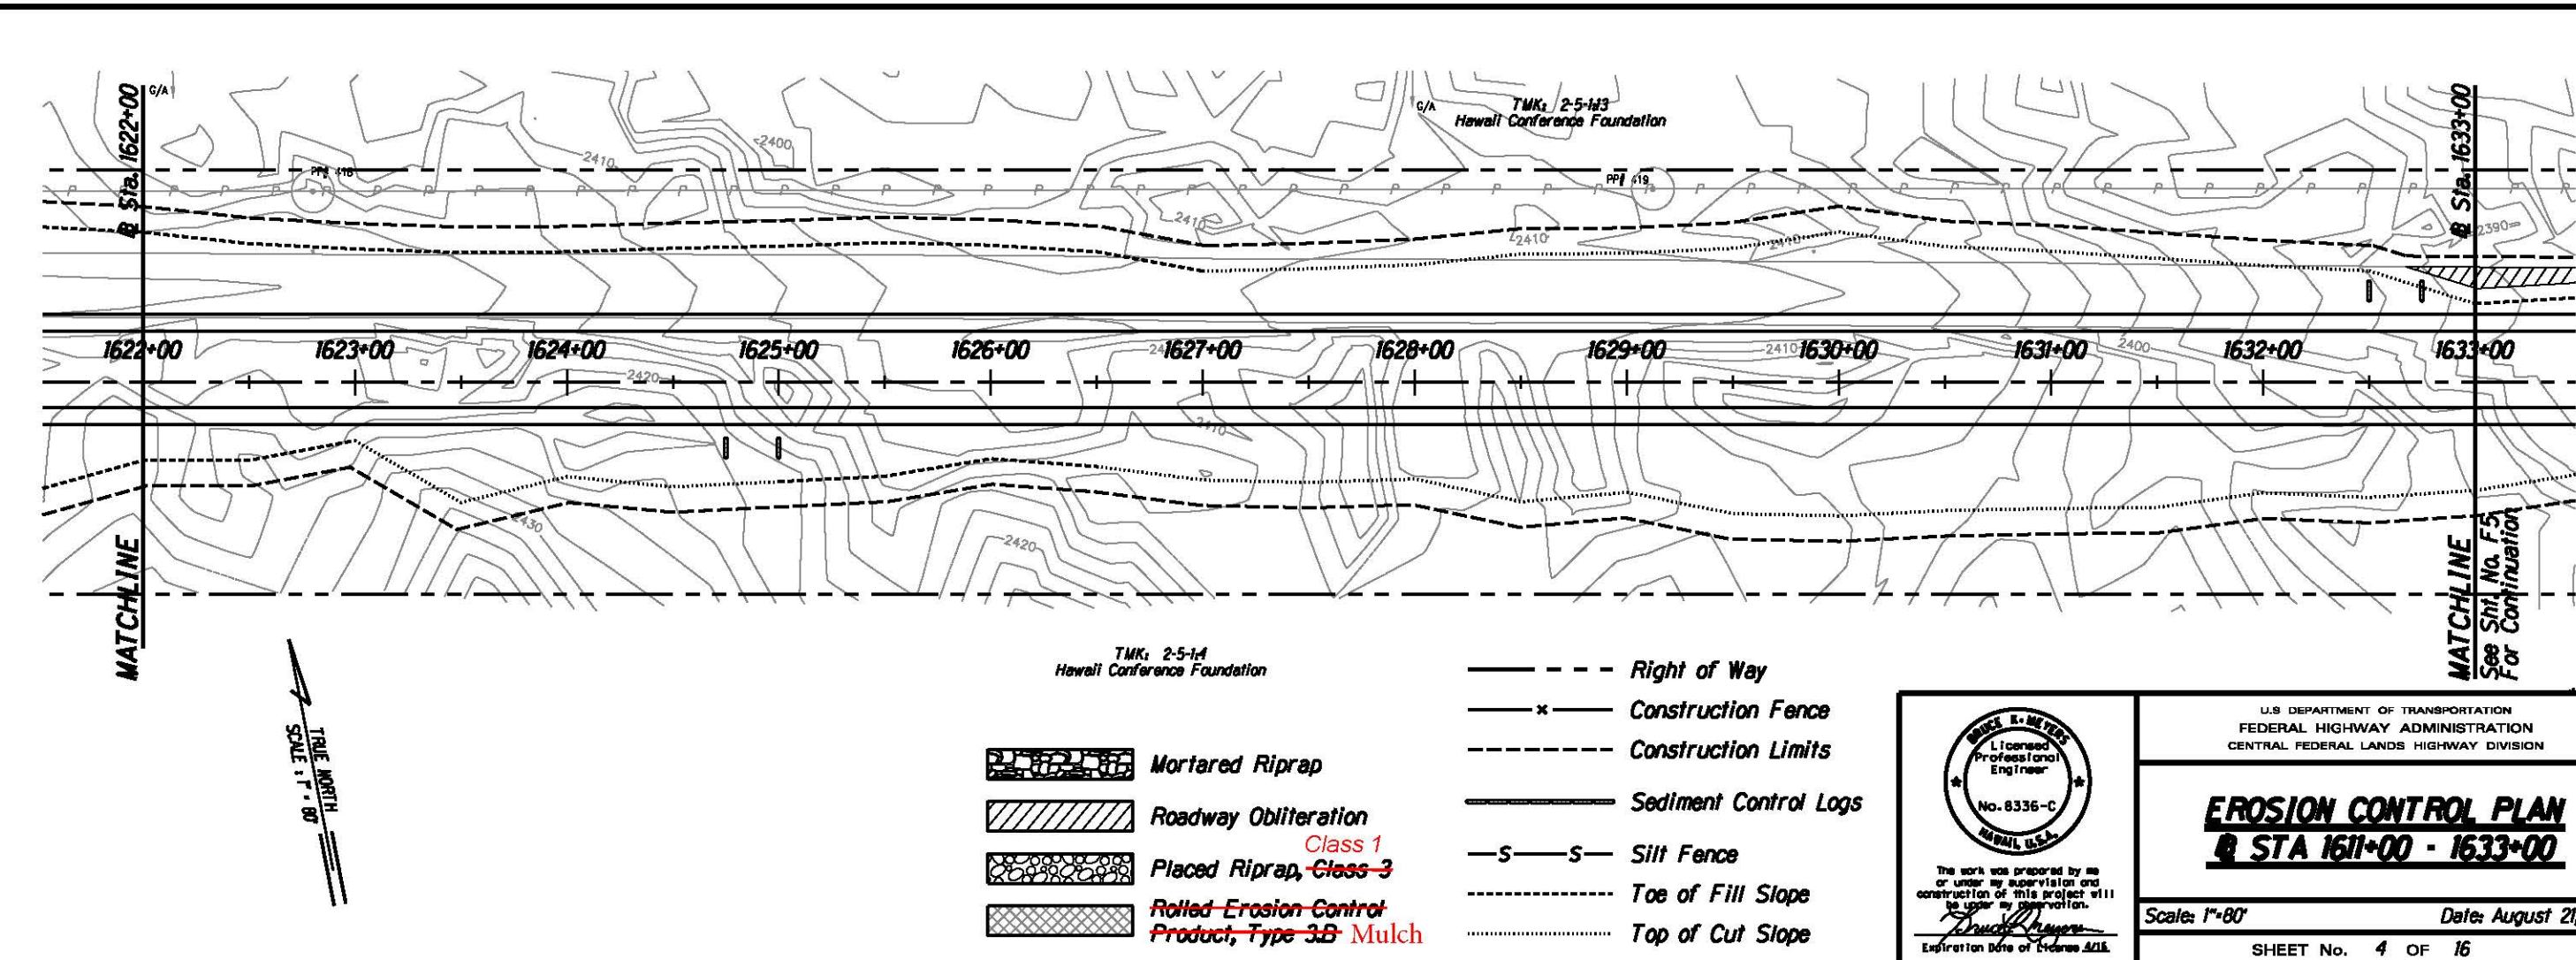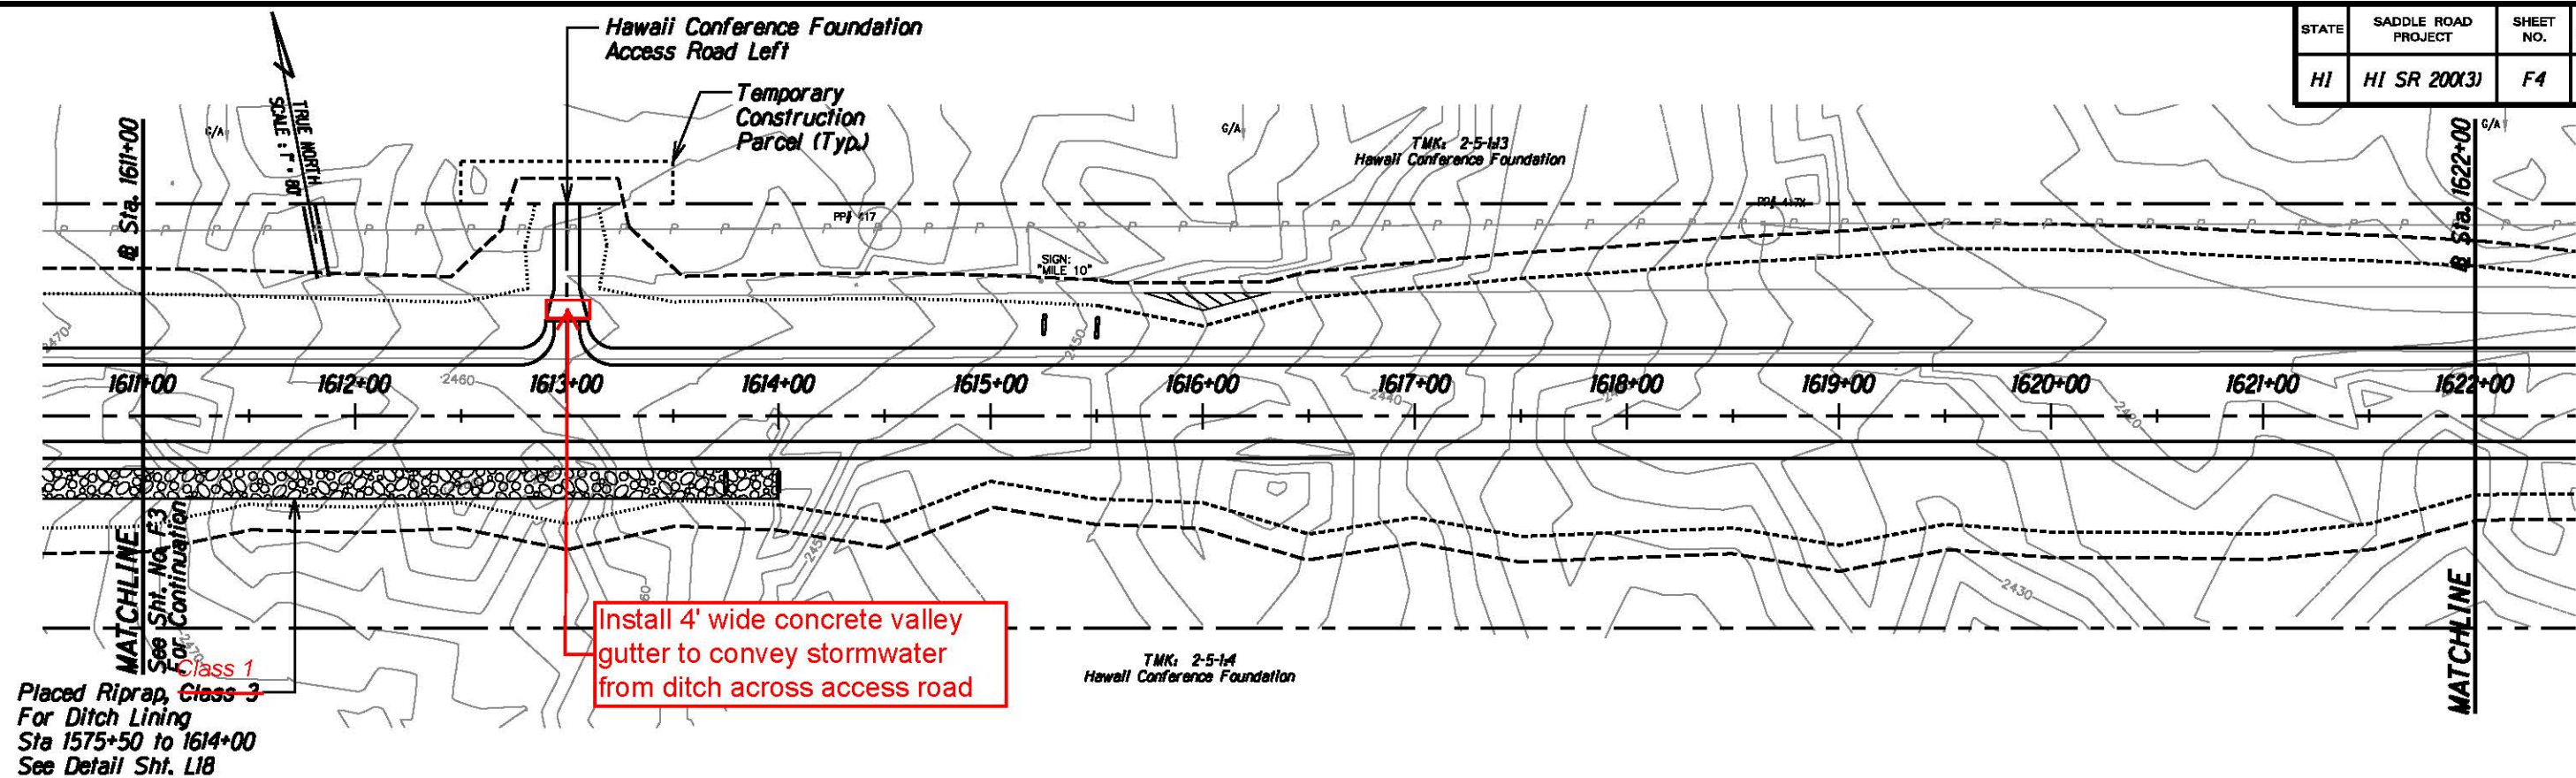



U.S. DEPARTMENT OF TRANSPORTATION
FEDERAL HIGHWAY ADMINISTRATION
CENTRAL FEDERAL LANDS HIGHWAY DIVISION

EROSION CONTROL PLAN
@ STA 1611+00 - 1633+00

Scale: 1"=80'
Date: August 21, 2015

SHEET No. 4 OF 16

STATE	SADDLE ROAD PROJECT	SHEET NO.	TOTAL SHEETS
HI	HI SR 200(3)	F5	F20

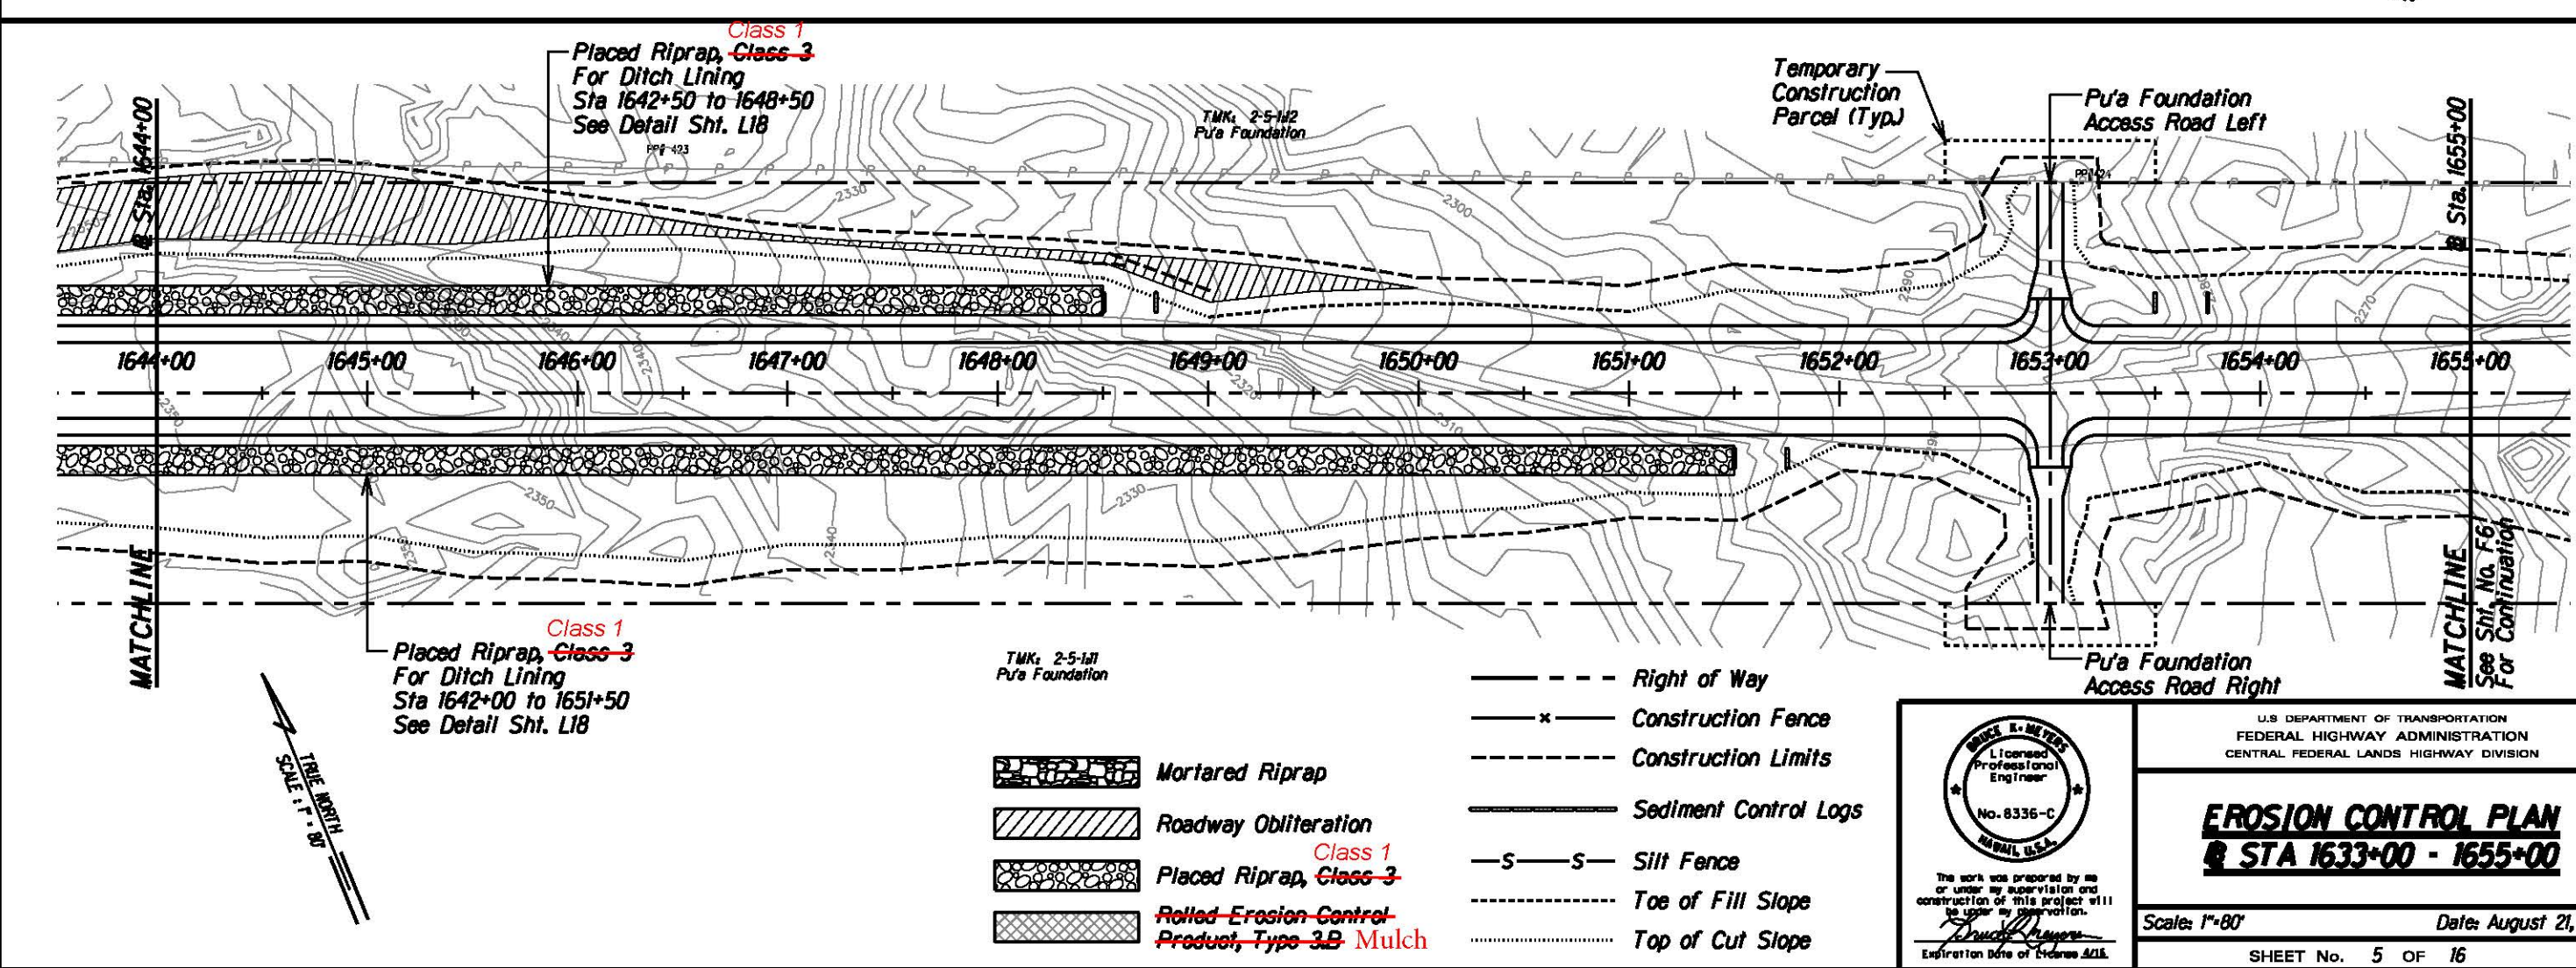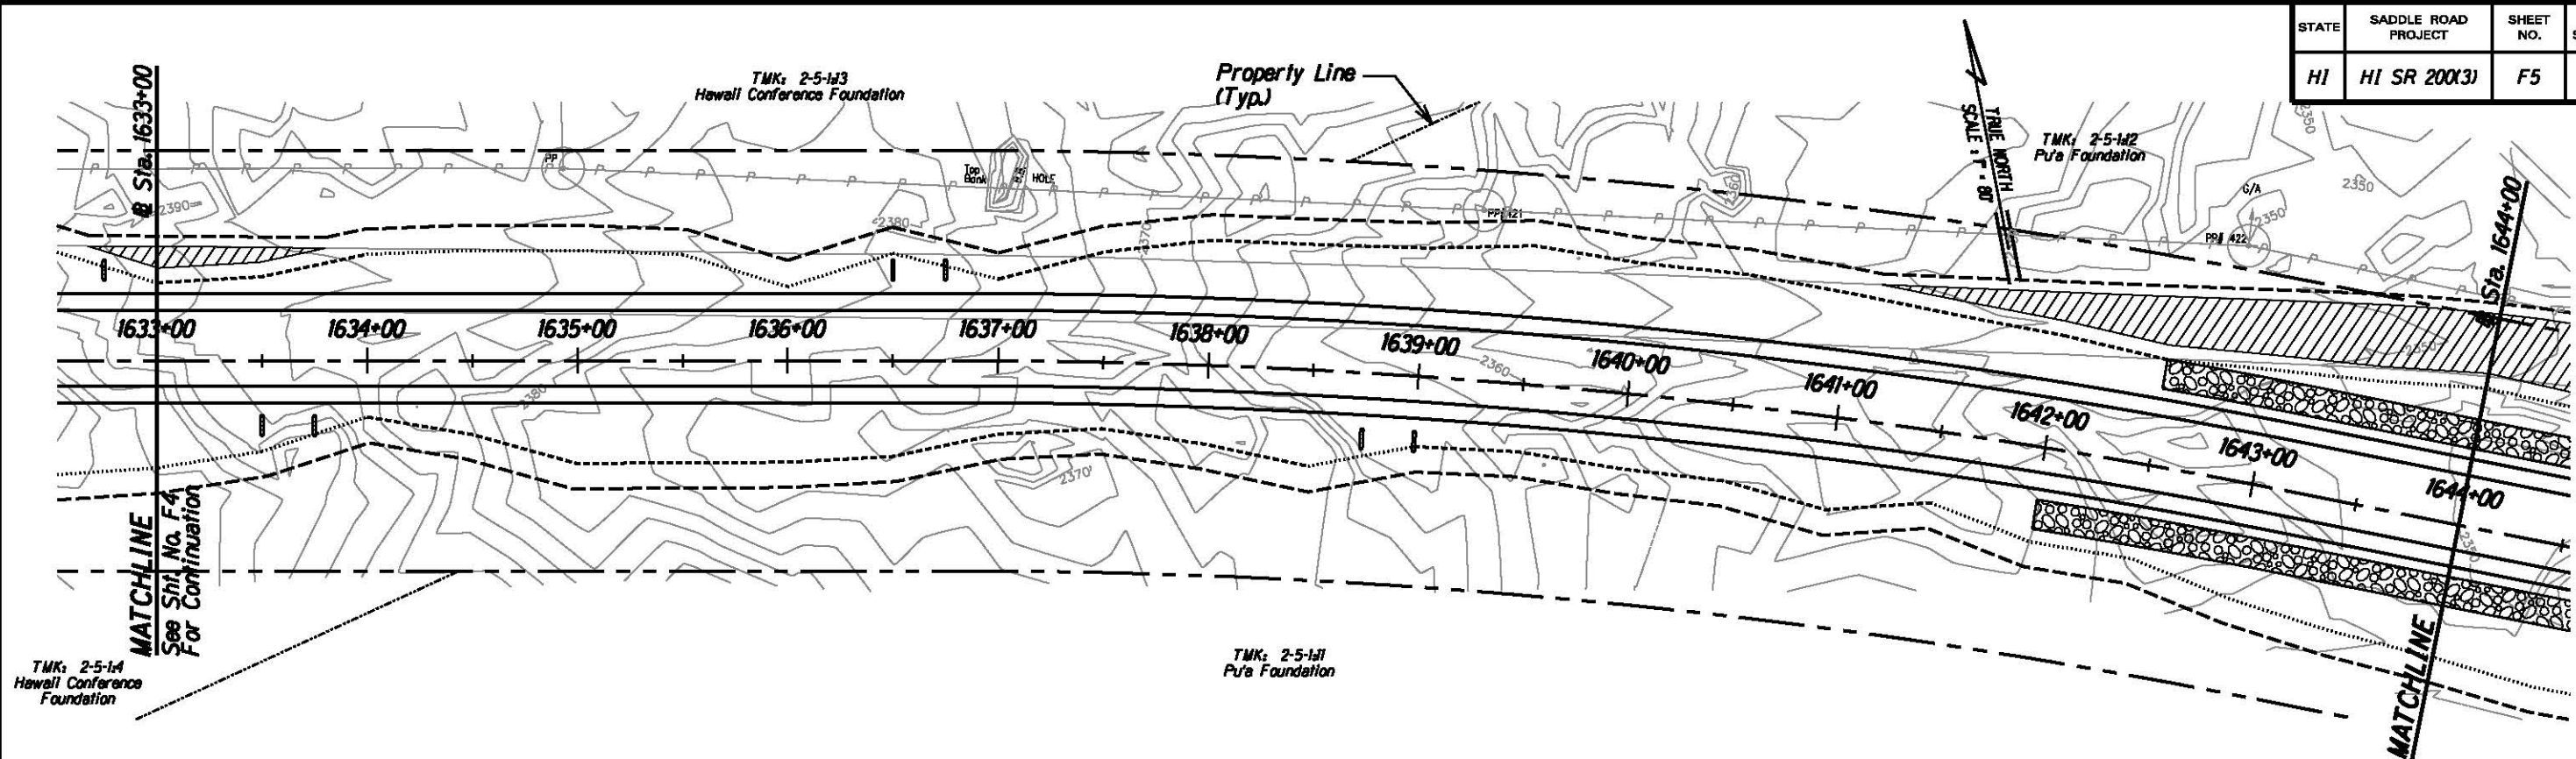

The work was prepared by me or under my supervision and construction of this project will be under my observation.
Bruce E. Meyers
 Expiration Date of License 2/15



U.S. DEPARTMENT OF TRANSPORTATION
 FEDERAL HIGHWAY ADMINISTRATION
 CENTRAL FEDERAL LANDS HIGHWAY DIVISION

EROSION CONTROL PLAN
@ STA 1633+00 - 1655+00

Scale: 1"=80' Date: August 21, 2015
 SHEET No. 5 OF 16

M:\Mproj\Lenzie\Saddle East 11-6\sheet\shft005.dgn

STATE	SADDLE ROAD PROJECT	SHEET NO.	TOTAL SHEETS
HI	HI SR 200(3)	F6	F20

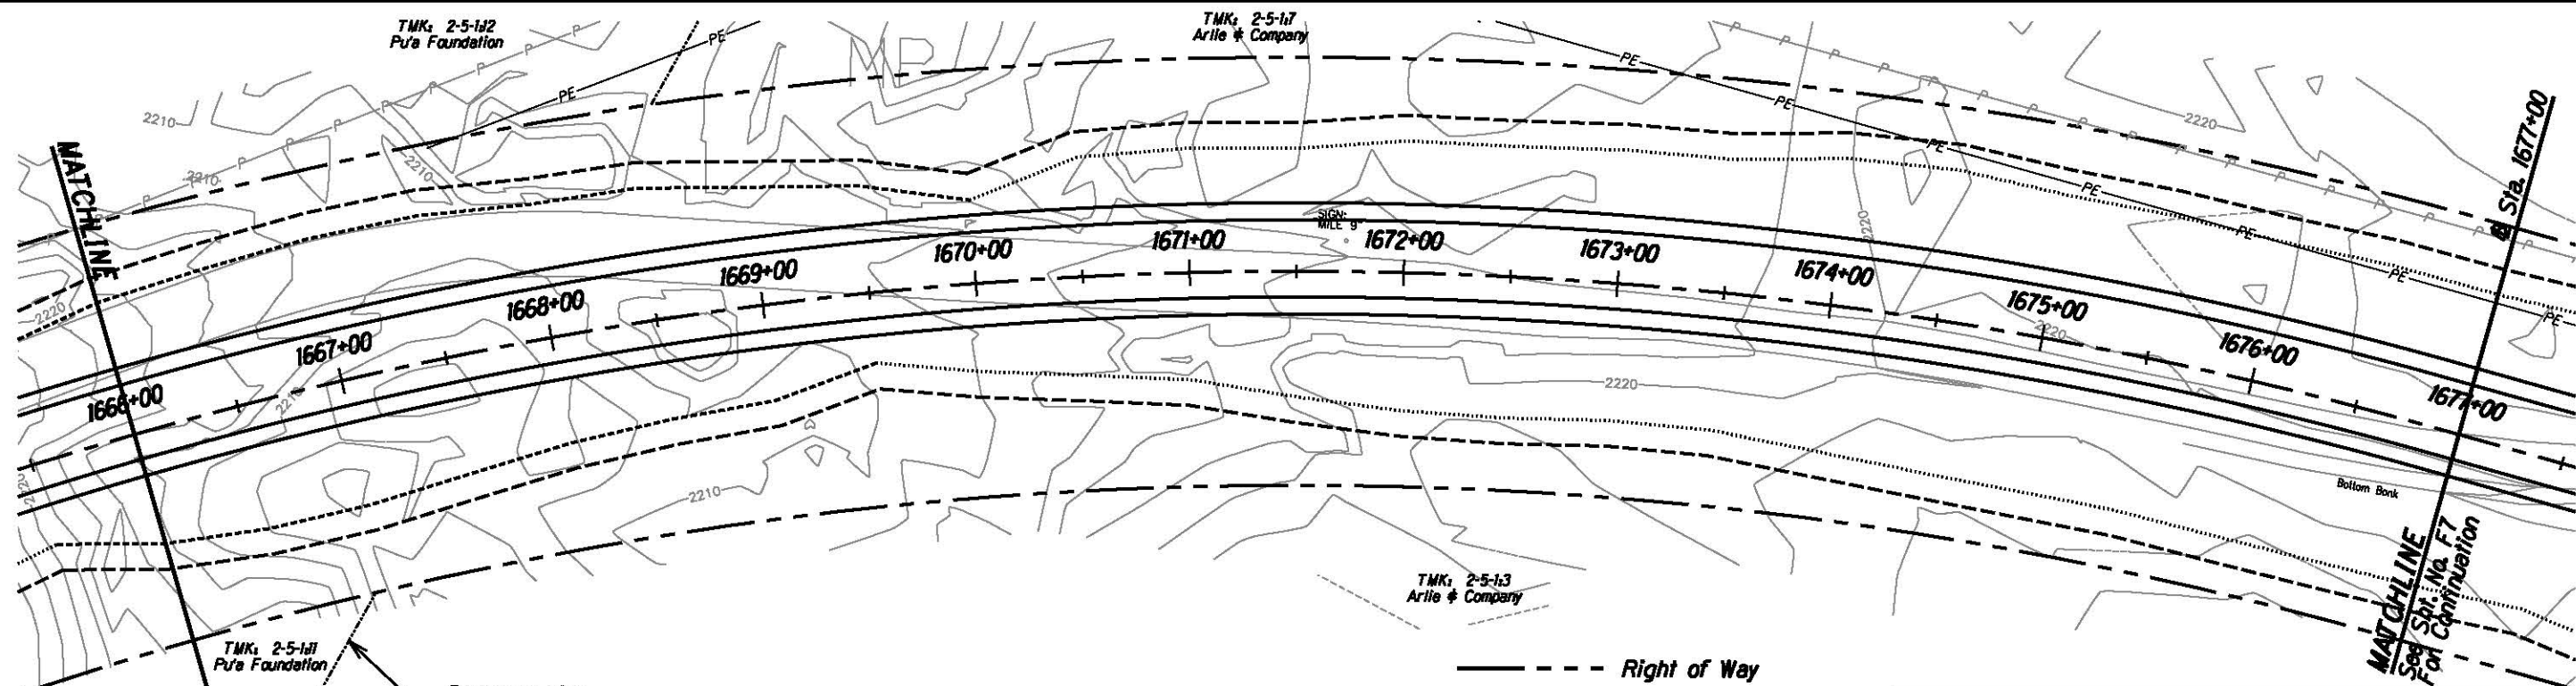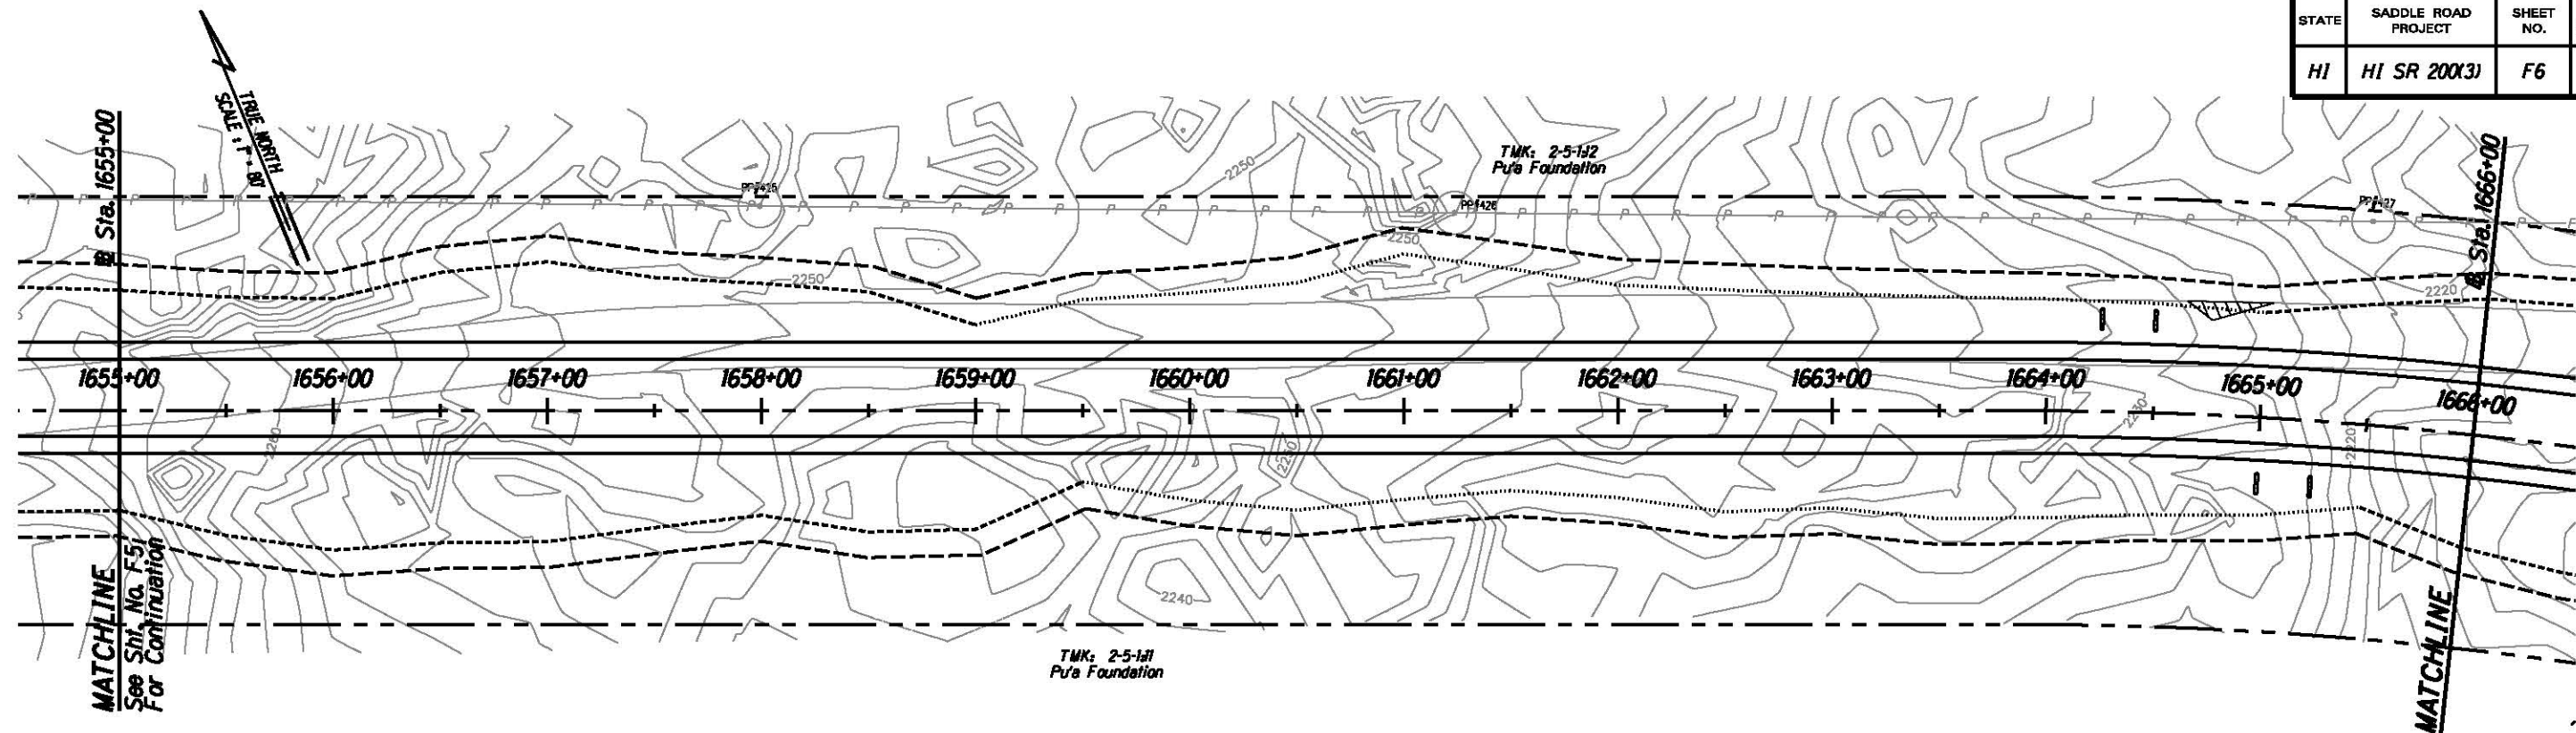

- Mortared Riprap
- Roadway Obliteration
- Placed Riprap, Class 3
- Rolled Erosion Control Product, Type 2B Mulch

- Right of Way
- Construction Fence
- Construction Limits
- Sediment Control Logs
- Silt Fence
- Toe of Fill Slope
- Top of Cut Slope

The work was prepared by me or under my supervision and construction of this project will be under my observation.

Bruce E. Meyers
Expiration Date of License 4/15

U.S. DEPARTMENT OF TRANSPORTATION
FEDERAL HIGHWAY ADMINISTRATION
CENTRAL FEDERAL LANDS HIGHWAY DIVISION



EROSION CONTROL PLAN
@ STA 1655+00 - 1677+00

Scale: 1"=80' Date: August 21, 2015

SHEET No. 6 OF 16



M:\Mproj\Lenzie\Saddle East 11-6\sheet\shfr006.dgn

STATE	SADDLE ROAD PROJECT	SHEET NO.	TOTAL SHEETS
HI	HI SR 200(3)	F7	F20

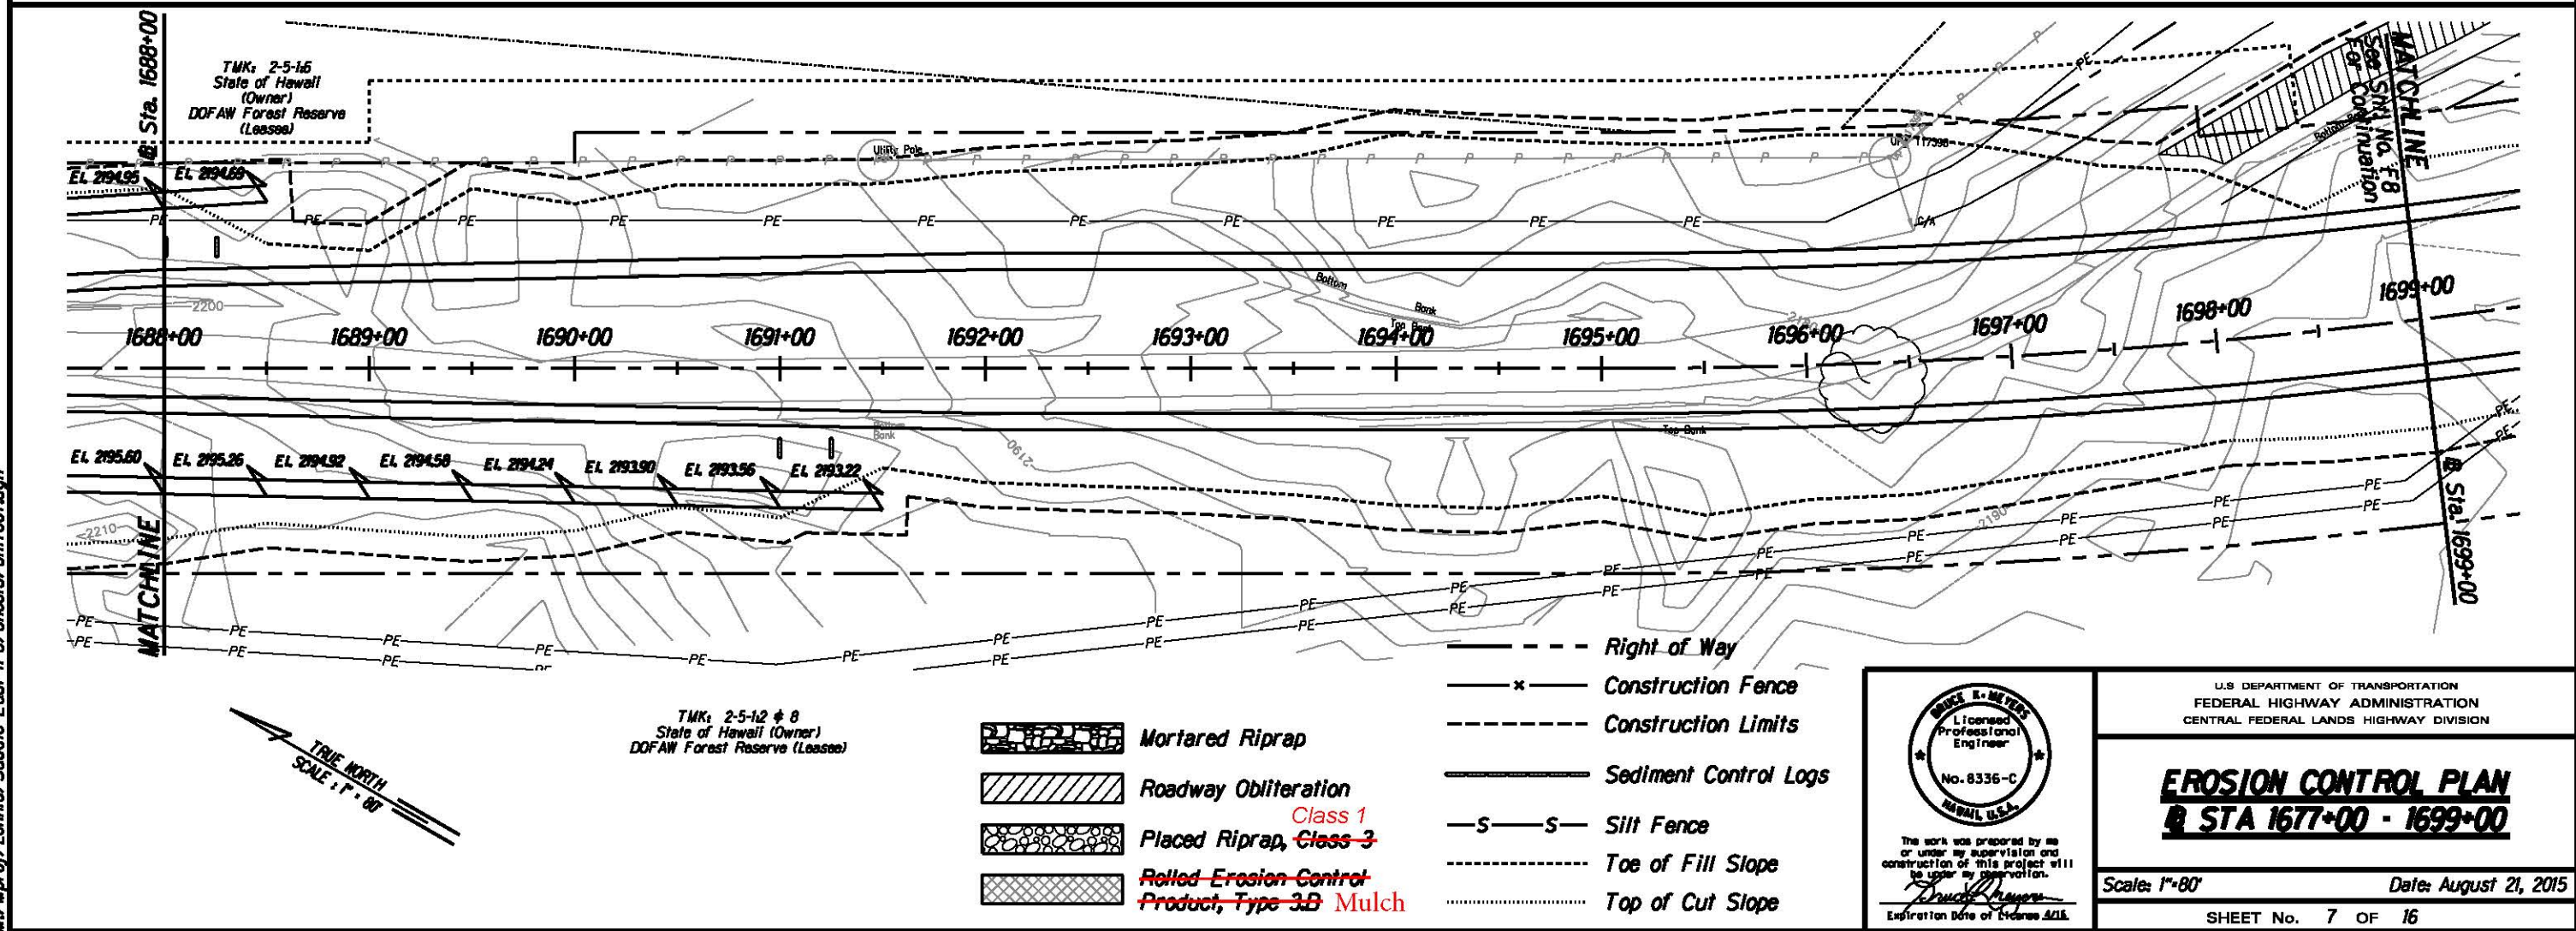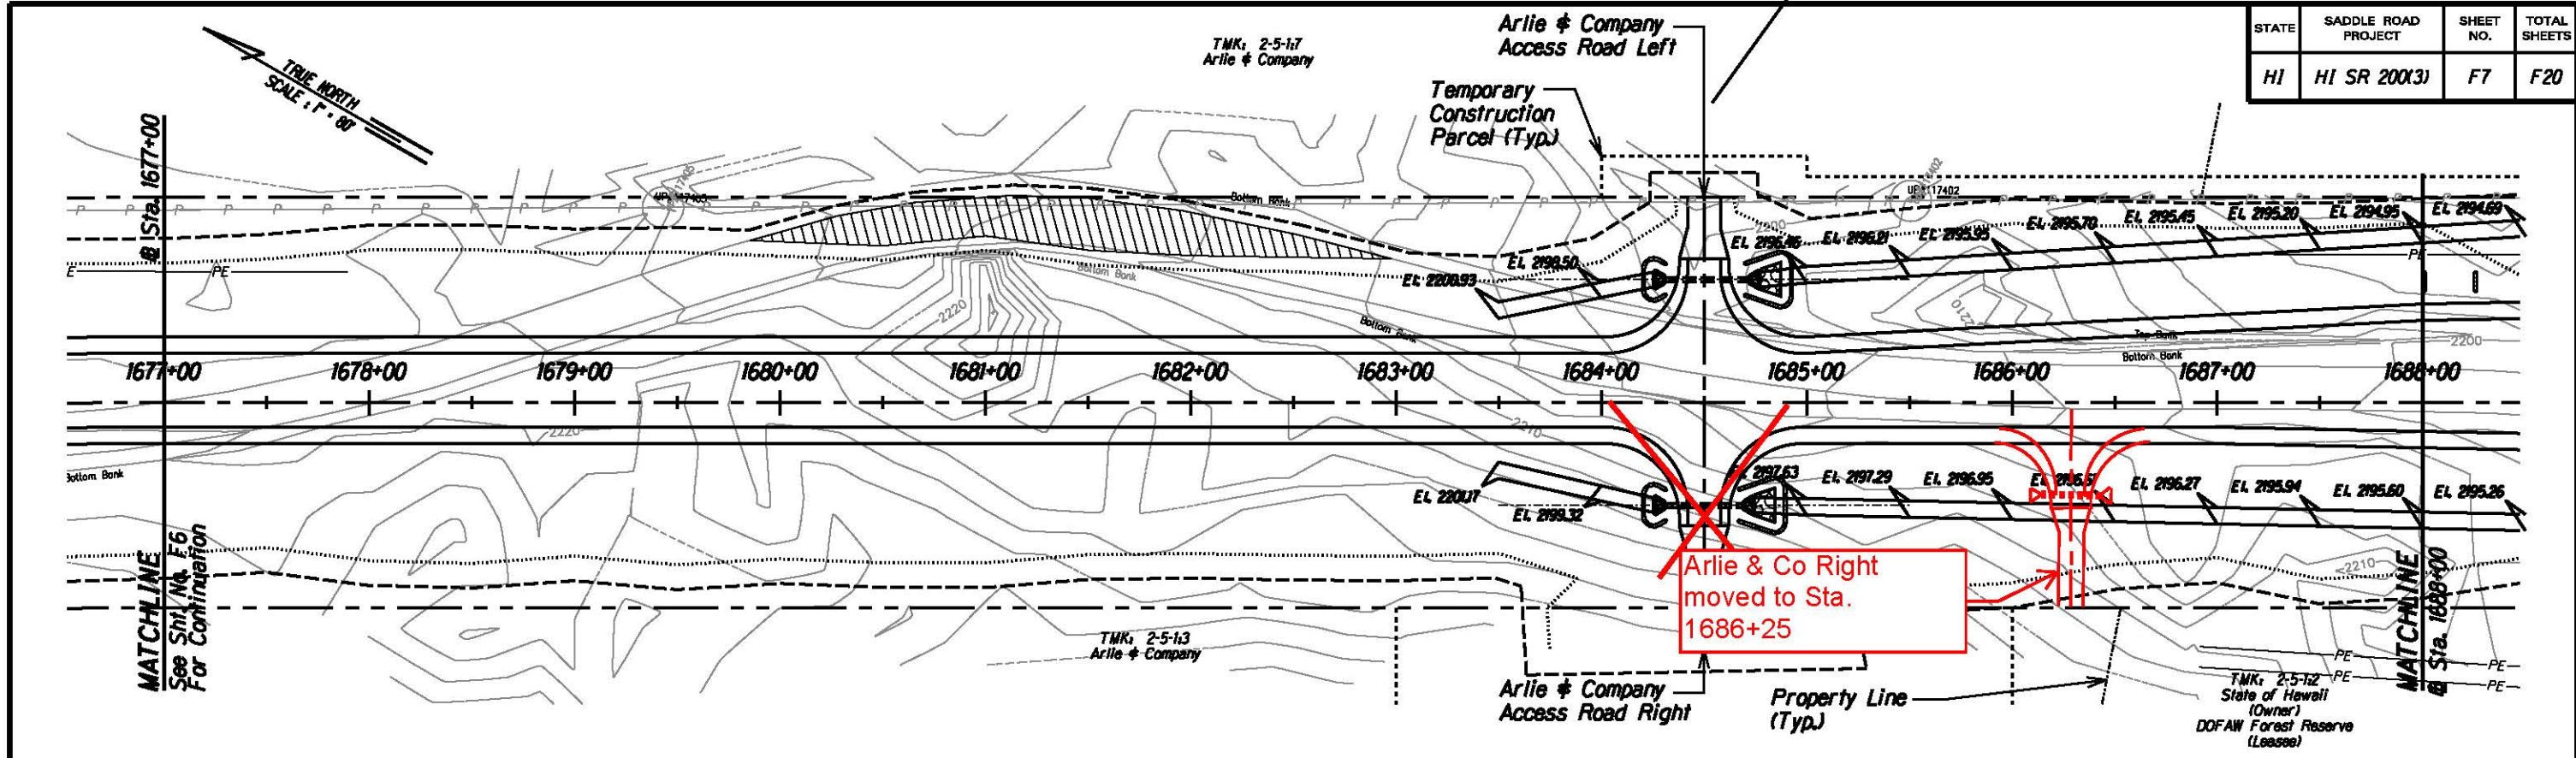



M:\Mproj\Lenzie\Saddle East 11-6\sheet\shfr007.dgn

STATE	SADDLE ROAD PROJECT	SHEET NO.	TOTAL SHEETS
HI	HI SR 200X3	F8	F20

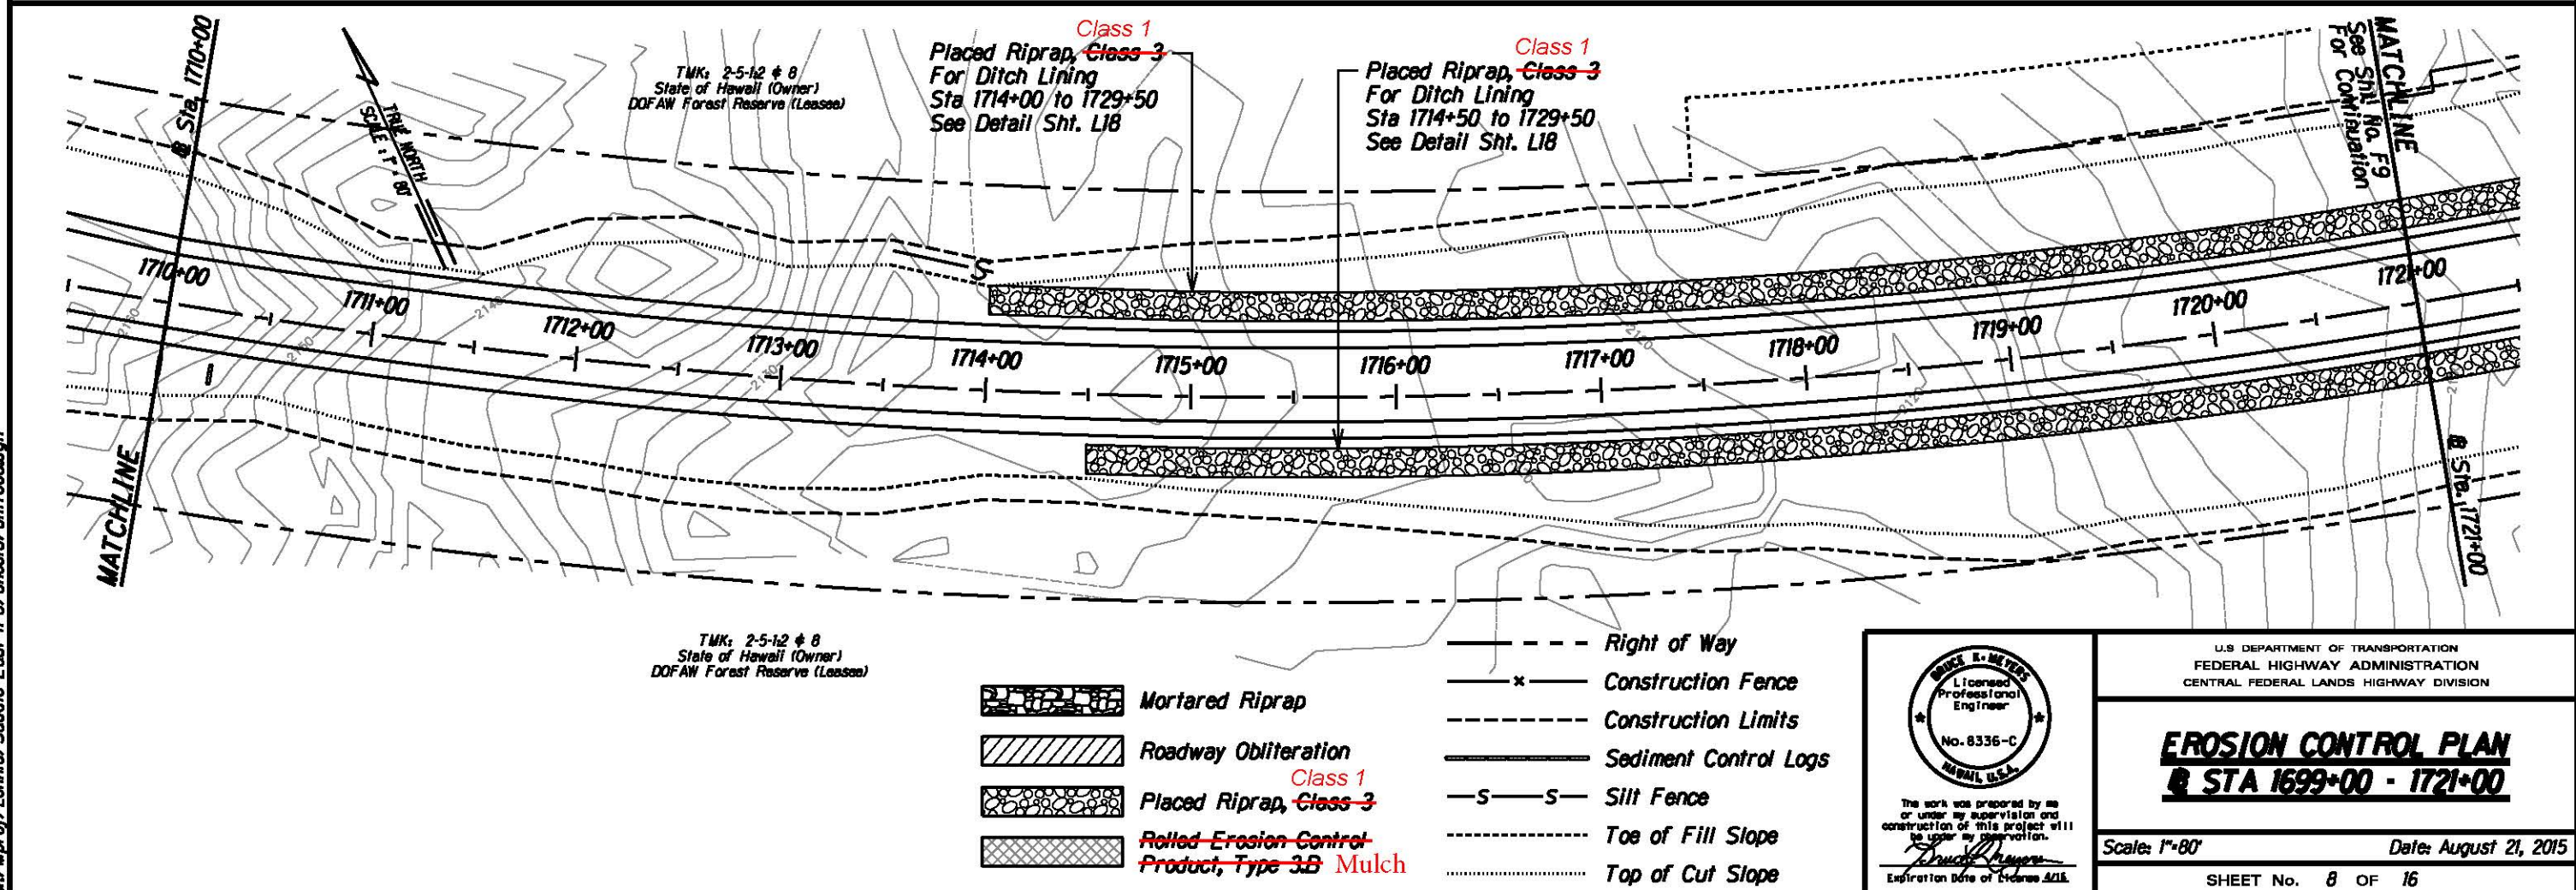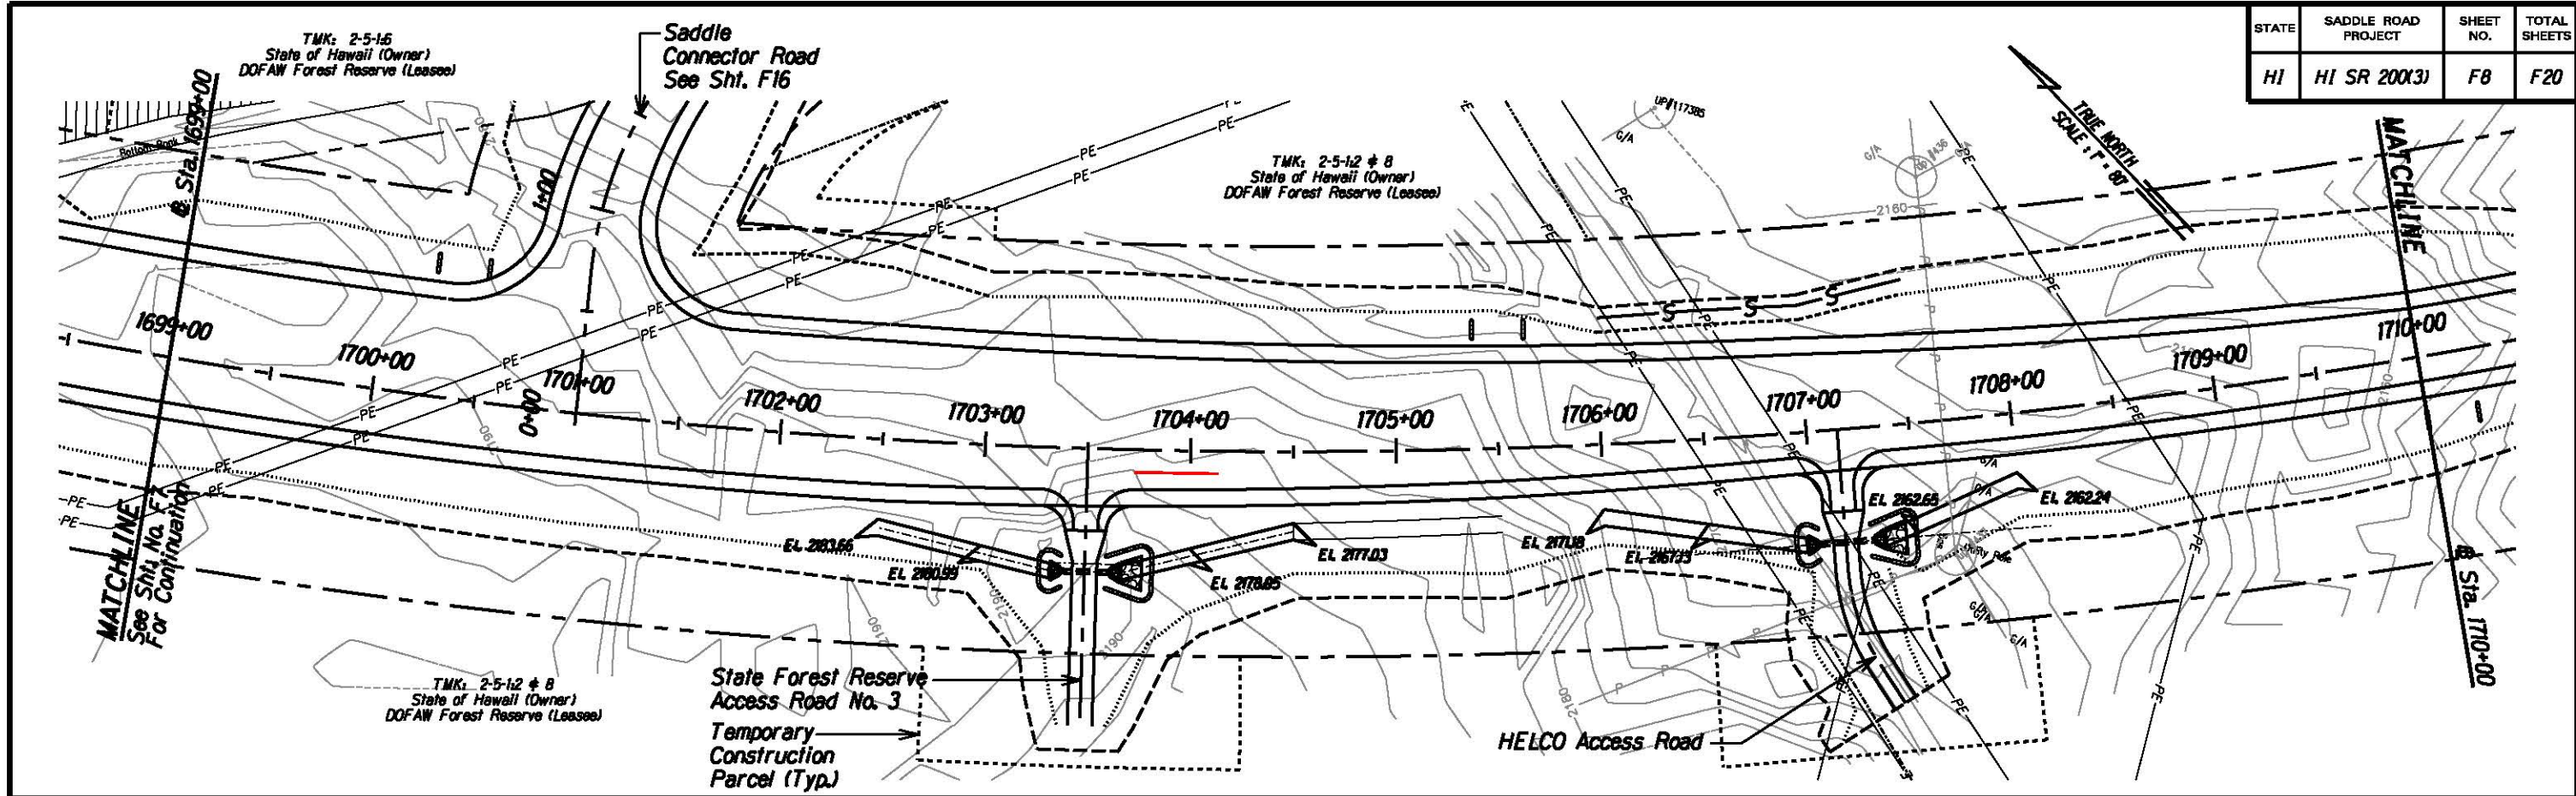

M:\Mproj\Lenzie\Saddle East 11-6\sheet\shtr008.dgn

STATE	SADDLE ROAD PROJECT	SHEET NO.	TOTAL SHEETS
HI	HI SR 200(3)	F10	F20

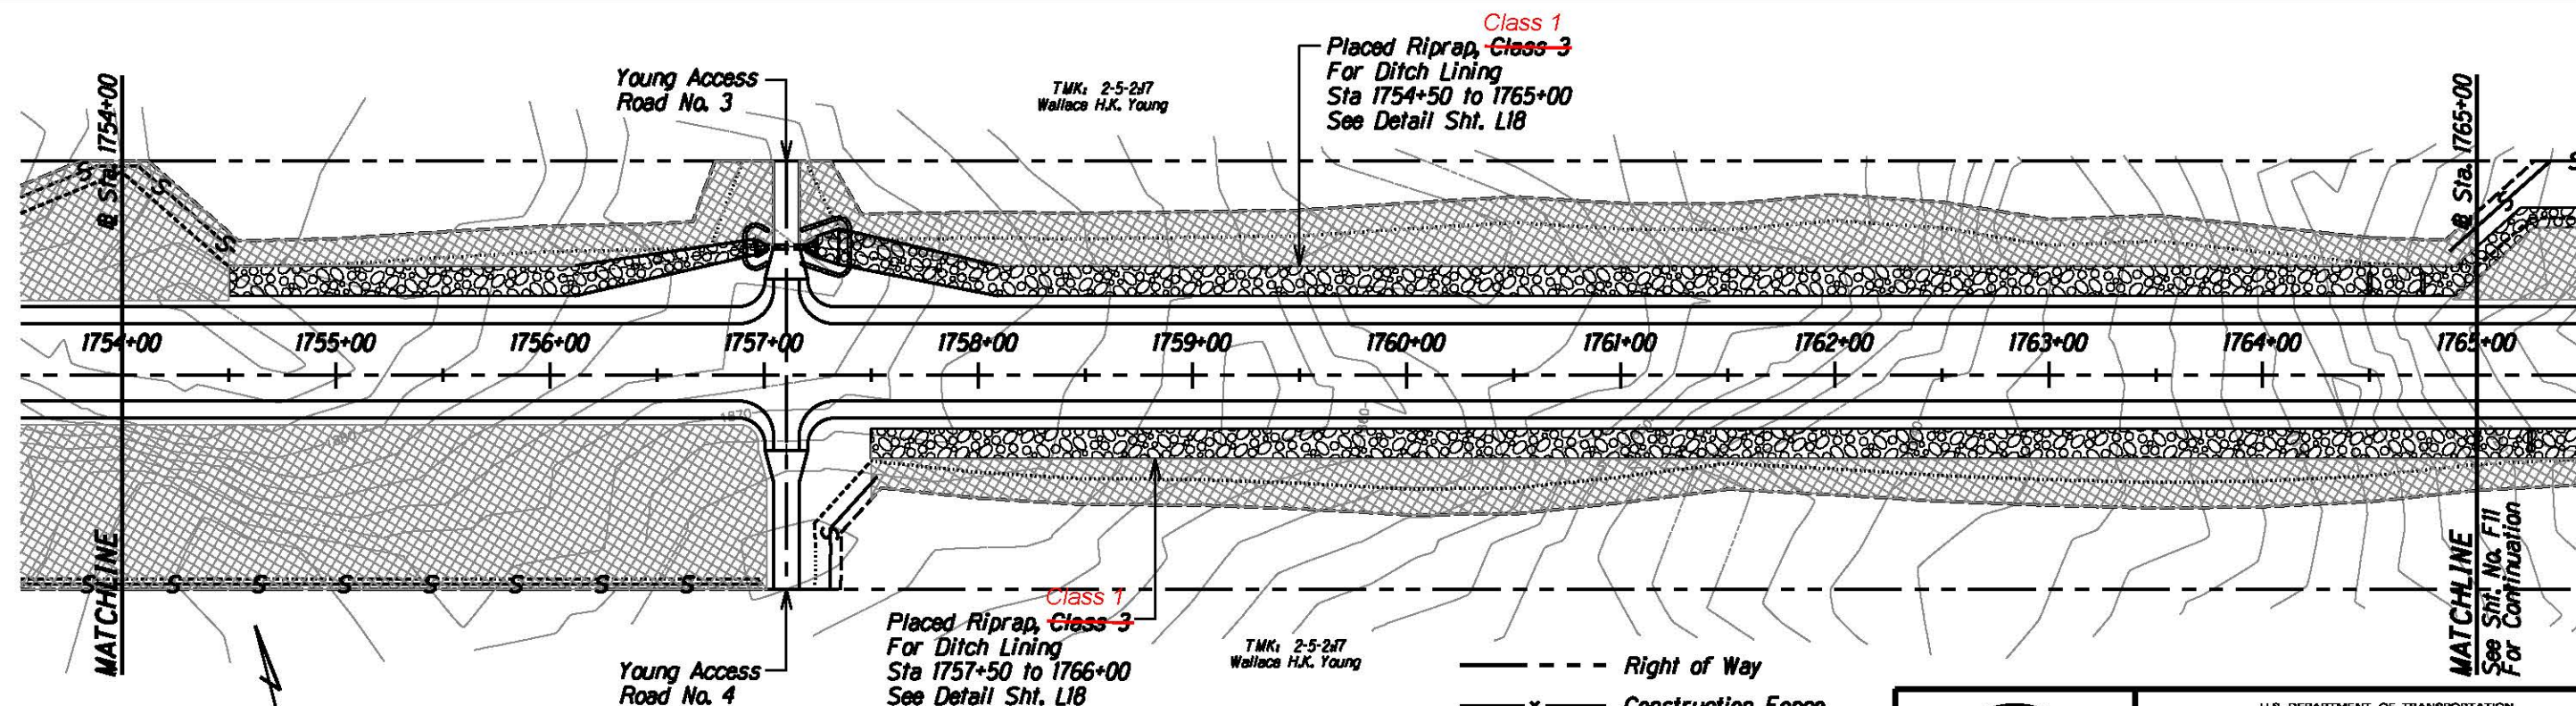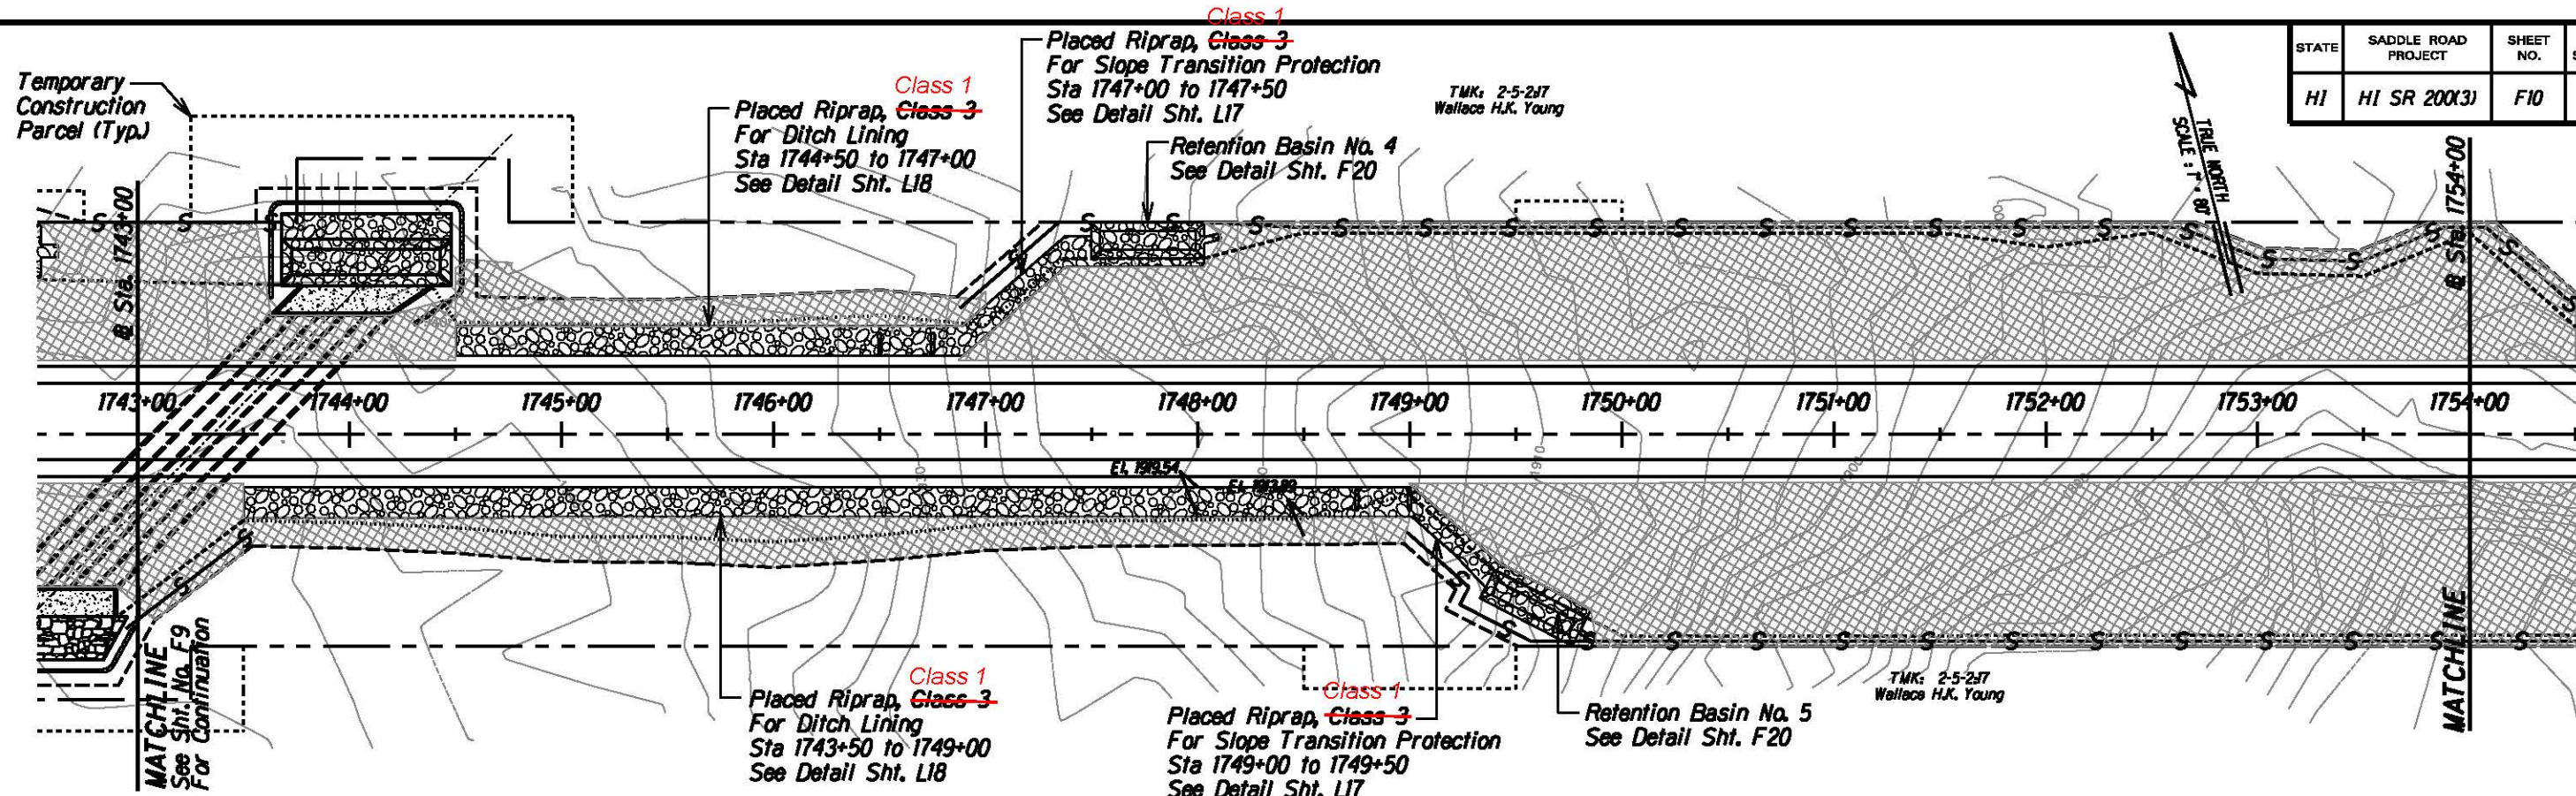

- Mortared Riprap
- Roadway Obliteration
- Placed Riprap, Class 3
- Rolled Erosion Control Product, Type 3B Mulch

- Right of Way
- Construction Fence
- Construction Limits
- Sediment Control Logs
- Silt Fence
- Toe of Fill Slope
- Top of Cut Slope



The work was prepared by me or under my supervision and construction of this project will be under my observation.

Bruce E. Meyers

Expiration Date of License 2018.

U.S. DEPARTMENT OF TRANSPORTATION
FEDERAL HIGHWAY ADMINISTRATION
CENTRAL FEDERAL LANDS HIGHWAY DIVISION

EROSION CONTROL PLAN @ STA 1743+00 - 1765+00



Scale: 1"=80'

Date: August 21, 2015

SHEET No. 10 OF 16


F10

STATE	SADDLE ROAD PROJECT	SHEET NO.	TOTAL SHEETS
HI	HI SR 200(3)	F11	F20

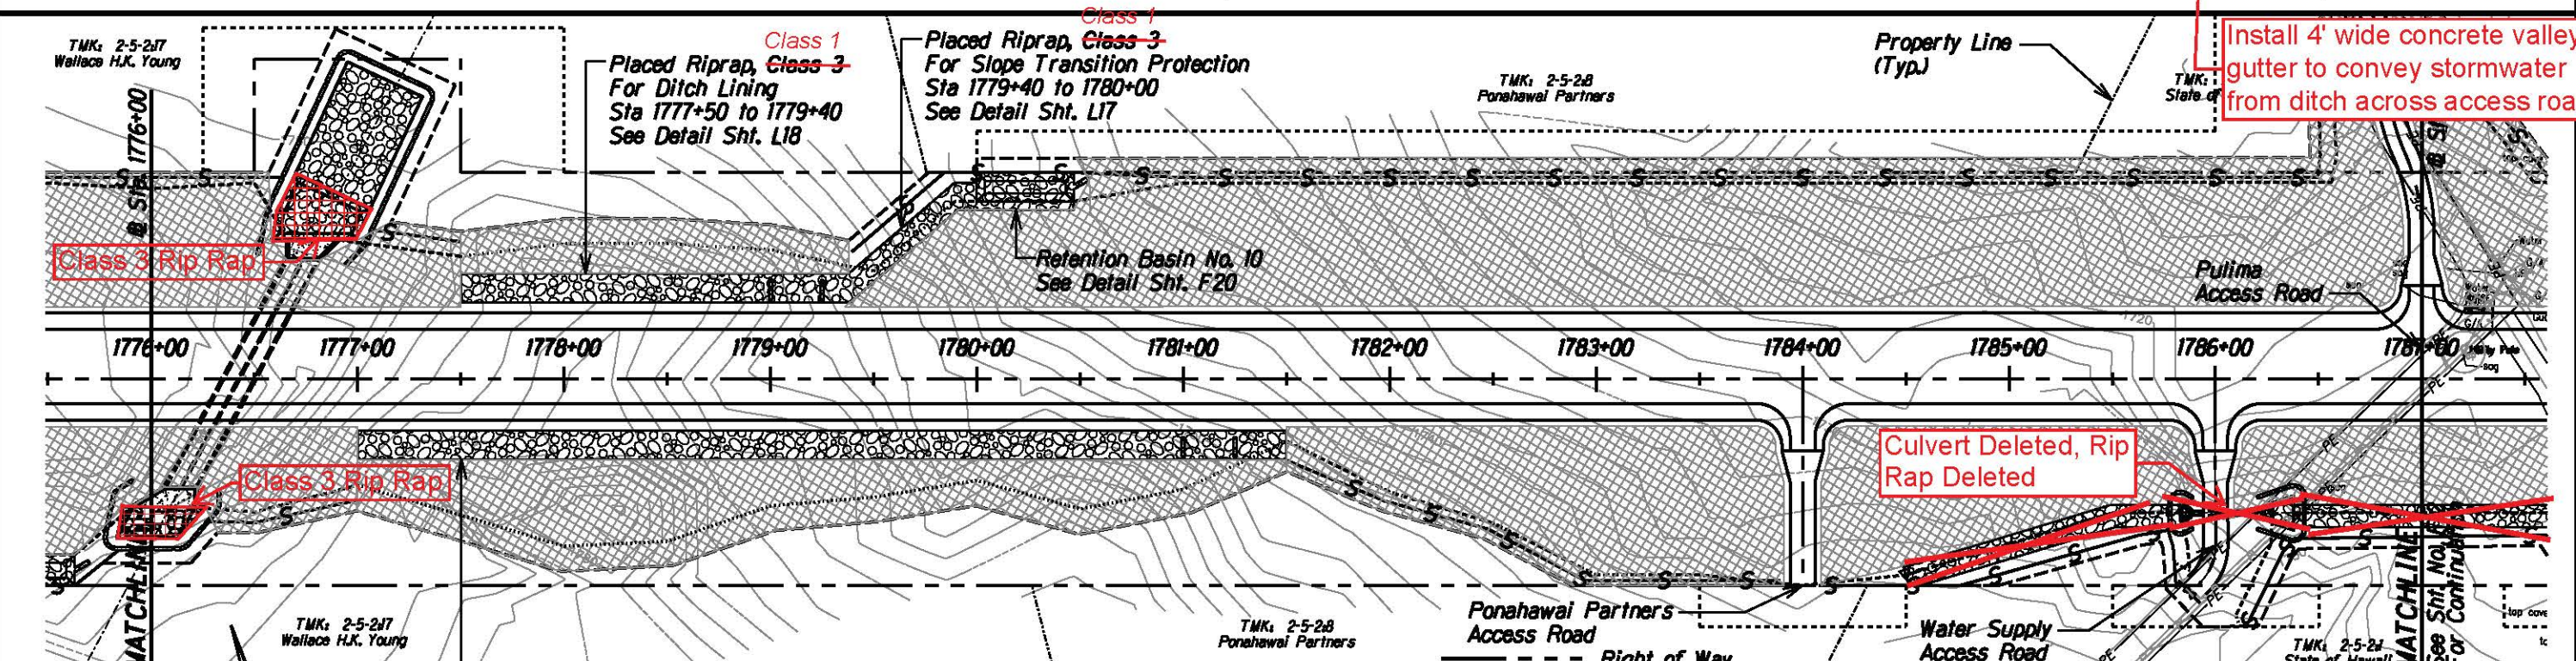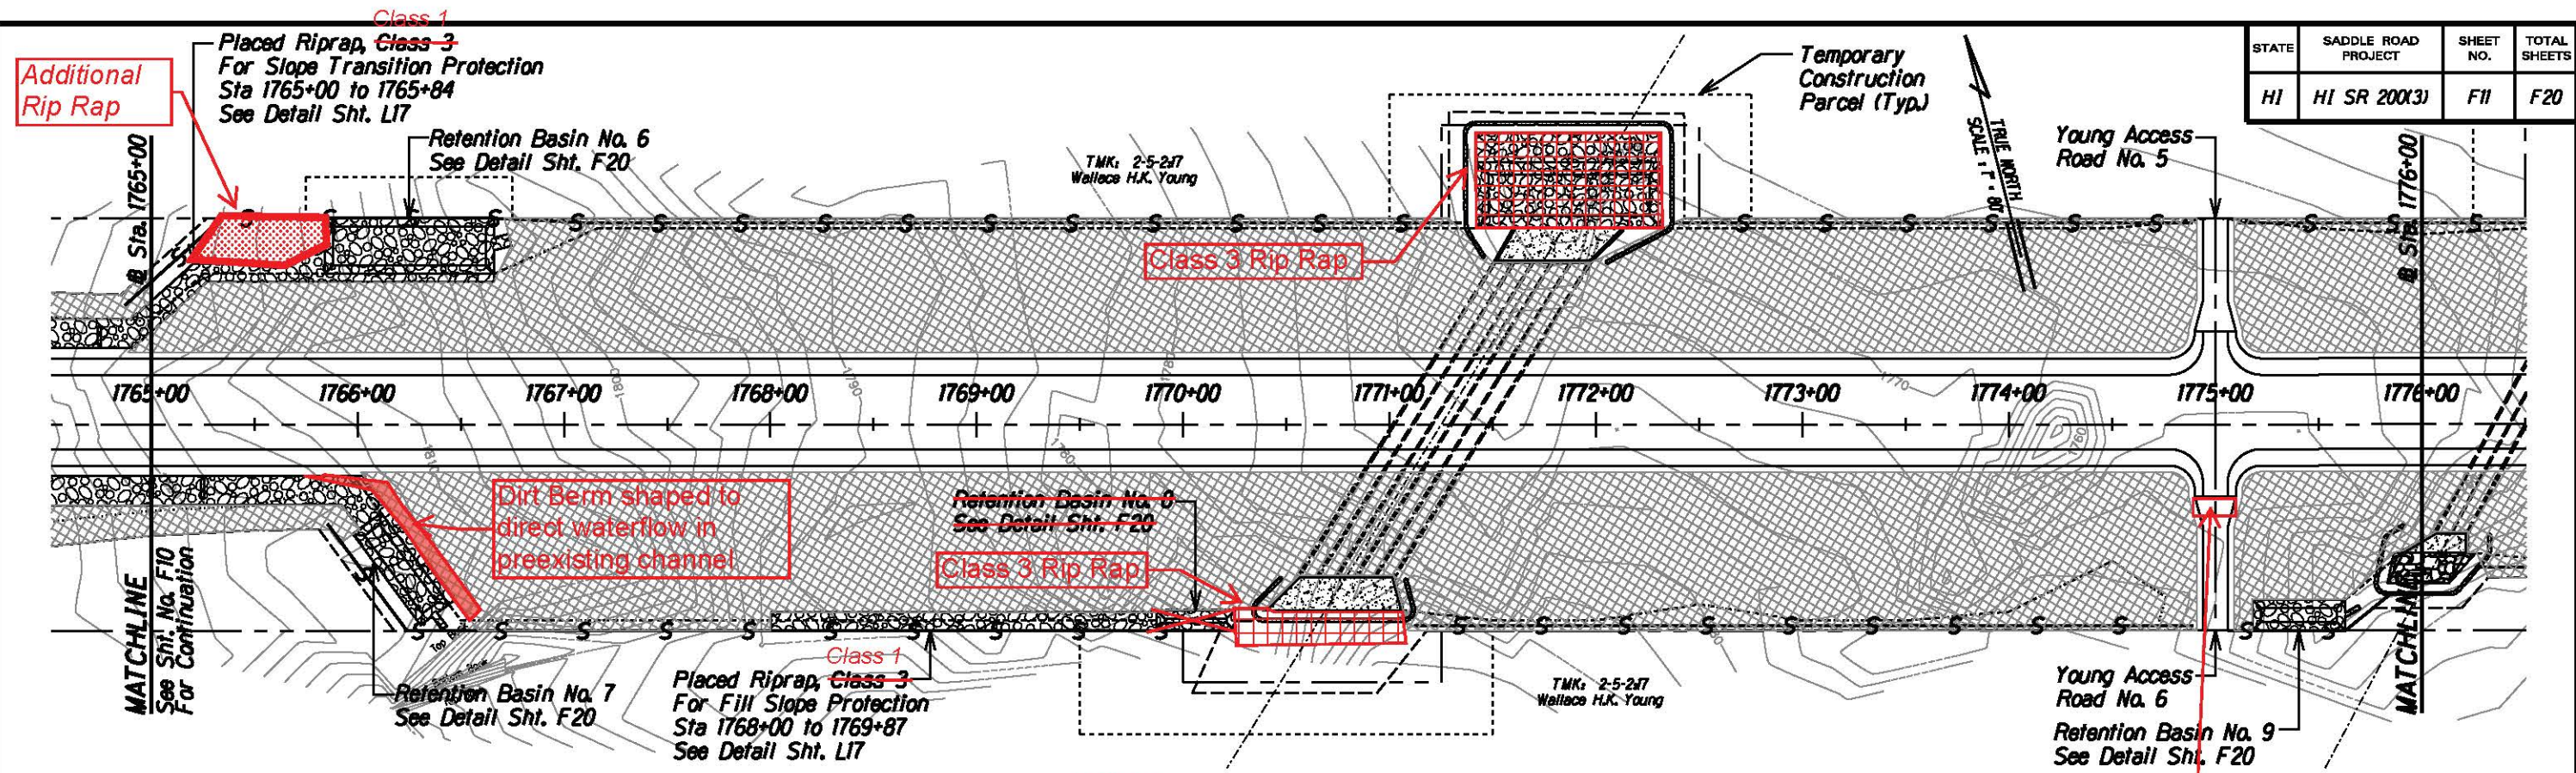

- Mortared Riprap
- Roadway Obliteration
- Placed Riprap, Class 1
- Placed Riprap, Class 3
- Rolled Erosion Control Product, Type 3A Mulch

- Right of Way
- Construction Fence
- Construction Limits
- Sediment Control Logs
- Silt Fence
- Toe of Fill Slope
- Top of Cut Slope

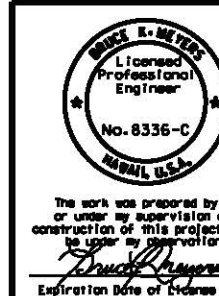

The work was prepared by me or under my supervision and construction of this project will be under my observation.
 Bruce E. Meyers
 Expiration Date of License 2018.

U.S. DEPARTMENT OF TRANSPORTATION
 FEDERAL HIGHWAY ADMINISTRATION
 CENTRAL FEDERAL LANDS HIGHWAY DIVISION



EROSION CONTROL PLAN
@ STA 1765+00 - 1787+00

Scale: 1"=80' Date: August 21, 2015



SHEET No. 11 OF 16

M:\Mproj\Lenzie\Saddle East 11-6\sheet\shf011.dgn

STATE	SADDLE ROAD PROJECT	SHEET NO.	TOTAL SHEETS
HI	HI SR 200(3)	F12	F20

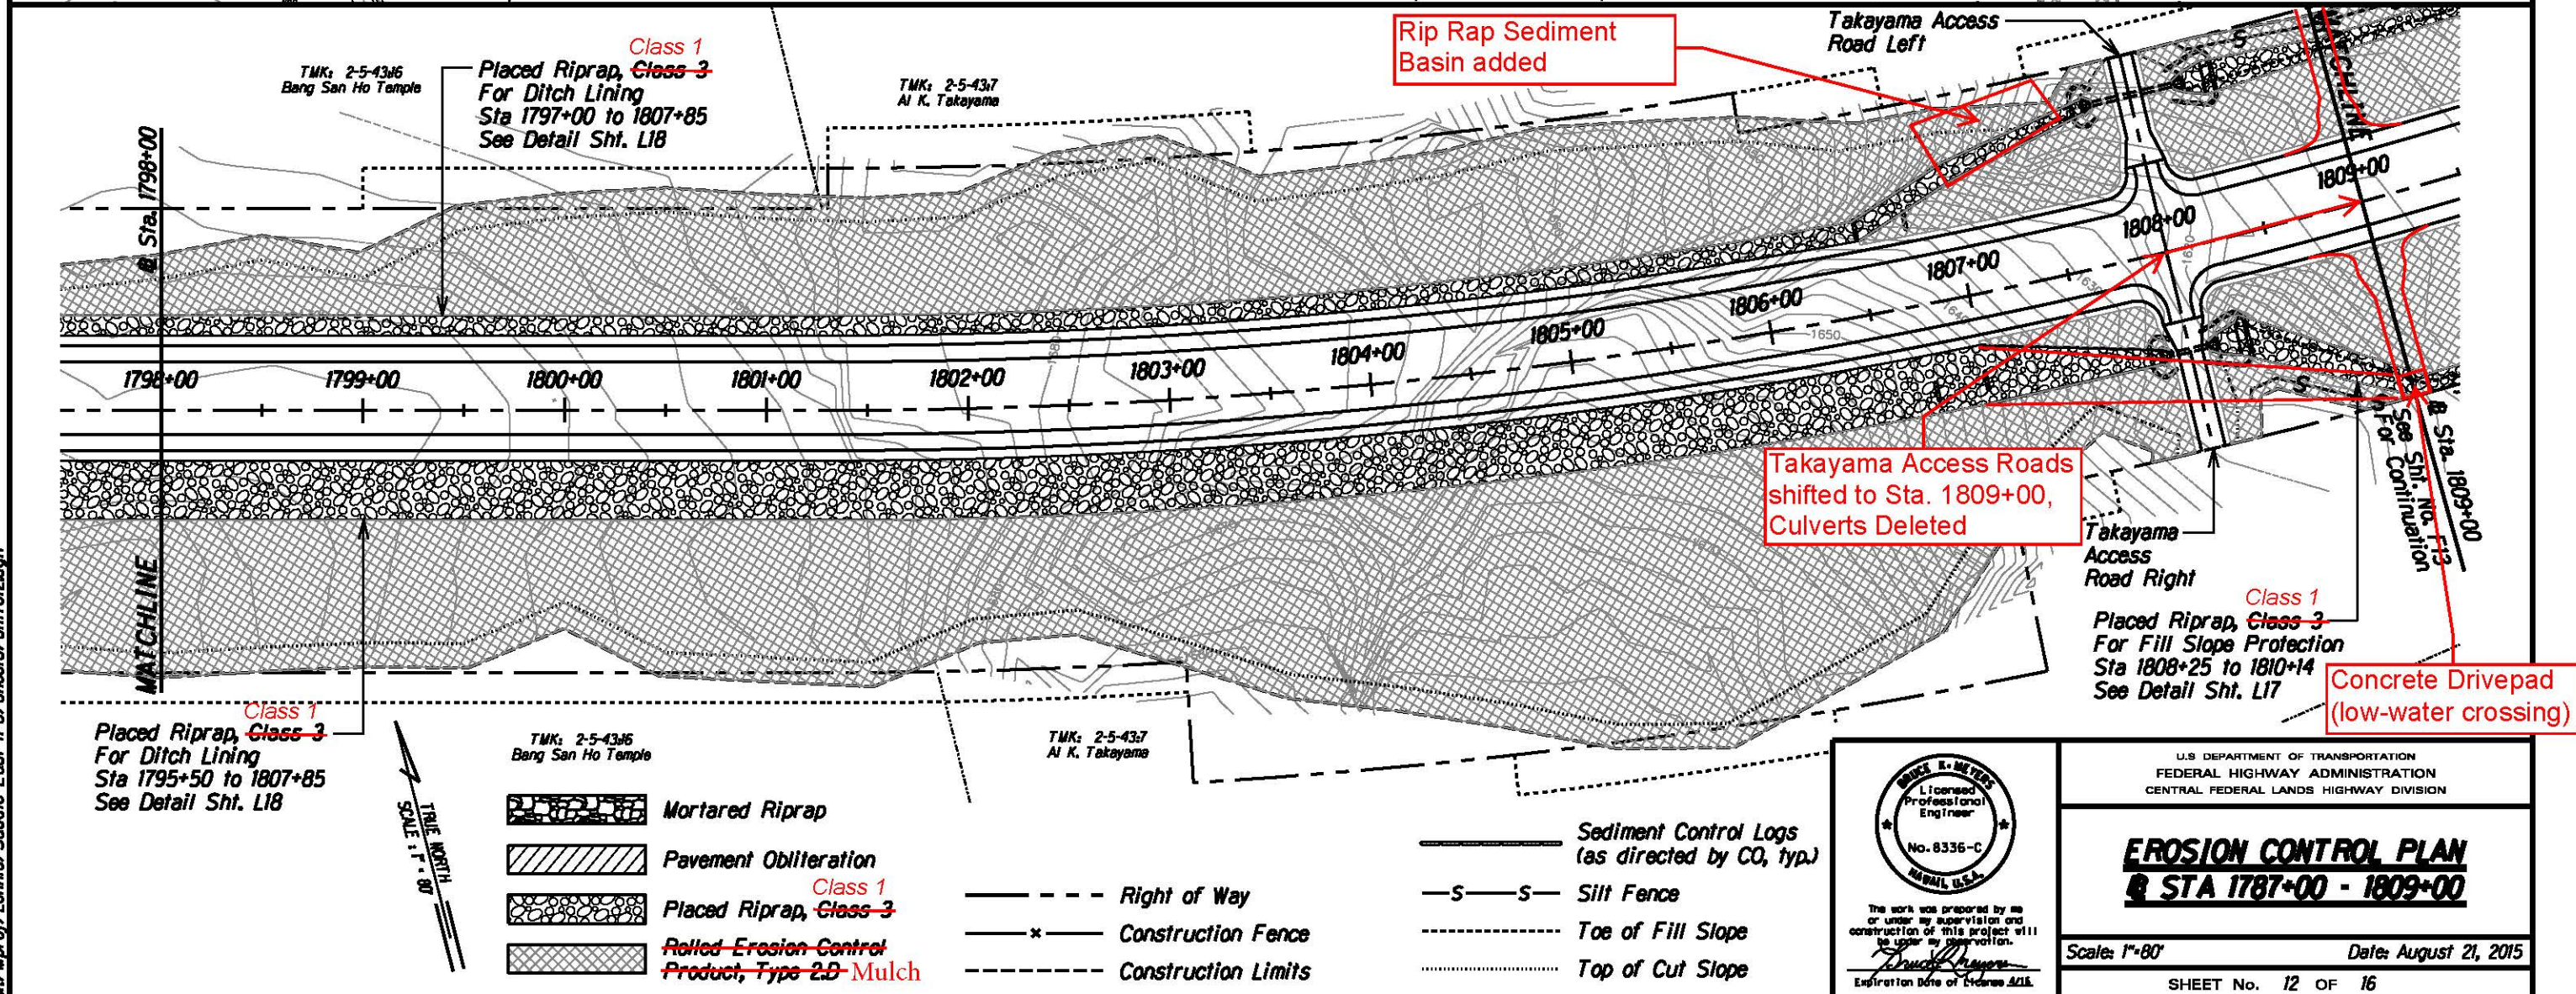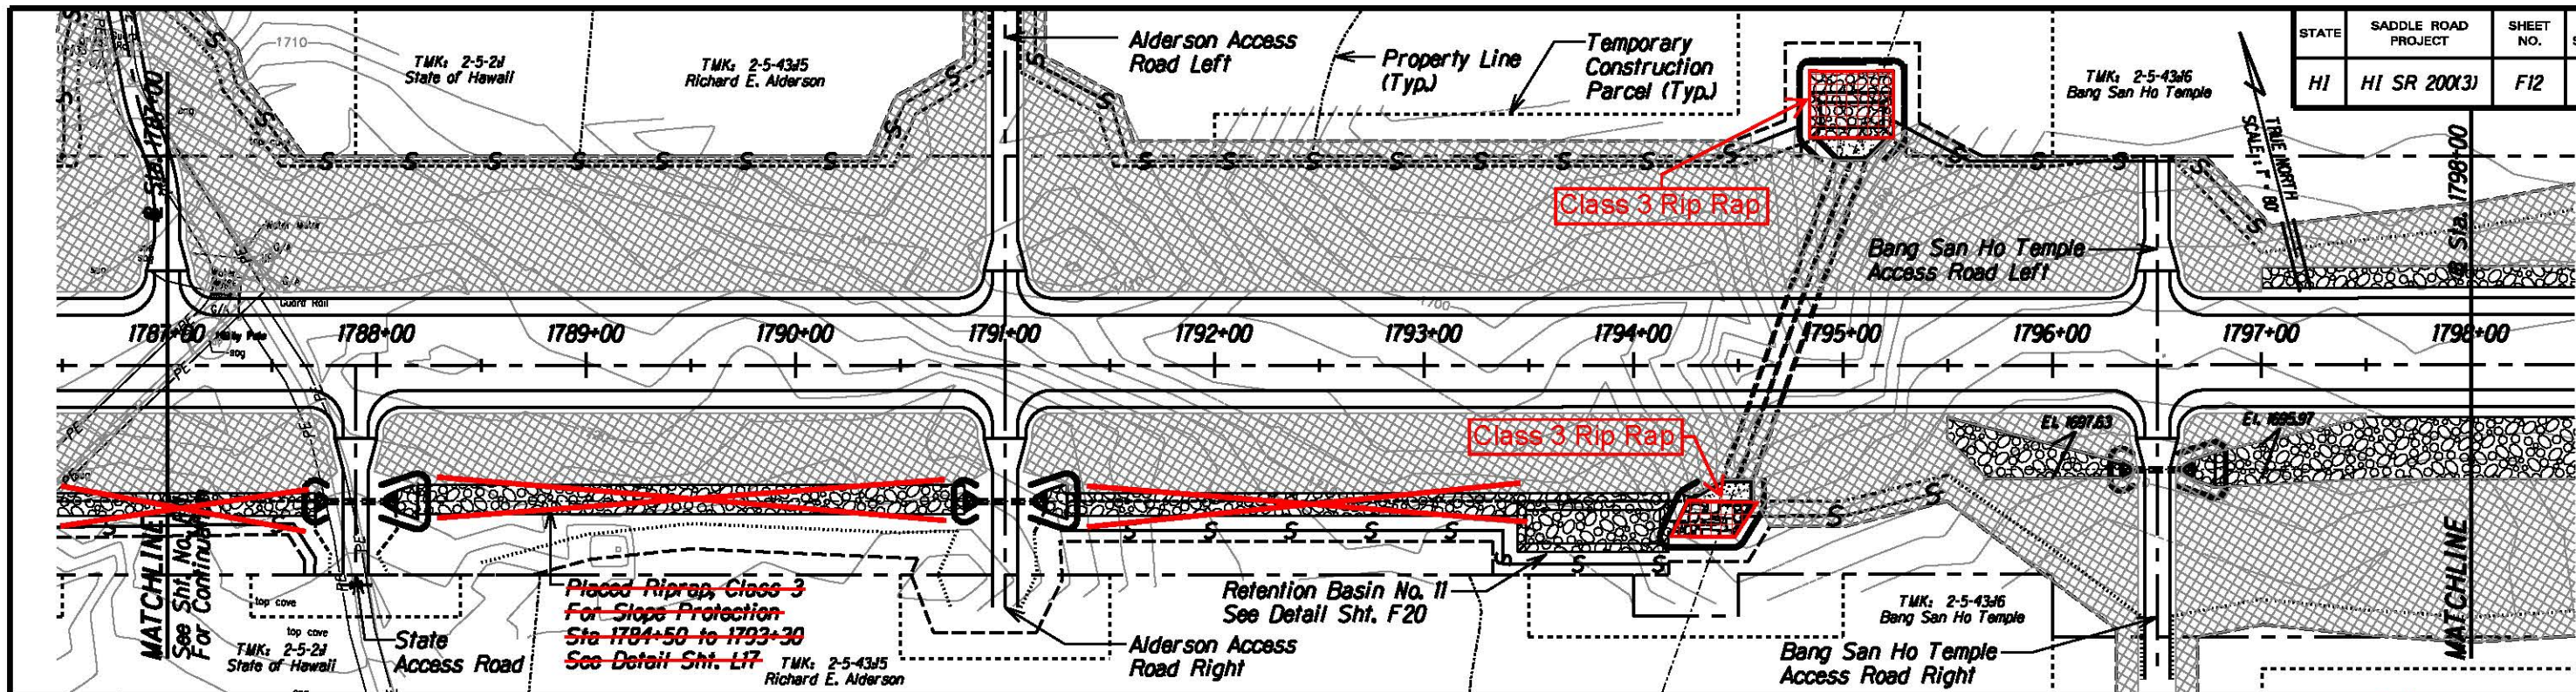

STATE	SADDLE ROAD PROJECT	SHEET NO.	TOTAL SHEETS
HI	HI SR 200(3)	F13	F20

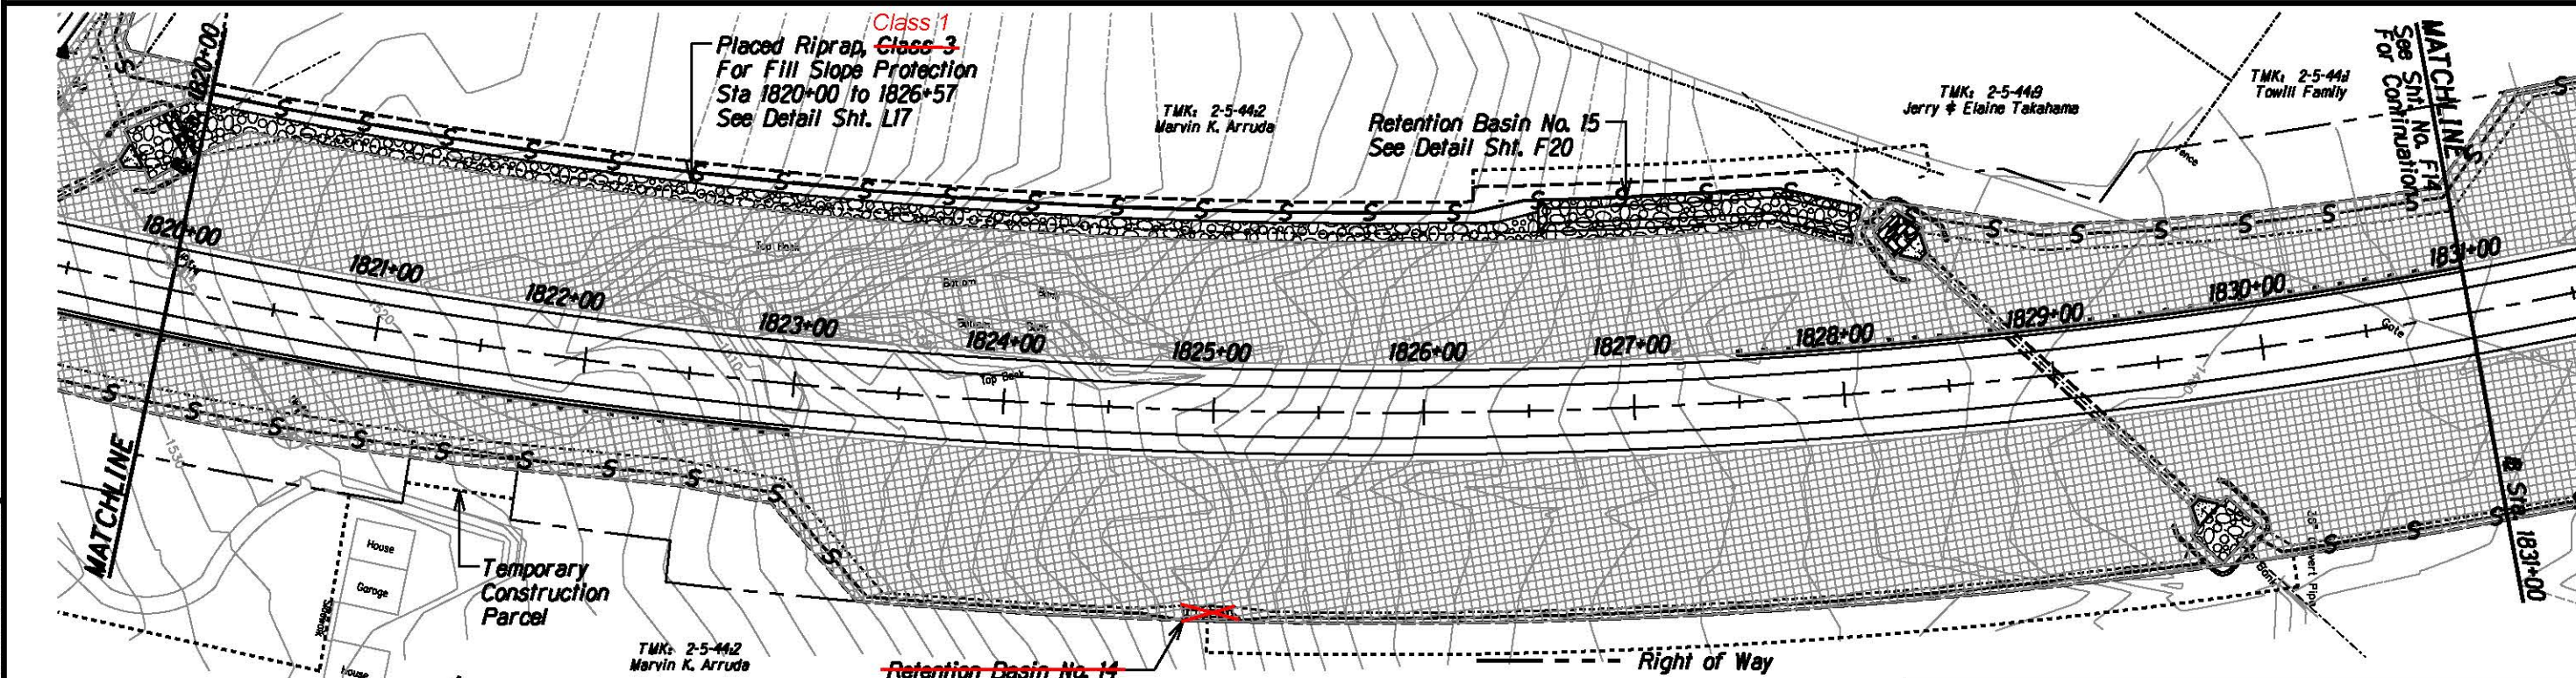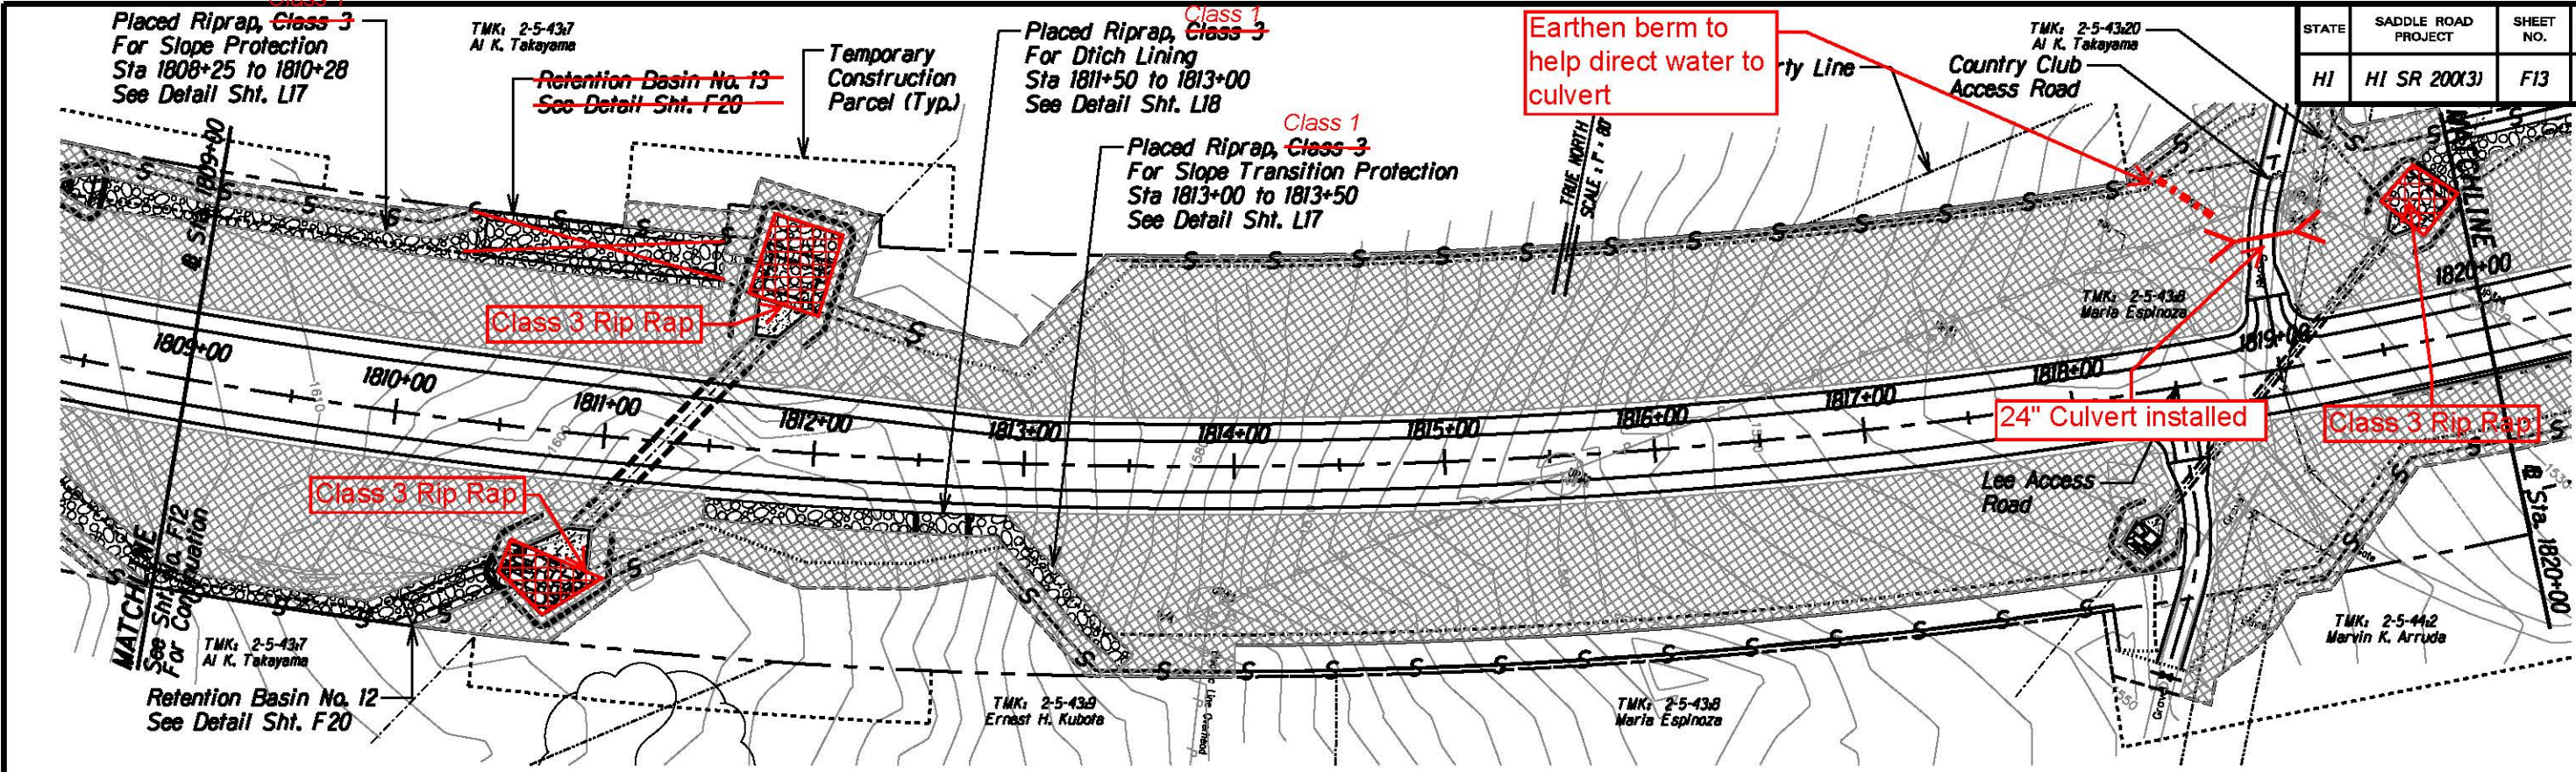

M:\Mproj\Lenzie\Saddle East 11-6\sheet\shfr013.dgn

- Mortared Riprap
- Pavement Obliteration
- Placed Riprap, Class 3
- Rolled Erosion Control Product, Type 2-D Mulch

- Right of Way
- Construction Fence
- Construction Limits
- Sediment Control Logs (as directed by CO, typ.)
- Silt Fence
- Toe of Fill Slope
- Top of Cut Slope

BRUCE E. MEYERS

Licensed Professional Engineer

No. 8336-C

HAWAII, U.S.A.

The work was prepared by me or under my supervision and construction of this project will be under my observation.

Bruce Meyers

Expiration Date of License 2018.

U.S. DEPARTMENT OF TRANSPORTATION
FEDERAL HIGHWAY ADMINISTRATION
CENTRAL FEDERAL LANDS HIGHWAY DIVISION

EROSION CONTROL PLAN

@ STA 1809+00 - 1831+00



Scale: 1"=80'

Date: August 21, 2015

SHEET No. 13 OF 16

F13

STATE	SADDLE ROAD PROJECT	SHEET NO.	TOTAL SHEETS
HI	HI SR 200(3)	F14	F20

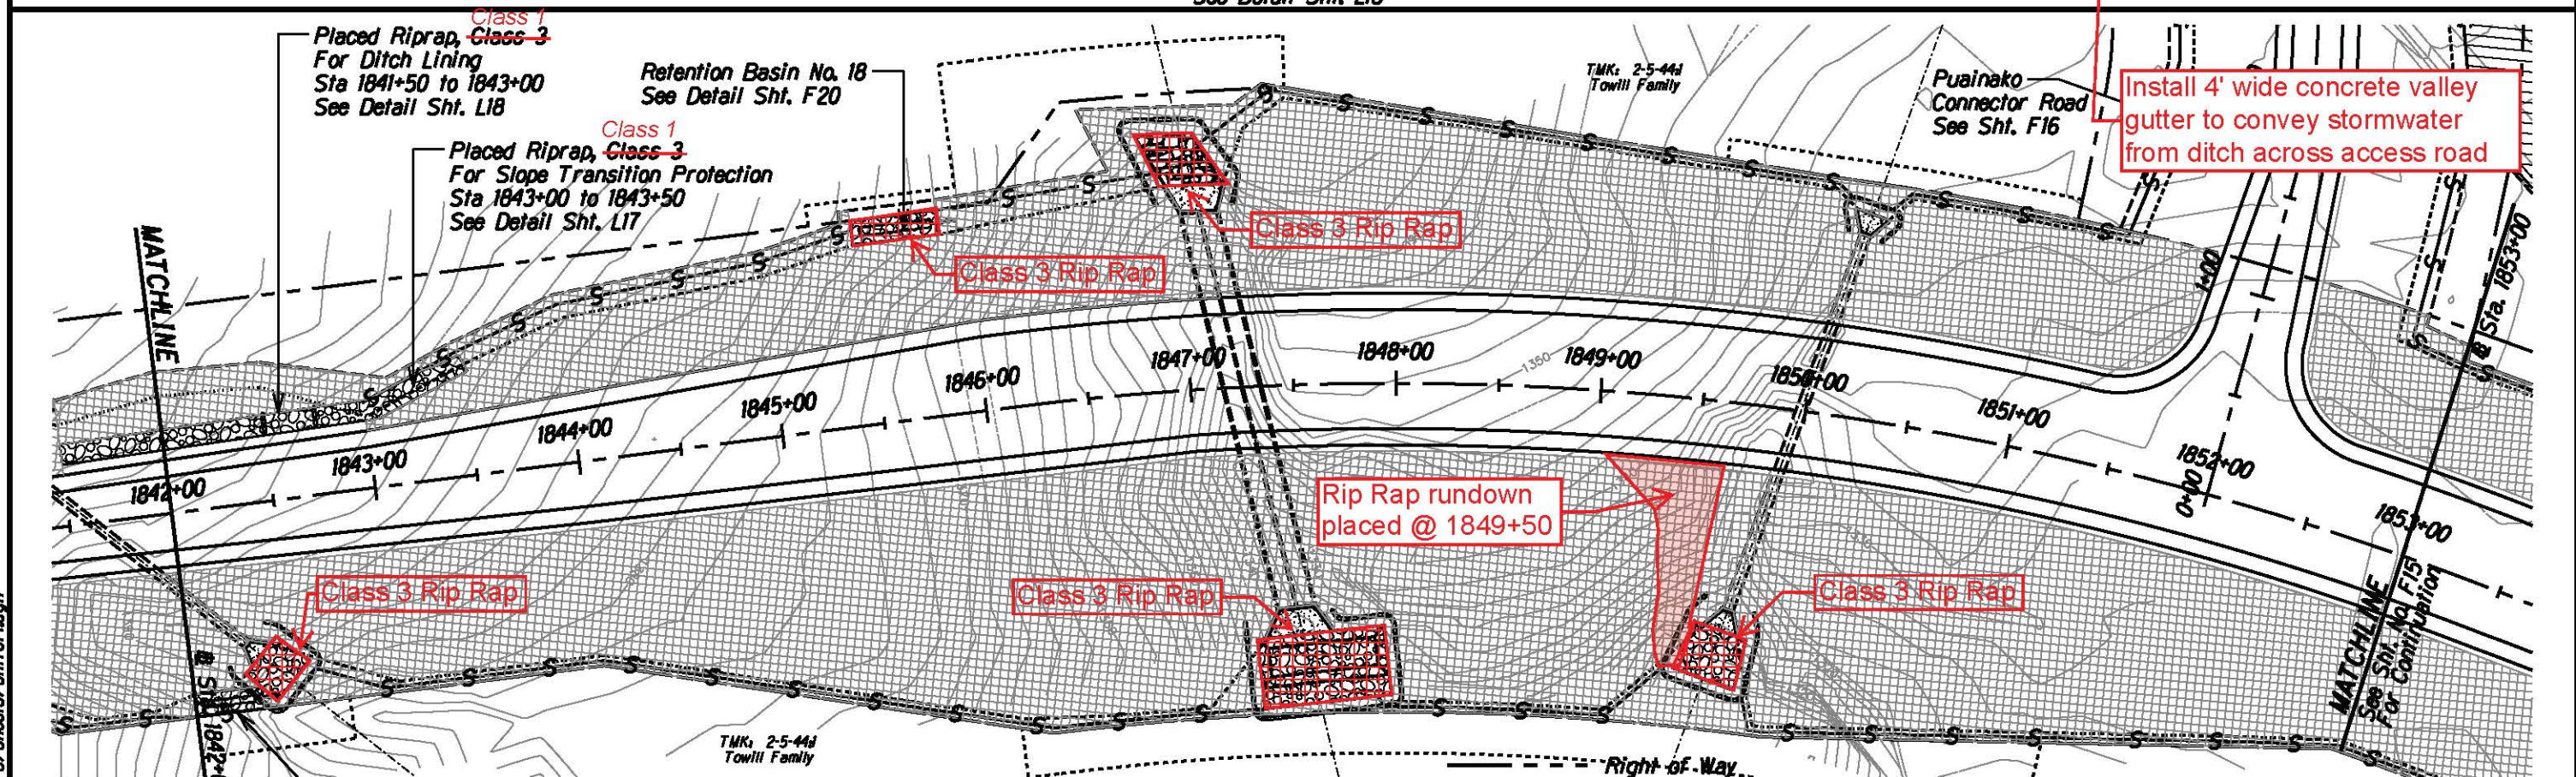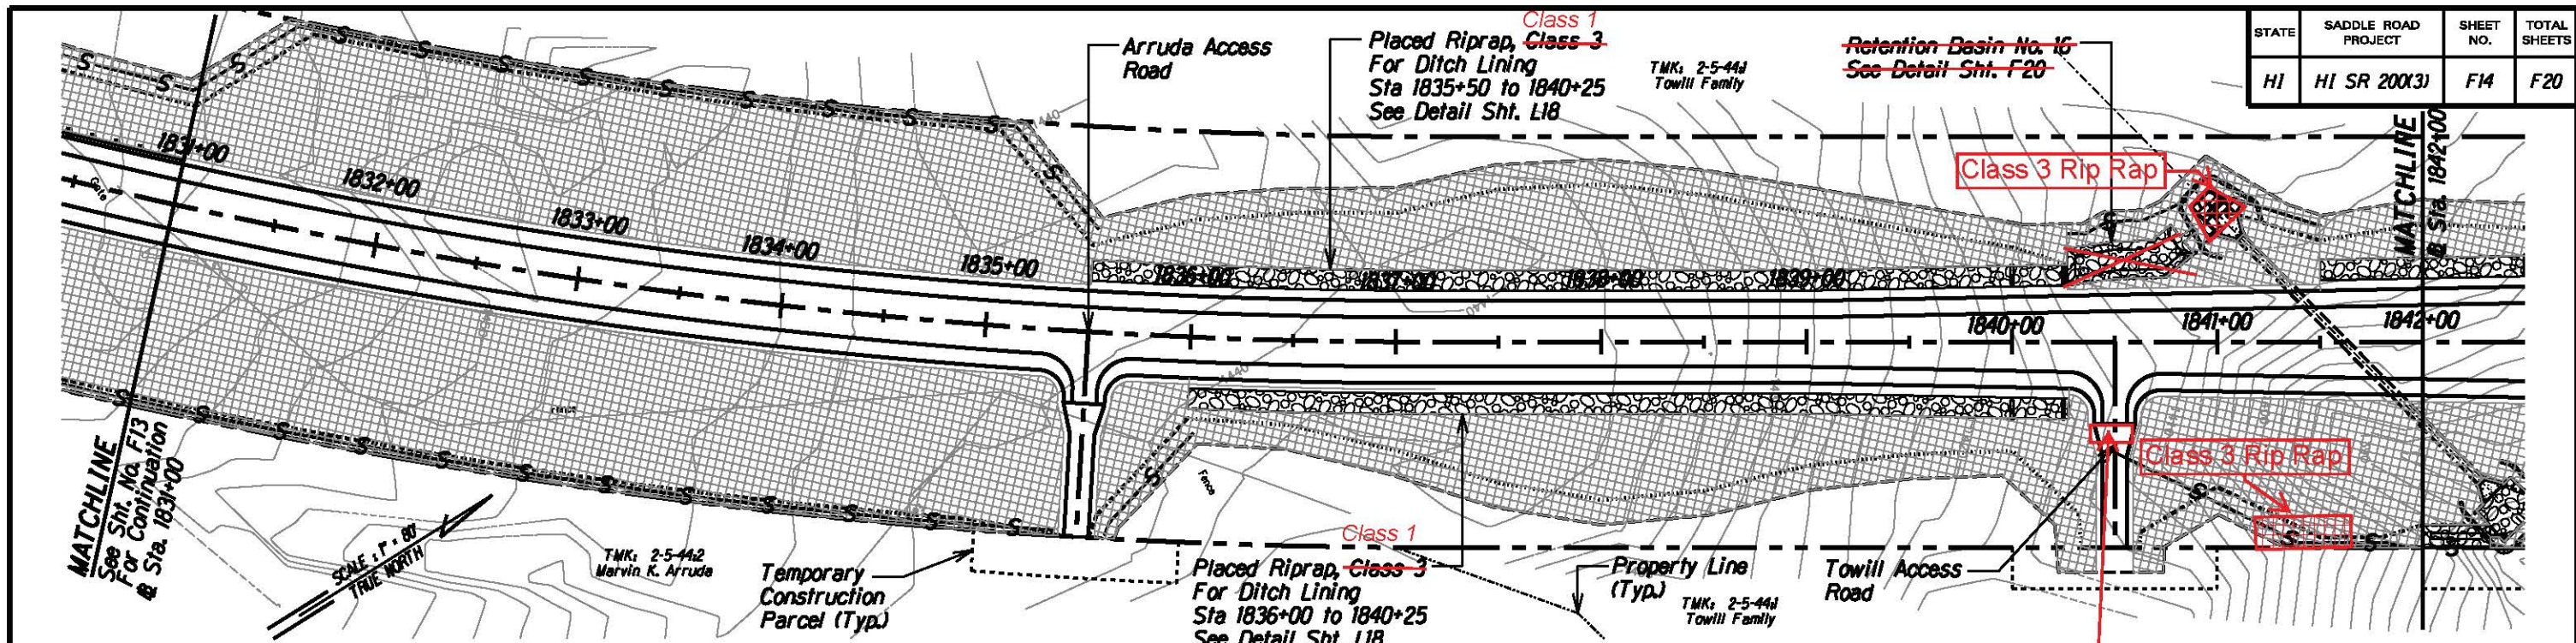

- Mortared Riprap
- Pavement Obliteration
- Placed Riprap, Class 3
- Rolled Erosion Control Product, Type 2D Mulch
- Construction Fence
- Construction Limits
- Sediment Control Logs (as directed by CO, typ.)
- Silt Fence
- Toe of Fill Slope
- Top of Cut Slope

BRUCE E. MEYERS
 Licensed Professional Engineer
 No. 8336-C
 HAWAII, U.S.A.

The work was prepared by me or under my supervision and construction of this project will be under my observation.

Bruce Meyers
 Expiration Date of License 2018.

U.S. DEPARTMENT OF TRANSPORTATION
 FEDERAL HIGHWAY ADMINISTRATION
 CENTRAL FEDERAL LANDS HIGHWAY DIVISION


**EROSION CONTROL PLAN
 @ STA 1831+00 - 1853+00**


Scale: 1"=80' Date: August 21, 2015

SHEET No. 14 OF 16

M:\Mproj\Lenzie\Saddle East 11-6\sheet\shfr014.dgn

STATE	SADDLE ROAD PROJECT	SHEET NO.	TOTAL SHEETS
HI	HI SR 200(3)	F15	F20

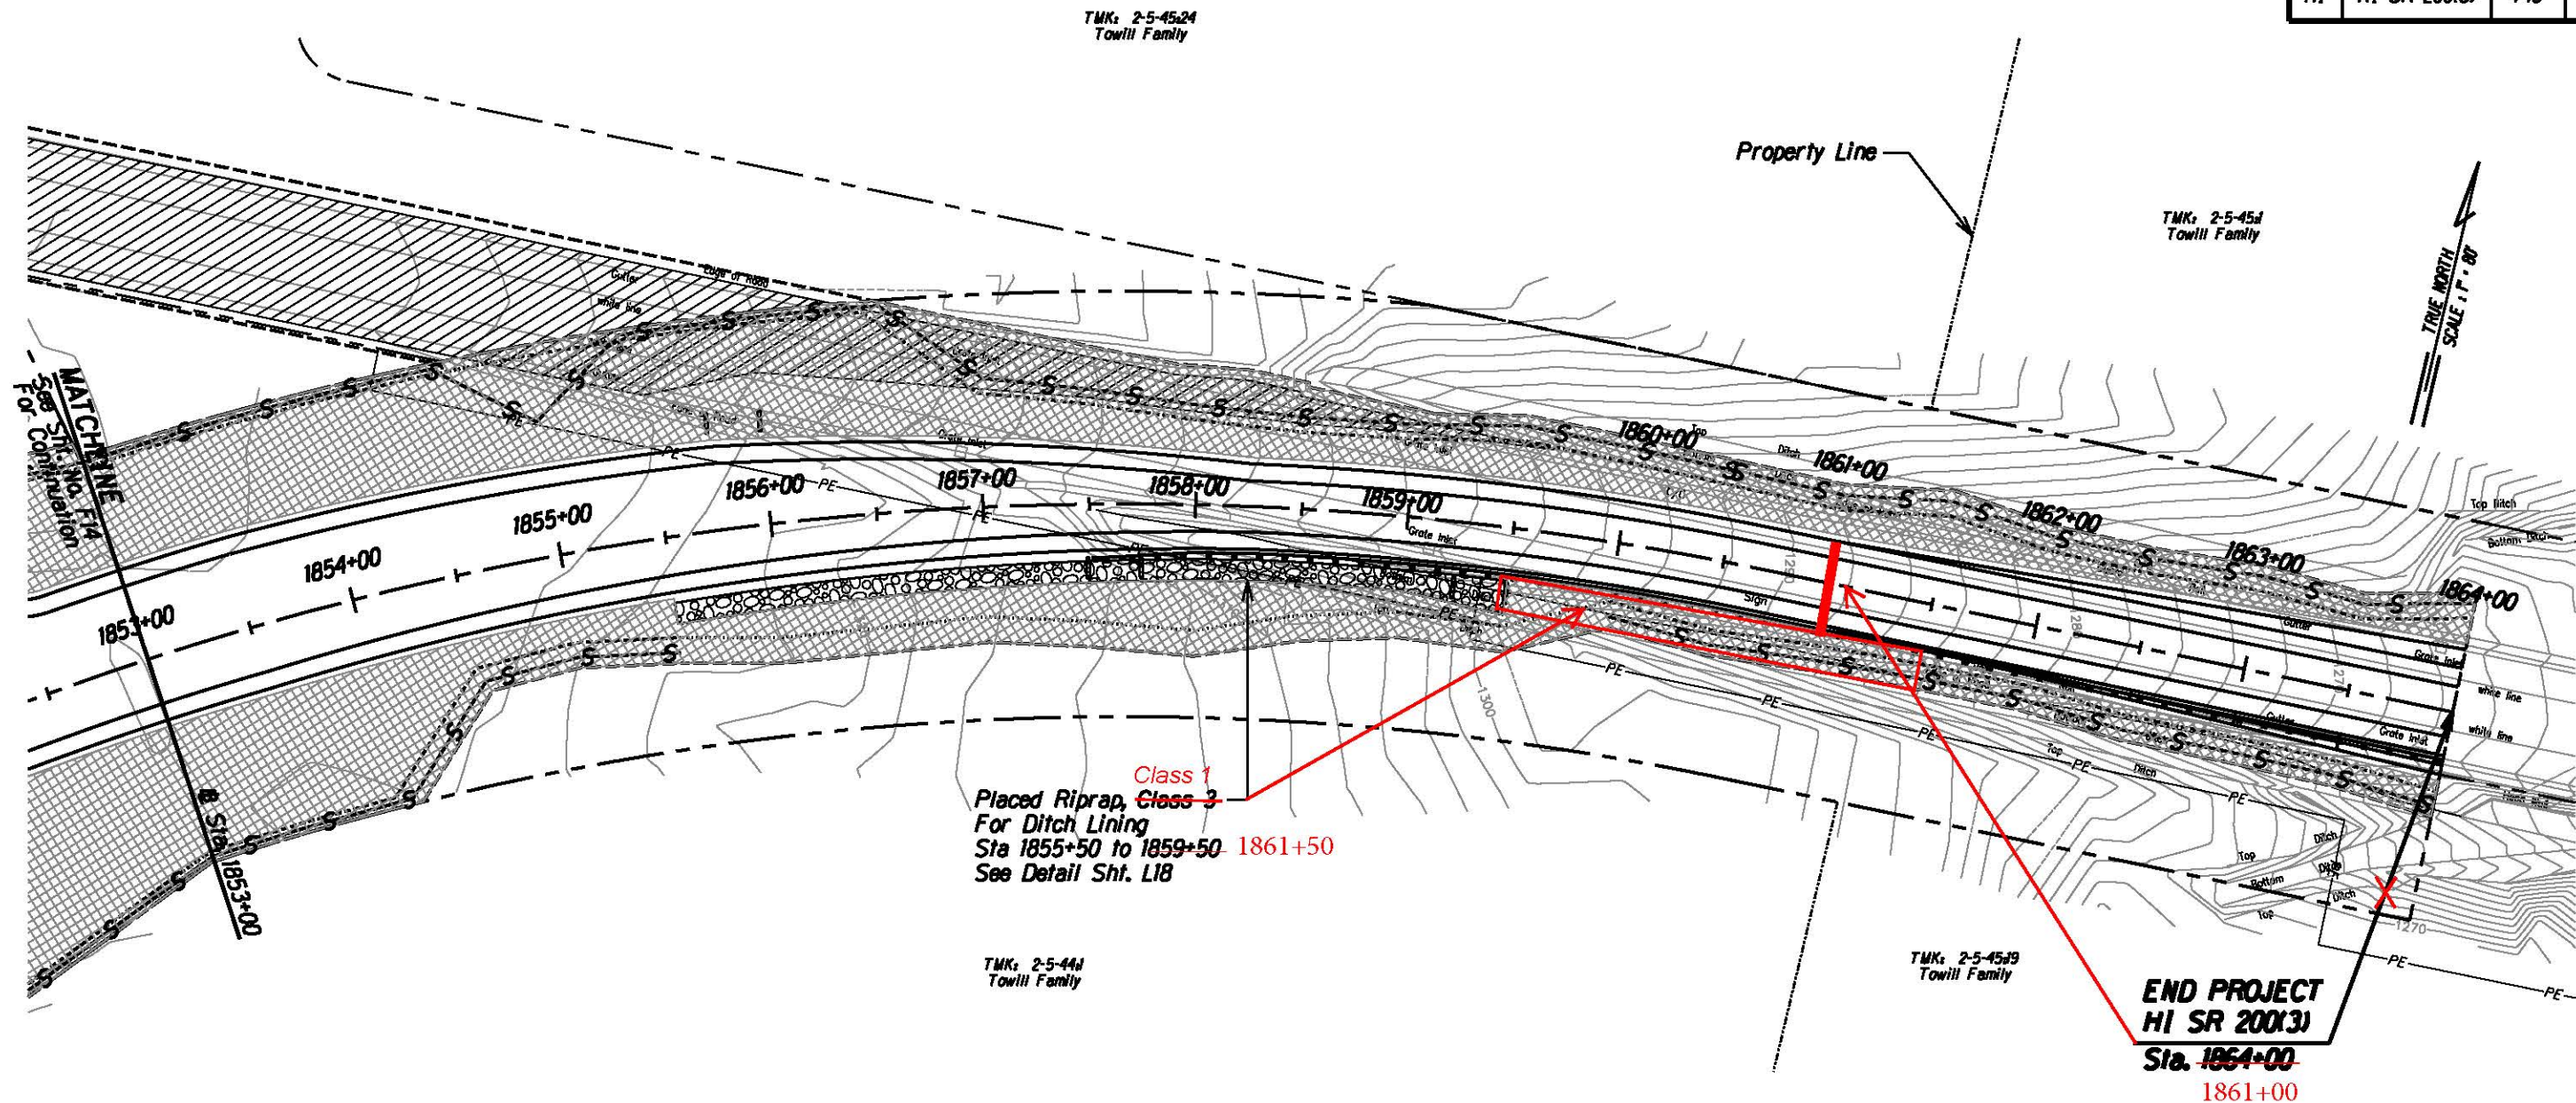

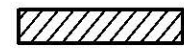-  Mortared Riprap
-  Pavement Obliteration
-  Placed Riprap, Class 3
-  Rolled Erosion Control Product, Type 2D Mulch

- Right of Way
- x- Construction Fence
- Construction Limits
- Sediment Control Logs (as directed by CO, typ.)
- S-S- Silt Fence
- Toe of Fill Slope
- Top of Cut Slope



U.S. DEPARTMENT OF TRANSPORTATION
 FEDERAL HIGHWAY ADMINISTRATION
 CENTRAL FEDERAL LANDS HIGHWAY DIVISION

EROSION CONTROL PLAN
STA 1853+00 - 1864+00

Scale: 1"=80'
 Date: August 21, 2015

SHEET No. 15 OF 16

M:\Mproj\Lenzie\Saddle East 11-6\sheet\shf015.dgn