

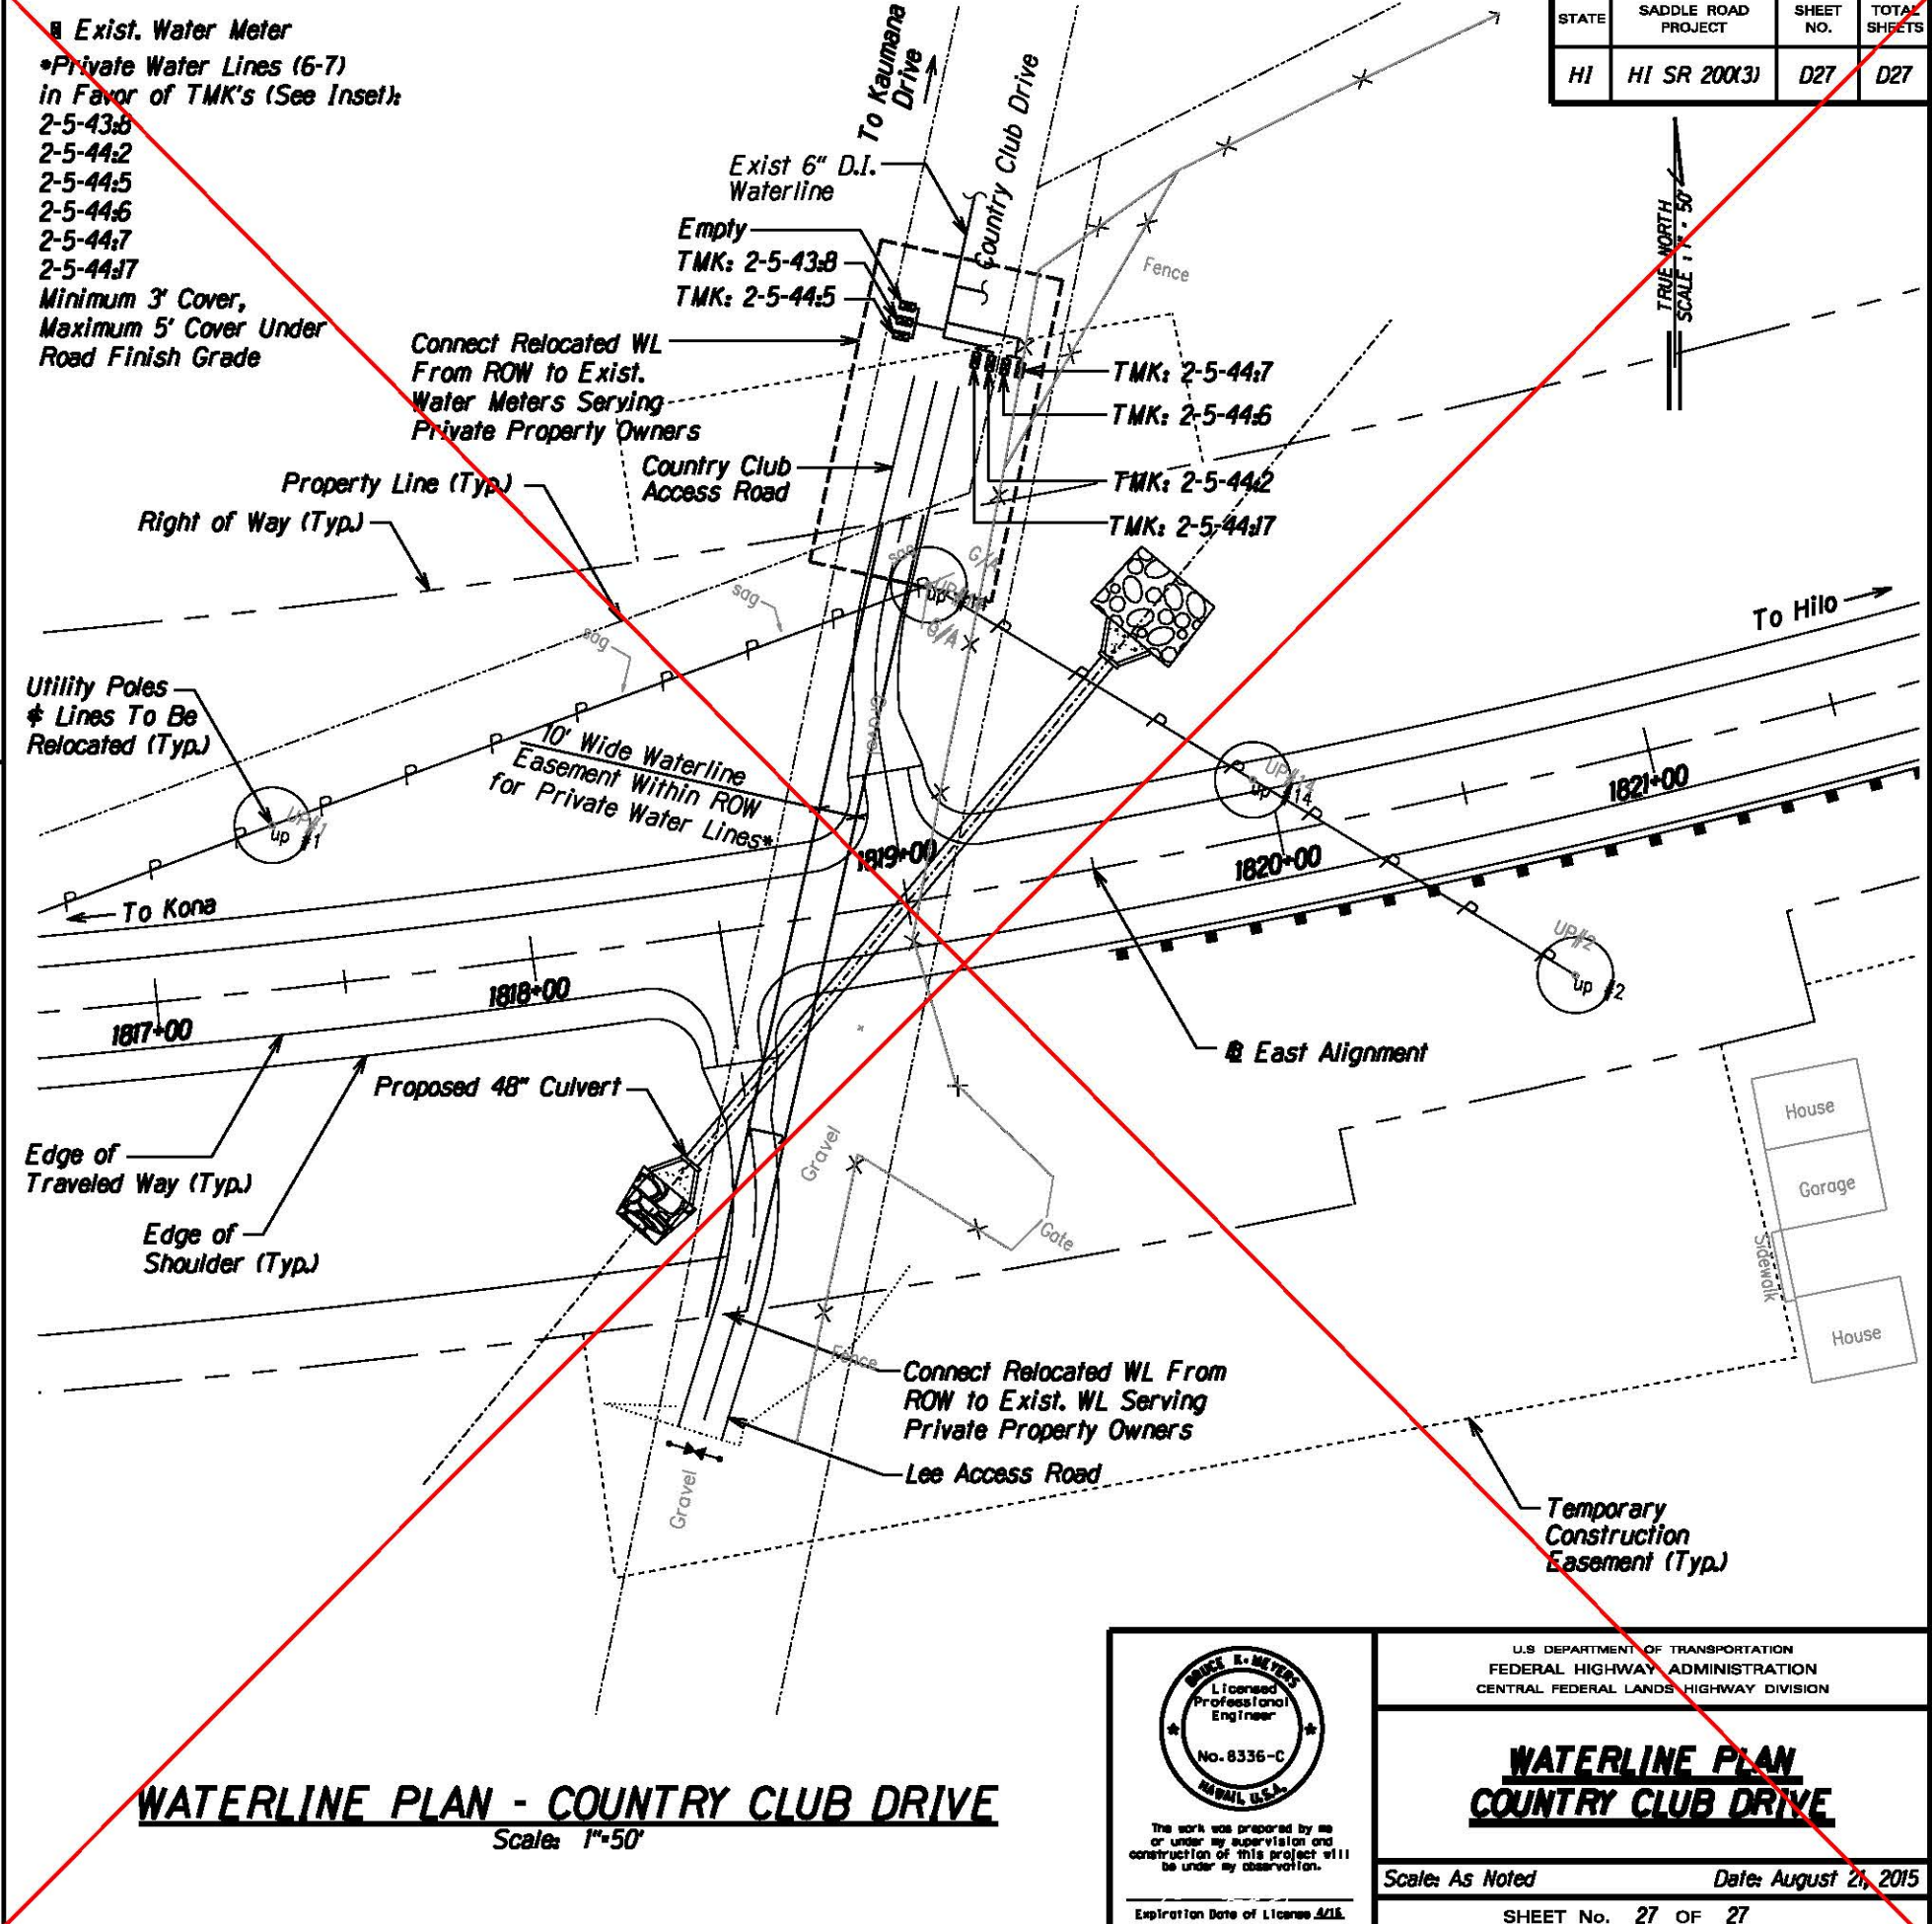
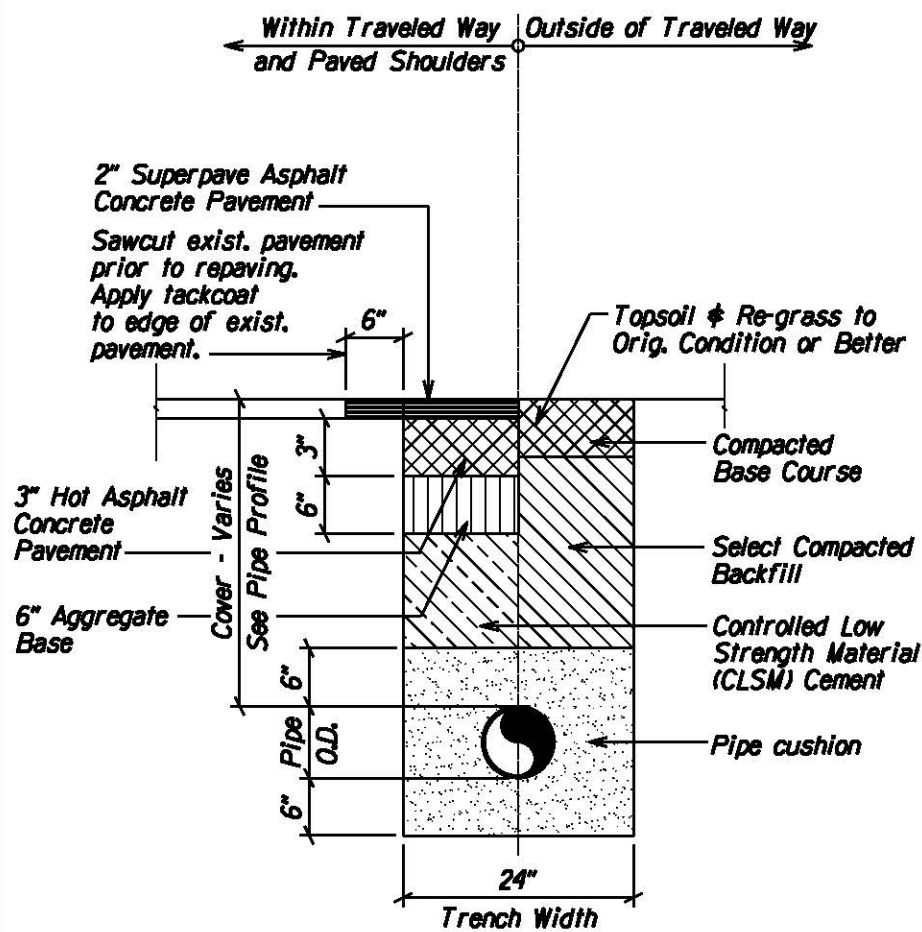
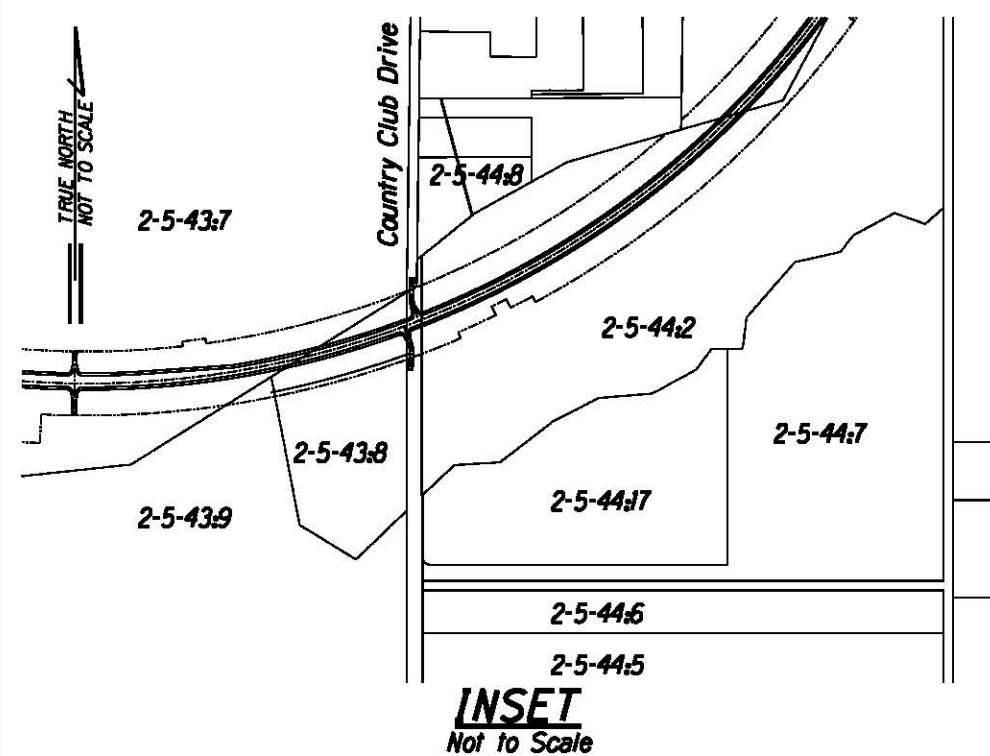


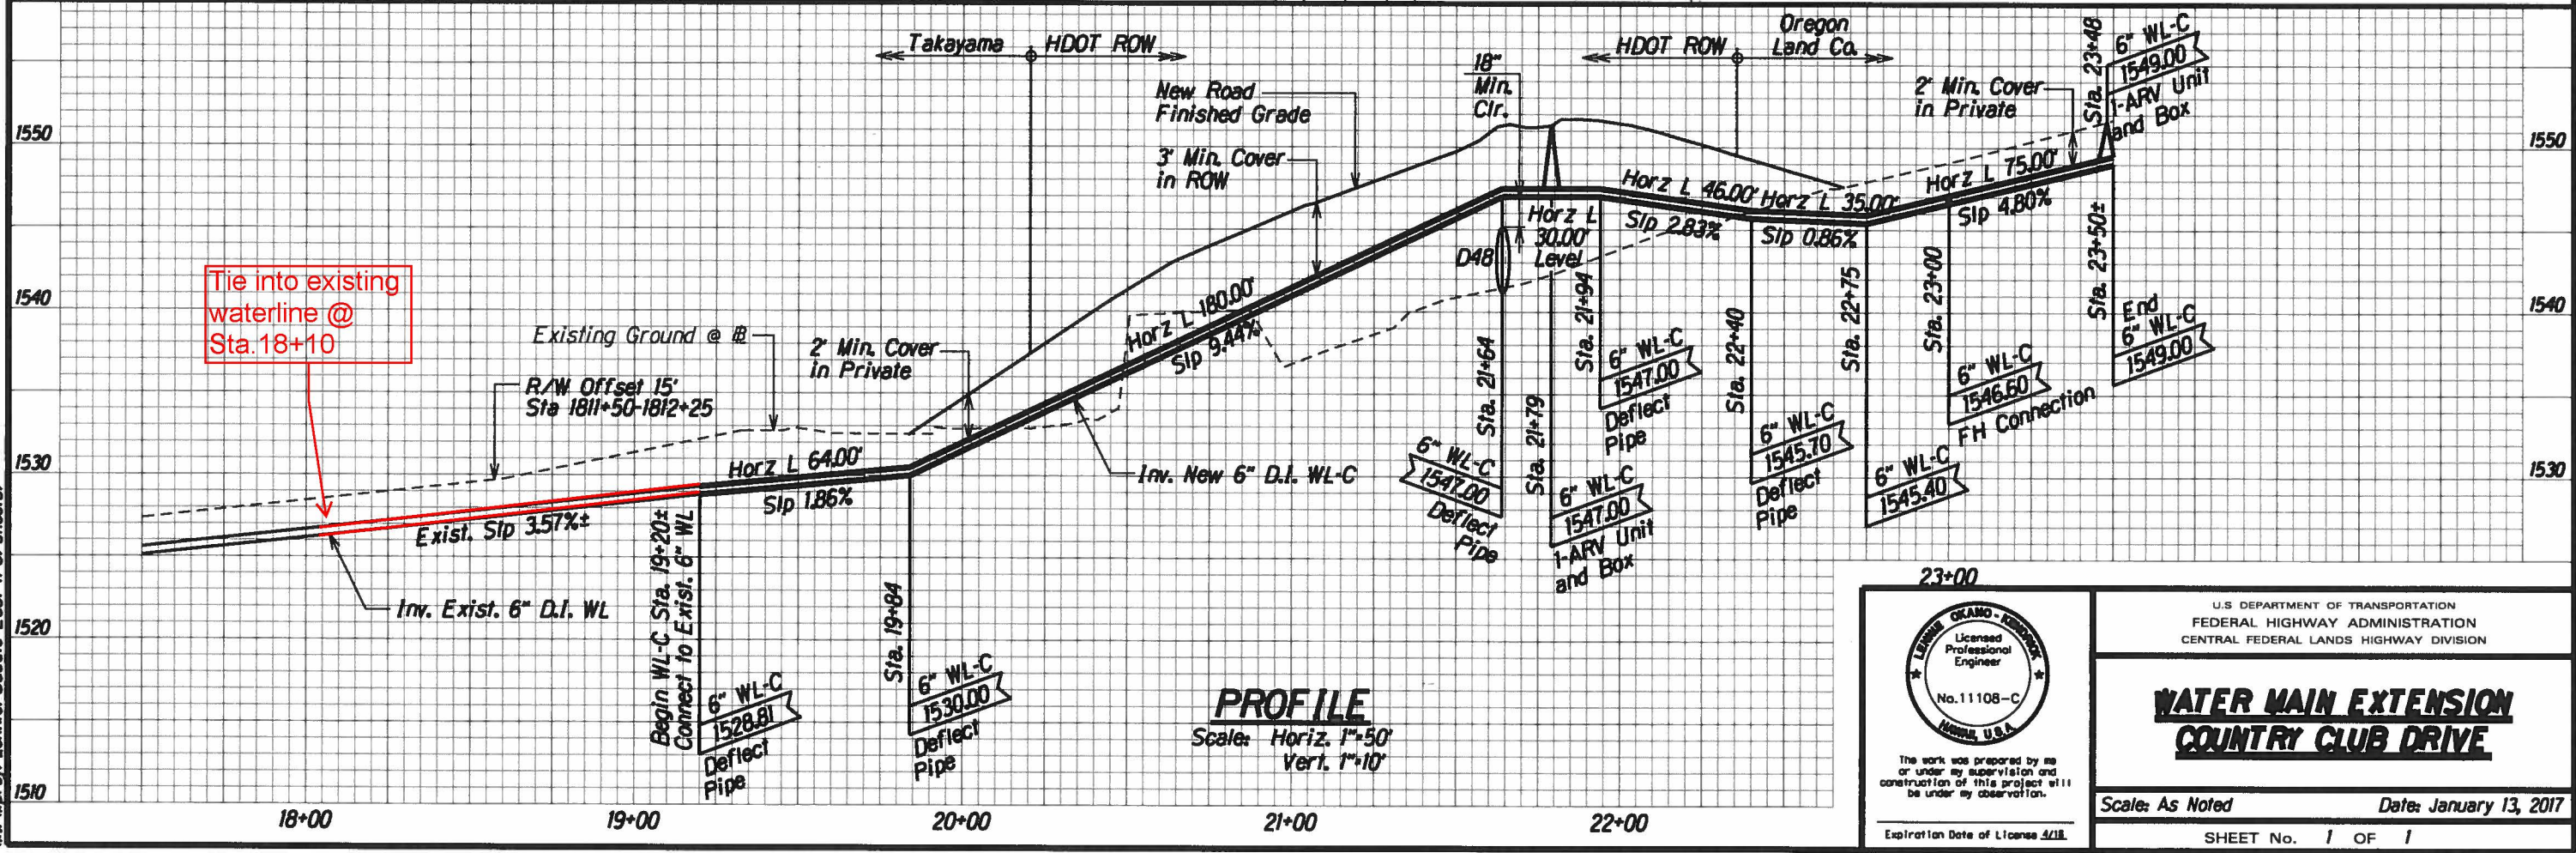

STATE	SADDLE ROAD PROJECT	SHEET NO.	TOTAL SHEETS
HI	HI SR 200(3)	1	1

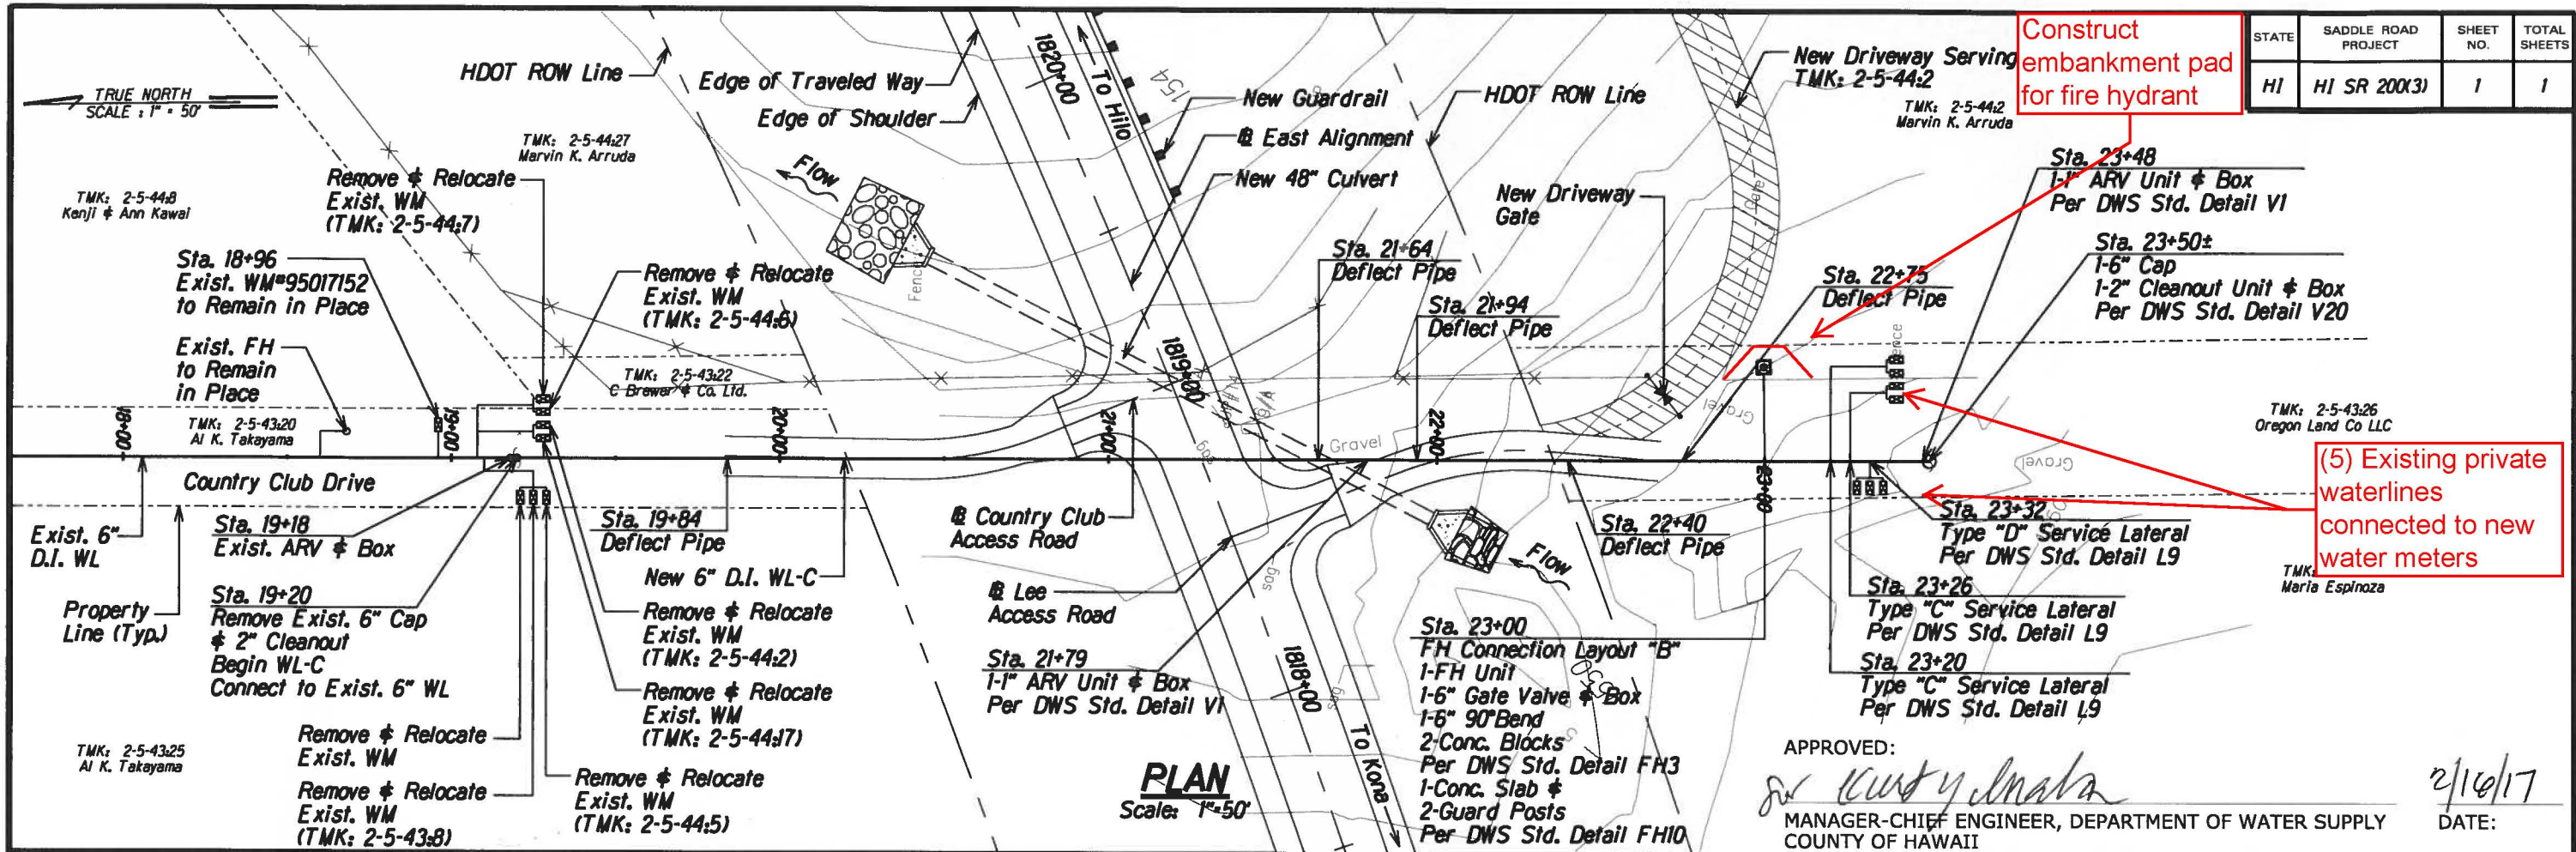

M:\Mproj\Lennie/Saddle East II-6/Sheets/

X