
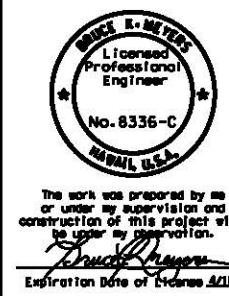
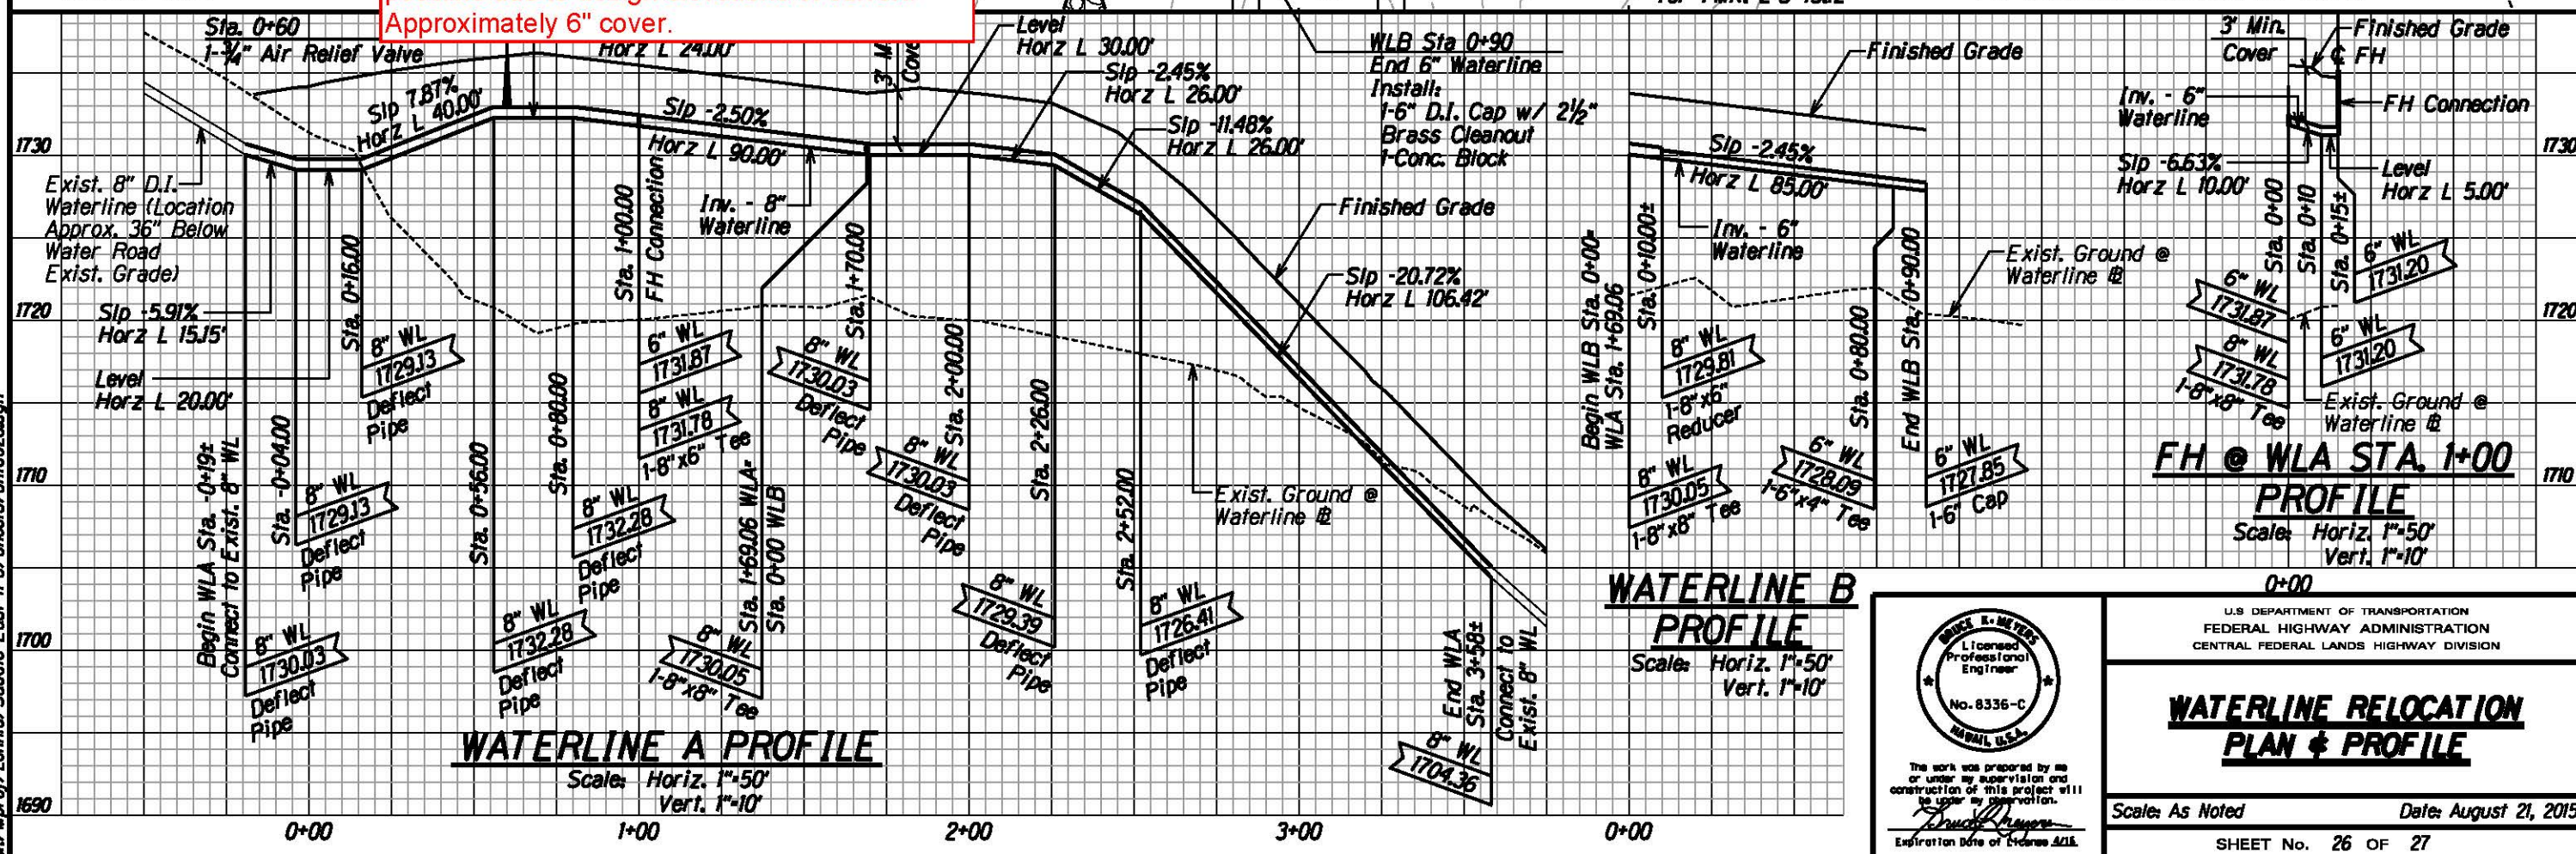


STATE	SADDLE ROAD PROJECT	SHEET NO.	TOTAL SHEETS
HI	HI SR 200(3)	D26	D27

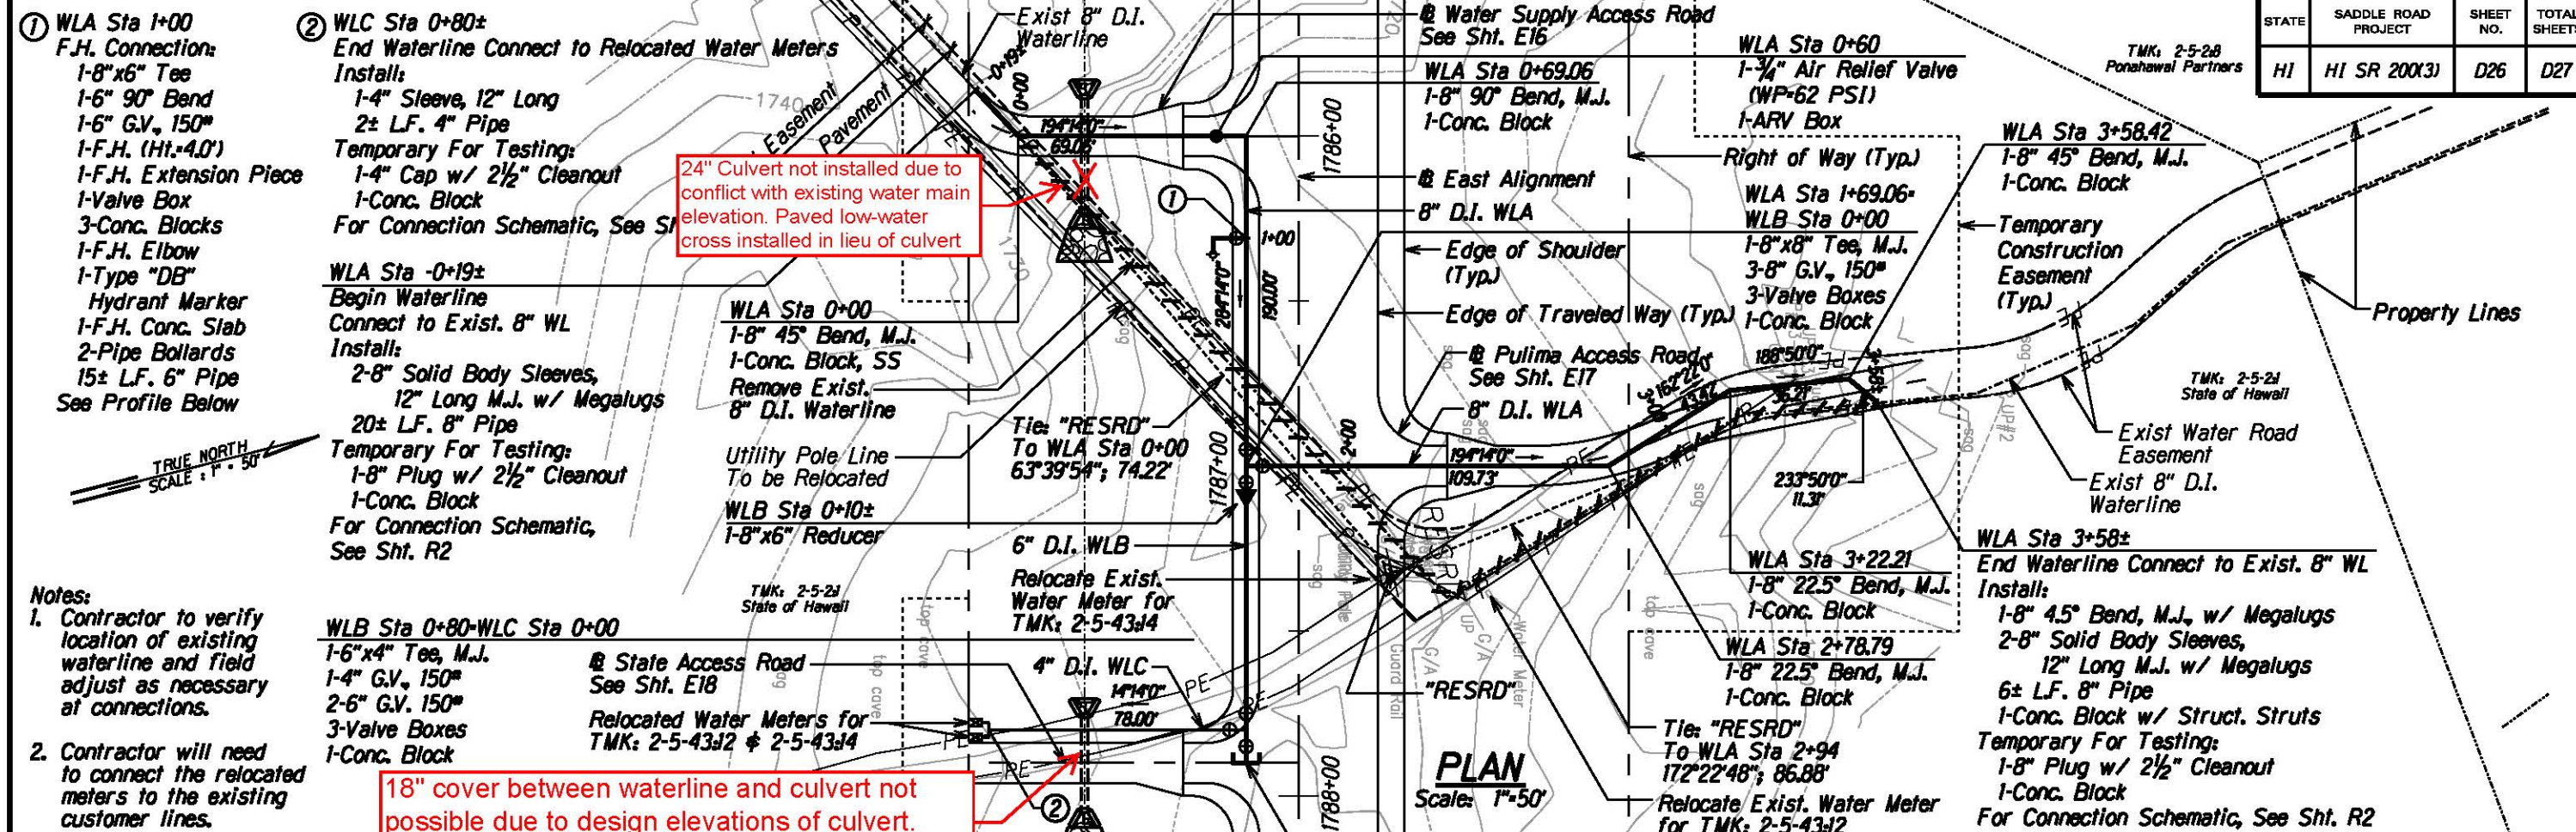

U.S. DEPARTMENT OF TRANSPORTATION
FEDERAL HIGHWAY ADMINISTRATION
CENTRAL FEDERAL LANDS HIGHWAY DIVISION

**WATERLINE RELOCATION
PLAN & PROFILE**

Scale: As Noted Date: August 21, 2015

SHEET No. 26 OF 27