


STATE	SADDLE ROAD PROJECT	SHEET NO.	TOTAL SHEETS
HI	HI HP & TI 200(2)	C14	C24


SCHEDULE A MASS HAUL DIAGRAM

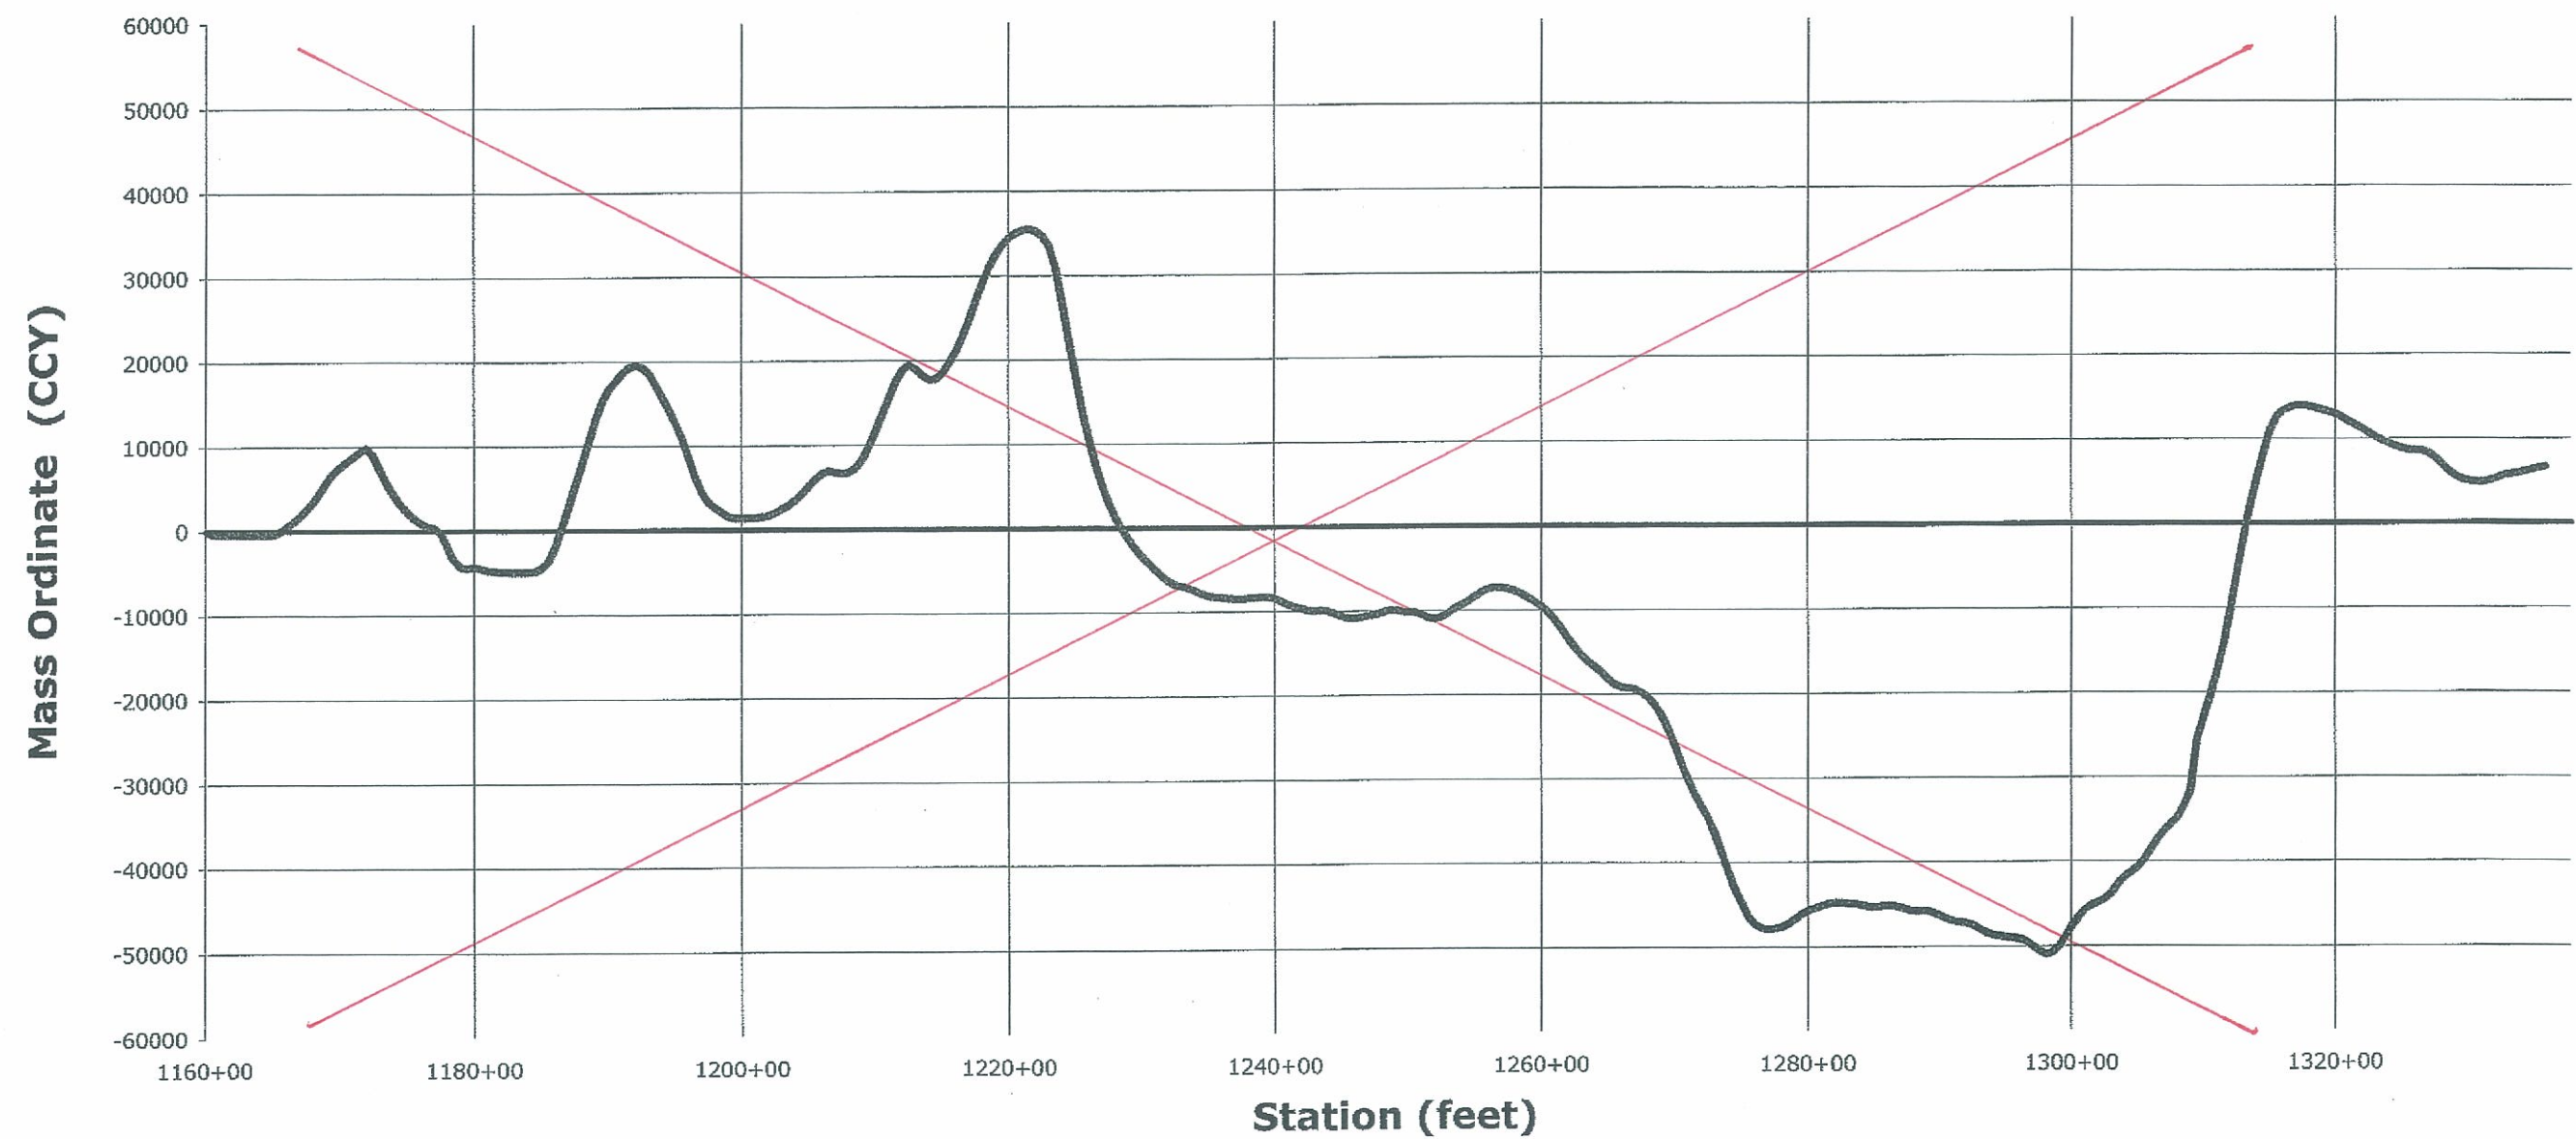

The work was prepared by me or under my supervision and construction of this project will be under my observation.
 Signature: *[Signature]*
 Expiration Date of License: 12/31/19

STATE	SADDLE ROAD PROJECT	SHEET NO.	TOTAL SHEETS
HI	HI HP & TI 200(2)	C15	C24

SCHEDULE B MASS HAUL DIAGRAM

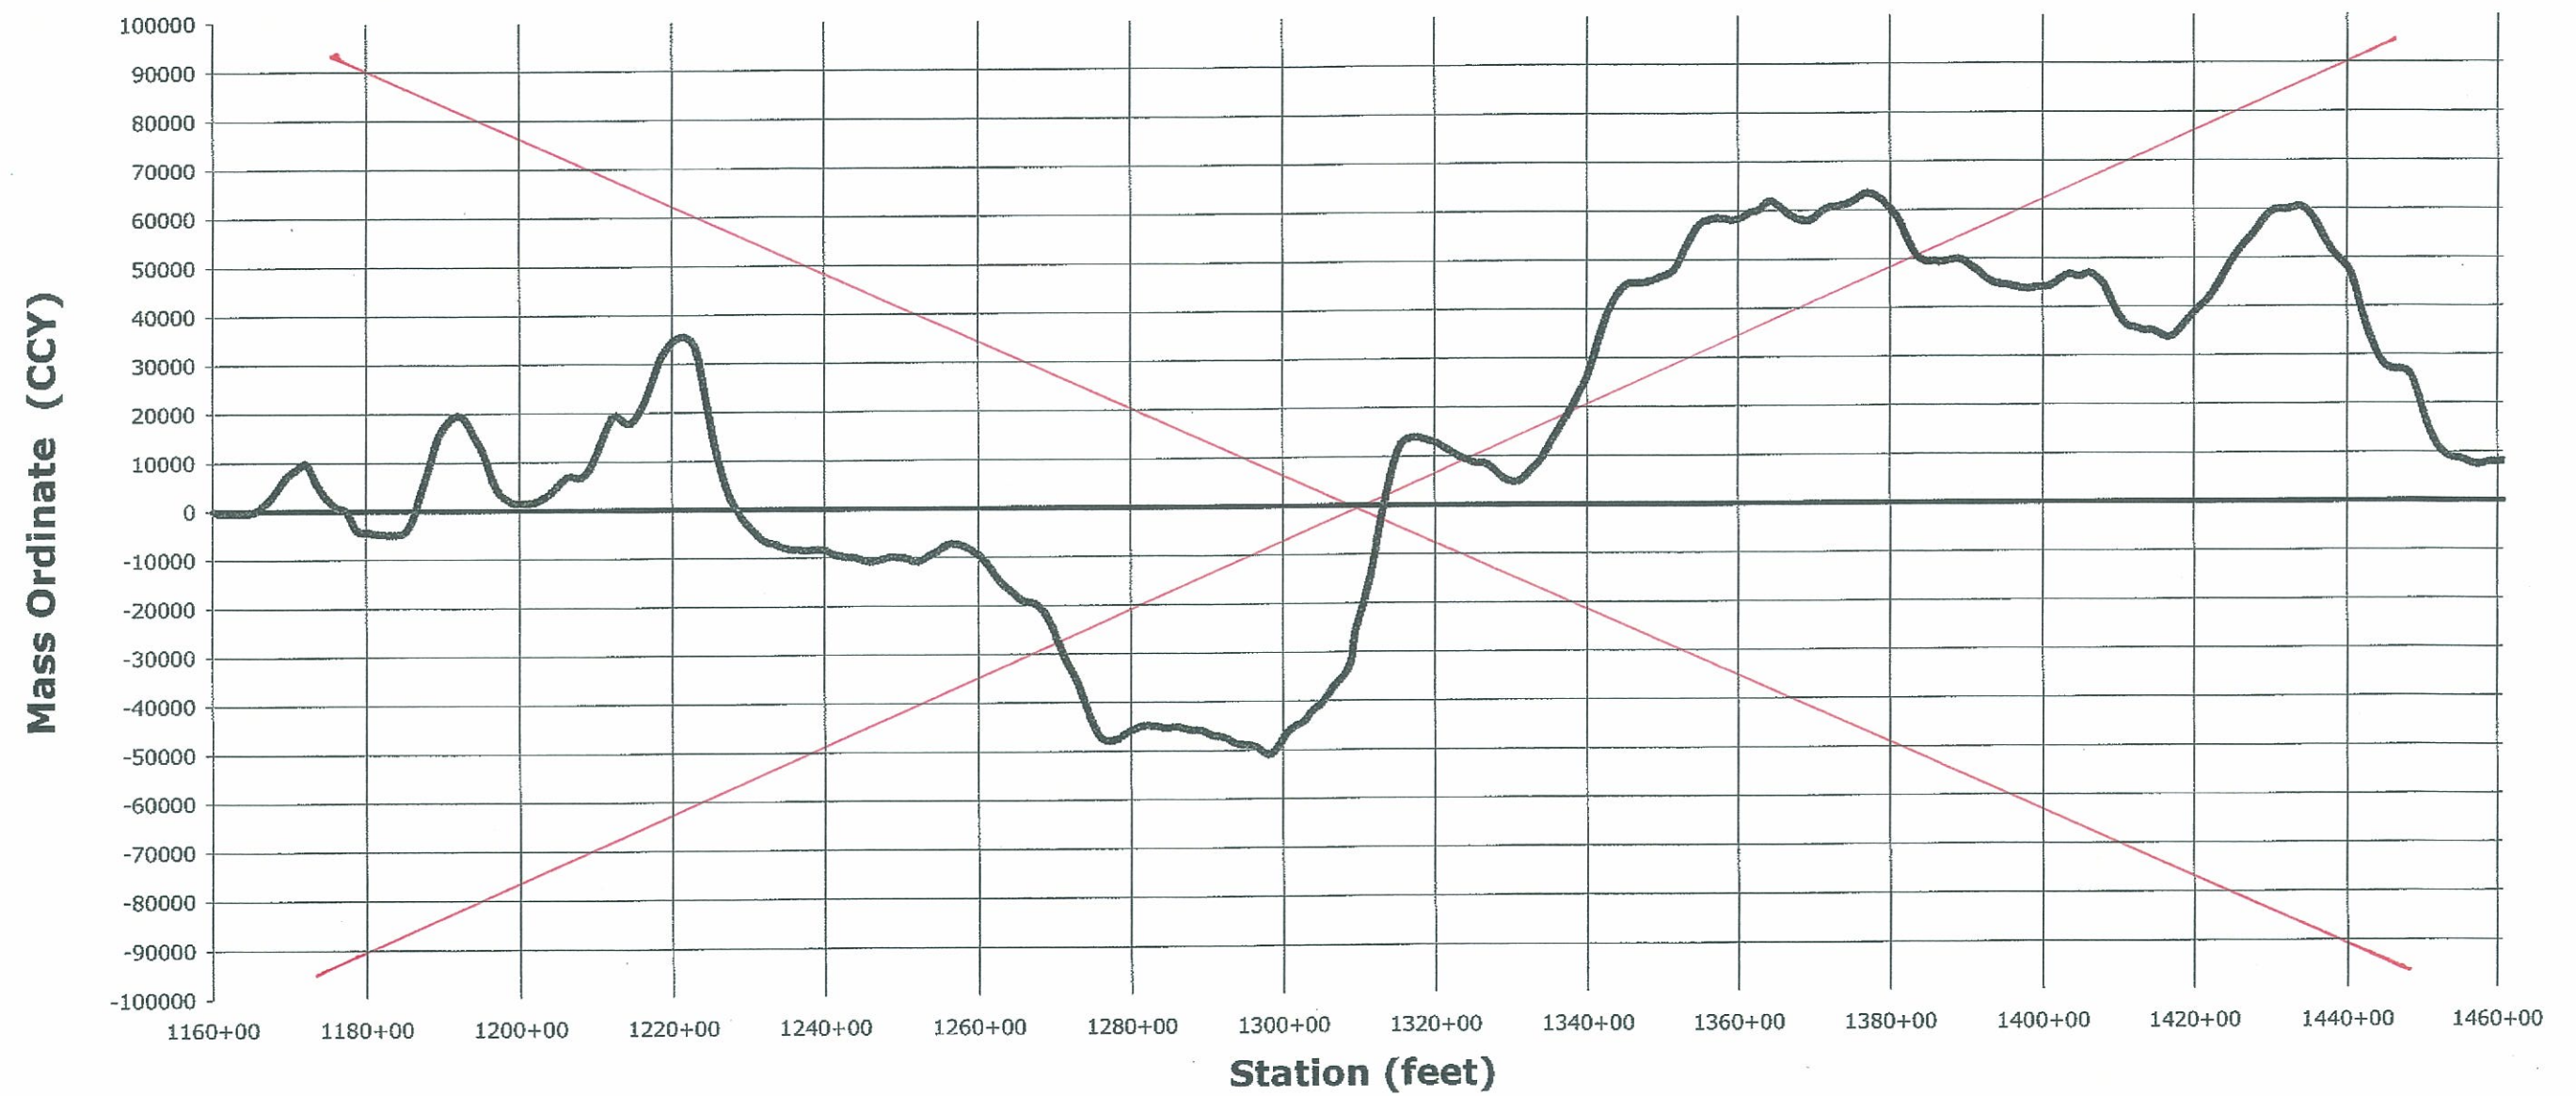

M:\Mproj\Lennie\2080009\summaries\100% 200(2) grading sum B.xls\Summary B




The work was prepared by me or under my supervision and construction of this project will be under my direction.

Signature: *[Handwritten Signature]*

Expiration Date of License: 6/30/10

STATE	SADDLE ROAD PROJECT	SHEET NO.	TOTAL SHEETS
HI	HI HP & TI 200(2)	C16	C24

SCHEDULE C MASS HAUL DIAGRAM

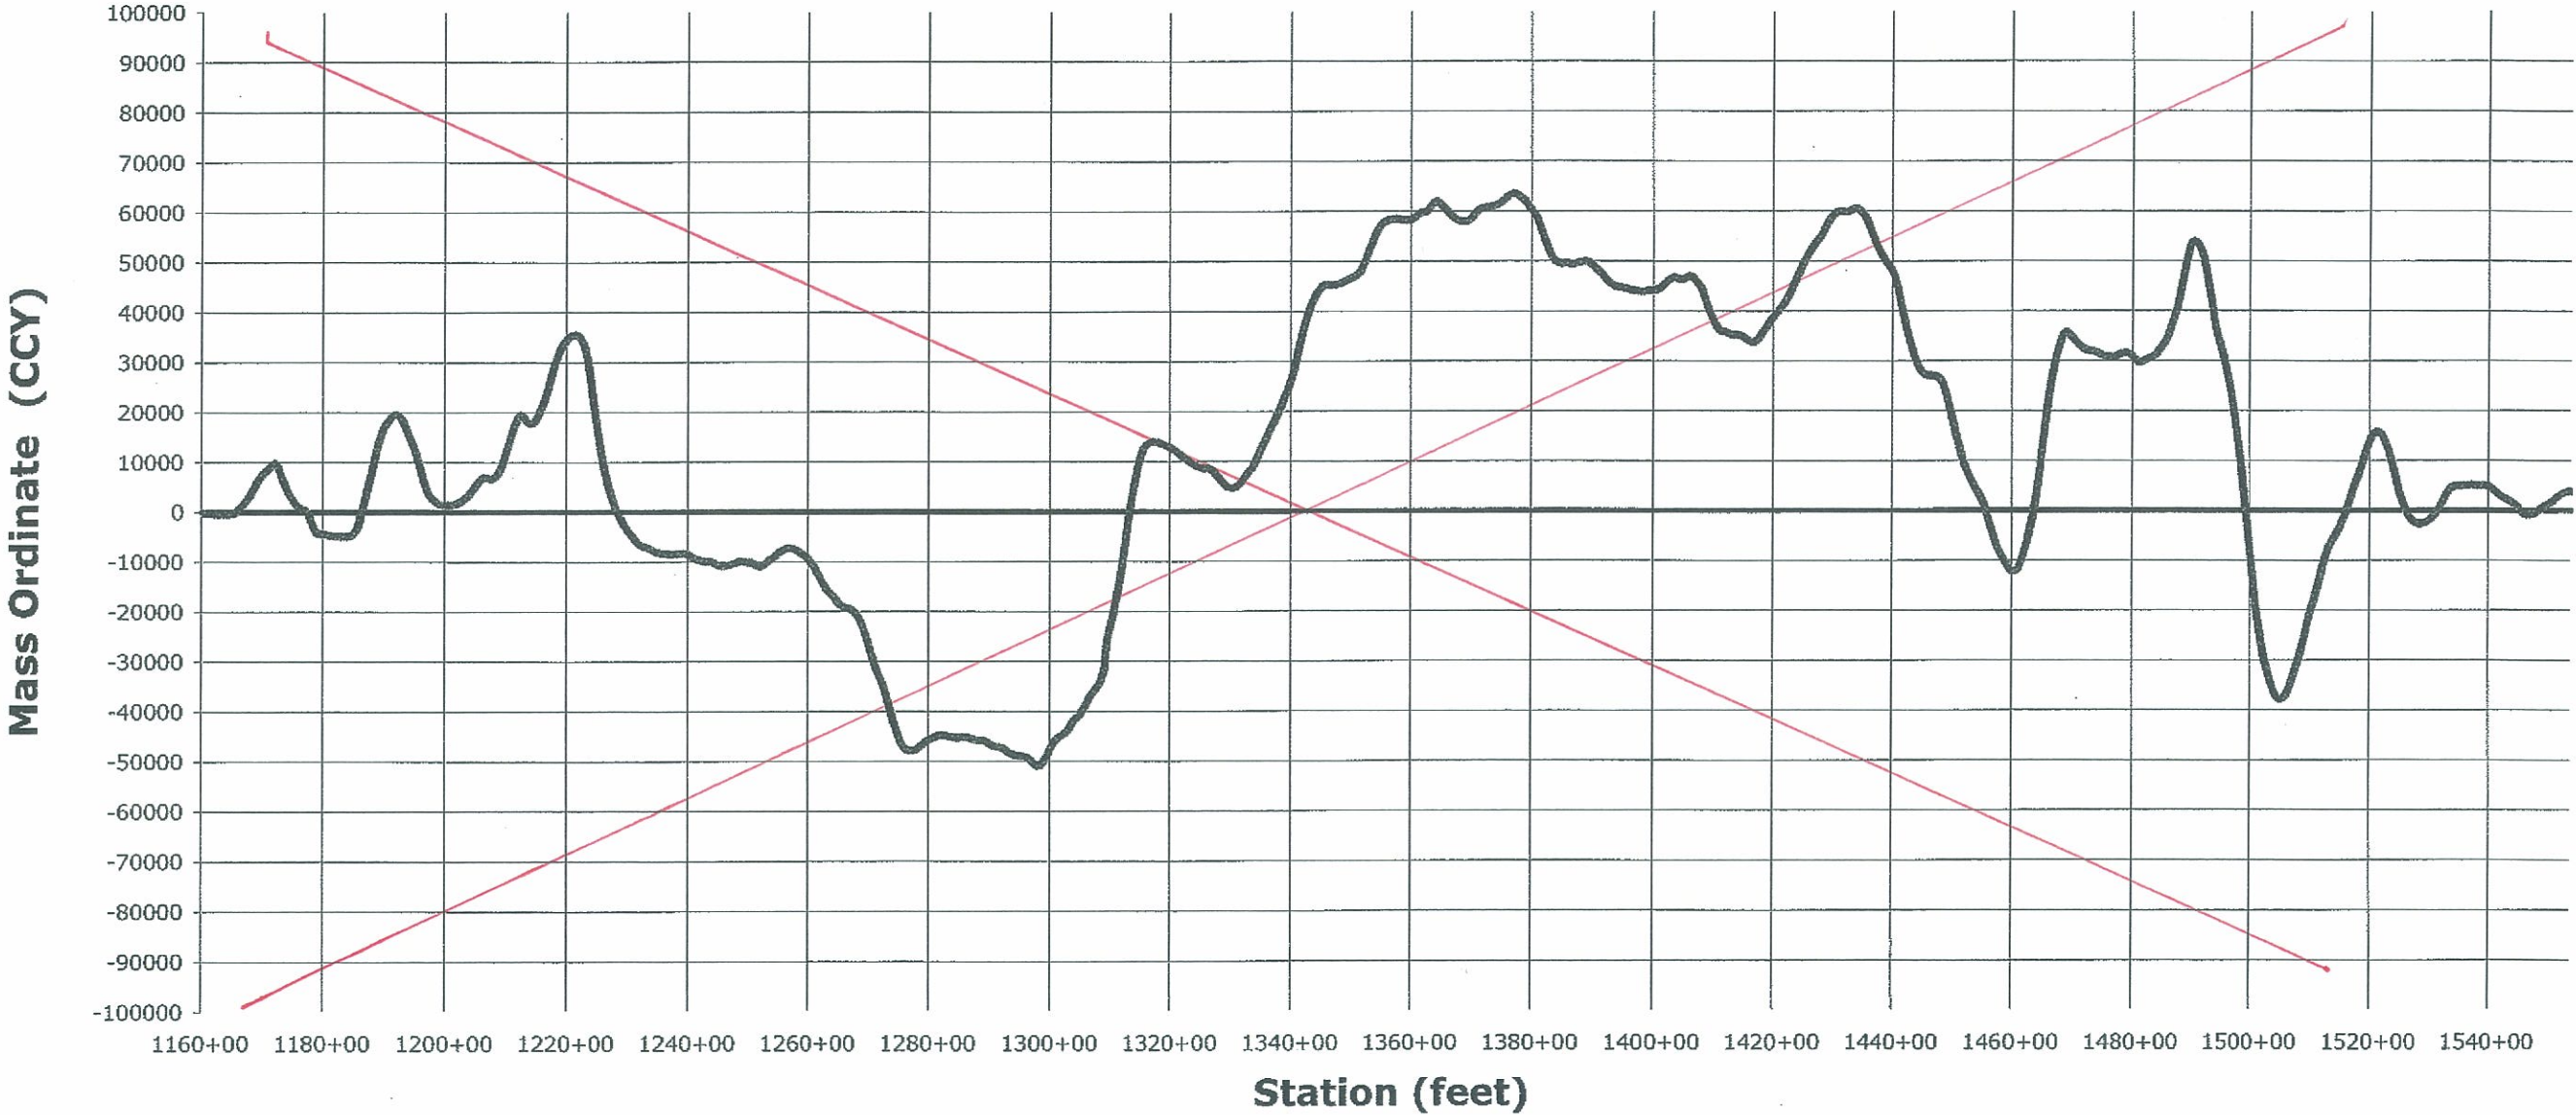


M:\proj\Lenzie\208009H\summarie\100% 200(2) grading sum C.x\is\MassHaul C

BRUCE H. MEYER
Licensed Professional Engineer
No. 6336-C
HAWAII, U.S.A.

The work was prepared by me or under my supervision and construction of this project will be in accordance with the Hawaii Engineering Code.

[Signature]
Expiration Date of License: 12/31/10

Revised Mass Diagram - Feb.15, 2011

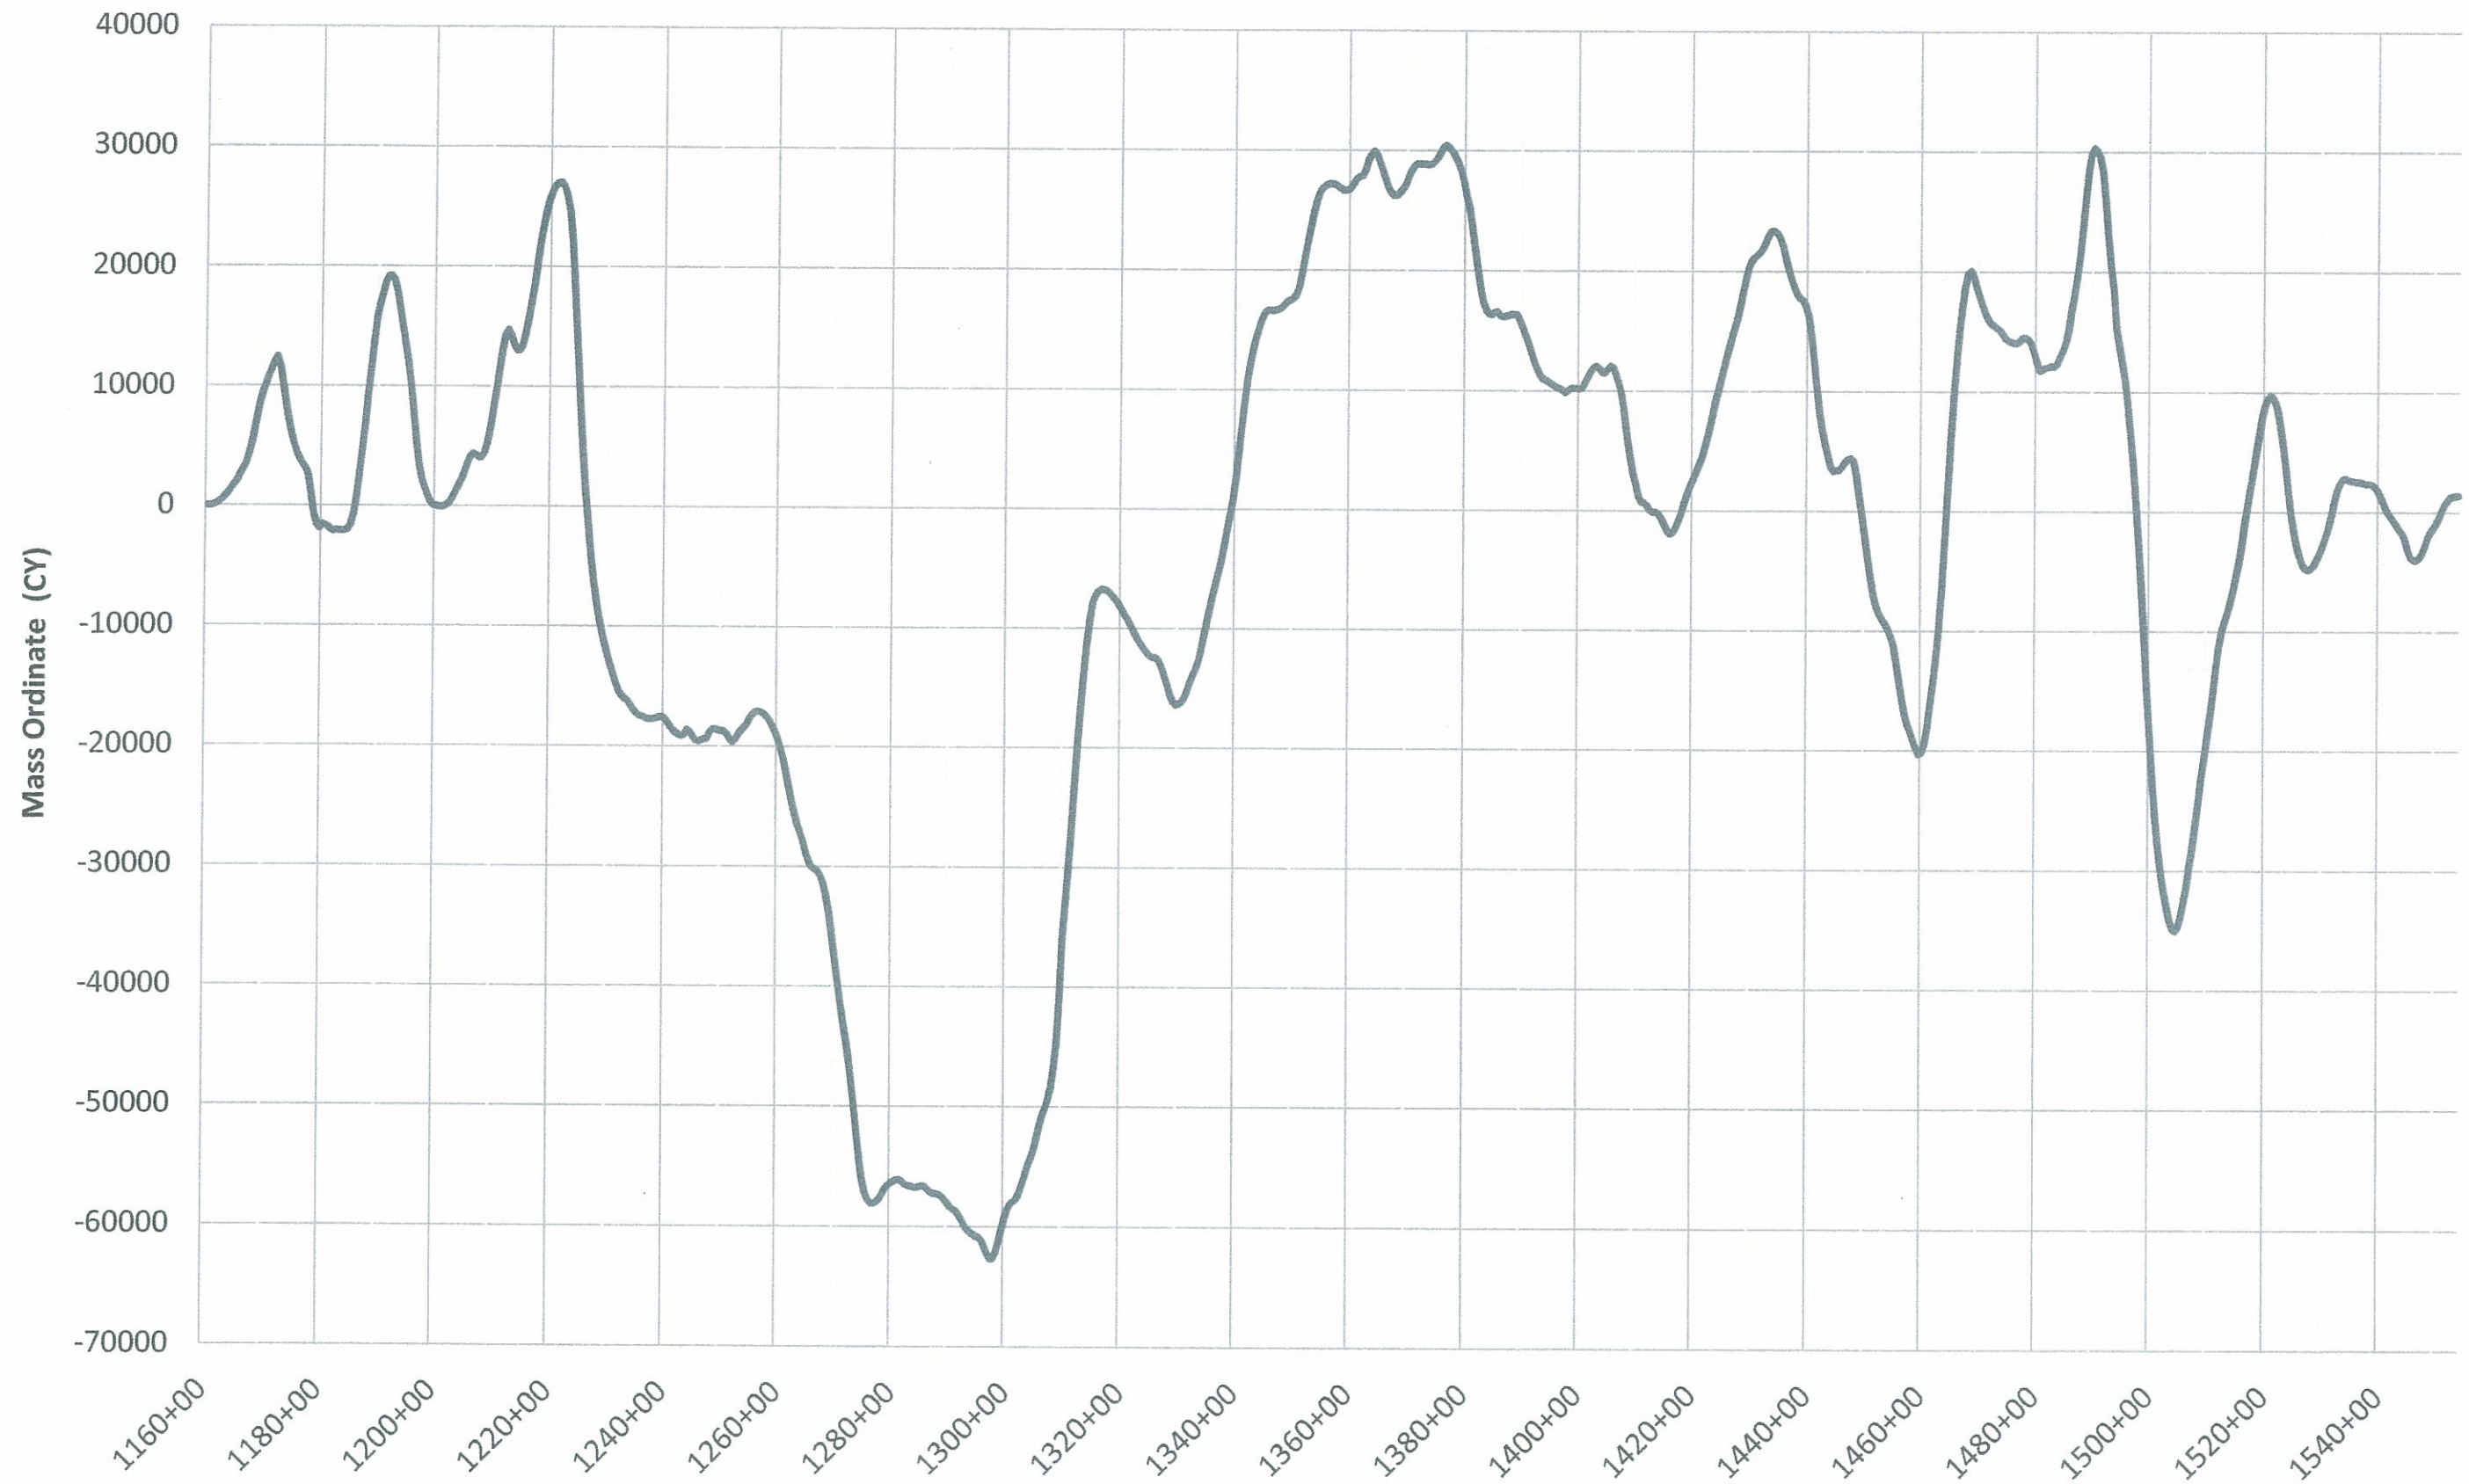

As BUILT C16