


STATE	SADDLE ROAD PROJECT	SHEET NO.	TOTAL SHEETS
HI	HI HP & TI 200(2)	B1	B14

TRUE NORTH  
SCALE: 1"=3000'

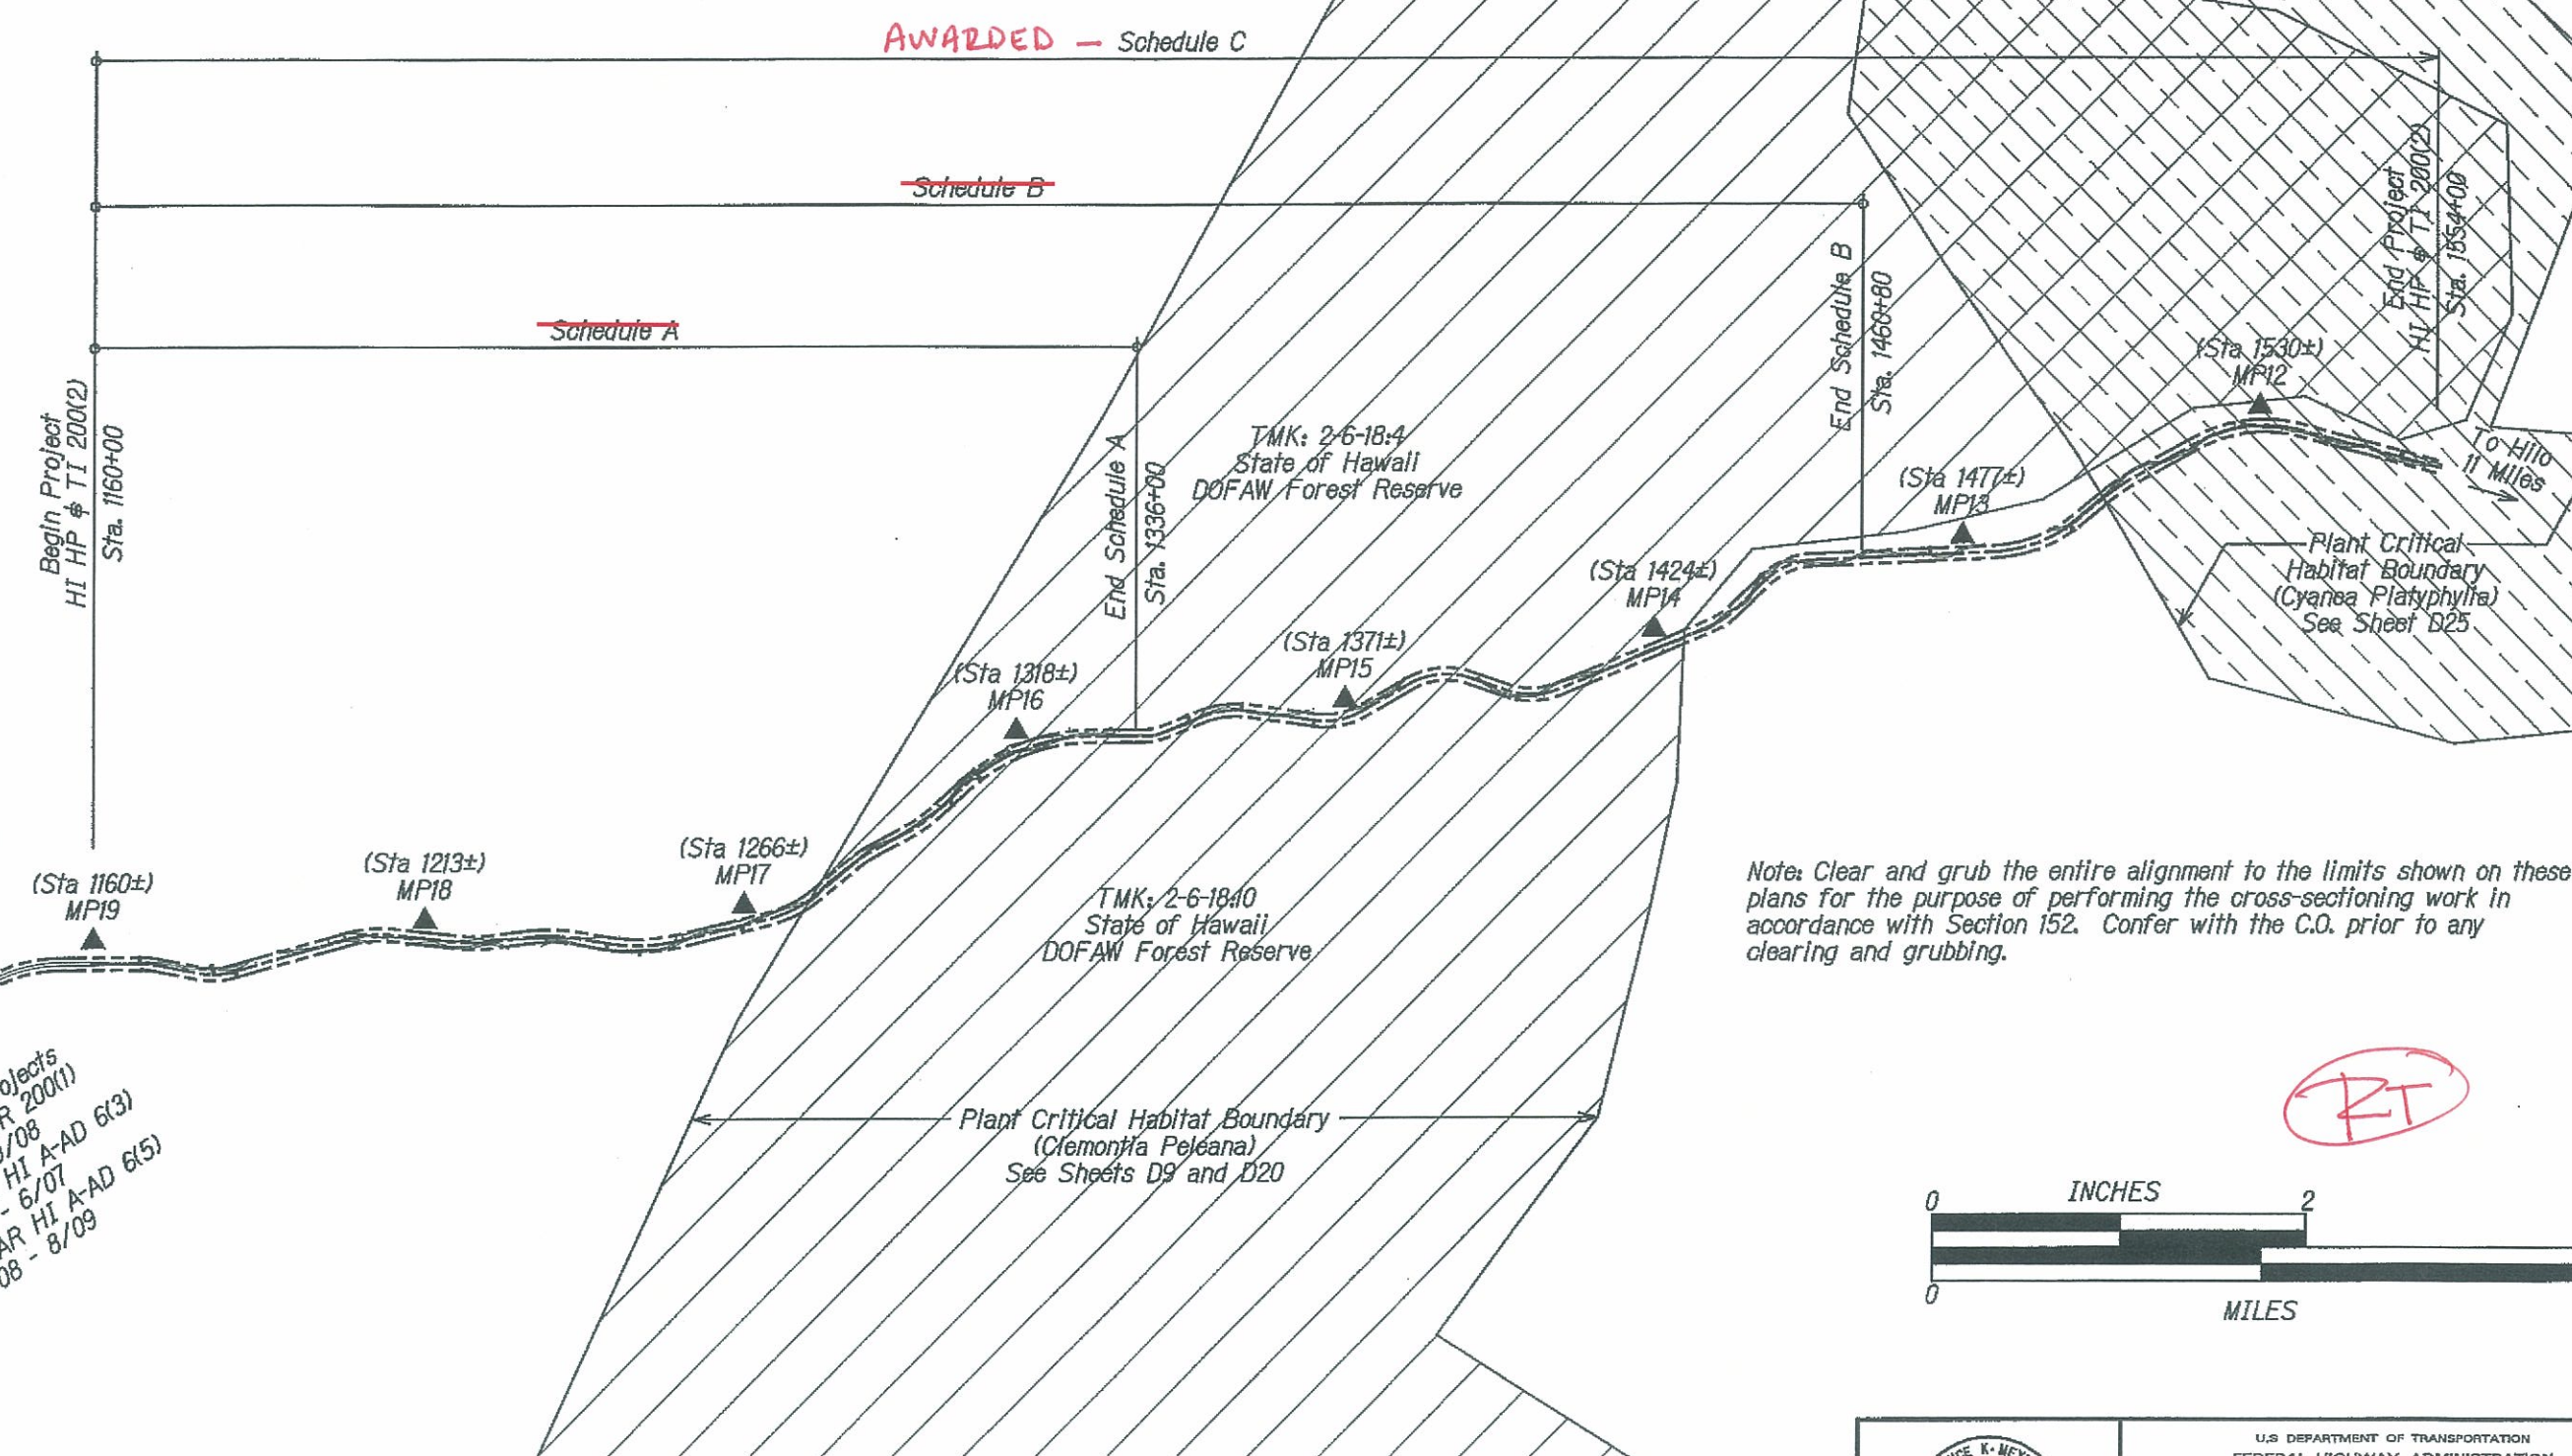


Note: Clear and grub the entire alignment to the limits shown on these plans for the purpose of performing the cross-sectioning work in accordance with Section 152. Confer with the C.O. prior to any clearing and grubbing.

PTA Quarry  
21 Miles  
See Sheets HI-H3  
To Waiimea  
43 Miles

Saddle Road Projects  
MP 19-28 HI SR 200(1)  
3/07 - 9/08  
MP 28-34 DAR HI A-AD 6(3)  
6/06 - 6/07  
MP 34-42 DAR HI A-AD 6(5)  
8/08 - 8/09

- LEGEND:**
- EAST ALIGNMENT
  - - - EAST ALIGNMENT ROW
  - EXISTING ROADS
  - PLANT CRITICAL HABITAT BOUNDARY  
REFER TO SHEETS D9, D20 & D25

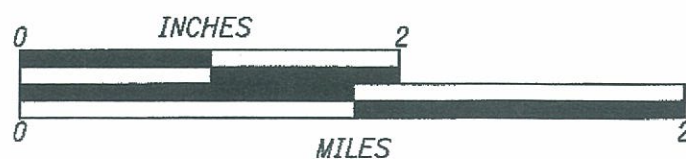

RT

BRUCE K. MEYERS  
Licensed Professional Engineer  
No. 8336-C  
HAWAII, U.S.A.

The work was prepared by me or under my supervision and construction of this project will be under my observation.

Expiration Date of License 3/31/10

U.S. DEPARTMENT OF TRANSPORTATION  
FEDERAL HIGHWAY ADMINISTRATION  
CENTRAL FEDERAL LANDS HIGHWAY DIVISION

**OVERALL SITE PLAN**

Scale: 1"=3000'      Date: June 5, 2009

SHEET No. 1 OF 1

M:\proj\Lenhle\208009H\sheet\shib001.dgn