
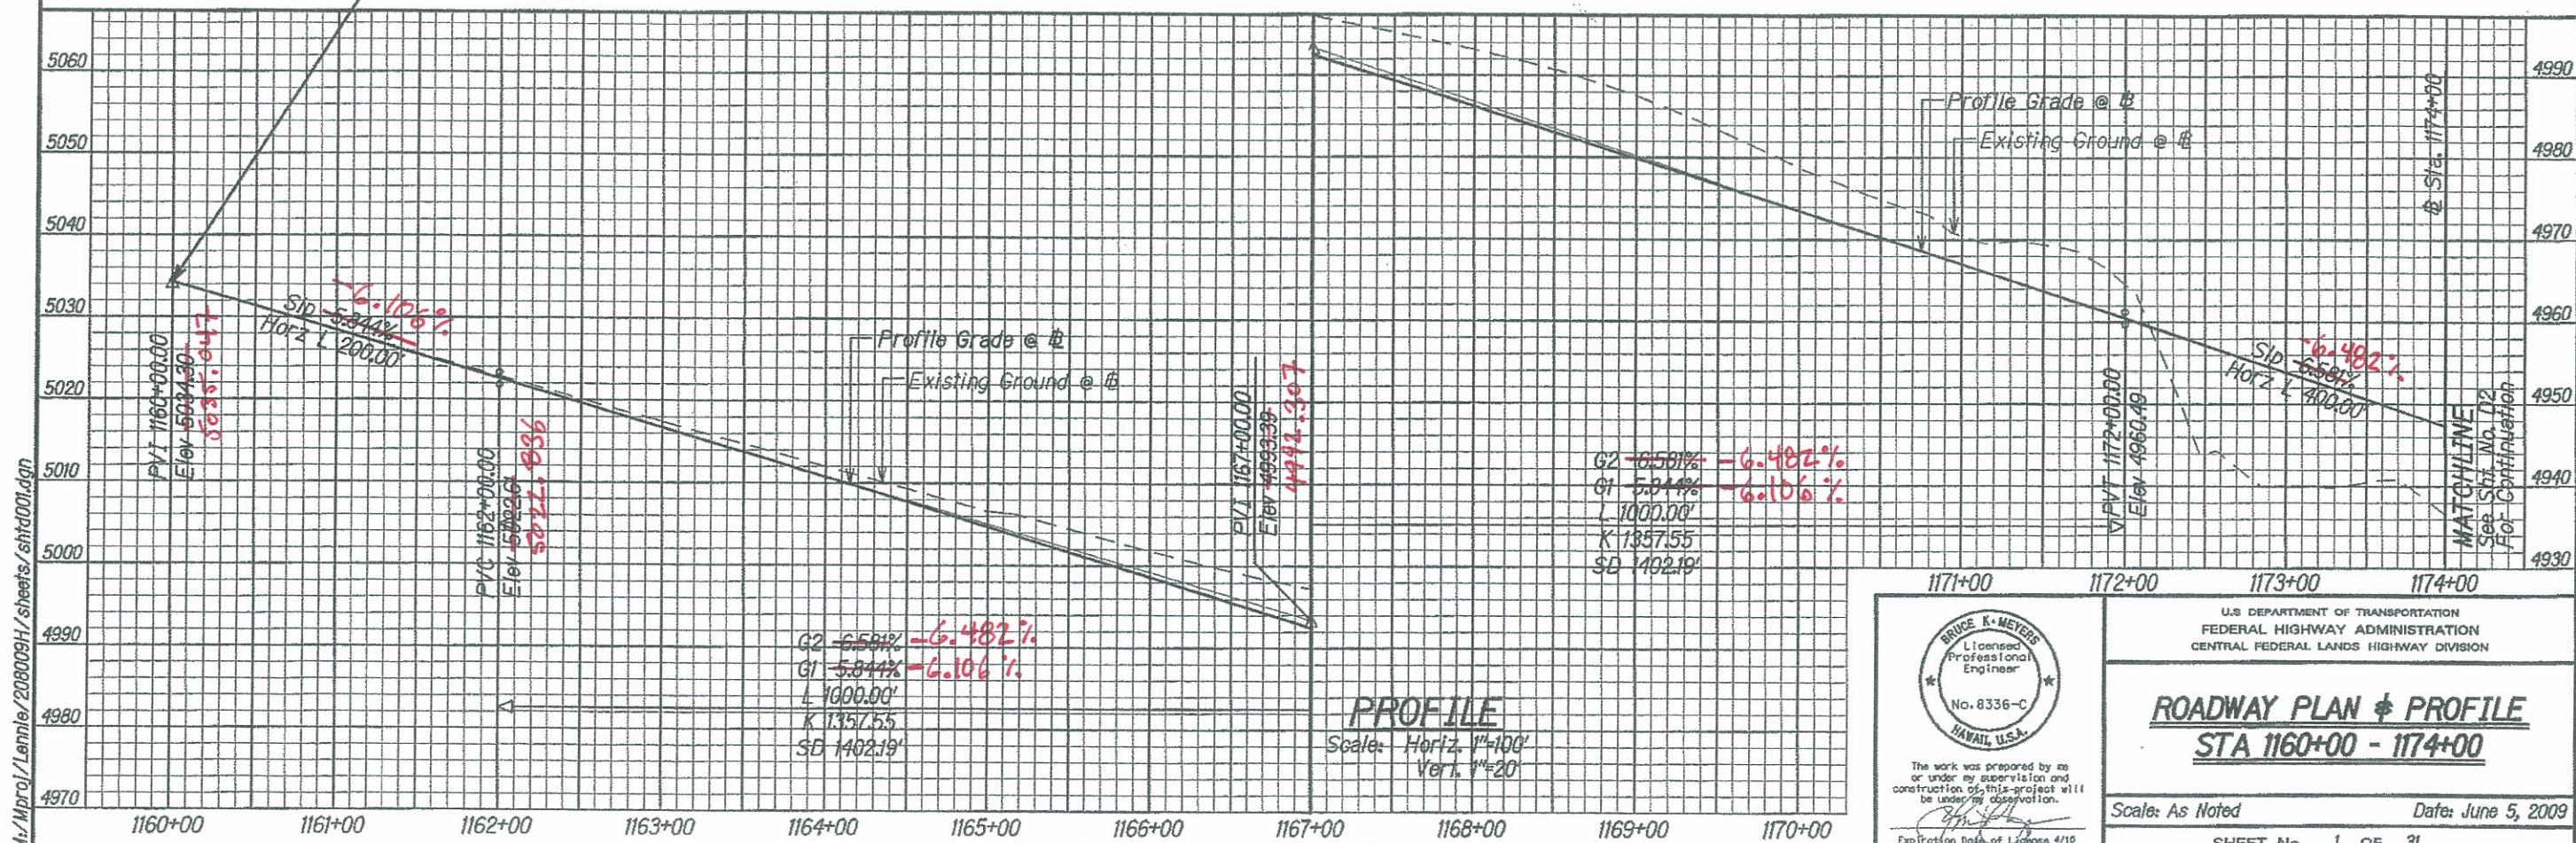


| STATE | SADDLE ROAD PROJECT | SHEET NO. | TOTAL SHEETS |
|-------|---------------------|-----------|--------------|
| HI    | HI HP & TI 200(2)   | D1        | D31          |

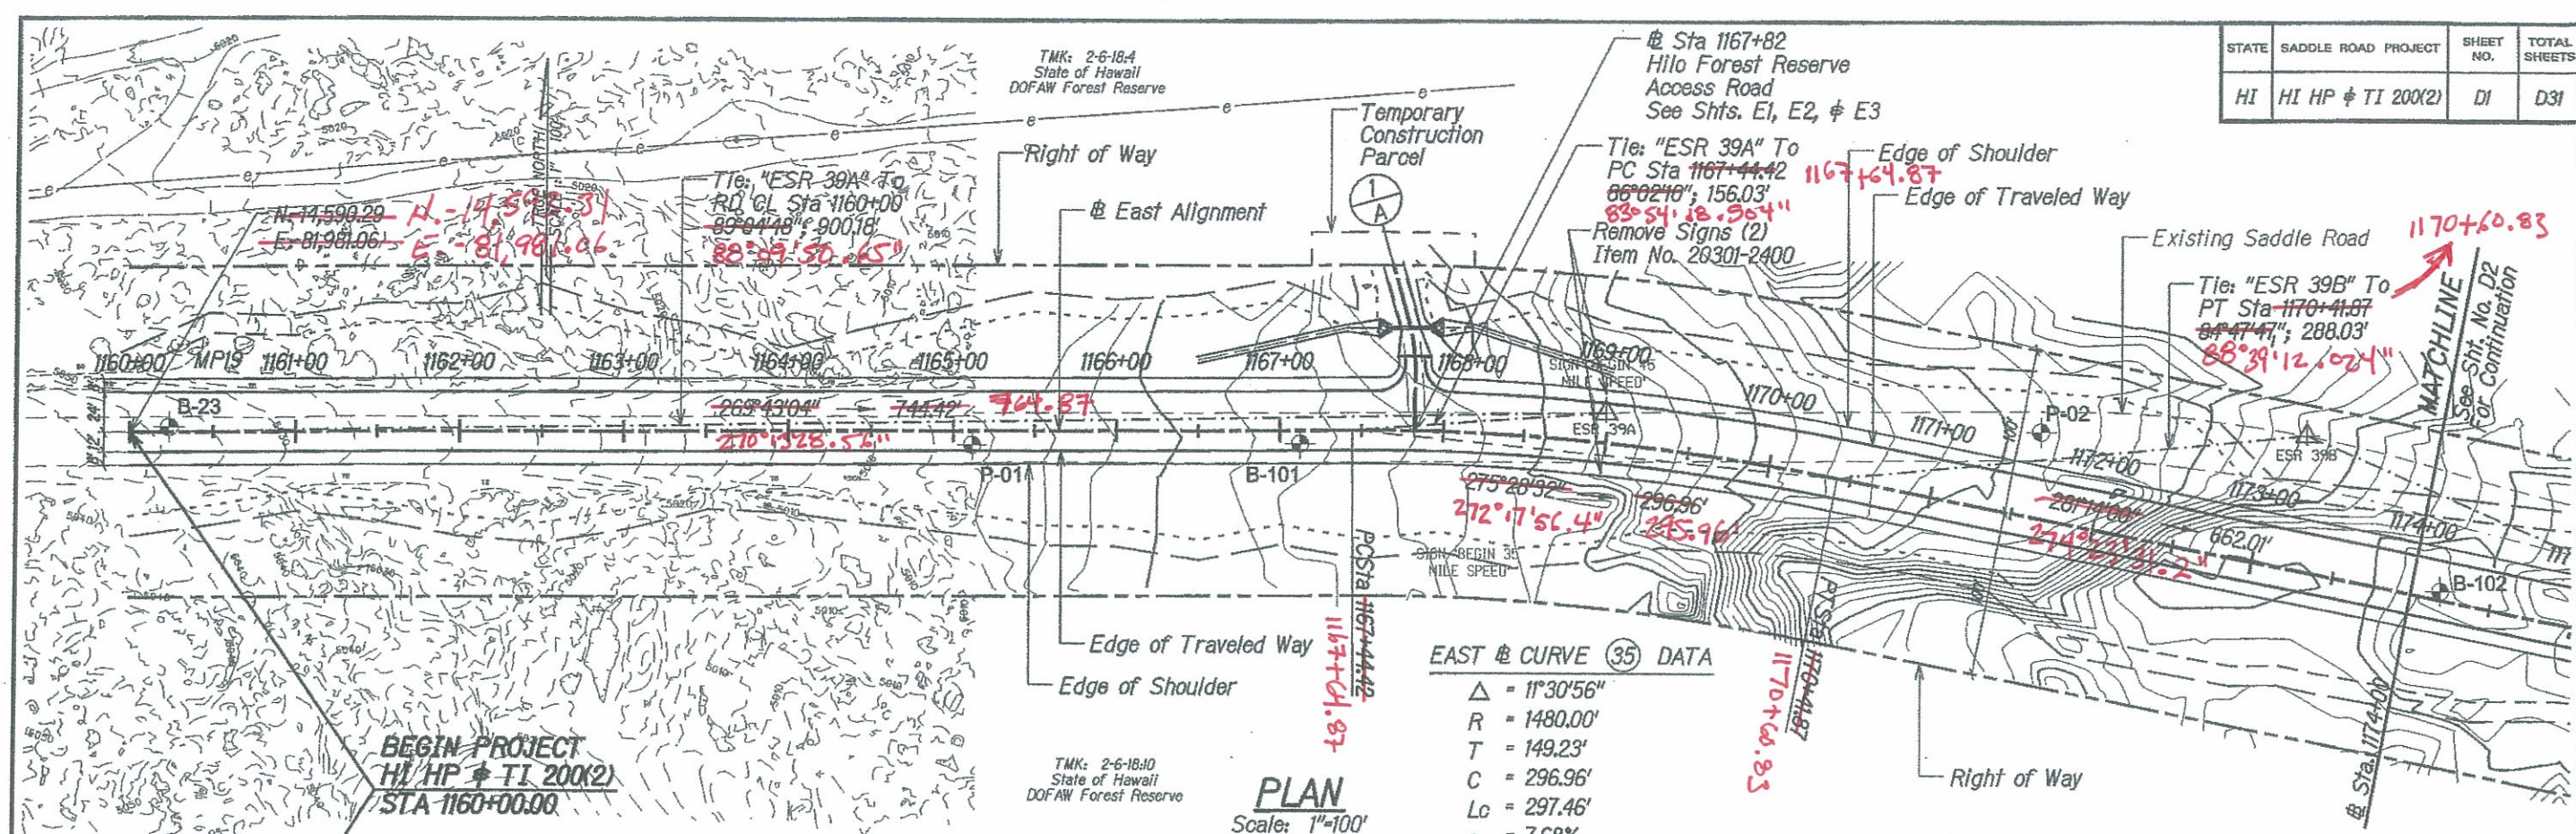

BRUCE K. MEYERS  
Licensed Professional Engineer  
No. 8336-C  
HAWAII, U.S.A.

The work was prepared by me or under my supervision and construction of this project will be under my observation.

Expiration Date of License 4/15.

U.S. DEPARTMENT OF TRANSPORTATION  
FEDERAL HIGHWAY ADMINISTRATION  
CENTRAL FEDERAL LANDS HIGHWAY DIVISION



**ROADWAY PLAN & PROFILE**  
**STA 1160+00 - 1174+00**

Scale: As Noted      Date: June 5, 2009

SHEET No. 1 OF 31





| STATE | SADDLE ROAD PROJECT | SHEET NO. | TOTAL SHEETS |
|-------|---------------------|-----------|--------------|
| HI    | HI HP & TI 200(2)   | D2        | D31          |

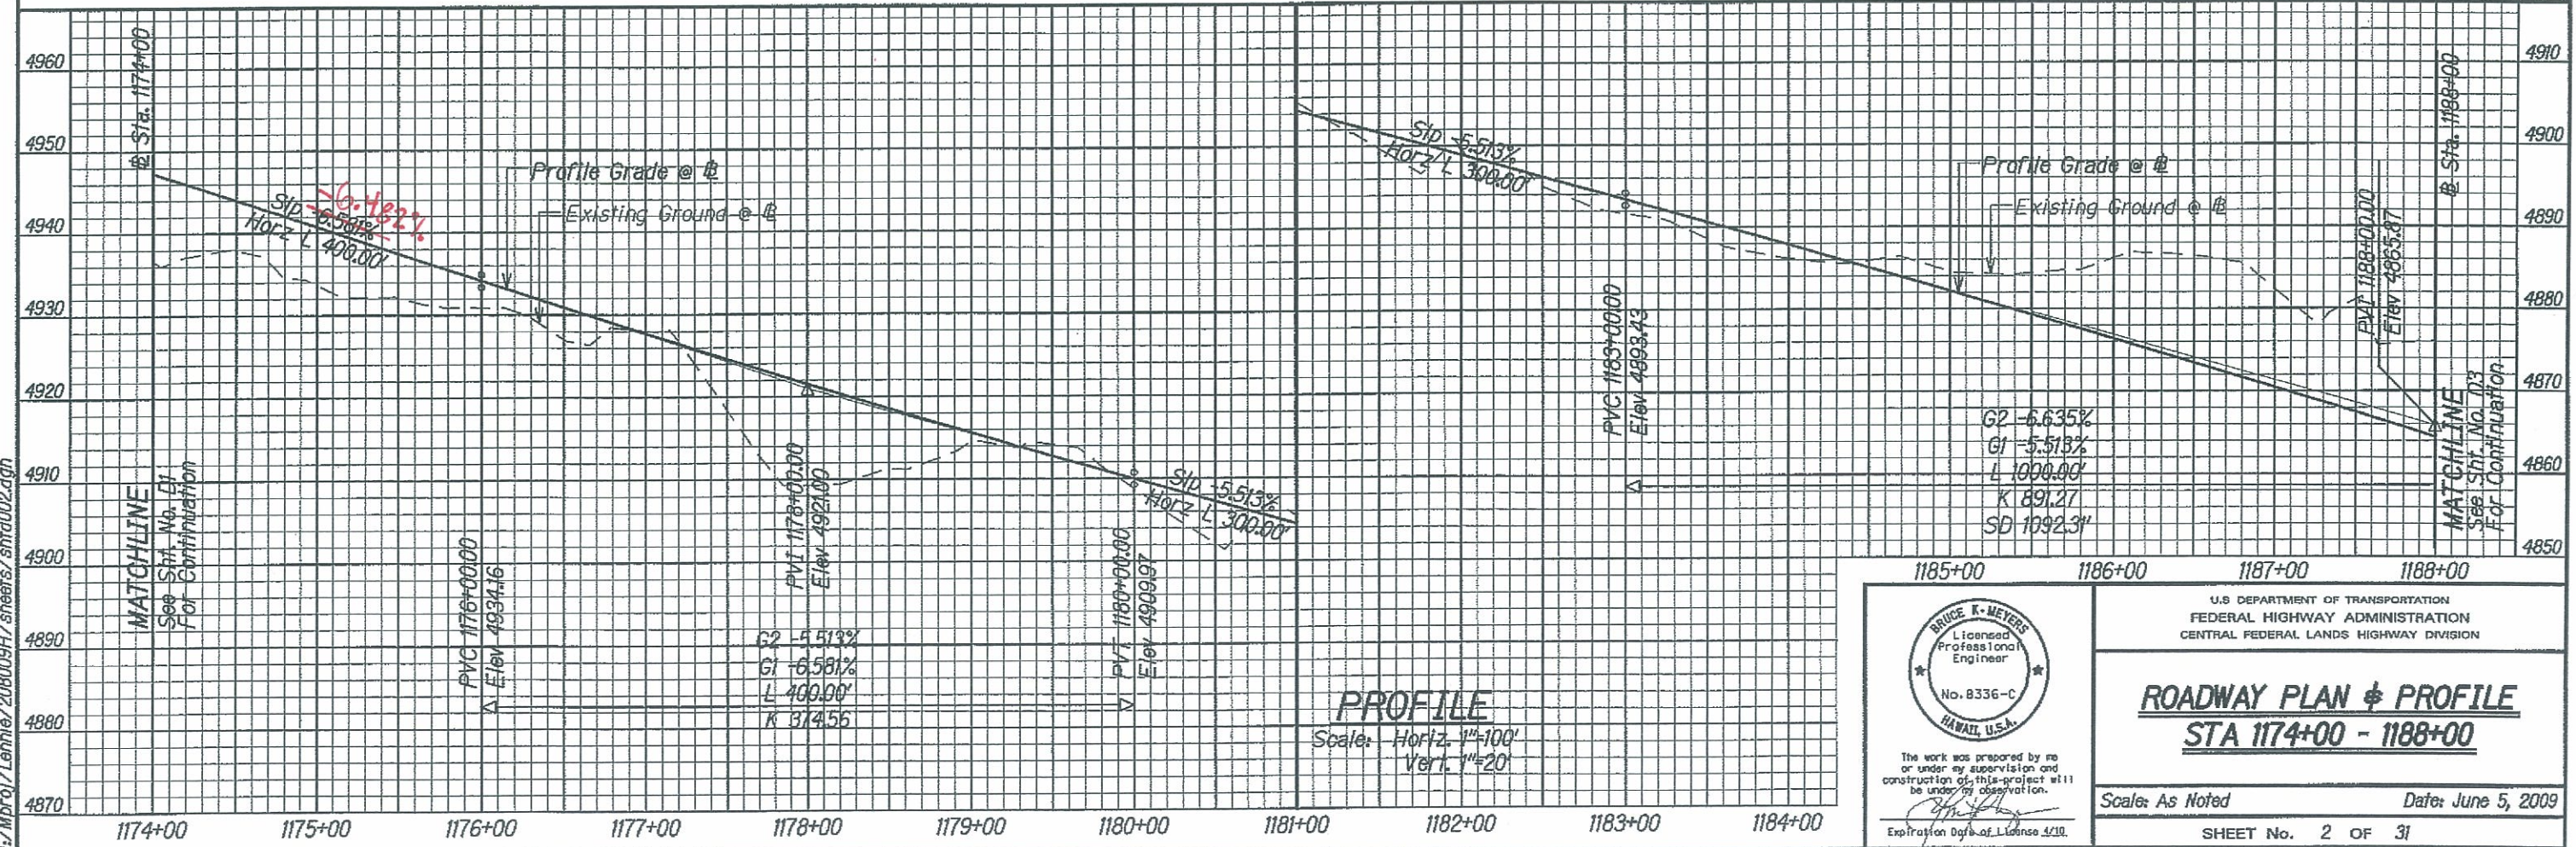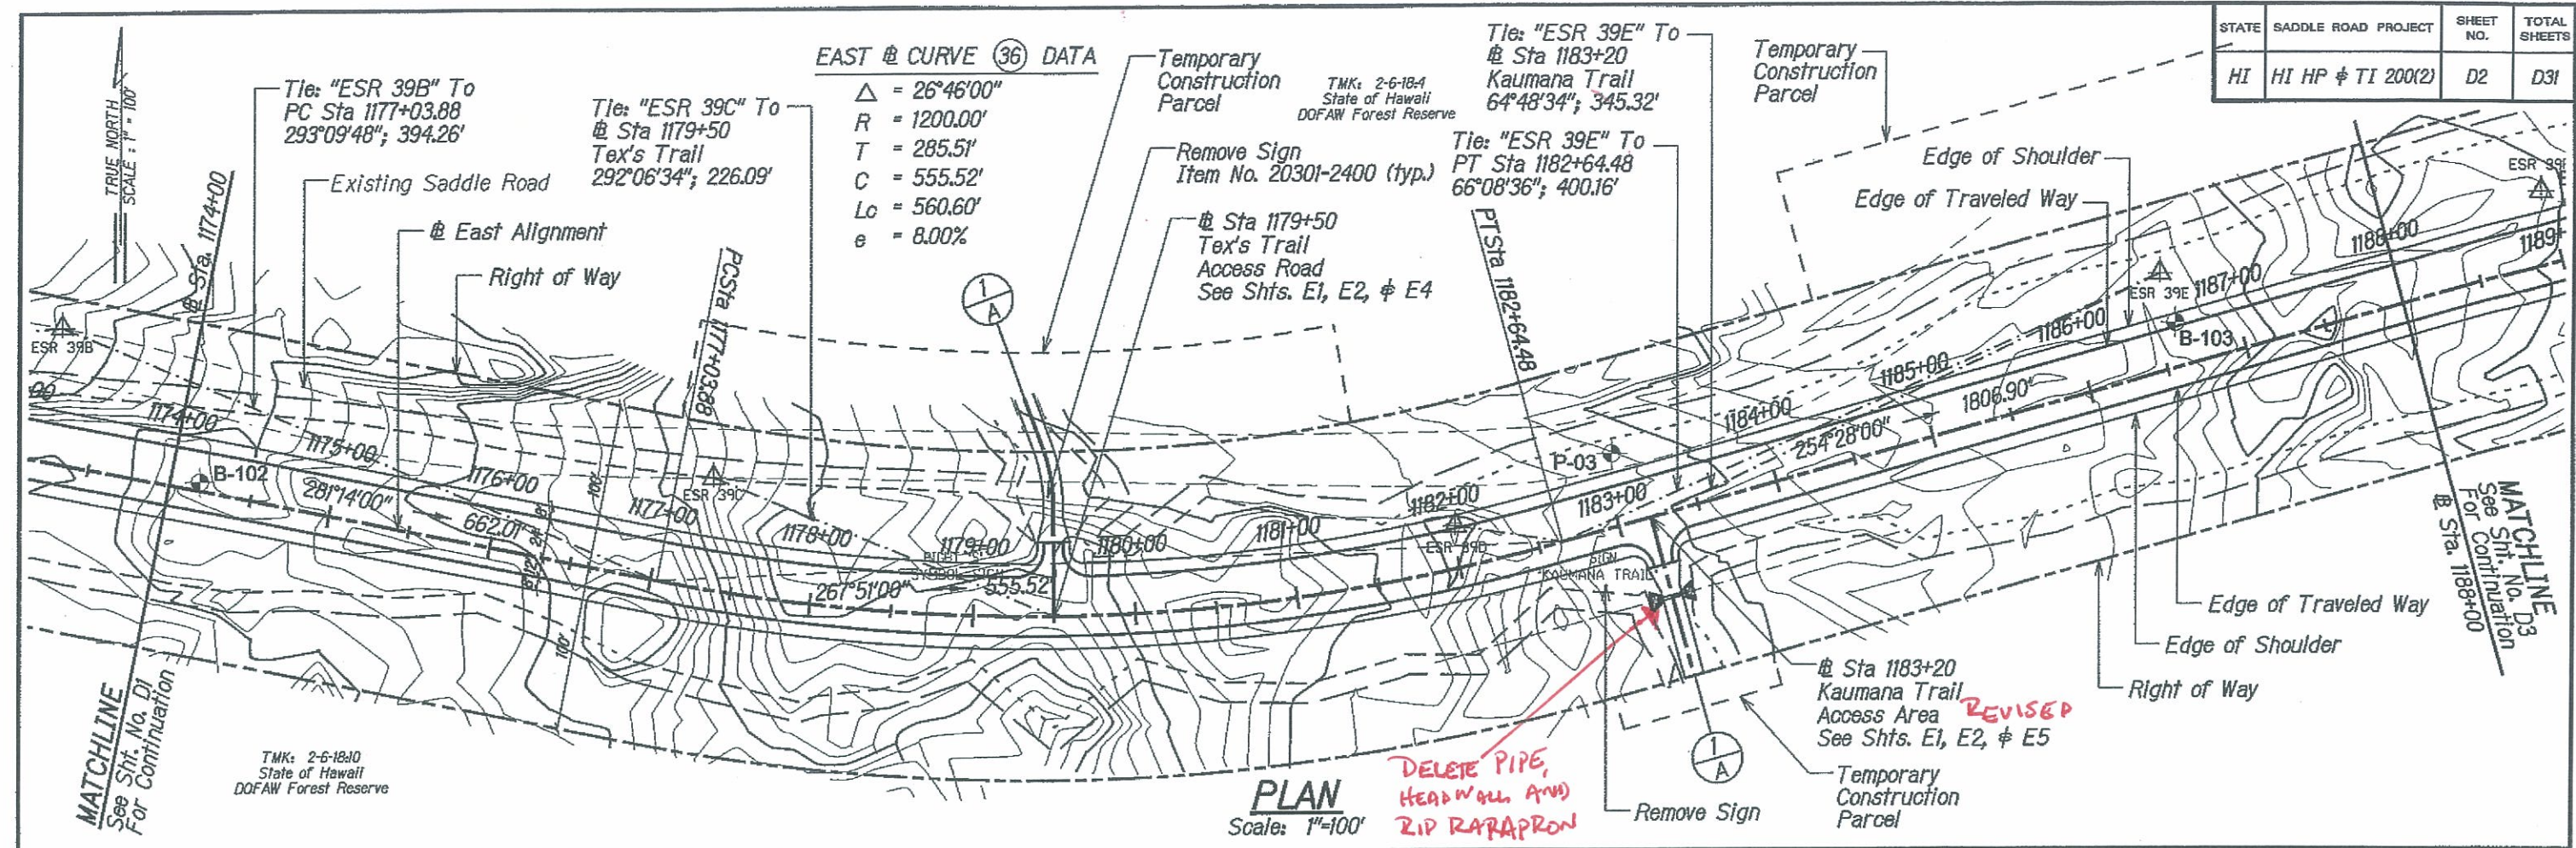

M:\Mpro\Lenile\208009H\sheet\shd002.dgn




| STATE | SADDLE ROAD PROJECT | SHEET NO. | TOTAL SHEETS |
|-------|---------------------|-----------|--------------|
| HI    | HI HP & TI 200(2)   | D3        | D31          |

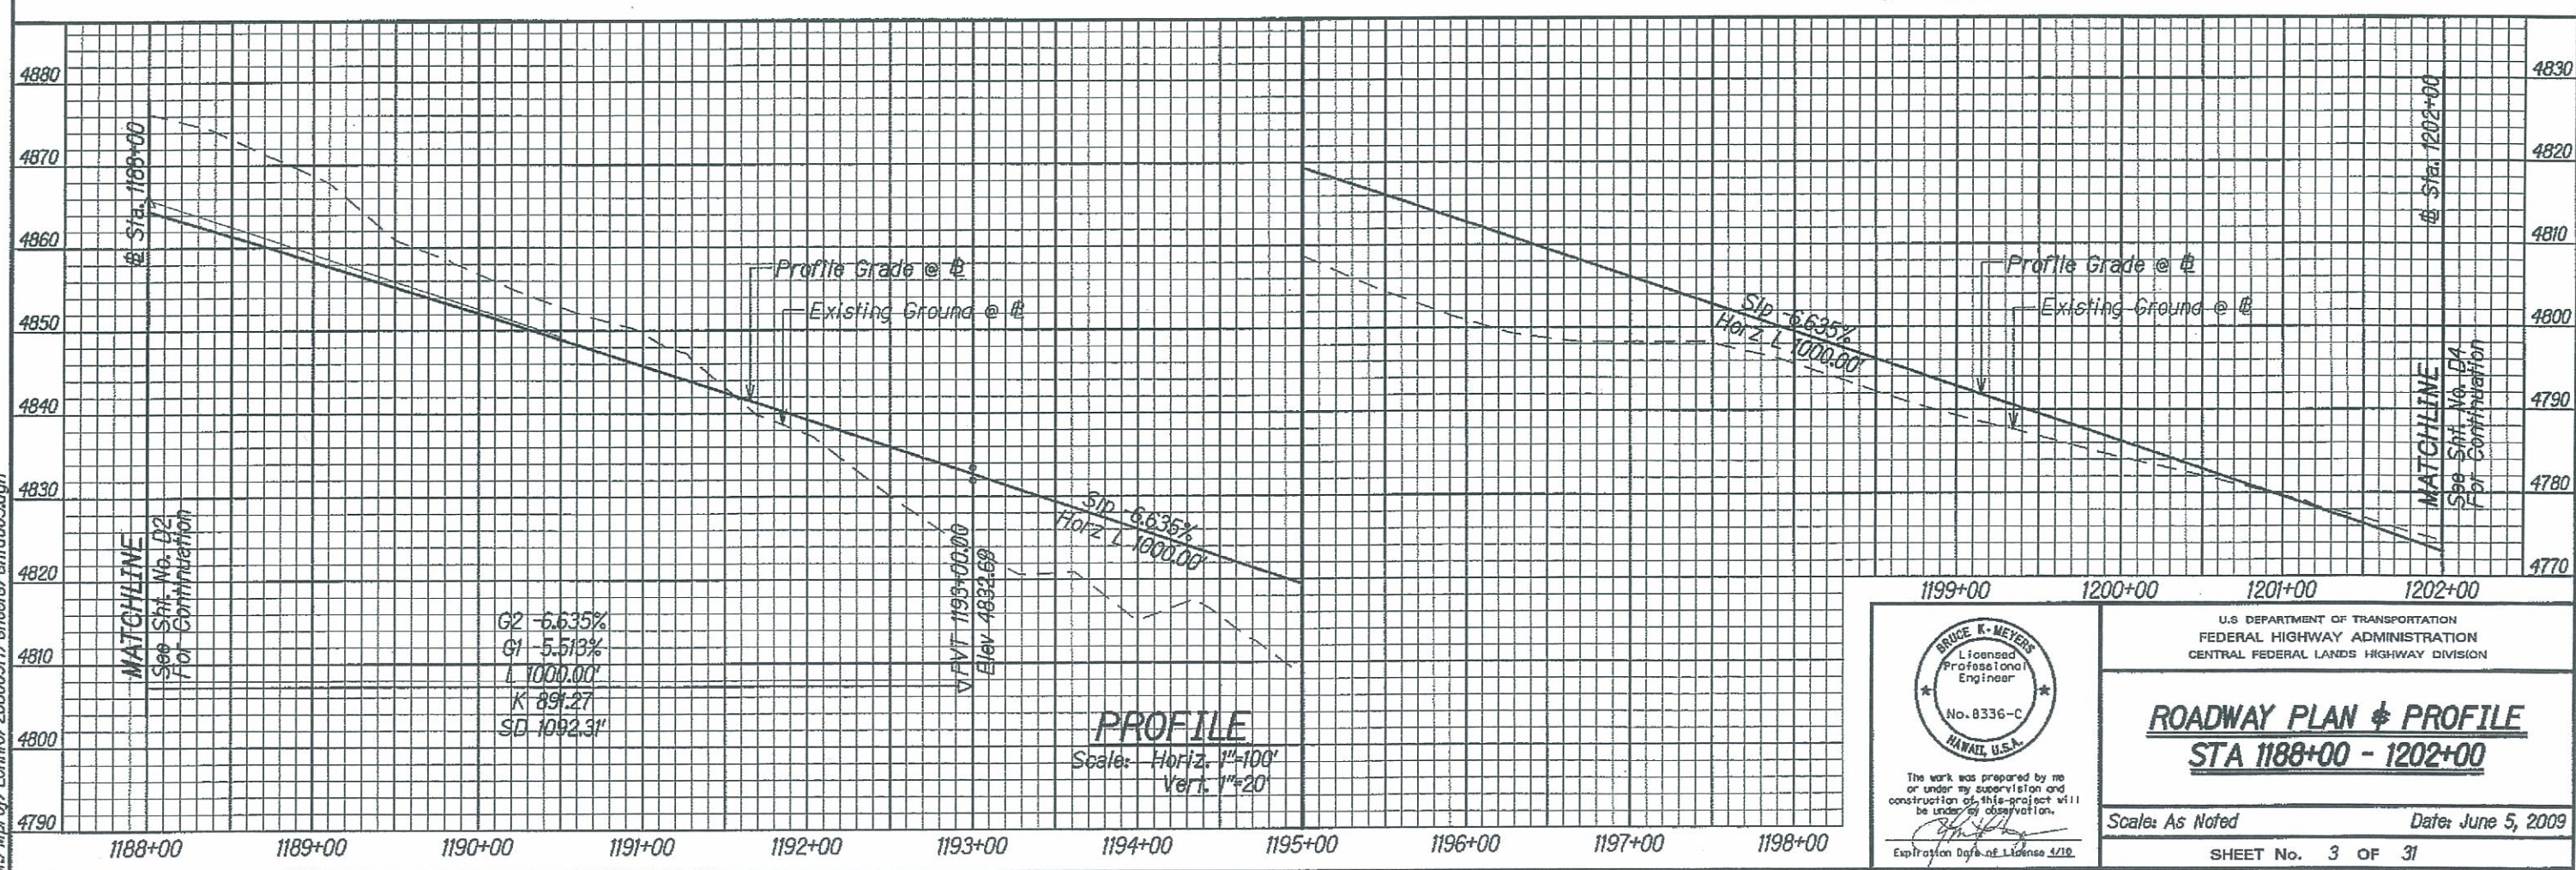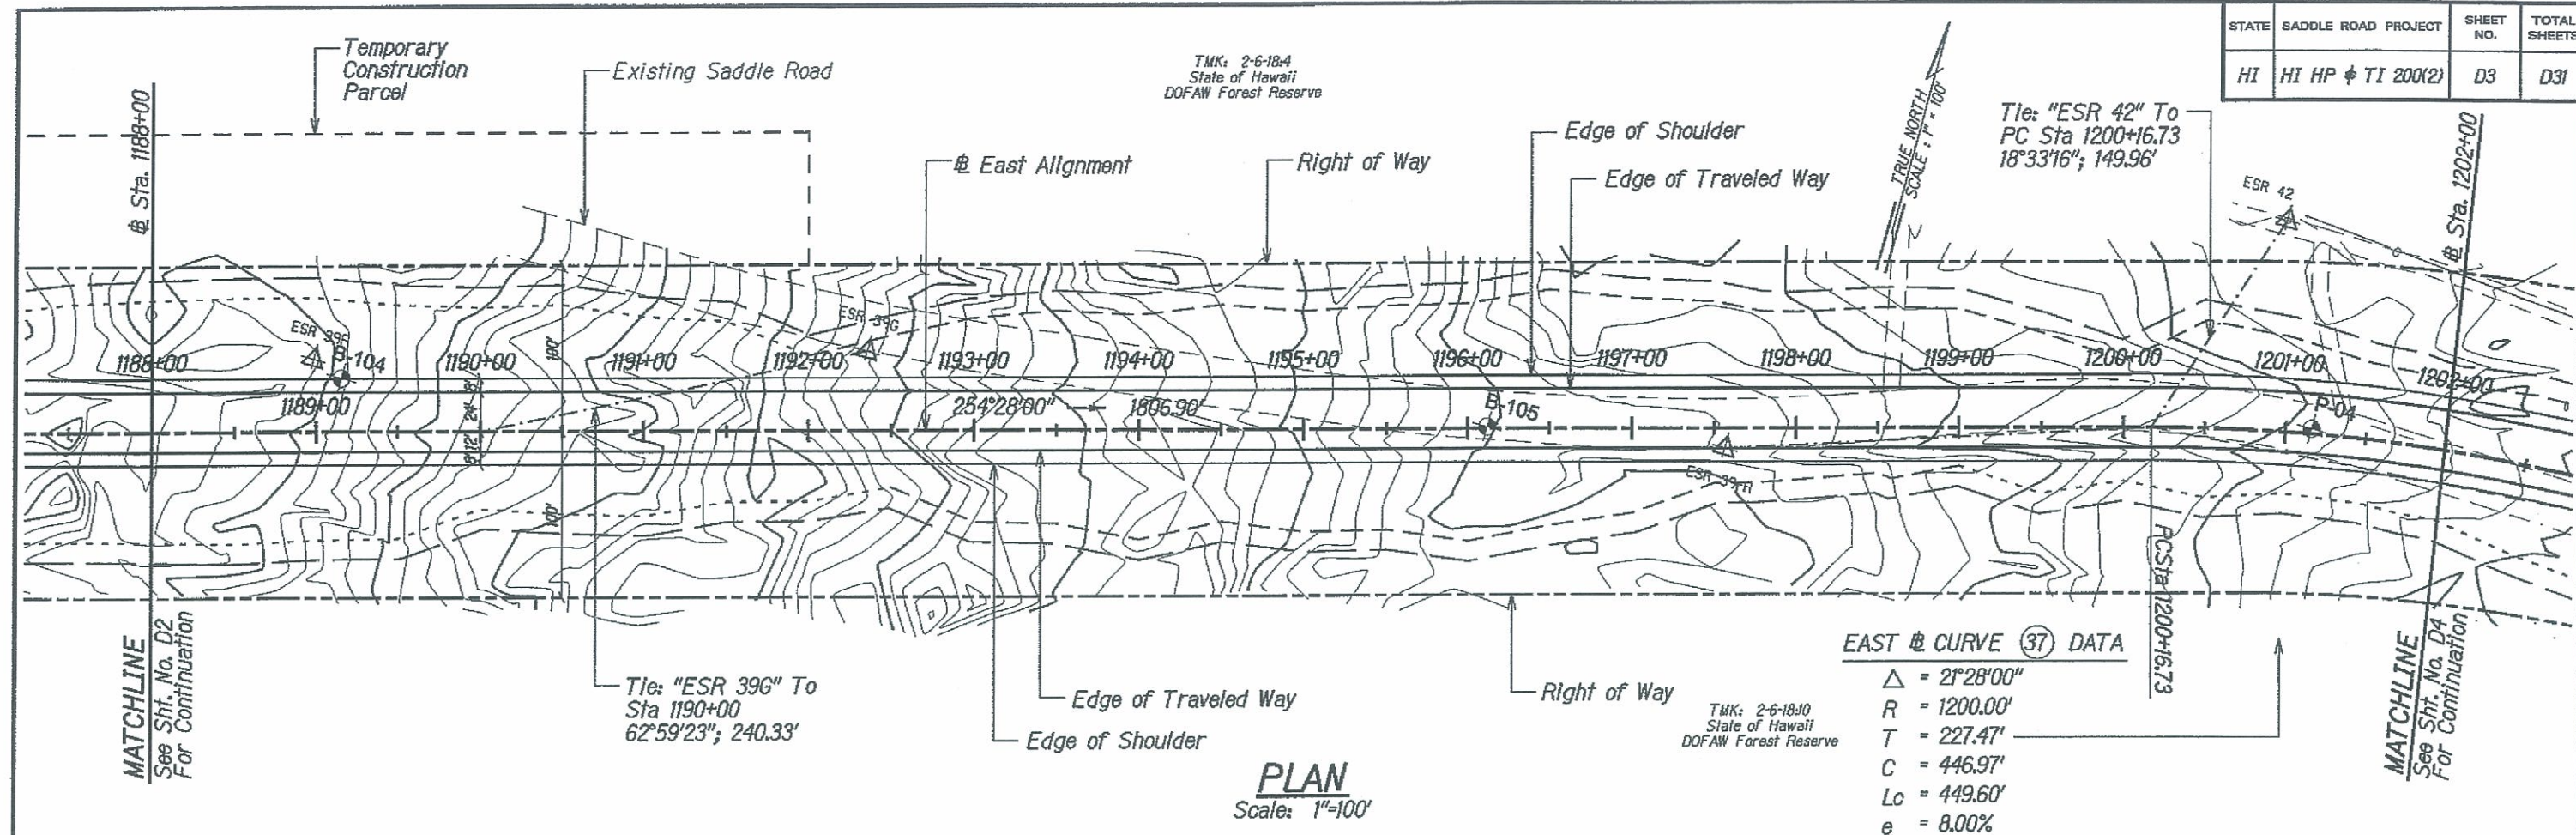


M:\Mproj\Leante\200809H\sheet\shd003.dgn



| STATE | SADDLE ROAD PROJECT | SHEET NO. | TOTAL SHEETS |
|-------|---------------------|-----------|--------------|
| HI    | HI HP & TI 200(2)   | D4        | D31          |

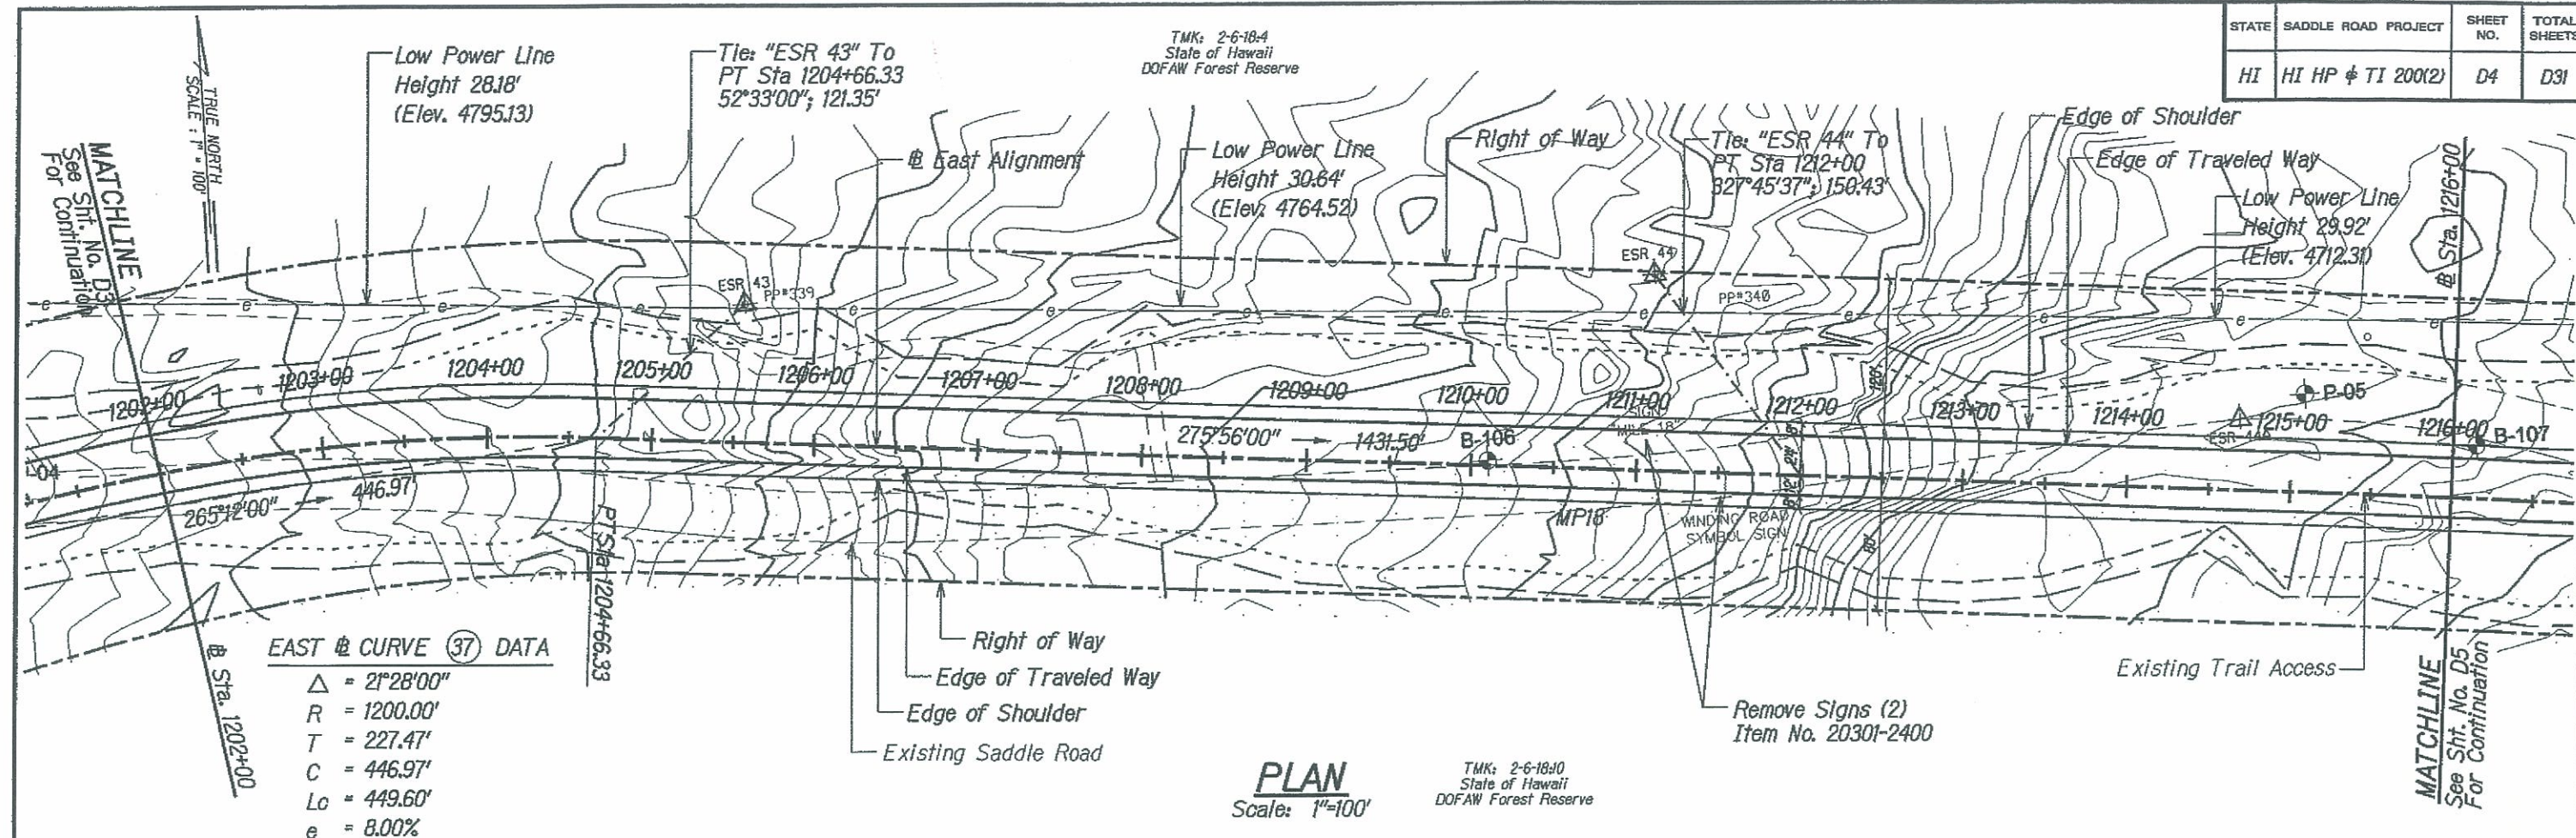

**PLAN**  
Scale: 1"=100'

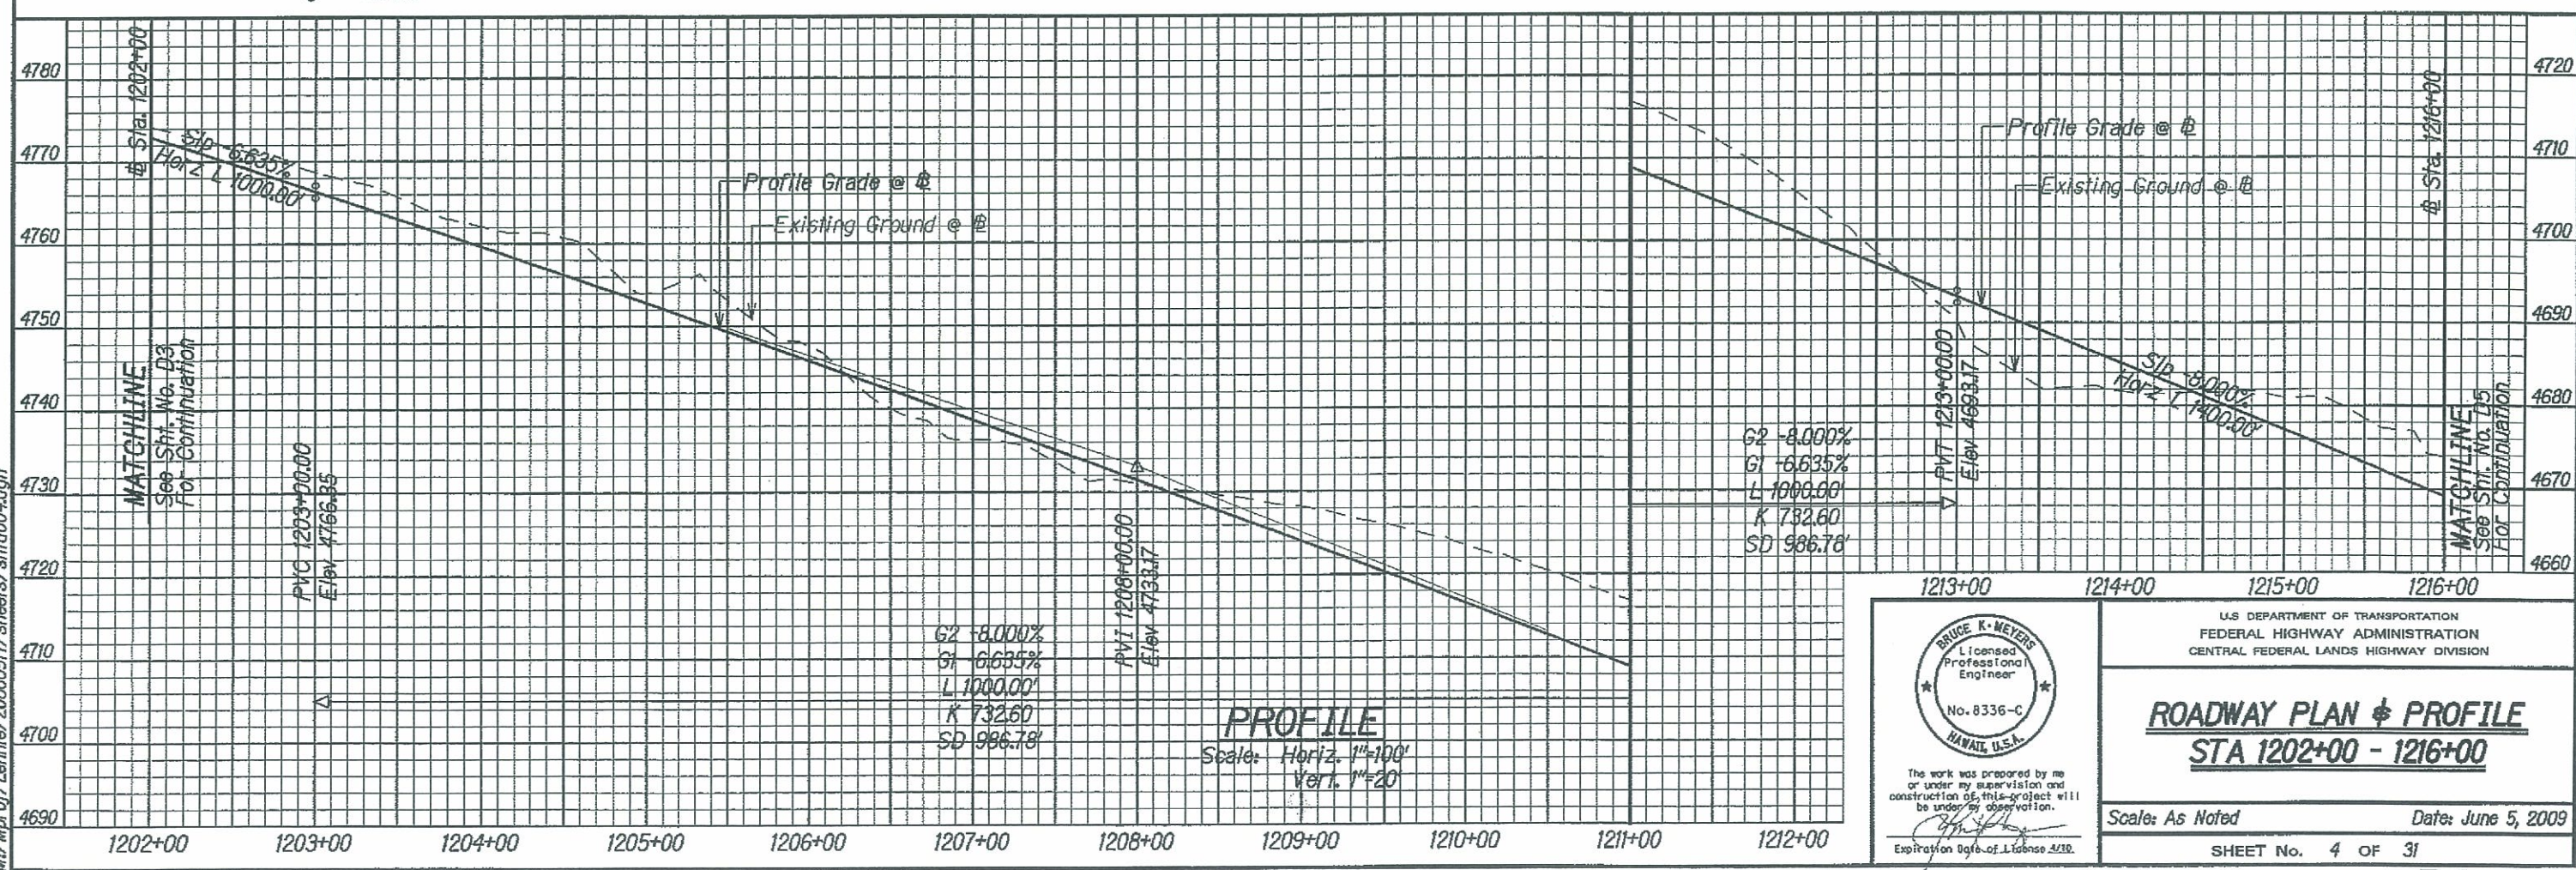

**PROFILE**  
Scale: Horiz. 1"=100'  
Vert. 1"=20'

BRUCE K. MEYERS  
Licensed Professional Engineer  
No. 8336-C  
HAWAII, U.S.A.

The work was prepared by me or under my supervision and construction of this project will be under my observation.

Expiration Date of License 12/31/10

U.S. DEPARTMENT OF TRANSPORTATION  
FEDERAL HIGHWAY ADMINISTRATION  
CENTRAL FEDERAL LANDS HIGHWAY DIVISION

**ROADWAY PLAN & PROFILE**  
**STA 1202+00 - 1216+00**

Scale: As Noted      Date: June 5, 2009

SHEET No. 4 OF 31

**D4**



M:\Mproj\Lenhle\208009H\sheet\shid004.dgn







| STATE | SADDLE ROAD PROJECT | SHEET NO. | TOTAL SHEETS |
|-------|---------------------|-----------|--------------|
| HI    | HI HP & TI 200(2)   | D6        | D31          |

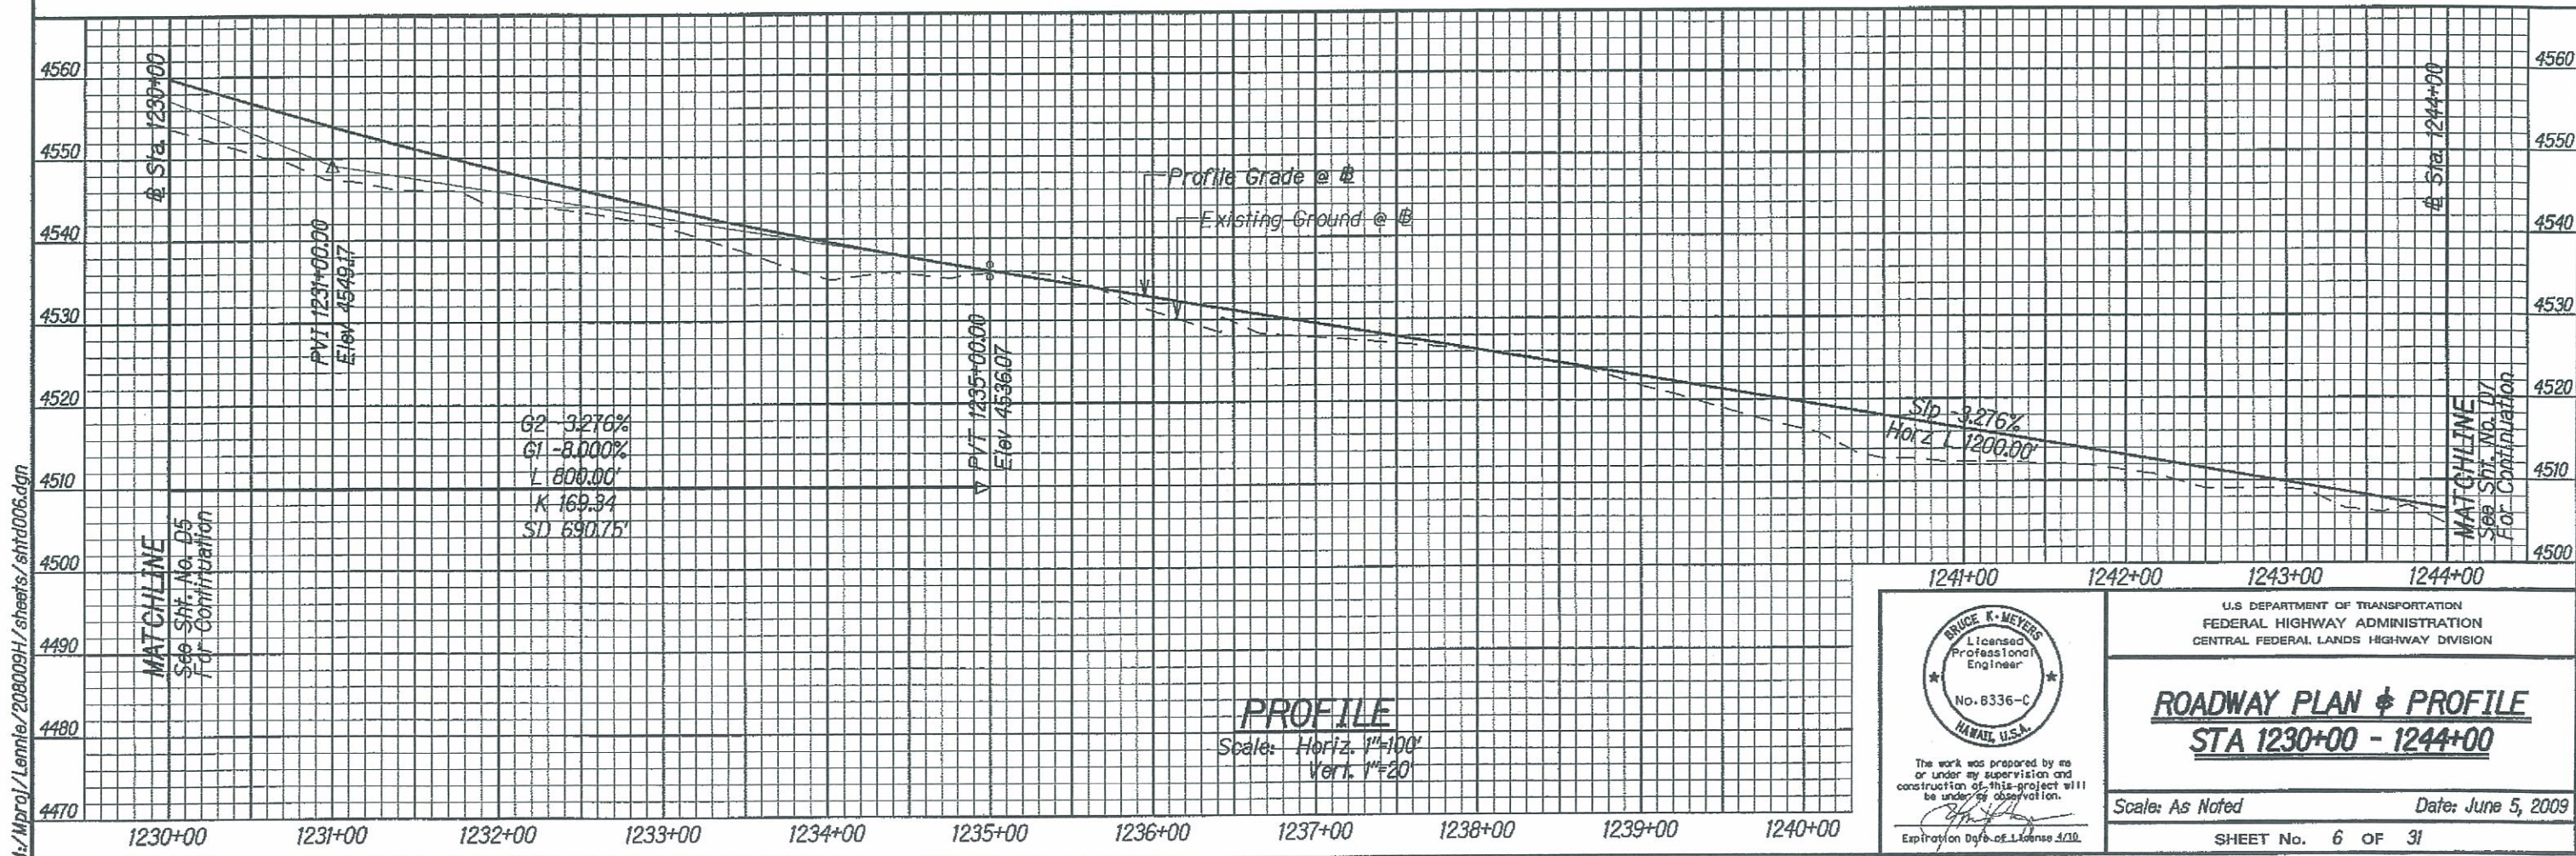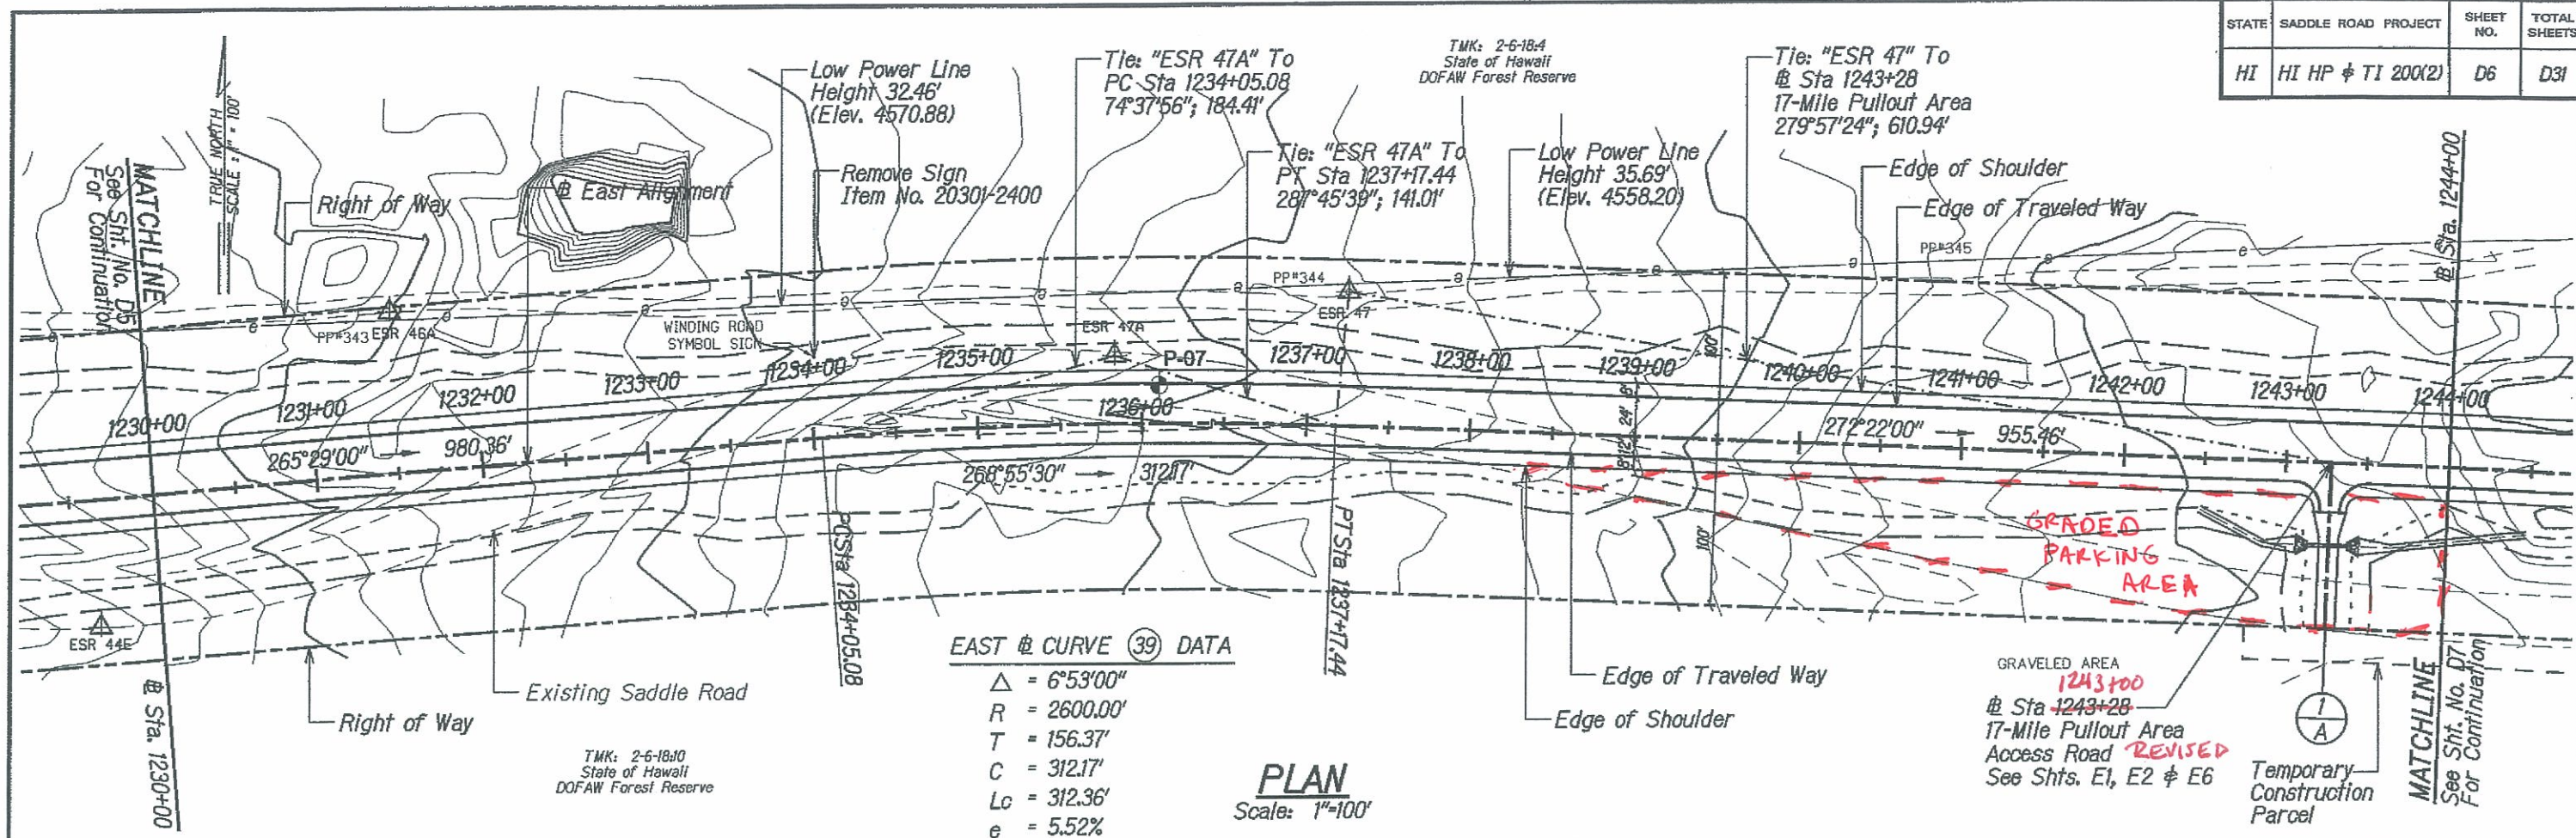



REVISED 07/14/09  
AMENDMENT A002


| STATE | SADDLE ROAD PROJECT | SHEET NO. | TOTAL SHEETS |
|-------|---------------------|-----------|--------------|
| HI    | HI HP & TI 200(2)   | D7        | D31          |

# EAST @ CURVE (40) DATA


$\Delta = 15^{\circ}55'00''$   
 $R = 3120.00'$   
 $T = 436.17'$   
 $C = 863.95'$   
 $Lc = 866.73'$   
 $e = 4.80\%$

TMK: 2-6-18-4  
 State of Hawaii  
 DOFAW Forest Reserve

TRUE NORTH  
SCALE: 1"=100'

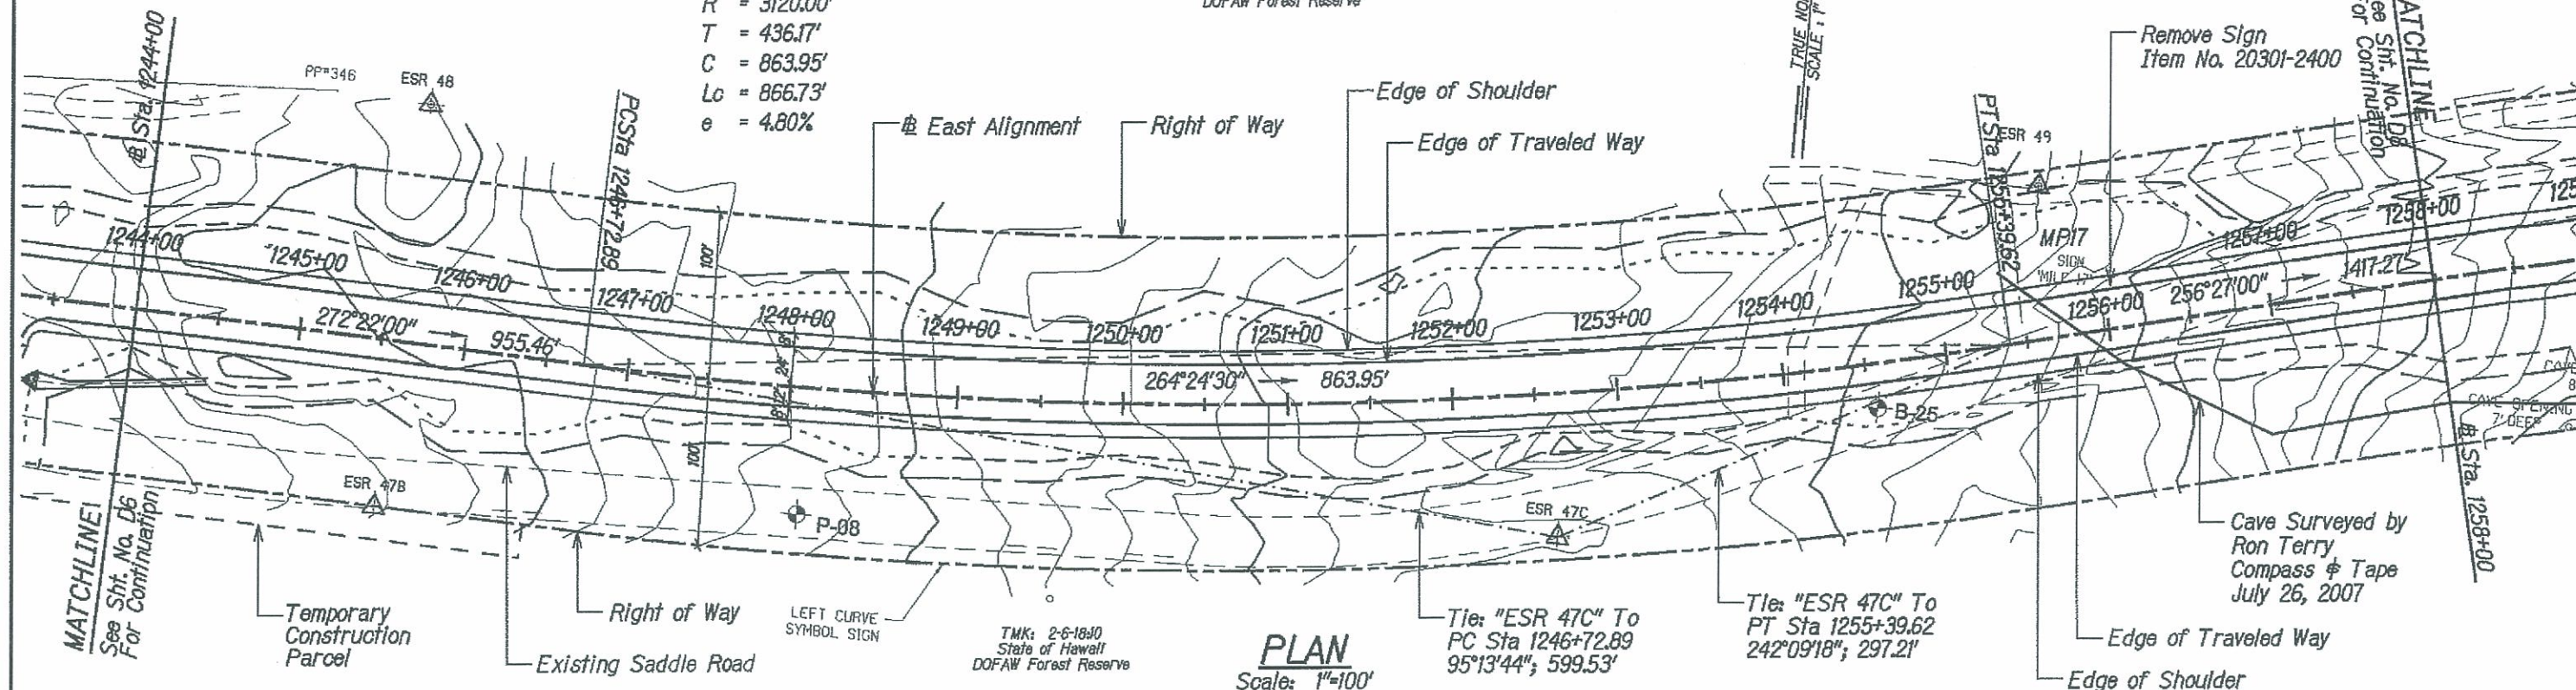

**PLAN**  
 Scale: 1"=100'

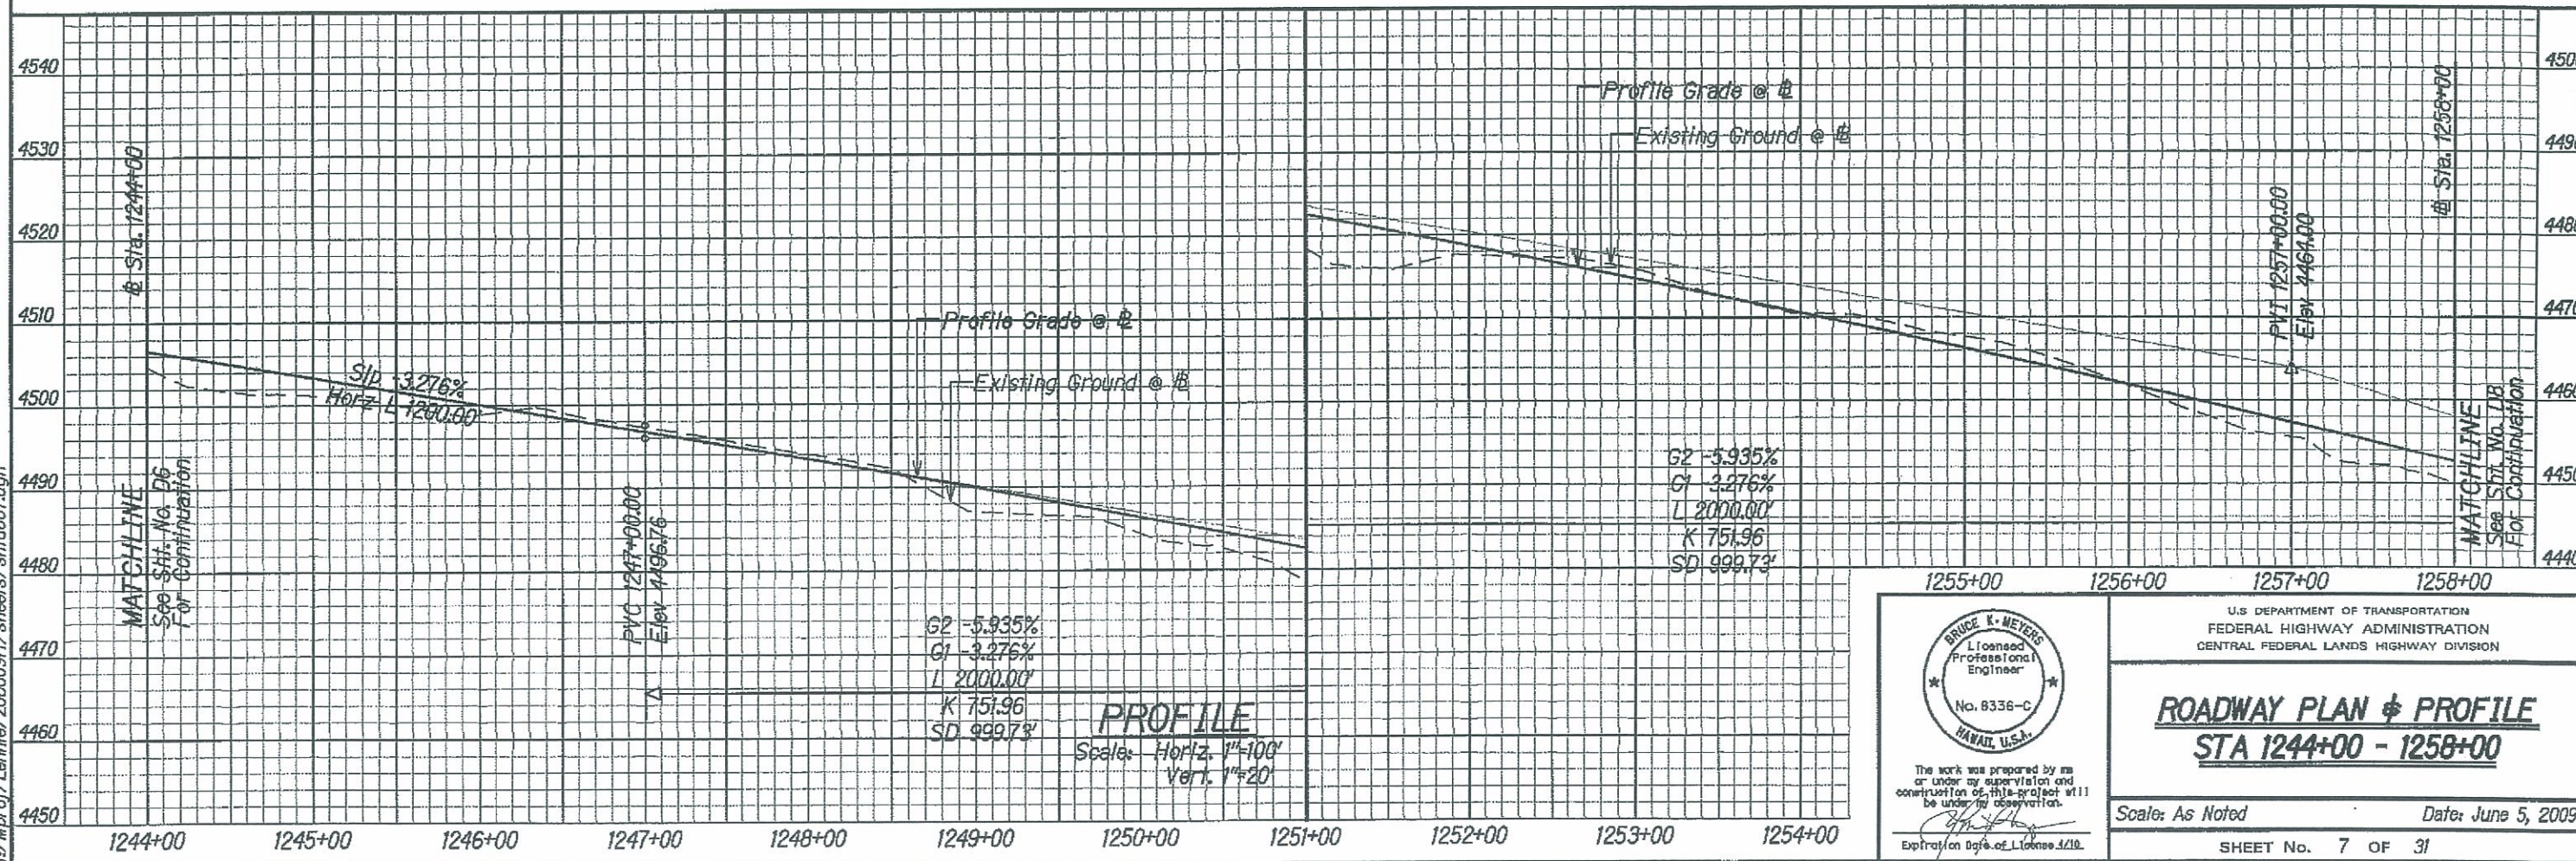

**PROFILE**  
 Scale: Horiz. 1"=100'  
 Vert. 1"=20'



The work was prepared by me  
 or under my supervision and  
 construction of this project will  
 be under my observation.  
 Expiration Date of License 3/18

U.S. DEPARTMENT OF TRANSPORTATION  
 FEDERAL HIGHWAY ADMINISTRATION  
 CENTRAL FEDERAL LANDS HIGHWAY DIVISION

## **ROADWAY PLAN & PROFILE** **STA 1244+00 - 1258+00**

Scale: As Noted

Date: June 5, 2009

SHEET No. 7 OF 31



| STATE | SADDLE ROAD PROJECT | SHEET NO. | TOTAL SHEETS |
|-------|---------------------|-----------|--------------|
| HI    | HI HP & TI 200(2)   | D8        | D31          |



# EAST @ CURVE (41) DATA

$\Delta = 26^{\circ}06'00''$   
 $R = 1970.00'$   
 $T = 456.62'$   
 $C = 889.66'$   
 $Lc = 897.40'$   
 $e = 6.68\%$

Tie: "ESR 50" To  
 PC Sta 1269+56.89  
 274°56'31"; 260.55'



Tie: "ESR 50" To  
 @ Sta 1264+78  
 Upper Waiakea Forest Reserve  
 56°49'30"; 246.05'

243°24'00"  
 889.66'

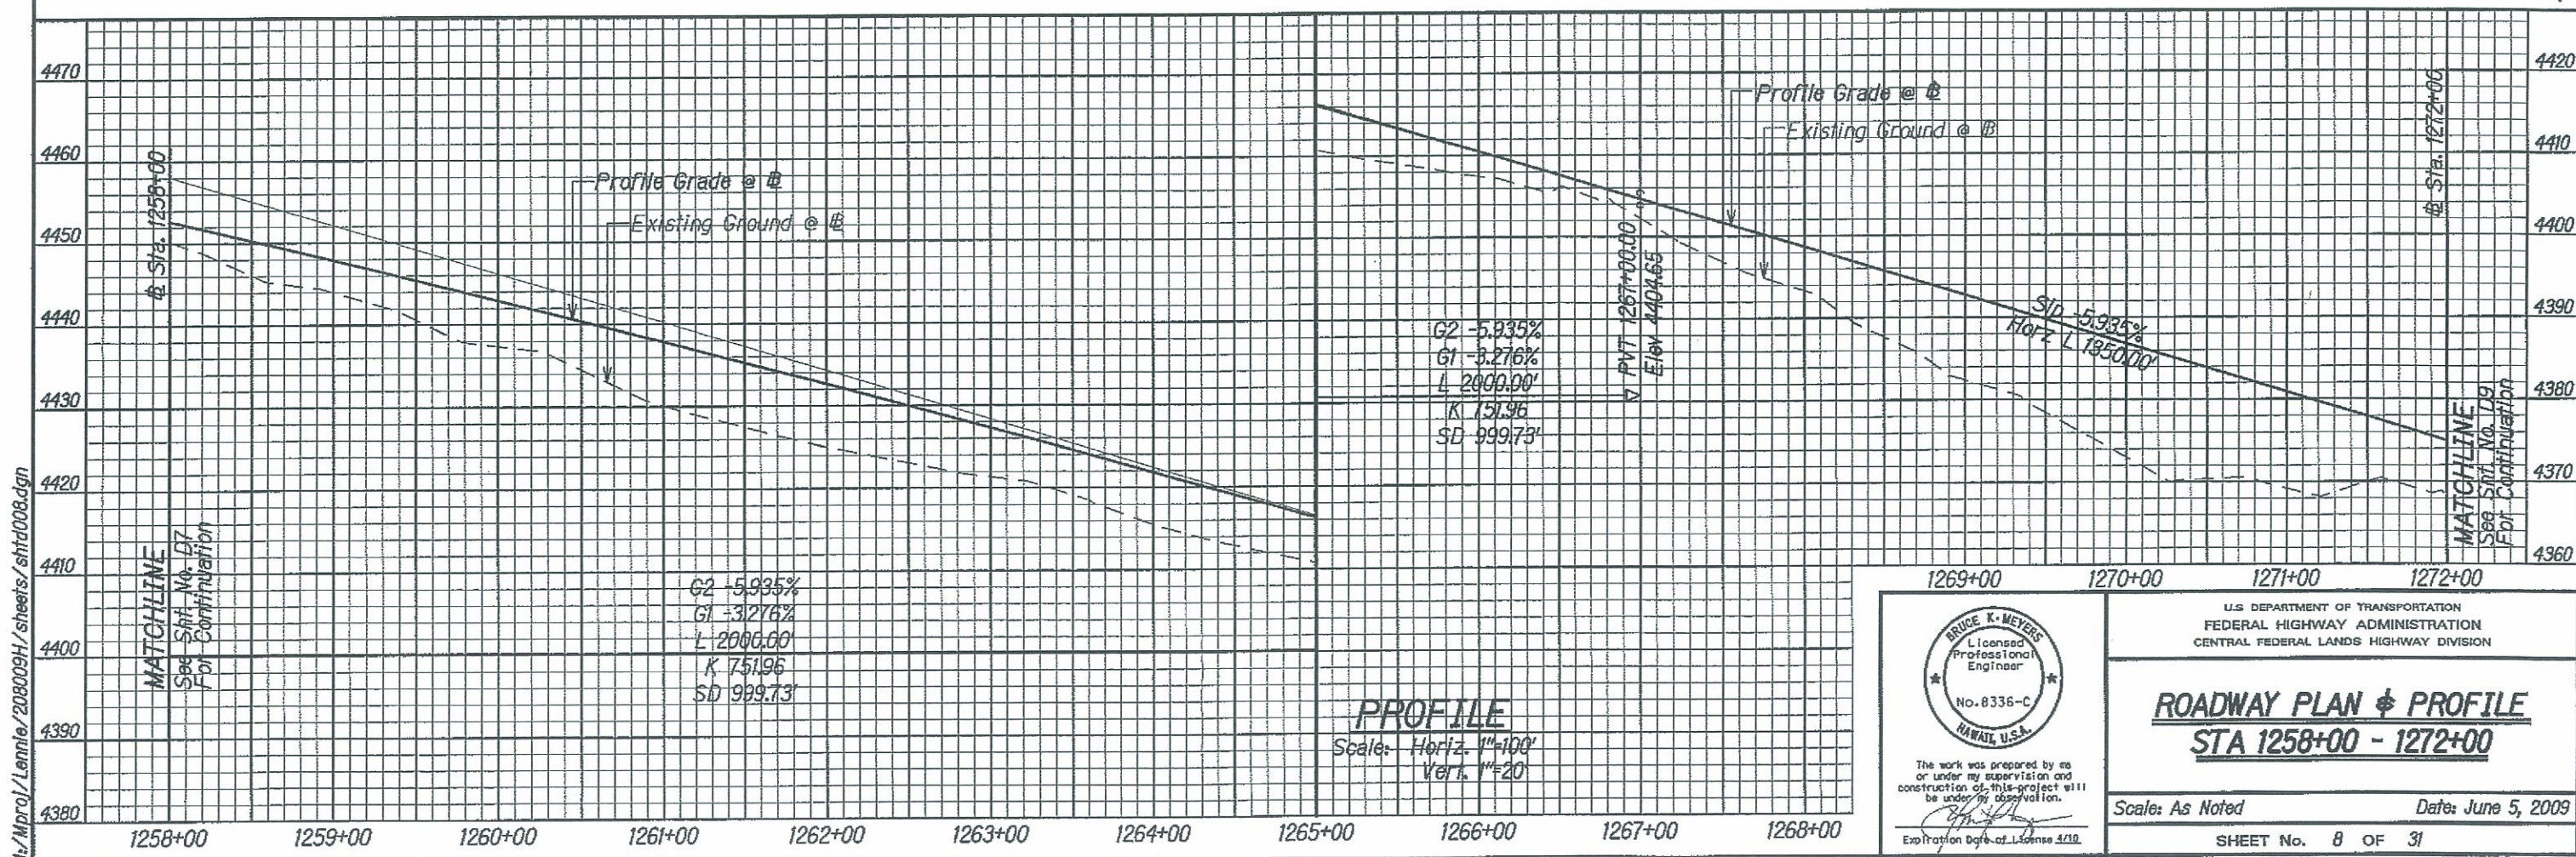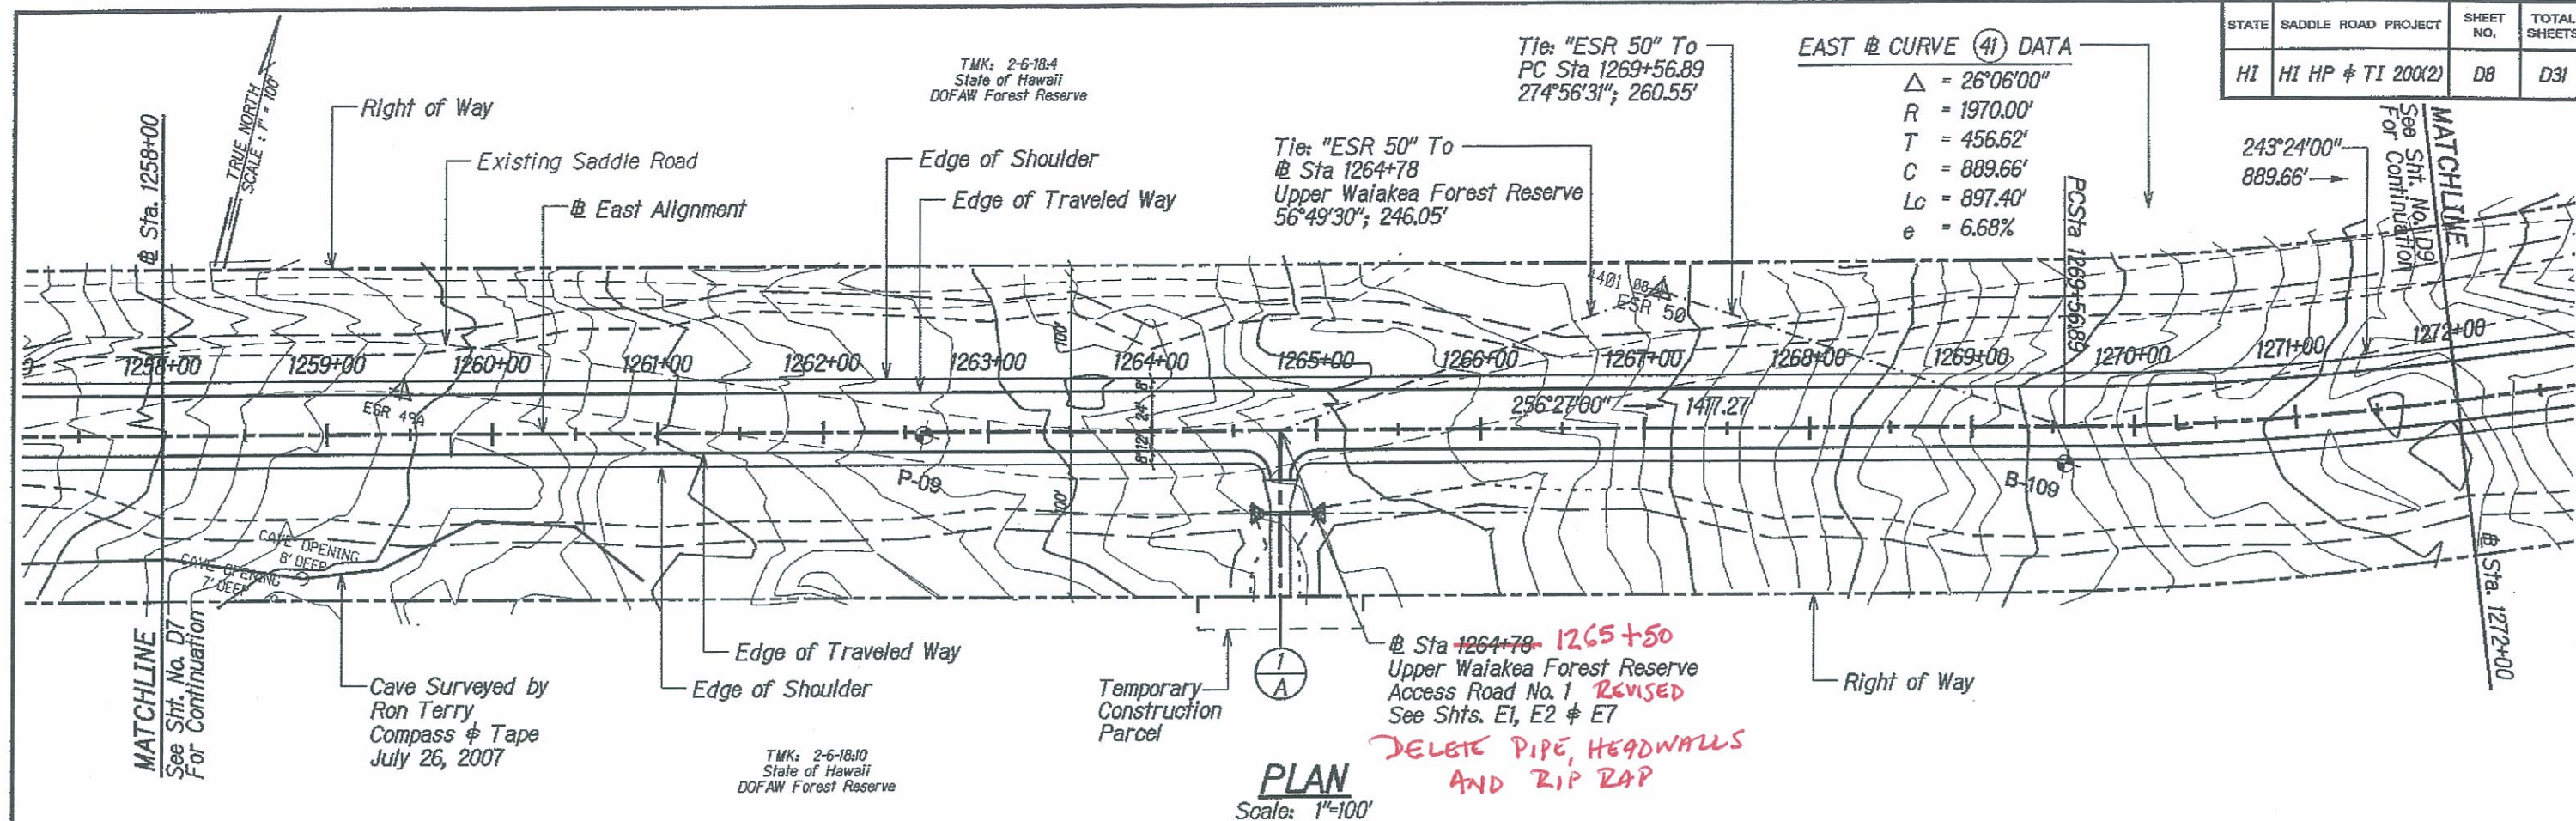



| STATE | SADDLE ROAD PROJECT | SHEET NO. | TOTAL SHEETS |
|-------|---------------------|-----------|--------------|
| HI    | HI HP & TI 200(2)   | D9        | D31          |

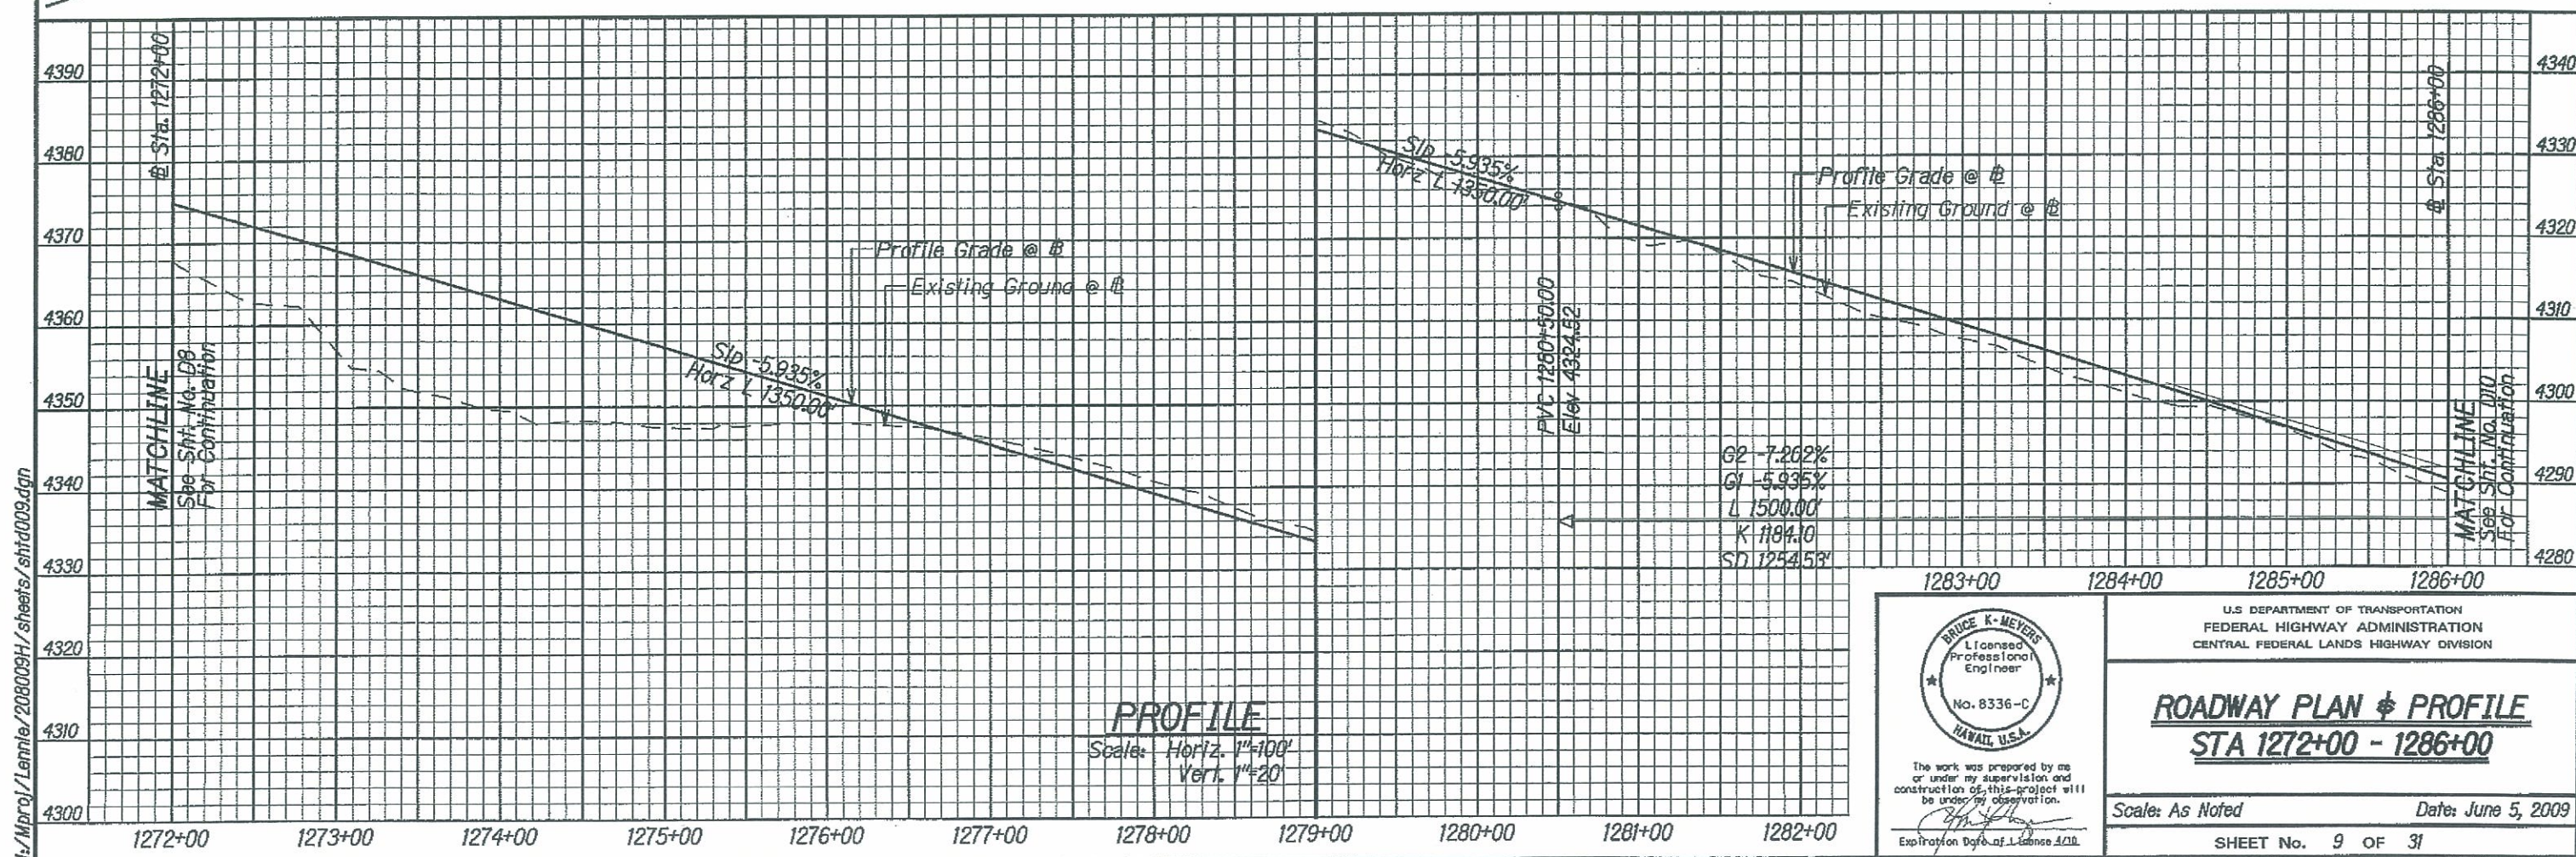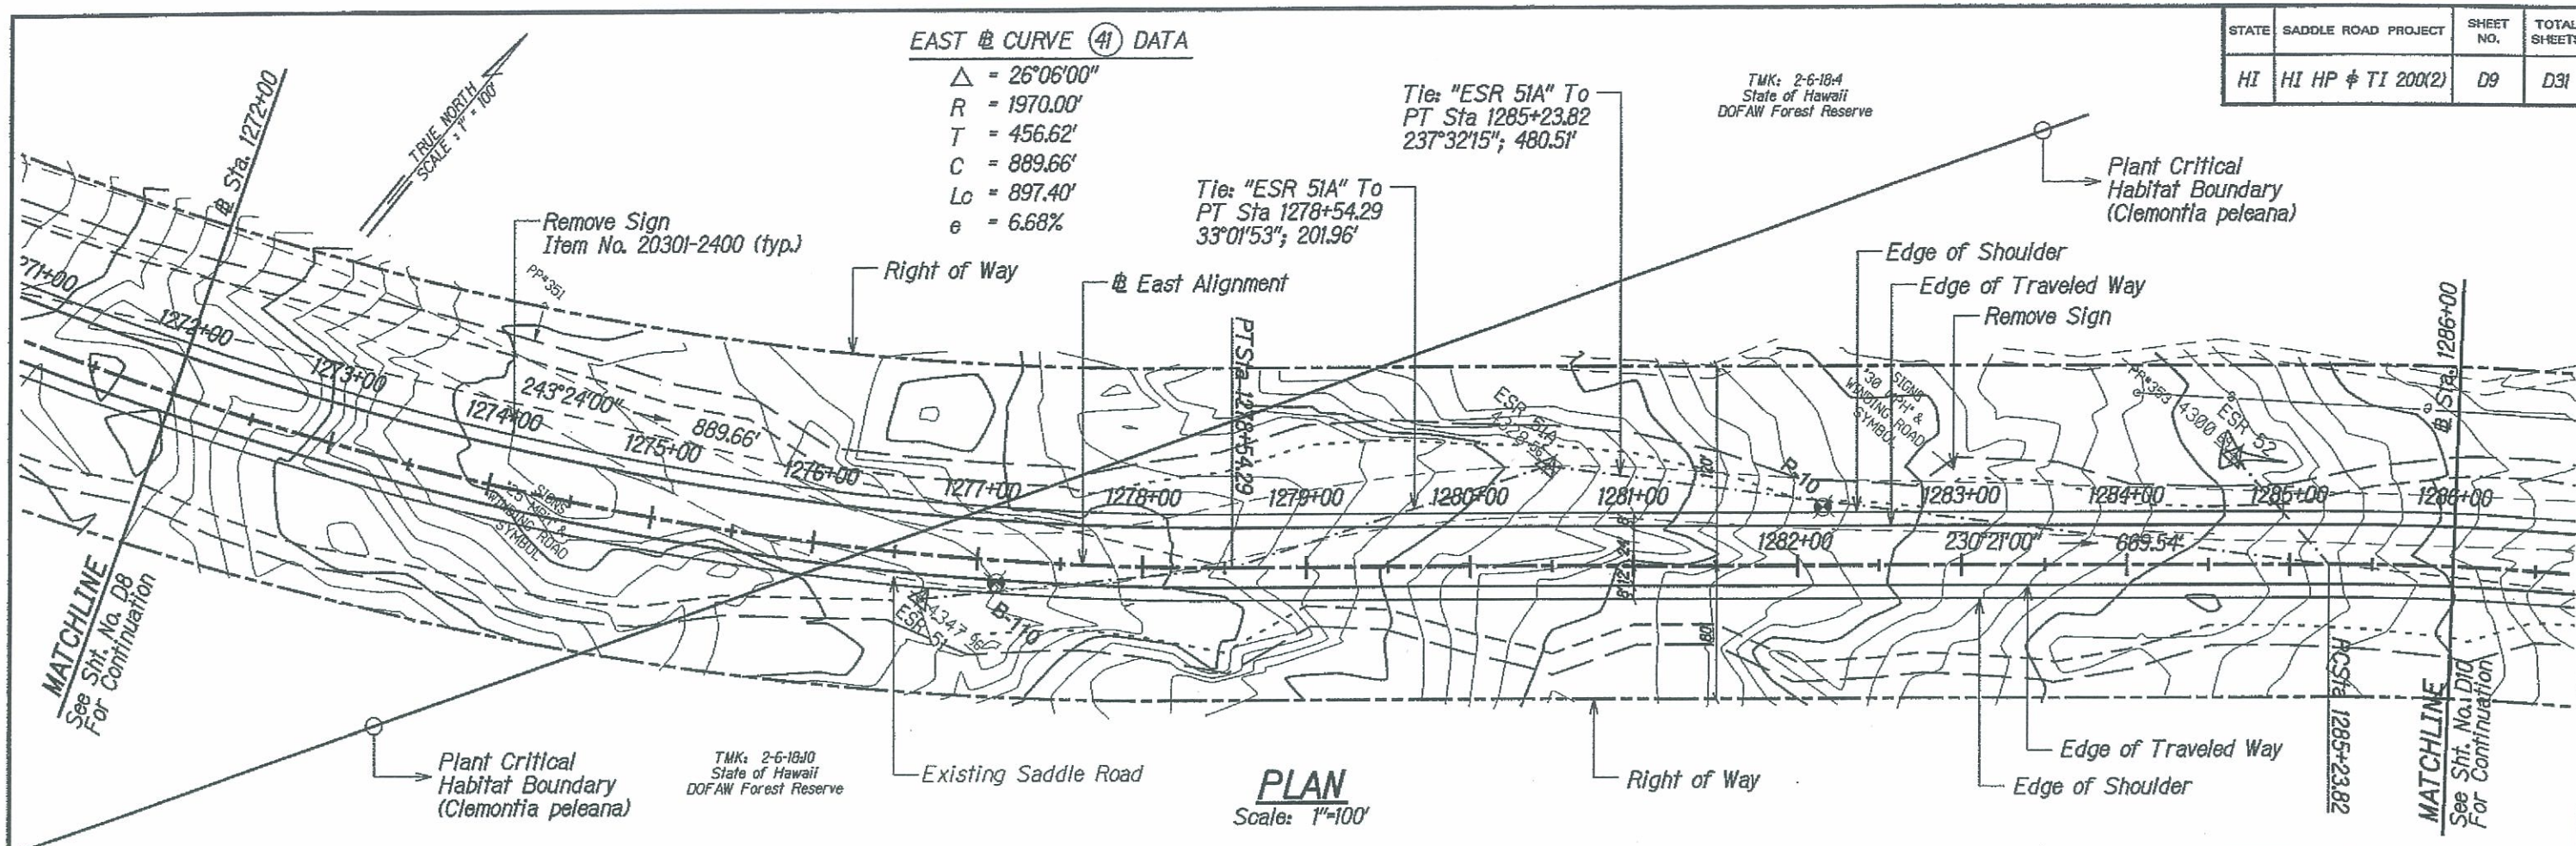

M:\Mproj\Lenite\208009H\sheet\shrd009.dgn



| STATE | SADDLE ROAD PROJECT | SHEET NO. | TOTAL SHEETS |
|-------|---------------------|-----------|--------------|
| HI    | HI HP & TI 200(2)   | D10       | D31          |



# EAST @ CURVE (42) DATA

$\Delta = 11^{\circ}39'00''$   
 $R = 2140.00'$   
 $T = 218.32'$   
 $C = 434.38'$   
 $Lc = 435.13'$   
 $e = 6.34\%$

TMK: 2-6-18-4  
 State of Hawaii  
 DOFAW Forest Reserve

# EAST @ CURVE (43) DATA



$\Delta = 14^{\circ}38'00''$   
 $R = 2300.00'$   
 $T = 295.32'$   
 $C = 585.83'$   
 $Lc = 587.42'$   
 $e = 6.04\%$

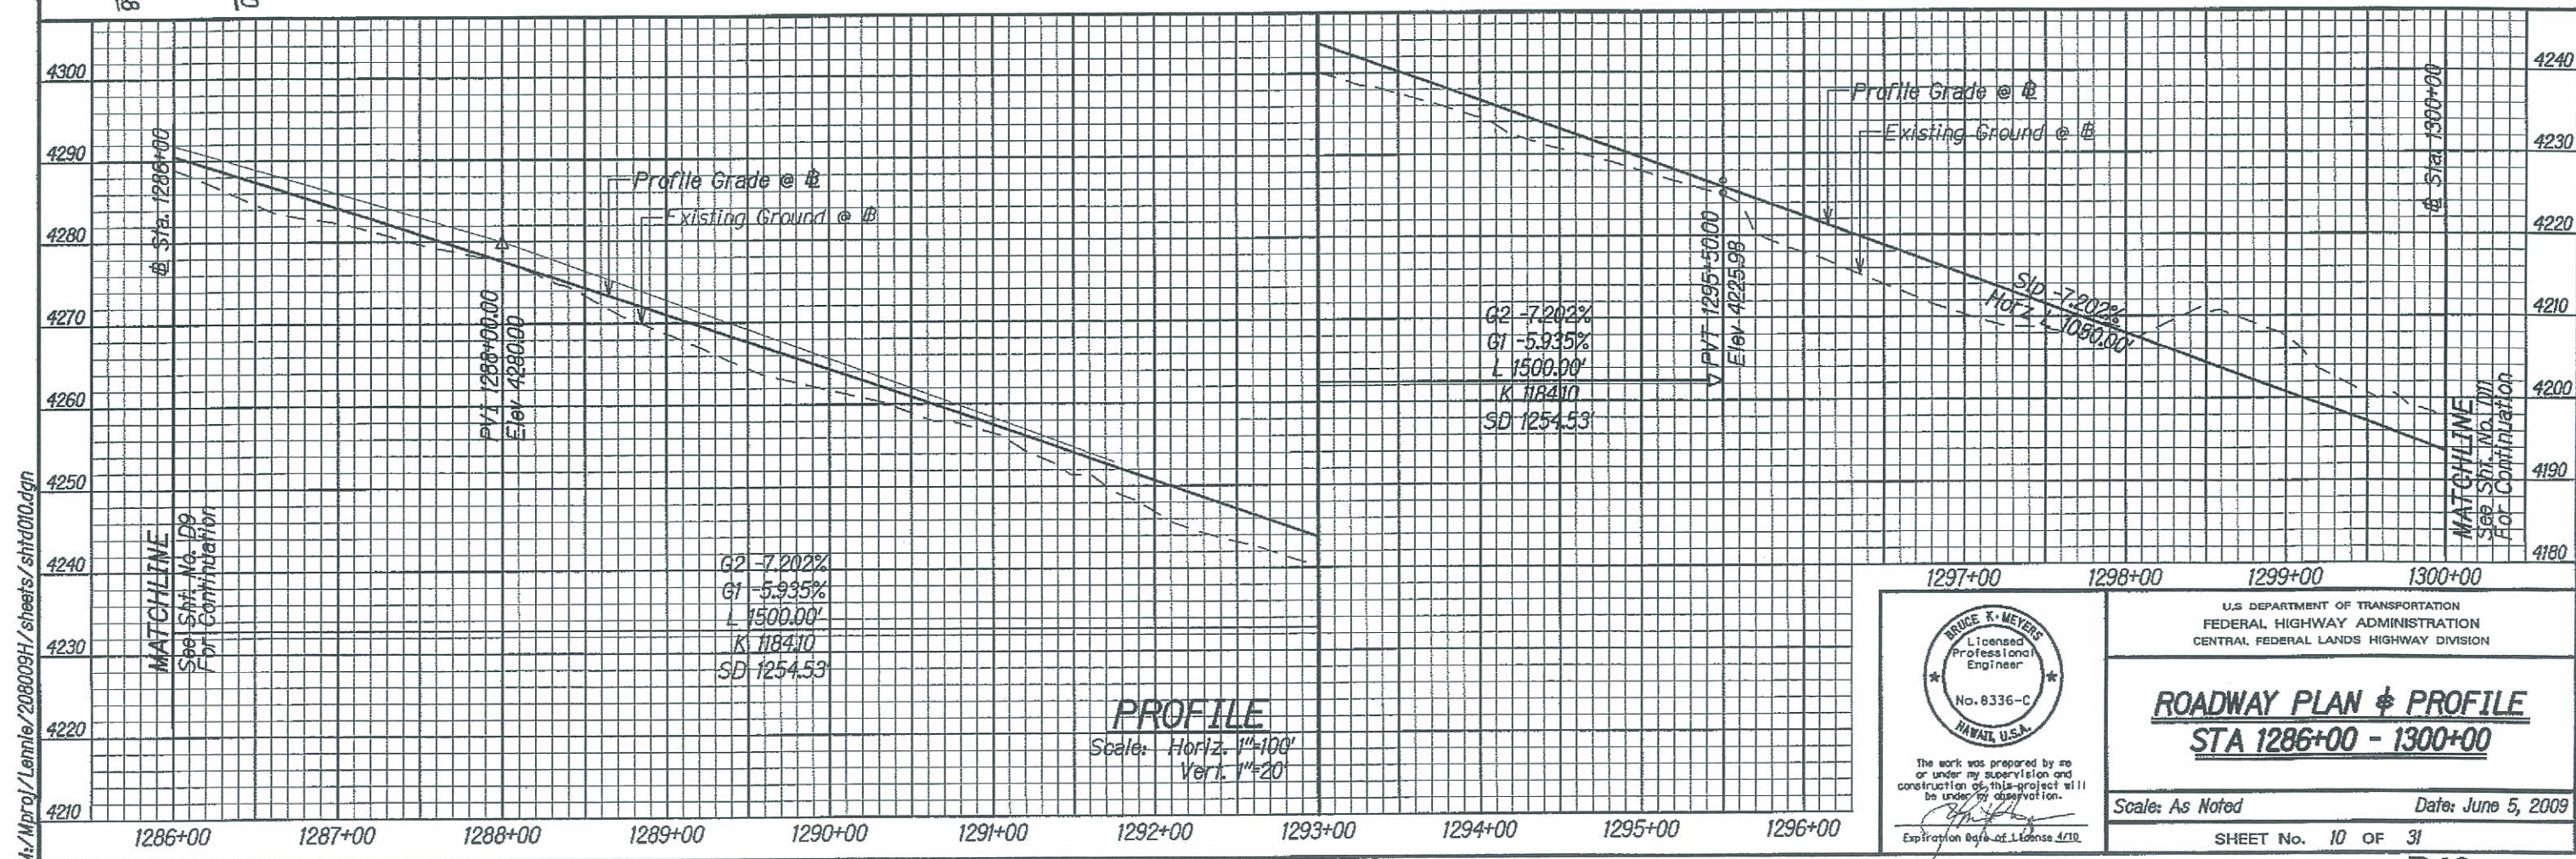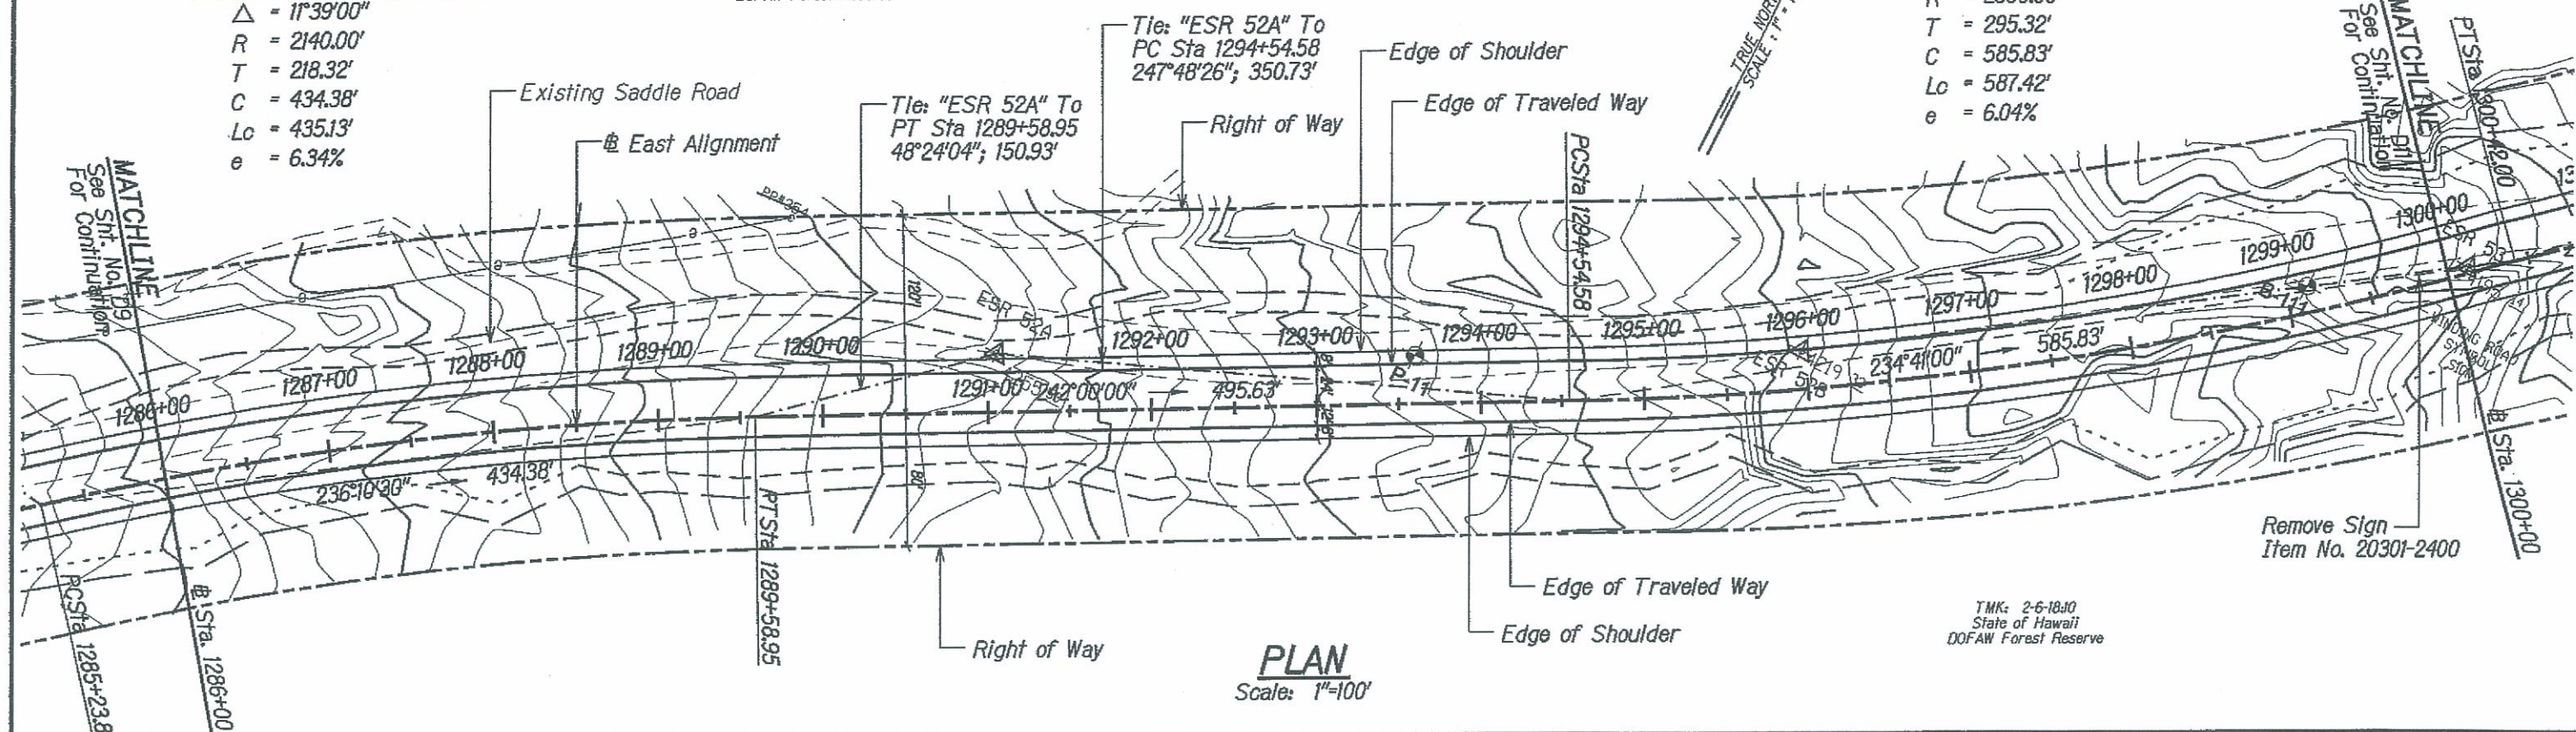

BRUCE K. MEYERS  
 Licensed Professional Engineer  
 No. 8336-C  
 HAWAII, U.S.A.  
 The work was prepared by me or under my supervision and construction of this project will be under my observation.  
 Expiration Date of License 4/1/10

U.S. DEPARTMENT OF TRANSPORTATION  
 FEDERAL HIGHWAY ADMINISTRATION  
 CENTRAL, FEDERAL LANDS HIGHWAY DIVISION  
**ROADWAY PLAN & PROFILE**  
**STA 1286+00 - 1300+00**  
 Scale: As Noted  
 Date: June 5, 2009  
 SHEET No. 10 OF 31



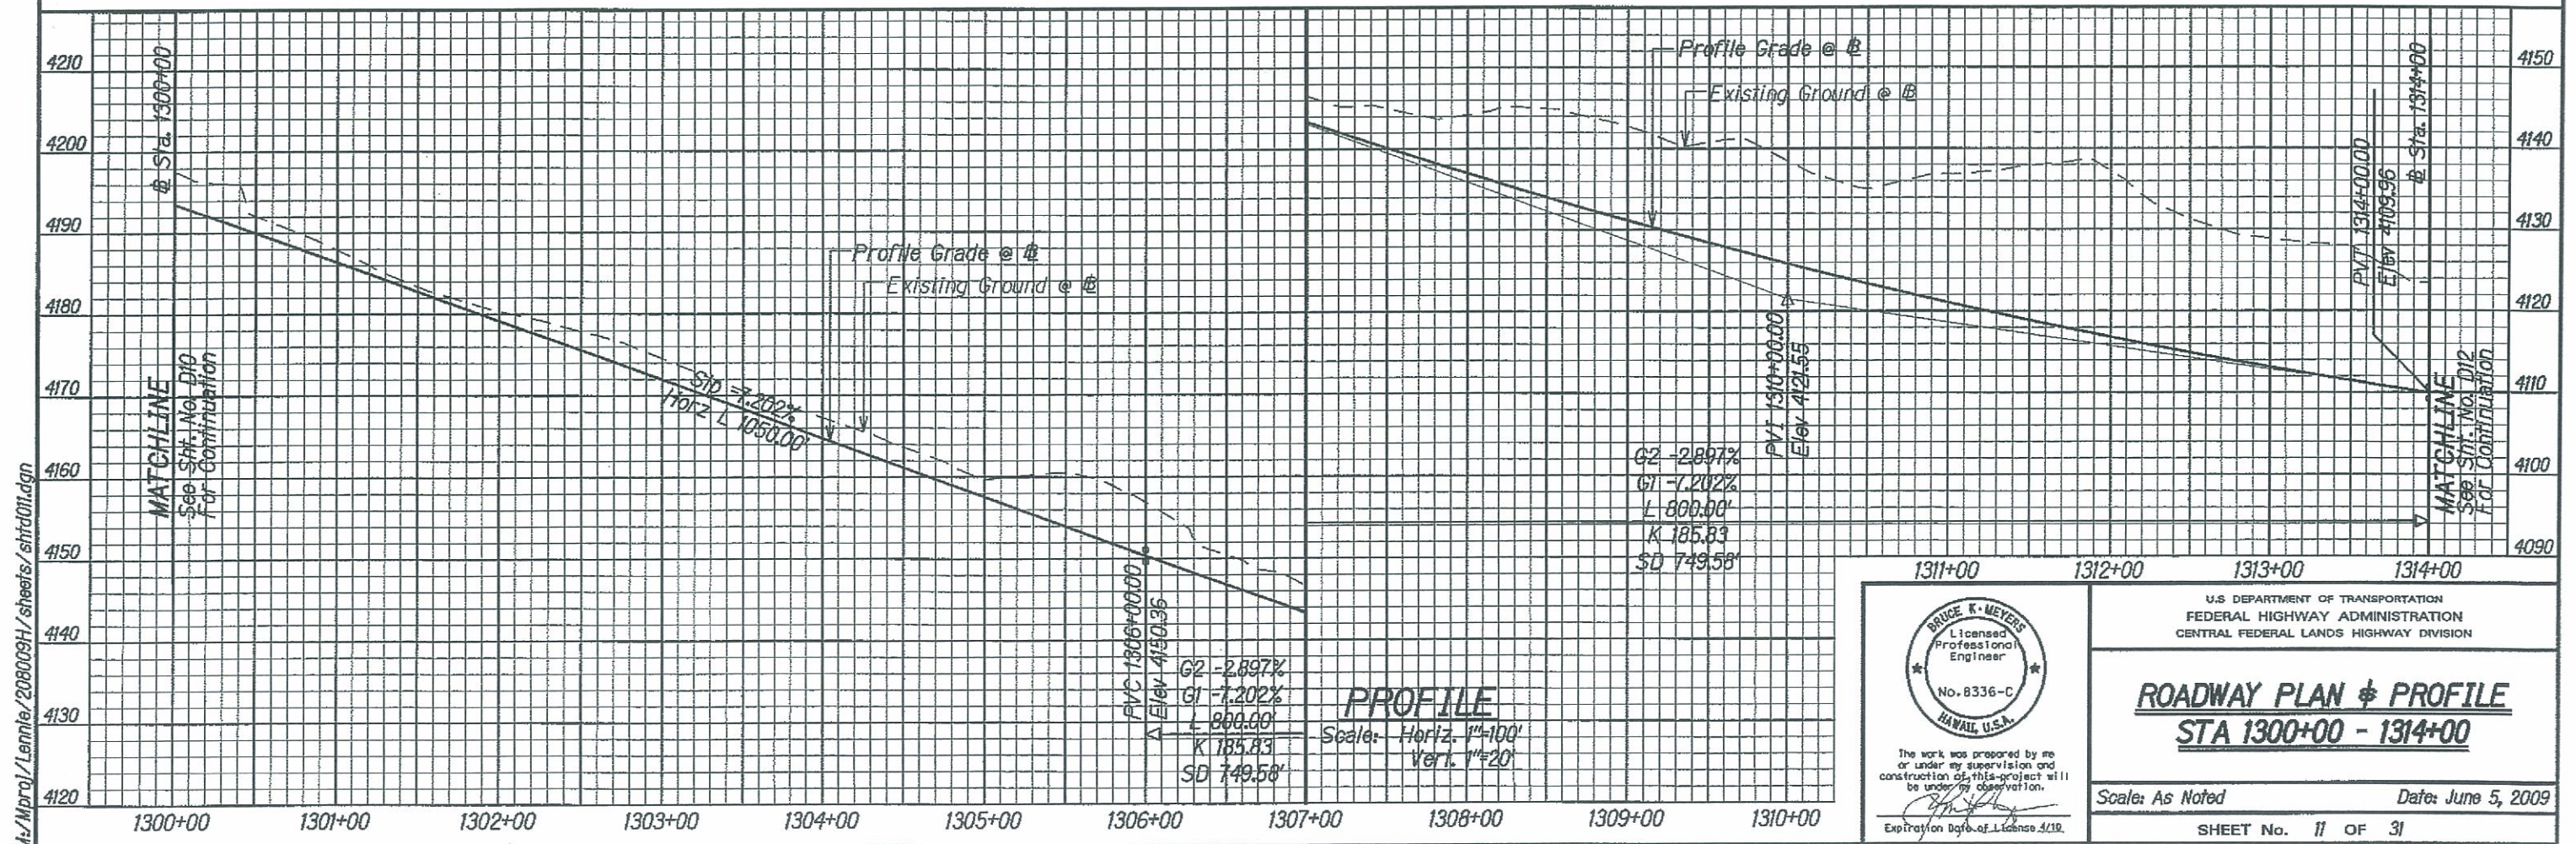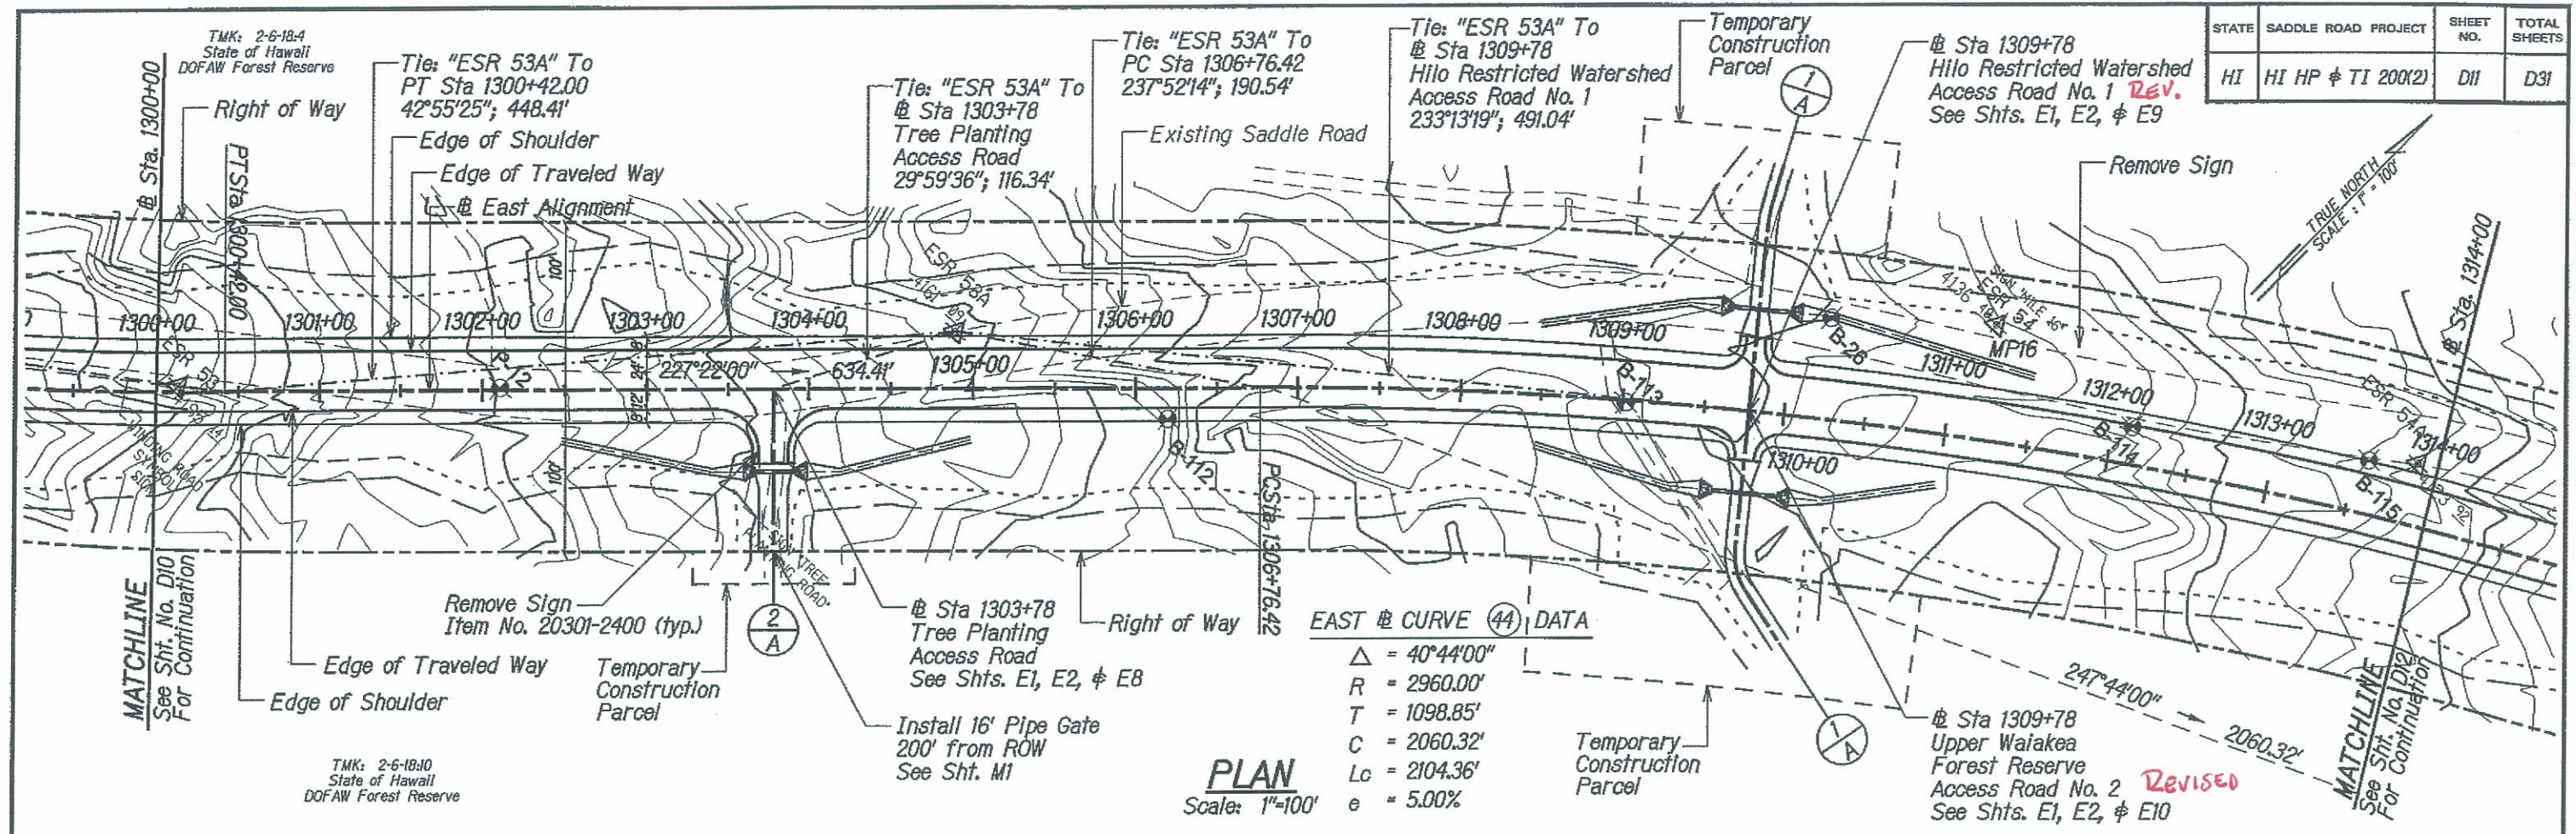









| STATE | SADDLE ROAD PROJECT | SHEET NO. | TOTAL SHEETS |
|-------|---------------------|-----------|--------------|
| HI    | HI HP & TI 200(2)   | D13       | D31          |

EAST @ CURVE (45) DATA

$\Delta = 19^{\circ}42'00''$   
 $R = 1230.00'$   
 $T = 213.56'$   
 $C = 420.83'$   
 $Lc = 422.91'$   
 $e = 7.97'$

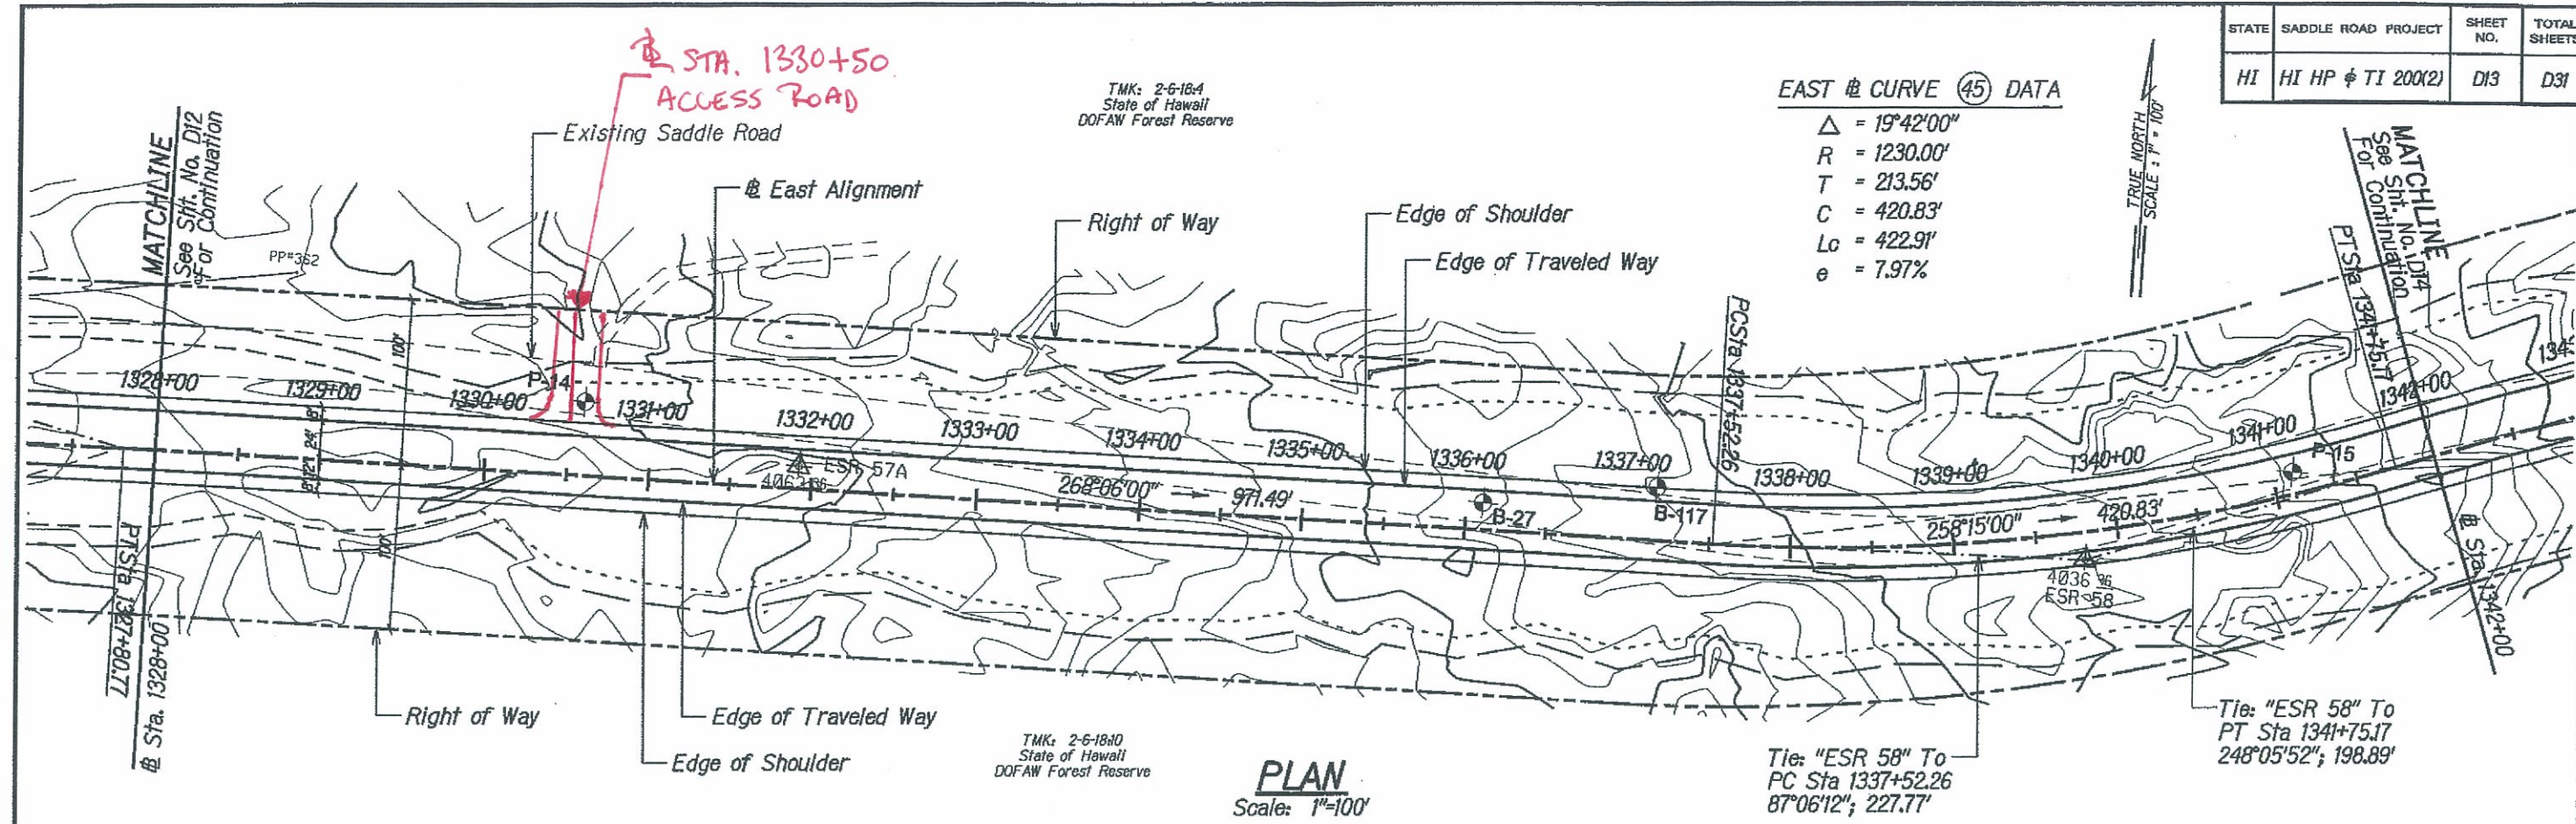

**PLAN**  
Scale: 1"=100'

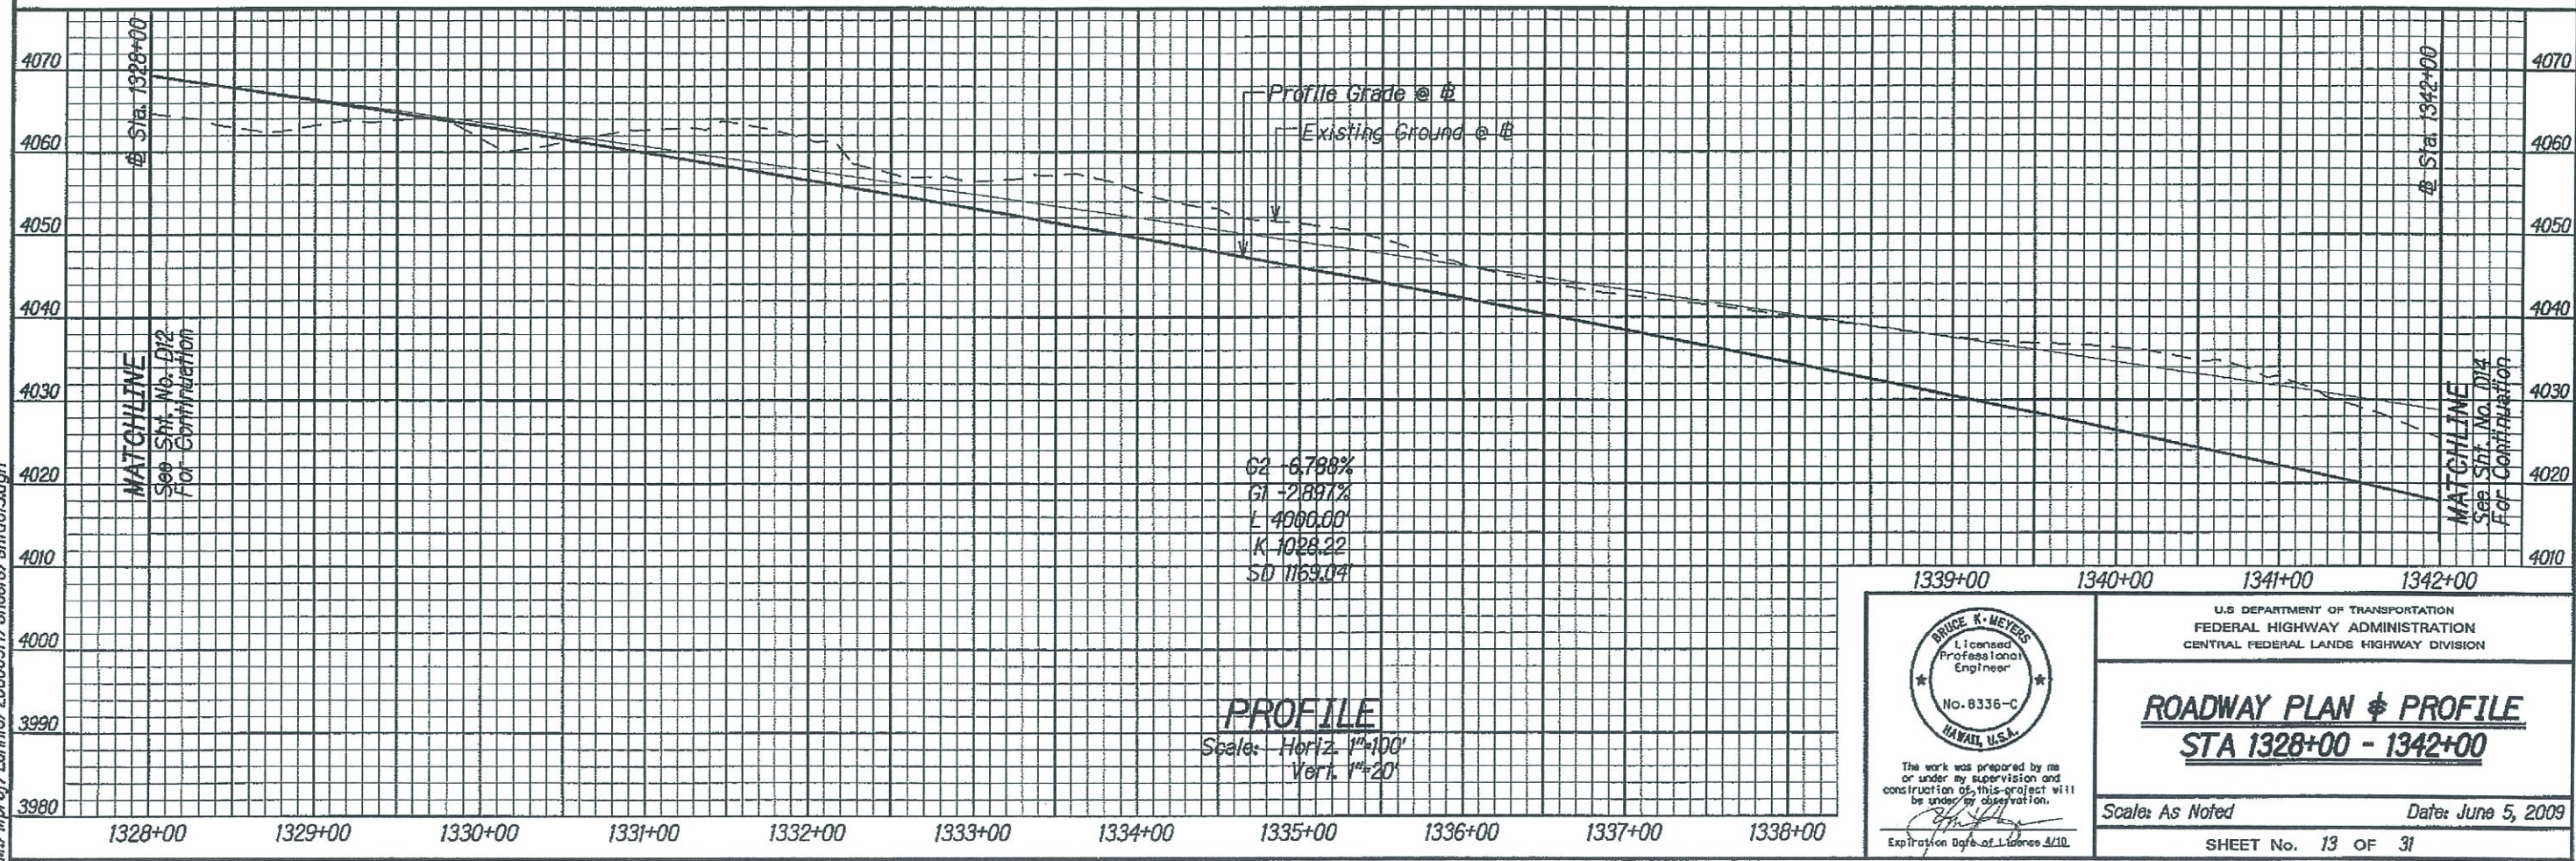

**PROFILE**  
Scale: Horiz. 1"=100'  
Vert. 1"=20'

BRUCE K. MEYERS  
Licensed Professional Engineer  
No. 8336-C  
HAWAII, U.S.A.

The work was prepared by me or under my supervision and construction of this project will be under my observation.

Expiration Date of License 4/10

U.S. DEPARTMENT OF TRANSPORTATION  
FEDERAL HIGHWAY ADMINISTRATION  
CENTRAL FEDERAL LANDS HIGHWAY DIVISION



**ROADWAY PLAN & PROFILE**  
**STA 1328+00 - 1342+00**

Scale: As Noted Date: June 5, 2009

SHEET No. 13 OF 31





| STATE | SADDLE ROAD PROJECT | SHEET NO. | TOTAL SHEETS |
|-------|---------------------|-----------|--------------|
| HI    | HI HP & TI 200(2)   | D14       | D31          |

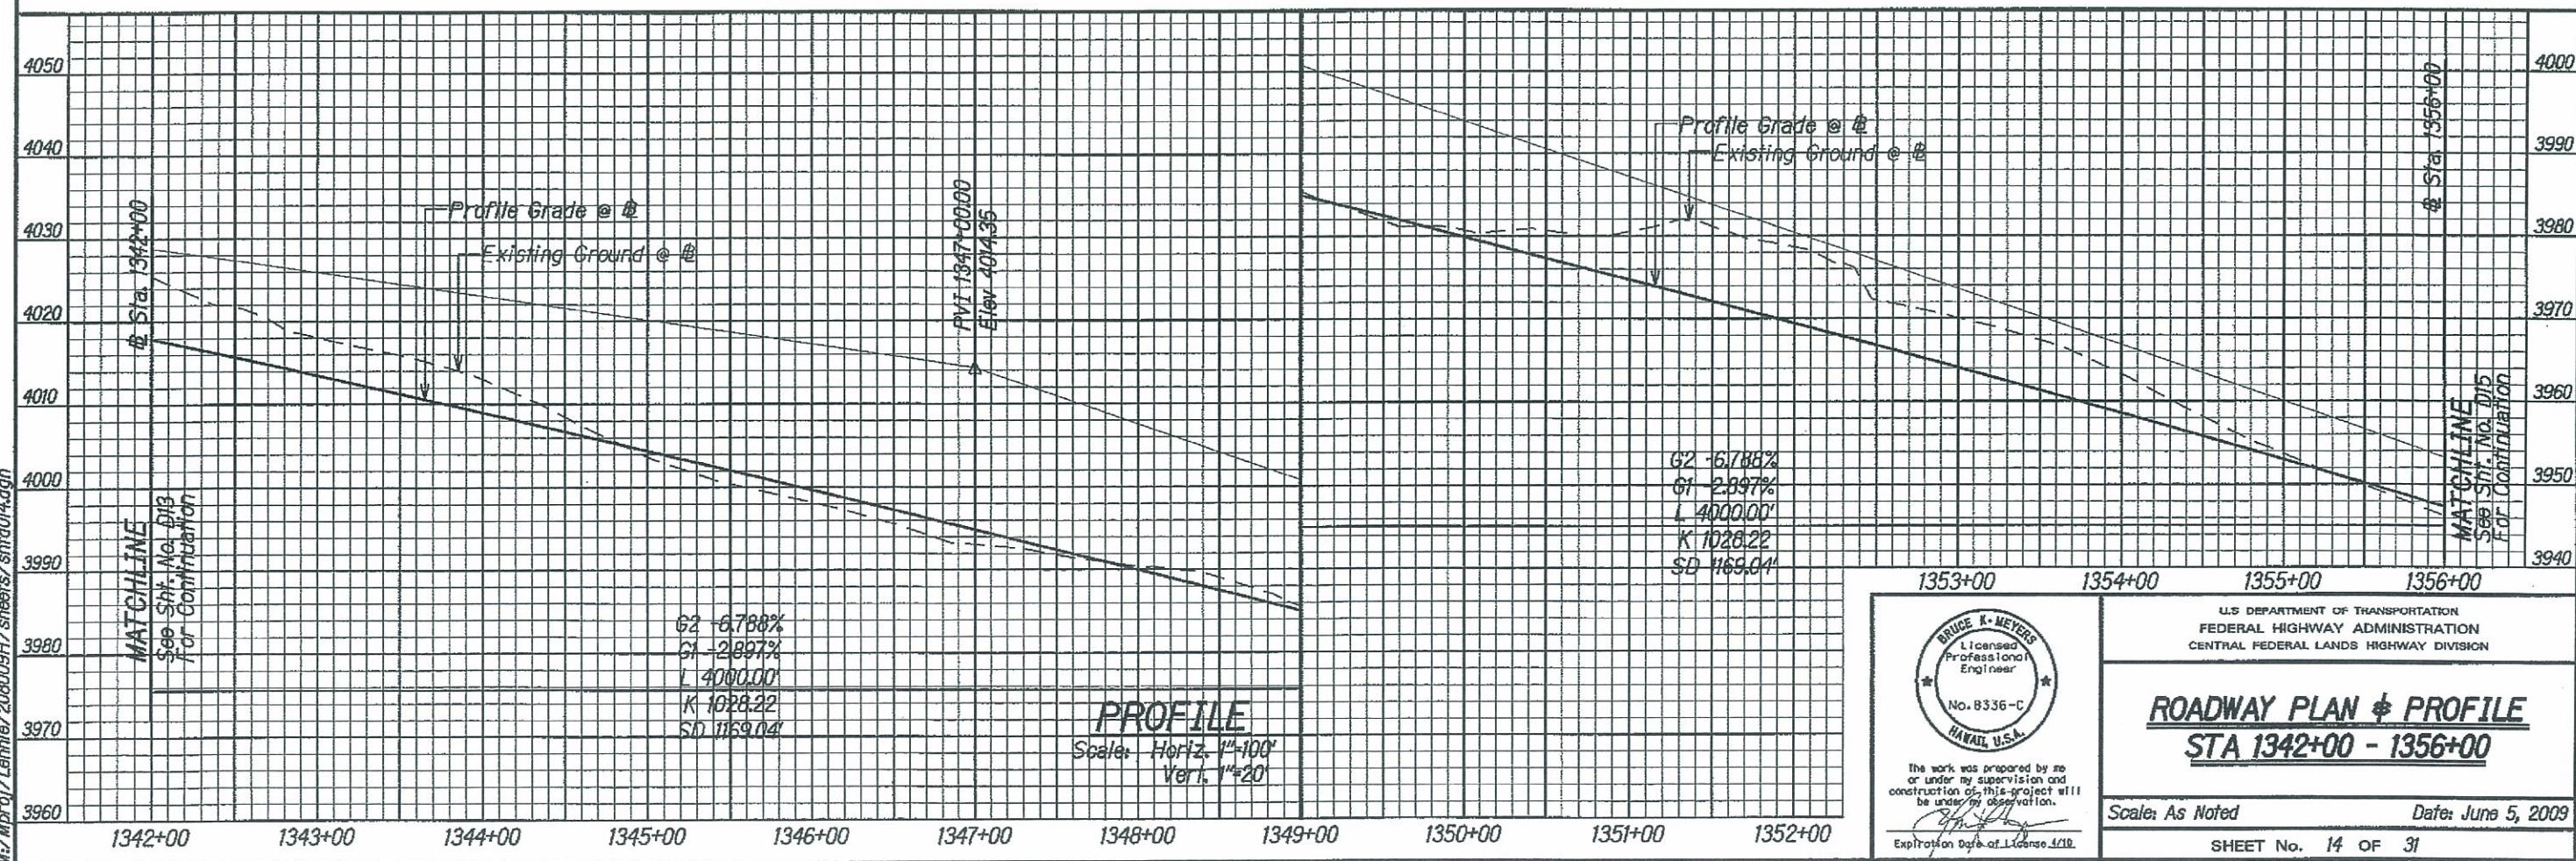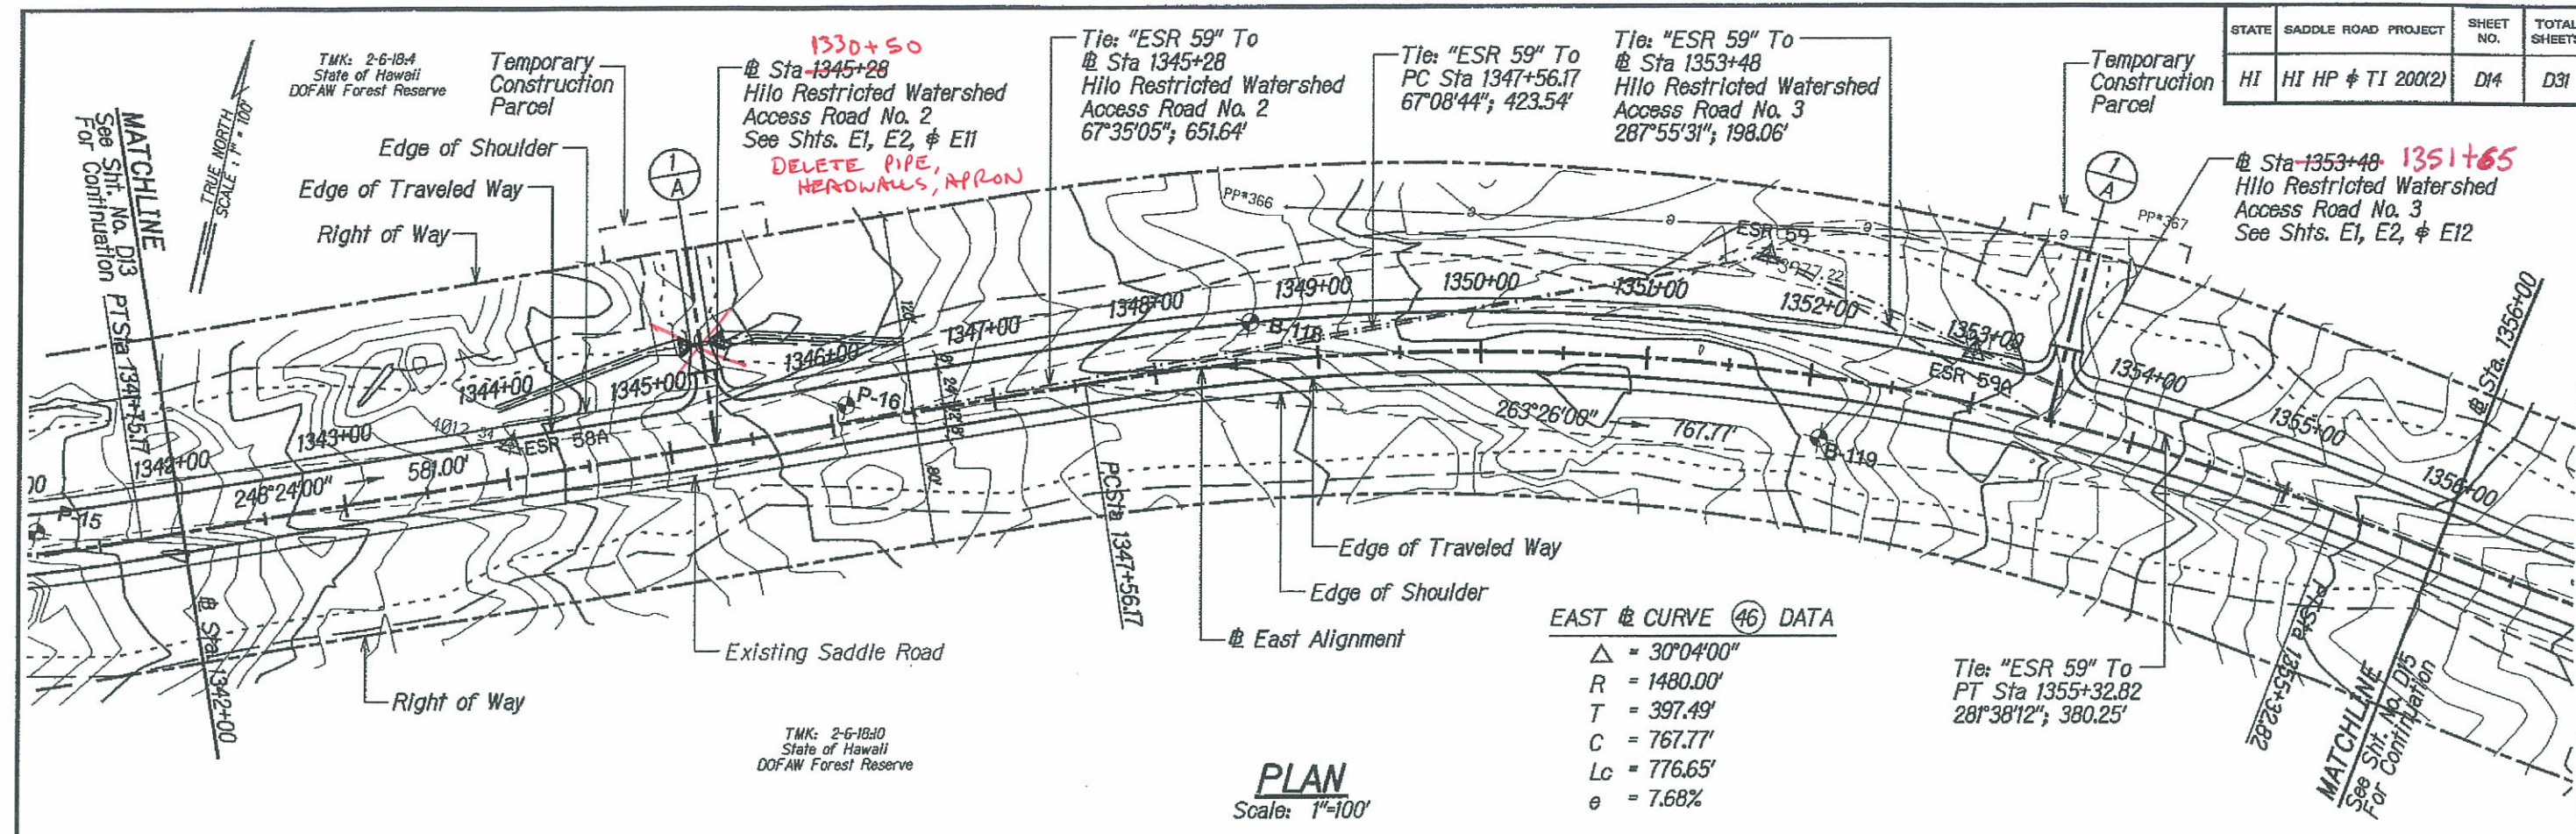



| STATE | SADDLE ROAD PROJECT | SHEET NO. | TOTAL SHEETS |
|-------|---------------------|-----------|--------------|
| HI    | HI HP & TI 200(2)   | D15       | D31          |

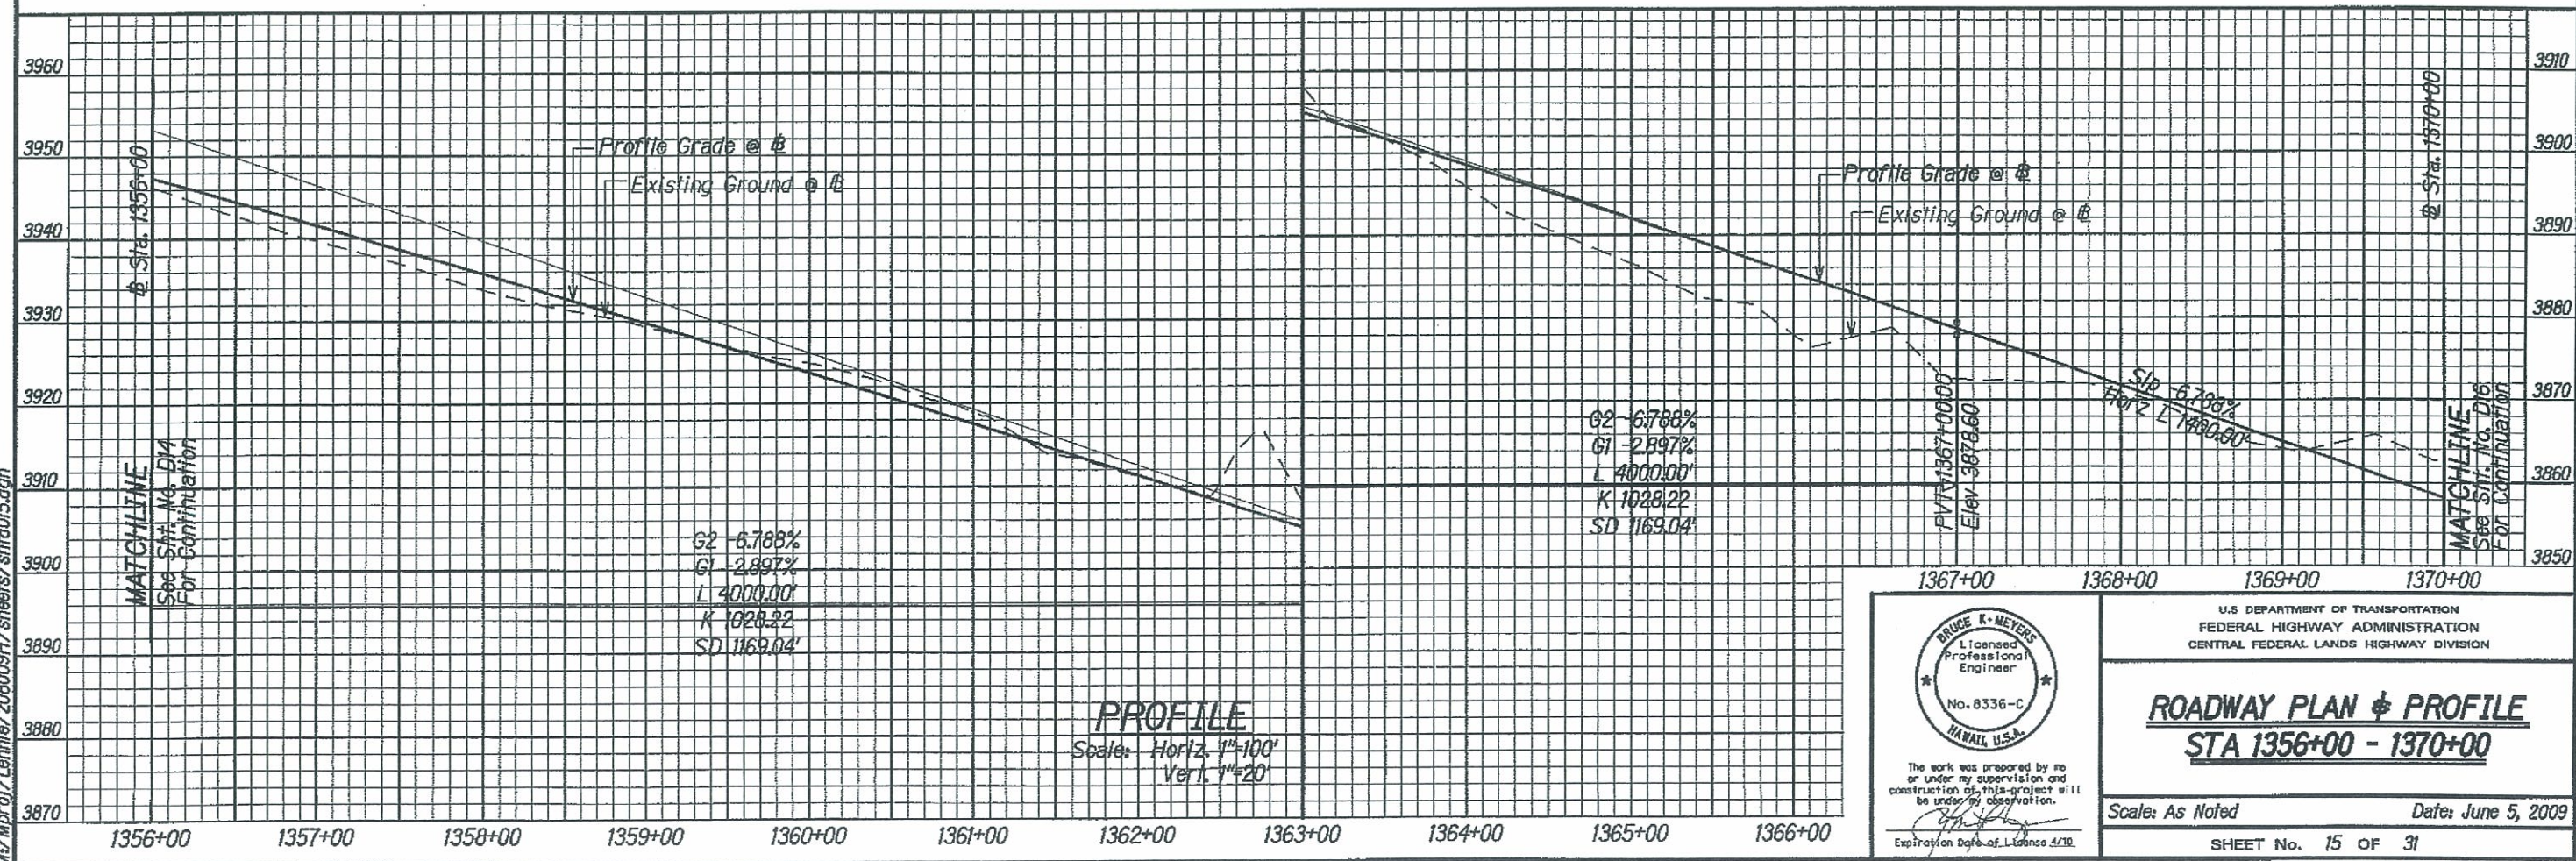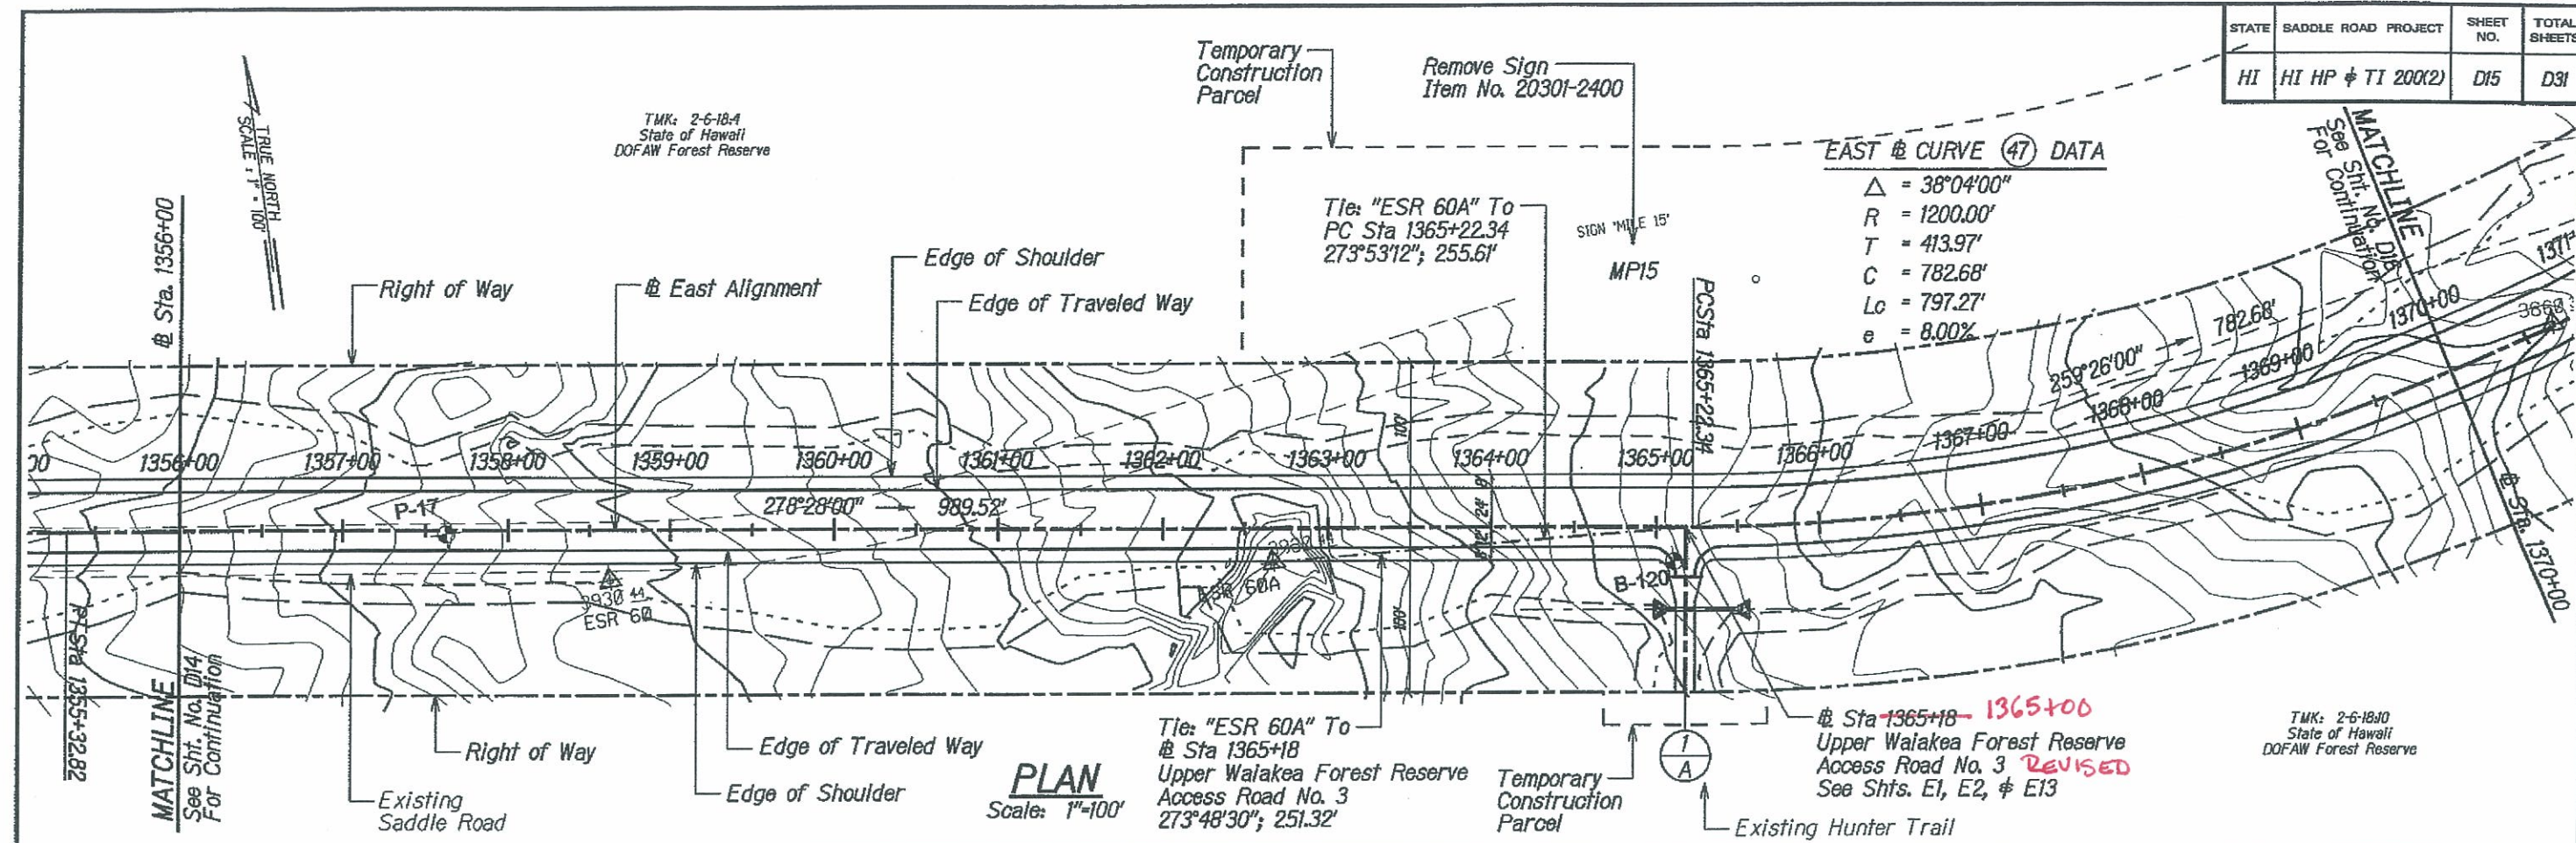

BRUCE K. MEYERS  
Licensed Professional Engineer  
No. 8336-C  
HAWAII, U.S.A.

The work was prepared by me or under my supervision and construction of this project will be under my observation.

Expiration Date of License 4/10

U.S. DEPARTMENT OF TRANSPORTATION  
FEDERAL HIGHWAY ADMINISTRATION  
CENTRAL FEDERAL LANDS HIGHWAY DIVISION

**ROADWAY PLAN & PROFILE**  
**STA 1356+00 - 1370+00**



Scale: As Noted      Date: June 5, 2009

SHEET No. 15 OF 31

M:\Mproj\Lenzie\20080911\sheet\sthd015.dgn



| STATE | SADDLE ROAD PROJECT | SHEET NO. | TOTAL SHEETS |
|-------|---------------------|-----------|--------------|
| HI    | HI HP & TI 200(2)   | D16       | D31          |

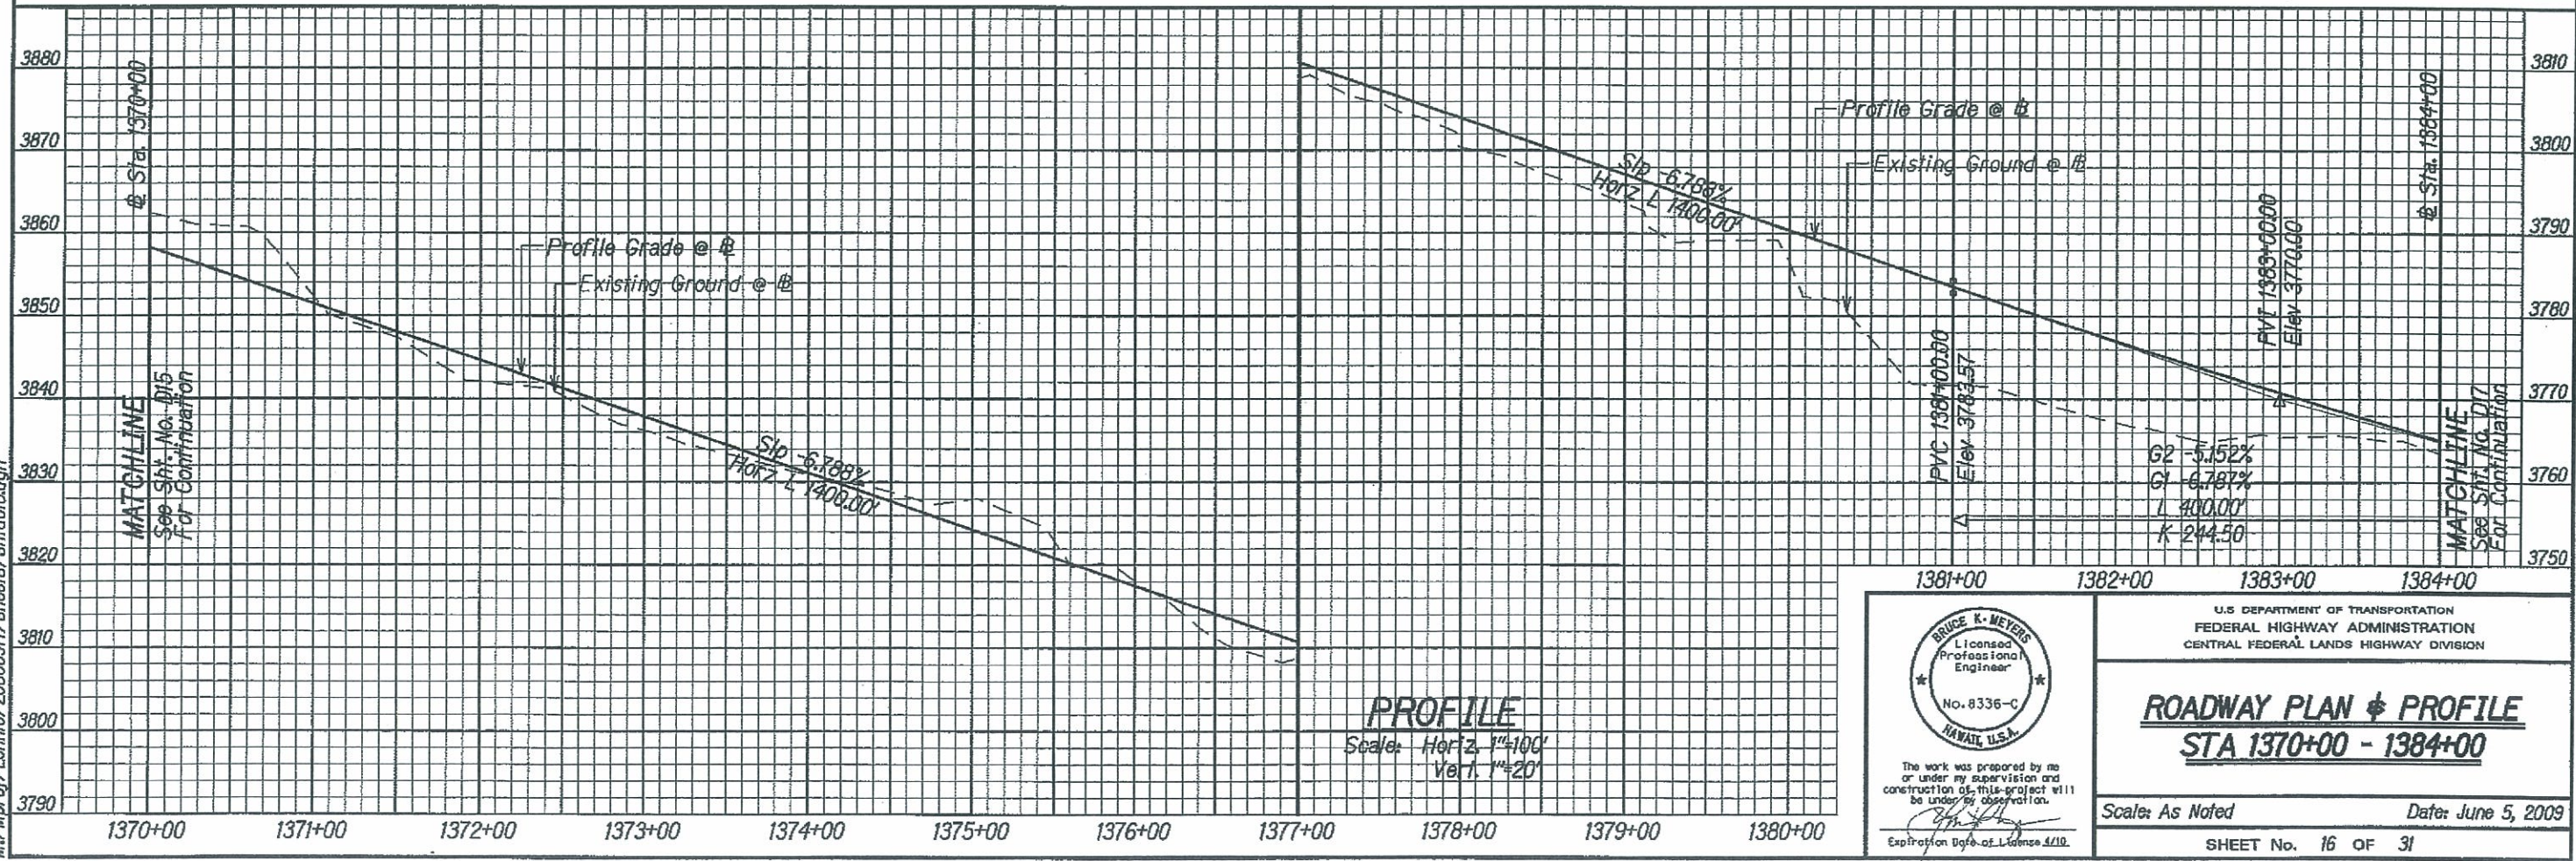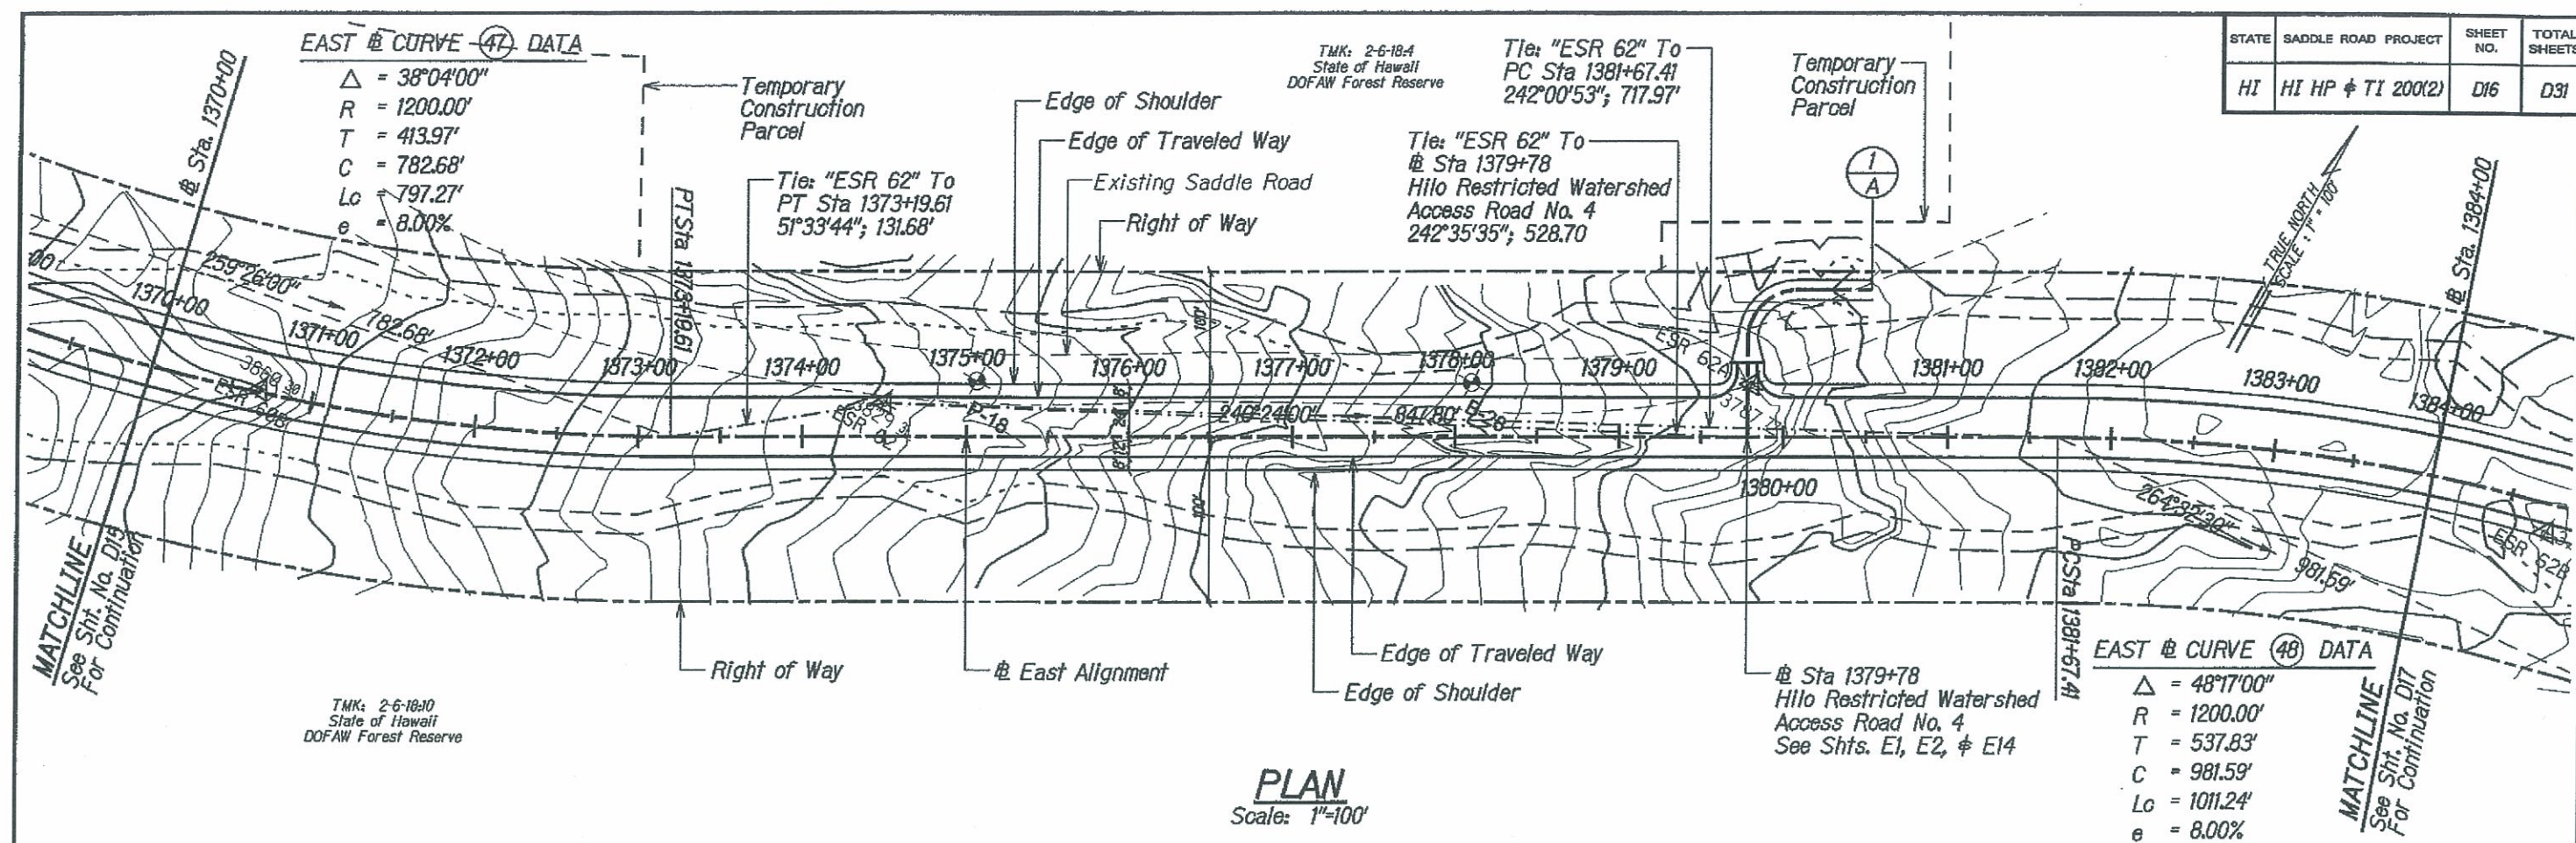

BRUCE K. MEYERS  
Licensed Professional Engineer  
No. 8336-C  
HAWAII, U.S.A.

The work was prepared by me or under my supervision and construction of this project will be under my observation.

Expiration Date of License 4/10.

U.S. DEPARTMENT OF TRANSPORTATION  
FEDERAL HIGHWAY ADMINISTRATION  
CENTRAL FEDERAL LANDS HIGHWAY DIVISION



**ROADWAY PLAN & PROFILE**  
**STA 1370+00 - 1384+00**

Scale: As Noted      Date: June 5, 2009

SHEET No. 16 OF 31





| STATE | SADDLE ROAD PROJECT | SHEET NO. | TOTAL SHEETS |
|-------|---------------------|-----------|--------------|
| HI    | HI HP & TI 200(2)   | D17       | D31          |

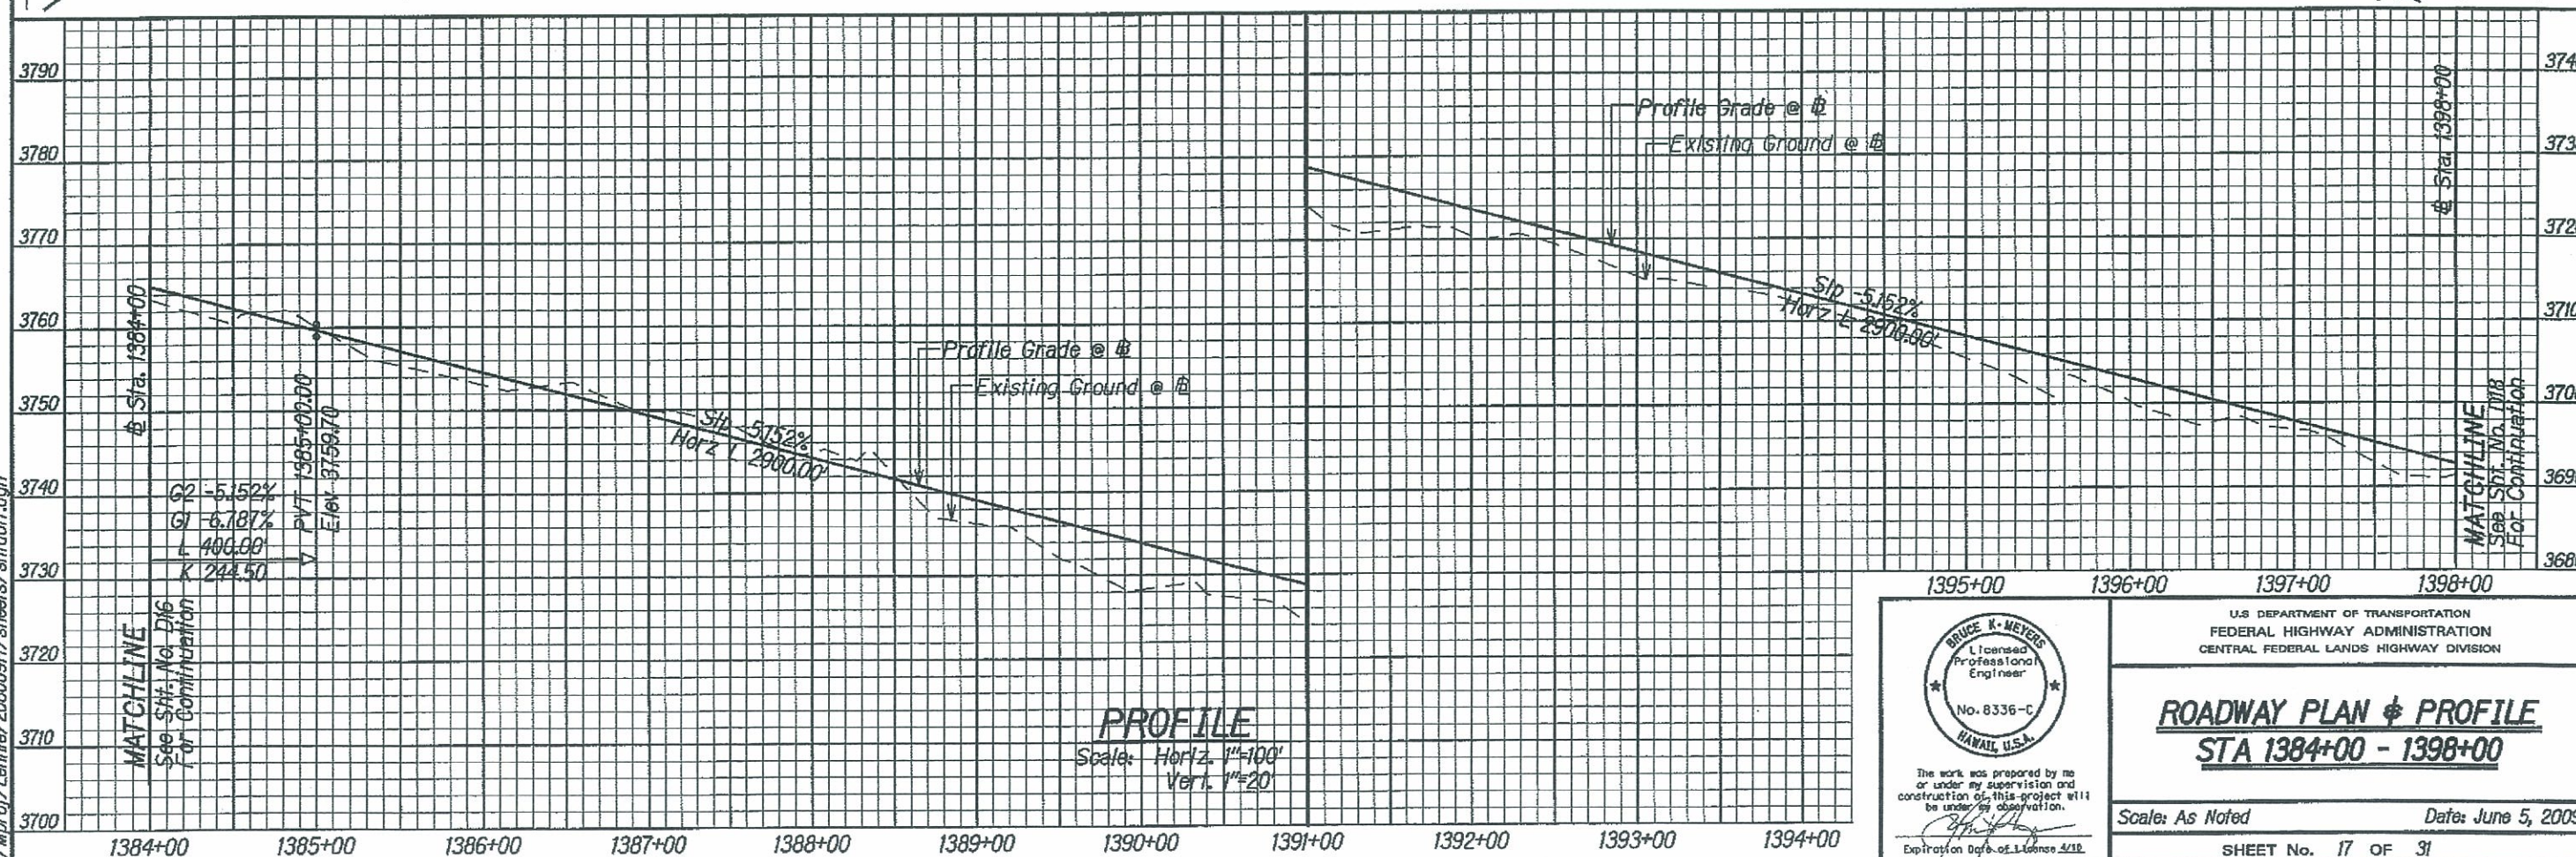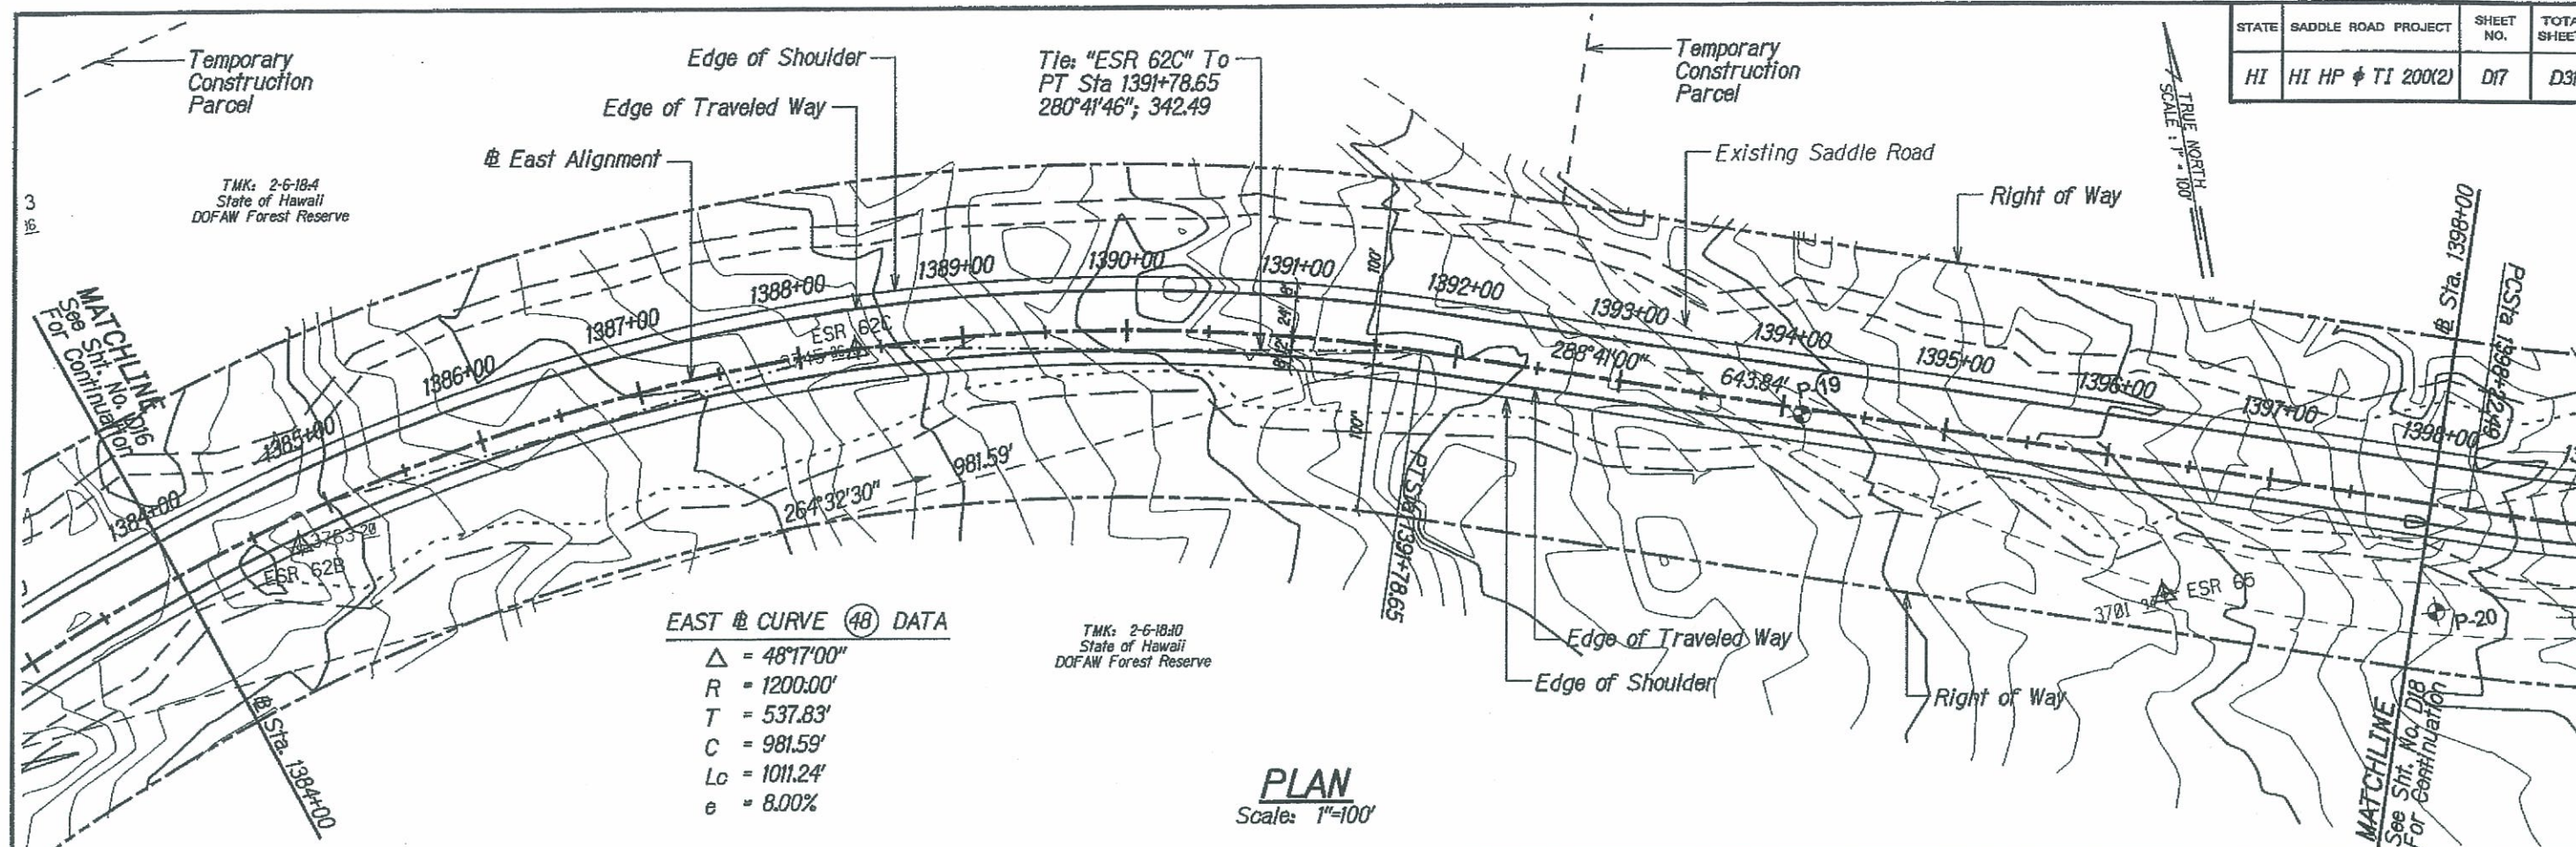

M:\Mpro\Lenile\200009H\sheet\shid017.dgn



| STATE | SADDLE ROAD PROJECT | SHEET NO. | TOTAL SHEETS |
|-------|---------------------|-----------|--------------|
| HI    | HI HP & TI 200(2)   | D18       | D31          |

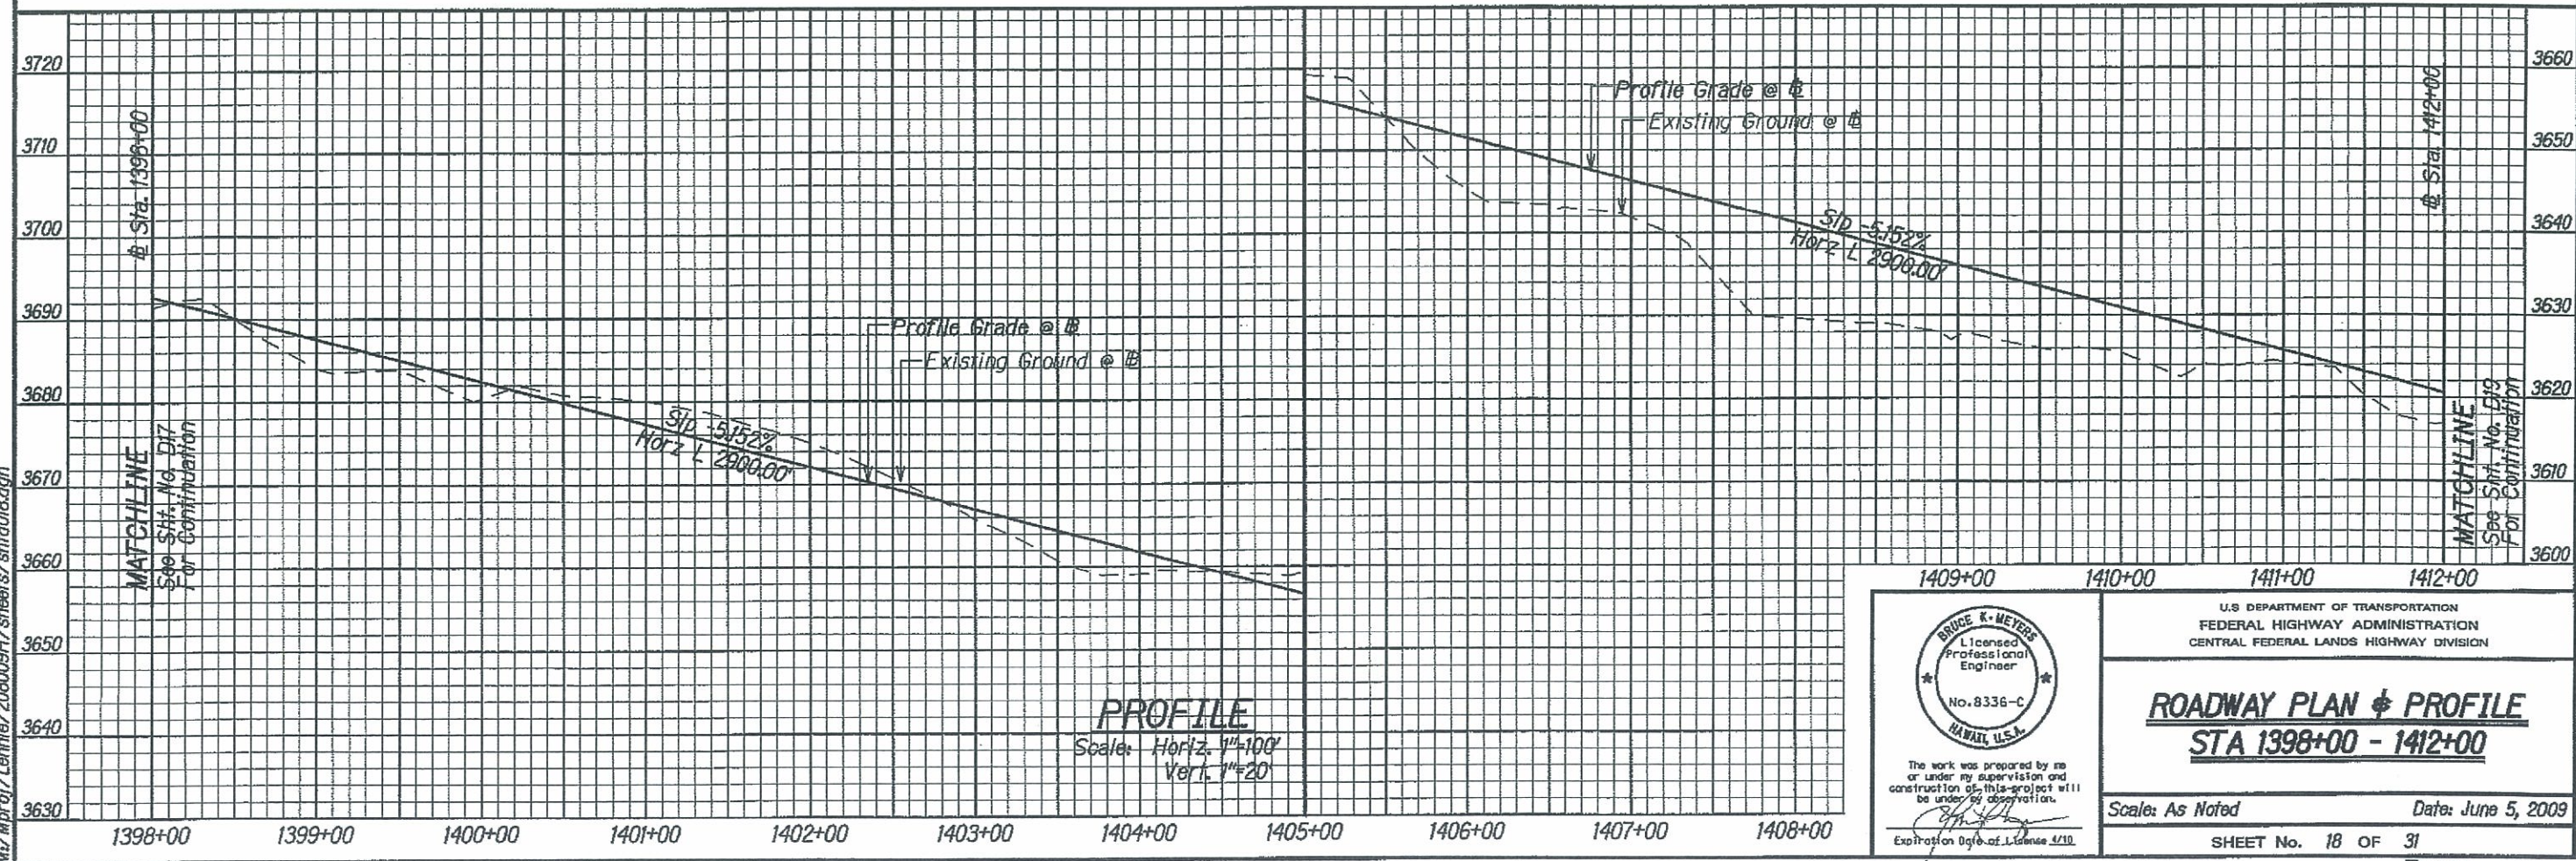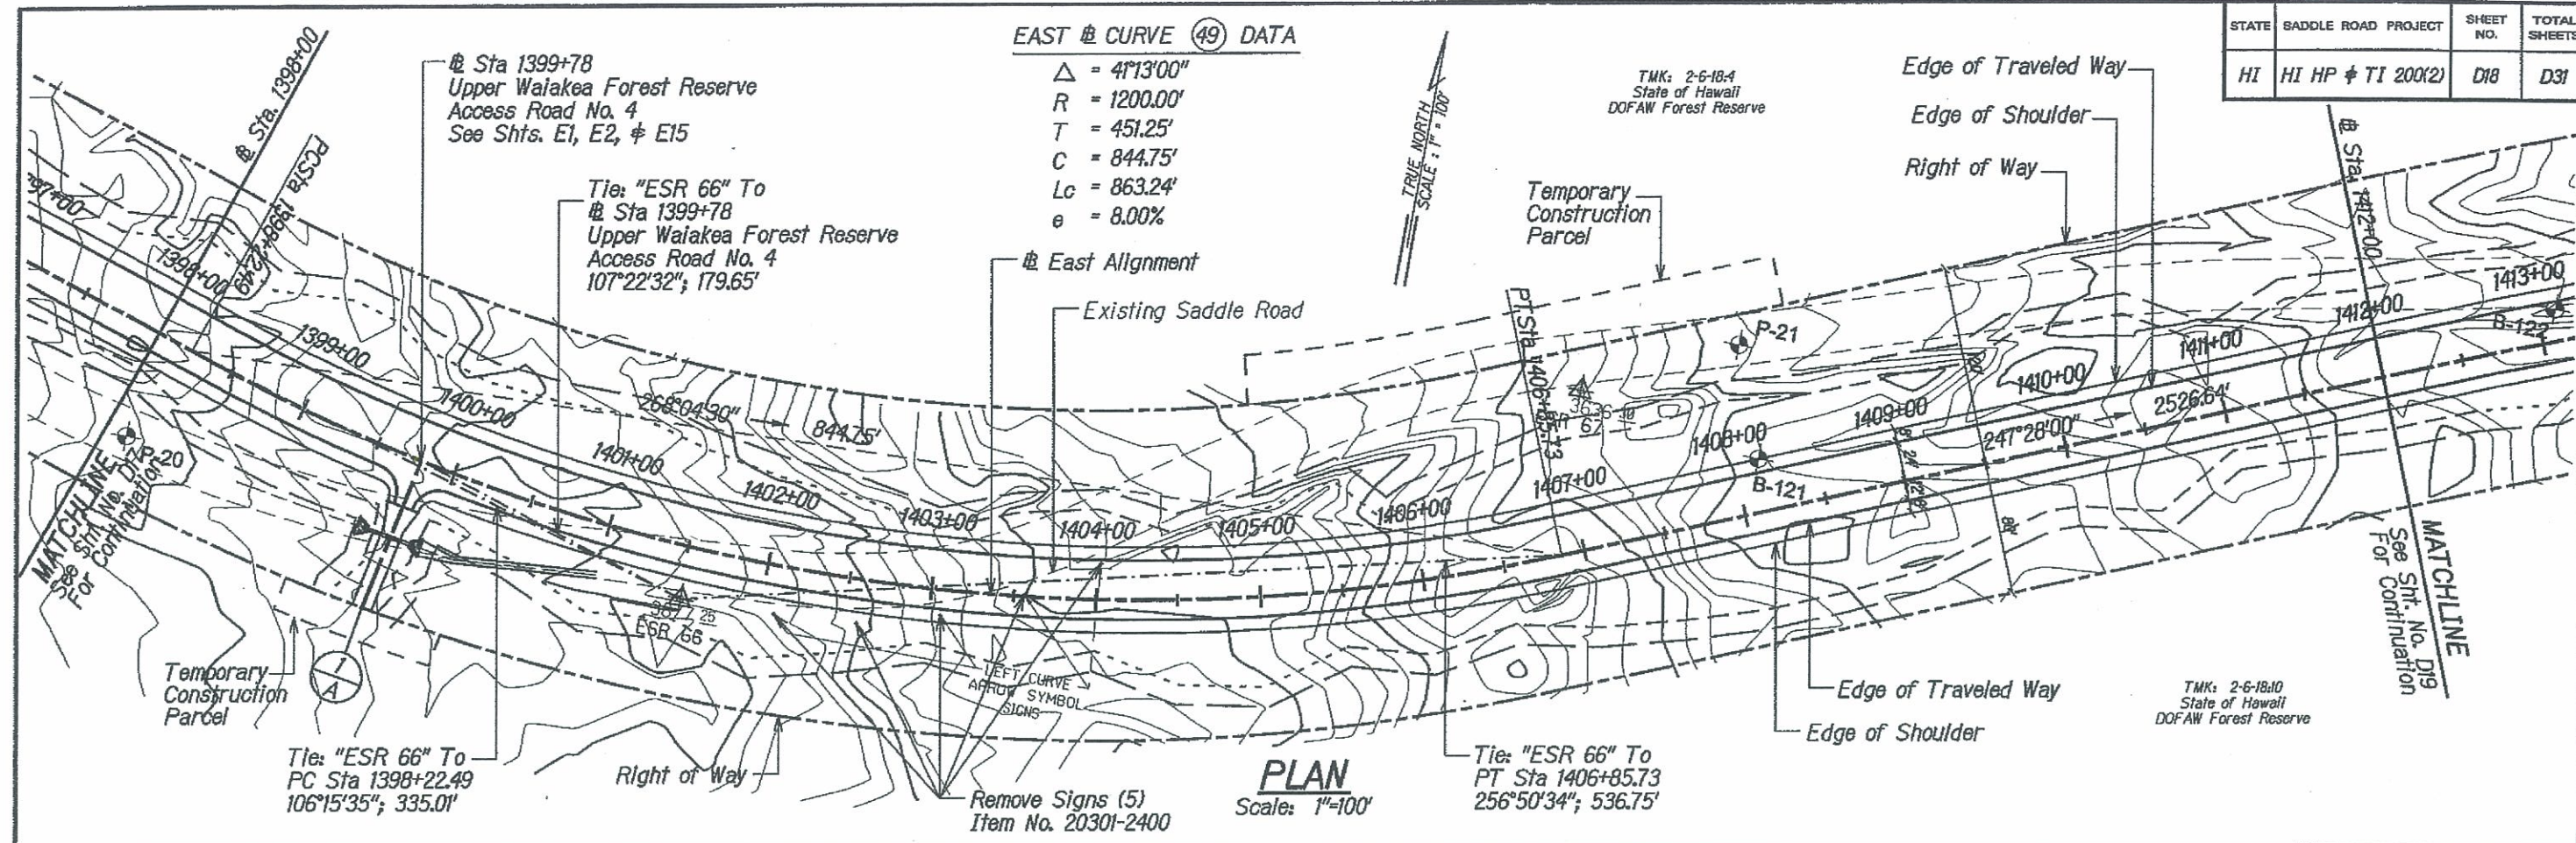

BRIDGE K. MEYERS  
Licensed Professional Engineer  
No. 8336-C  
HAWAII, U.S.A.

The work was prepared by me or under my supervision and construction of this project will be under my observation.  
Expiration Date of License 2/10

U.S. DEPARTMENT OF TRANSPORTATION  
FEDERAL HIGHWAY ADMINISTRATION  
CENTRAL FEDERAL LANDS HIGHWAY DIVISION

**ROADWAY PLAN & PROFILE**  
**STA 1398+00 - 1412+00**

Scale: As Noted      Date: June 5, 2009


SHEET No. 18 OF 31

1409+00    1410+00    1411+00    1412+00




TMK: 2-6-18A  
State of Hawaii  
DOFAW Forest Reserve


| STATE | SADDLE ROAD PROJECT | SHEET NO. | TOTAL SHEETS |
|-------|---------------------|-----------|--------------|
| HI    | HI HP & TI 200(2)   | D19       | D31          |

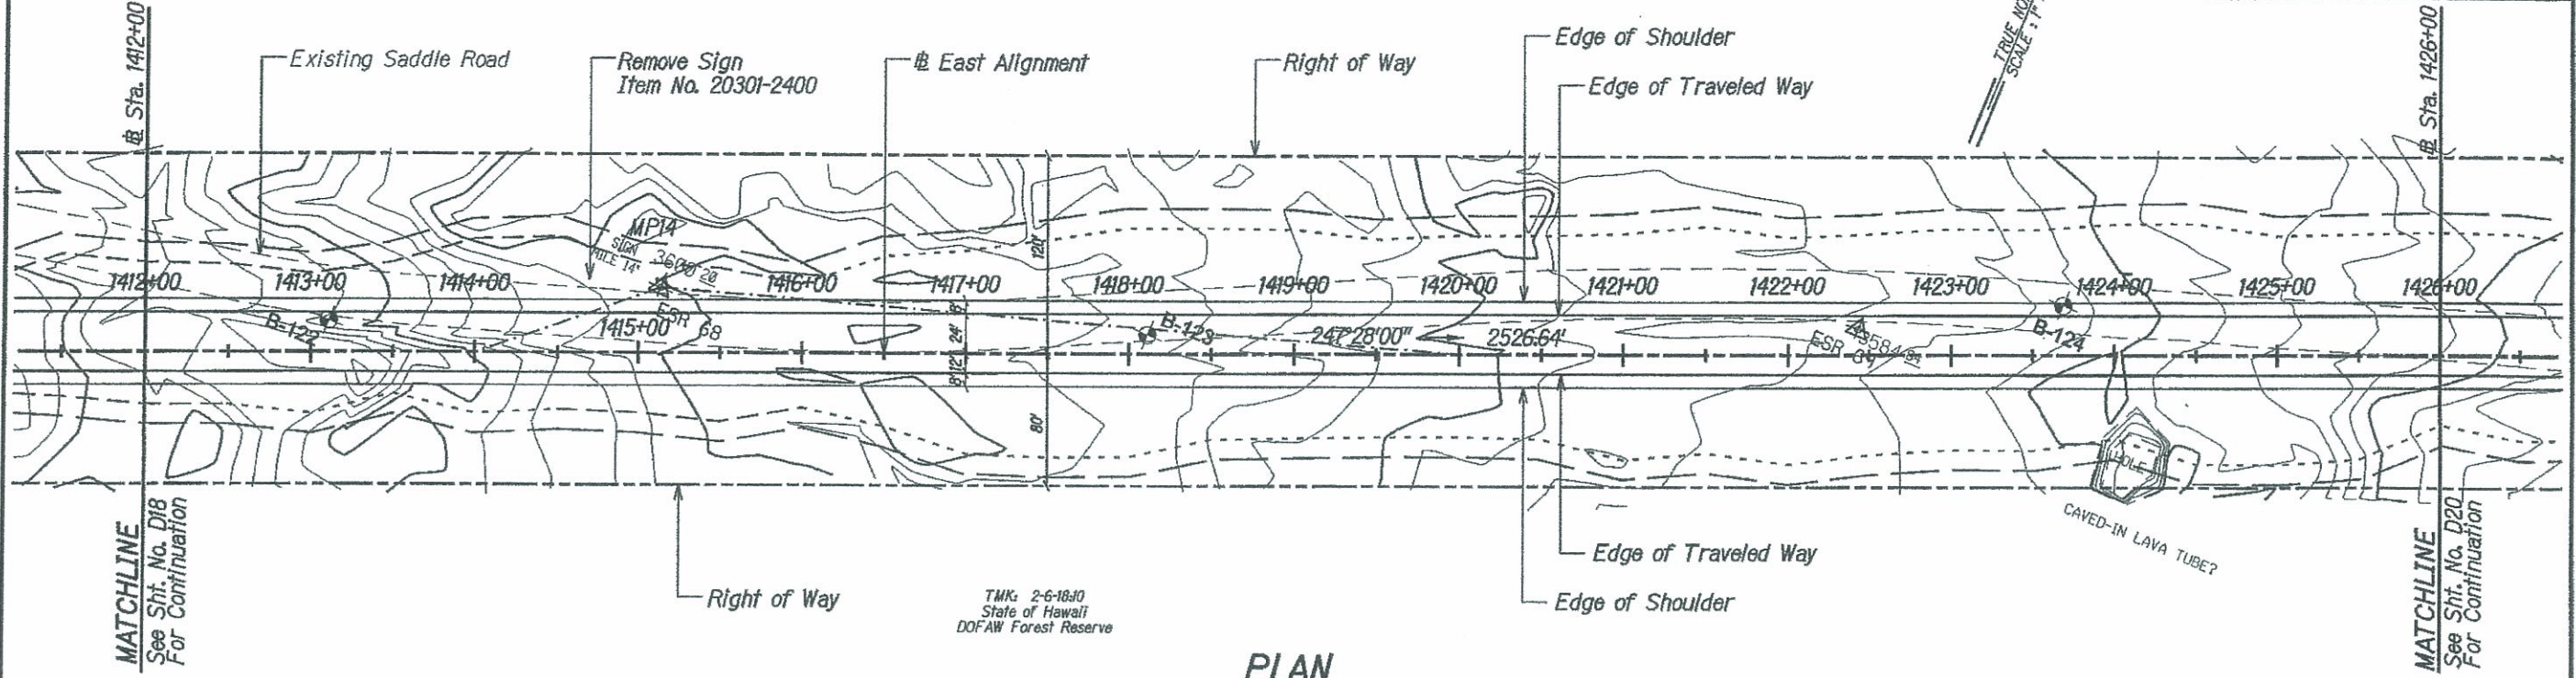

**PLAN**  
Scale: 1"=100'

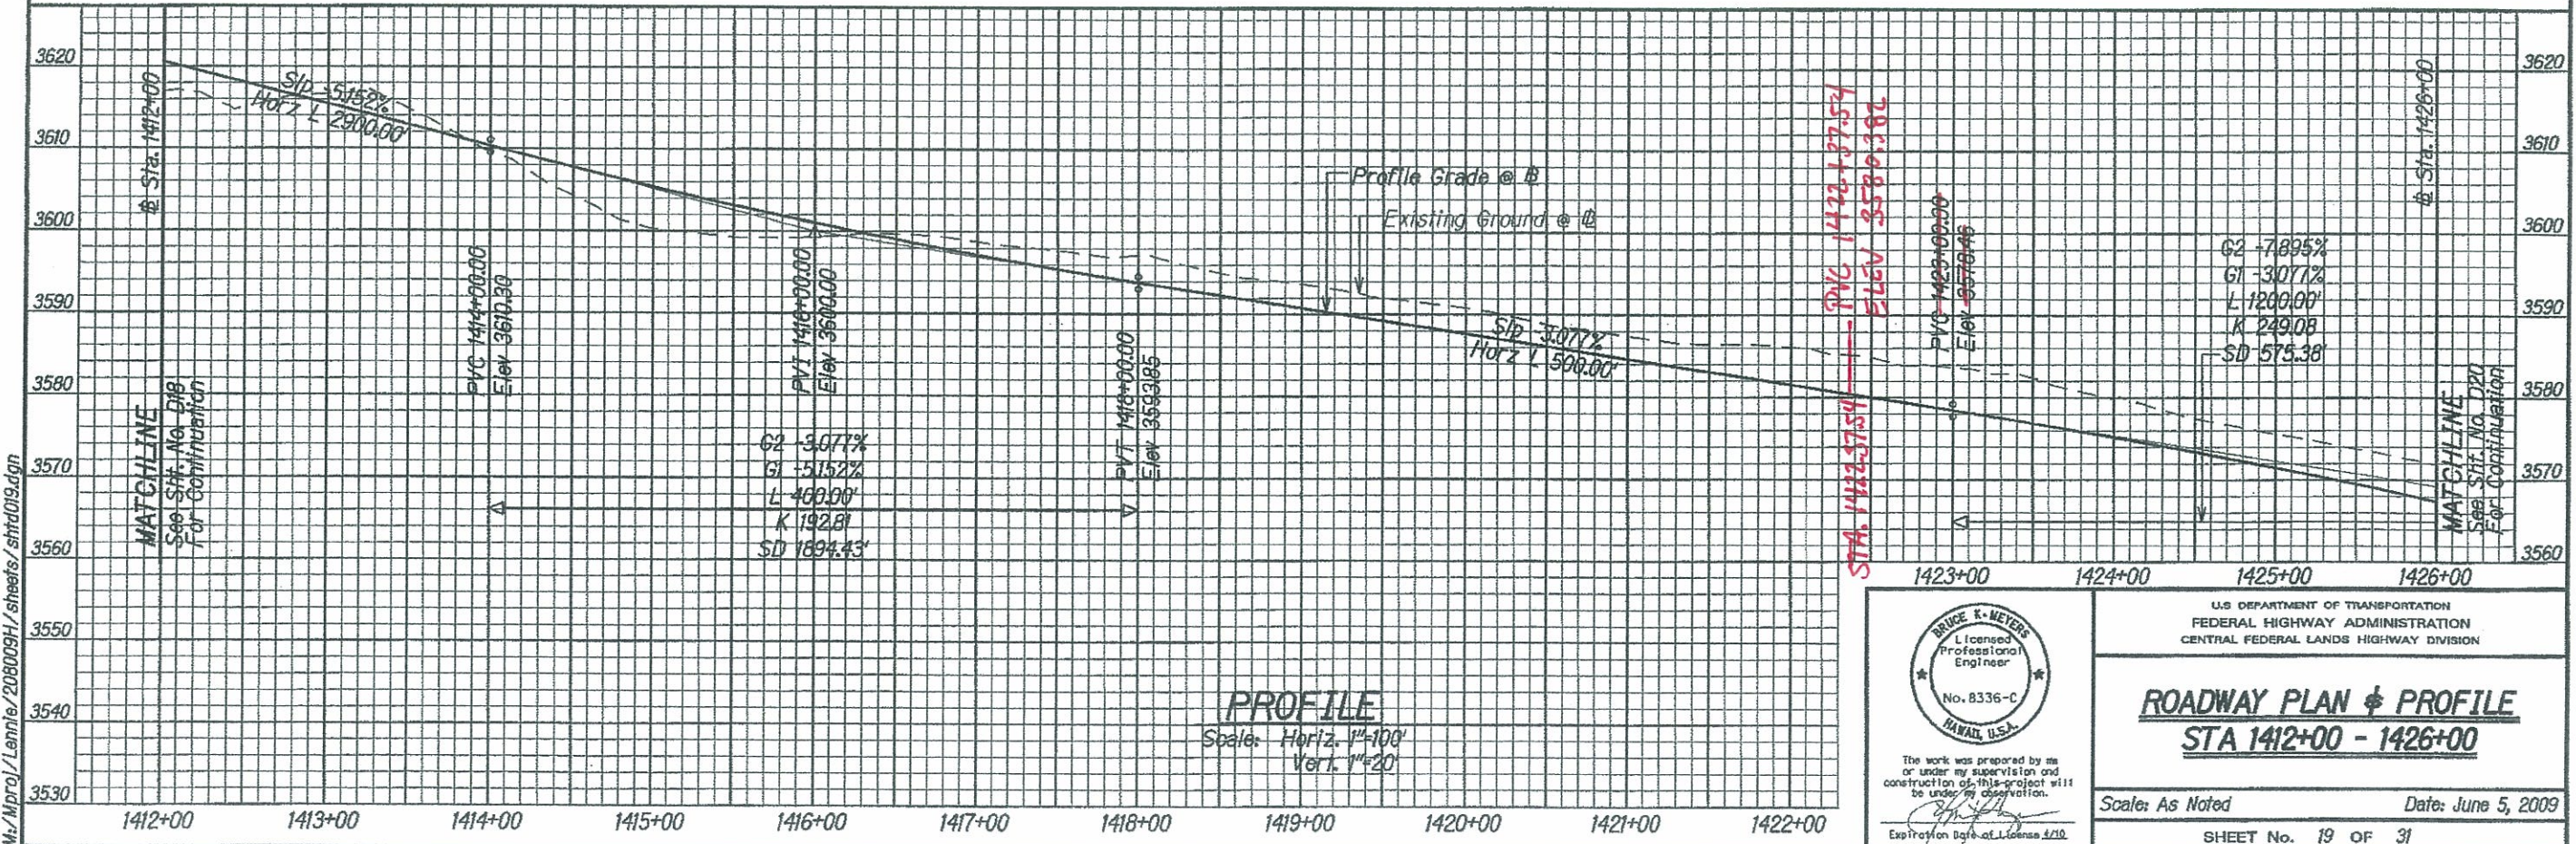

**PROFILE**  
Scale: Horiz. 1"=100'  
Vert. 1"=20'

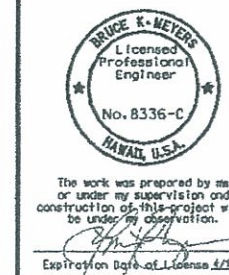

U.S. DEPARTMENT OF TRANSPORTATION  
FEDERAL HIGHWAY ADMINISTRATION  
CENTRAL FEDERAL LANDS HIGHWAY DIVISION

**ROADWAY PLAN & PROFILE**  
**STA 1412+00 - 1426+00**

Scale: As Noted Date: June 5, 2009




SHEET No. 19 OF 31







| STATE | SADDLE ROAD PROJECT | SHEET NO. | TOTAL SHEETS |
|-------|---------------------|-----------|--------------|
| HI    | HI HP & TI 200(2)   | D21       | D31          |

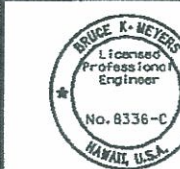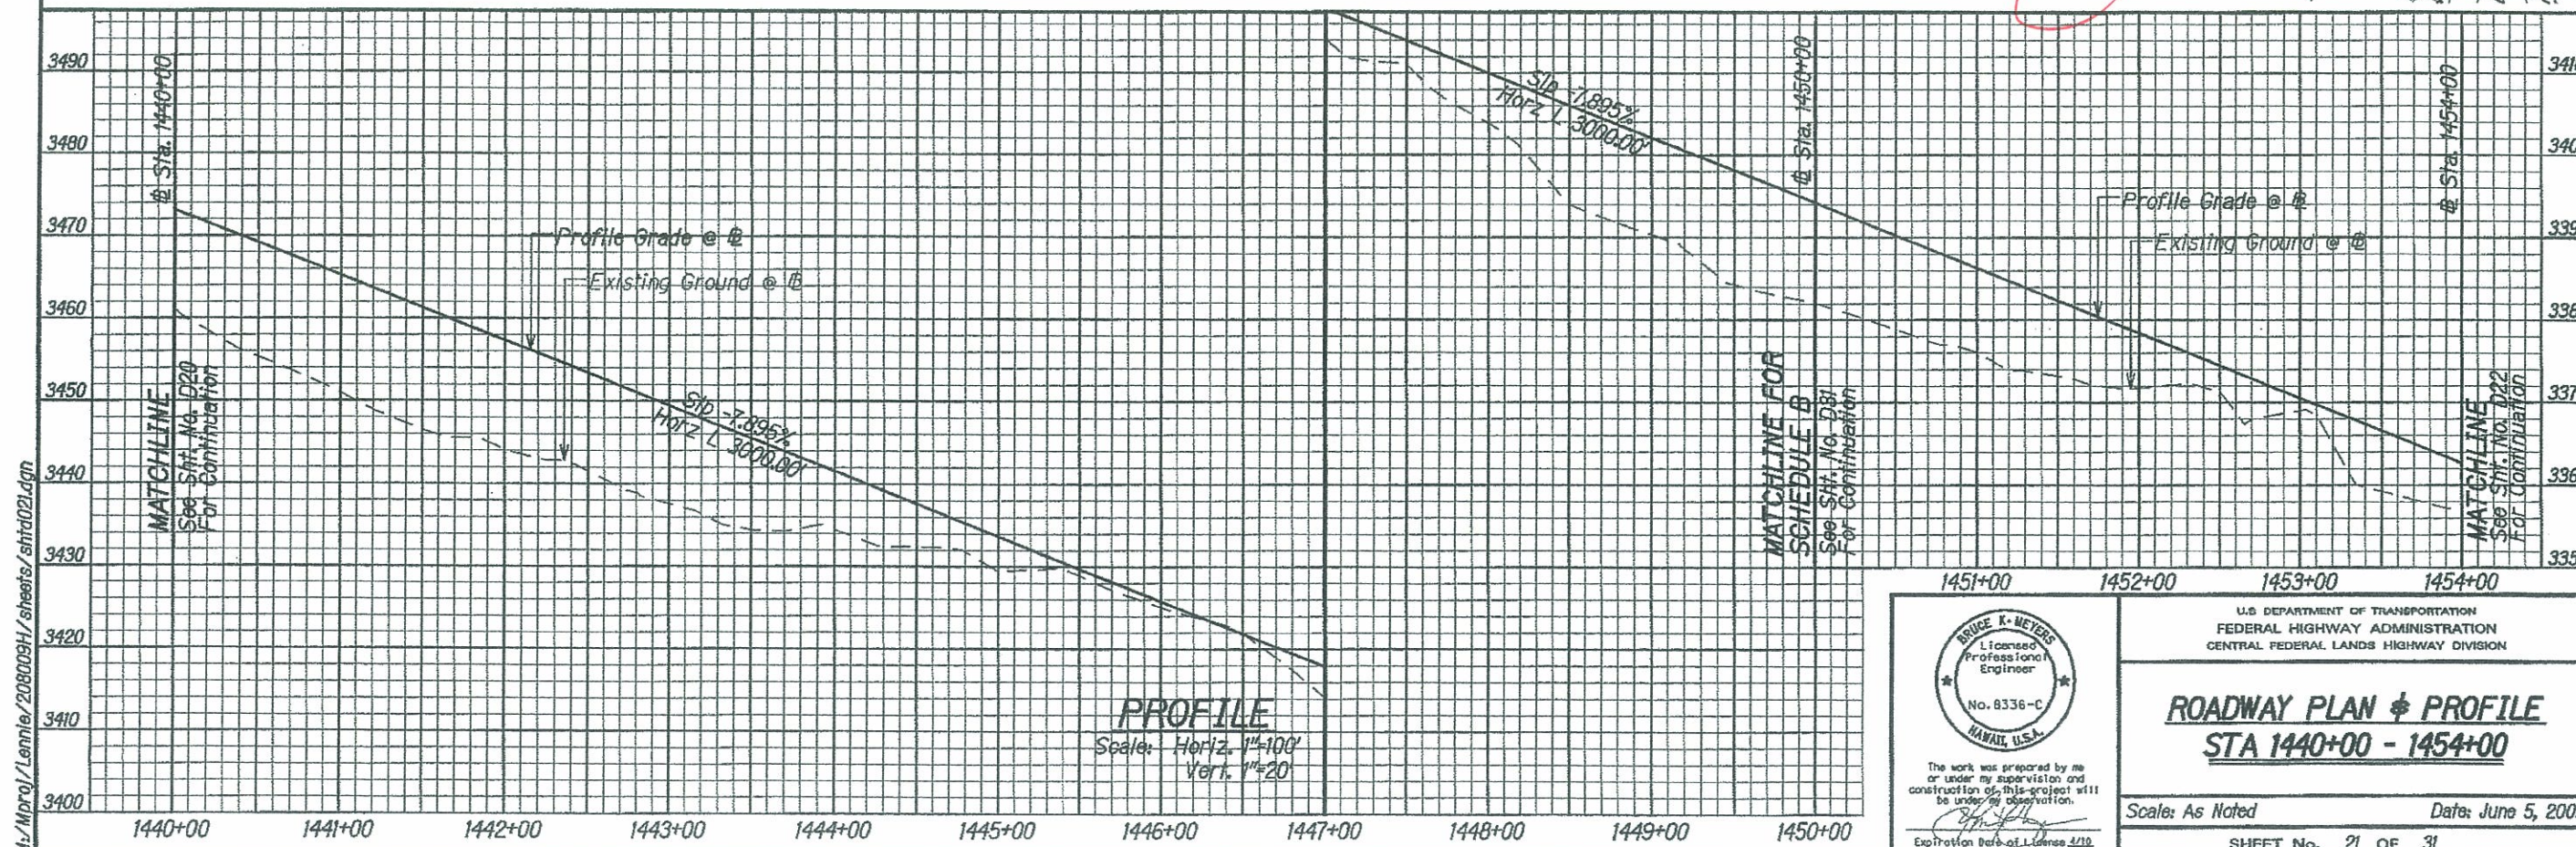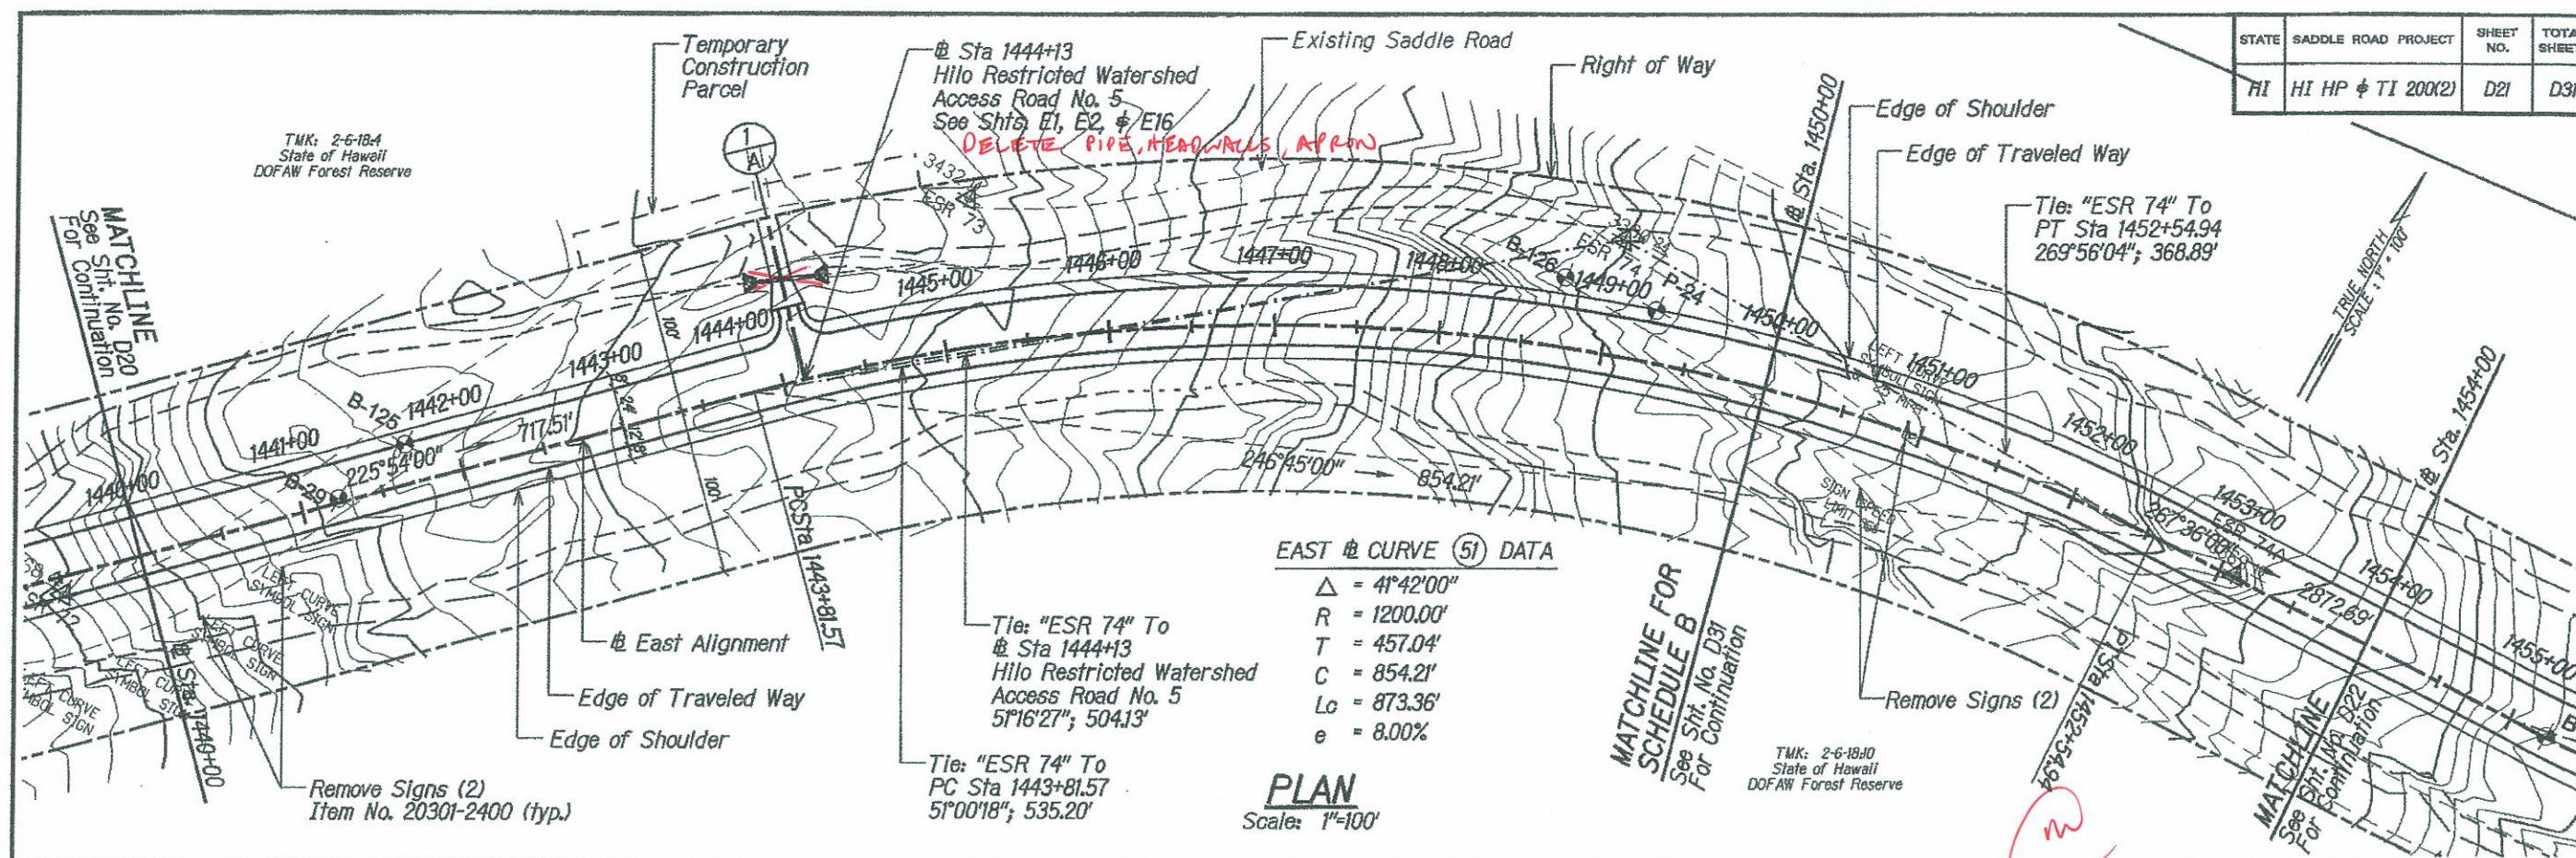

The work was prepared by me  
or under my supervision and  
construction of this project will  
be under my observation.  
*Bruce K. Meyers*  
Expiration Date of License 4/10

U.S. DEPARTMENT OF TRANSPORTATION  
FEDERAL HIGHWAY ADMINISTRATION  
CENTRAL FEDERAL LANDS HIGHWAY DIVISION


# **ROADWAY PLAN & PROFILE** **STA 1440+00 - 1454+00**

Scale: As Noted Date: June 5, 2009  
SHEET No. 21 OF 31




| STATE | SADDLE ROAD PROJECT | SHEET NO. | TOTAL SHEETS |
|-------|---------------------|-----------|--------------|
| HI    | HI HP & TI 200(2)   | D22       | D31          |

TMK: 2-6-18-4  
State of Hawaii  
DOFAW Forest Reserve

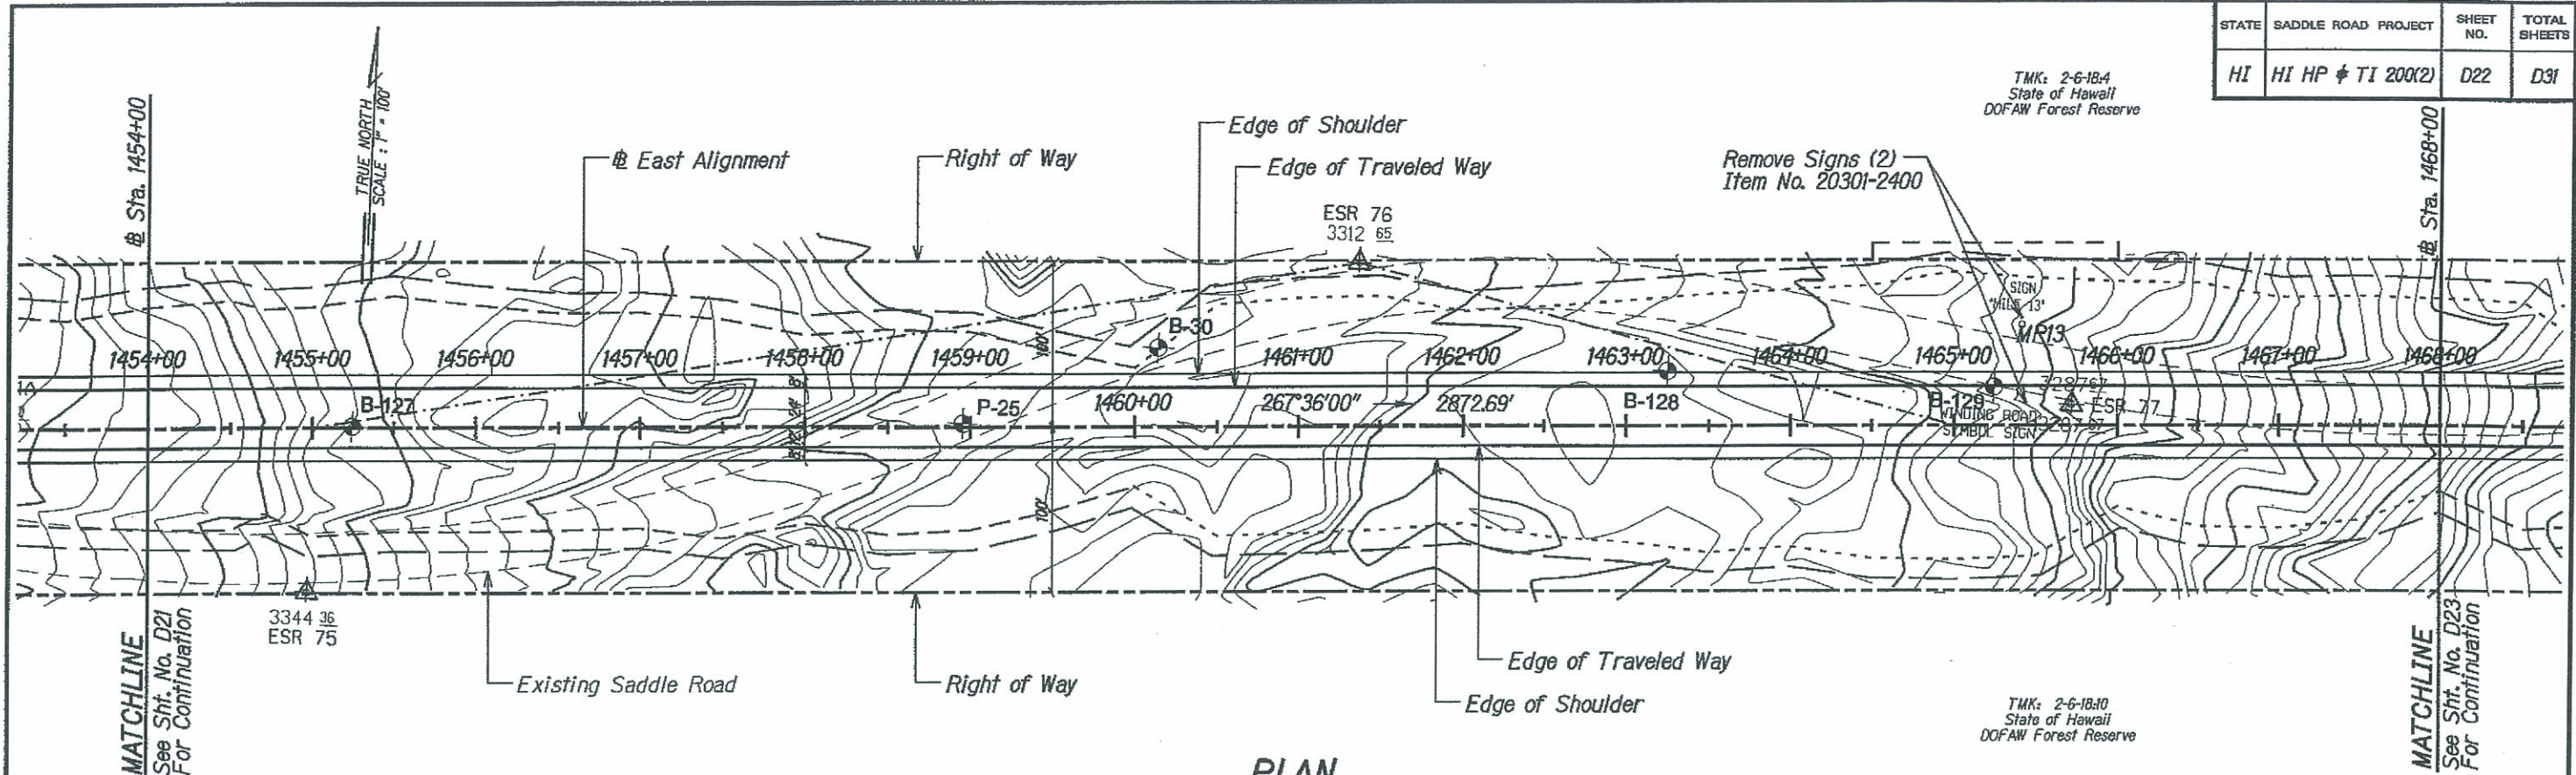

**PLAN**  
Scale: 1"=100'

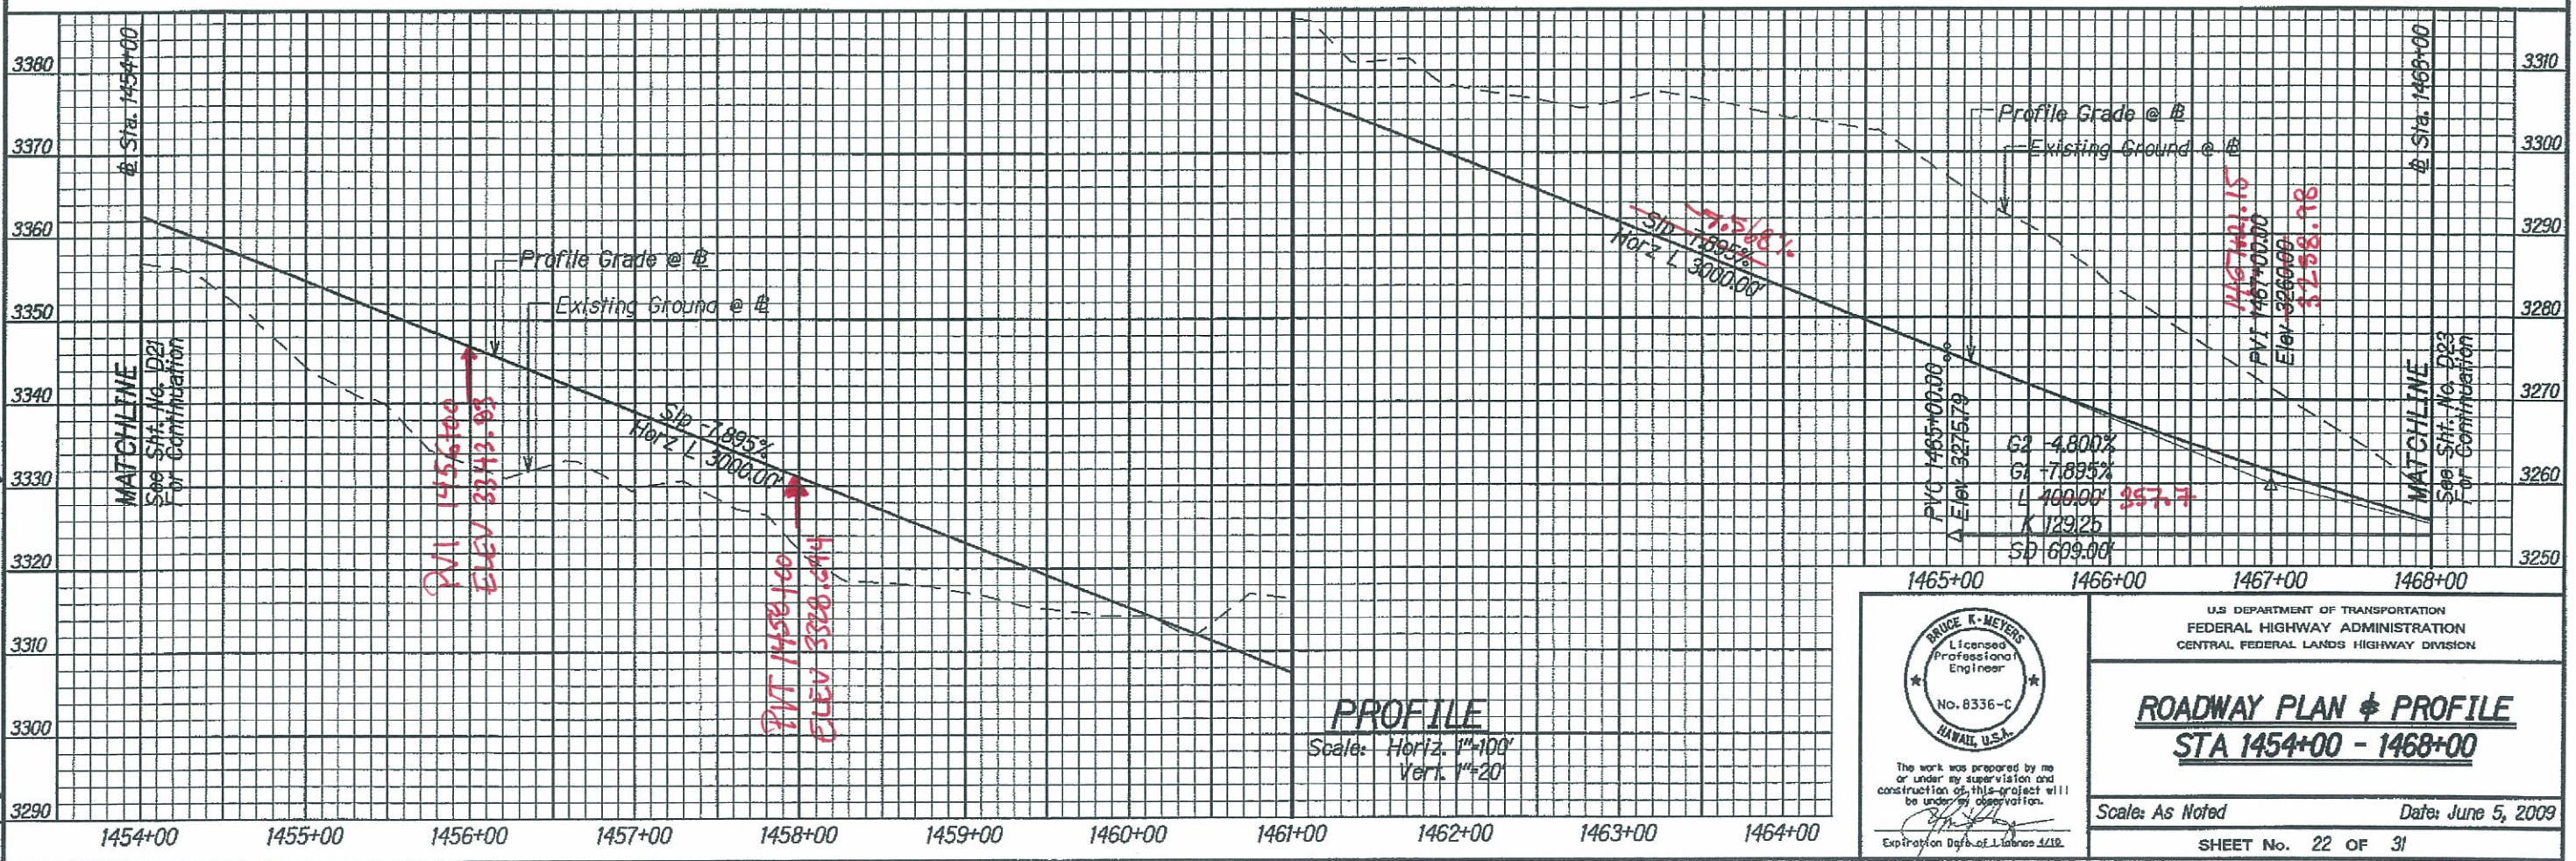

**PROFILE**  
Scale: Horiz. 1"=100'  
Vert. 1"=20'

BRUCE R. MEYERS  
Licensed Professional Engineer  
No. 8336-C  
HAWAII, U.S.A.

The work was prepared by me or under my supervision and construction of this project will be under my observation.

Expiration Date of License 2/12

U.S. DEPARTMENT OF TRANSPORTATION  
FEDERAL HIGHWAY ADMINISTRATION  
CENTRAL FEDERAL LANDS HIGHWAY DIVISION

**ROADWAY PLAN & PROFILE**  
**STA 1454+00 - 1468+00**

Scales: As Noted      Date: June 5, 2009



SHEET No. 22 OF 31

D22

M:\Mproj\Lenhle\200809H\Sheets\shd022.dgn



| STATE | SADDLE ROAD PROJECT | SHEET NO. | TOTAL SHEETS |
|-------|---------------------|-----------|--------------|
| HI    | HI HP & TI 200(2)   | D23       | D31          |

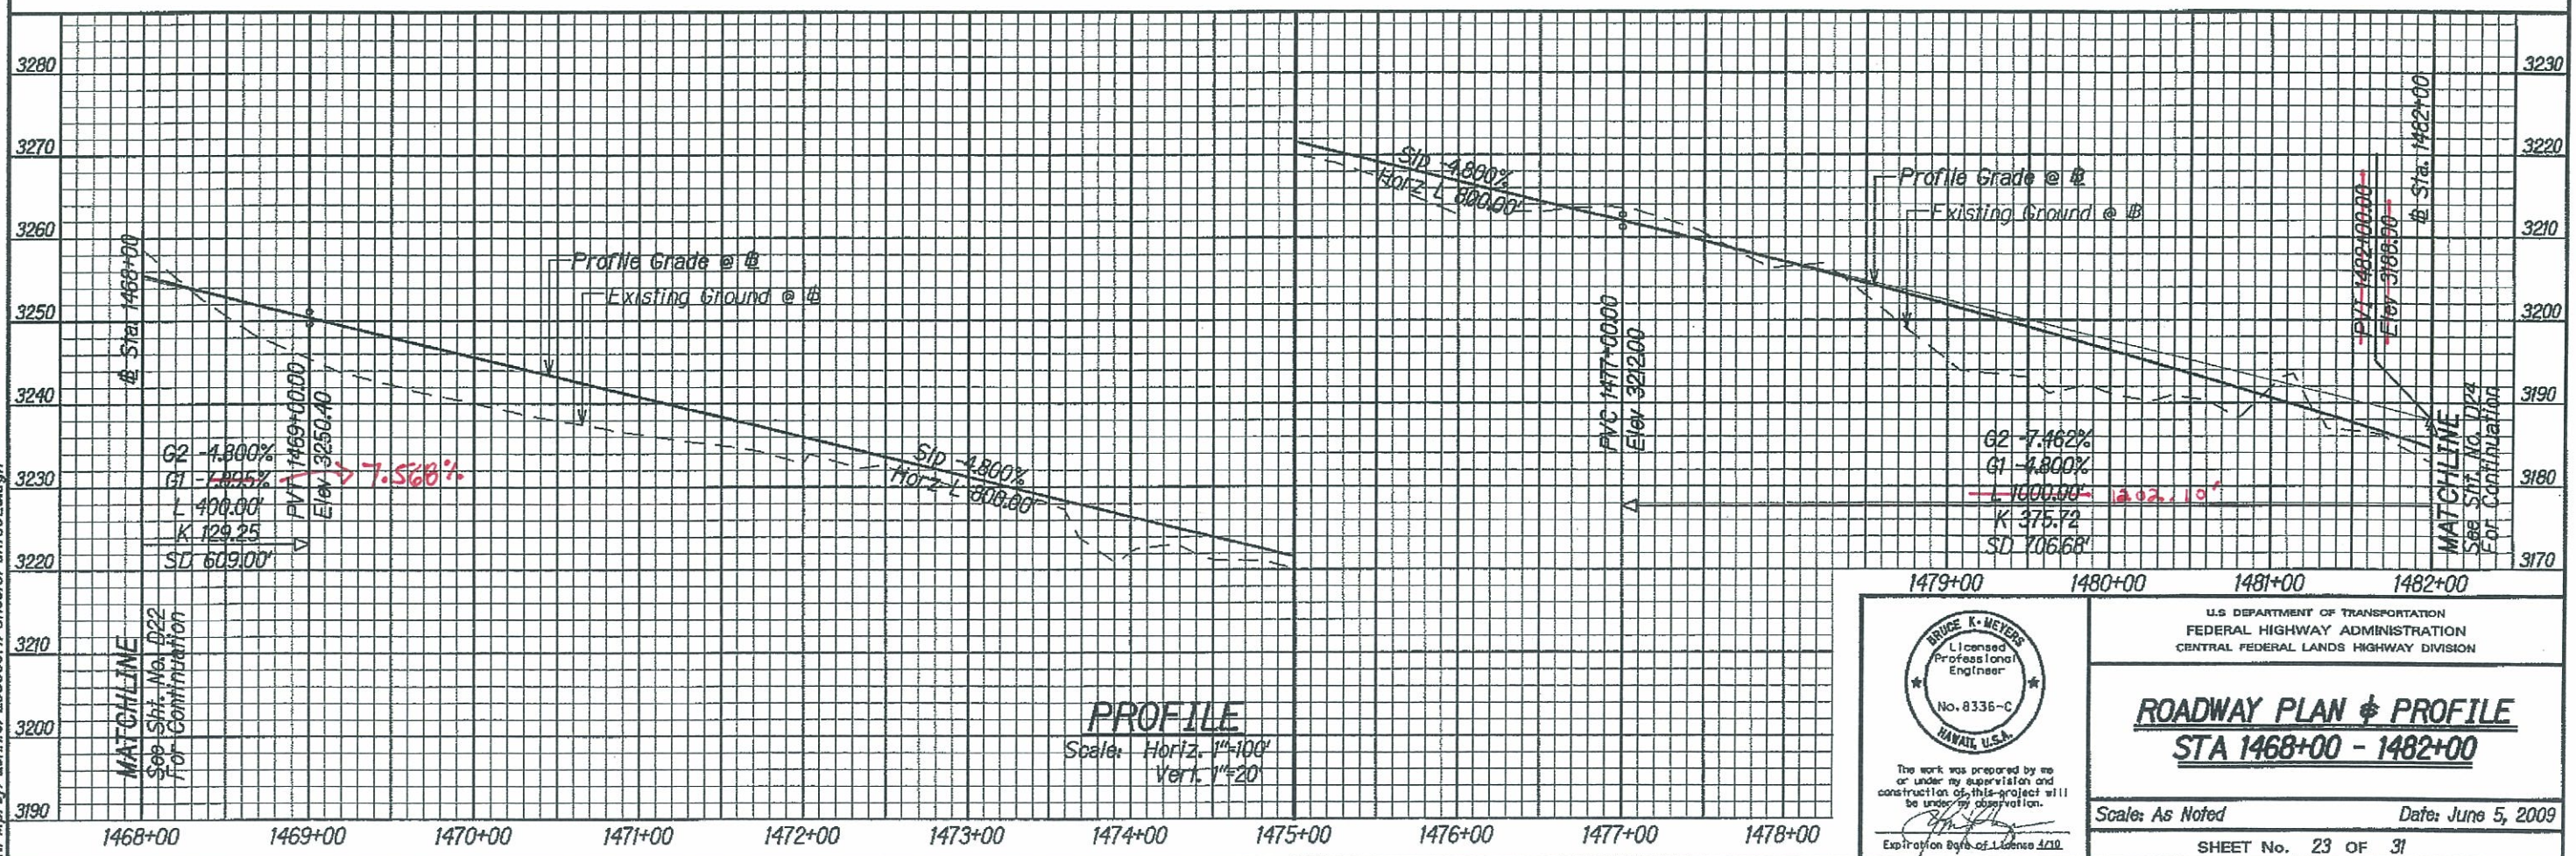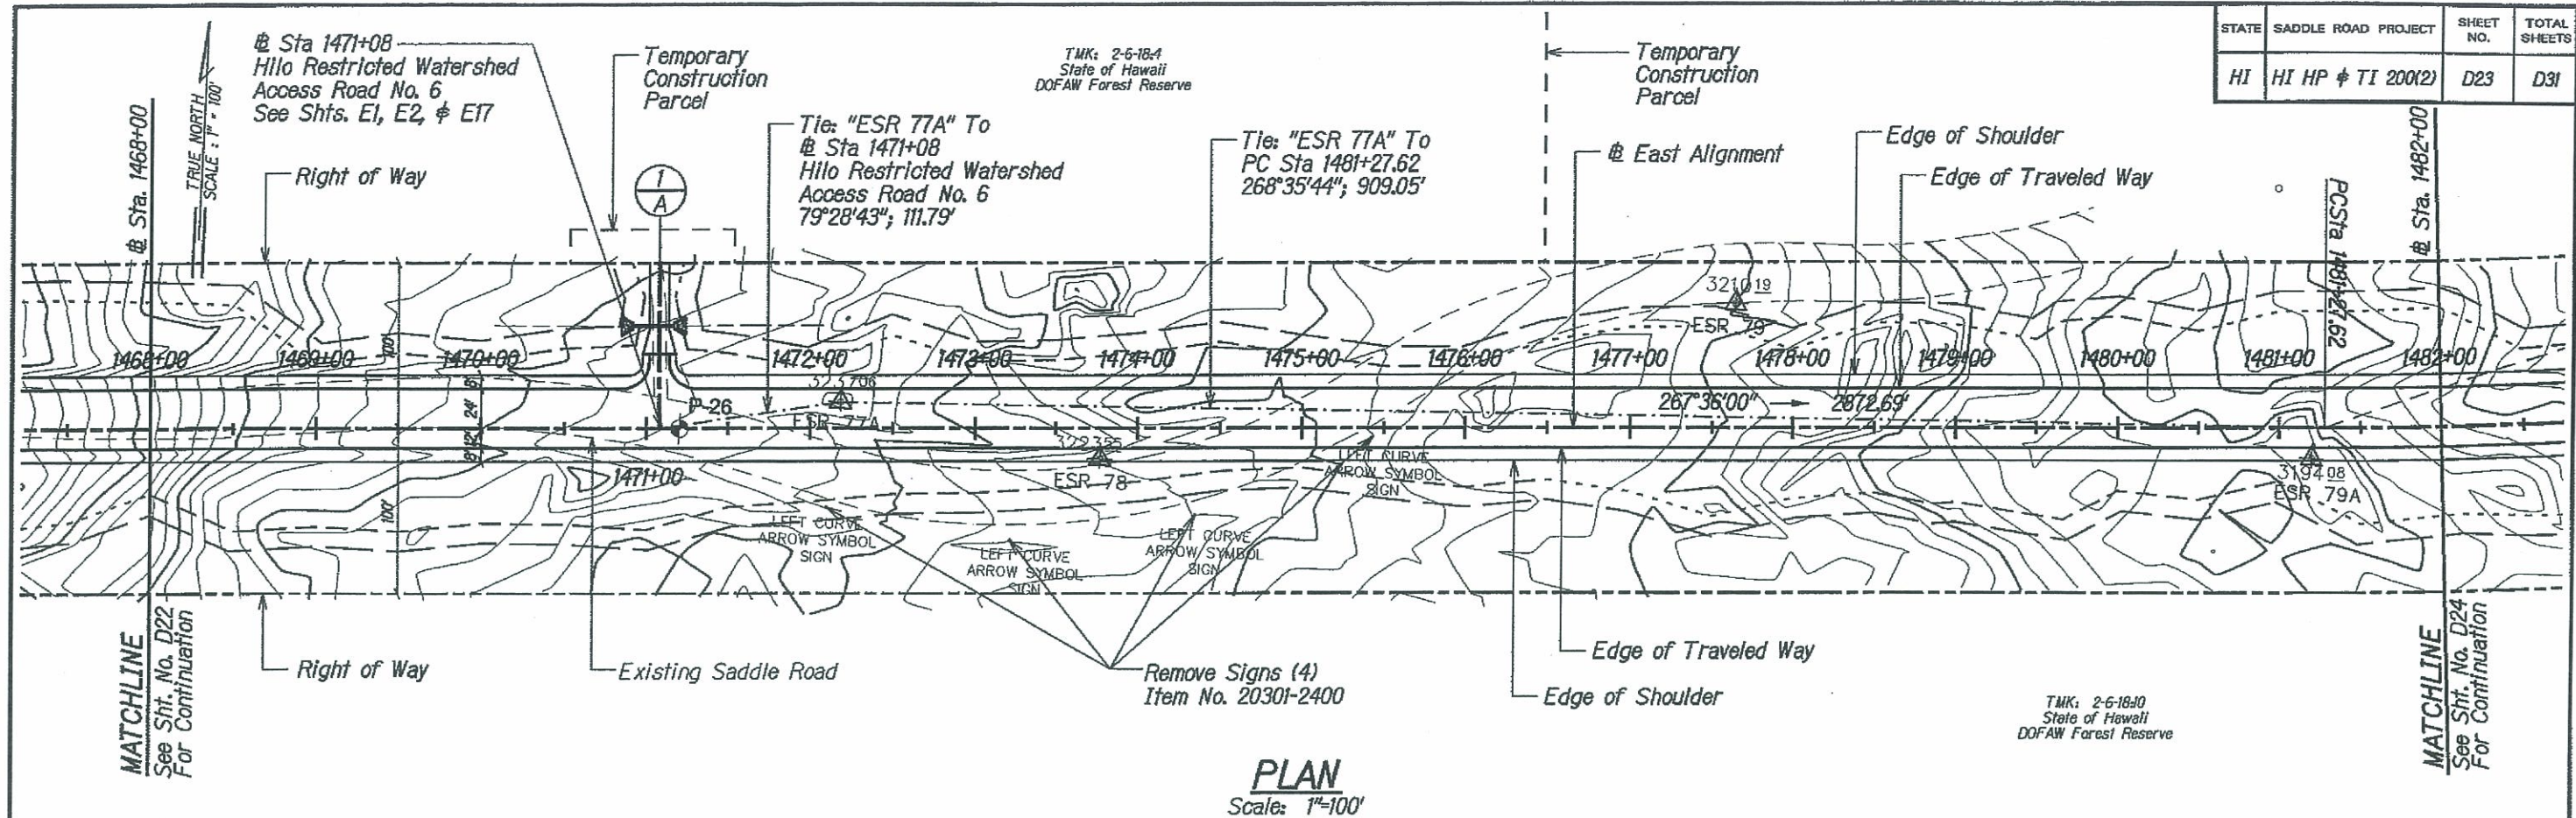

**BRUCE K. MEYERS**  
 Licensed Professional Engineer  
 No. 8336-C  
 HAWAII, U.S.A.

The work was prepared by me or under my supervision and construction of this project will be under my observation.

Expiration Date of License 4/10

U.S. DEPARTMENT OF TRANSPORTATION  
 FEDERAL HIGHWAY ADMINISTRATION  
 CENTRAL FEDERAL LANDS HIGHWAY DIVISION



**ROADWAY PLAN & PROFILE**  
**STA 1468+00 - 1482+00**

Scale: As Noted Date: June 5, 2009

SHEET No. 23 OF 31



| STATE | SADDLE ROAD PROJECT | SHEET NO. | TOTAL SHEETS |
|-------|---------------------|-----------|--------------|
| HI    | HI HP & TI 200(2)   | D24       | D31          |

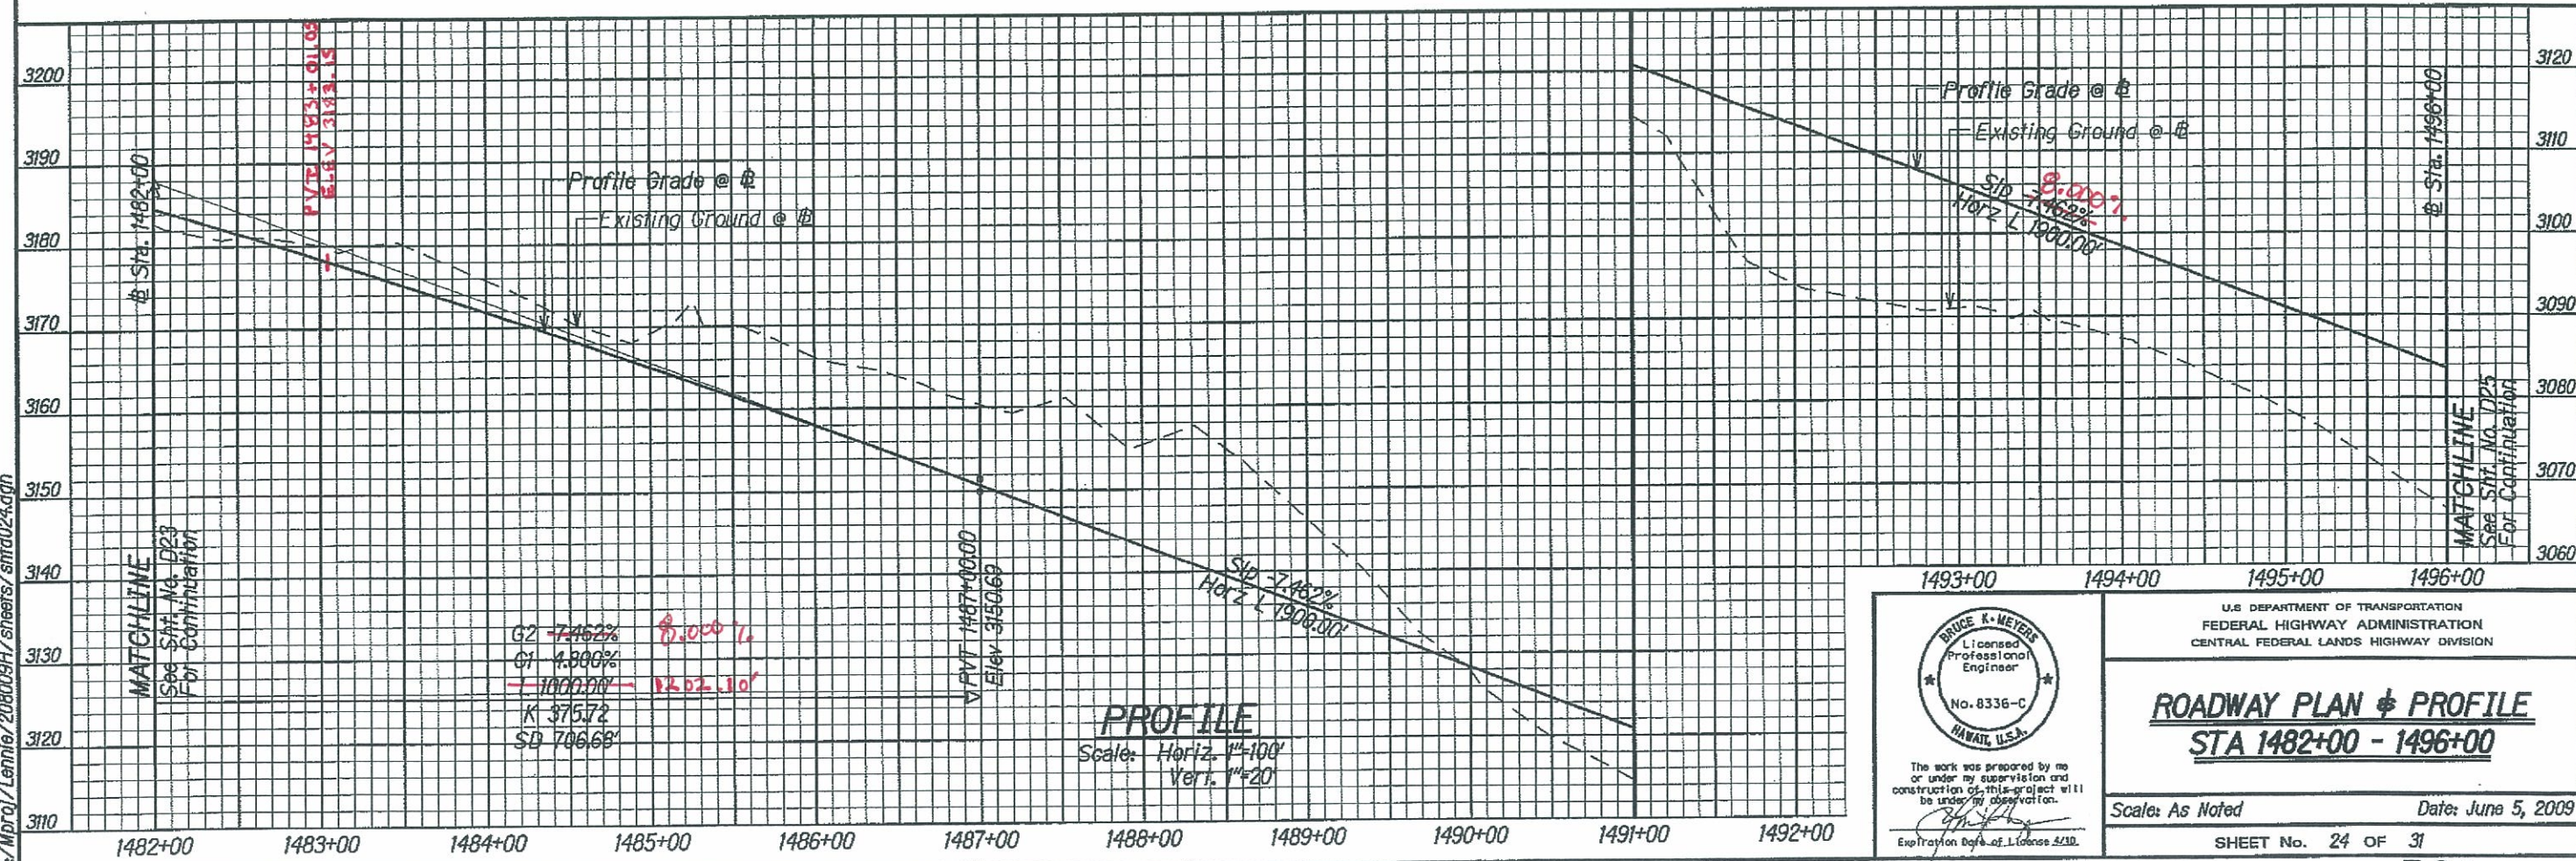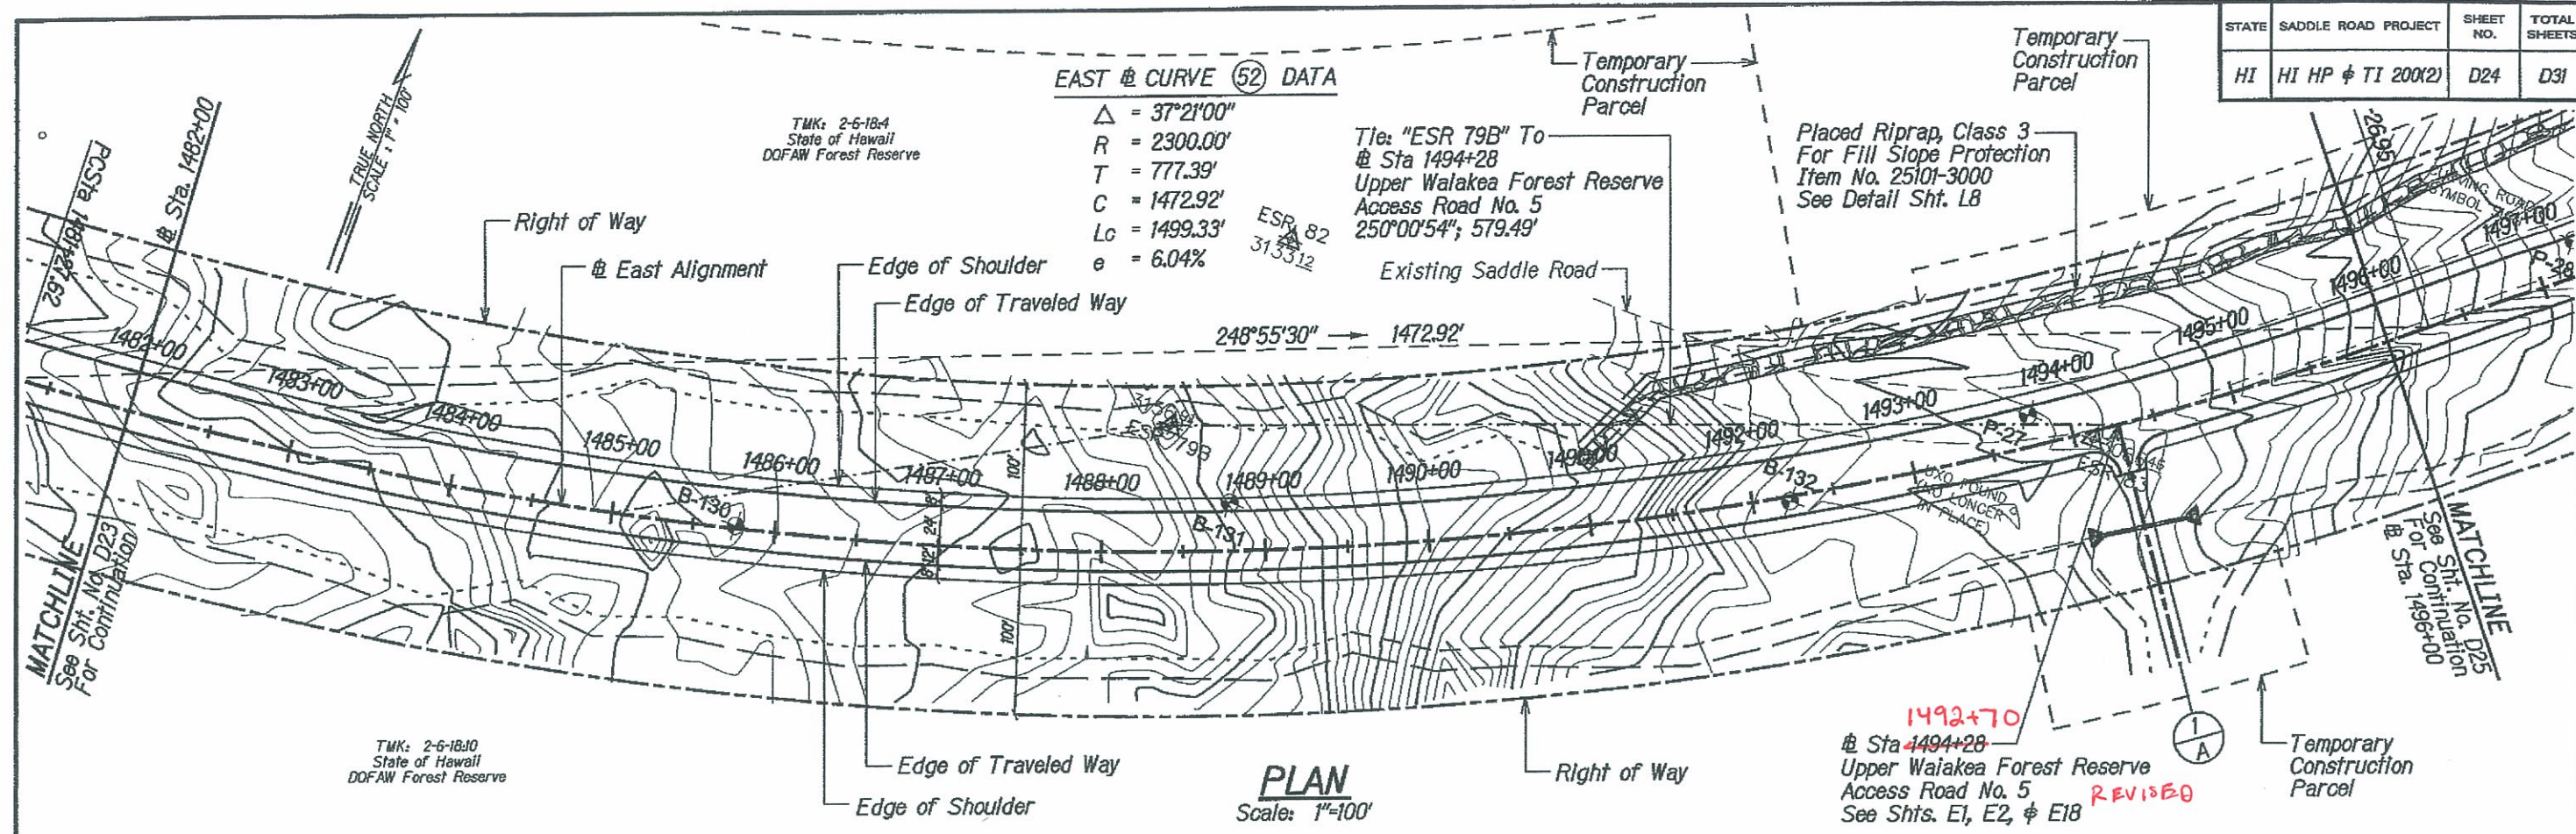

BRUCE K. MEYERS  
Licensed Professional Engineer  
No. 8336-C  
HAWAII, U.S.A.

The work was prepared by me or under my supervision and construction of this project will be under my observation.

Expiration Date of License 2/10.

U.S. DEPARTMENT OF TRANSPORTATION  
FEDERAL HIGHWAY ADMINISTRATION  
CENTRAL FEDERAL LANDS HIGHWAY DIVISION

**ROADWAY PLAN & PROFILE**  
**STA 1482+00 - 1496+00**


Scales: As Noted      Date: June 5, 2009

SHEET No. 24 OF 31

**D24**




| STATE | SADDLE ROAD PROJECT | SHEET NO. | TOTAL SHEETS |
|-------|---------------------|-----------|--------------|
| HI    | HI HP & TI 200(2)   | D25       | D31          |

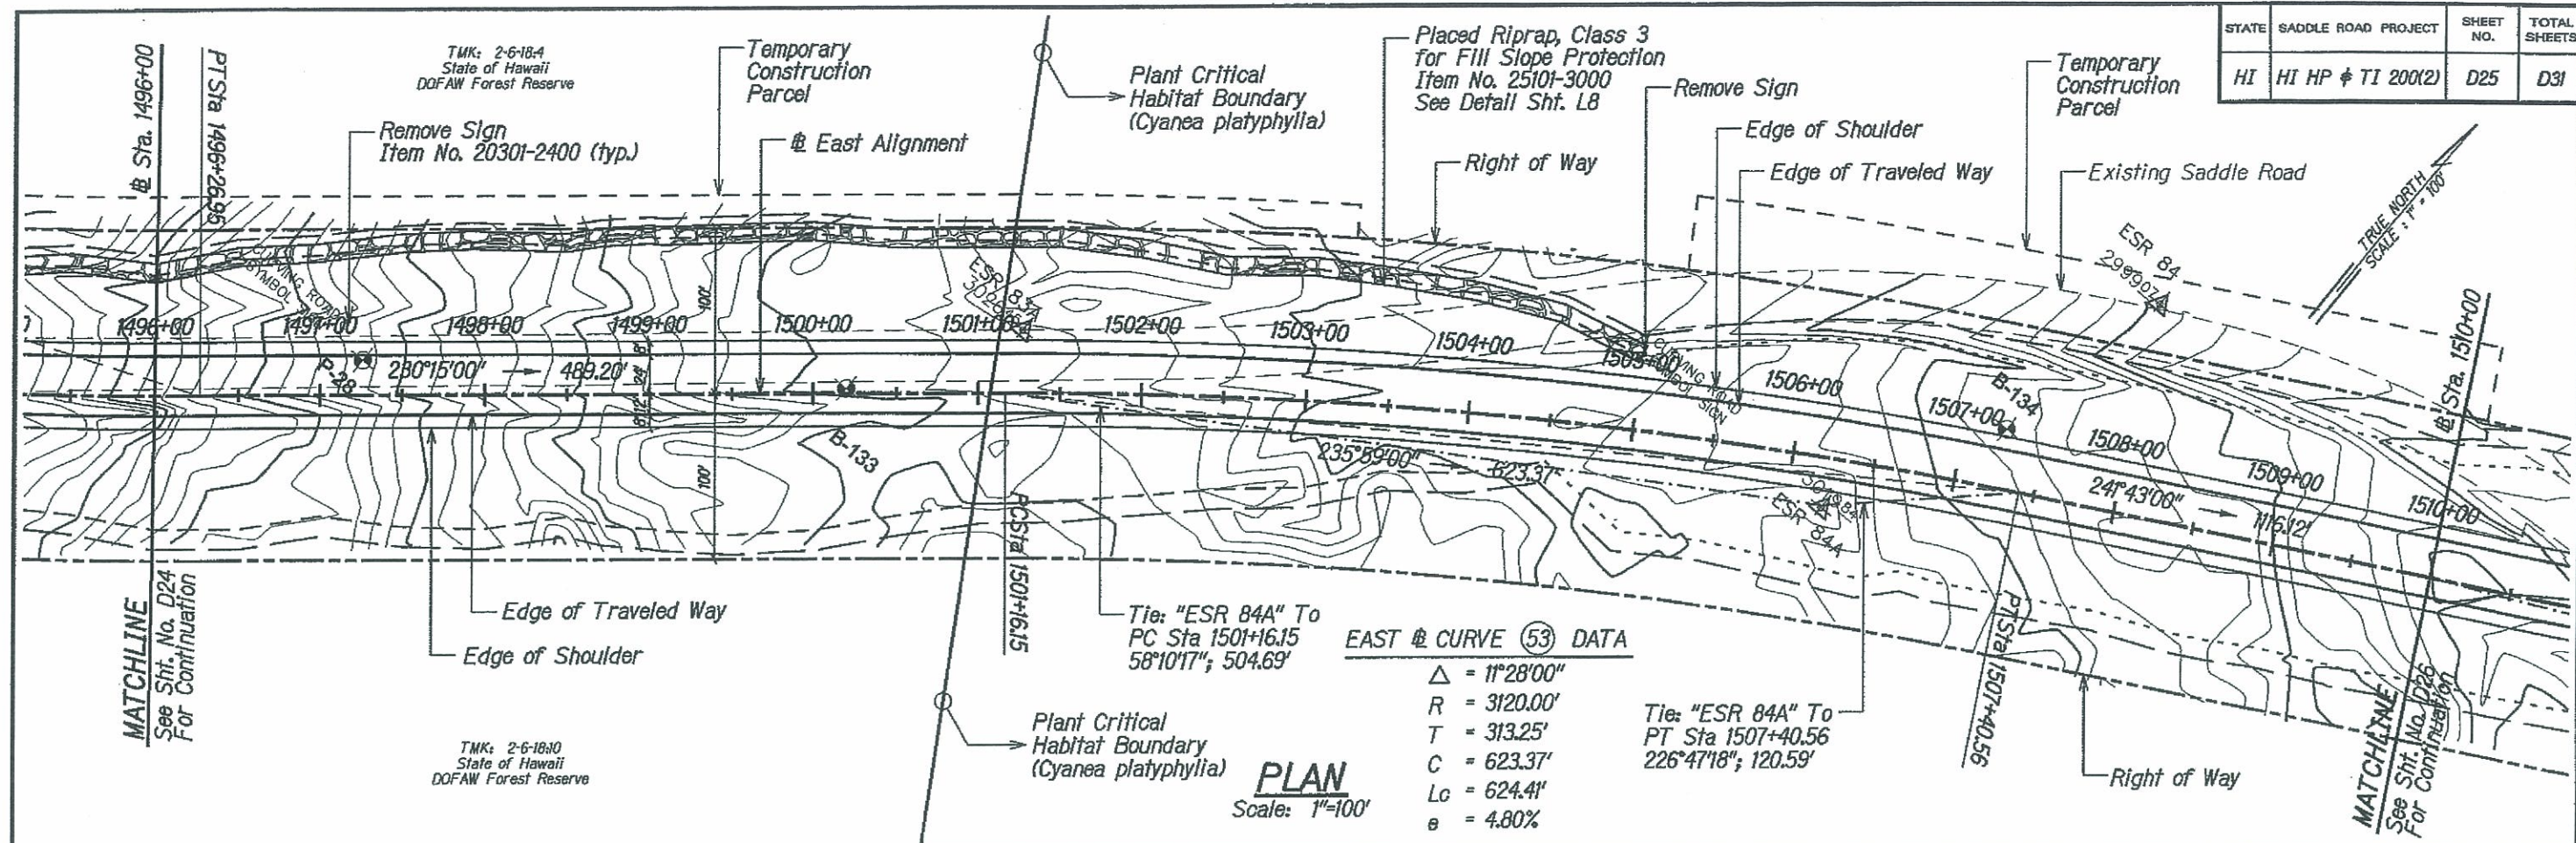


**EAST & CURVE (53) DATA**

|    |             |
|----|-------------|
| Δ  | = 11°28'00" |
| R  | = 3120.00'  |
| T  | = 313.25'   |
| C  | = 623.37'   |
| Lc | = 624.41'   |
| e  | = 4.80%     |

**PLAN**  
Scale: 1"=100'

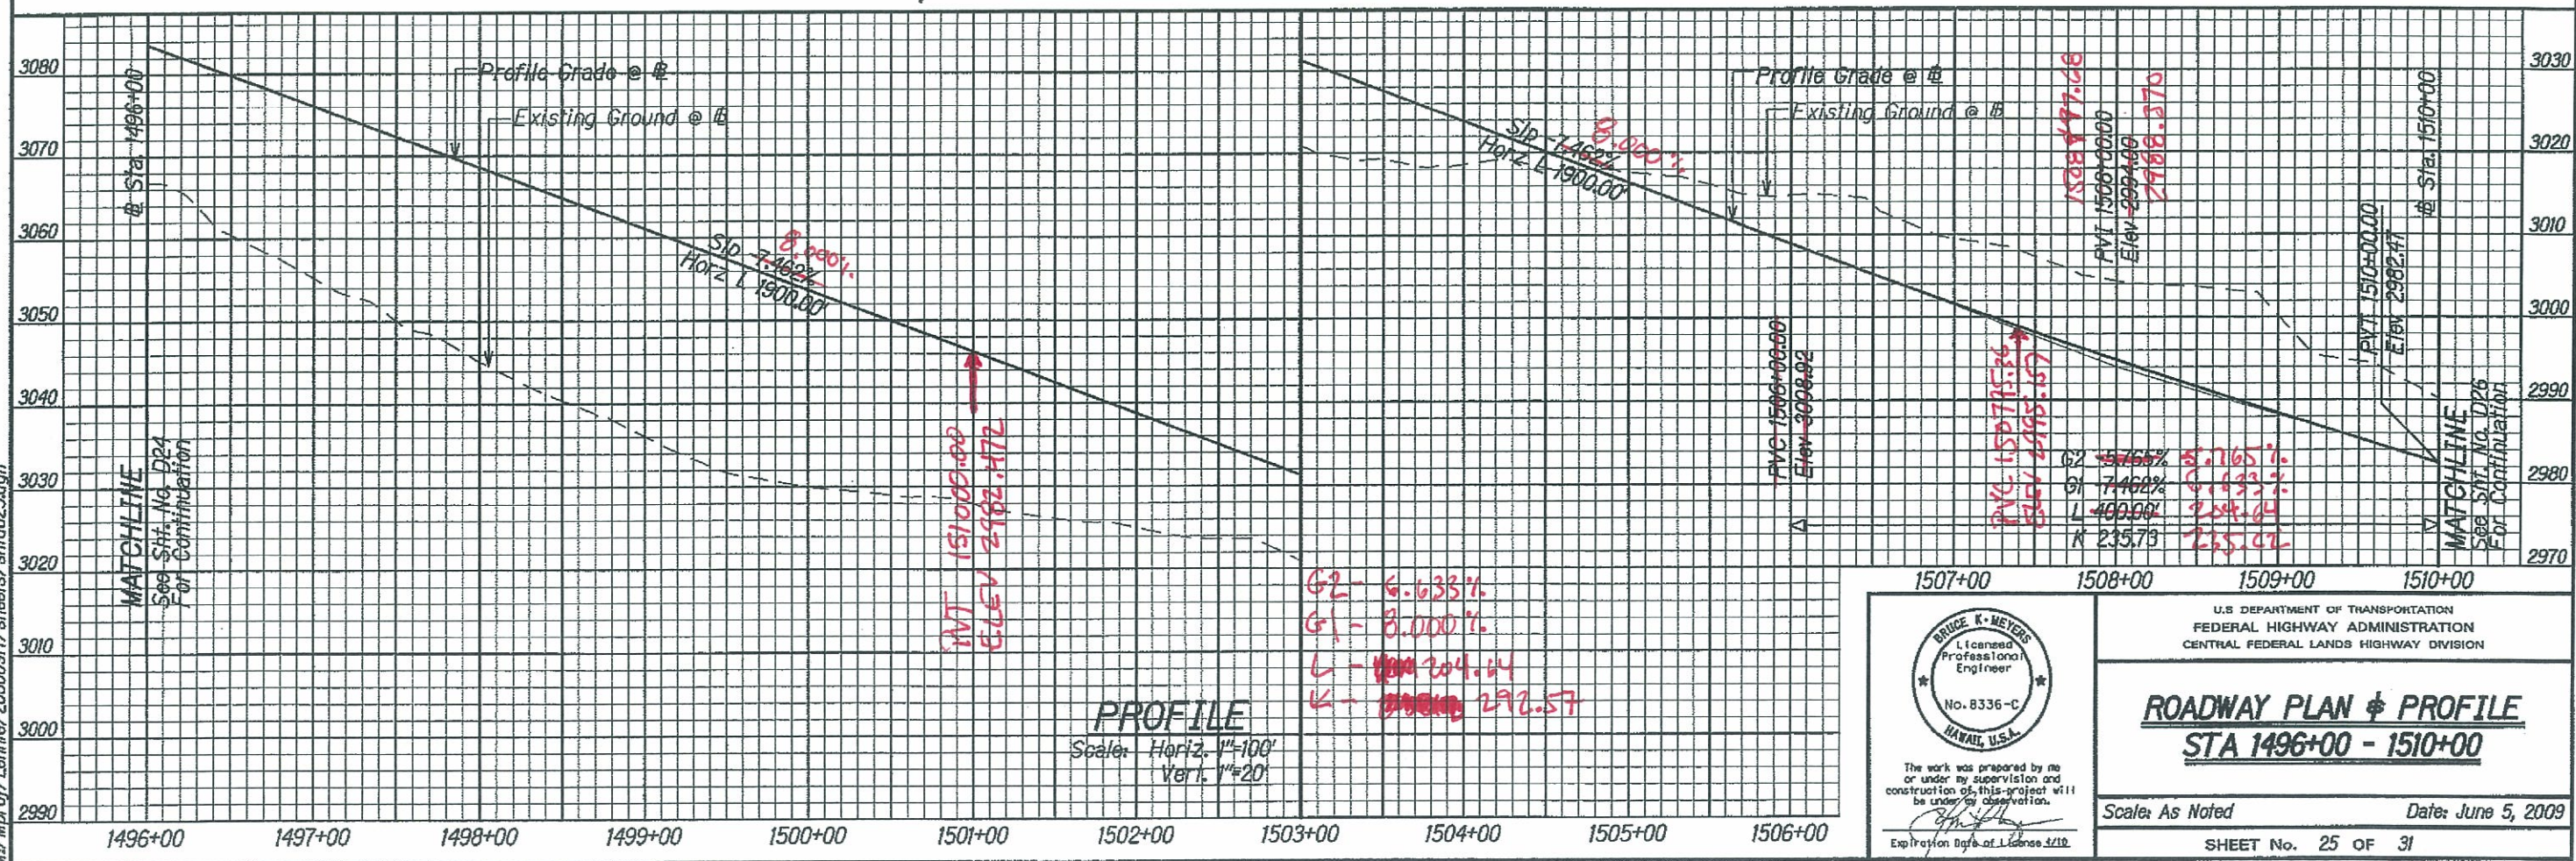

**PROFILE**  
Scale: Horiz. 1"=100'  
Vert. 1"=20'

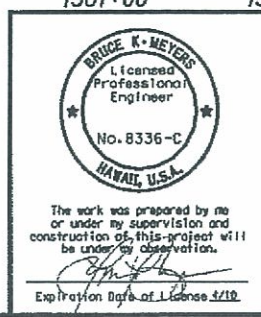

U.S. DEPARTMENT OF TRANSPORTATION  
FEDERAL HIGHWAY ADMINISTRATION  
CENTRAL FEDERAL LANDS HIGHWAY DIVISION




**ROADWAY PLAN & PROFILE**  
**STA 1496+00 - 1510+00**

Scale: As Noted Date: June 5, 2009

SHEET No. 25 OF 31



| STATE | SADDLE ROAD PROJECT | SHEET NO. | TOTAL SHEETS |
|-------|---------------------|-----------|--------------|
| HI    | HI HP & TI 200(2)   | D26       | D31          |

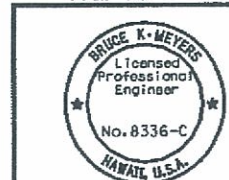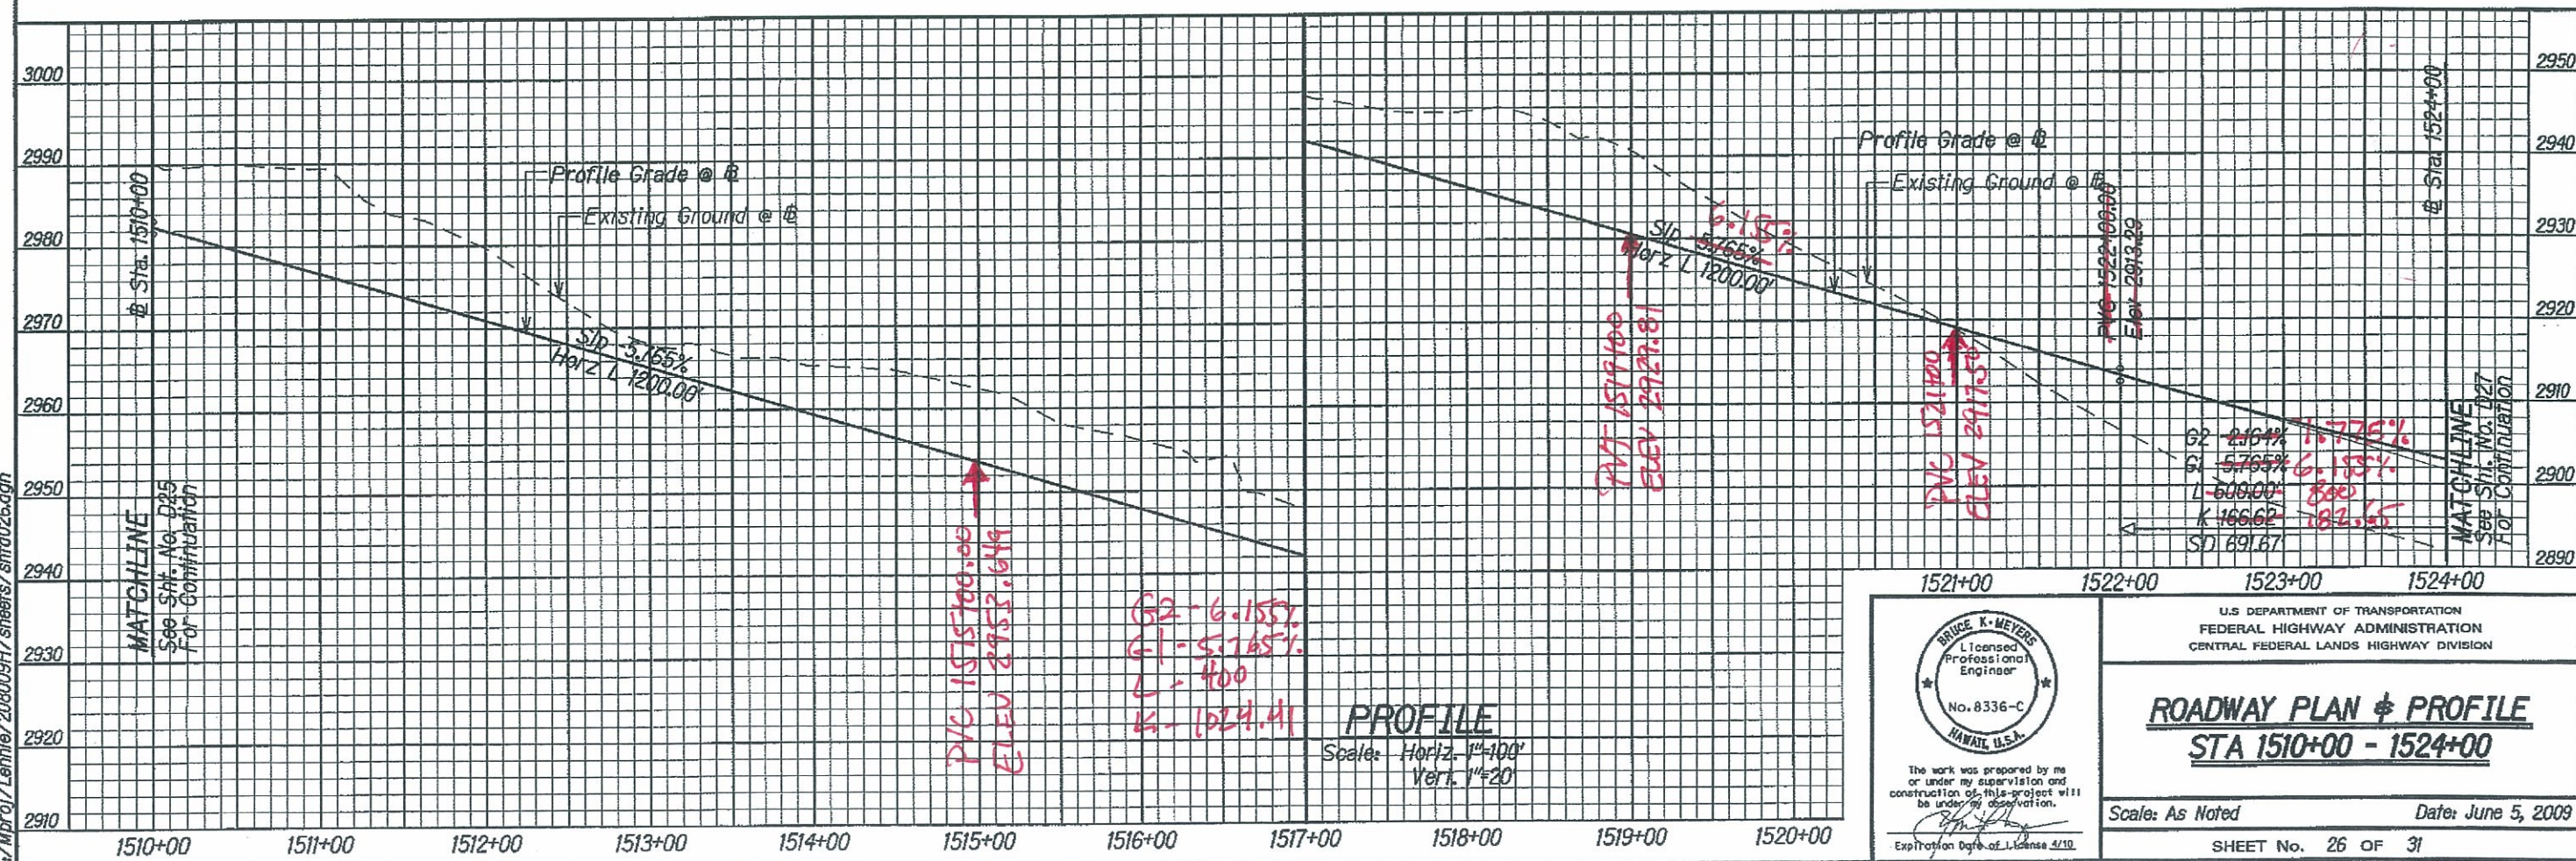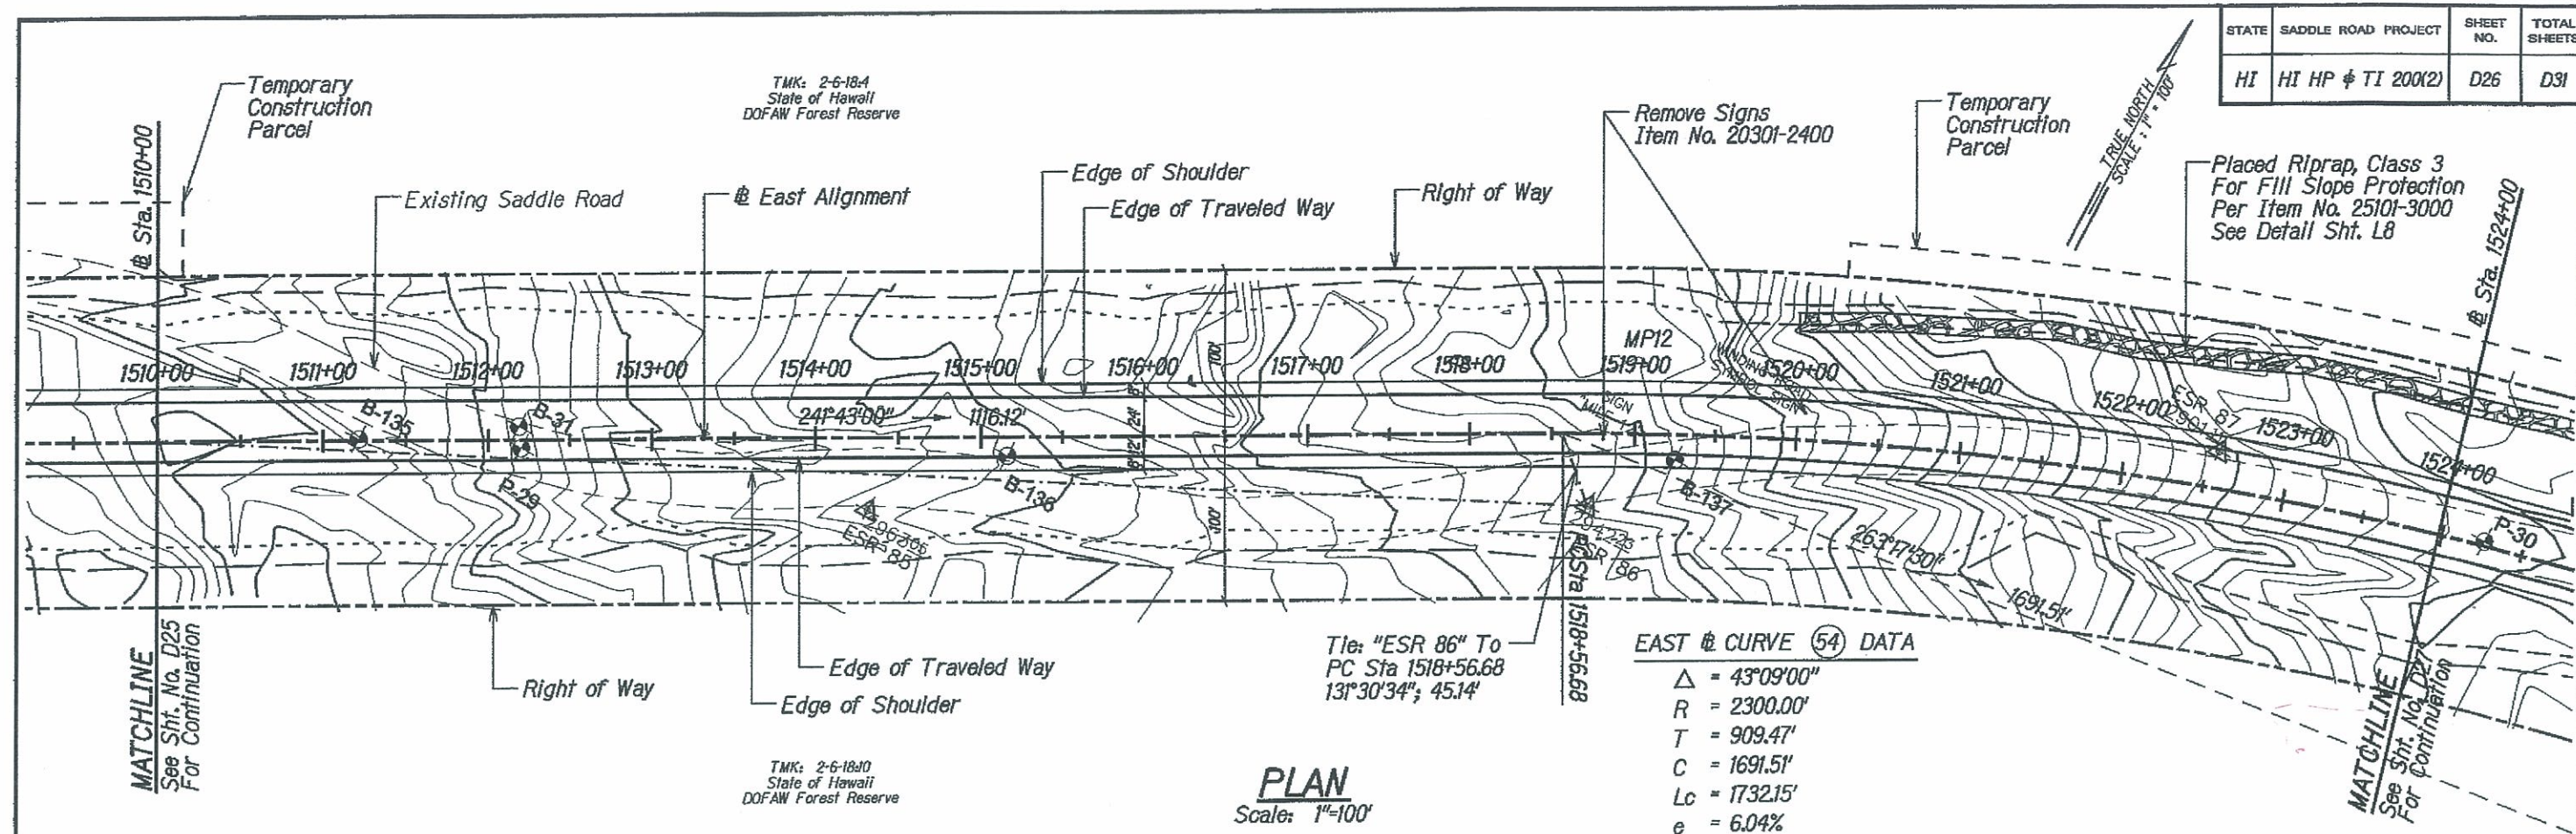

The work was prepared by me or under my supervision and construction of this project will be under my observation.

Expiration Date of License 2/10

U.S. DEPARTMENT OF TRANSPORTATION  
FEDERAL HIGHWAY ADMINISTRATION  
CENTRAL FEDERAL LANDS HIGHWAY DIVISION



**ROADWAY PLAN & PROFILE**  
**STA 1510+00 - 1524+00**

Scale: As Noted Date: June 5, 2009

SHEET No. 26 OF 31



| STATE | SADDLE ROAD PROJECT | SHEET NO. | TOTAL SHEETS |
|-------|---------------------|-----------|--------------|
| HI    | HI HP & TI 200(2)   | D27       | D31          |

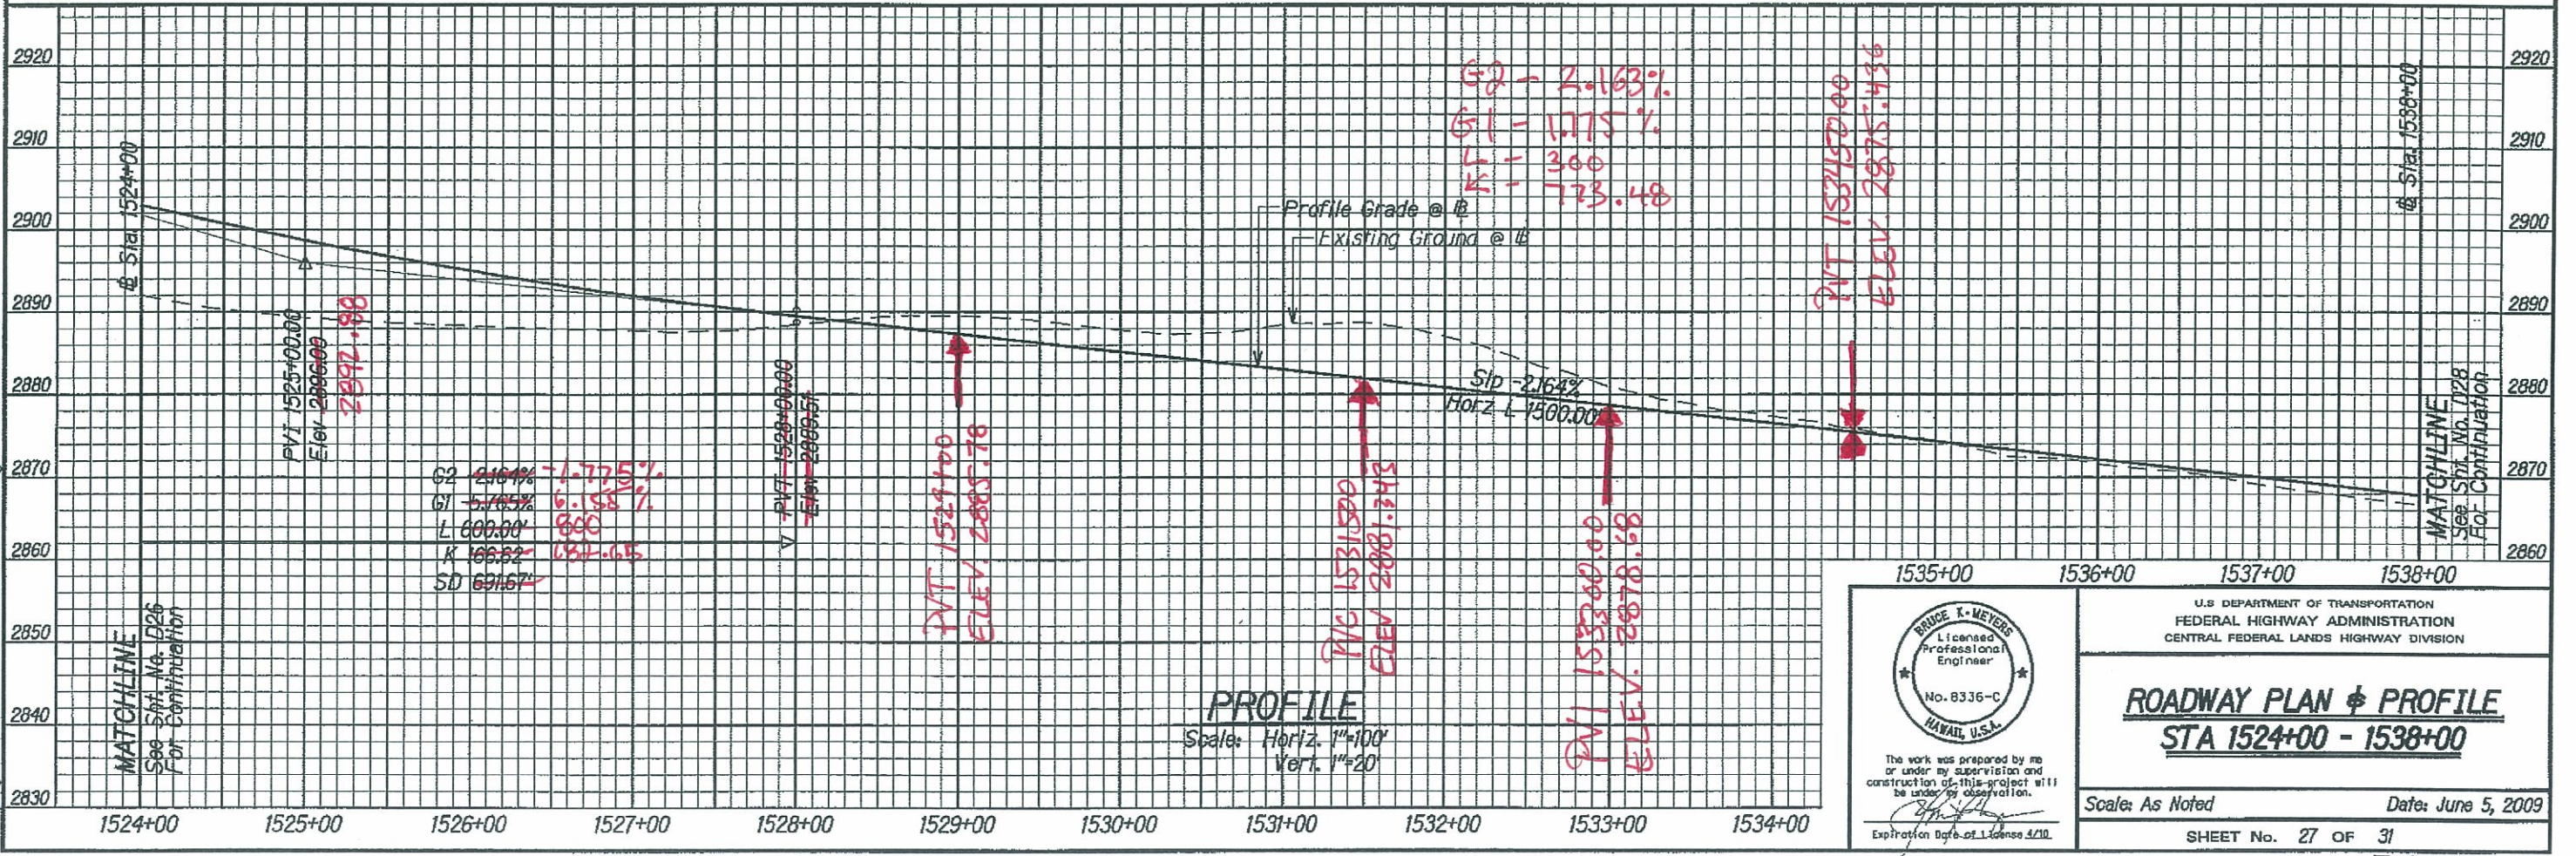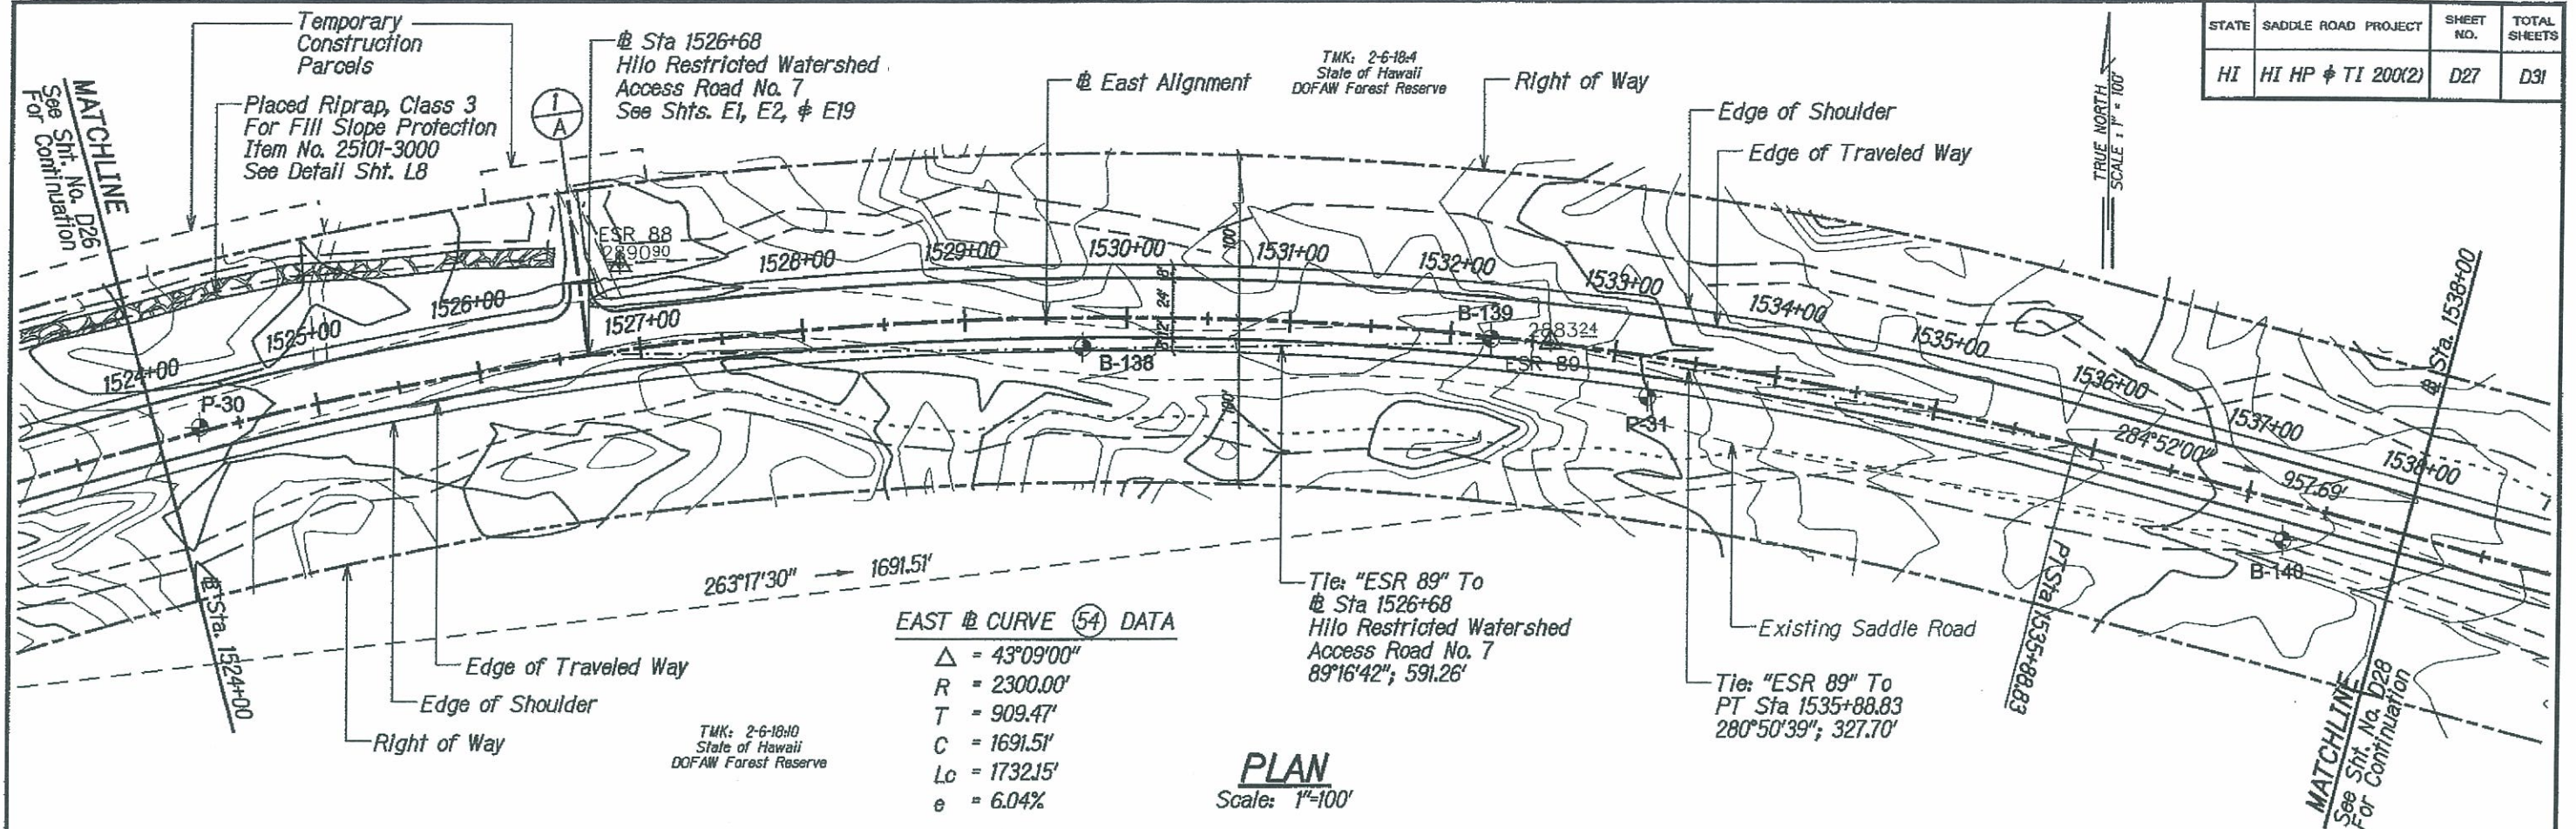

BRUCE K. MEYERS  
Licensed Professional Engineer  
No. 8336-C  
HAWAII, U.S.A.

The work was prepared by me or under my supervision and construction of this project will be under my observation.

Expiration Date of License 5/10

U.S. DEPARTMENT OF TRANSPORTATION  
FEDERAL HIGHWAY ADMINISTRATION  
CENTRAL FEDERAL LANDS HIGHWAY DIVISION

**ROADWAY PLAN & PROFILE**  
**STA 1524+00 - 1538+00**



Scale: As Noted      Date: June 5, 2009

SHEET No. 27 OF 31

**D27**



| STATE | SADDLE ROAD PROJECT | SHEET NO. | TOTAL SHEETS |
|-------|---------------------|-----------|--------------|
| HI    | HI HP & TI 200(2)   | D28       | D31          |

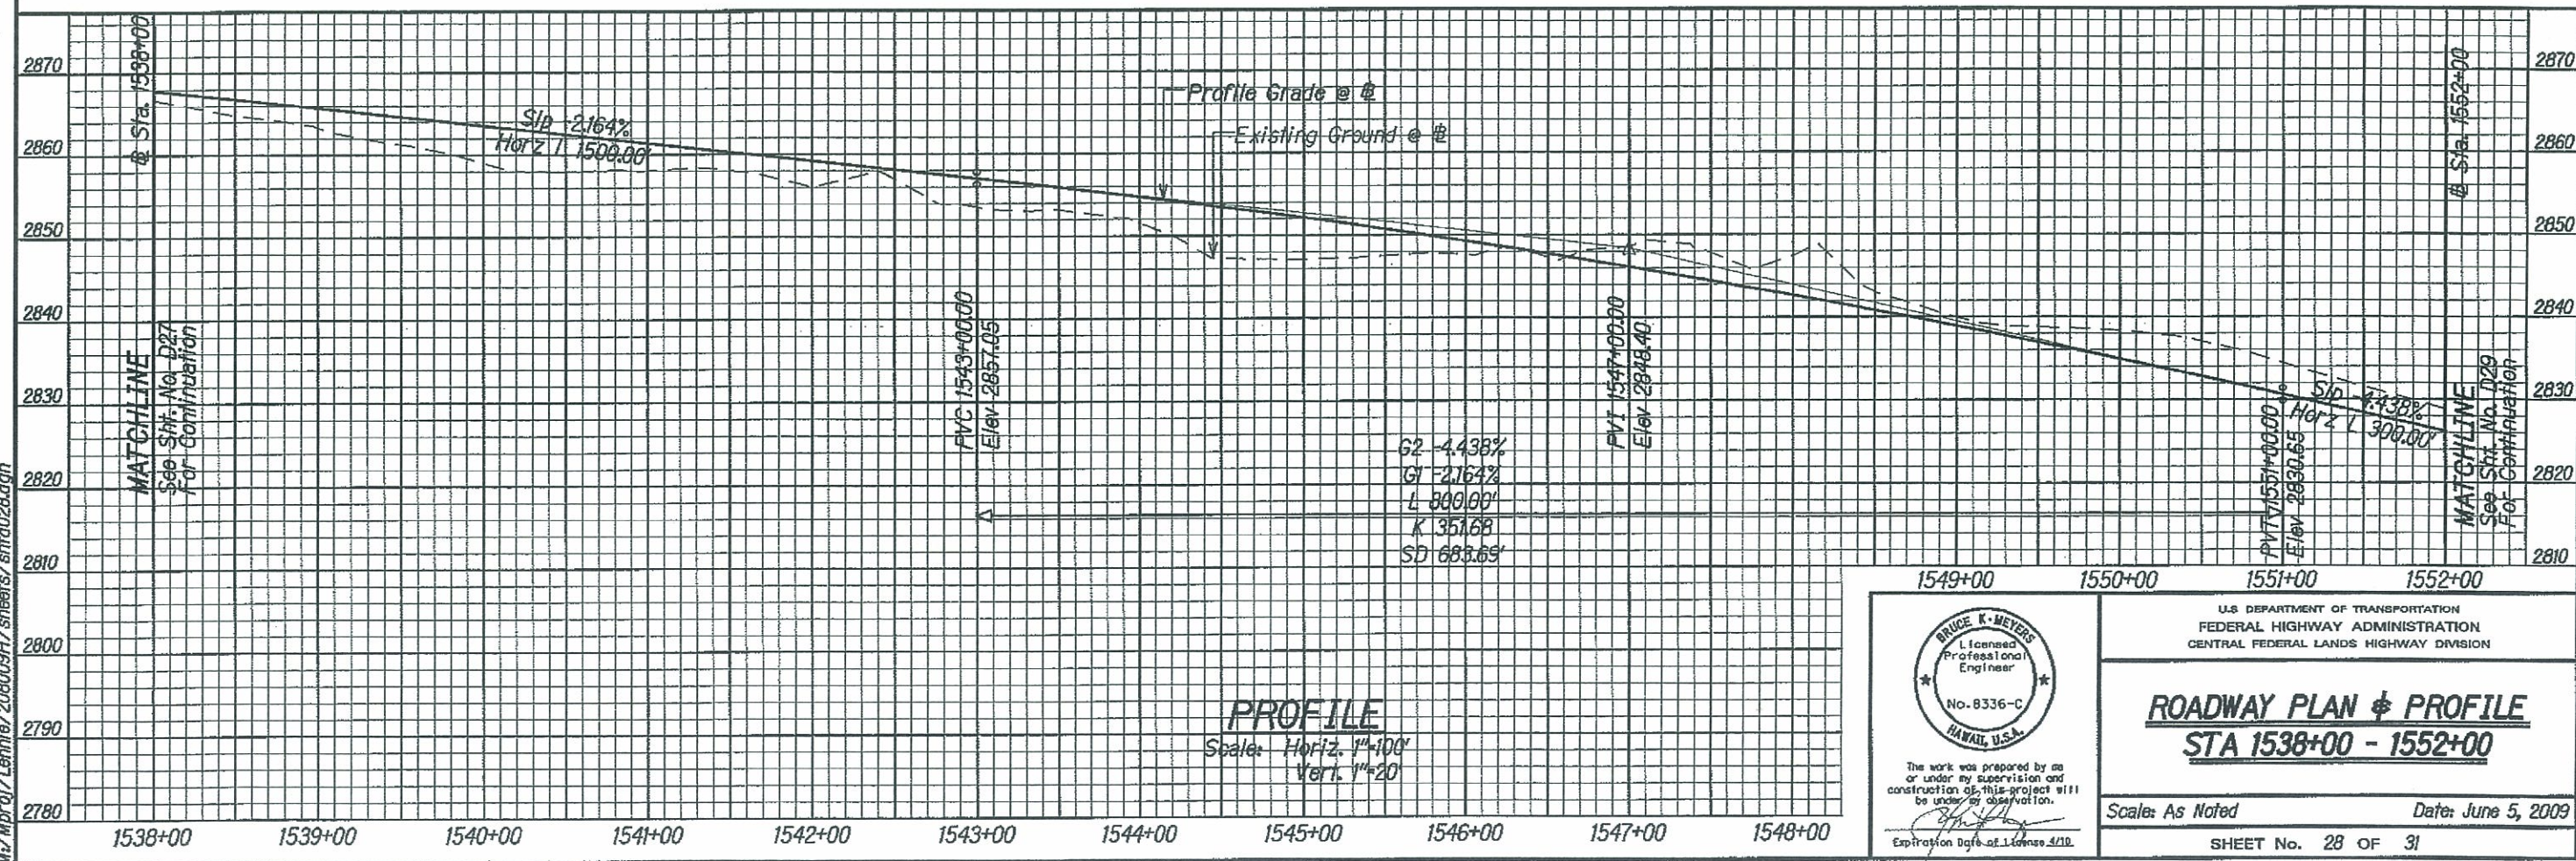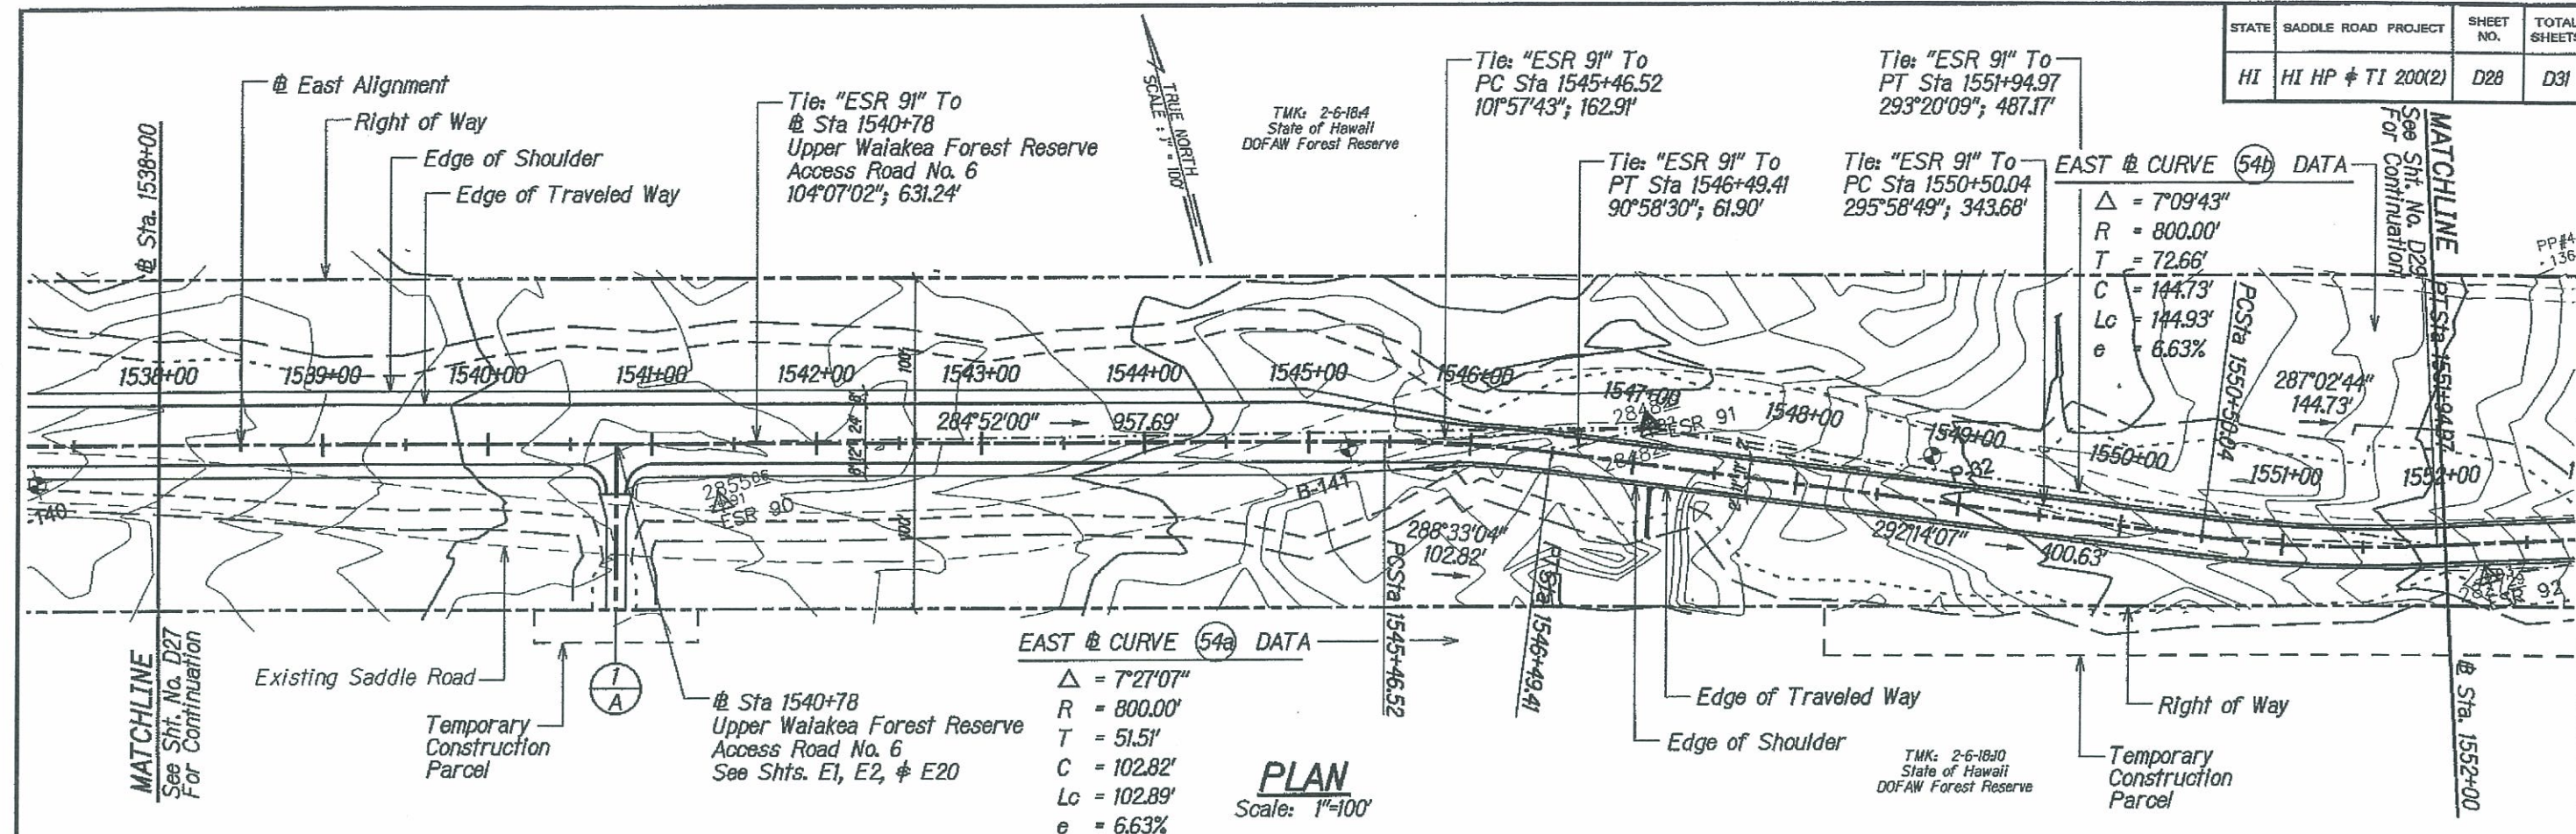

BRUCE K. MEYERS  
Licensed Professional Engineer  
No. 8336-C  
HAWAII, U.S.A.

The work was prepared by me or under my supervision and construction of this project will be under my observation.  
Expiration Date of License 4/10

U.S. DEPARTMENT OF TRANSPORTATION  
FEDERAL HIGHWAY ADMINISTRATION  
CENTRAL FEDERAL LANDS HIGHWAY DIVISION

**ROADWAY PLAN & PROFILE**  
**STA 1538+00 - 1552+00**



Scale: As Noted      Date: June 5, 2009

SHEET No. 28 OF 31

**D28**



| STATE | SADDLE ROAD PROJECT | SHEET NO. | TOTAL SHEETS |
|-------|---------------------|-----------|--------------|
| HI    | HI HP & TI 200(2)   | D29       | D31          |

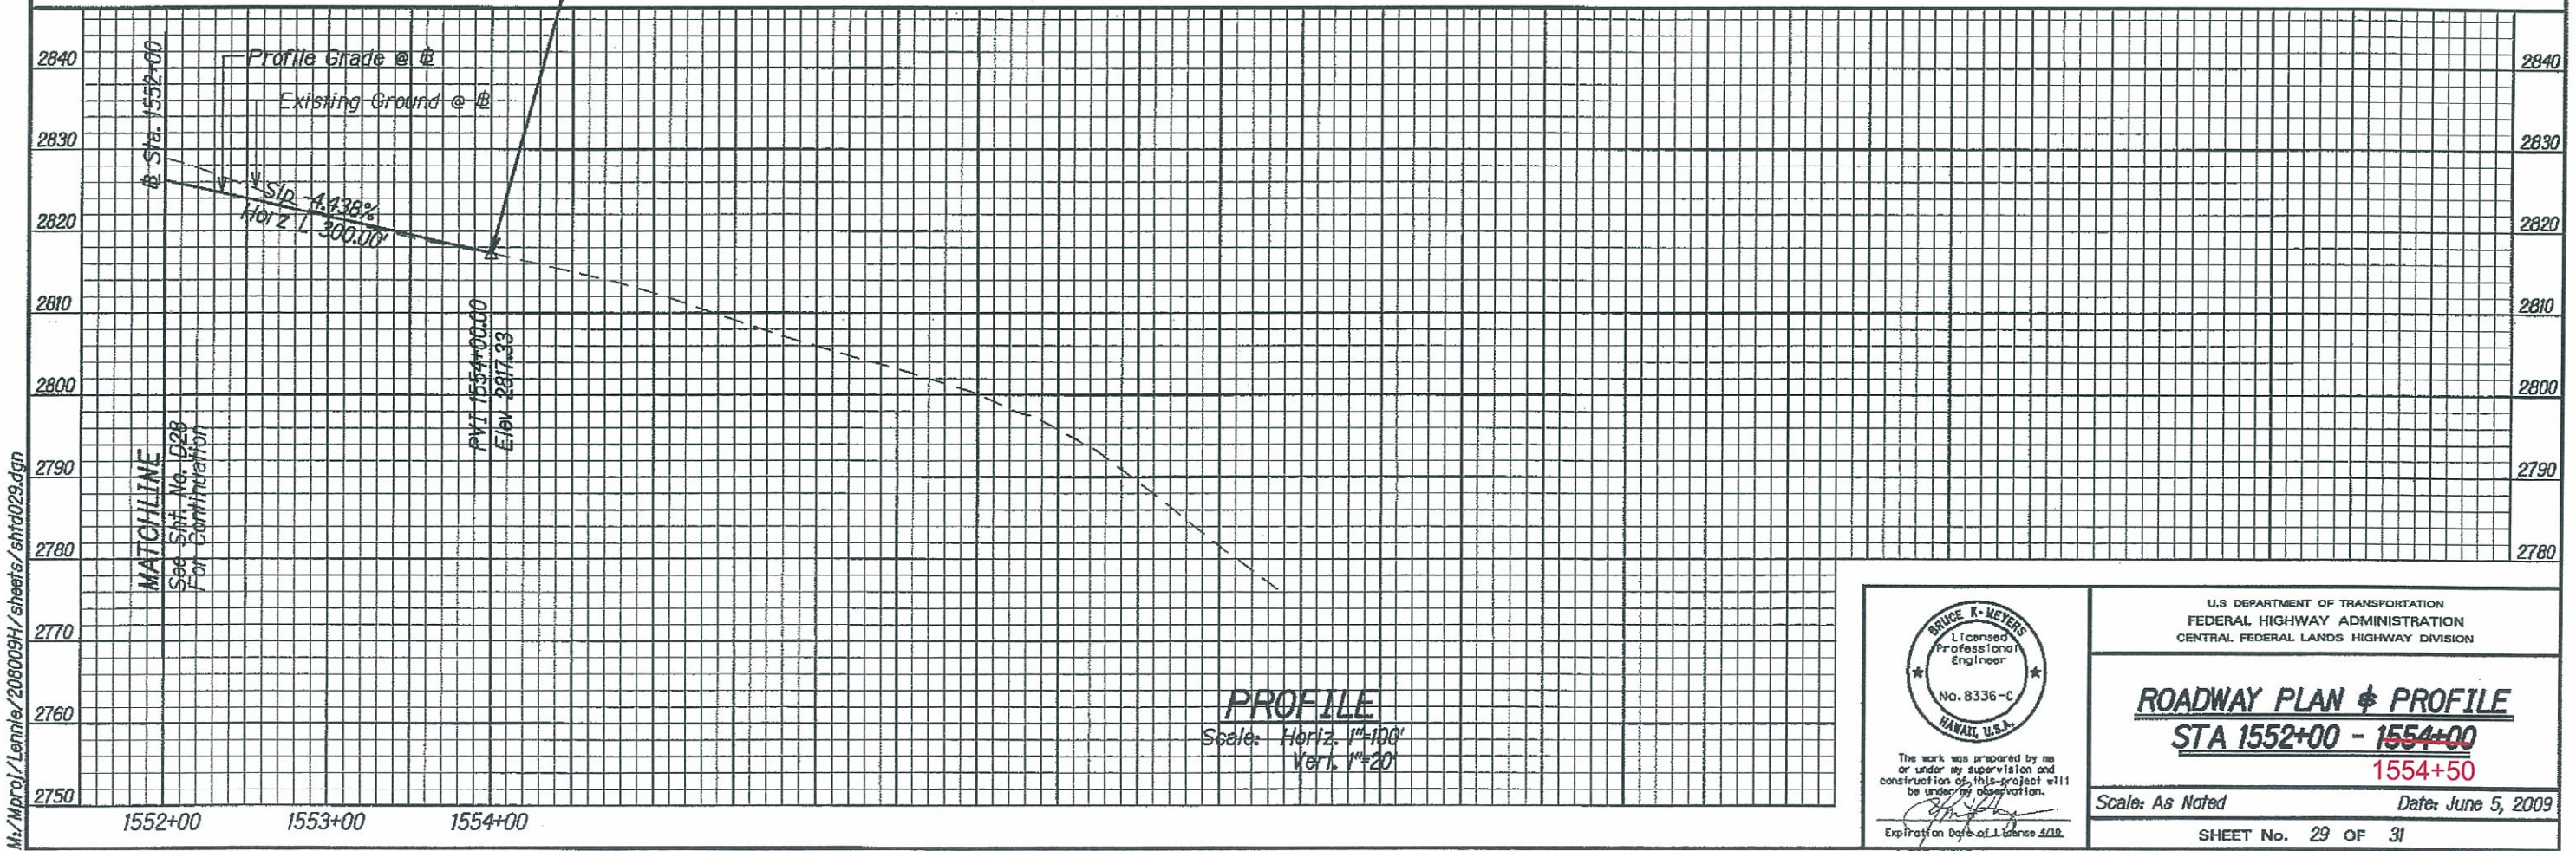
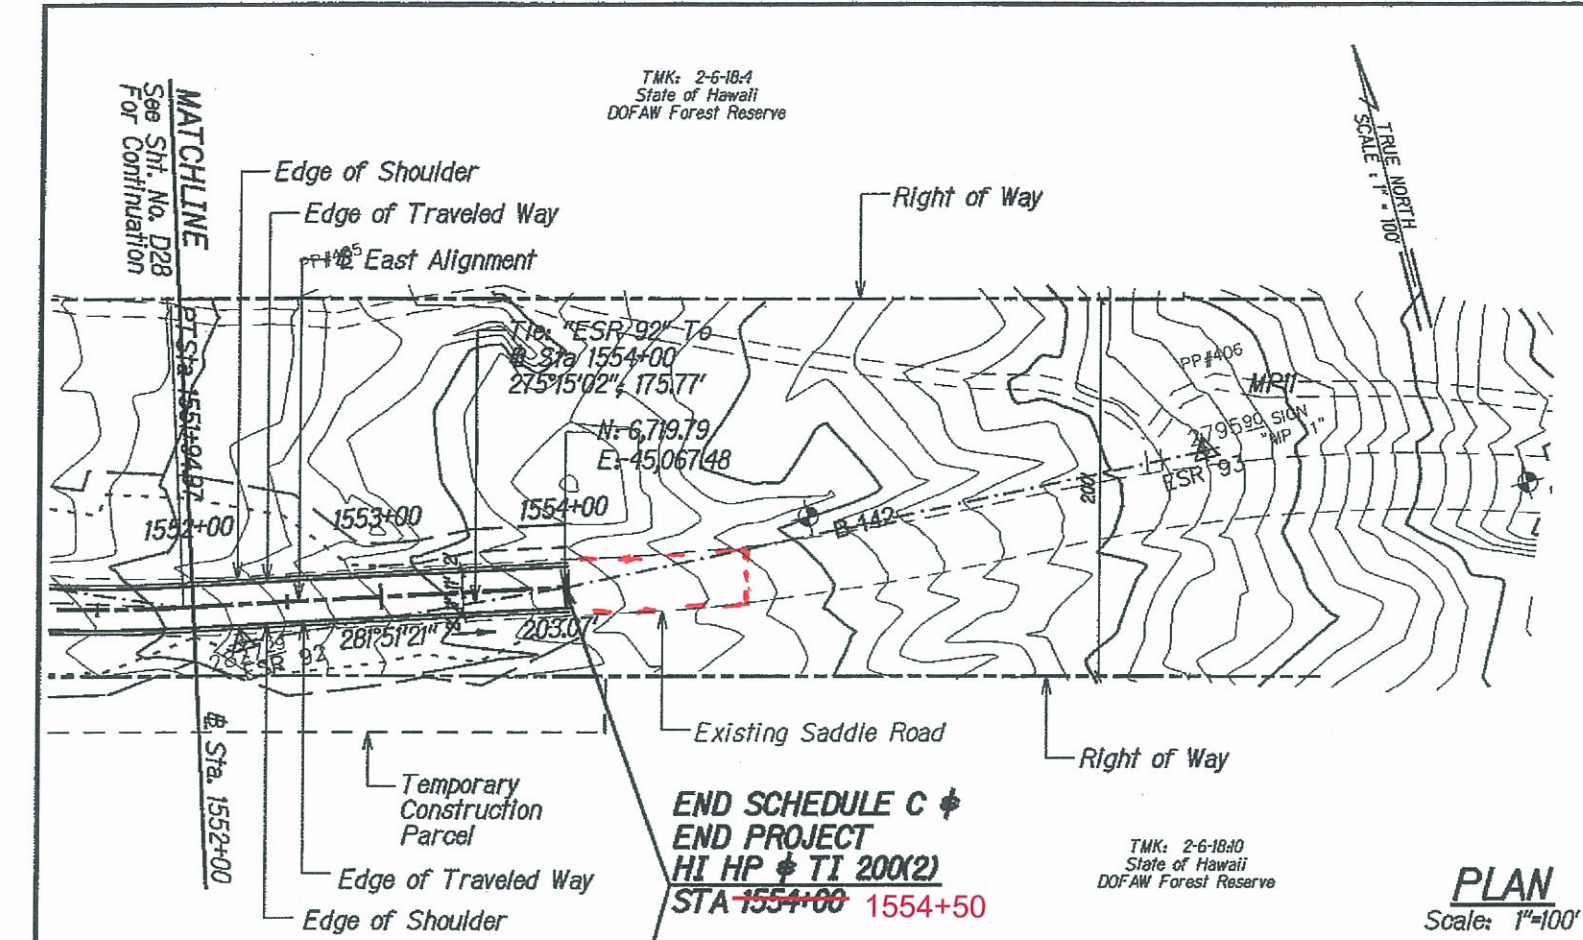


  
 The work was prepared by me or under my supervision and construction of this project will be under my observation.  
 Bruce K. Meyers  
 Expiration Date of License 4/10

U.S. DEPARTMENT OF TRANSPORTATION  
 FEDERAL HIGHWAY ADMINISTRATION  
 CENTRAL FEDERAL LANDS HIGHWAY DIVISION  
  
**ROADWAY PLAN & PROFILE**  
**STA 1552+00 - 1554+00**  
 1554+50  
 Scale: As Noted Date: June 5, 2009  
 SHEET No. 29 OF 31



| STATE | SADDLE ROAD PROJECT | SHEET NO. | TOTAL SHEETS |
|-------|---------------------|-----------|--------------|
| HI    | HI HP & TI 200(2)   | D30       | D31          |

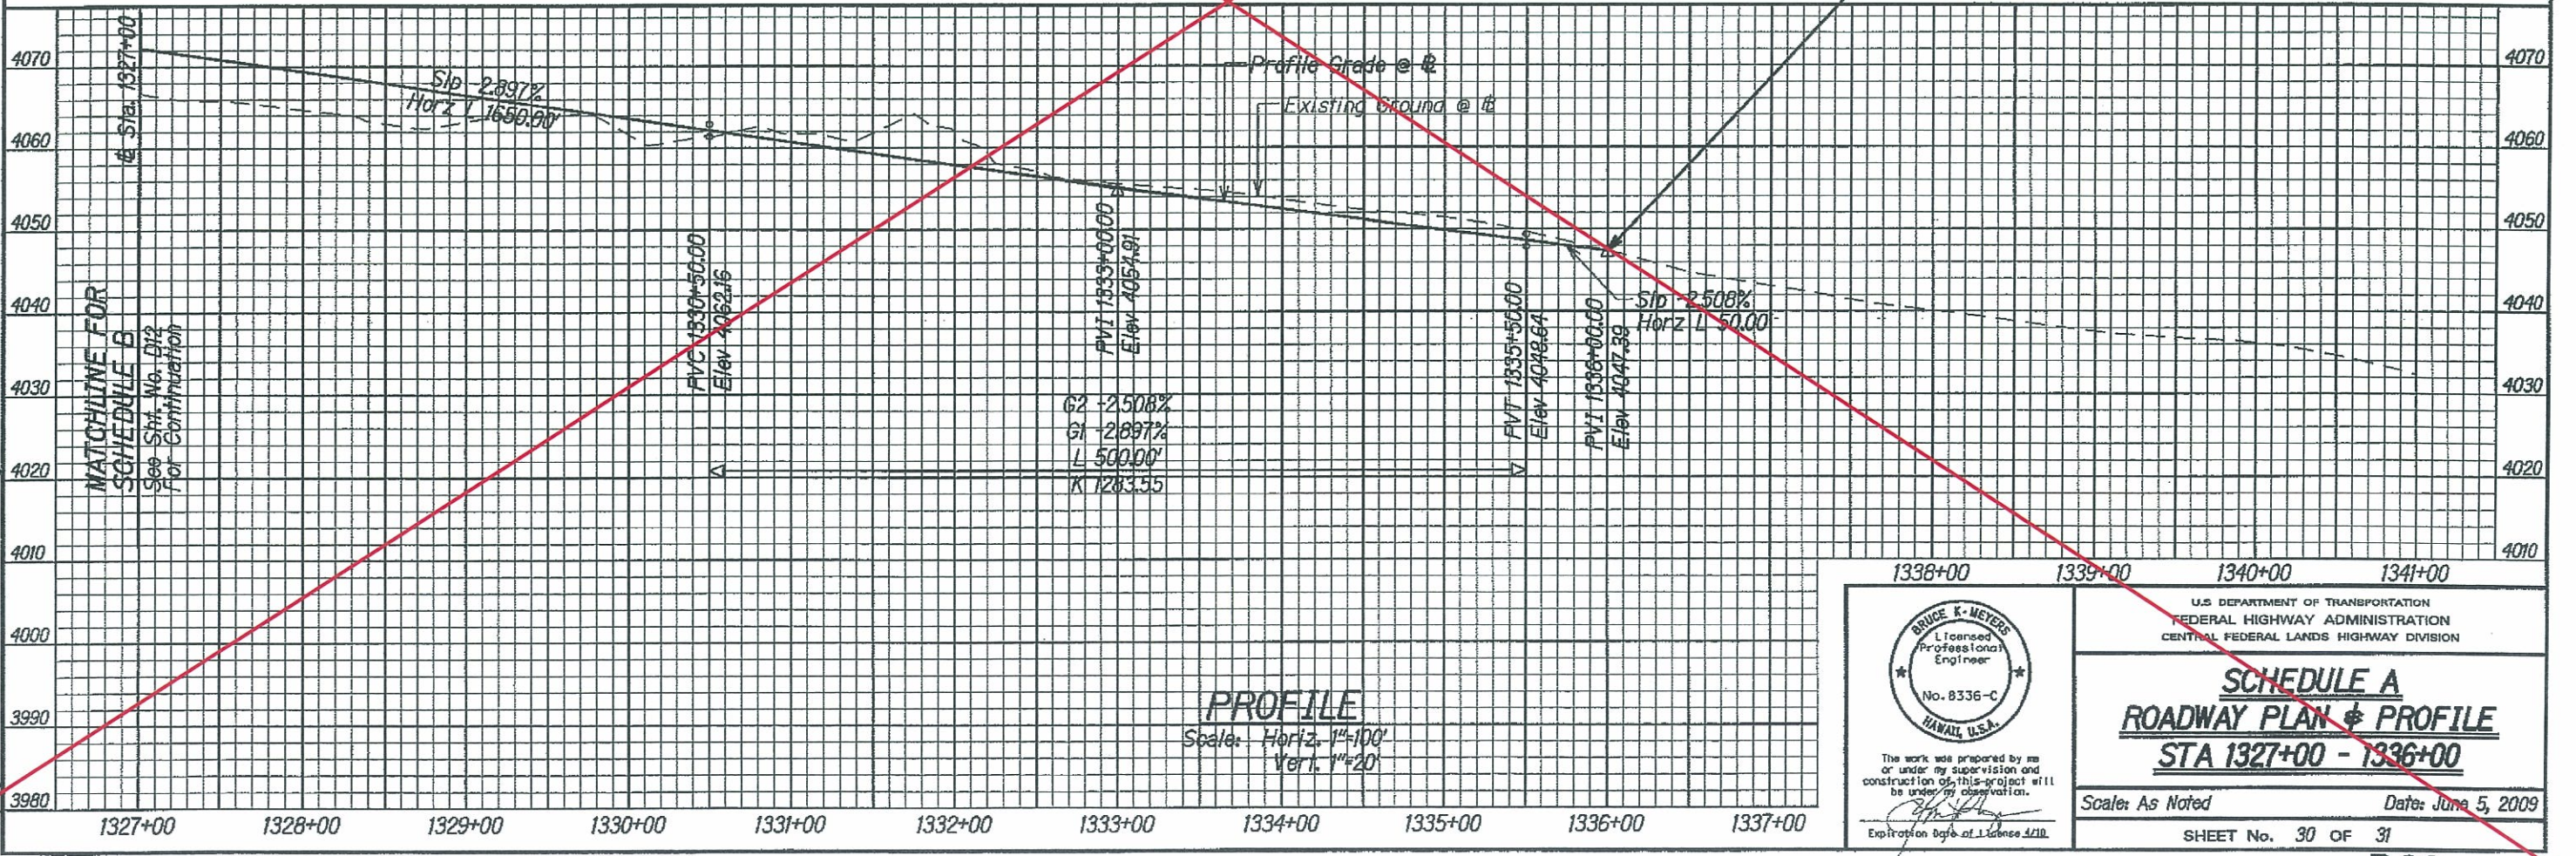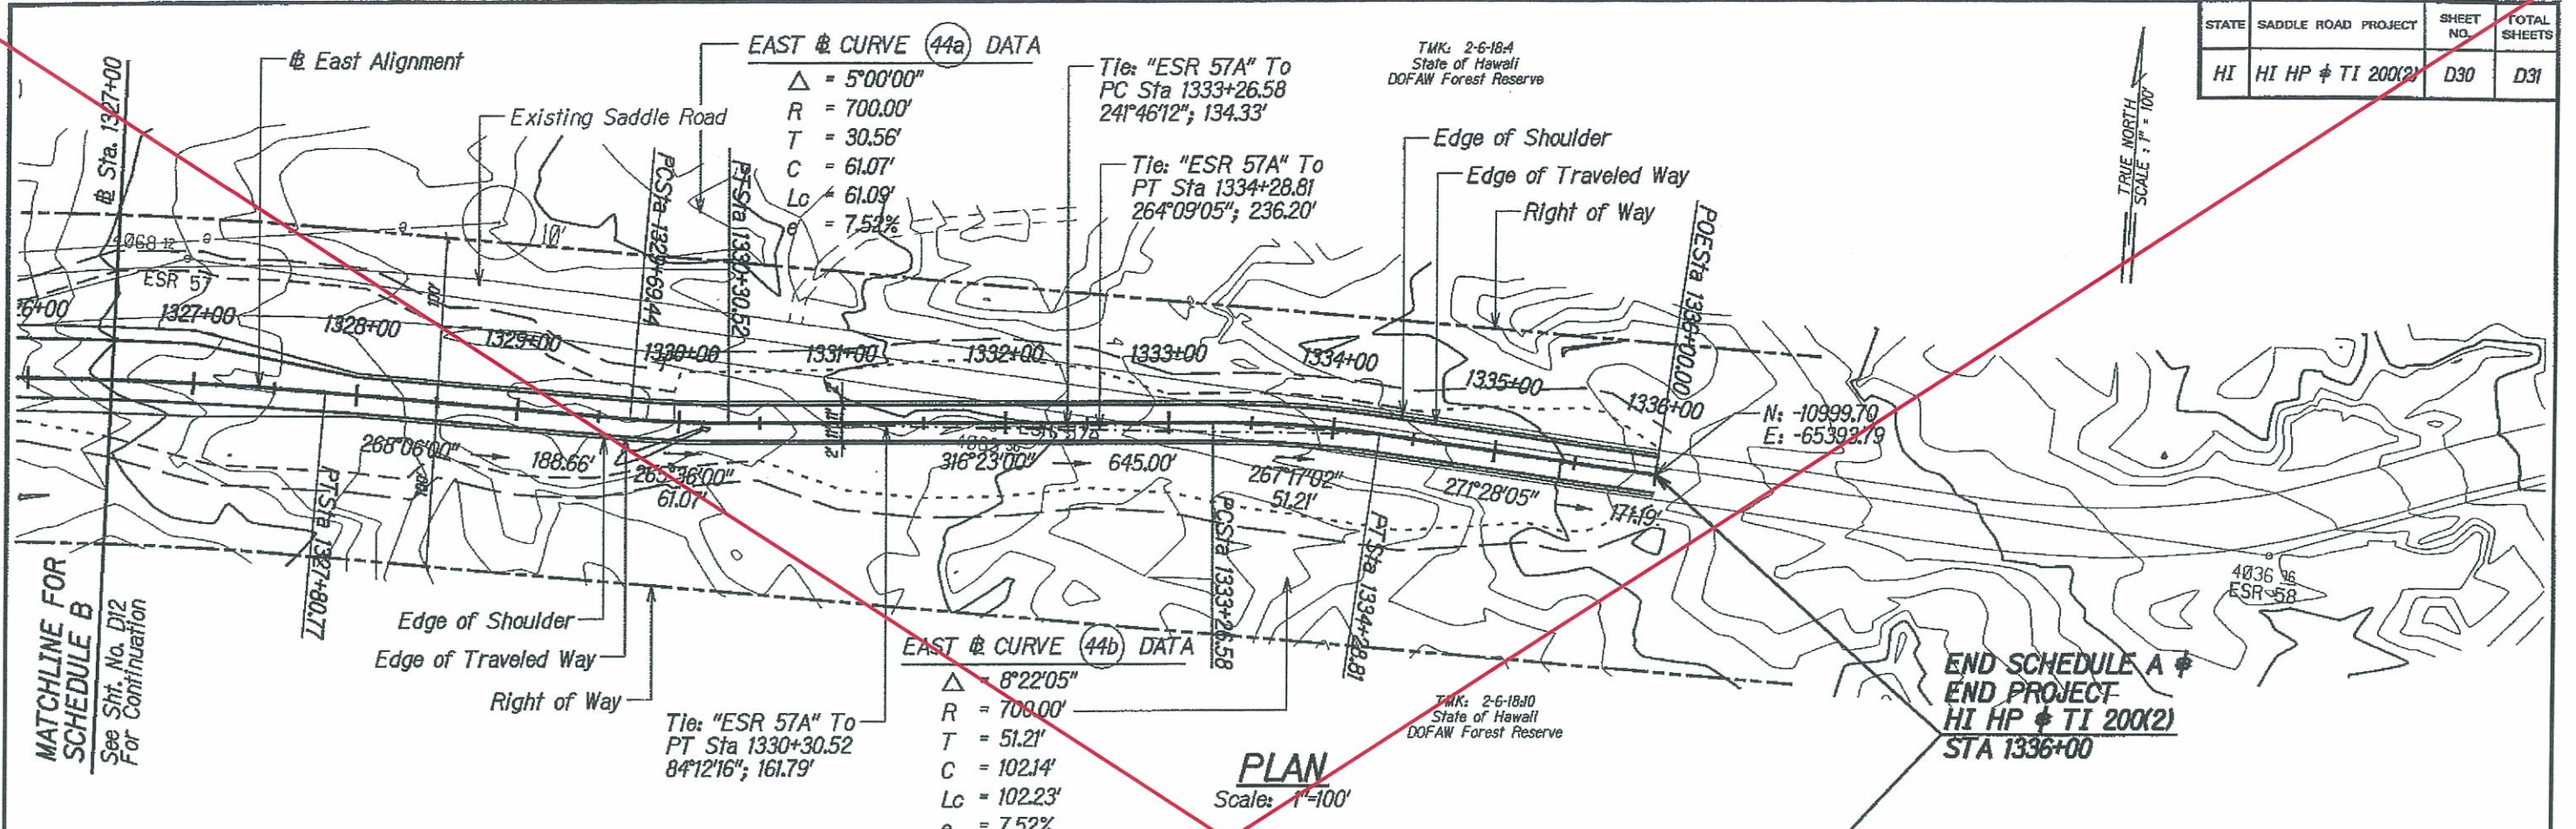

BRUCE K. MEYERS  
Licensed Professional Engineer  
No. 8336-C  
HAWAII, U.S.A.

The work was prepared by me or under my supervision and construction of this project will be under my observation.

Expiration Date of License 3/21/10

U.S. DEPARTMENT OF TRANSPORTATION  
FEDERAL HIGHWAY ADMINISTRATION  
CENTRAL FEDERAL LANDS HIGHWAY DIVISION



**SCHEDULE A**  
**ROADWAY PLAN & PROFILE**  
**STA 1327+00 - 1336+00**

Scale: As Noted      Date: June 5, 2009

SHEET No. 30 OF 31



| STATE | SADDLE ROAD PROJECT | SHEET NO. | TOTAL SHEETS |
|-------|---------------------|-----------|--------------|
| HI    | HI HP & TI 200(2)   | D31       | D31          |

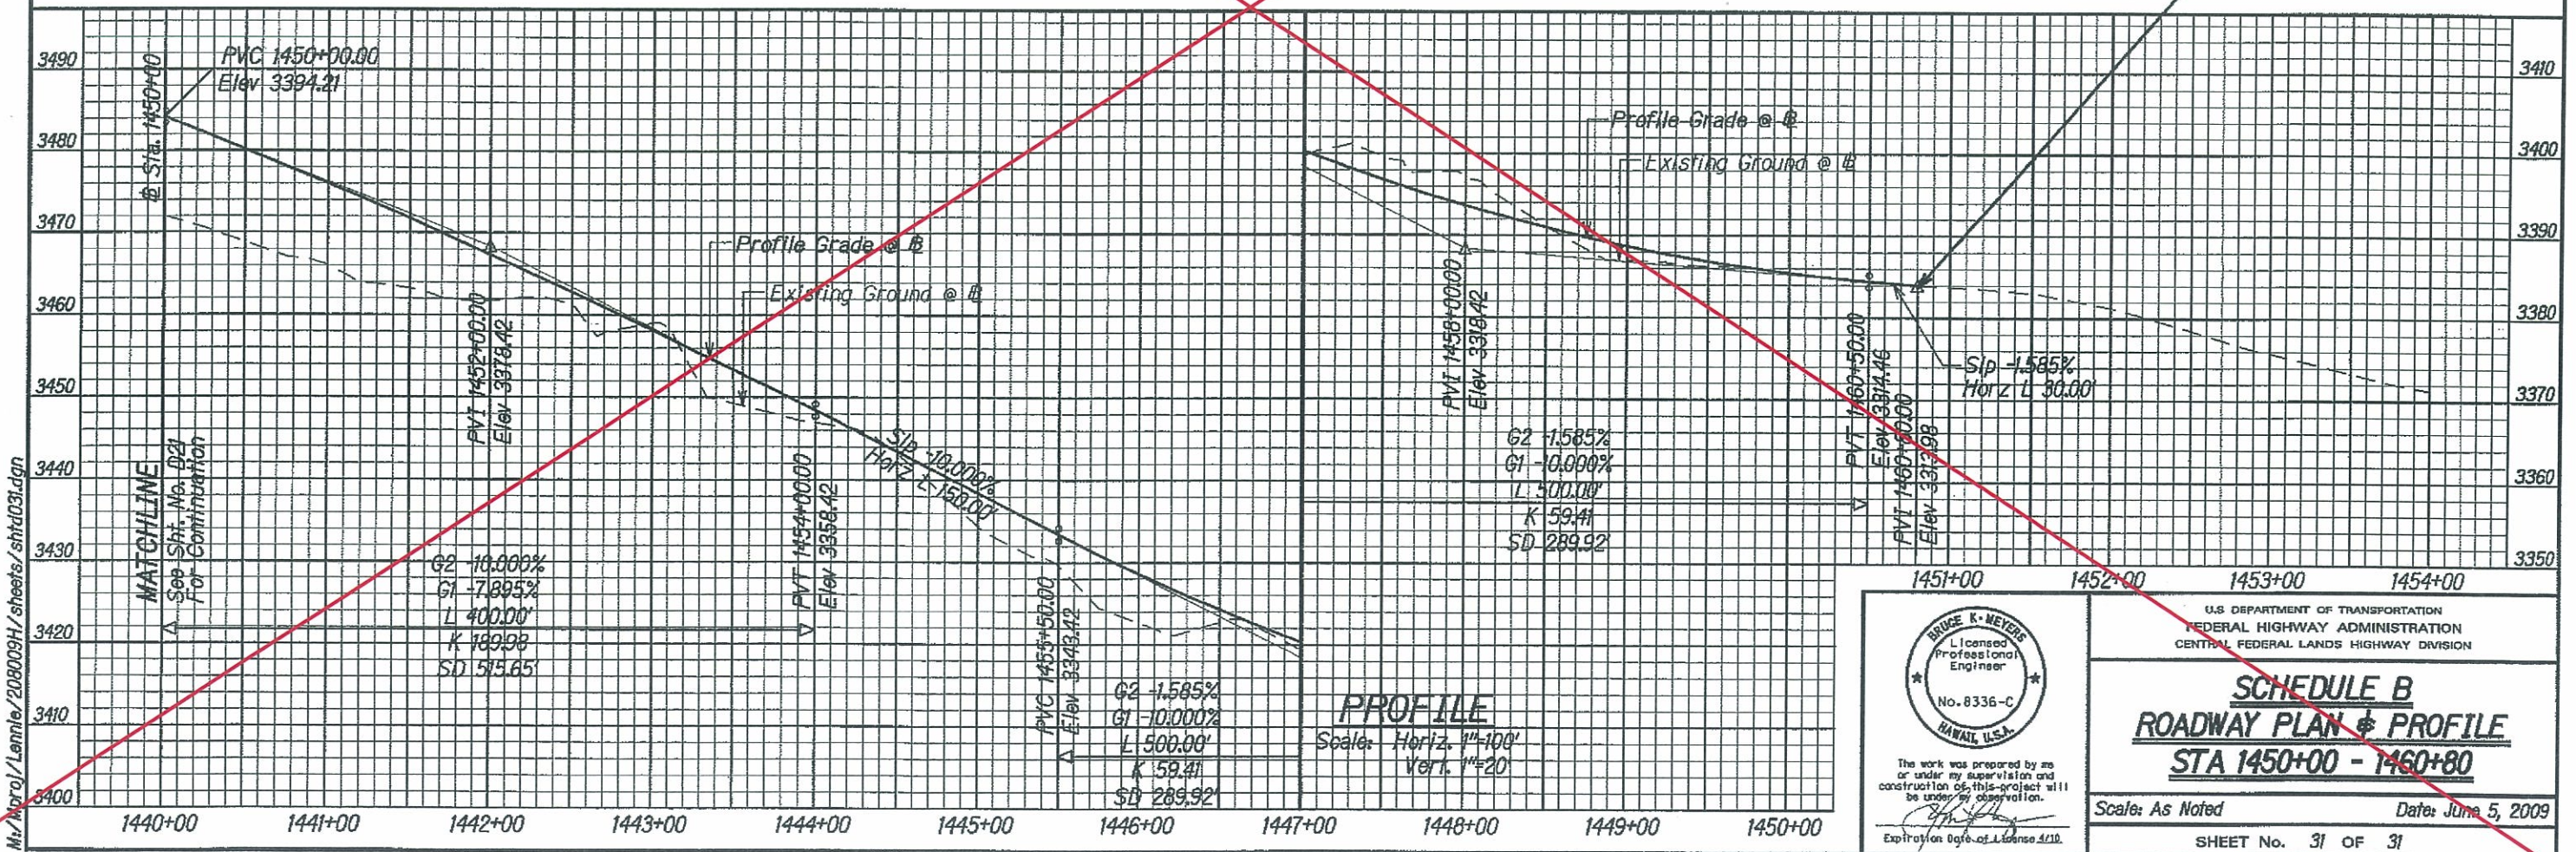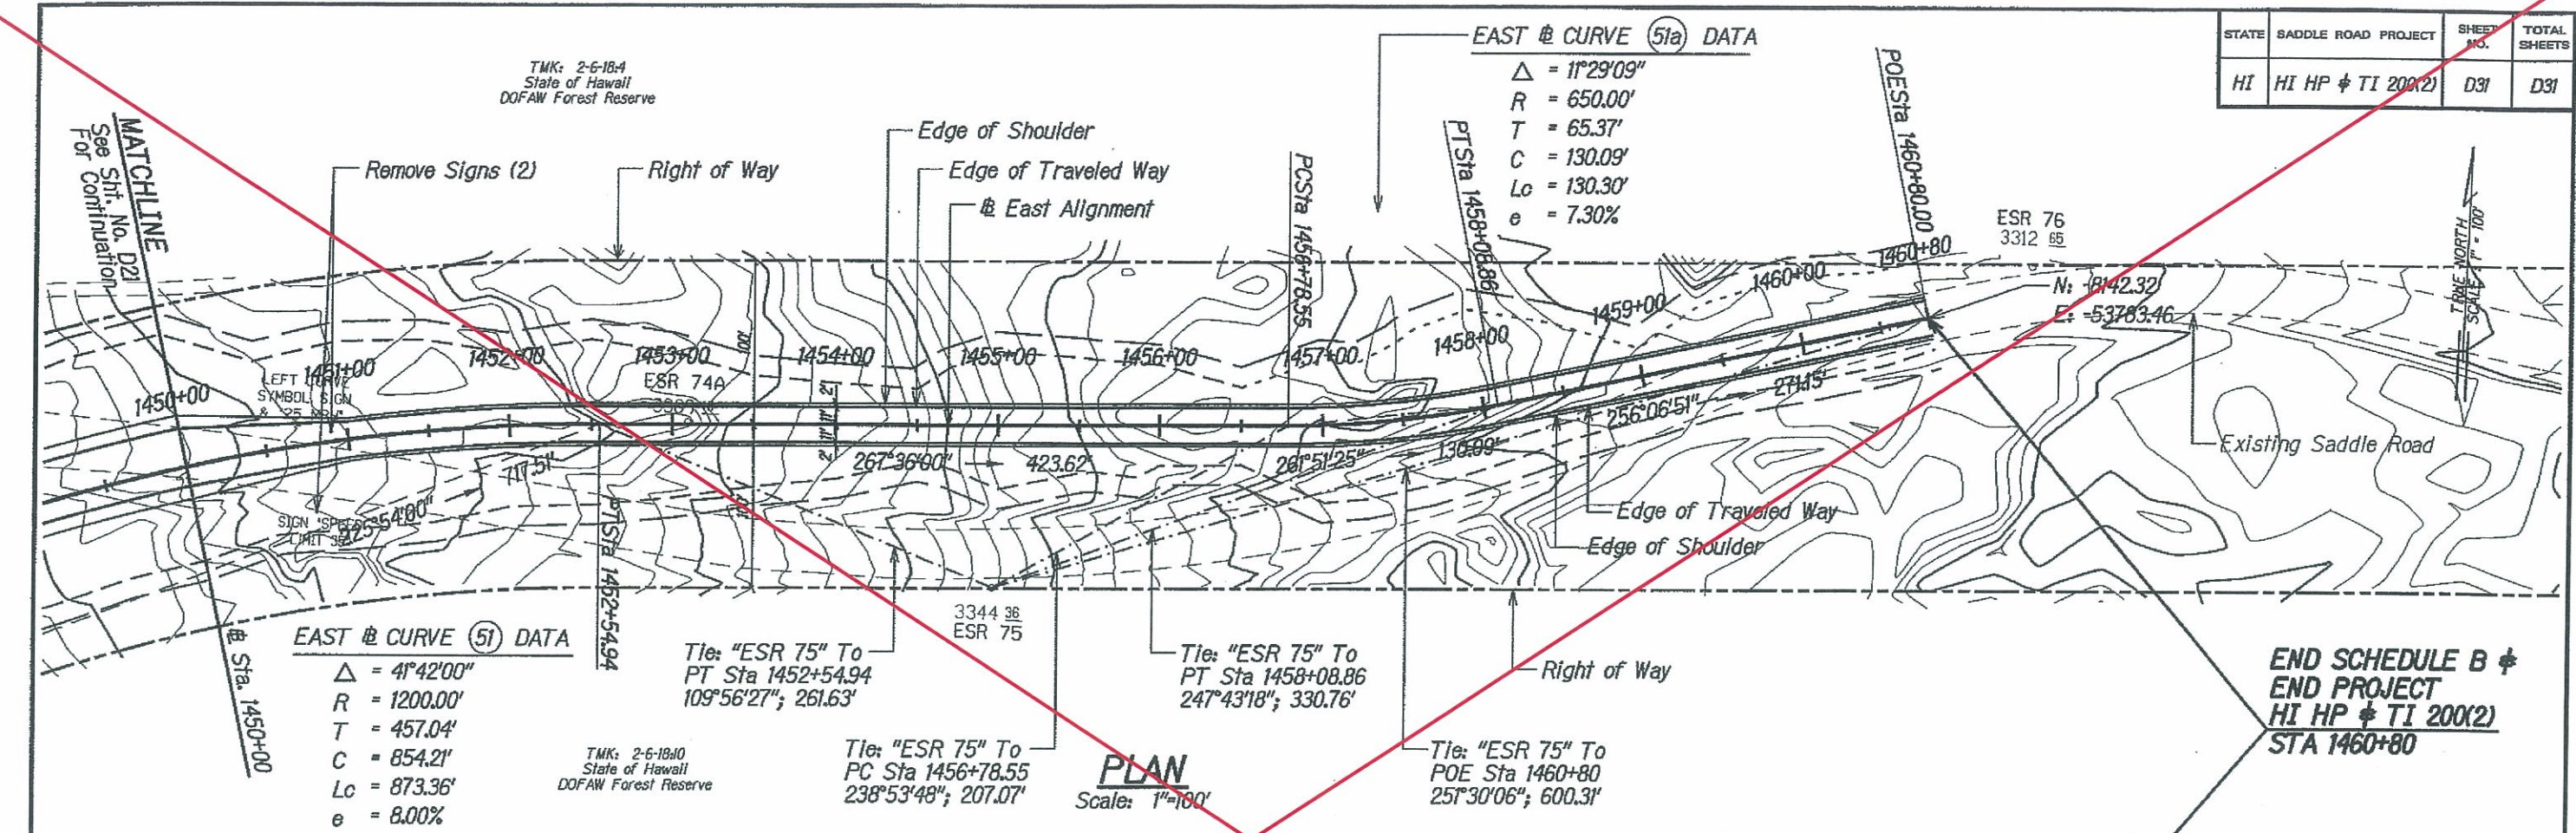

**BRUCE K. MEYERS**  
 Licensed Professional Engineer  
 No. 8336-C  
 HAWAII, U.S.A.

The work was prepared by me or under my supervision and construction of this project will be under my observation.

Expiration Date of License 4/10

U.S. DEPARTMENT OF TRANSPORTATION  
 FEDERAL HIGHWAY ADMINISTRATION  
 CENTRAL FEDERAL LANDS HIGHWAY DIVISION

**SCHEDULE B**  
**ROADWAY PLAN & PROFILE**  
**STA 1450+00 - 1460+80**

Scale: As Noted      Date: June 5, 2009

SHEET No. 31 OF 31

**D31**