

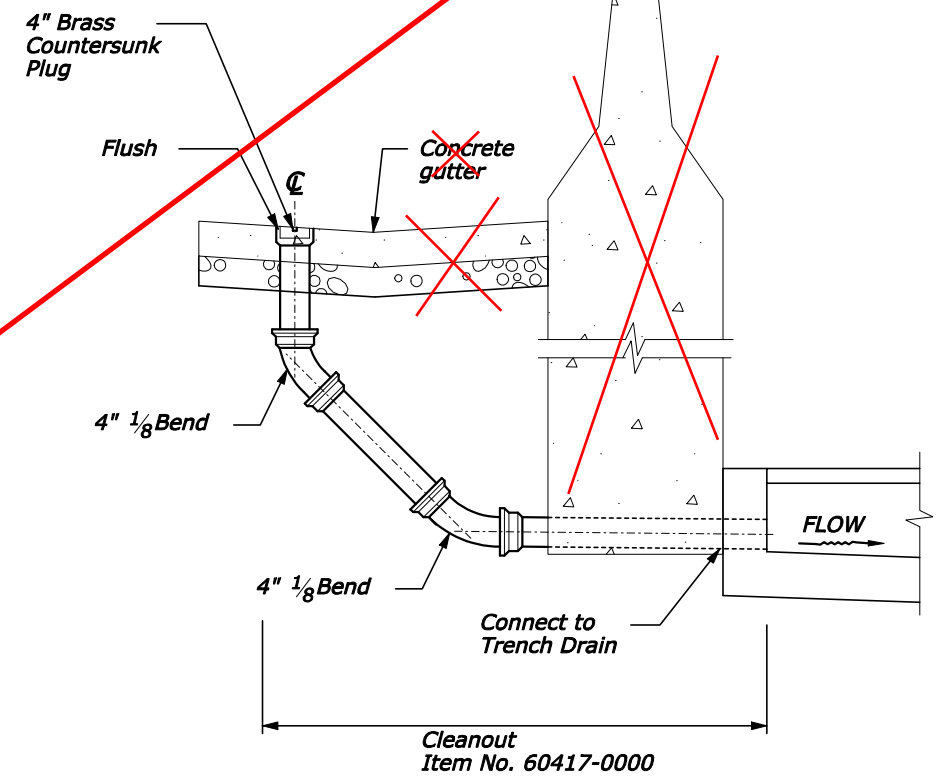



STATE	PROJECT	SHEET NO.	TOTAL SHEETS
HI	HI A-AD 6(8)	G19	G19

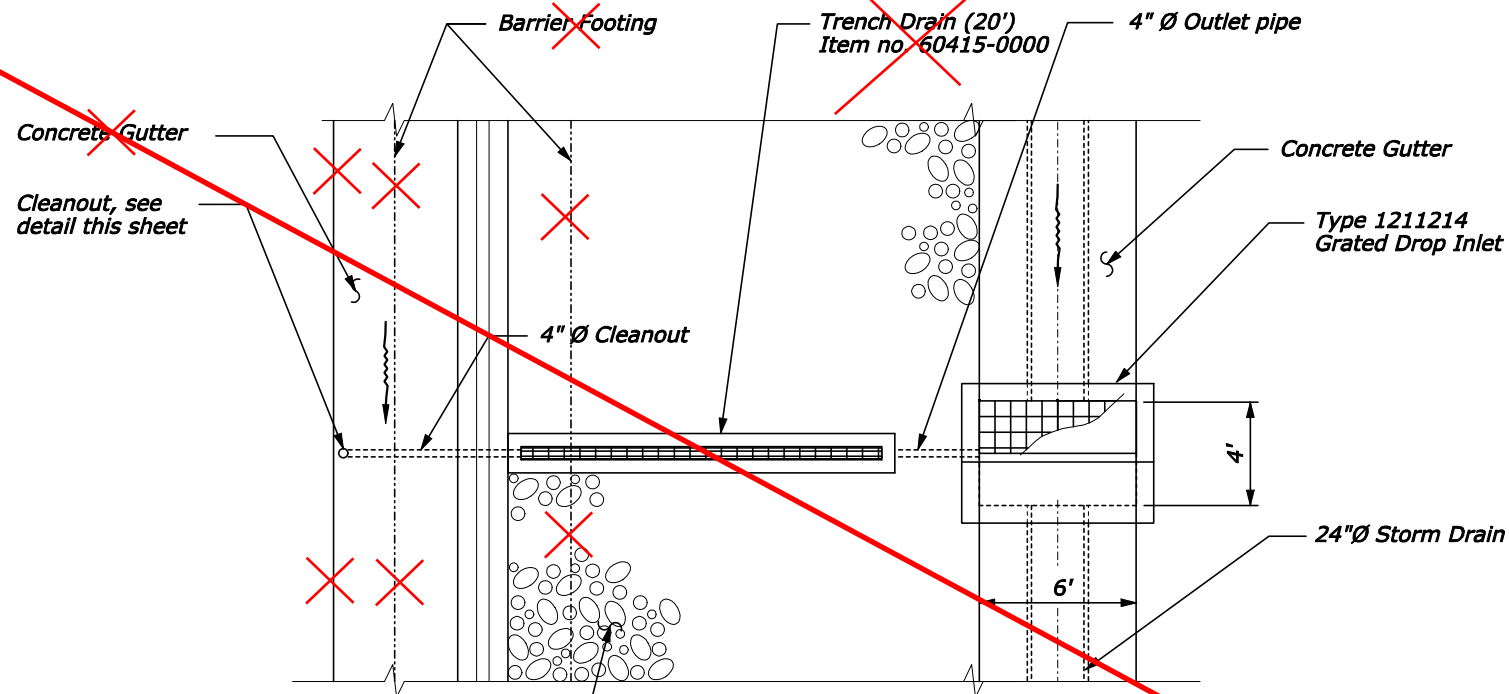

## CLEANOUT TO GRADE

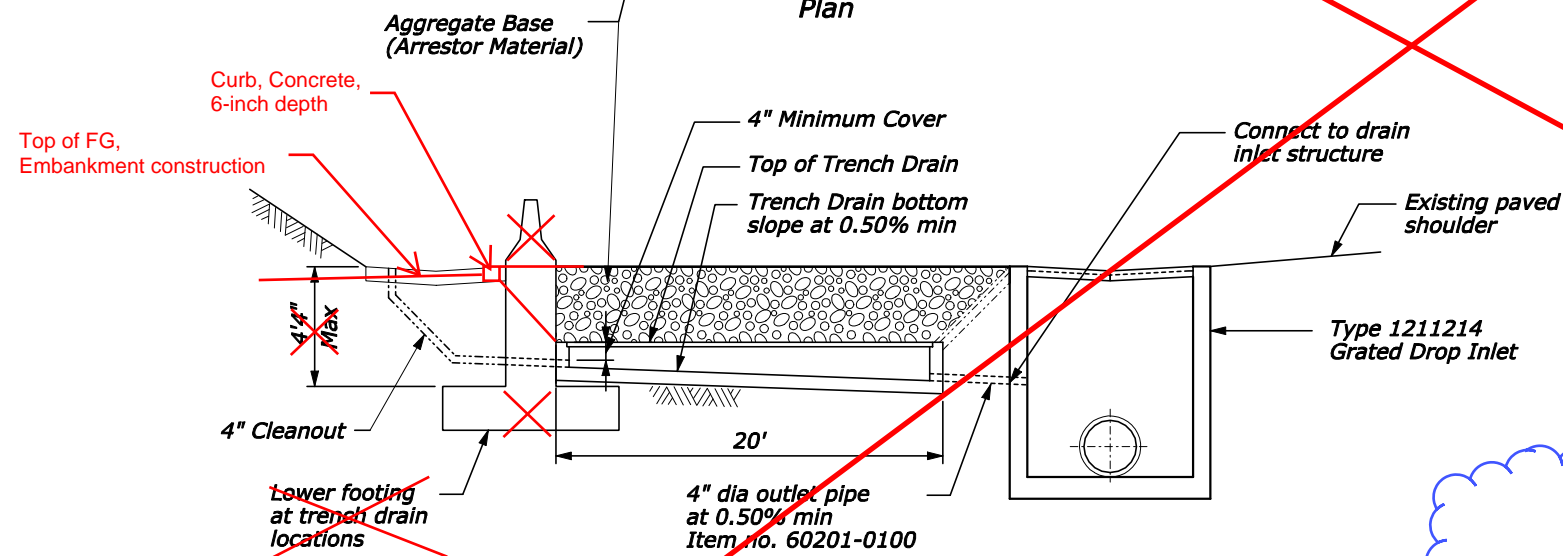


Eliminate Trench Drain

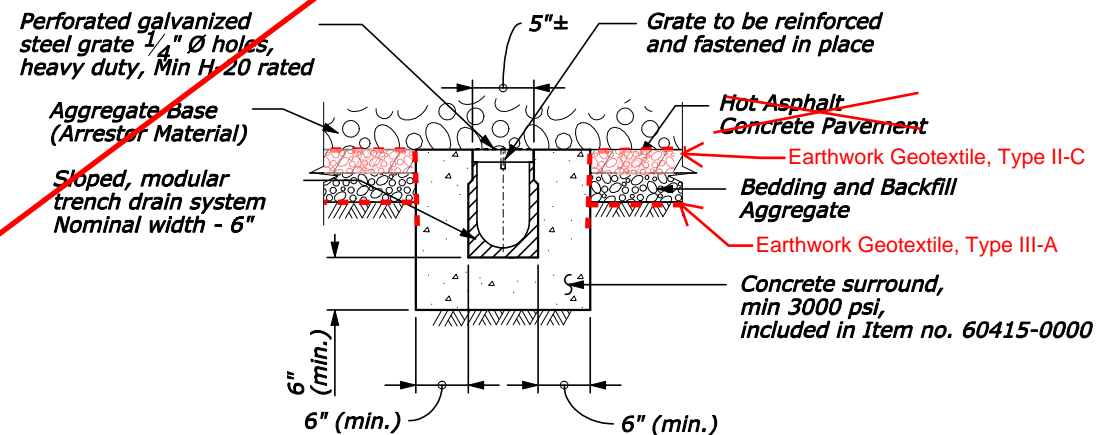

## Section - Trench Drain TRENCH DRAIN DETAIL

Amendment A001  
3/6/15 Contract negotiation revisions and NPDES compliance

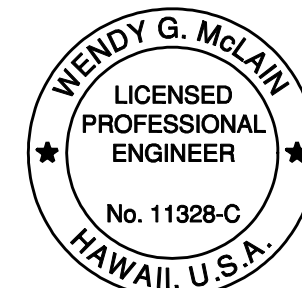

THIS WORK WAS PREPARED BY ME OR  
UNDER MY SUPERVISION.  
4/30/2016  
SIGNATURE EXPIRATION DATE  
OF THE LICENSE

U.S. DEPARTMENT OF TRANSPORTATION  
FEDERAL HIGHWAY ADMINISTRATION  
CENTRAL FEDERAL LANDS HIGHWAY DIVISION

U.S. CUSTOMARY SPECIAL  
**TRENCH DRAIN  
AND CLEANOUT  
DETAILS**

SPECIAL  
610-A

As Built S.T. Rhoades Construction, Inc.