



1/6/2015 4:55:31 PM W:_Civil 3D Projects\2014_027.001 ATKINS Saddle Road West Side Truck Escape Ramps\Roadway\Sheets\G-I\HI SR 200 00_pnp_dm01.dgn

TMK: 6-7-01:041
KE'AMUKU MANEUVER AREA

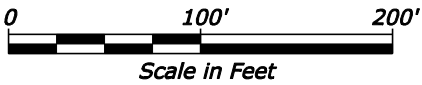


STATE	PROJECT	SHEET NO.	TOTAL SHEETS
HI	HI A-AD 6(8)	G1	G19

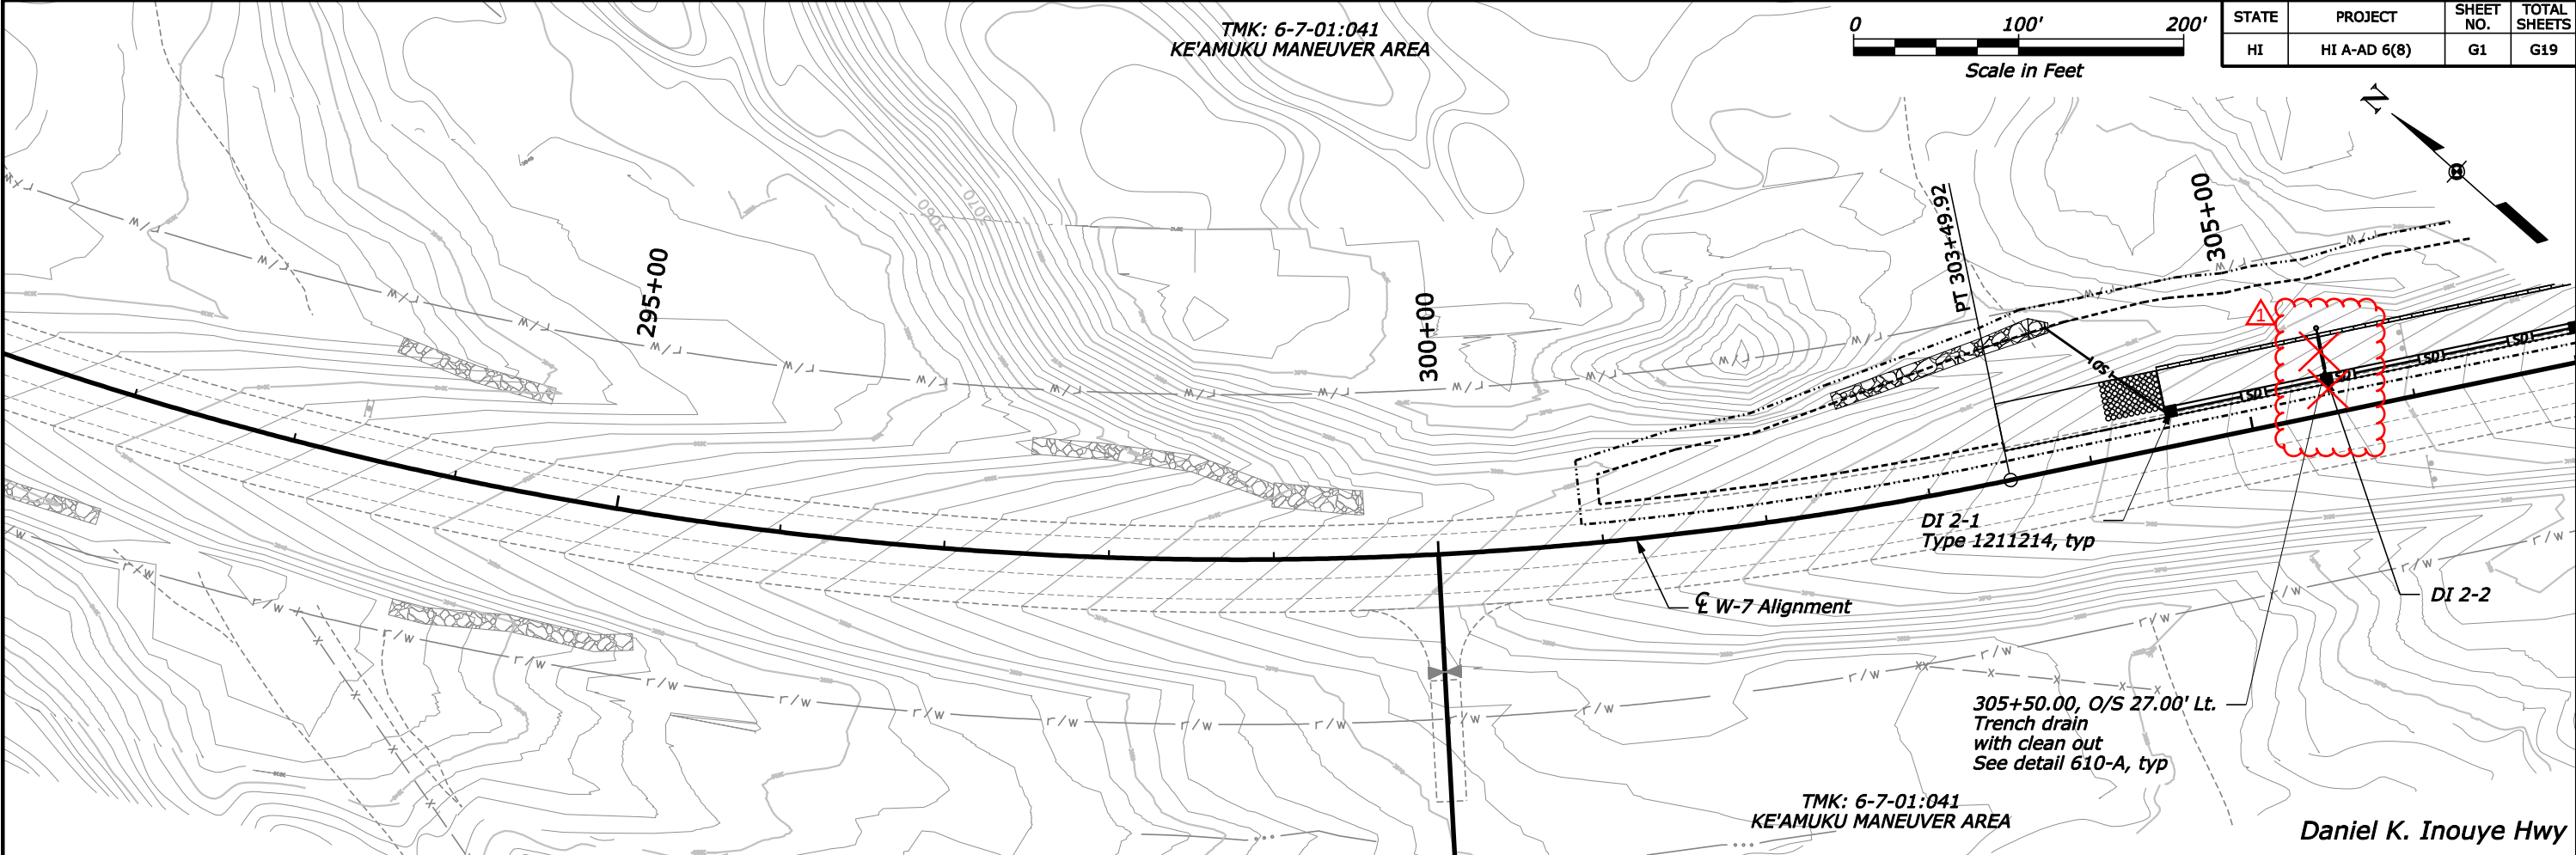

Daniel K. Inouye Hwy

TMK: 6-7-01:041
KE'AMUKU MANEUVER AREA

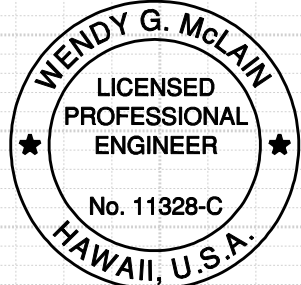

THIS WORK WAS PREPARED BY ME OR
UNDER MY SUPERVISION.
SIGNATURE: *Wendy G. McLain* EXPIRATION DATE
OF THE LICENSE: 4/30/2016

Existing Grade at
Roadway Centerline

+5.083%

Amendment A001
⚠ 3/6/15 Contract negotiation revisions and NPDES compliance

Existing Grade at
Roadway Centerline

303+78
303+89.00, O/S 86.08' Lt.
Outlet SD at toe of slope
Inv. 3089.62
with Flared End Section

304+53.50, O/S 21.00' Lt.
DI 2-1
Rim 3101.76
Inv. 3095.76

305+50, O/S 21.00' Lt.
DI 2-2
Rim 3107.00
Inv. 3101.00

K = 1162
1,000' VC



+5.083%

90' - 24" SD
@ 6.8%

100' - 24" SD
@ 5.2%


VPI 306+00.00
EL 3,109.28

1/6/2015 4:55:55 PM W:\Civil 3D Projects\2014_027.001 ATKINS Saddle Road West Side Truck Escape Ramps\Roadway\Sheets\G-IHI SR 200_00_pnp_din02.dgn

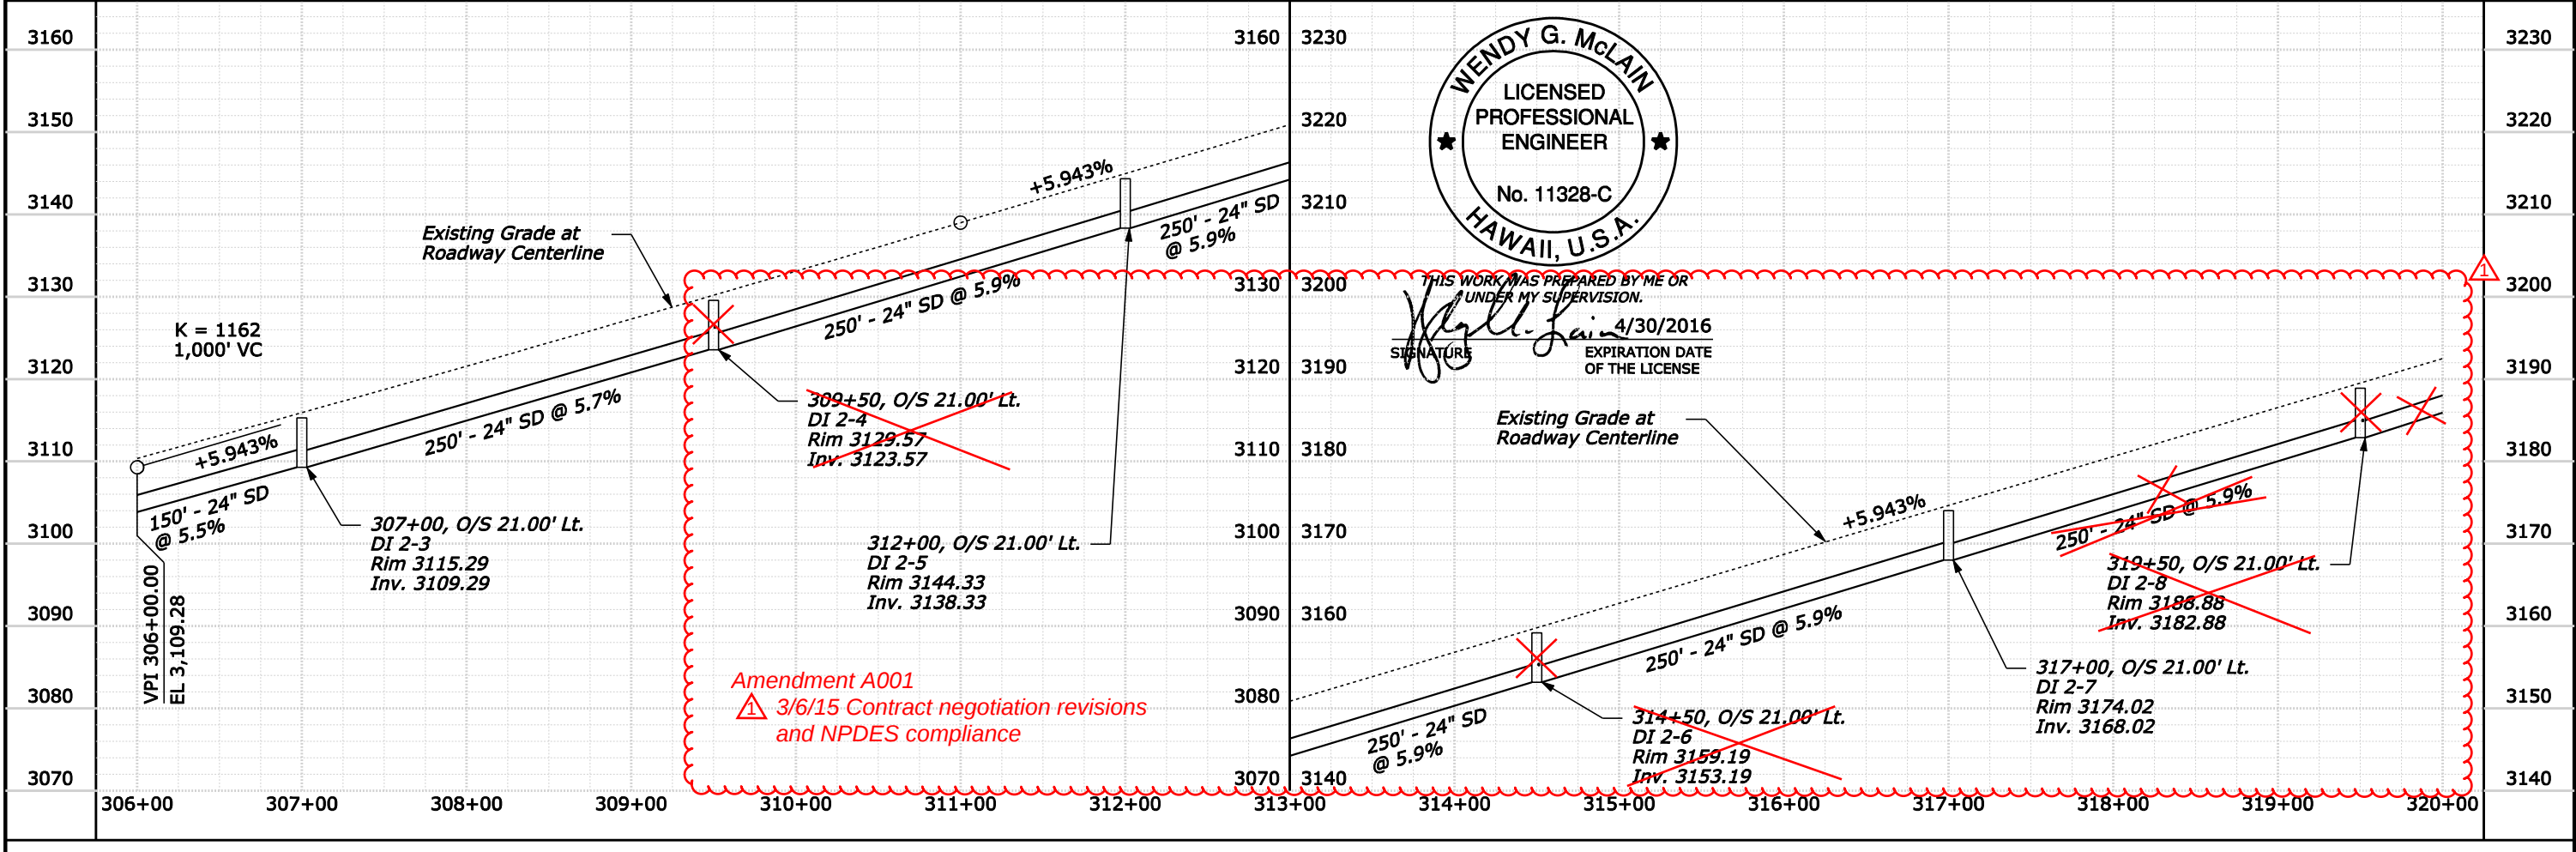
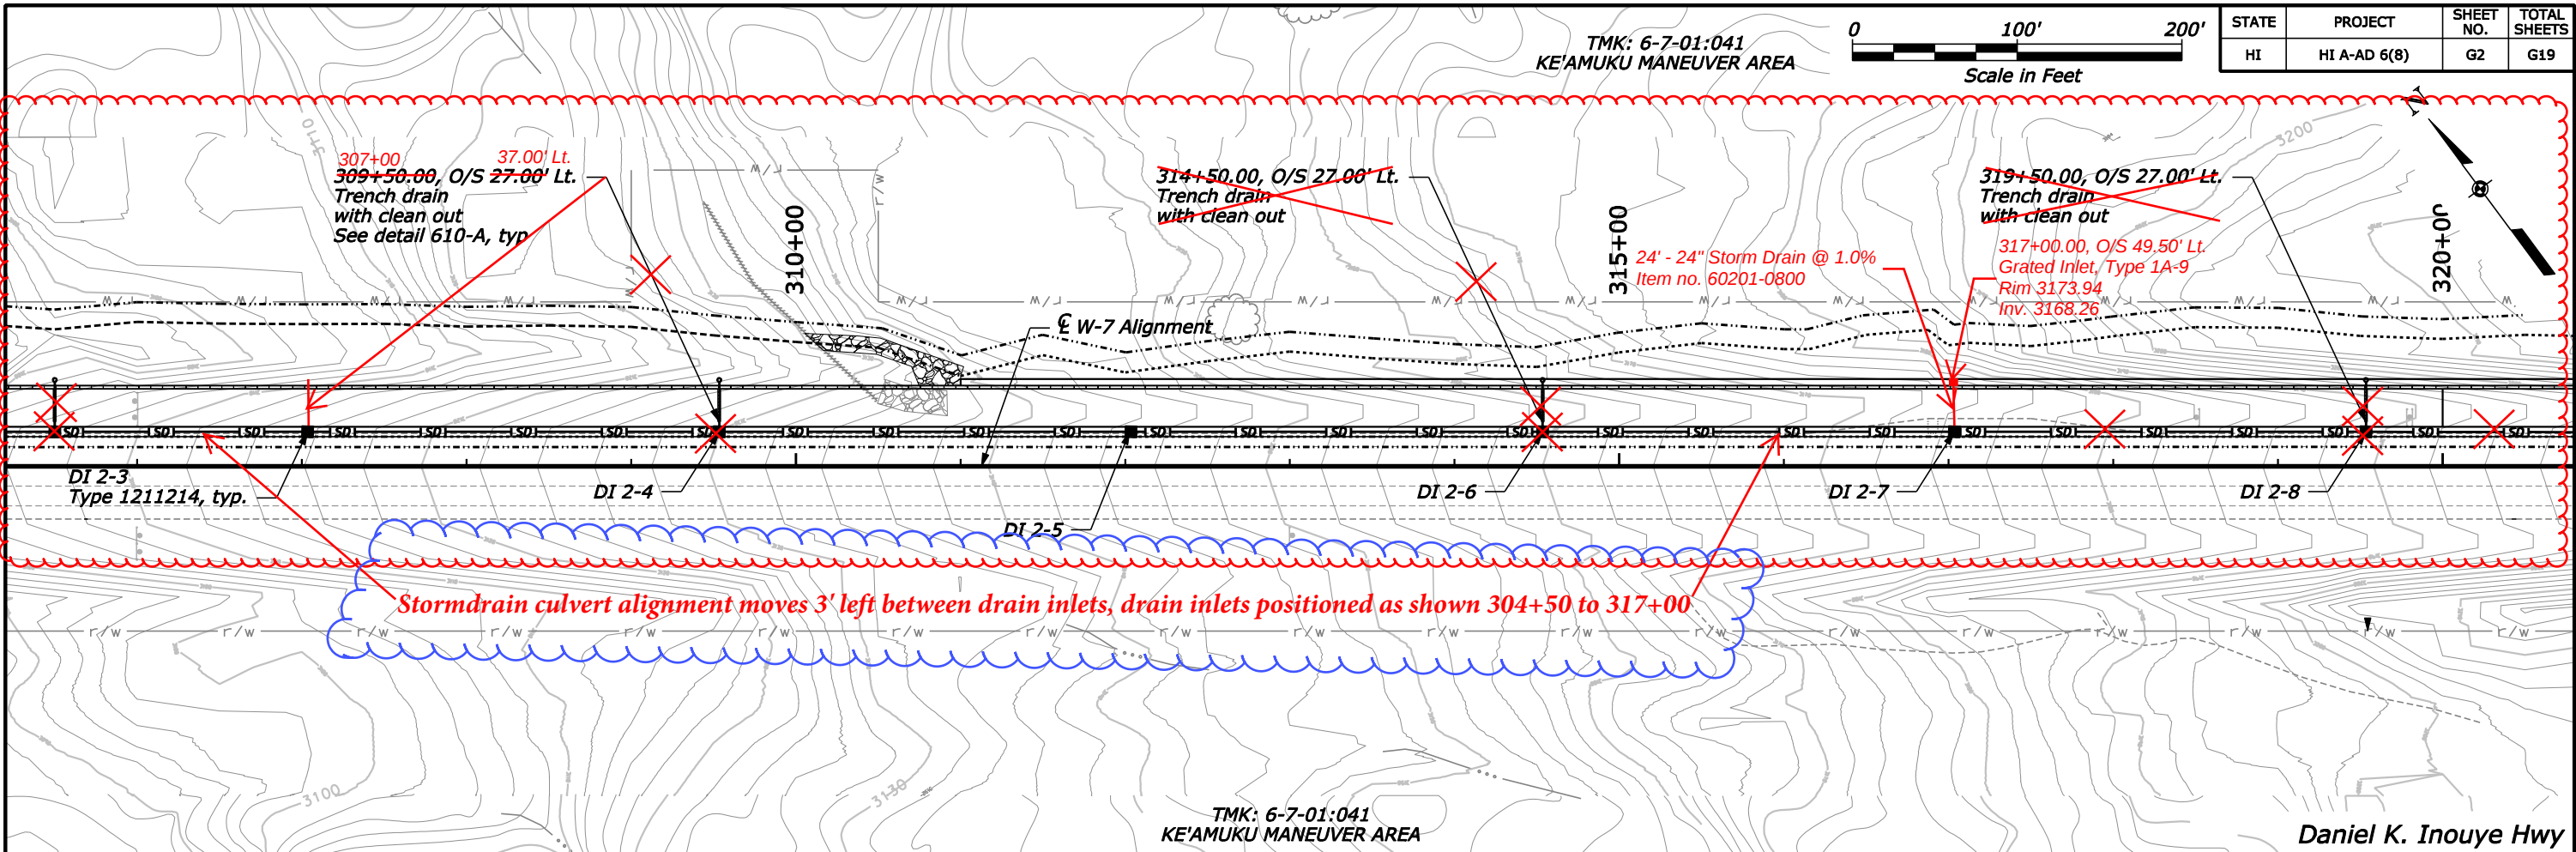


1/6/2015 4:56:21 PM W:\Civil 3D Projects\2014_027.001 ATKINS Saddle Road West Side Truck Escape Ramps\Sheets\G-HI SR 200_00_pnp_dm03.dgn


TMK: 6-7-01:041
KE'AMUKU MANEUVER AREA

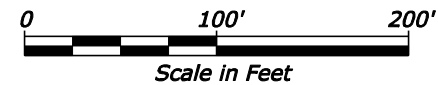


STATE	PROJECT	SHEET NO.	TOTAL SHEETS
HI	HI A-AD 6(8)	G3	G19

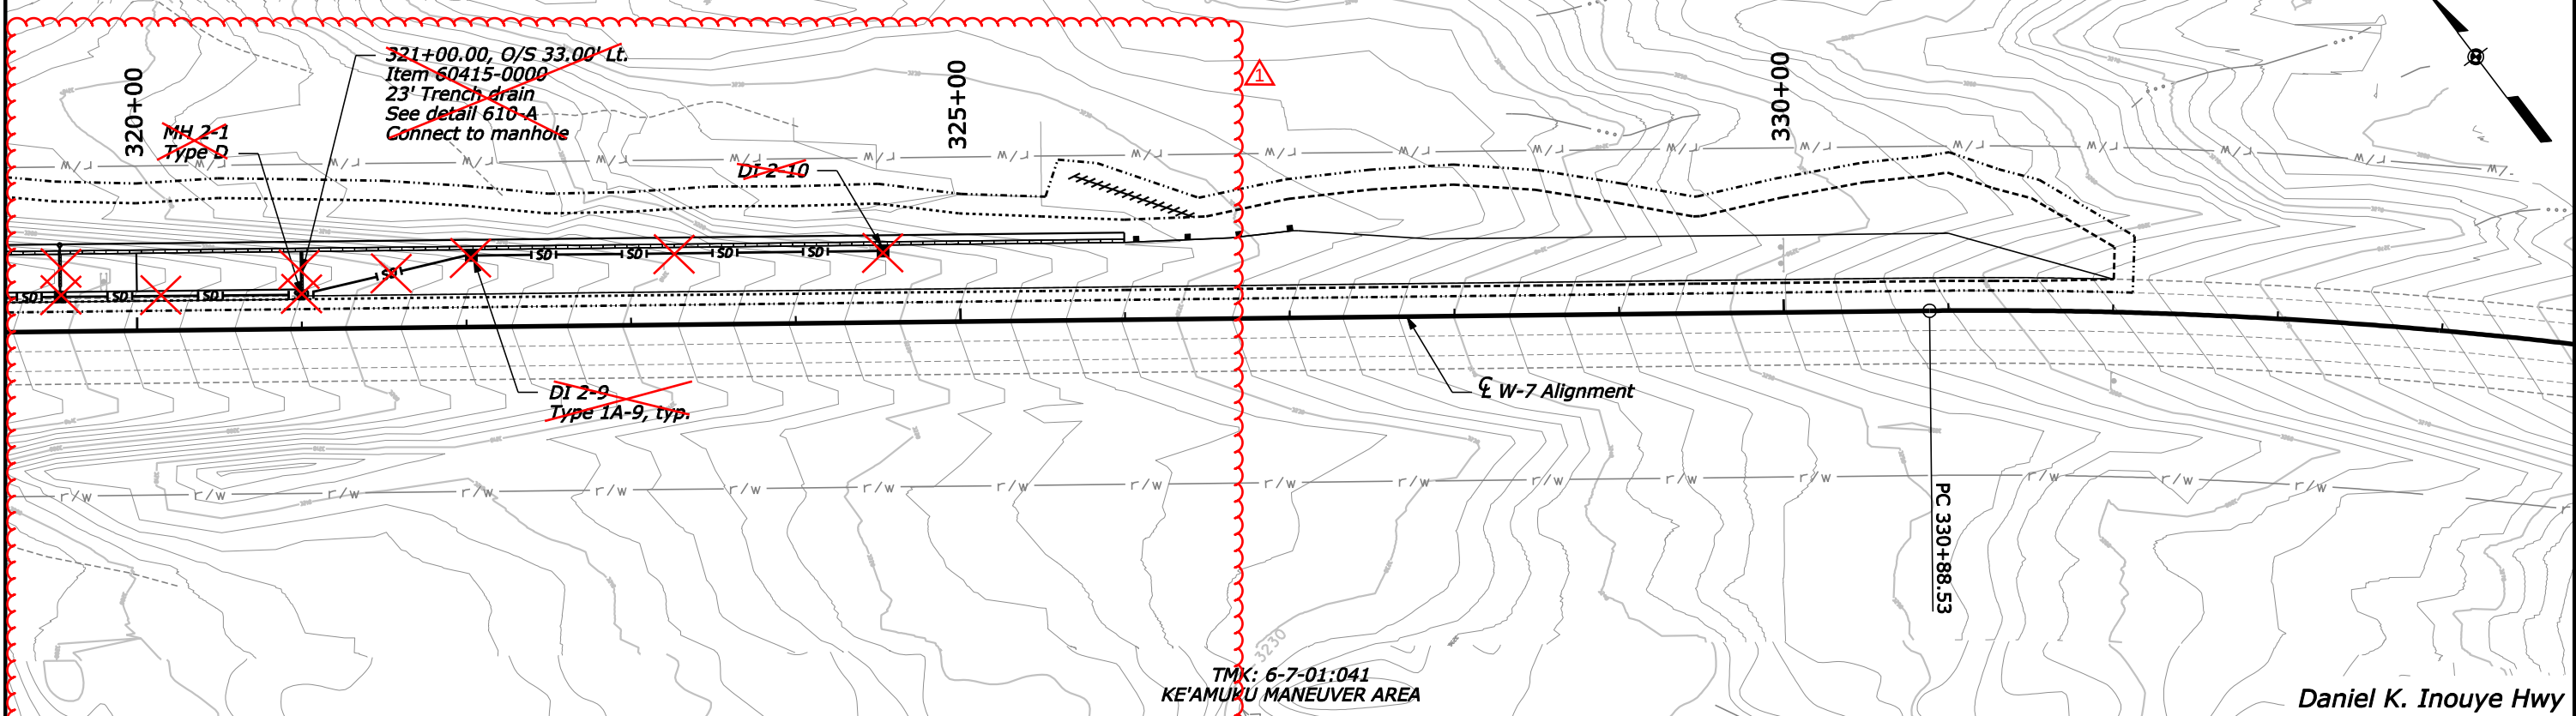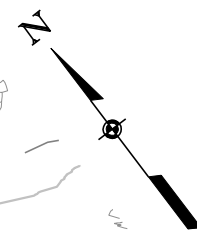

Daniel K. Inouye Hwy

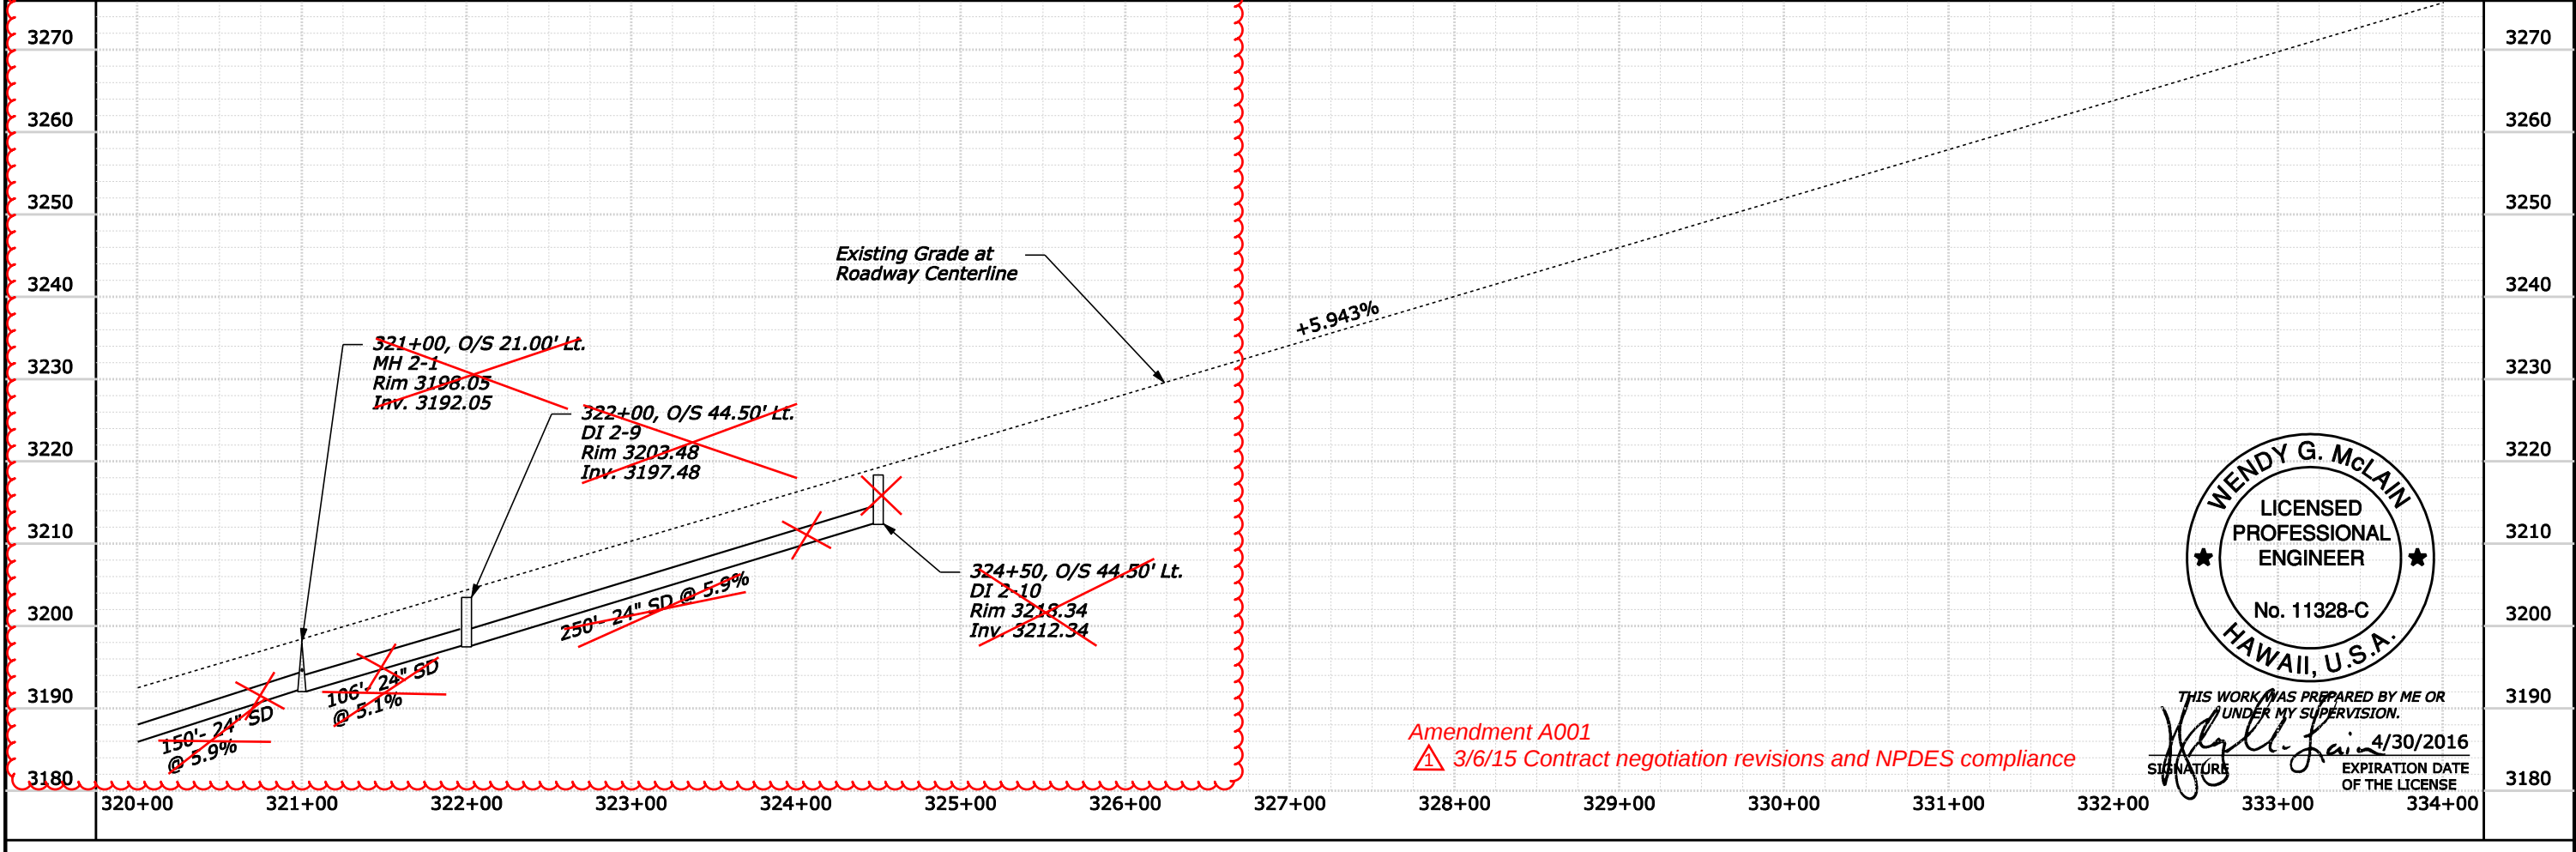

Amendment A001
3/6/15 Contract negotiation revisions and NPDES compliance

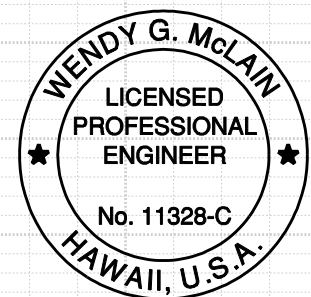

THIS WORK WAS PREPARED BY ME OR UNDER MY SUPERVISION.
SIGNATURE: [Signature] EXPIRATION DATE OF THE LICENSE: 4/30/2016