

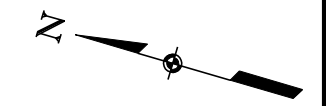



STATE	PROJECT	SHEET NO.	TOTAL SHEETS
HI	HI A-AD 6(8)	V1	V23

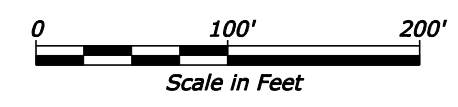

Curve = MAIN-1
 PI 226+37.25
 $\Delta = 55^\circ 32' 10''$ (LT)
 R = 3,120.00'
 T = 1,642.77'
 L = 3,024.18'
 e = 4.80%

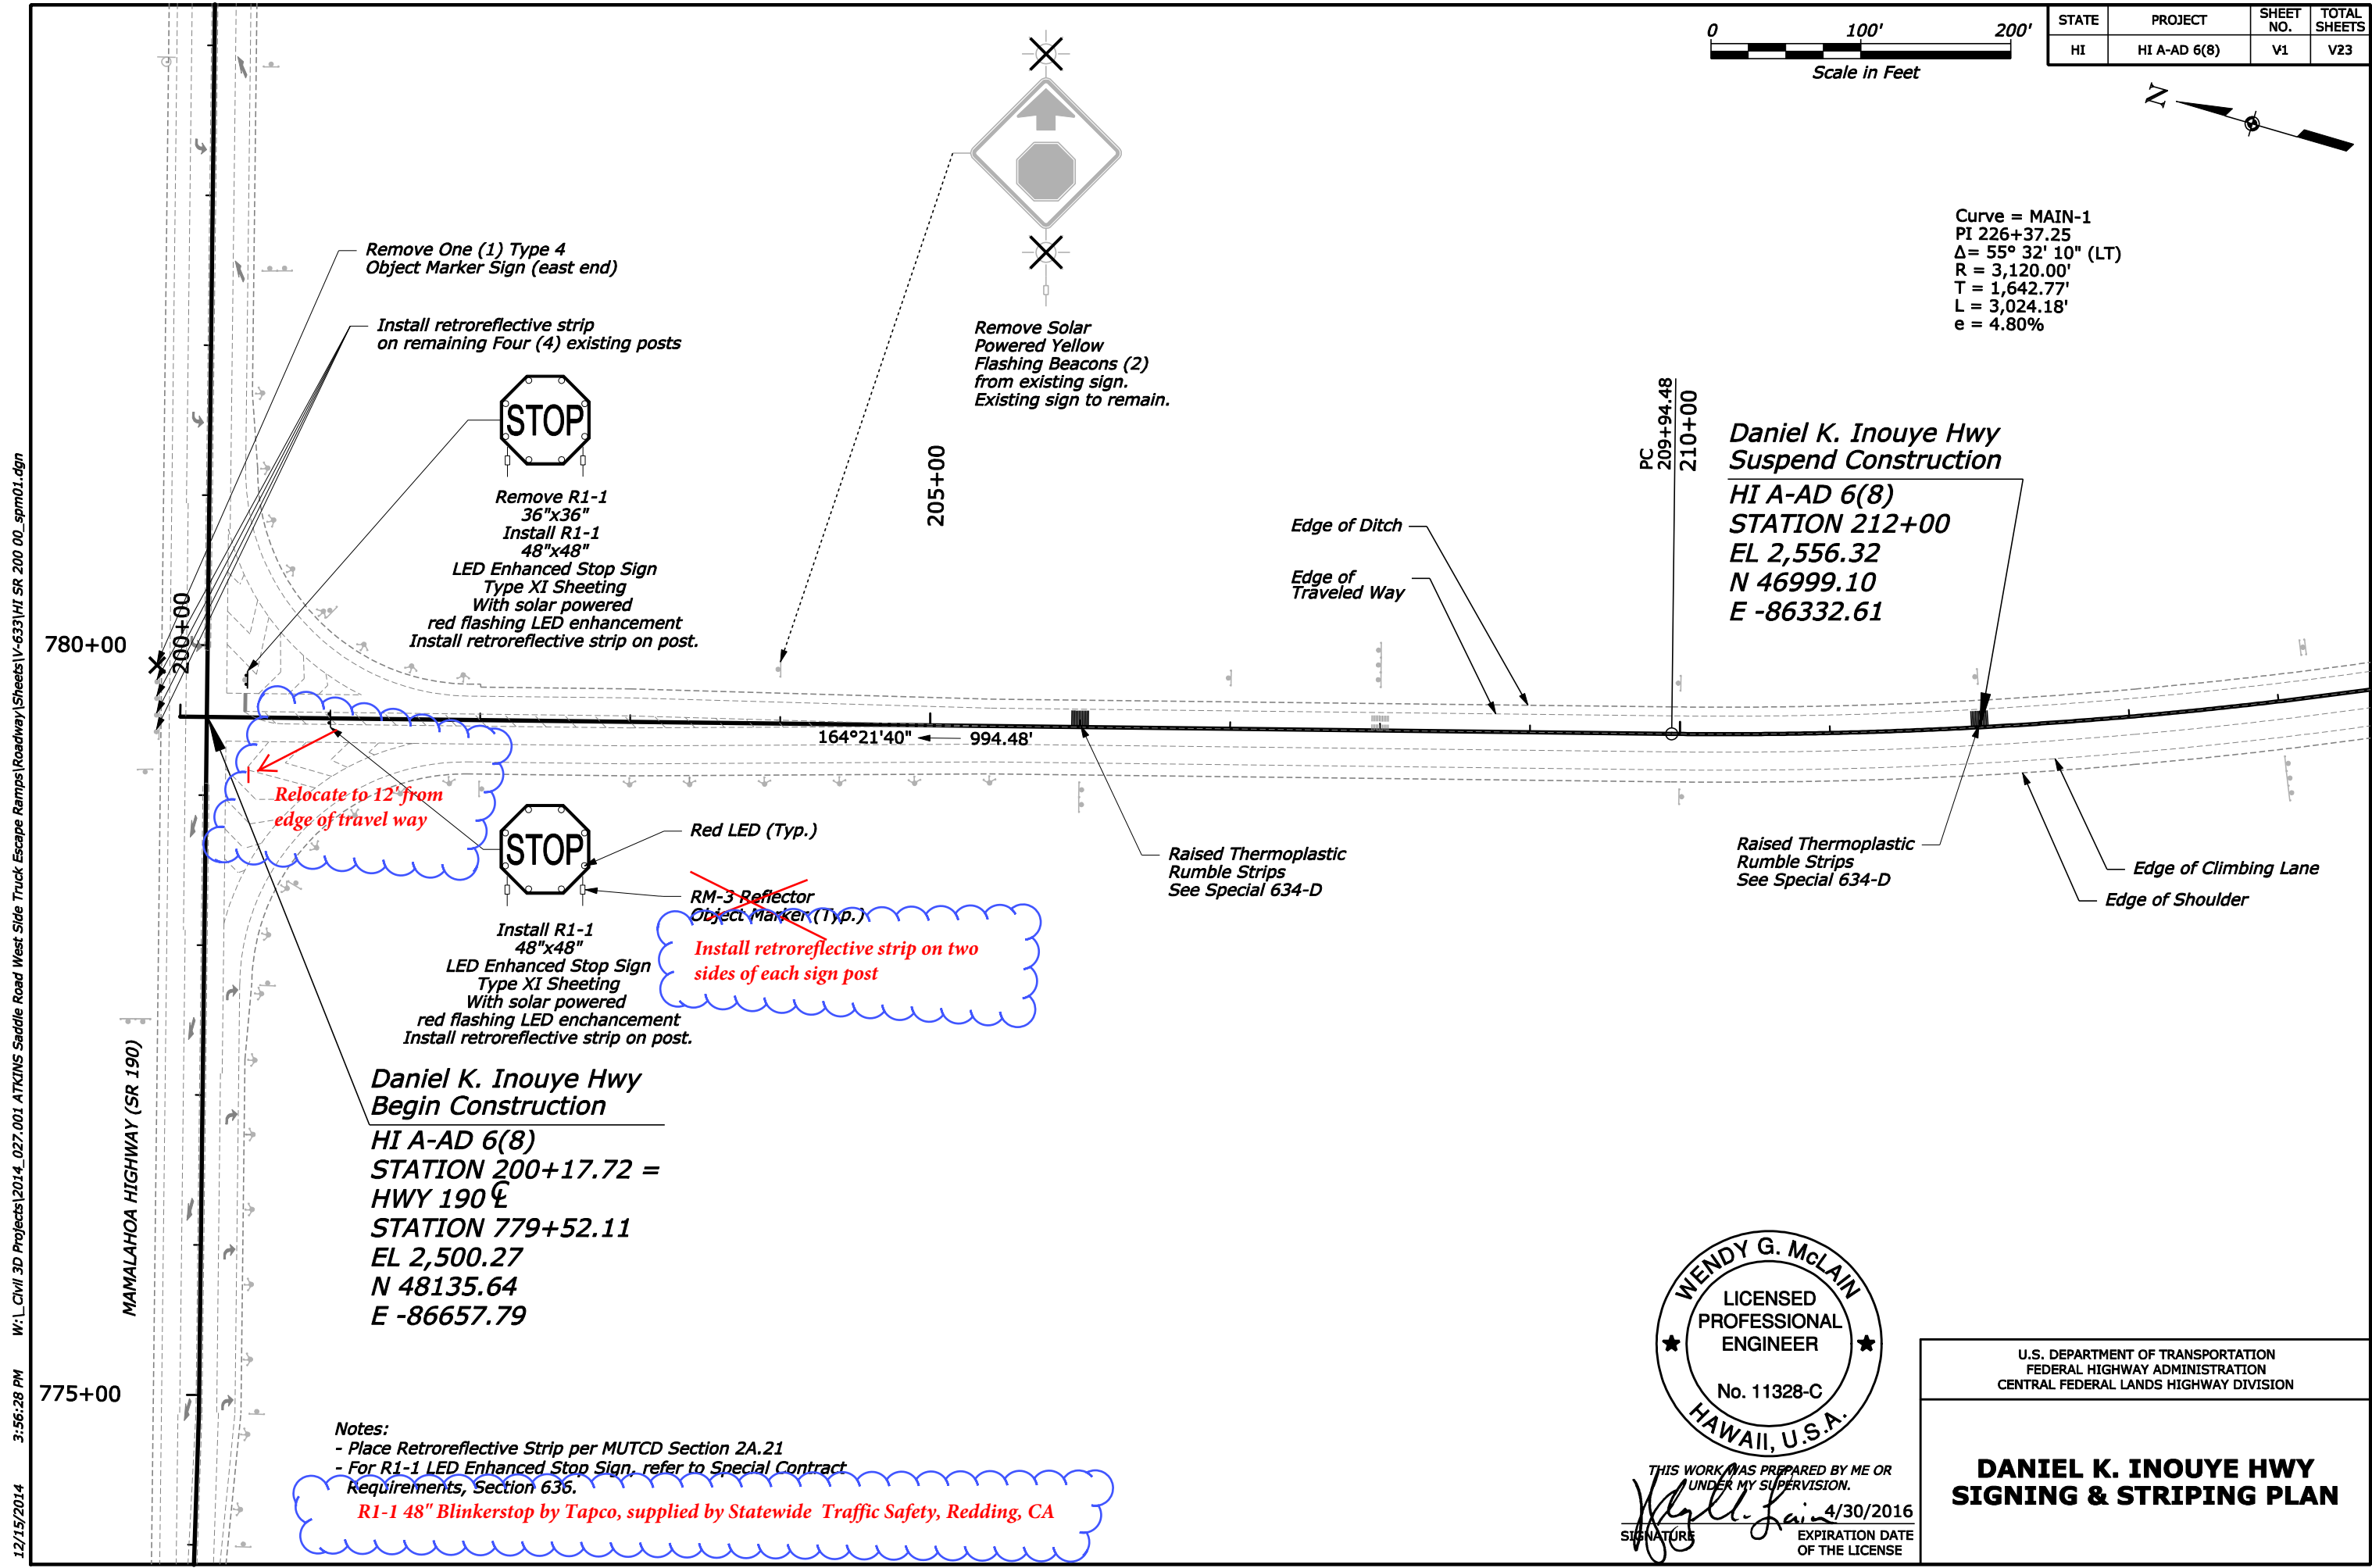

Notes:
 - Place Retroreflective Strip per MUTCD Section 2A.21
 - For R1-1 LED Enhanced Stop Sign, refer to Special Contract Requirements, Section 636.
 R1-1 48" Blinkerstop by Tapco, supplied by Statewide Traffic Safety, Redding, CA

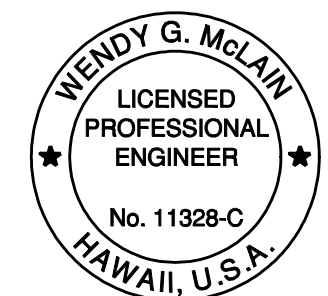


THIS WORK WAS PREPARED BY ME OR UNDER MY SUPERVISION.
 SIGNATURE: *Wendy G. McLain* EXPIRATION DATE OF THE LICENSE: 4/30/2016


U.S. DEPARTMENT OF TRANSPORTATION
 FEDERAL HIGHWAY ADMINISTRATION
 CENTRAL FEDERAL LANDS HIGHWAY DIVISION

**DANIEL K. INOUE HWY
 SIGNING & STRIPING PLAN**


12/15/2014 3:56:28 PM W:_Civil\3D Projects\2014_027.001 ATKINS Saddle Road West Side Truck Escape Ramps\Roadway\Sheets\I-633\HI SR 200 00_spm01.dgn

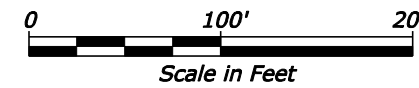


STATE	PROJECT	SHEET NO.	TOTAL SHEETS
HI	HI A-AD 6(8)	V2	V23

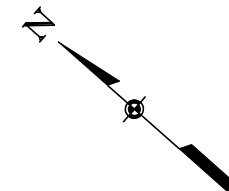

12/9/2014 11:33:25 AM W:_Civil\3D Projects\2014_027.001 ATKINS Saddle Road West Side Truck Escape Ramps\Roadway\Sheets\1-633\HI SR 200 00_spm02.dgn

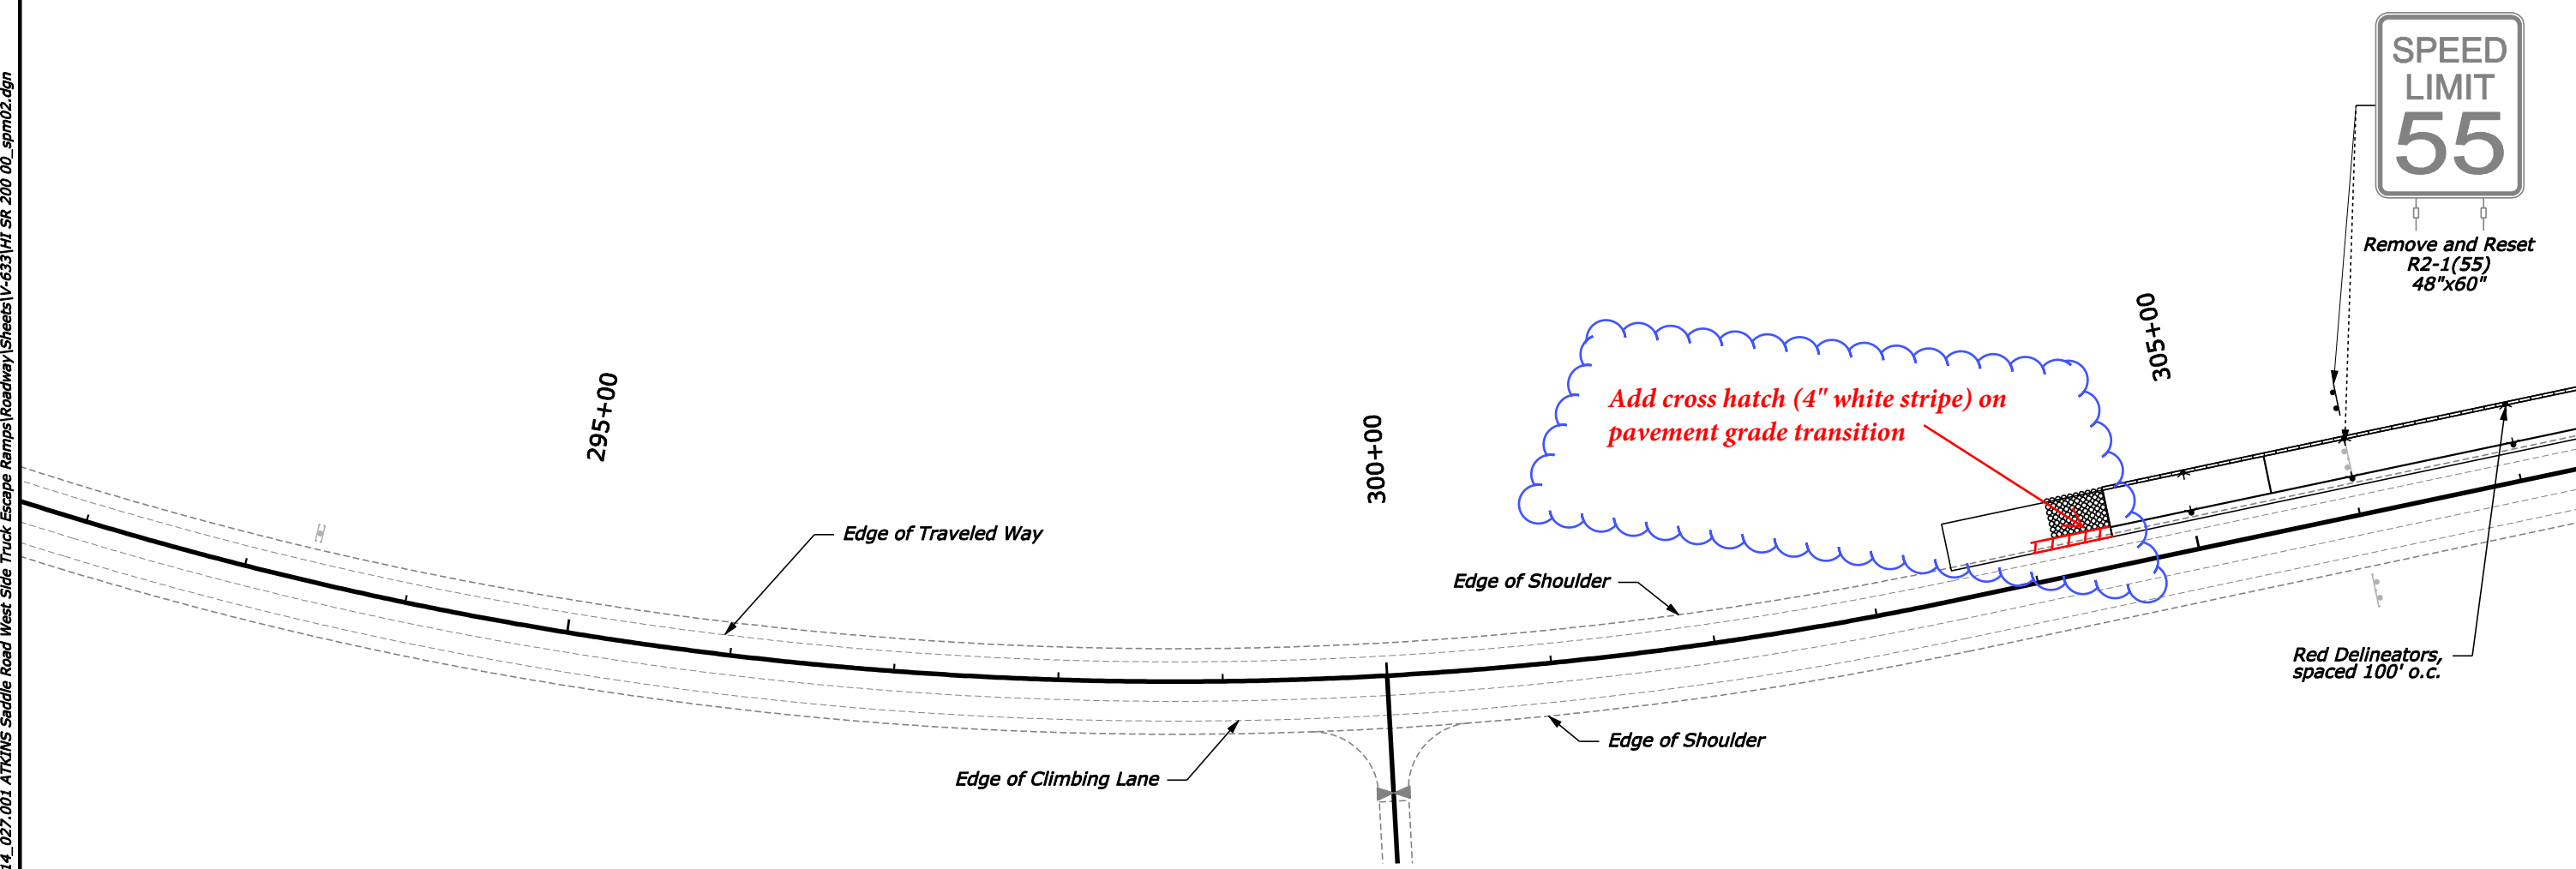

Note:
 - Place Delineators per MUTCD Part 3.
 - Delineators in Truck Ramp shall be color red per MUTCD.

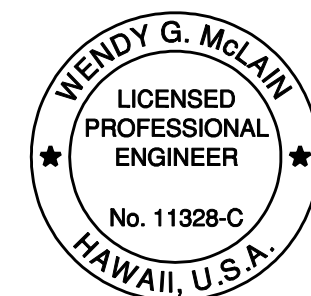


THIS WORK WAS PREPARED BY ME OR UNDER MY SUPERVISION.
 Daniel K. Inouye
 SIGNATURE 4/30/2016
 EXPIRATION DATE OF THE LICENSE

U.S. DEPARTMENT OF TRANSPORTATION
 FEDERAL HIGHWAY ADMINISTRATION
 CENTRAL FEDERAL LANDS HIGHWAY DIVISION


**DANIEL K. INOUE HWY
 SIGNING & STRIPING PLAN**

As Built S.T. Rhoades Construction, Inc.


12/9/2014 11:46:25 AM W:_Civil\3D Projects\2014_027.001 ATKINS Saddle Road West Side Truck Escape Ramps\Roadway\Sheets\1-633\HI SR 200 00_spm03.dgn

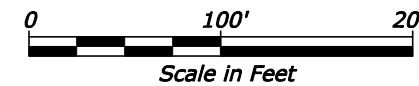

STATE	PROJECT	SHEET NO.	TOTAL SHEETS
HI	HI A-AD 6(8)	V3	V23

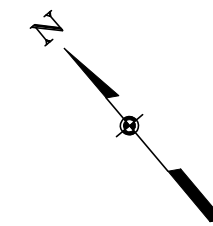

Rotate delineators so that reflectors face on coming traffic in escape lane. (Typical for all)

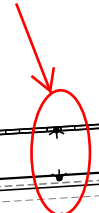


310+00


Edge of Shoulder
Edge of Traveled Way

Red Delineators, spaced 100' o.c.

315+00

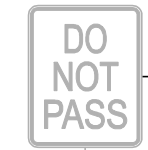


Remove and reset R4-1 24"x30"

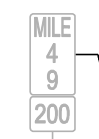

Remove and reset (2) D10-2 10"x27" with (2) D10-7 10"x7"

320+00

Edge of Climbing Lane
Edge of Shoulder

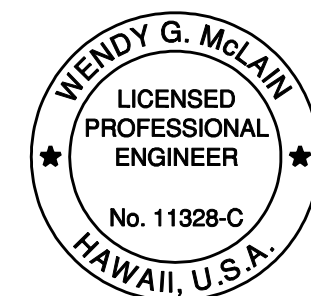


THIS WORK WAS PREPARED BY ME OR UNDER MY SUPERVISION.
Wendy G. McLain 4/30/2016
SIGNATURE EXPIRATION DATE OF THE LICENSE




U.S. DEPARTMENT OF TRANSPORTATION
FEDERAL HIGHWAY ADMINISTRATION
CENTRAL FEDERAL LANDS HIGHWAY DIVISION

**DANIEL K. INOUE HWY
SIGNING & STRIPING PLAN**

12/9/2014 1:22:24 PM W:_Civil\3D Projects\2014_027.001 ATKINS Saddle Road West Side Truck Escape Ramps\Roadway\Sheets\14-633\HI SR 200 00_spm04.dgn

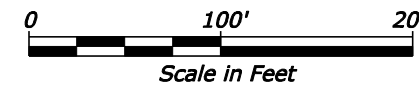


STATE	PROJECT	SHEET NO.	TOTAL SHEETS
HI	HI A-AD 6(8)	V4	V23

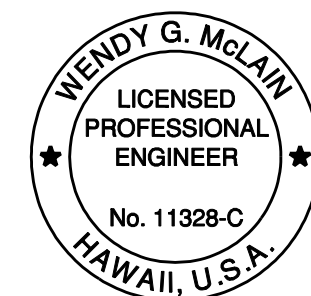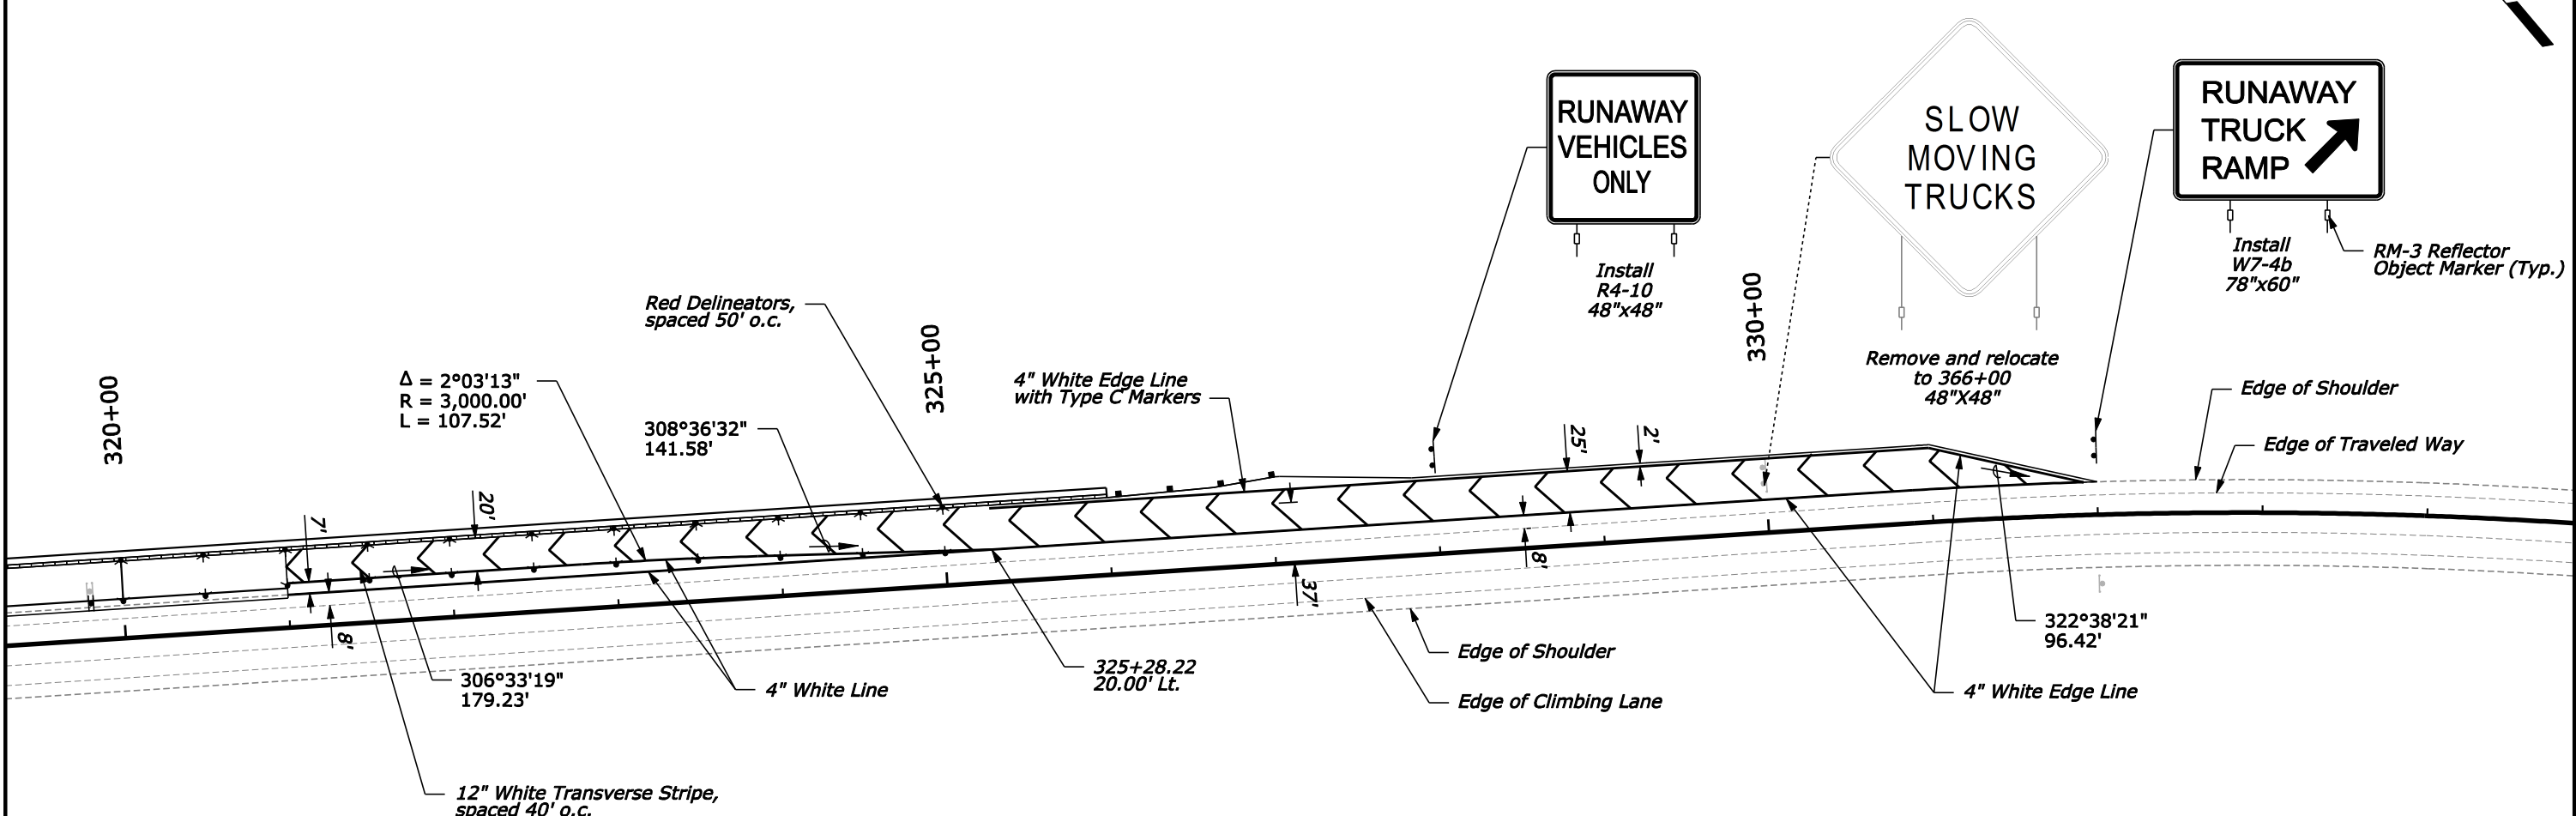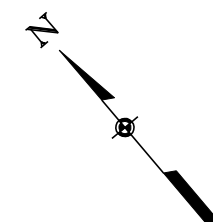


THIS WORK WAS PREPARED BY ME OR UNDER MY SUPERVISION.
Wendy G. McLain
 SIGNATURE 4/30/2016 EXPIRATION DATE OF THE LICENSE

U.S. DEPARTMENT OF TRANSPORTATION
 FEDERAL HIGHWAY ADMINISTRATION
 CENTRAL FEDERAL LANDS HIGHWAY DIVISION


**DANIEL K. INOUE HWY
 SIGNING & STRIPING PLAN**

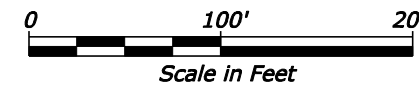


STATE	PROJECT	SHEET NO.	TOTAL SHEETS
HI	HI A-AD 6(8)	V5	V23

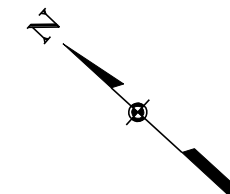

12/5/2014 10:49:15 AM W:_Civil\3D Projects\2014_027.001 ATKINS Saddle Road West Side Truck Escape Ramps\Roadway\Sheets\1-633\HI SR 200 00_spm05.dgn

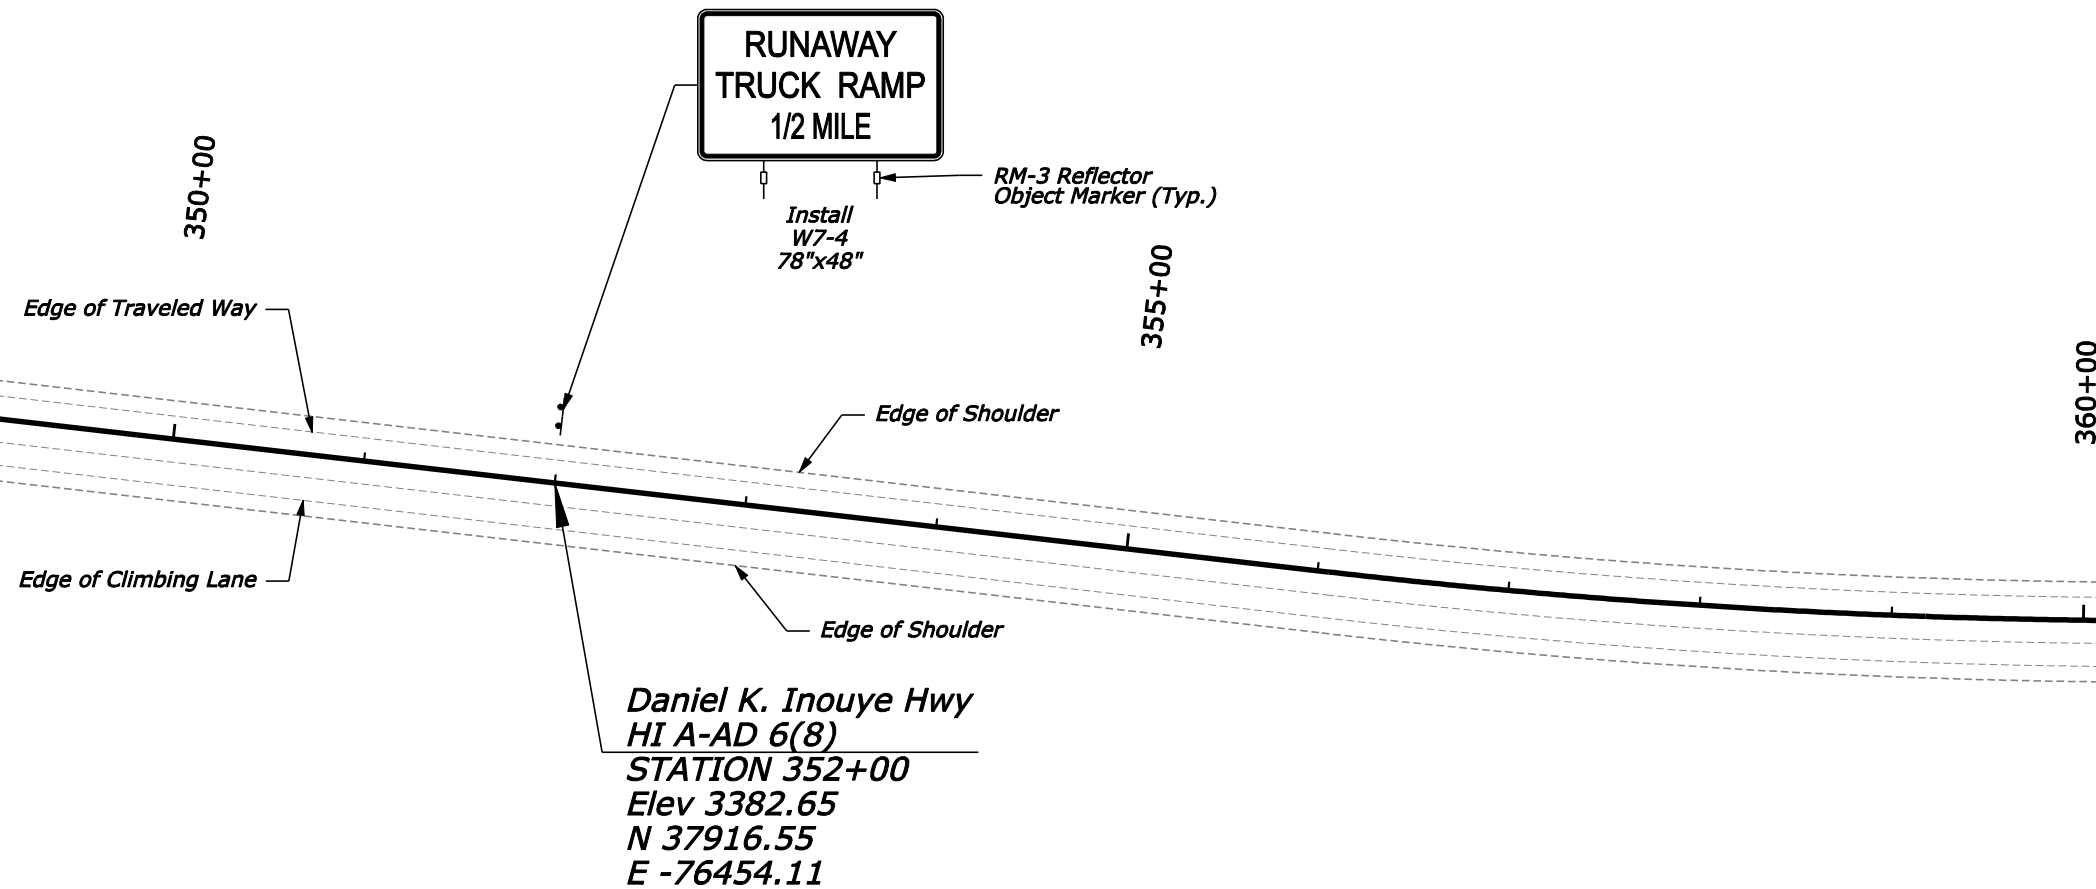

Daniel K. Inouye Hwy
 HI A-AD 6(8)
 STATION 352+00
 Elev 3382.65
 N 37916.55
 E -76454.11

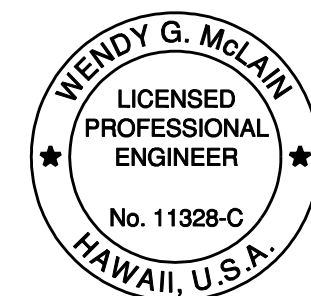


THIS WORK WAS PREPARED BY ME OR UNDER MY SUPERVISION.
Wendy G. McLain
 SIGNATURE 4/30/2016 EXPIRATION DATE OF THE LICENSE



U.S. DEPARTMENT OF TRANSPORTATION
 FEDERAL HIGHWAY ADMINISTRATION
 CENTRAL FEDERAL LANDS HIGHWAY DIVISION

**DANIEL K. INOUE HWY
 SIGNING & STRIPING PLAN**


12/9/2014 1:24:07 PM W:_Civil\3D Projects\2014_027.001 ATKINS Saddle Road West Side Truck Escape Ramps\Roadway\Sheets\1-633\HI SR 200 00_spm06.dgn

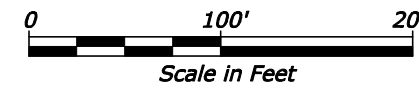

STATE	PROJECT	SHEET NO.	TOTAL SHEETS
HI	HI A-AD 6(8)	V6	V23

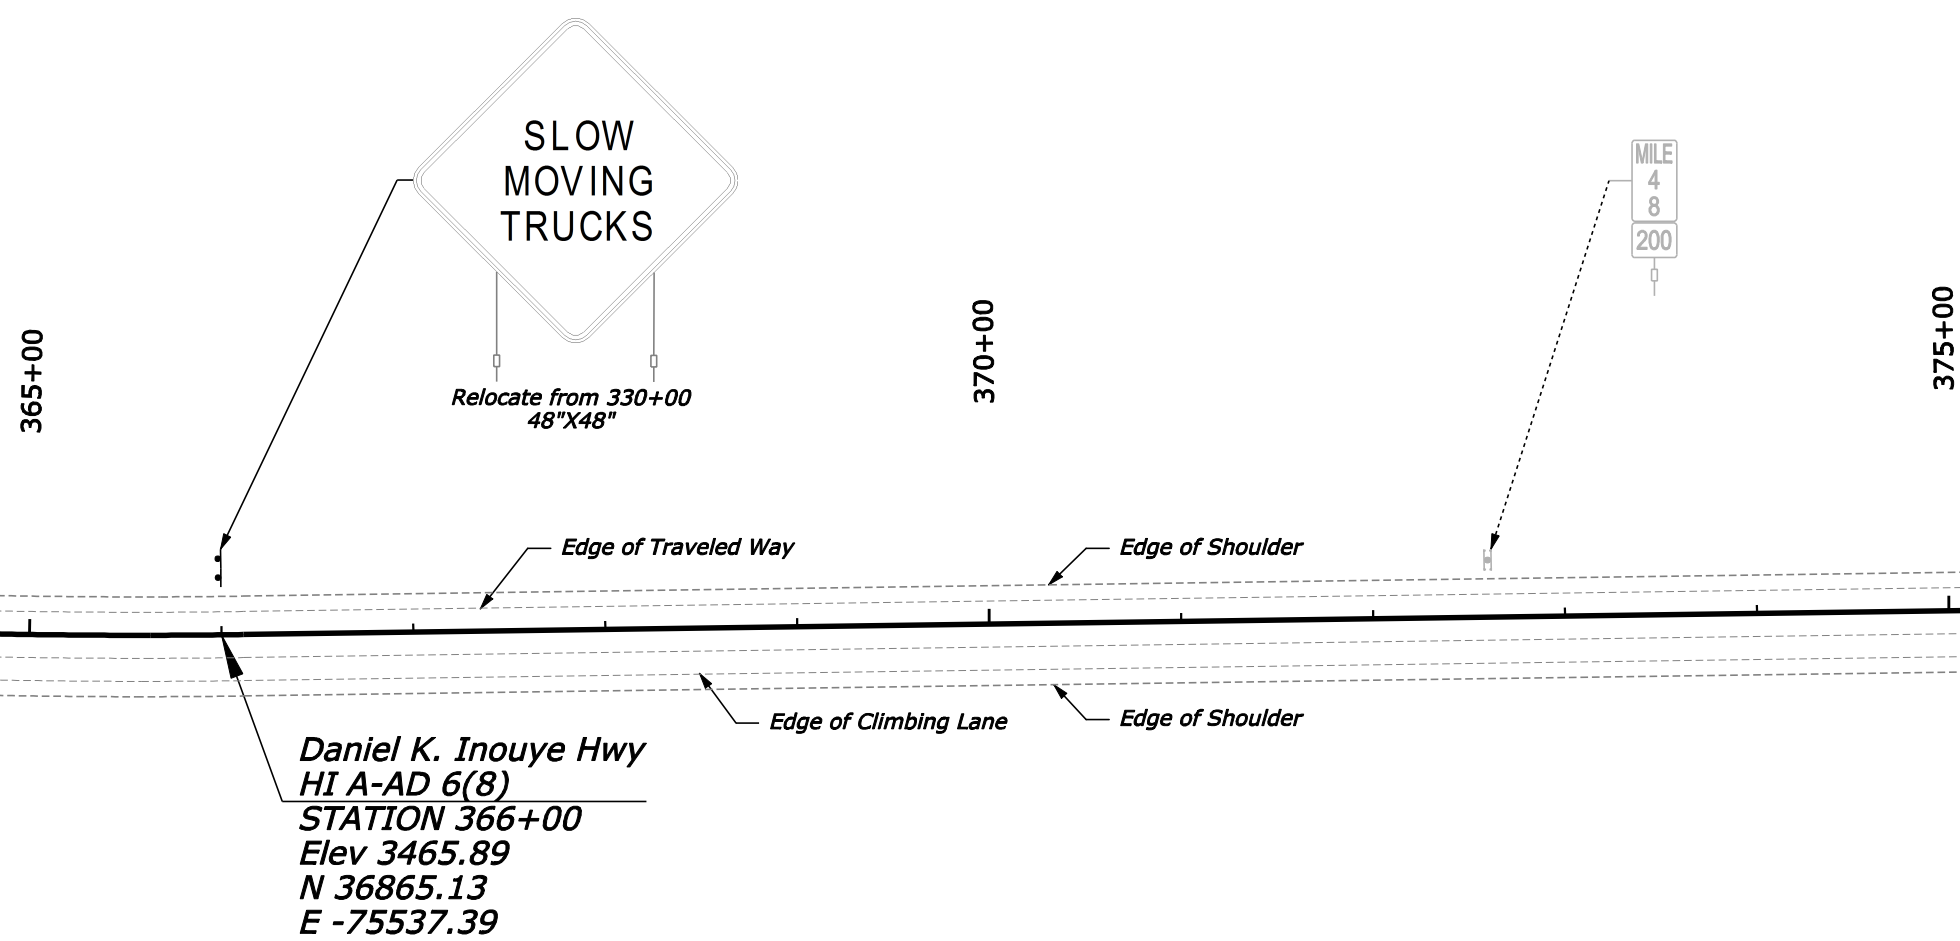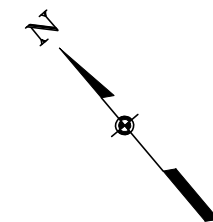


Daniel K. Inouye Hwy
 HI A-AD 6(8)
 STATION 366+00
 Elev 3465.89
 N 36865.13
 E -75537.39

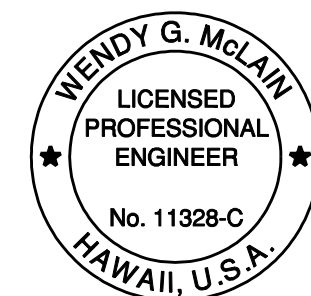


THIS WORK WAS PREPARED BY ME OR UNDER MY SUPERVISION.
 Signature: *Wendy G. McLain*
 EXPIRATION DATE OF THE LICENSE: 4/30/2016

U.S. DEPARTMENT OF TRANSPORTATION
 FEDERAL HIGHWAY ADMINISTRATION
 CENTRAL FEDERAL LANDS HIGHWAY DIVISION

**DANIEL K. INOUE HWY
 SIGNING & STRIPING PLAN**

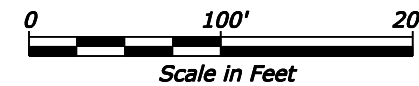

STATE	PROJECT	SHEET NO.	TOTAL SHEETS
HI	HI A-AD 6(8)	V7	V23

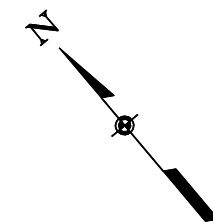

**RUNAWAY
TRUCK RAMP
1 MILE**

Install
W7-4
78"x48"

Install
RM-3 Reflector
Object Marker (Typ.)

**DO
NOT
PASS**

Do not disturb
R4-1
24"x30"

380+00


385+00

390+00

Edge of Traveled Way
Edge of Shoulder

Edge of Shoulder
Edge of Climbing Lane

Daniel K. Inouye Hwy
HI A-AD 6(8)
STATION 378+00
Elev 3552.36
N 36105.04
E -74608.80

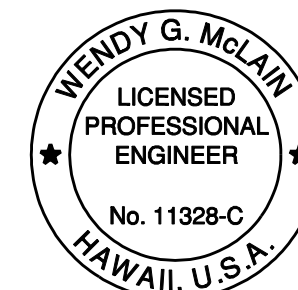

THIS WORK WAS PREPARED BY ME OR
UNDER MY SUPERVISION.
Wendy G. McLain 4/30/2016
SIGNATURE EXPIRATION DATE
OF THE LICENSE

U.S. DEPARTMENT OF TRANSPORTATION
FEDERAL HIGHWAY ADMINISTRATION
CENTRAL FEDERAL LANDS HIGHWAY DIVISION

**DANIEL K. INOUYE HWY
SIGNING & STRIPING PLAN**

12/9/2014 1:25:22 PM W:_Civil\3D Projects\2014_027.001 ATKINS Saddle Road West Side Truck Escape Ramps\Roadway\Sheets\1-633\HI SR 200 00_spm07.dgn