


1/7/2015 7:19:56 PM W:_Civil 3D Projects\2014_027.001 ATKINS Saddle Road West Side Truck Escape Ramps\Roadway\Sheets\E-150\HI SR 20000_epl07.dgn


STATE	PROJECT	SHEET NO.	TOTAL SHEETS
HI	HI A-A0 6(8)	E7	E10

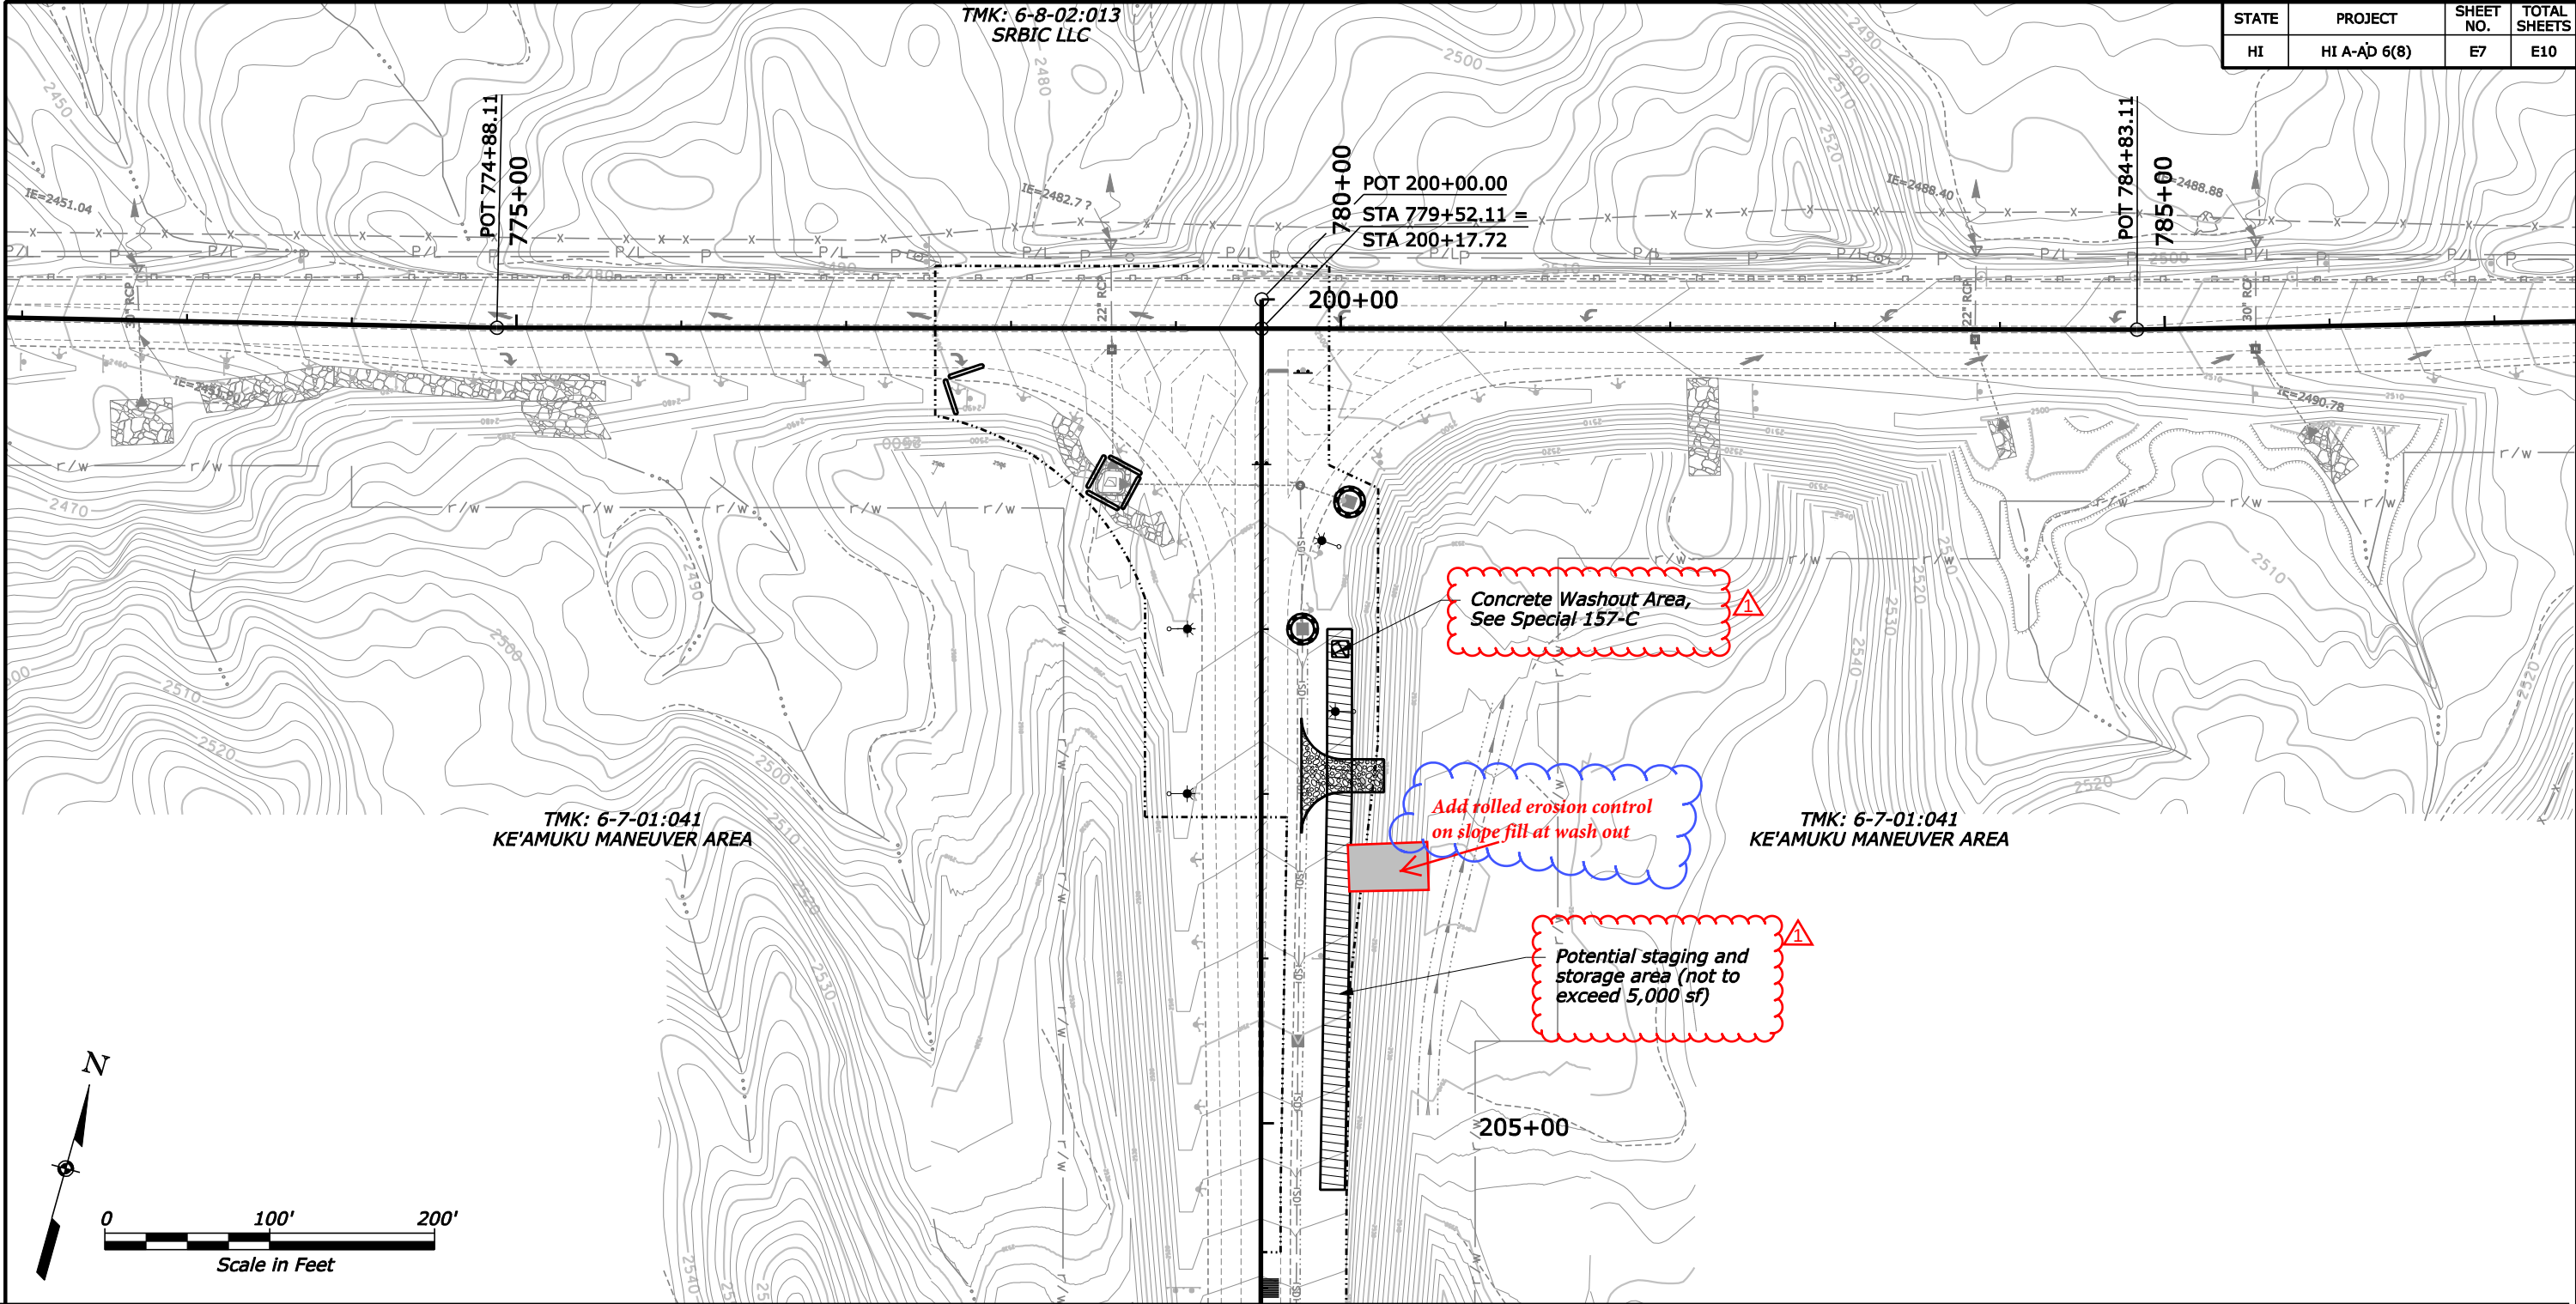

Amendment A001
⚠ 3/6/15 Contract negotiation revisions and NPDES compliance

NOTE:

- 1. Erosion and sediment control devices not to scale.
- 2. Refer to the Conventional Plan Symbols and Abbreviations sheet for erosion and sediment control symbols.

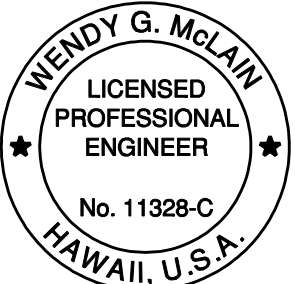

THIS WORK WAS PREPARED BY ME OR UNDER MY SUPERVISION.
Signature: [Signature] 4/30/2016
EXPIRATION DATE OF THE LICENSE

U.S. DEPARTMENT OF TRANSPORTATION
FEDERAL HIGHWAY ADMINISTRATION
CENTRAL FEDERAL LANDS HIGHWAY DIVISION

HWY 190 (Mamalahoa Hwy)
Intersection
EROSION AND SEDIMENT
CONTROL PLAN