



Comments relative to 48 inch and plastic fences are valid and should not be struck out. Changes to stationing only.



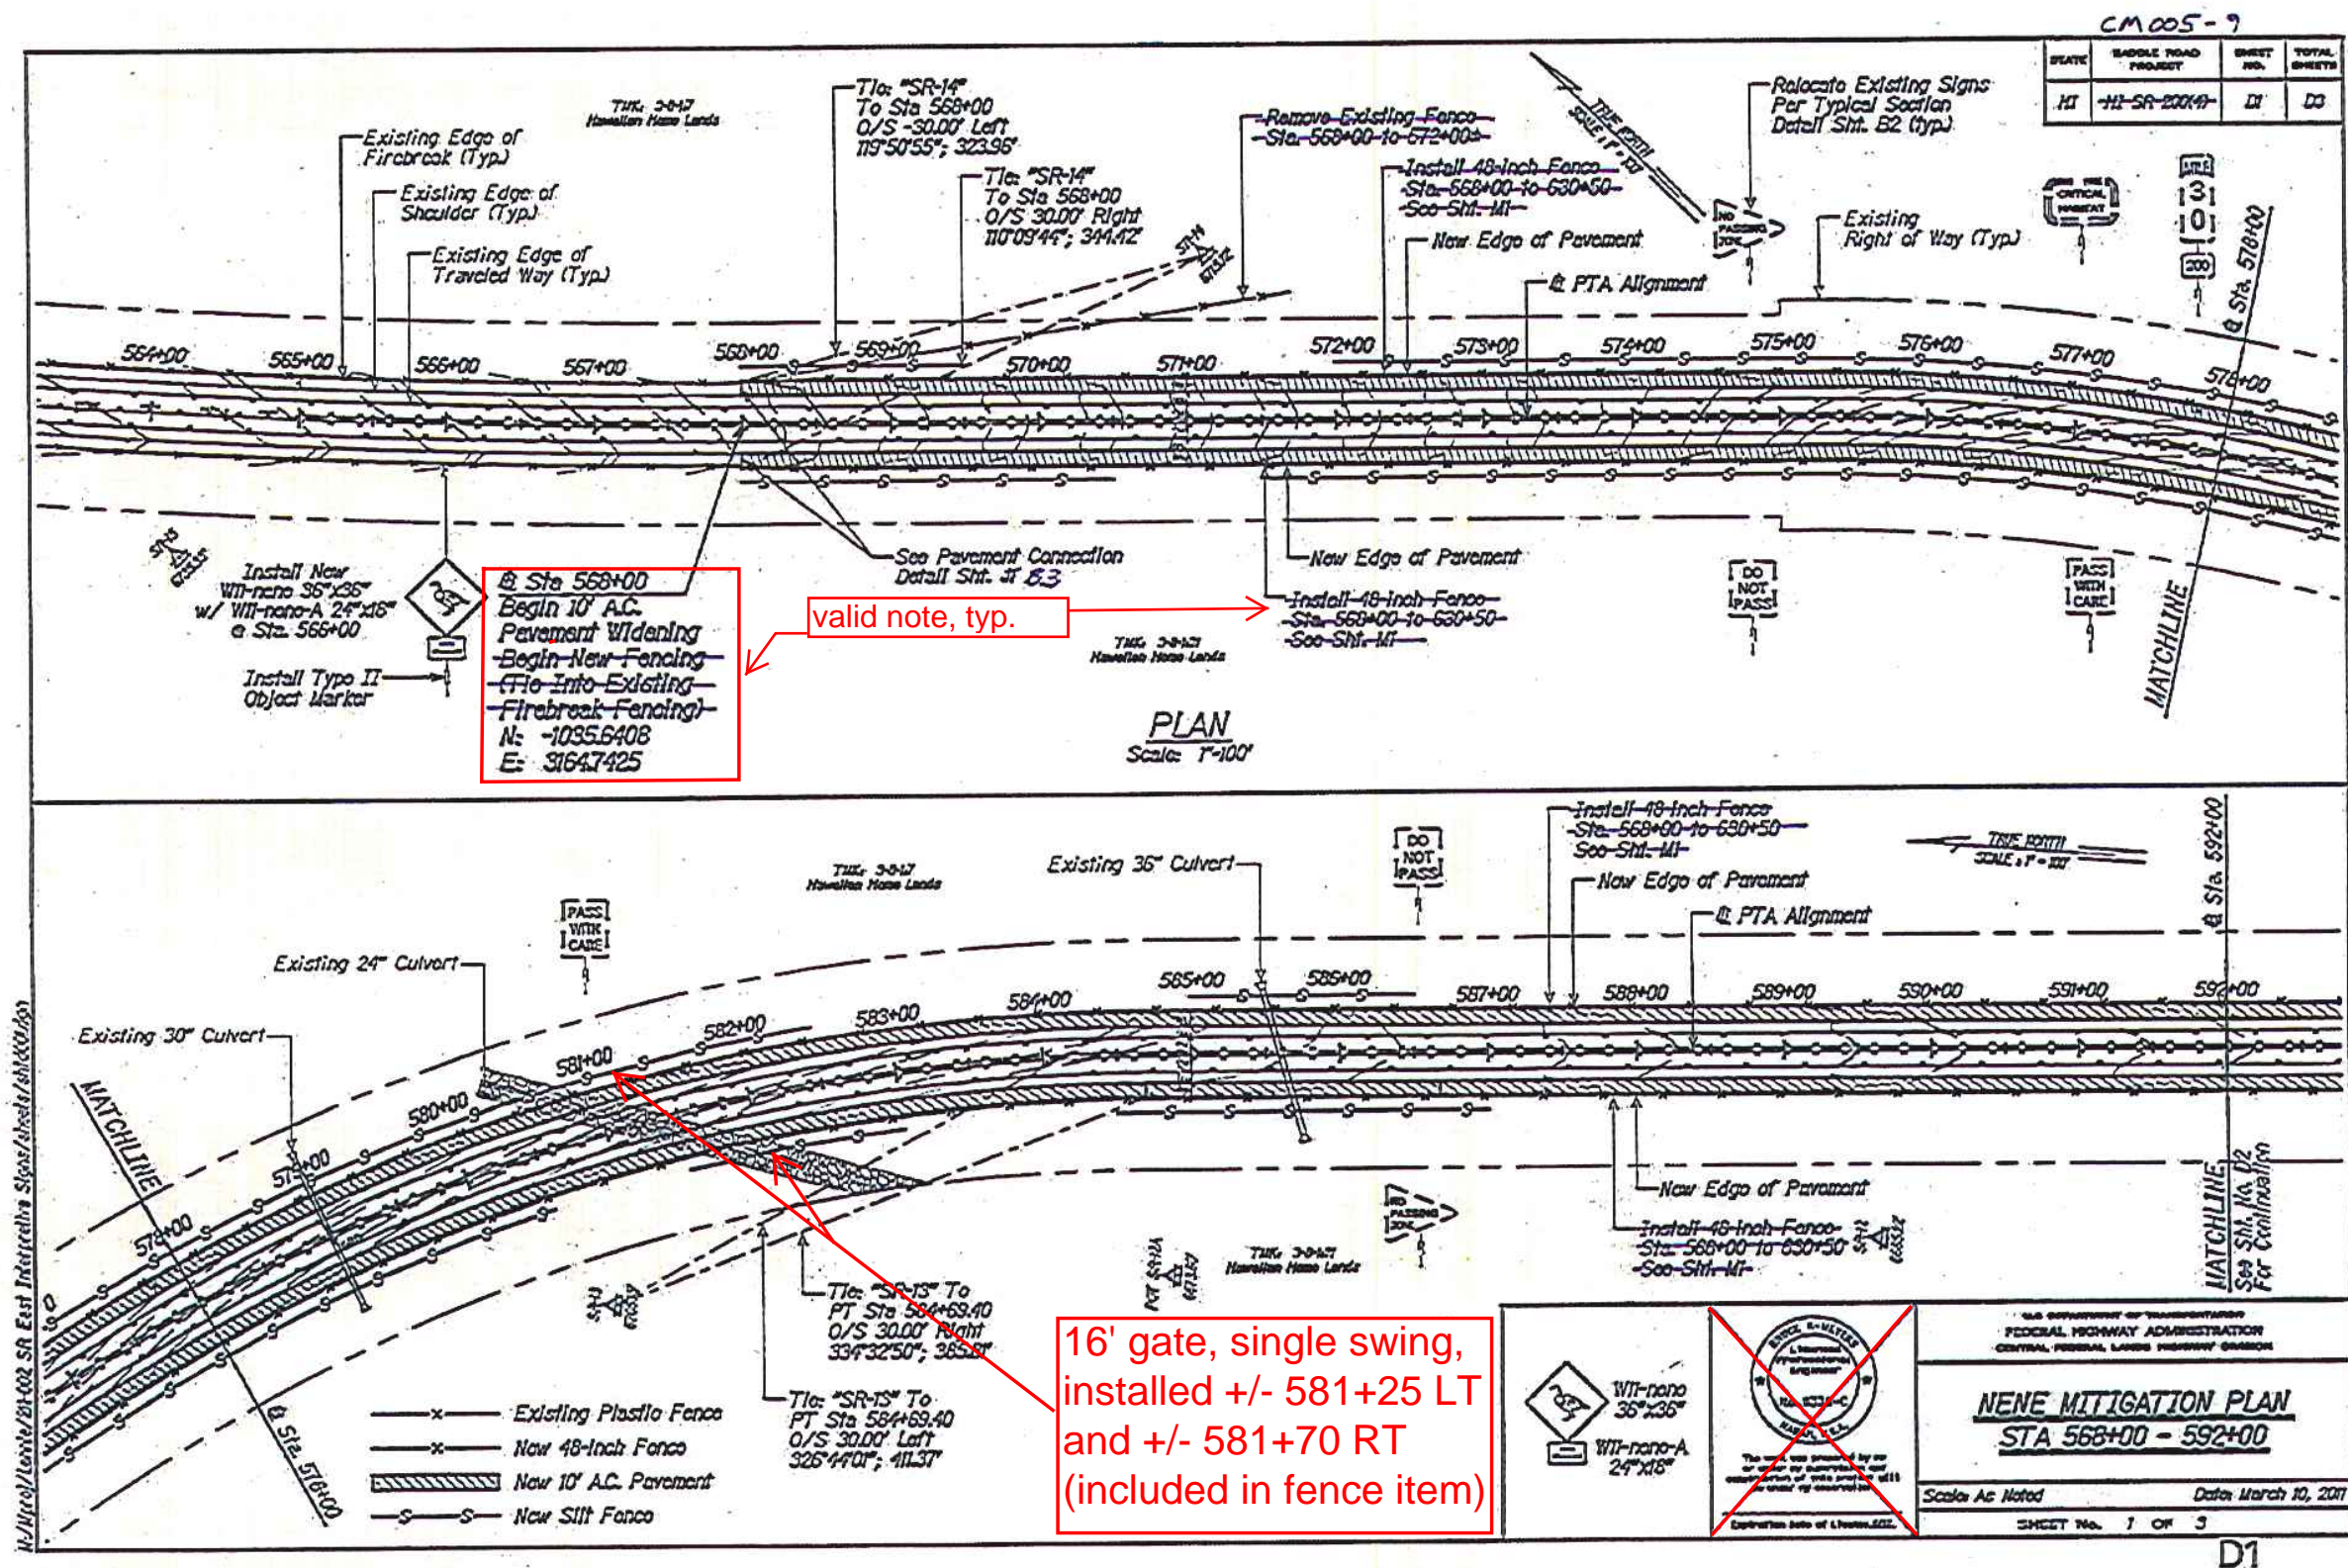

Comments relative to 48 inch and plastic fences are valid and should not be struck out. Changes to stationing only.

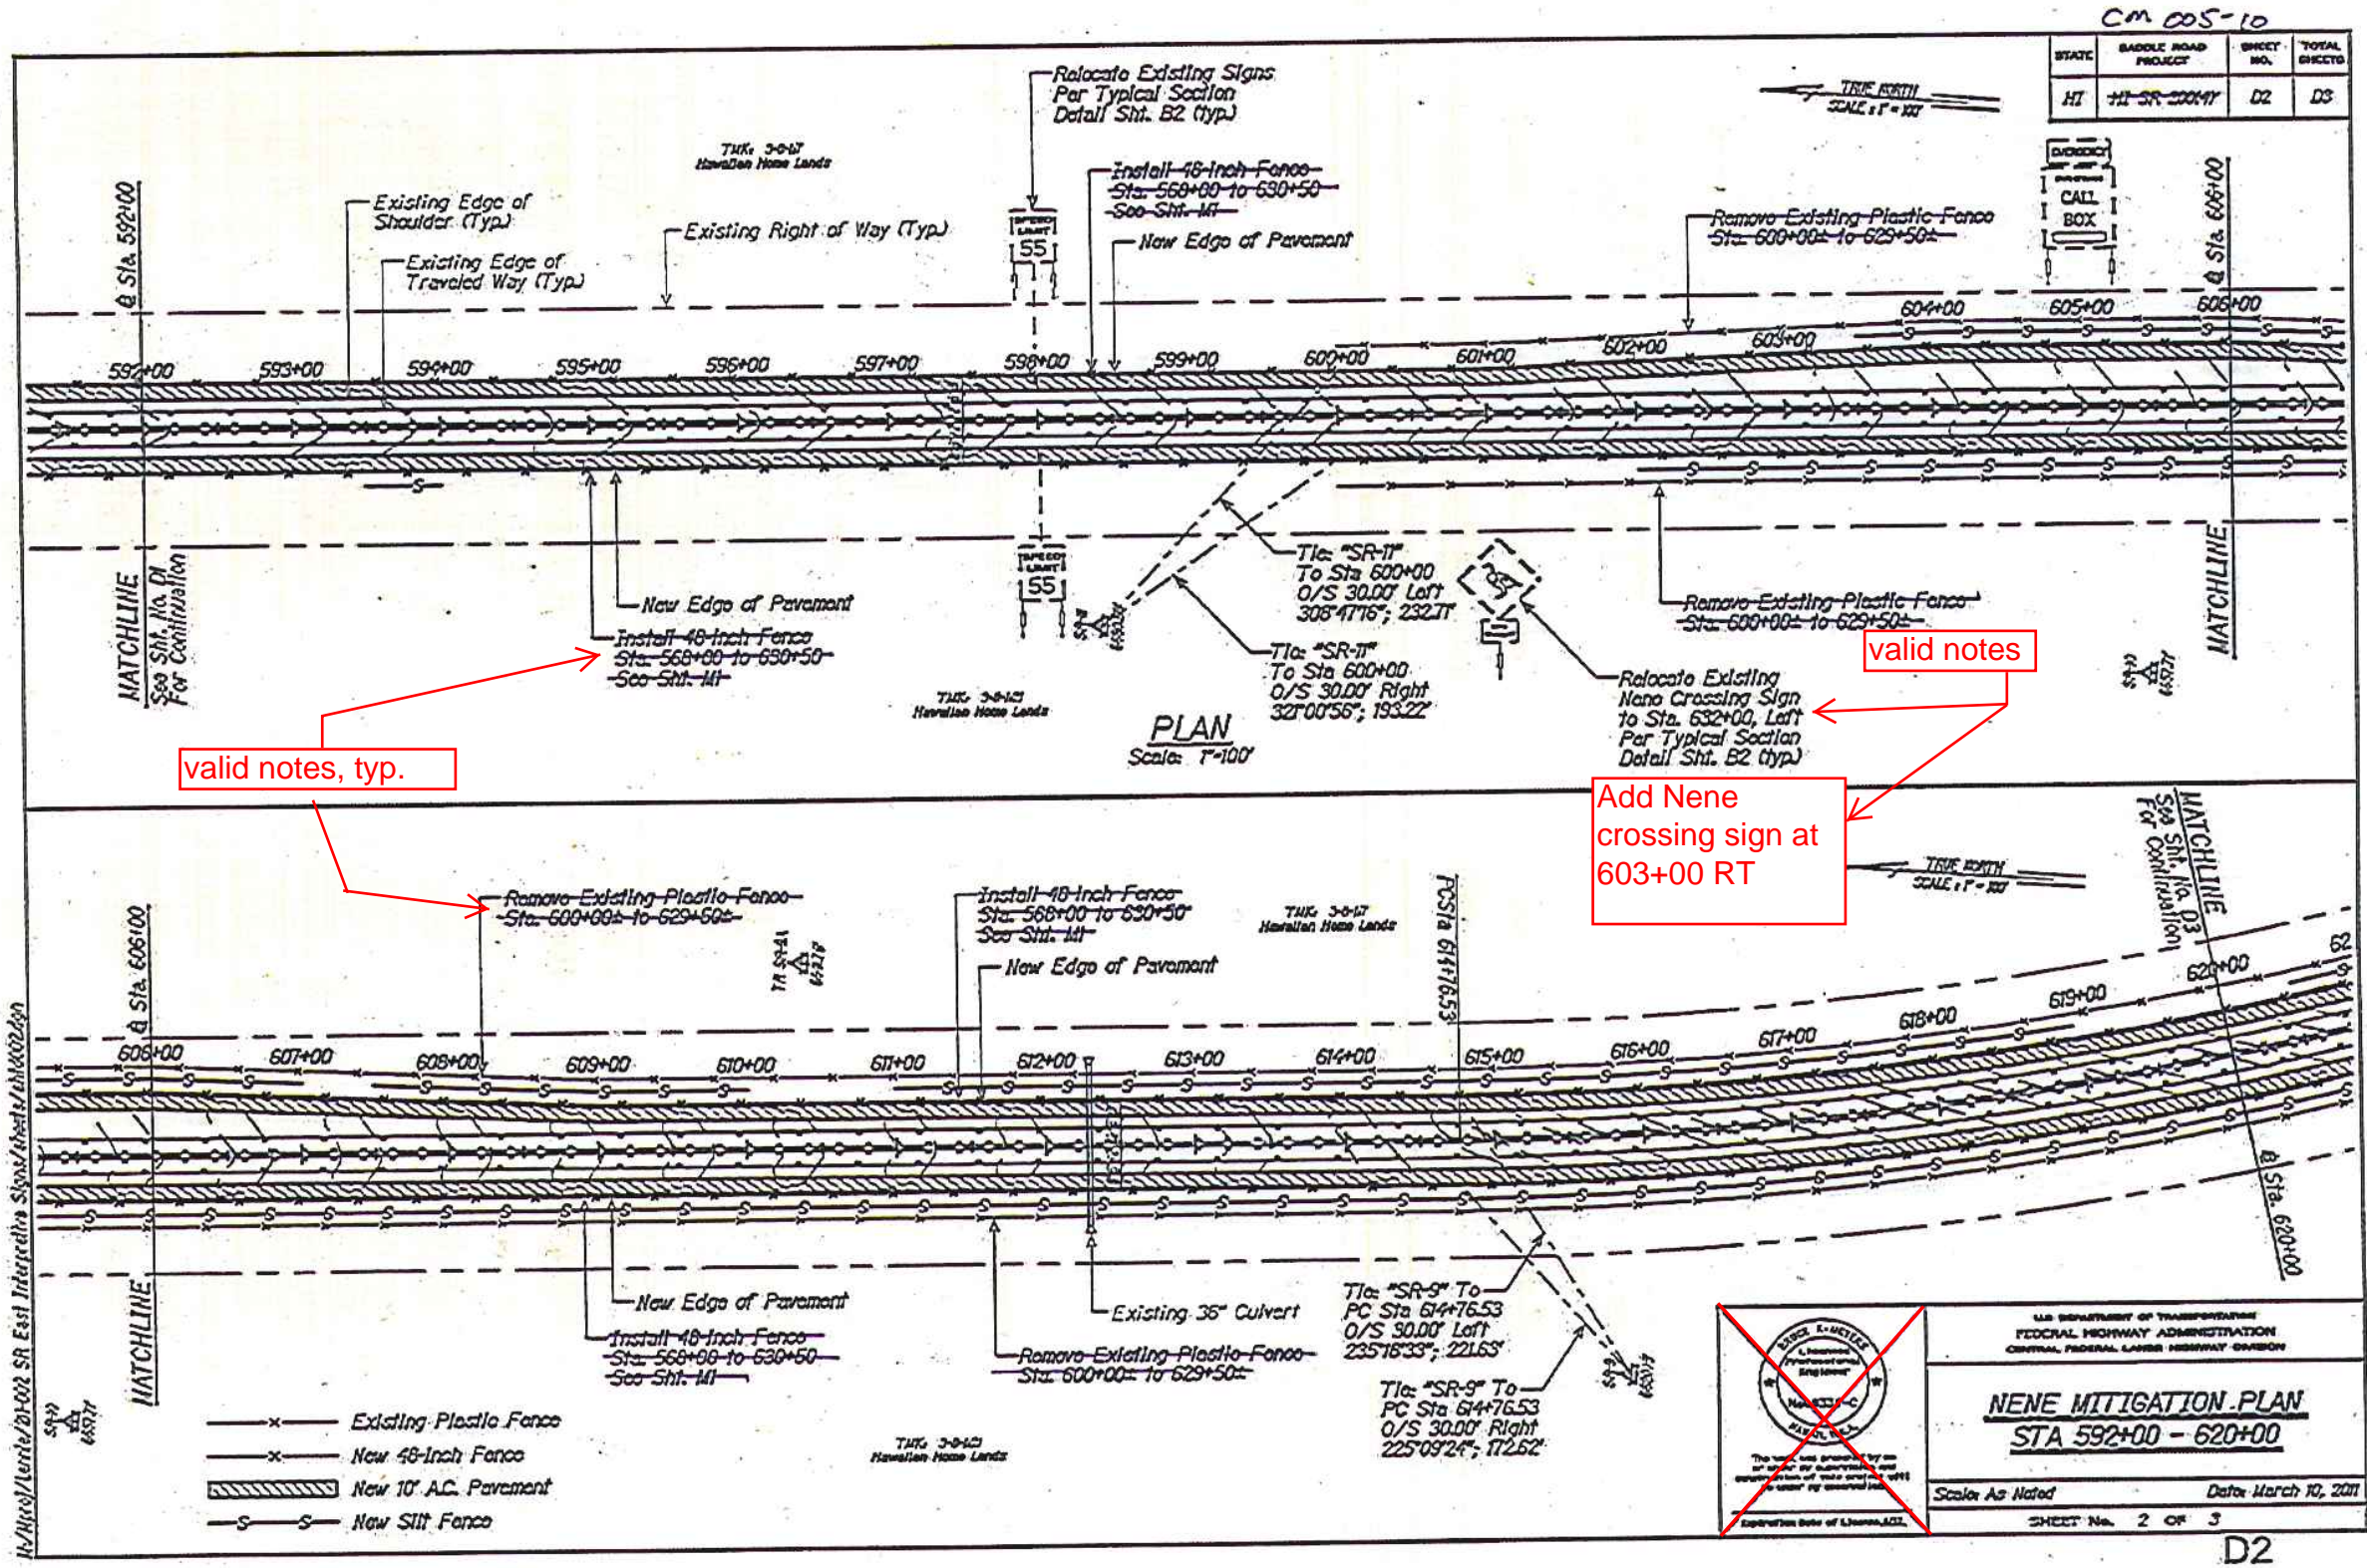



Comments relative to 48 inch and plastic fences are valid and should not be struck out. Changes to stationing only.

