


CM 005-5

STATE	ROUTE ROAD PROJECT	SHEET NO.	TOTAL SHEETS
HI	HI-SR-20049	B2	B3

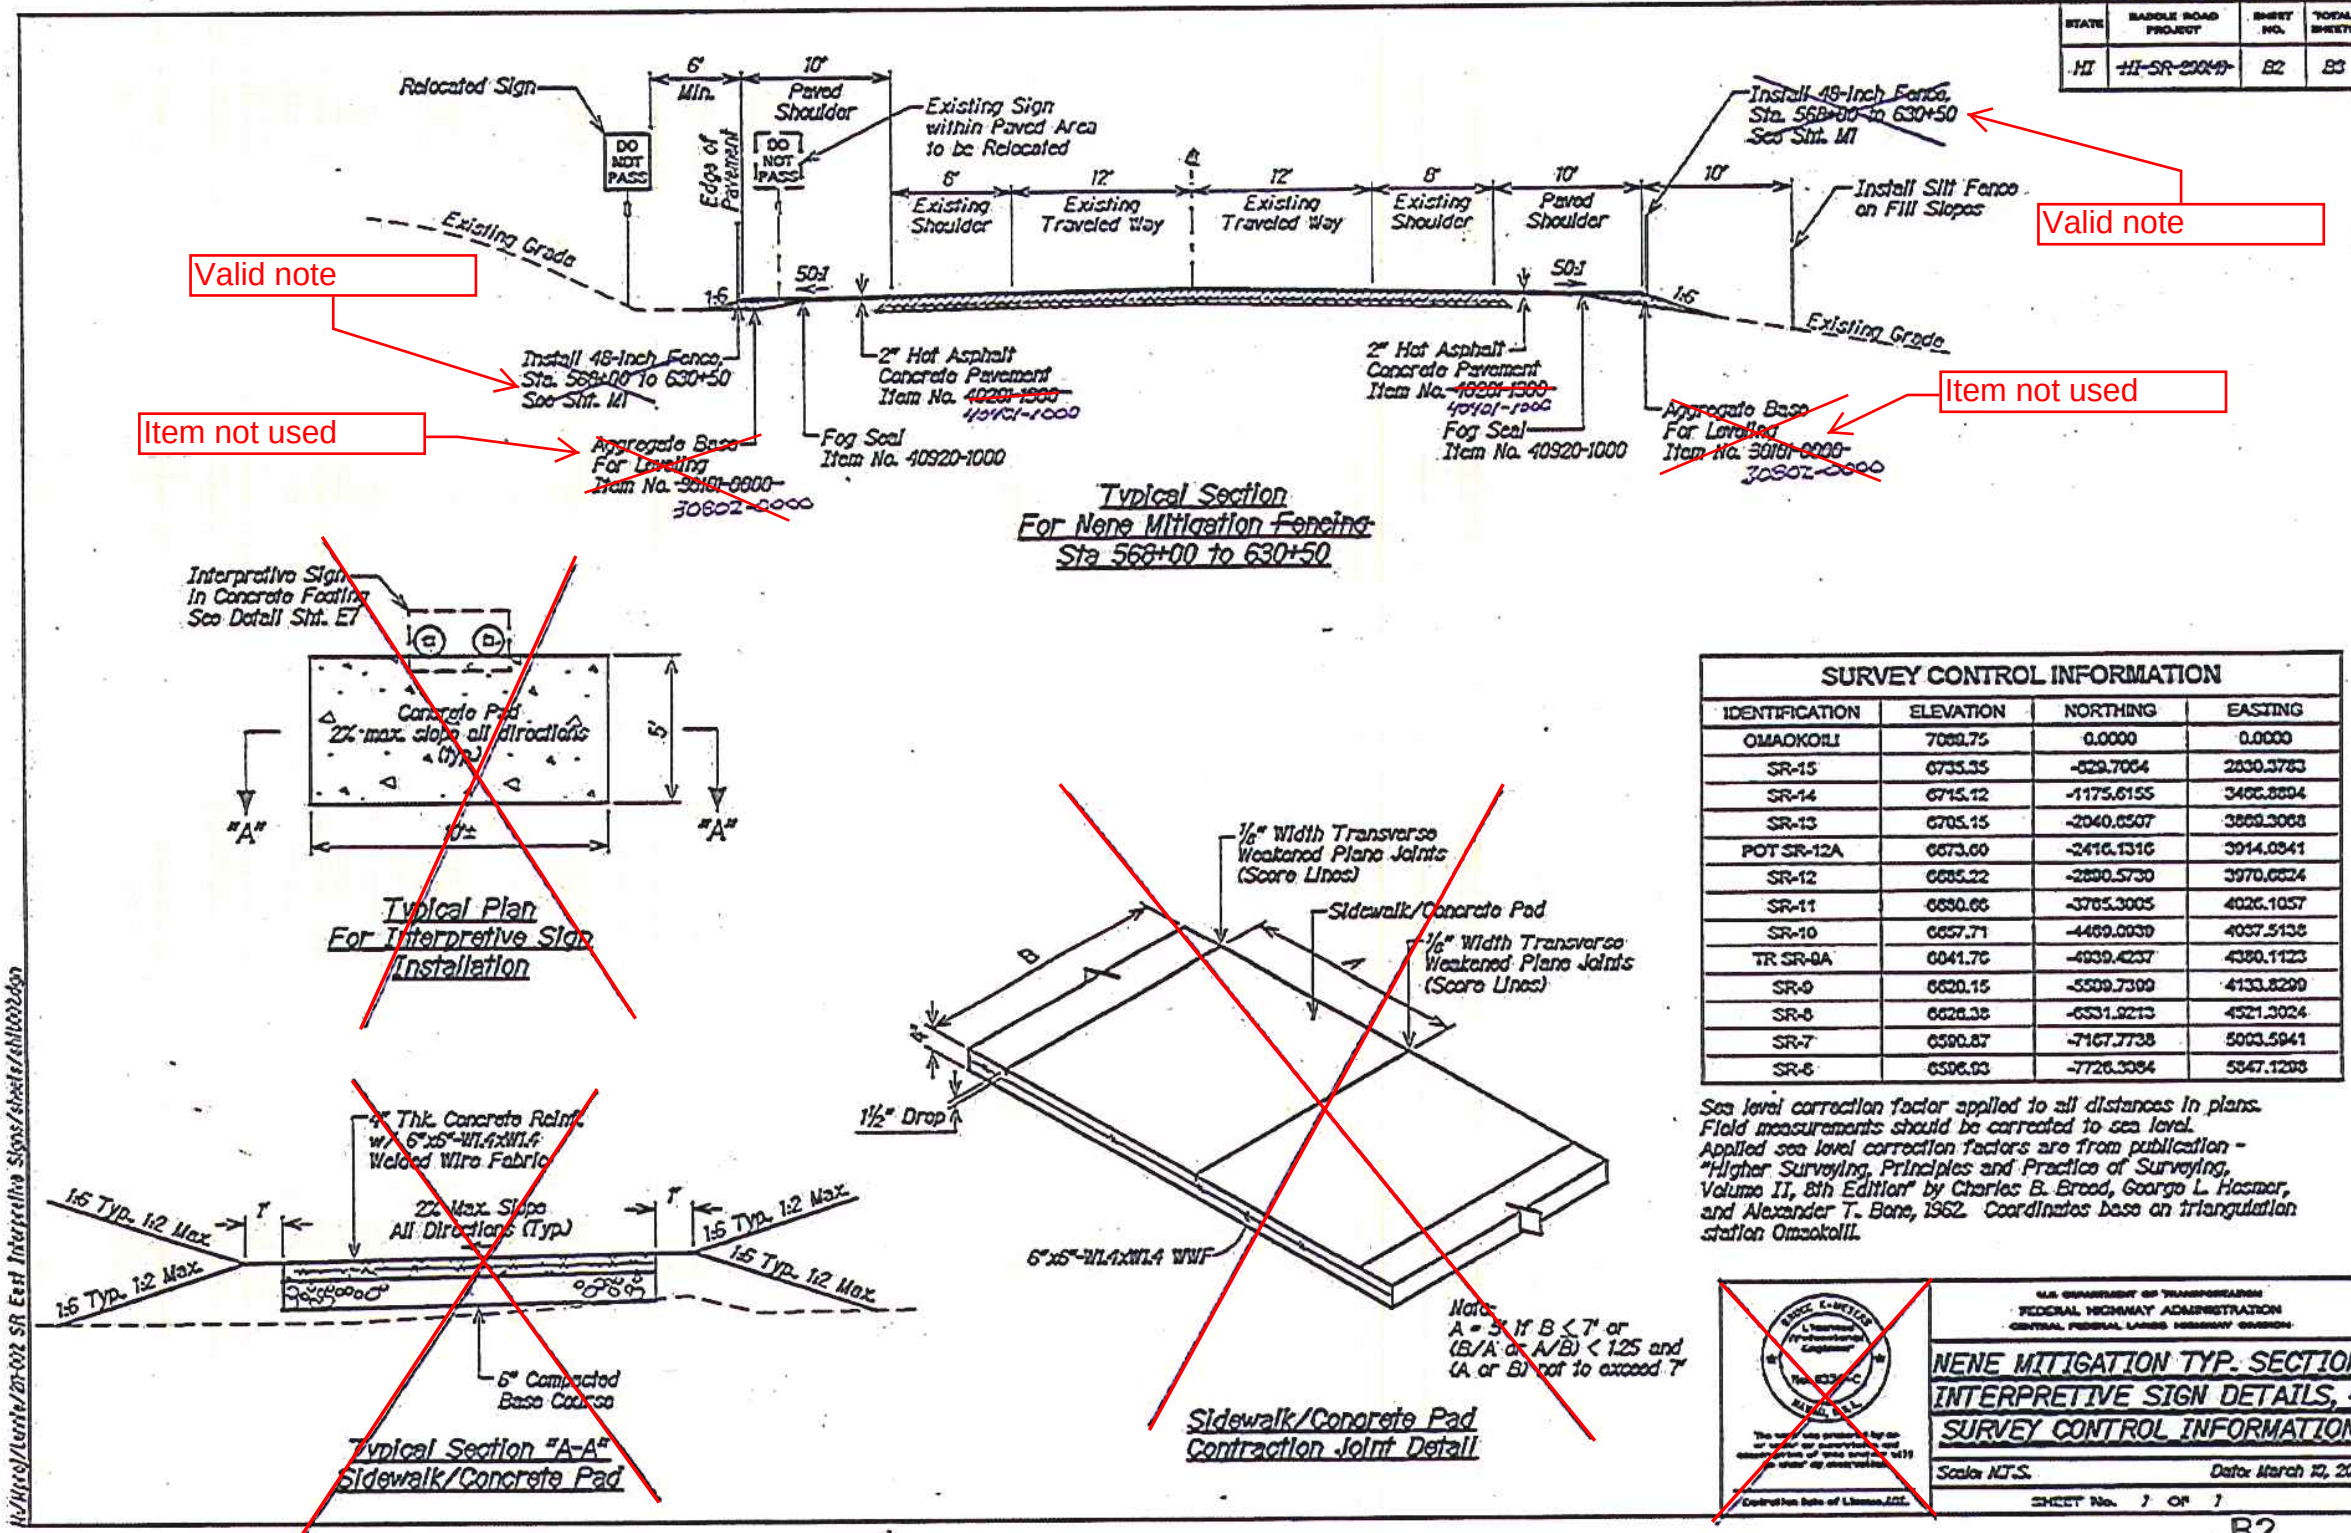

HI/Hwy/Route/20-002 SR East Interpretive Signs/Sheet/01/002/02/03