


CM 005-4

STATE	SADDLE ROAD PROJECT	SHEET NO.	TOTAL SHEETS
HI	HI-SR-20040	B1	B3

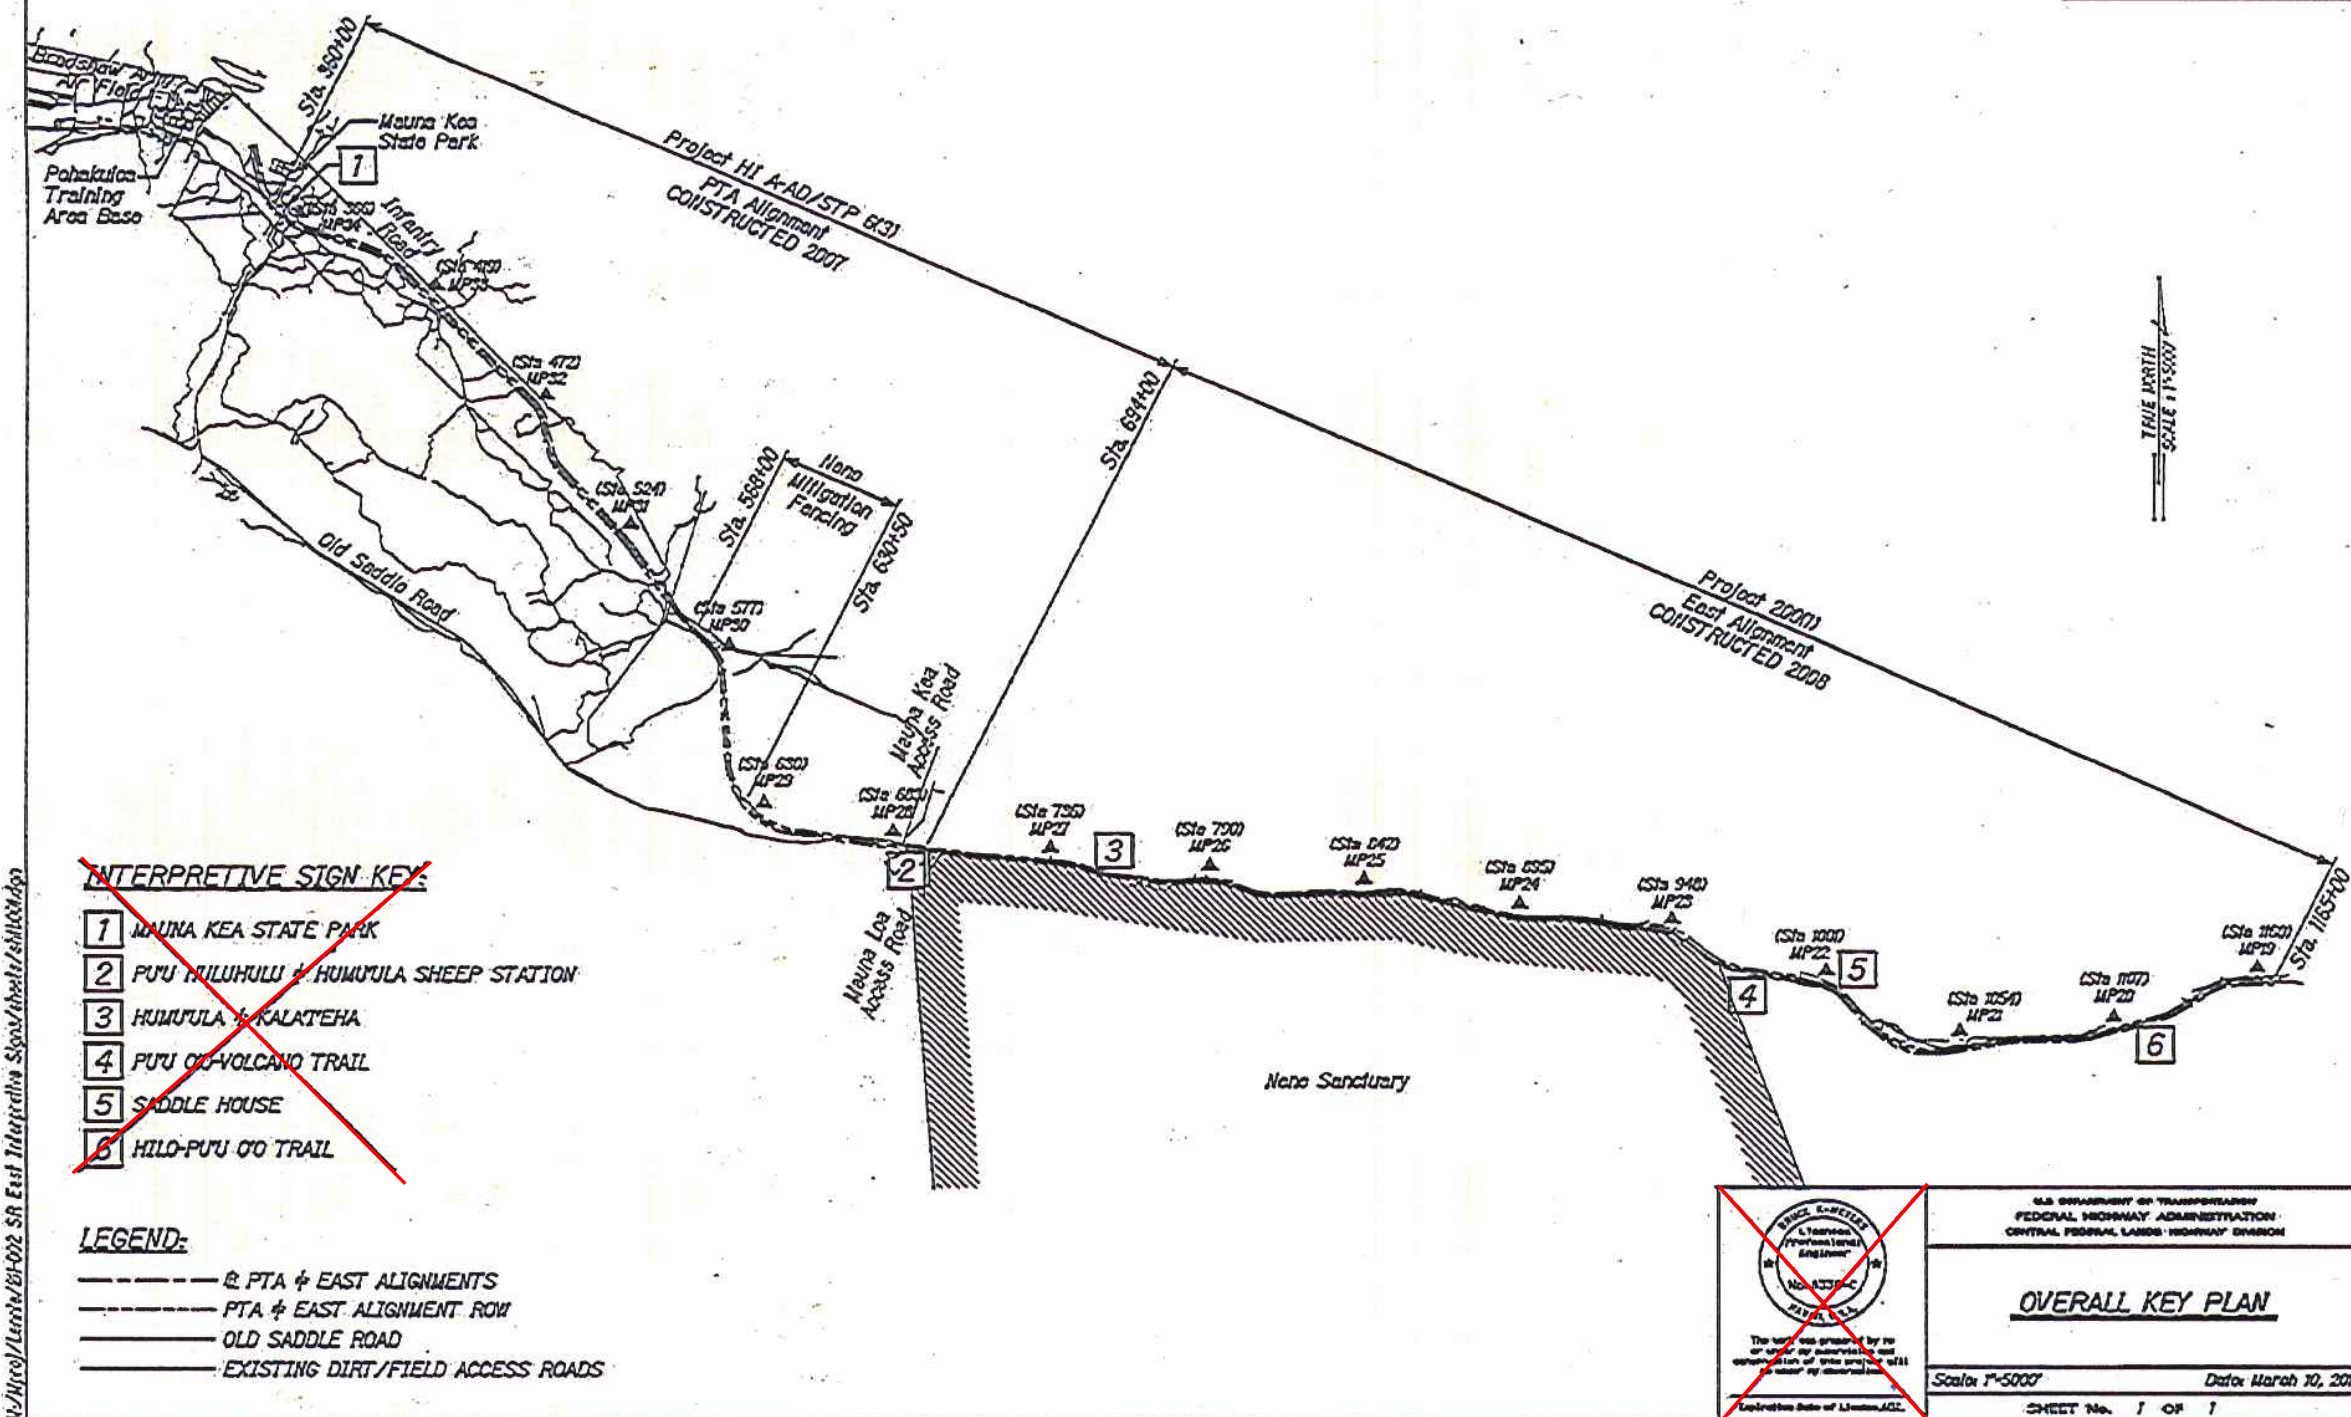

H:\Hiro\Units\B1-002 SR East Interpretive Signs\sheet\sh1004.dwg

- INTERPRETIVE SIGN KEY:**
- 1 MAUNA KEA STATE PARK
 - 2 PUU HULUHULU & HUMUHULA SHEEP STATION
 - 3 HUMUHULA & KALATEHA
 - 4 PUU OO-VOLCANO TRAIL
 - 5 SADDLE HOUSE
 - 6 HILO-PUU OO TRAIL
- LEGEND:**
- PTA & EAST ALIGNMENTS
 - PTA & EAST ALIGNMENT ROW
 - OLD SADDLE ROAD
 - EXISTING DIRT/FIELD ACCESS ROADS



U.S. DEPARTMENT OF TRANSPORTATION
FEDERAL HIGHWAY ADMINISTRATION
CENTRAL FEDERAL LANDS HIGHWAY DIVISION

OVERALL KEY PLAN

Scale: 1"=5000' Date: March 10, 2011

SHEET No. 1 OF 1

B1