



STATE	SADDLE ROAD PROJECT	SWEET NO.	TOT SWEET
HI	HI-SR-2004-1	BS	BS

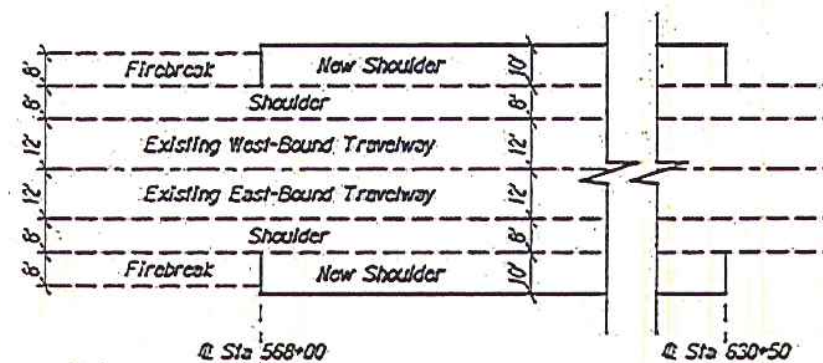

Pavement Transition Detail
For Noise Mitigation

41302, Asphalt pavement milling,
2-inch depth (in lieu of sawcut)

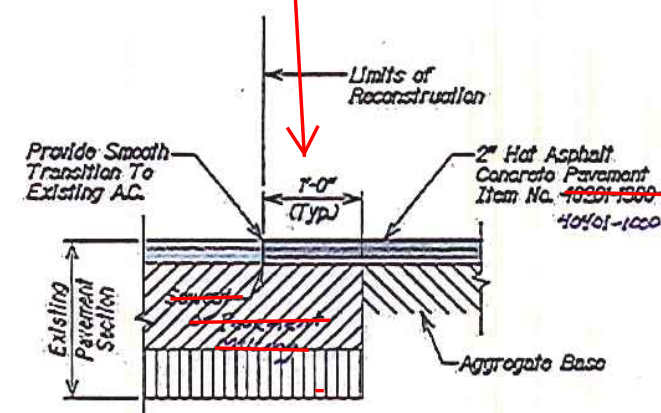

Connection To Existing
A.C. Pavement Detail



U.S. DEPARTMENT OF TRANSPORTATION
FEDERAL HIGHWAY ADMINISTRATION
CENTRAL FEDERAL LANDS HIGHWAY DIVISION

PAVEMENT TRANSITION
& CONNECTION

Scale: N.T.S.

Date: March 10, 2011

SHEET No. 1 OF 1