


FED. ROAD DIST. NO.	STATE	FED. AID PROJ. NO.	FISCAL YEAR	SHEET NO.	TOTAL SHEETS
HAWAII	HAW.	220A-02-72	1972	CO.205-1	20

Sta. 7+24

Install 2'-24" Corr. Metal Pipe,
Sht. Thickness 0.079 inch or
2'-24" RCP Class III or 2'-24" ACP
Class III w/2 CRM Headwalls.
Total Length 80 Lin. Ft. Sht. No. 5
Construct Channel to Existing
Ditch as shown. See Sheet No. 6

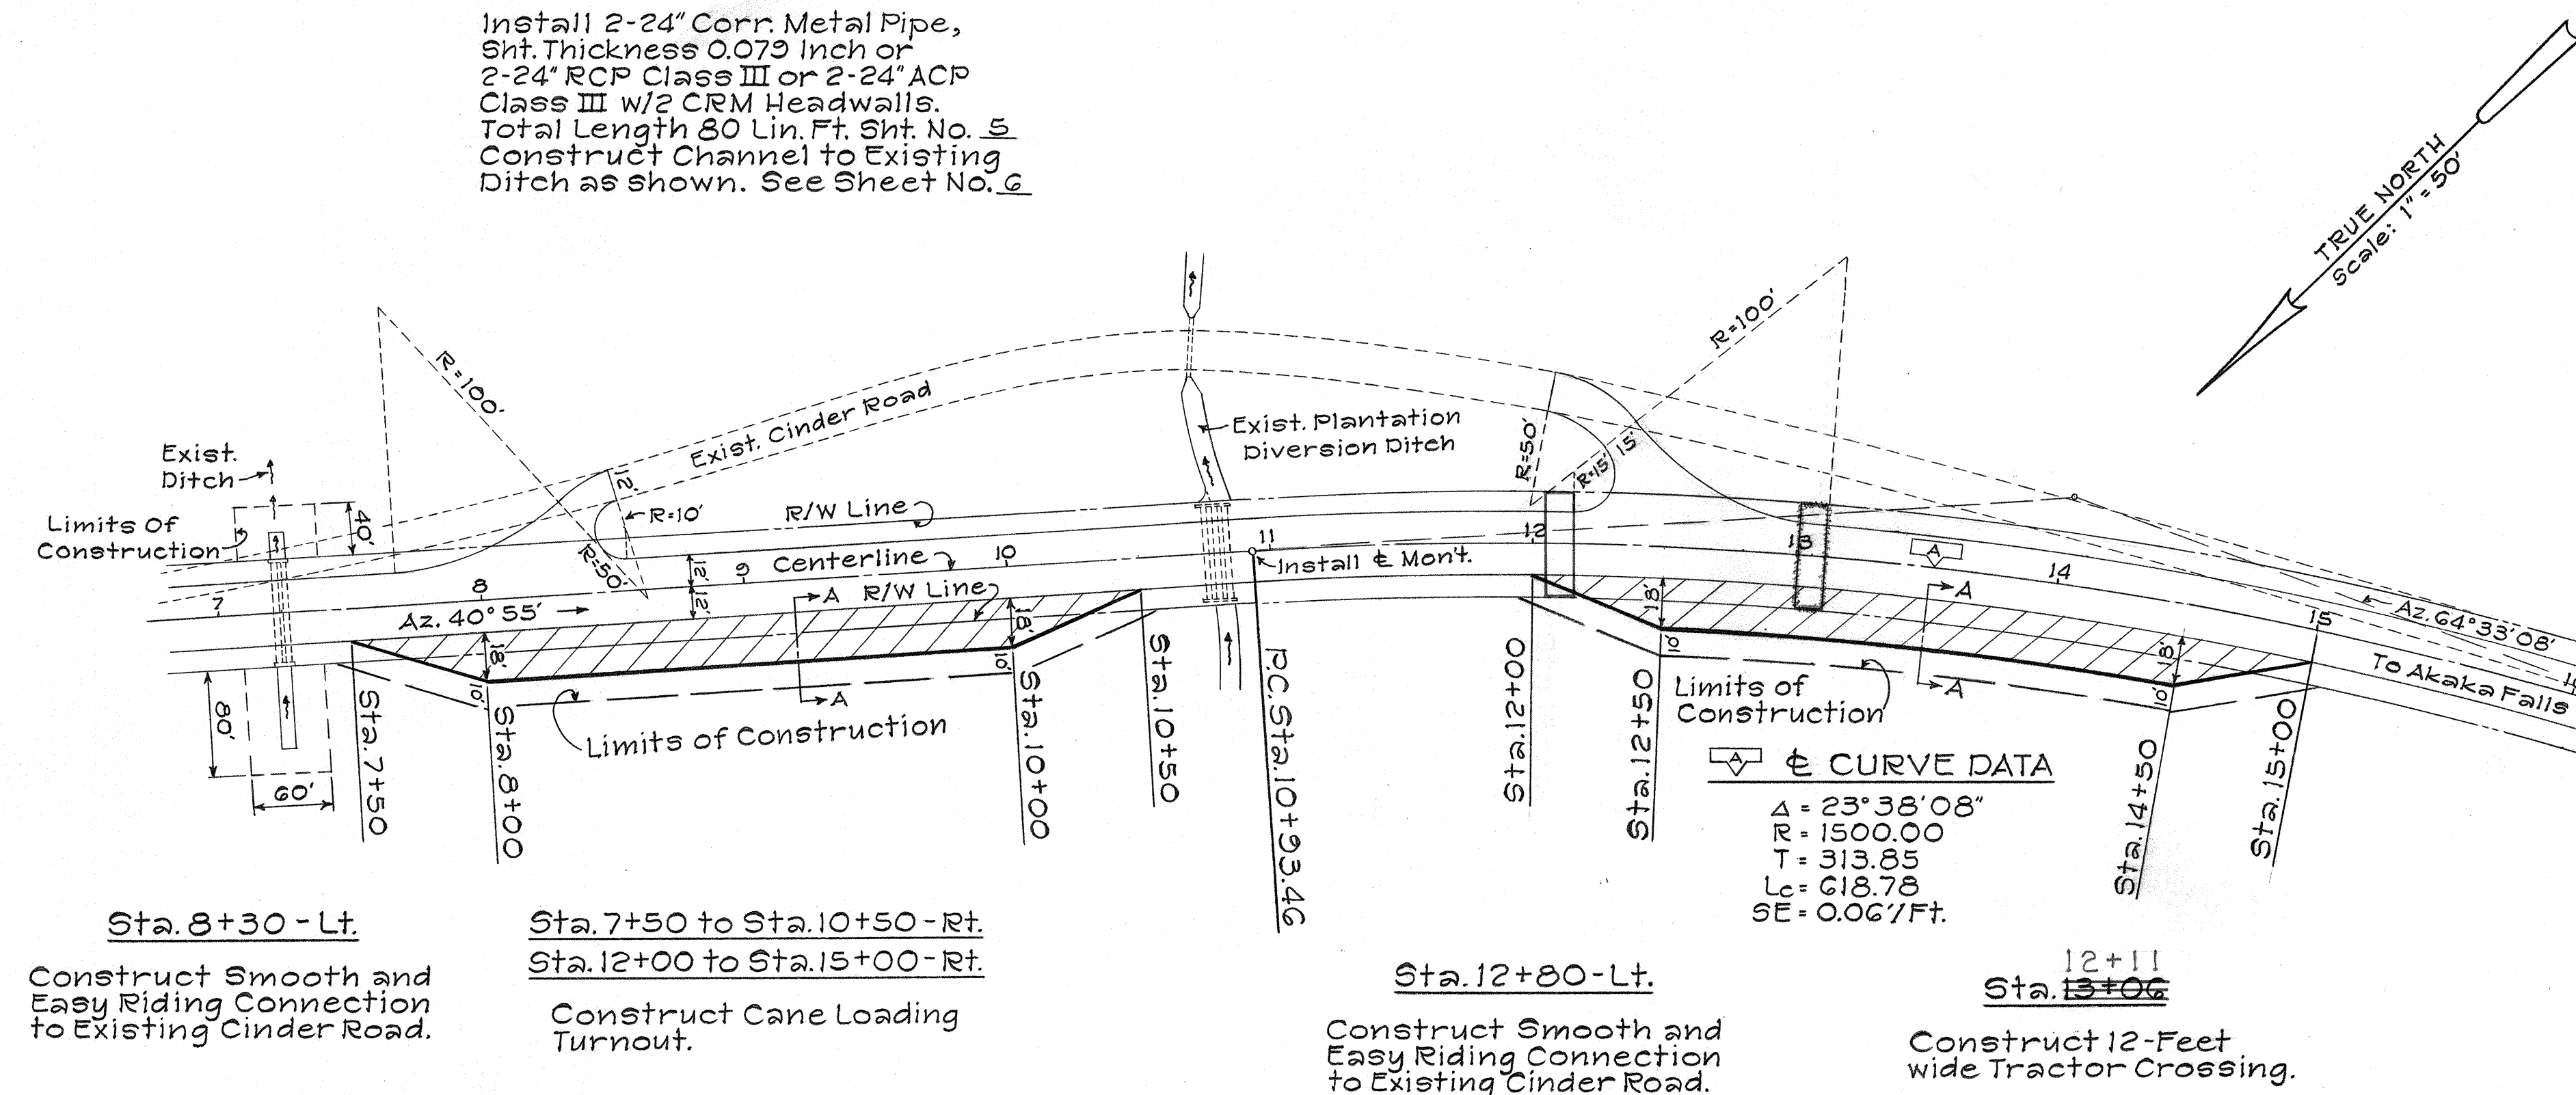

ESTIMATED QUANTITIES


Roadway Exc.....	310	C.Y.
Aggregate Subbase.....	420	C.Y.
MC-30 Prime Coat.....	70	Gal.
A.C. Pav't. Mix V.....	25	Ton

Sta. 10+82

Install ²~~2~~-36-inch x 22-inch
Corr. Metal Pipe-Arch
Sheet Thickness 0.079 inch
Total Length 120 Lin. Ft.
See Sheet No. 5

PLAN
Scale: 1" = 50'

Scale: 1" = 50'

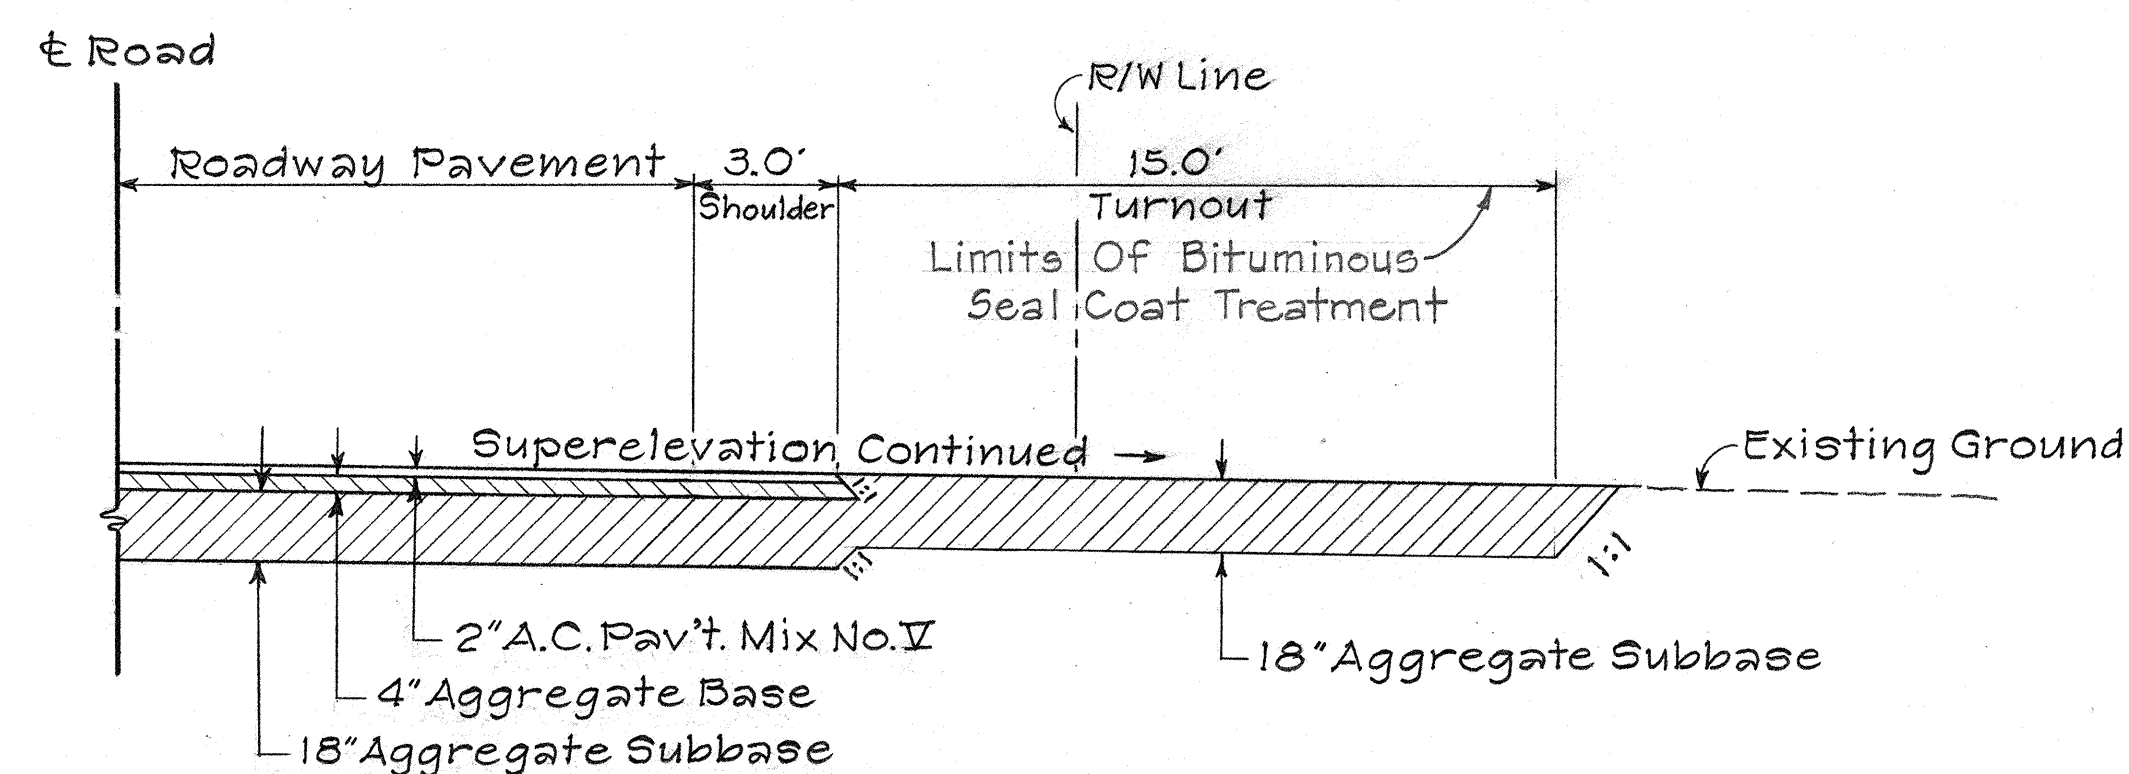

SECTION A-A
Scale: 1/4" = 1'-0"

Scale: $1/4" = 1' - 0"$

Contract Change Order No. 1

THIS SHEET IS A SUPPLEMENT
TO THE CONTRACT PLANS

**STATE OF HAWAII
DEPARTMENT OF TRANSPORTATION
HIGHWAYS DIVISION**

PLAN
FOR

AKAKA FALLS ROAD

PROJECT No. 220A-02-72
SOUTH HILO, HAWAII

Scale: As Noted Date: Jan., 1973

SHEET No. 1 OF 1 SHEETS

C.O. 20 S-1