

INDEX TO DRAWINGS	
SHEET NO.	DESCRIPTION
1	TITLE SHEET
2	TYPICAL SECTION
3-4	PLAN & PROFILE
5	DRAINAGE
6-16	MISCELLANEOUS AND STANDARD DETAILS
17-19	CROSS SECTION
C.O. 20 S-1	CONTRACT CHANGE ORDER *1

STATE OF HAWAII

DEPARTMENT OF TRANSPORTATION

HIGHWAYS DIVISION

"AS BUILT"

PLANS FOR

THE CONSTRUCTION OF



AKAKA FALLS ROAD

PROJECT NO. 220A-02-72

DISTRICT OF SOUTH HILO

ISLAND OF HAWAII

STATE	PROJECT NO.	FISCAL YEAR	SHEET NO.	TOTAL SHEETS
HAWAII	220A-02-72	1972	1	19

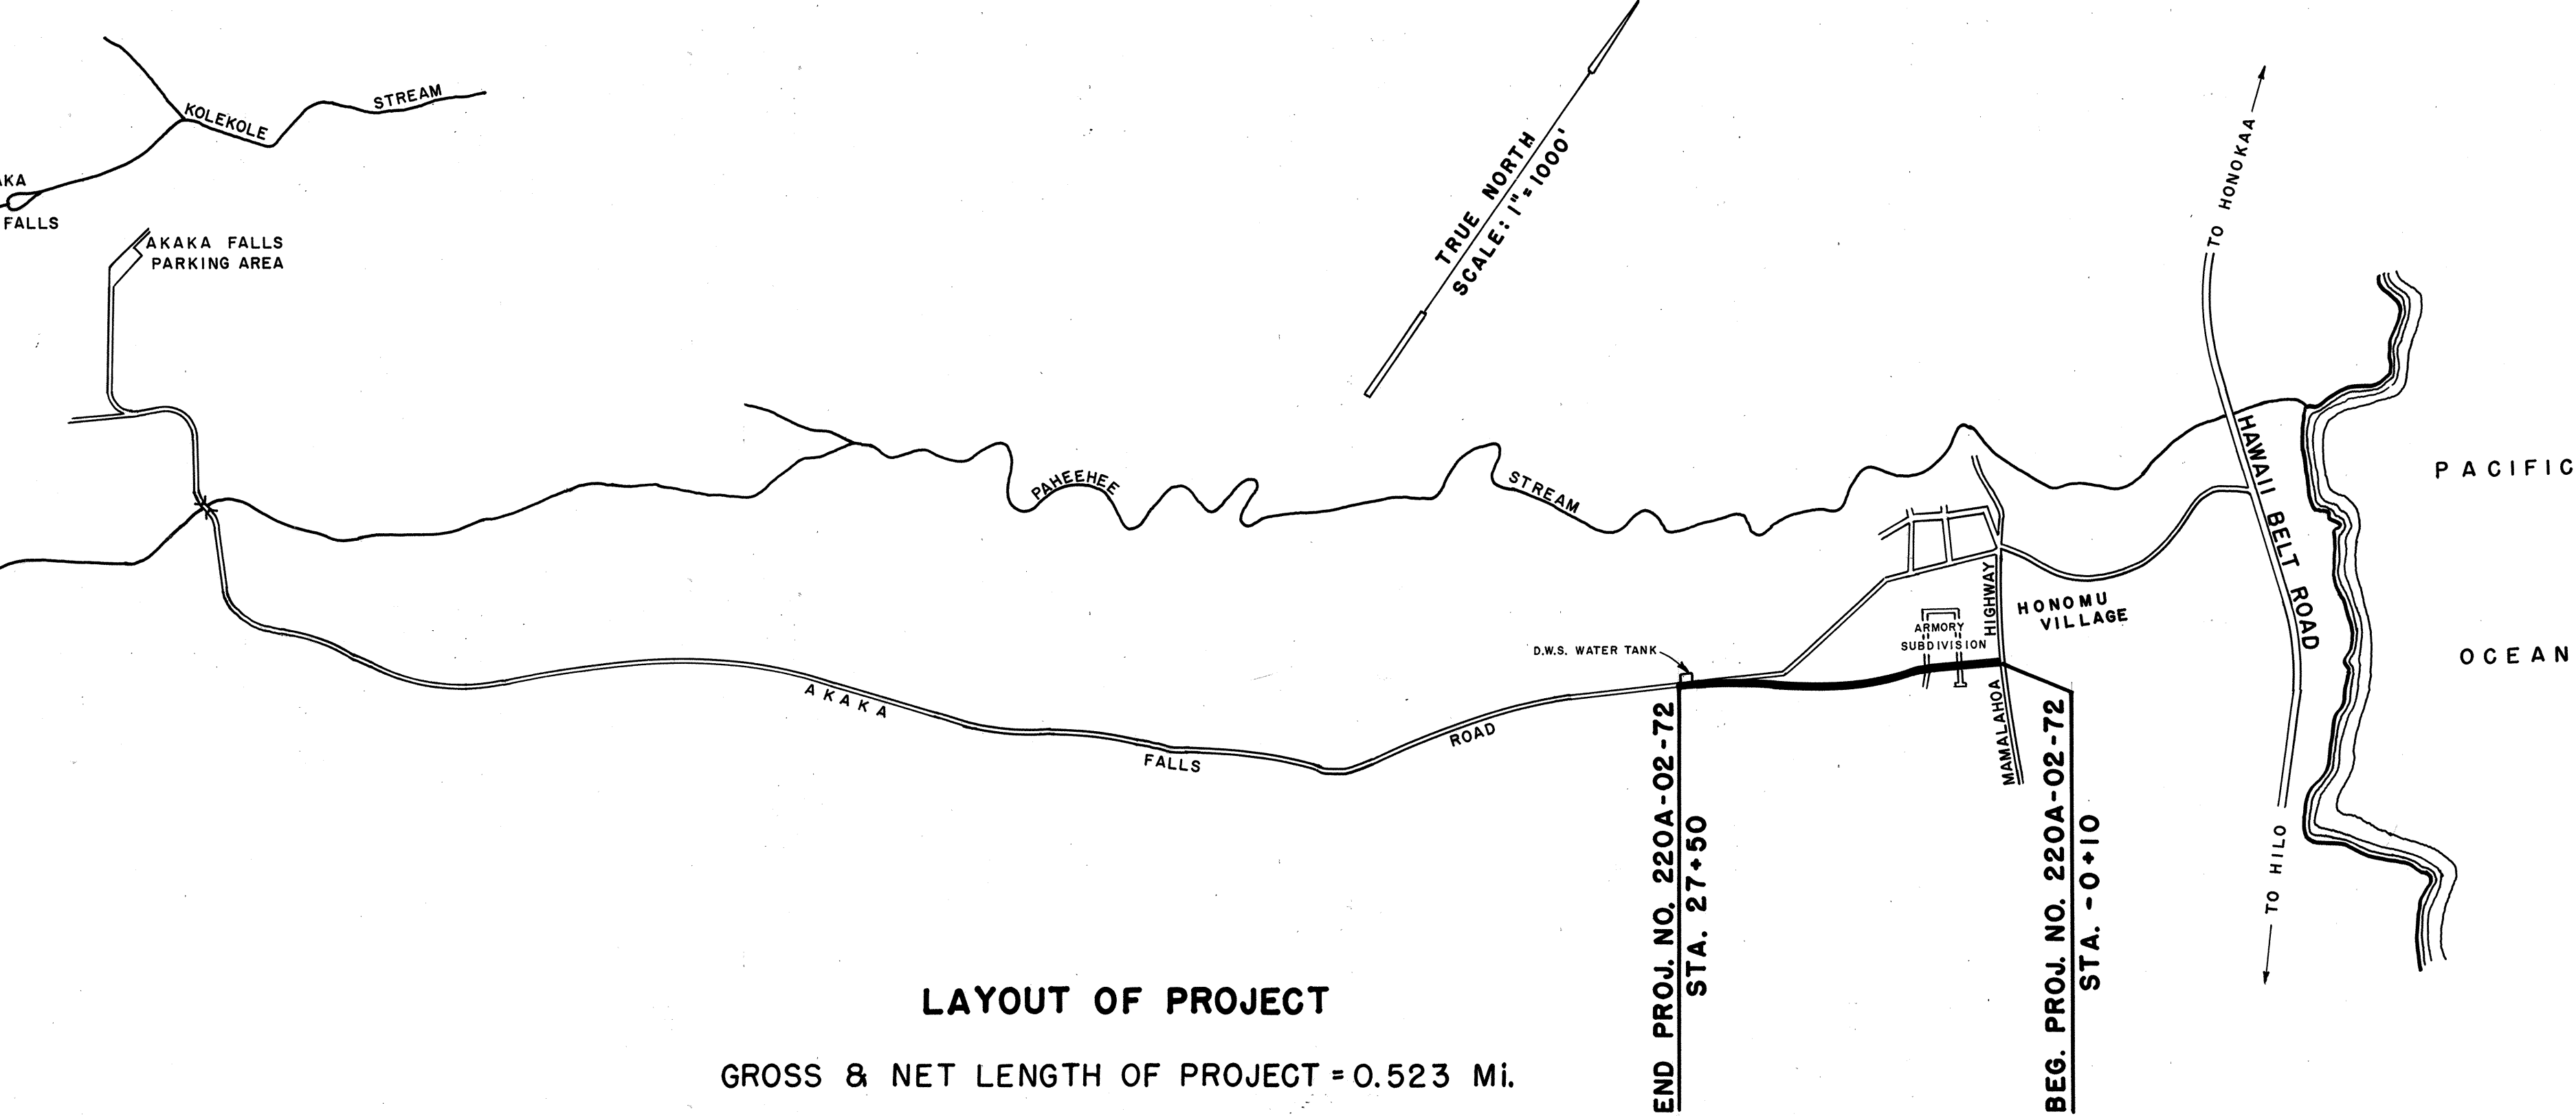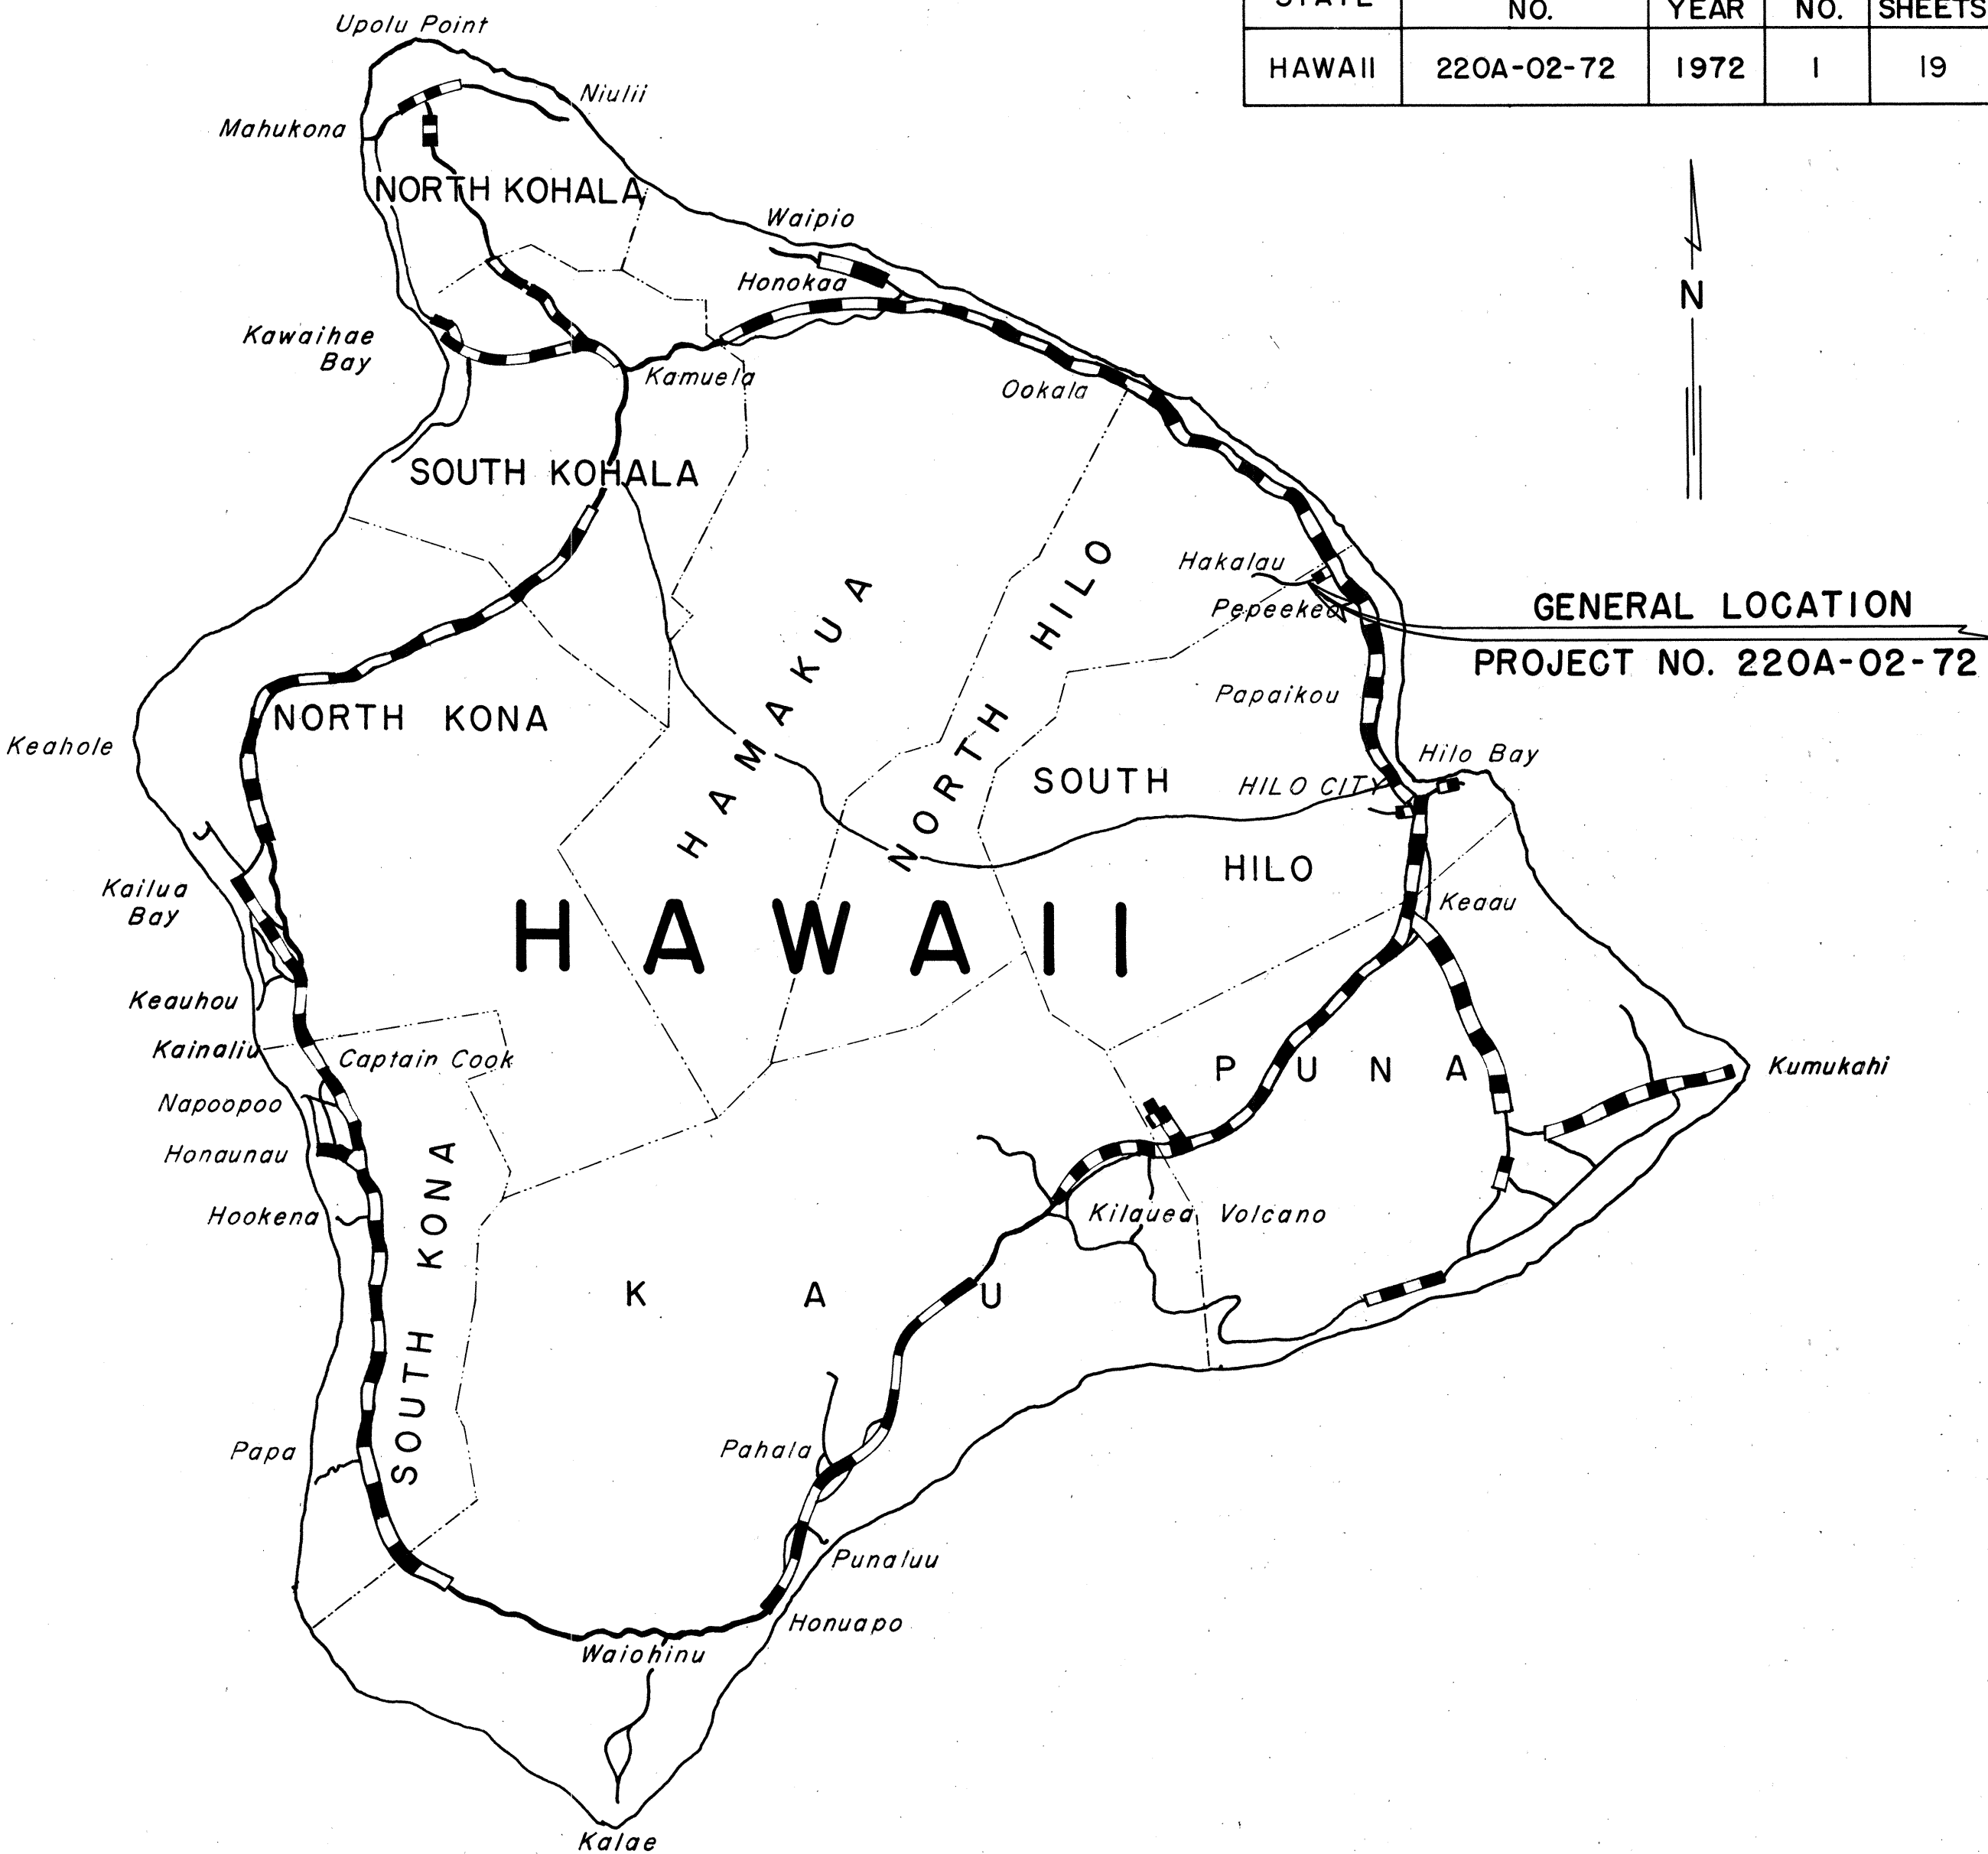

Federal Aid Projects Previously Constructed Or Under Construction

NOTE:

ALL CHANGES MADE DURING CONSTRUCTION HAVE BEEN INCORPORATED ON THESE PLANS IN RED EXCEPT CHANGES IN THE ORIGINAL THEORETICAL QUANTITIES.

Alan Matunda

RESIDENT ENGINEER

11-26-73

DATE

DEPARTMENT OF TRANSPORTATION STATE OF HAWAII	
APPROVED:	
<i>E. Alvey Knight</i>	11/27/72
for DIR. OF TRANSPORTATION	DATE

DESIGNED BY: COUNTY OF HAWAII

PS&E

RONALD E. TSUZUKI

548-2450

PHONE

DESIGN UNIT

NOV. 1972

DATE

LAYOUT OF PROJECT

GROSS & NET LENGTH OF PROJECT = 0.523 Mi.