· · · · · · · · · · · · · · · · · · ·	INDEX TO DRAWINGS
SHEET NO.	DESCRIPTION
l	TITLE SHEET
2	STANDARD PLANS SUMMARY
3-4	TYPICAL SECTIONS & DETAILS
5-7	ROADWAY AND STRIPING PLAN
8	MISCELLANEOUS SCHEDULES
9	CONSTRUCTION SIGN PLAN AND SCHEDULE
\$ *** \$ ***	

JULY, 1989 DATE

RICHARD TAKAESU 548-4125 P. S. & E. BY

> HAWAII DISTRICT DESIGNED BY

STATE OF HAWAII

## DEPARTMENT OF TRANSPORTATION


HIGHWAYS DIVISION
HONOLULU, HAWAII
"AS BUILT"
PLANS FOR


## AKAKA FALLS ROAD RESURFACING

HONOMU TOWN TO AKAKA FALLS

PROJECT NO. 220A-01-90M

DISTRICT OF SOUTH HILO

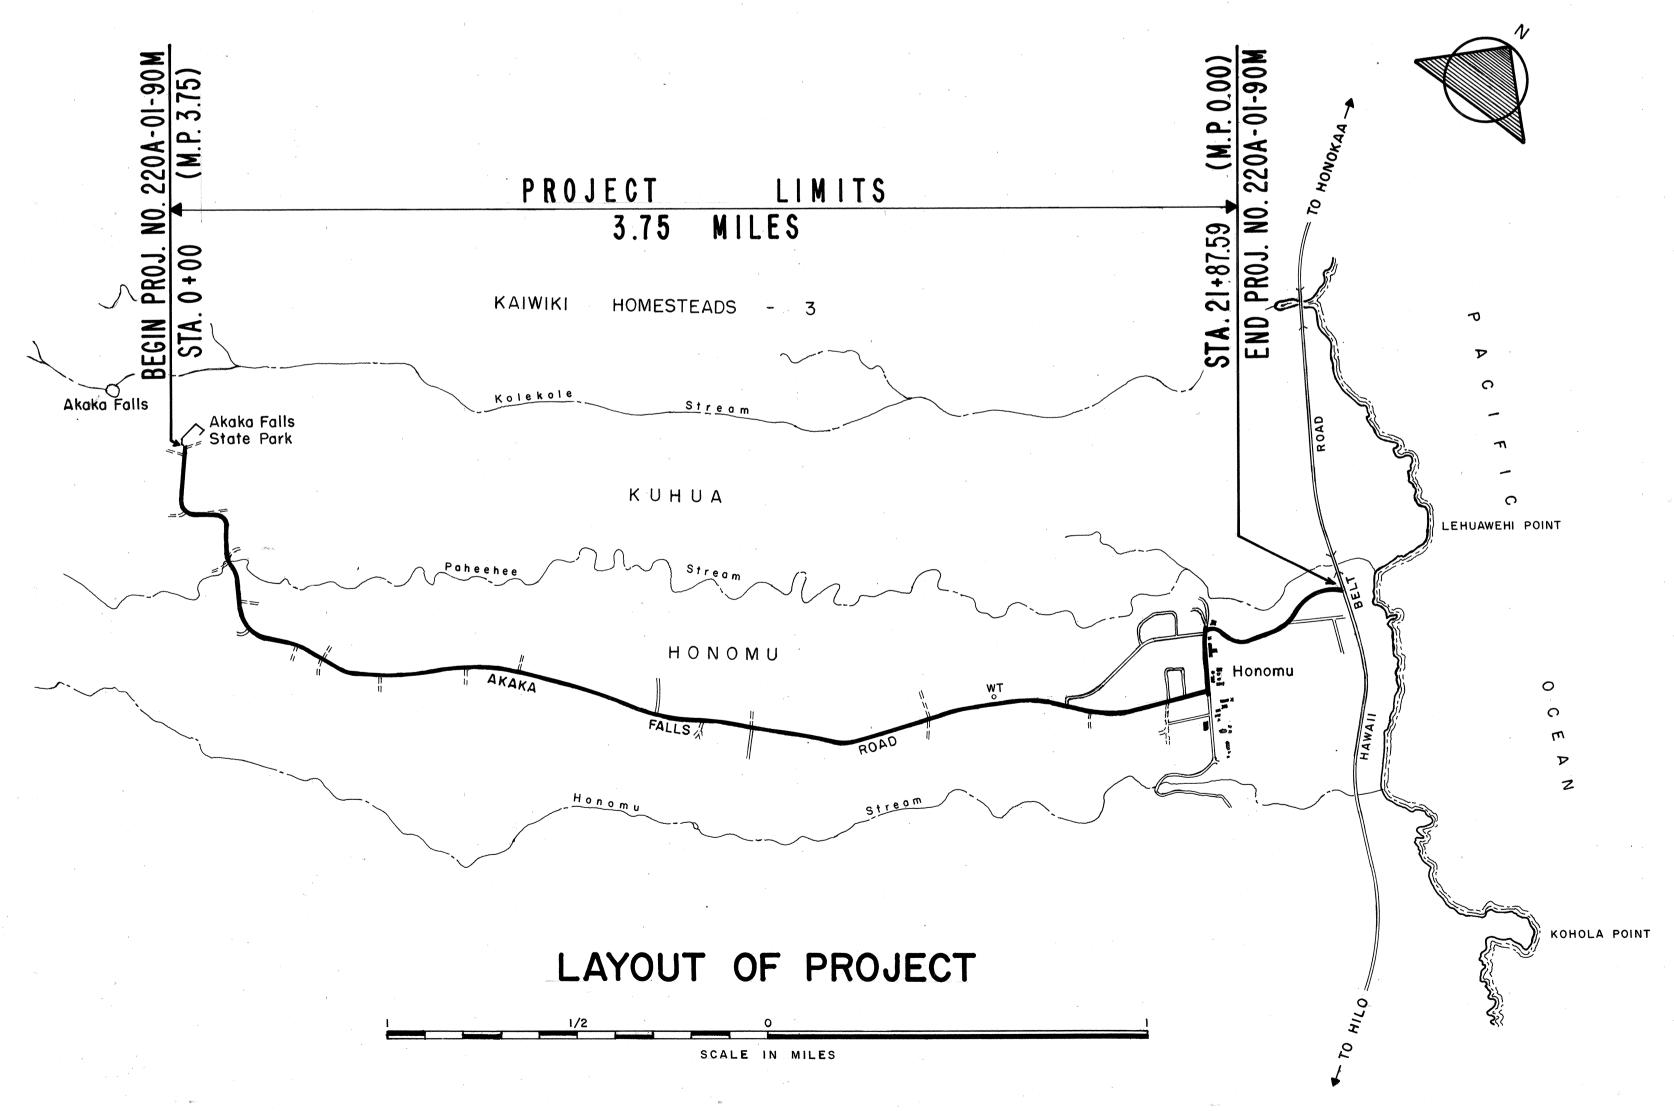

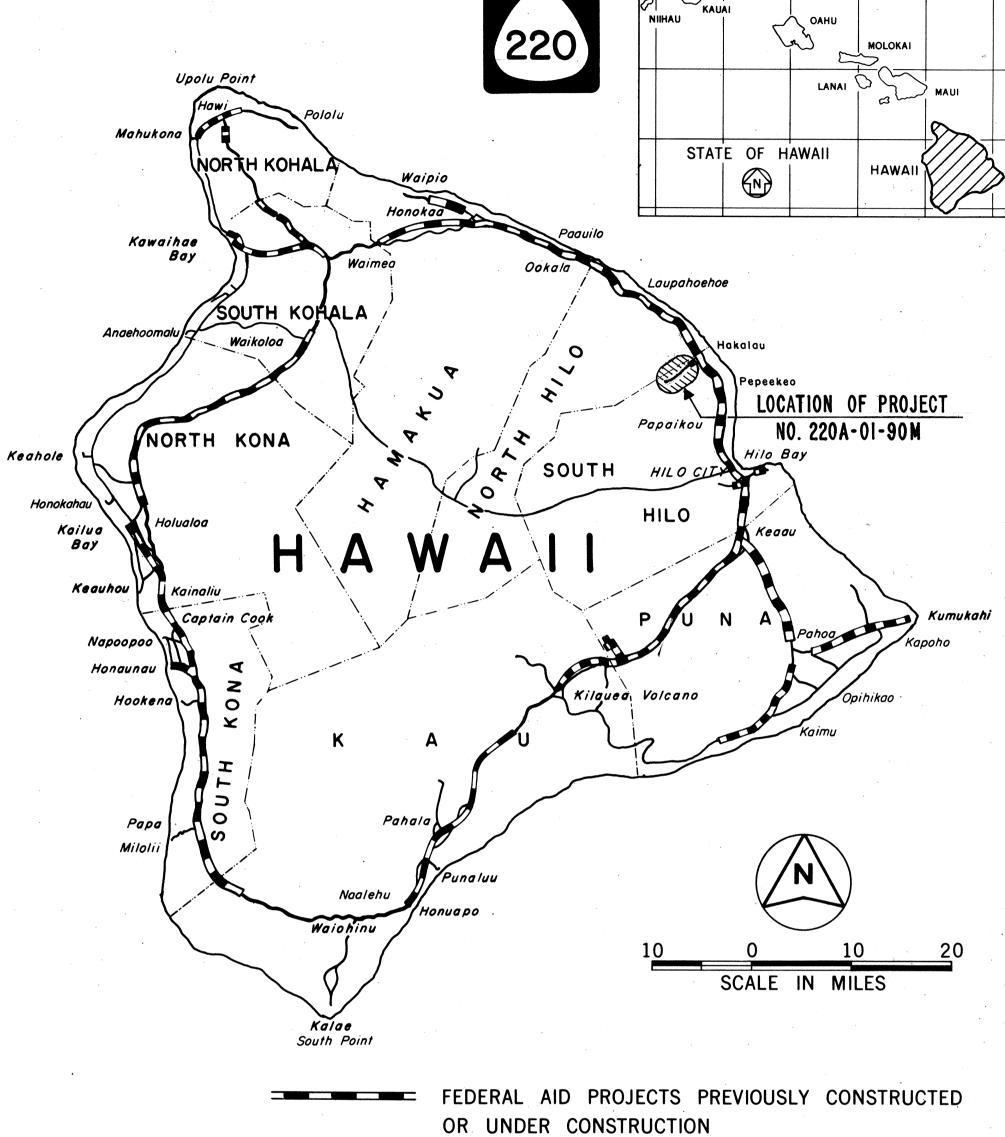

FED. ROAD DIST. NO. FISCAL YEAR

PROJ. NO.

SHEET NO.

CHANGES MADE DURING CONSTRUCTION HAVE BEEN INCORPORATED ON THESE PLANS EXCEPT CHANGES IN THE ORIGINAL THEORETICAL QUANTITIES.

RESIDENT ENGINEER

10-30-90 DATE

DEPARTMENT OF TRANSPORTATION
STATE OF HAWAII

APPROVED:

81/31/89

DIR. OF TRANSPORTATION DATE