


GUARDRAIL SCHEDULE																															
CONSTRUCTION PROJECT NO.	REMOVE EXISTING GUARDRAIL STATION LOCATIONS		INSTALL NEW GUARDRAIL STATION LOCATIONS		RESET EXISTING GUARDRAIL STATION LOCATIONS		LEFT / RIGHT	GUARDRAIL REMOVAL LENGTH (FT.)	NEW GUARDRAIL LENGTH (FT.)	NESTED GUARDRAIL LENGTH (FT.)	INSTALL GUARDRAIL AT OBSTRUCTION (FT.)	INSTALL 8-FT. POST (EACH)	RESET POST AND REPLACE SPACER BLOCK (EACH)	GUARDRAIL END TREATMENTS														END TREATMENT REMOVAL	REMARKS		
														TO EXISTING		RUBRAIL (LIN. FT.)	MODIFIED TYPE "A-1"		MODIFIED TYPE "G"		FLEAT 350		ET 2000		SKT 350		BRIDGE RAILING UPGRADE			BRIDGE NAME	
	FROM	TO	FROM	TO	FROM	TO								LEAD	TRAIL			LEAD	TRAIL	LEAD	TRAIL	LEAD	TRAIL	LEAD	TRAIL	LEAD	TRAIL				LEAD
1416	03+85	08+15	02+49 3+26	10+06 10+01	+	+	L	425.0	662.5 600.0	--	--	40	--	--	--	--	--	--	--	1	1	--	--	--	--	--	--				
	04+00	04+84 7+85	02+88 3+50	08+42 8+00	+	+	R	387.5	462.5 350.0	--	--	27	--	--	--	--	1	1	--	≠	≠	--	--	--	--	--	--				
A-220-01-61	14+72	15+75	14+71	16+52 16+34	+	+	L	112.5	137.5	--	--	19	--	--	--	--	1	--	--	1	--	--	--	--	--	--	--			R = 30ft (3) *	
	20+80	20+92	19+62	20+60	+	+	L	12.5	87.5	--	--	--	--	--	--	--	--	--	--	≠	--	--	--	--	--	--	--			R = 40ft (3) *	
	21+23	21+59	21+60	22+43	+	+	R	37.5	37.5	--	--	--	--	--	--	--	--	≠	--	--	--	--	--	--	--	--	--				
	21+23	22+12	21+60	25+00	+	+	L	87.5	312.5	--	--	--	--	--	--	--	--	--	--	≠	--	--	--	--	--	--	--				
TOTALS								763 925	1700 2400	0	0	86	0	0	0	0	≠ 3	≠ 1	≠ 6	0	0	0									
																			* (X) = (# of standard rail lengths required)												
A-220-01-64			73+17.5	80+86			R		700.0			20							1	1											
A-220-01-64			76+20	83+12			L		612.5			17							1	1											

ORIGINAL PLAN	SURVEY PLOTTED BY	DATE
NOTE BOOK	DRAWN BY	
DESIGNED BY		
QUANTITIES BY		
CHECKED BY		

LEGEND FOR

AS-BUILT POSTINGS

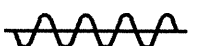

Squiggly line for as-built deletion



Double line for as-built deletion



Roadway Text for as-built posting

STATE OF HAWAII
DEPARTMENT OF TRANSPORTATION
HIGHWAYS DIVISION

GUARDRAIL SCHEDULE

AKAKA FALLS ROAD RESURFACING
HONOMU TOWN TO AKAKA FALLS
PROJECT NO. 220A-01-02M

Scale: none Date: April, 2002

SHEET No. 1 OF 1 SHEETS