

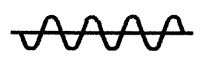
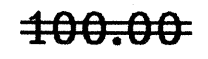
ROUTE MARKER SCHEDULE						
STATION	LEFT	RIGHT	ROUTE MARKER SIGN NO. (ROUTE NO.)	REMOVE	INSTALL TYPE A ASSEMBLY	RM-3 W/O POST
Project No. 1416						
7+38	●		MI-6C (220)	1	1	1
7+39.22 7+38		●	MI-6C (220)	1	1	1
Project No. A-220-01-61						
33+63.59 33+24	●		MI-6C (220)	1	1	1
34+04.01 33+65		●	MI-6C (220)	1	1	1
Project No. A-220-01-64						
35+40.34	●		MI-6C (220)	1	1	1
35+40.41		●	MI-6C (220)	1	1	1
Project No. 220A-02-72						
0+68		●	MI-6C (220)	1	1	1
0+76	●		MI-6C (220)	1	1	1
0+76	●		M6-1	1		
0+76	●		M4-13	1		
0+76	●		MI-6(19)	1		
TOTALS				11	8	8
CONTRACT ITEM NUMBER					621.6110	621.4030

UTILITY SCHEDULE					
PROJECT NO.	STATION	OFFSET FROM C		TYPE	REMARKS
		Right	Left		
1416	1+32		13	WV	
	3+24		13	WV WMH	
A-220-01-61	7+95		15	WMH	2ft dia.
	20+48.5		10.5	WV	
	26+50		13	WV WMH	
	29+22		12	WV	
220A-02-72	5+58	5		WV	
	3+07	11		WV	
	0+79	16		WV	Meter
Legend : (●) WV = Water Valve 5 ≠ Total **					
(●) WMH = Water Manhole 3 ≠ Total					

** CONTRACT ITEM NO. 604.4550

MILEPOST MARKER SCHEDULE						
STATION	LEFT	RIGHT	MILE POST D10-2 (10"X27") MILE POST NO. (RTE. NO.)	REMOVE	INSTALL WITH POST (Bi-Dir)	RM-3 W/O POST
Project No. 1416						
-0+44		●	3/75	1	1	
Project No. A-220-01-61						
1+97.98	●		3 (220)	1	1	
Project No. A-220-01-64						
56+00.20	●		2 (220)	1	1	
Project No. 220A-02-72						
22+18		●	1 (220)	1	1	
CONTRACT ITEM NO. 621.7610				TOTALS	4	4

* Contractor shall submit shop drawings of the kilometer-post sign to the Engineer for acceptance. Fabrication and installation of these signs shall be considered incidental to various sign items.

LEGEND FOR AS-BUILT POSTINGS	
	Squiggly line for as-built deletion
	Double line for as-built deletion
Roadway	Text for as-built posting

STATE OF HAWAII
DEPARTMENT OF TRANSPORTATION
HIGHWAYS DIVISION

MISCELLANEOUS SCHEDULES

AKAKA FALLS ROAD RESURFACING
HONOMU TOWN TO AKAKA FALLS
PROJECT NO. 220A-01-02M

Date: April, 2002

SHEET No. 1 OF 1 SHEETS