

FED. ROAD DIST. NO.	STATE	PROJ. NO.	FISCAL YEAR	SHEET NO.	TOTAL SHEETS
HAWAII	HAW.	220A-01-02M	2002	25	49

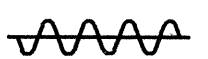
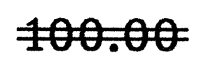
REFLECTOR AND OBJECT MARKER SCHEDULE

STATION		LEFT	RIGHT	RM-2 (White) (Bi-dir)			RM-3 (Yellow)		RM-3 (Bi-dir) # of Rows (White)		RM-4		TYPE II (Bi-dir)		RM-5	REMARKS
FROM	TO			STEEL POST	FLEX POST	W/OUT POST	FLEX POST	W/OUT POST	FLEX POST	W/OUT POST	STEEL POST	W/OUT POST	FLEX POST	W/OUT POST	W/OUT POST	
Project No. 1416																
0+86 0+79			●						1							Drop Off
4+50 3+67	8+50	●			1								3			Guardrail
2+50 4+05	10+00	●	●		1										30	Guardrail
5+00 5+67	7+00	●	●		1								2			Guardrail
2+90 6+05	8+10		●		1										23	Guardrail
6+50			●						1							Culvert
6+54		●							1							Culvert
7+50		●	●										2			Guardrail
Project No. A-220-01-61																
15+18 7+67		●	●		1				1							Drop Off
15+65			●						1							Culvert
15+76		●							1							Culvert
19+90 7+75			●		1		1									Bridge Approach
20+10 9+67		●	●		1		1									Bridge Approach
20+30 14+62		●	●				1						1			Bridge Approach Obj. Marker
19+62 14+70	20+93	●			1						1		2		5	Bridge Approach
19+90 15+16	20+50		●		3				1							Delineation
20+57 15+80	20+93	●	●		1						1		1		2	Bridge Approach
21+23 14+62	22+23 16+34	●									1		1		4 7	Bridge Approach Guardrail
21+23 19+82	22+23		●						1		1		1		4	Bridge Approach
22+00 19+87	25+00	●			1								2		13	Guardrail
31+11 20+04	32+87		●			5	5		1							Drop Off
Project No. 1416																
25+00		●							1							Drop Off
25+32		●							1							Culvert
25+80		●							1							Culvert
26+00		●							1							Drop Off
Project No. A-220-01-64																
42+05	44+80		●						3							Drop Off
67+00	68+50	●							3							Drop Off
73+53	80+50	●							10							Drop Off

ADDED REFLECTOR AND OBJECT MARKER SCHEDULE

STATION		LEFT	RIGHT	RM-2 (White) (Bi-dir) FLEX POST	RM-3 (White) (Bi-dir) FLEX POST	RM-5 GUARDRAIL	REMARKS
FROM	TO						
Project No. 1416							
3+26	10+01	●				24	
3+50	8+00		●			16	
Project No. A-220-01-61							
20+28			●		1		
20+34		●		1			
21+79		●		1			
21+84			●	1			
31+11	32+87		●		6		
33+50	36+75	●			6		
Project No. A-220-01-64							
25+00		●			1		
26+00		●			1		
29+00	35+50		●		13		
40+50	48+00		●		15		
67+50		●			1		
68+50		●			1		
73+50	75+50	●			8		
73+17	80+86		●			30	
73+17	80+86		●	5			
76+20	83+12	●				25	
76+20	83+12	●		4			

LEGEND FOR
AS-BUILT POSTINGS

 Squiggly line for
as-built deletion
 Double line for
as-built deletion
Roadway Text for as-built
posting

STATE OF HAWAII
DEPARTMENT OF TRANSPORTATION
HIGHWAYS DIVISION
**REFLECTOR AND OBJECT
MARKER SCHEDULE**
AKAKA FALLS ROAD RESURFACING
HONOLULU TOWN TO AKAKA FALLS
PROJECT NO. 220A-01-02M

Scale: None Date: April, 2002

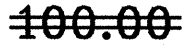
SHEET No. 1 OF 2 SHEETS

"AS-BUILT"

FED. ROAD DIST. NO.	STATE	PROJ. NO.	FISCAL YEAR	SHEET NO.	TOTAL SHEETS
HAWAII	HAW.	220A-01-02M	2002	26	49

REFLECTOR AND OBJECT MARKER SCHEDULE																
STATION		LEFT	RIGHT	RM-2 (White) (Bi-dir)			RM-3 (Yellow) (Bi-dir)		RM-3 (Bi-dir) (Yellow) (White)		RM-4		TYPE II (Bi-dir)		RM-5	REMARKS
FROM	TO			STEEL POST	FLEX POST	W/OUT POST	FLEX POST	W/OUT POST	FLEX POST	W/OUT POST	STEEL POST	W/OUT POST	FLEX POST Obj. Marker	W/OUT POST	W/OUT POST	
Project No. A-220-01-64																
75+48	79+58		●						9							Drop Off
79+00		●							1							Culvert
79+10			●						1							Culvert
90+94			●						1							Drop Off
90+98		●							1							Drop Off
91+35			●						1							Drop Off
94+19		●							1							Drop Off
Project No. A-220-02-72																
19+94		●	●						2							Culvert
10+82		●	●						2							Culvert
7+22		●	●						2							Culvert
5+16		●												1		J Pole #3
5+10		●												1		T Pole #4
3+57		●												1		T Pole #3
3+42		●							1							Culvert
2+83		●												2		J Pole #2
2+35		●												1		T Pole #2
0+46		●												2		J Pole #1
TOTALS					3 22	5 0	8 1		48 92		4 0		44 3	8	8 102	
CONTRACT ITEM NUMBER					621.4120	621.4020	621.4130		621.4135		621.4240		621.4170	621.4070	621.4050	
Project No. A-220-02-72																
24+00	25+50		●						3							
21+60		●											2			J Pole
4+50		●							2							
3+50		●							1							
3+40			●						1							
3+00		●					1									
2+83			●						1							
2+60		●							1							
2+12			●						1							
2+10		●							1							
-0+09	0+00		●						5							

ORIGINAL PLAN	SURVEY PLOTTED BY	DATE
NOTE BOOK	DRAWN BY	
DESIGNED BY	CHECKED BY	
QUANTITIES BY		
CHECKED BY		

LEGEND FOR AS-BUILT POSTINGS	
	Squiggly line for as-built deletion
	Double line for as-built deletion
Roadway	Text for as-built posting

STATE OF HAWAII DEPARTMENT OF TRANSPORTATION HIGHWAYS DIVISION	
REFLECTOR AND OBJECT MARKER SCHEDULE	
AKAKA FALLS ROAD RESURFACING HONOMU TOWN TO AKAKA FALLS PROJECT NO. 220A-01-02M	
Scale: None	Date: April, 2002
SHEET No. 2 OF 2 SHEETS	

"AS-BUILT"