



FED. ROAD DIST. NO.	STATE	PROJ. NO.	FISCAL YEAR	SHEET NO.	TOTAL SHEETS
HAWAII	HAW.	220A-01-02M	2002	7	49

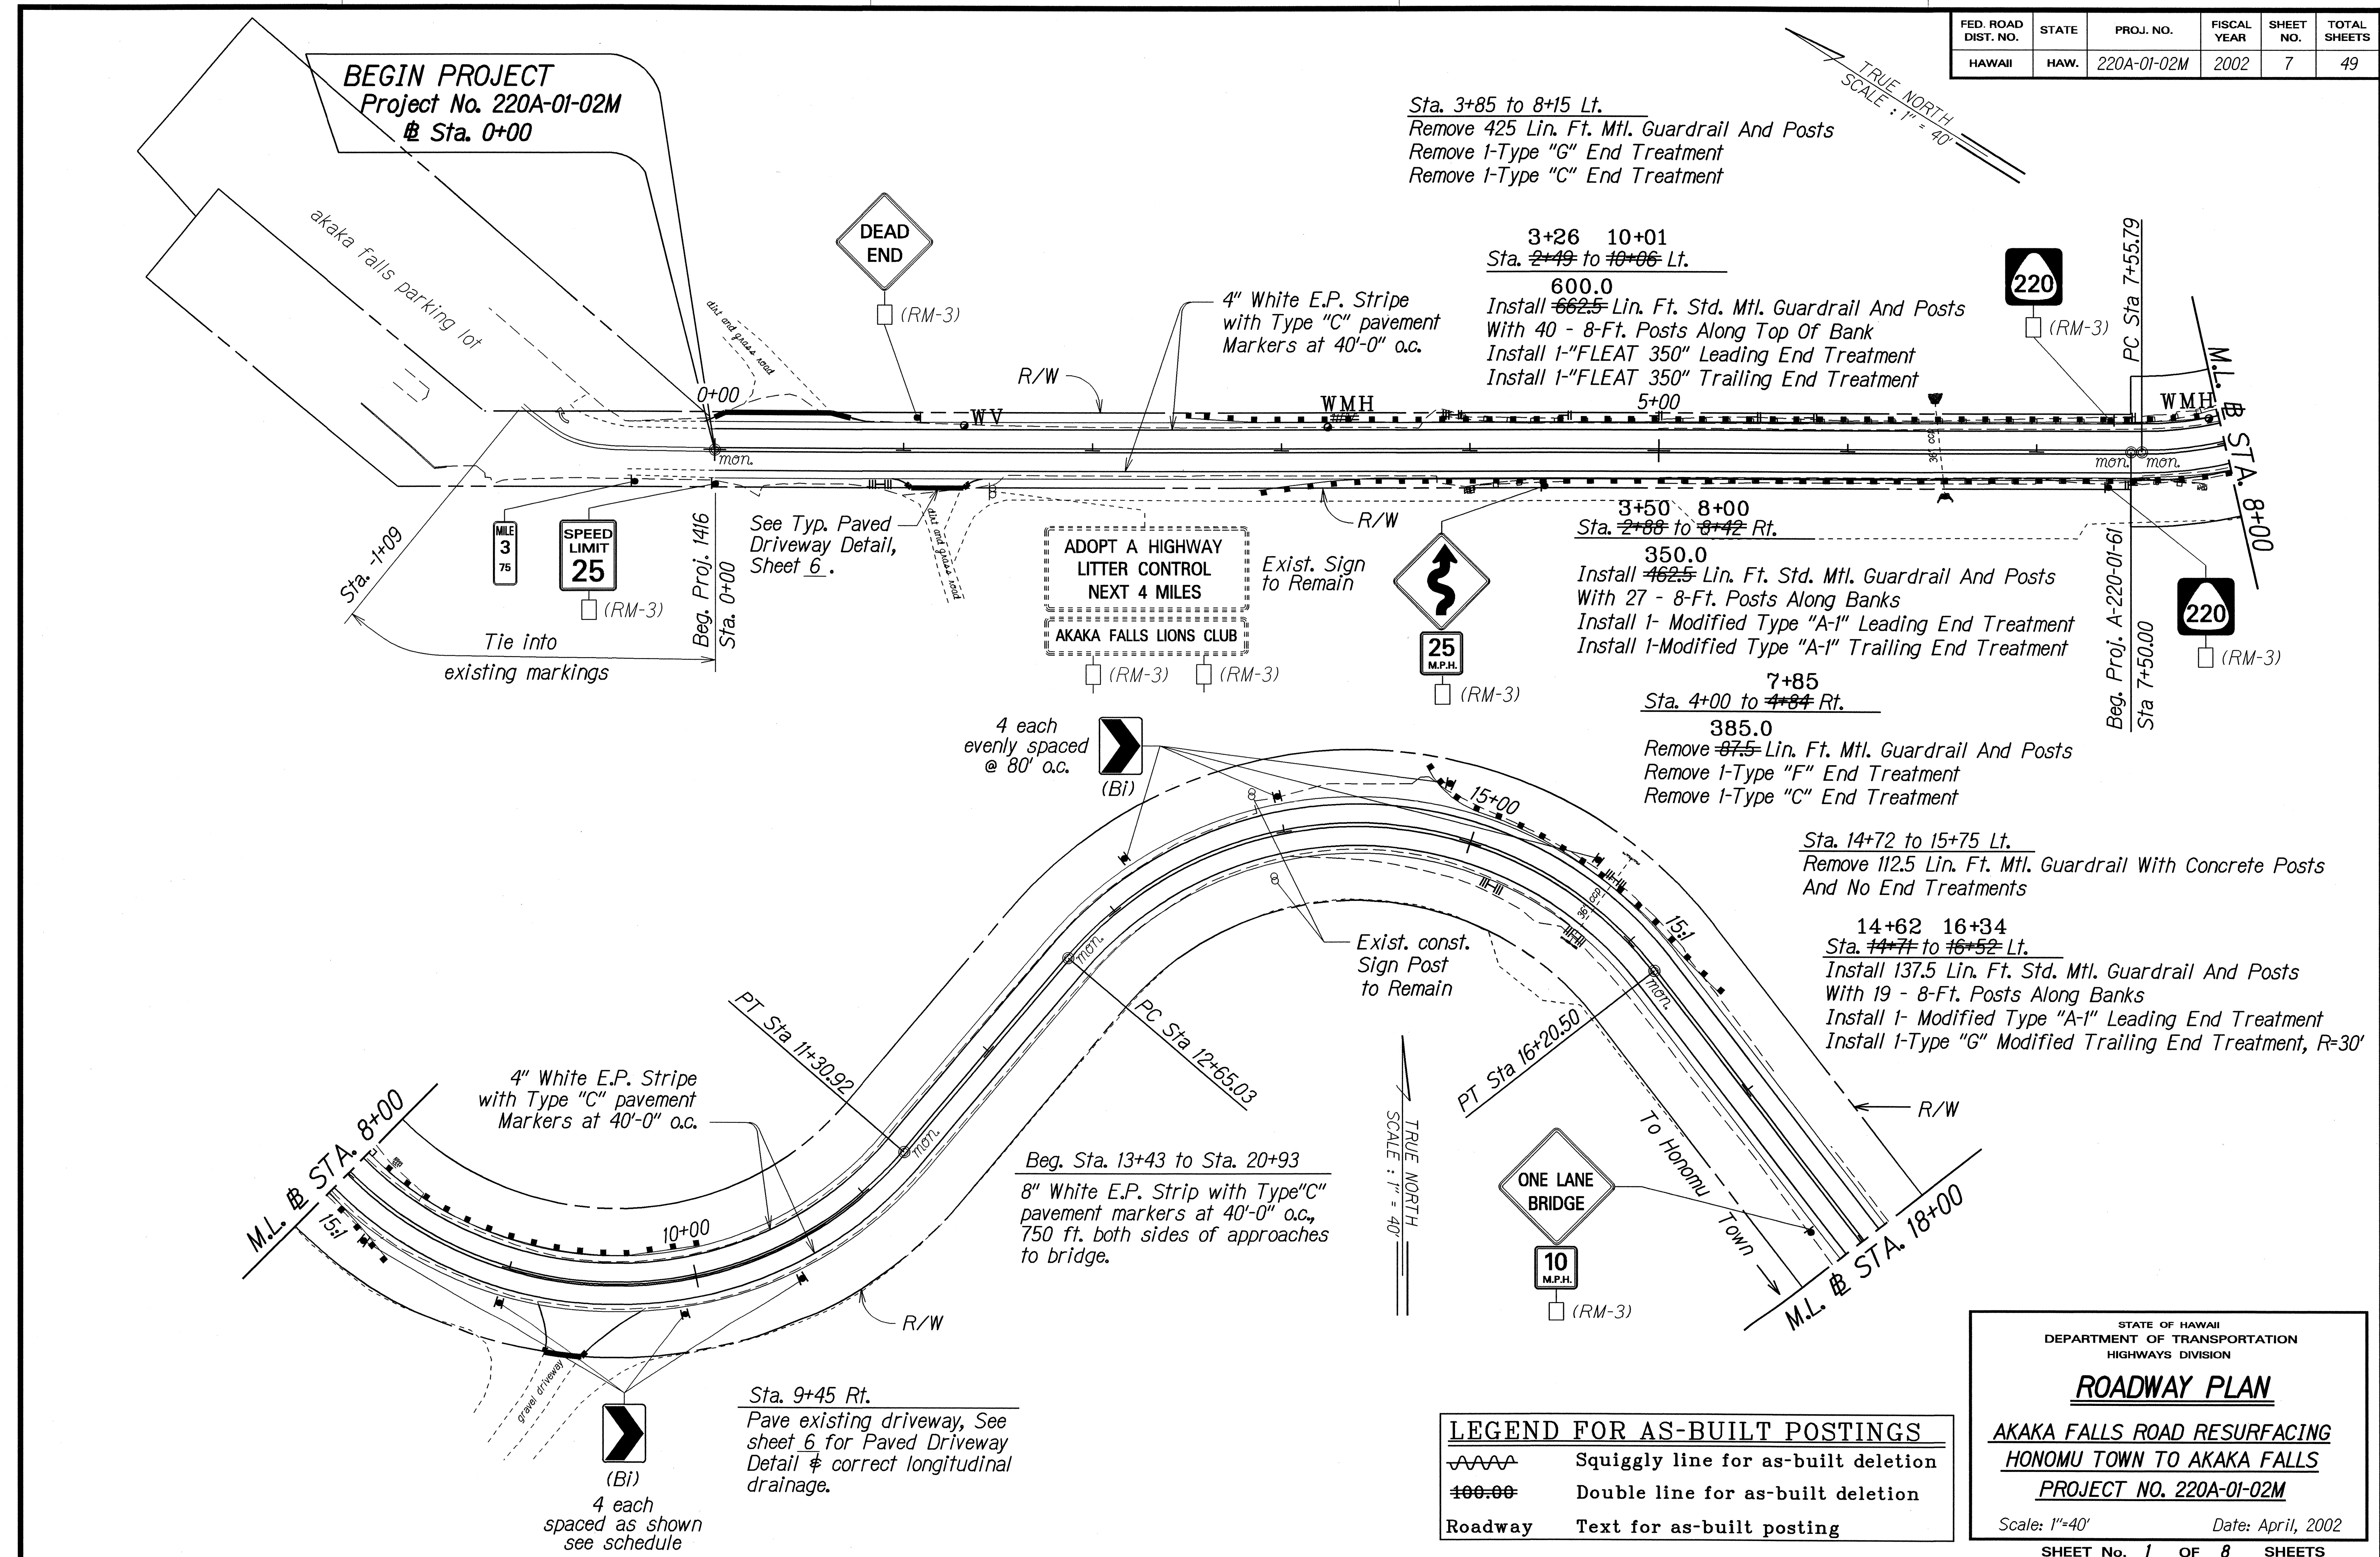

"AS-BUILT"

FED. ROAD DIST. NO.	STATE	PROJ. NO.	FISCAL YEAR	SHEET NO.	TOTAL SHEETS
HAWAII	HAW.	220A-01-02M	2002	8	49

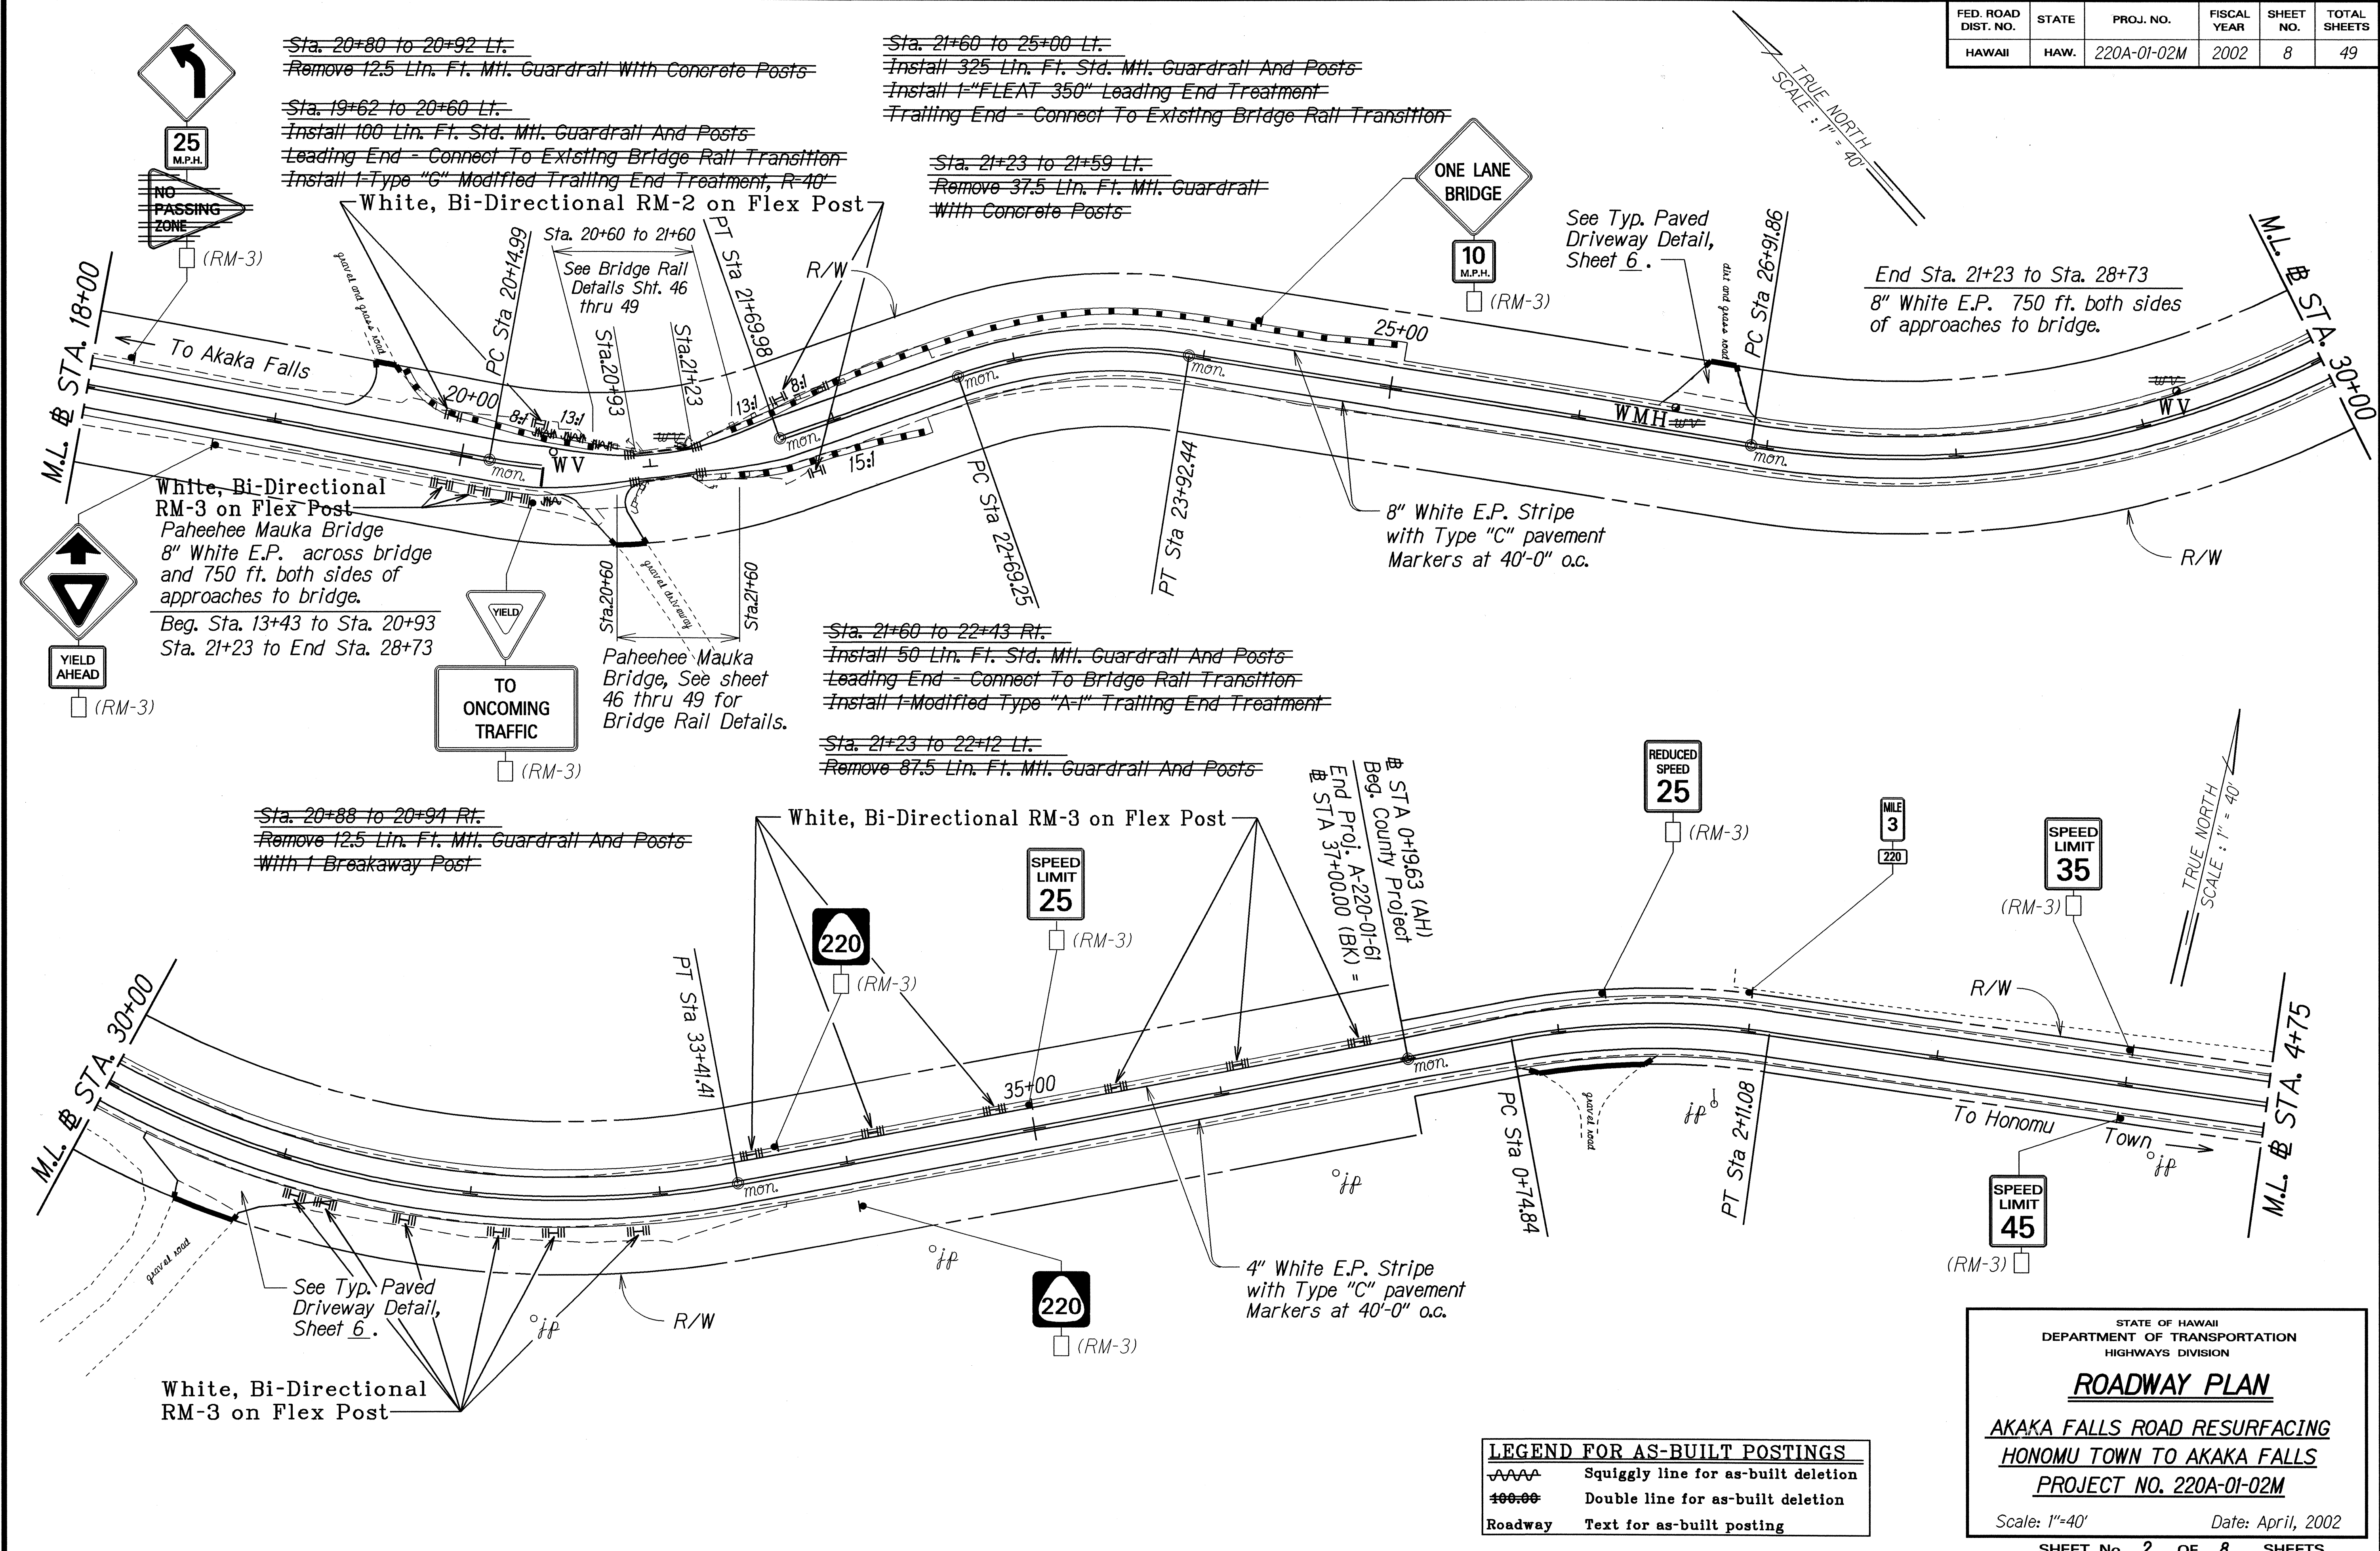

ORIGINAL PLAN	DATE
SURVEY PLOTTED BY	
DRAWN BY	
DESIGNED BY	
CHECKED BY	
NOTE BOOK	
QUANTITIES BY	
CHECKED BY	
DATE	

STATE OF HAWAII
DEPARTMENT OF TRANSPORTATION
HIGHWAYS DIVISION

ROADWAY PLAN


**AKAKA FALLS ROAD RESURFACING
HONUMU TOWN TO AKAKA FALLS**

PROJECT NO. 220A-01-02M

Scale: 1"=40' Date: April, 2002

SHEET No. 2 OF 8 SHEETS

FED. ROAD DIST. NO.	STATE	PROJ. NO.	FISCAL YEAR	SHEET NO.	TOTAL SHEETS
HAWAII	HAW.	220A-01-02M	2002	9	49

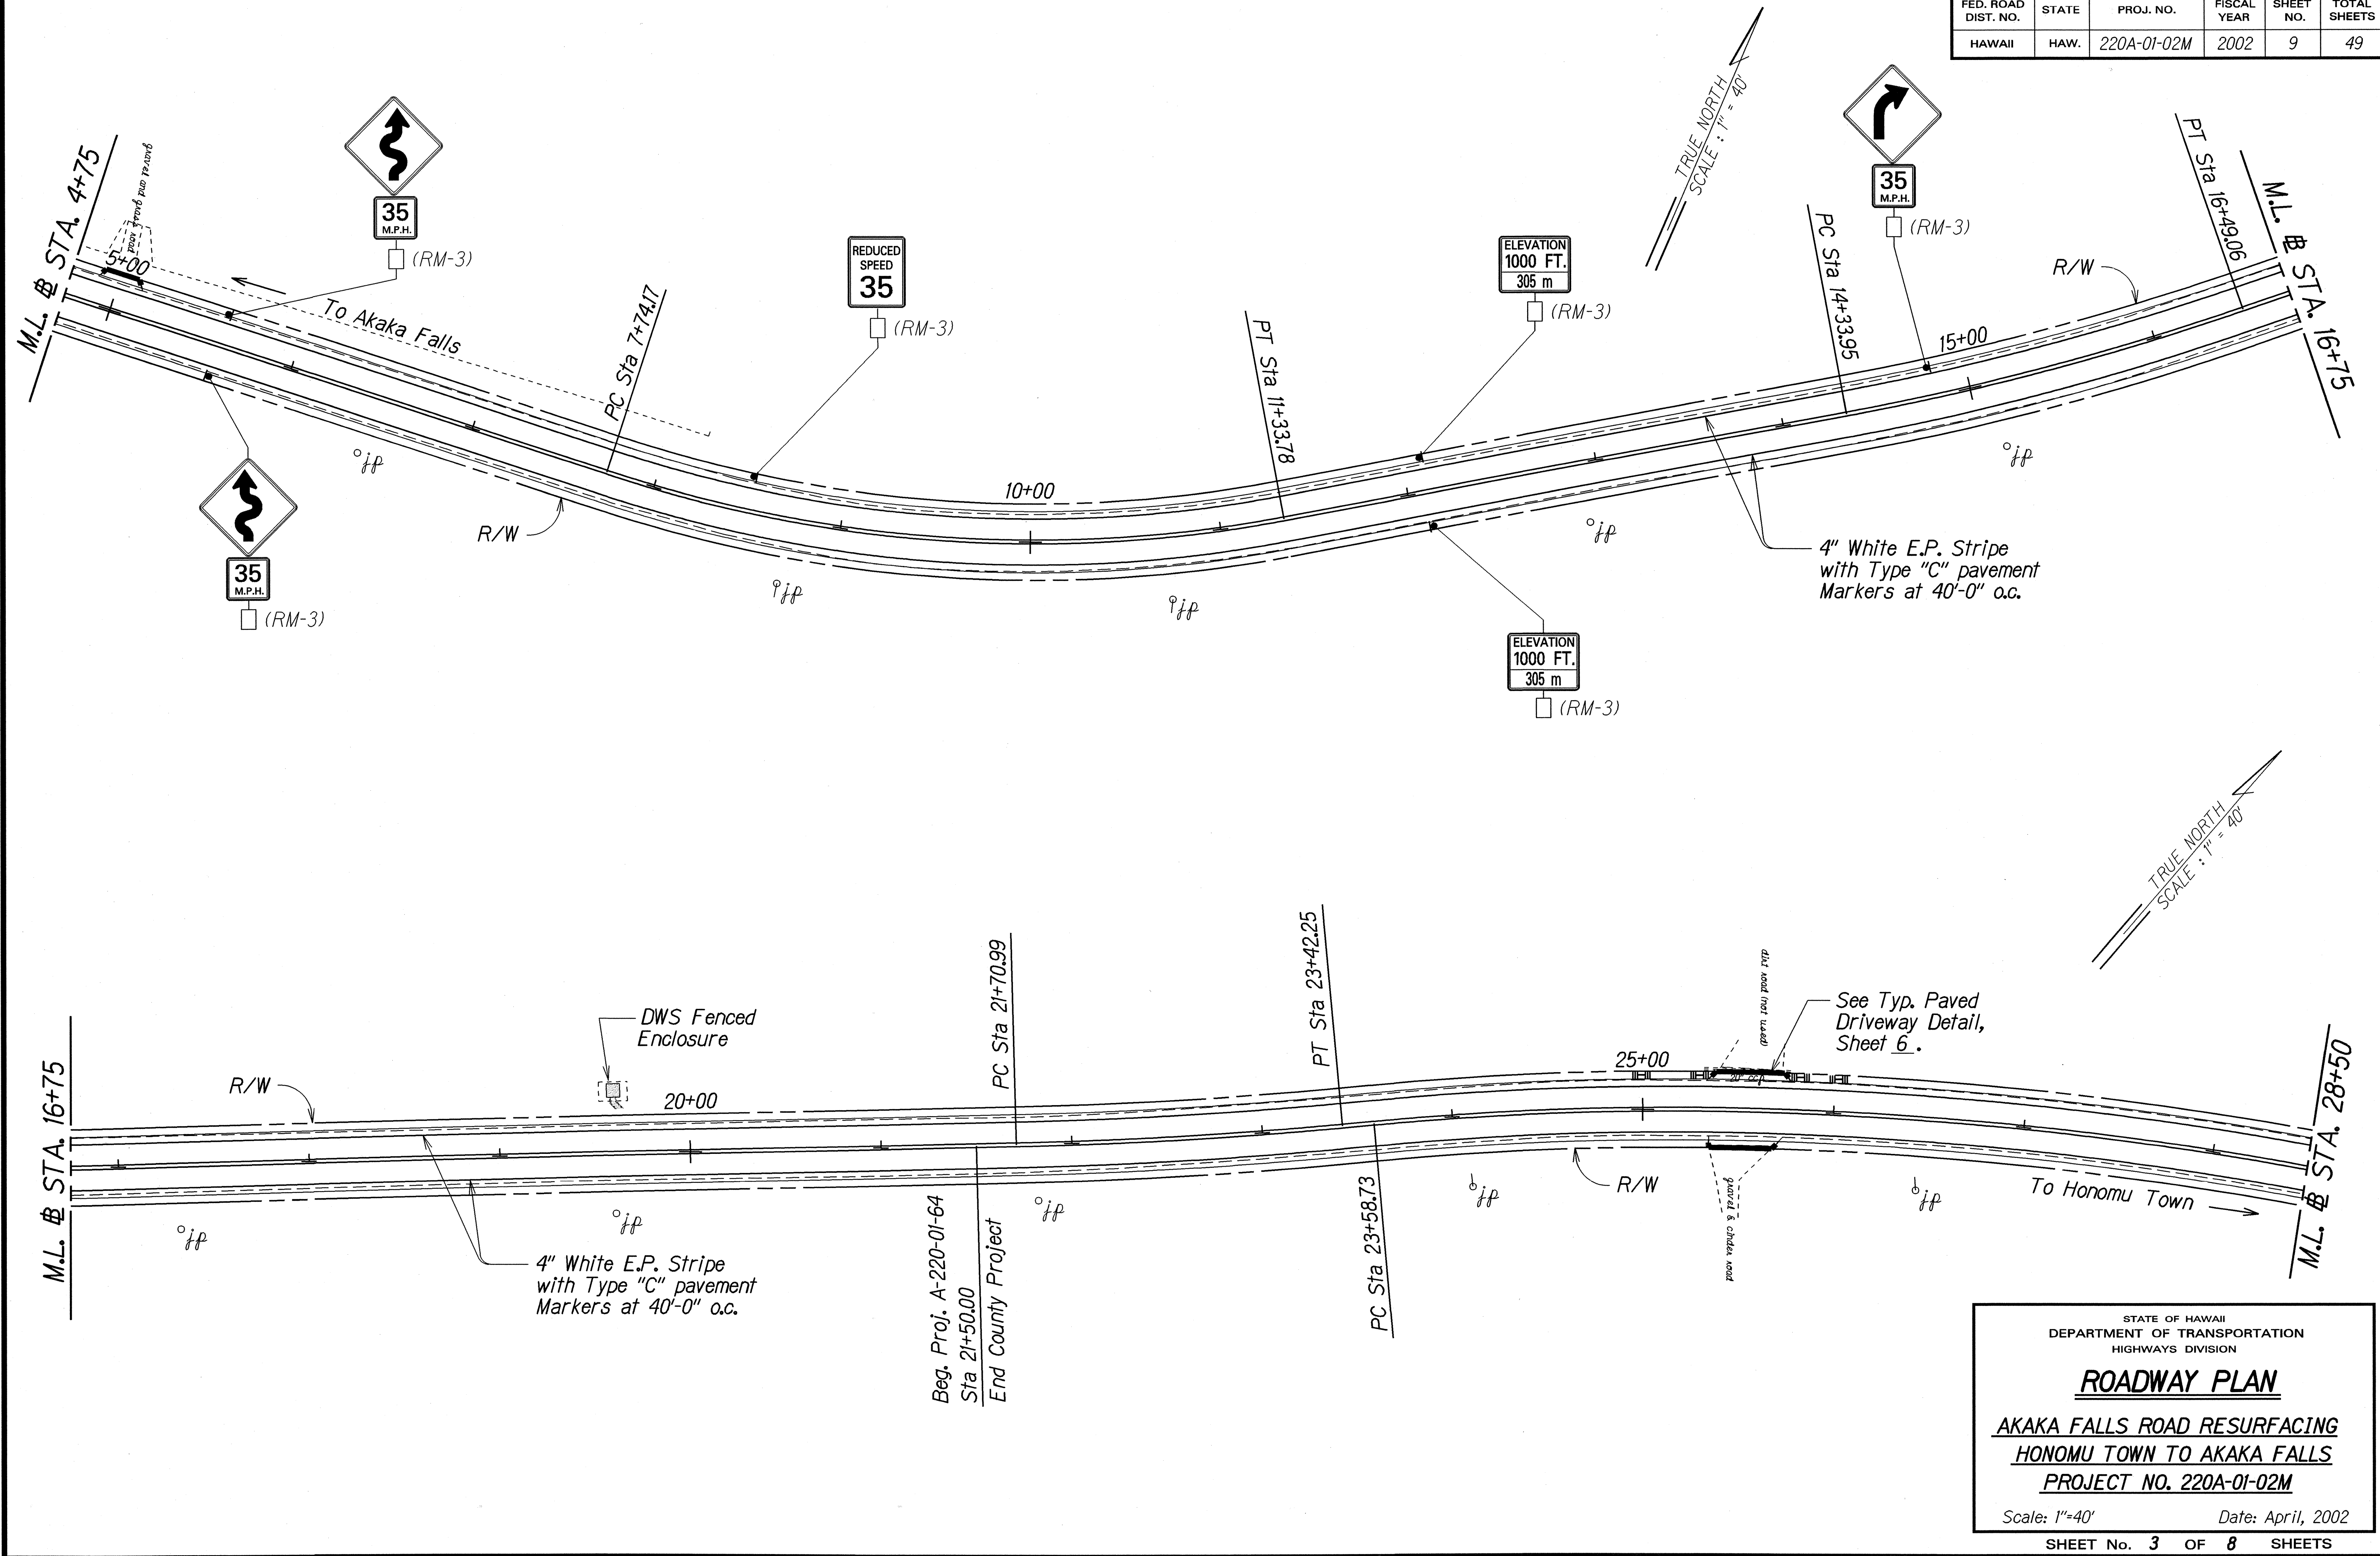

ORIGINAL PLAN	SURVEY PLOTTED BY	DATE
NOTE BOOK	DRAWN BY	
DESIGNED BY	CHECKED BY	
CHECKED BY		
SS. helik		

STATE OF HAWAII
DEPARTMENT OF TRANSPORTATION
HIGHWAYS DIVISION



ROADWAY PLAN

**AKAKA FALLS ROAD RESURFACING
HONOMU TOWN TO AKAKA FALLS
PROJECT NO. 220A-01-02M**

Scale: 1"=40' Date: April, 2002

SHEET NO. 3 OF 8 SHEETS

FED. ROAD DIST. NO.	STATE	PROJ. NO.	FISCAL YEAR	SHEET NO.	TOTAL SHEETS
HAWAII	HAW.	220A-01-02M	2002	10	49

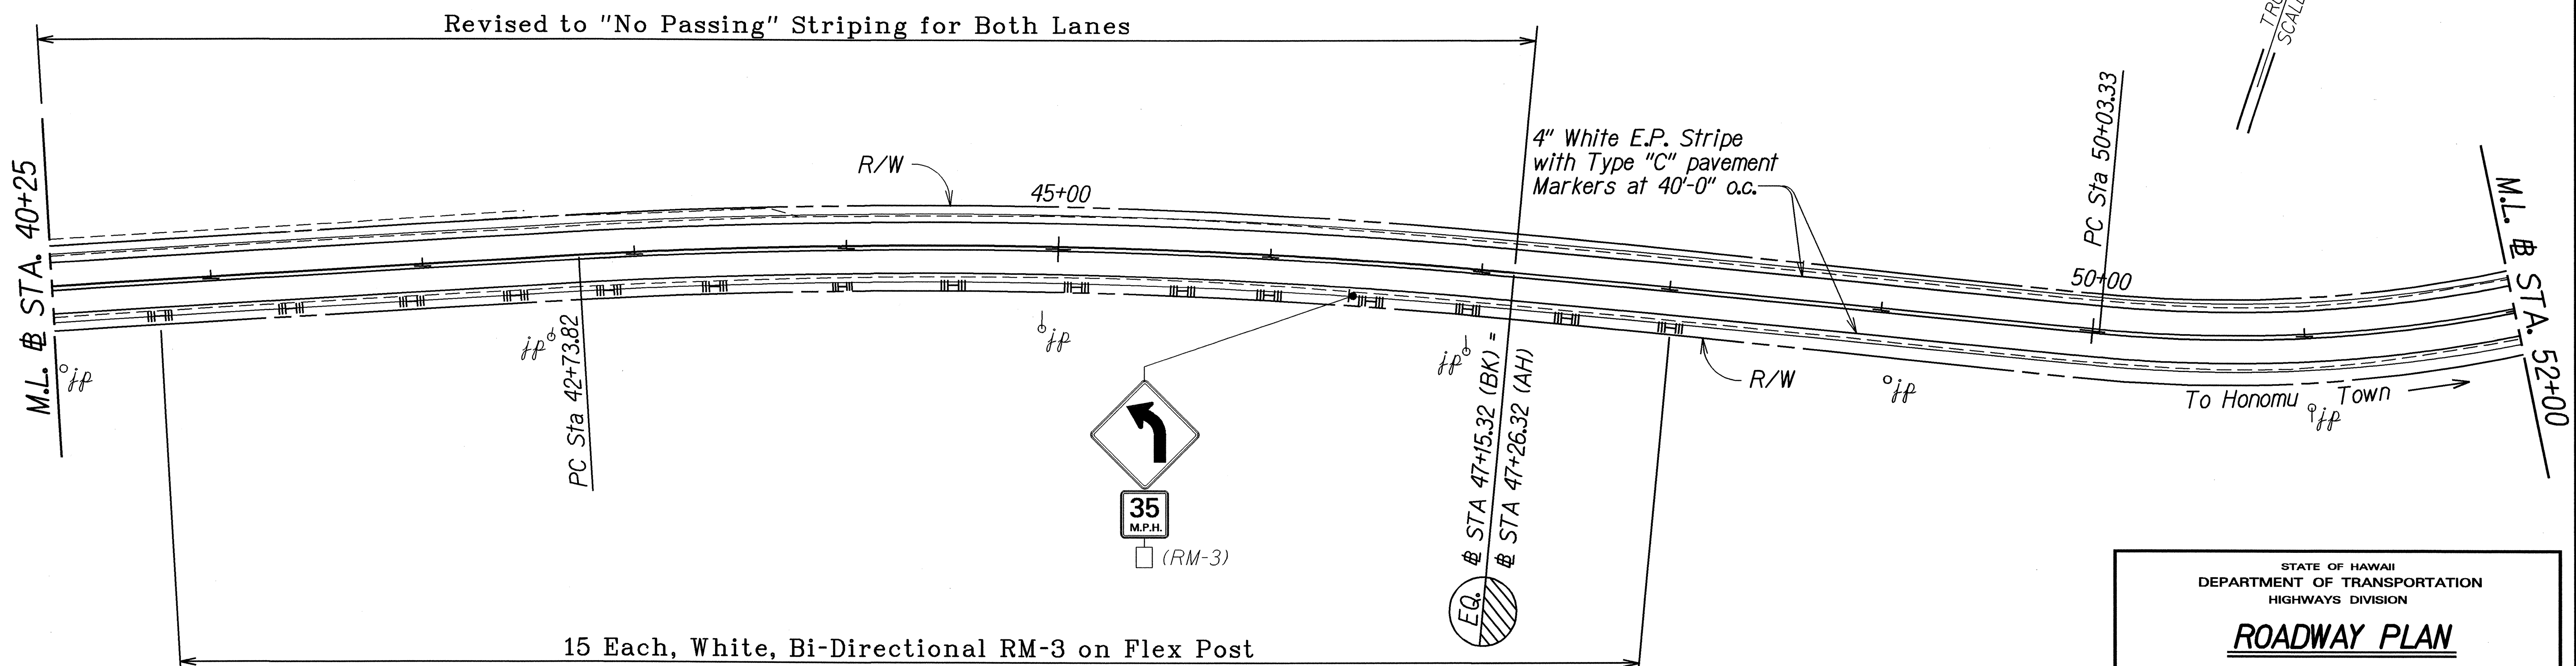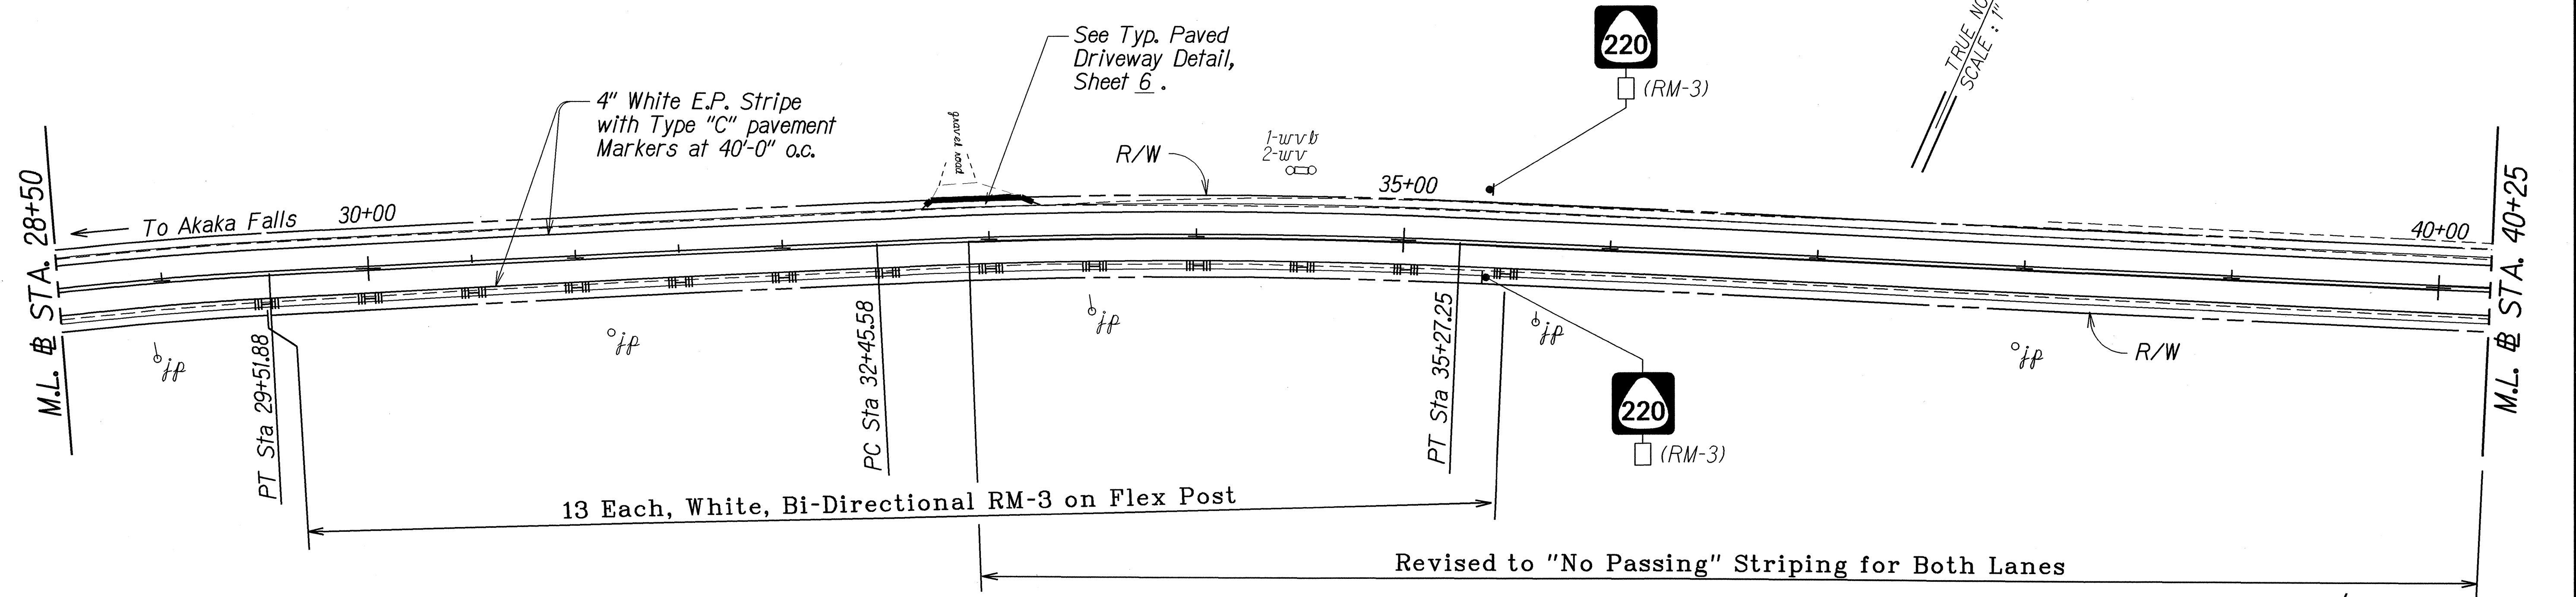

ORIGINAL PLAN	SURVEY PLOTTED BY	DATE
NOTE BOOK	DRAWN BY	
30/1/2002	DESIGNED BY	
30/1/2002	CHECKED BY	

LEGEND FOR AS-BUILT POSTINGS	
	Squiggly line for as-built deletion
	Double line for as-built deletion
Roadway	Text for as-built posting

STATE OF HAWAII
DEPARTMENT OF TRANSPORTATION
HIGHWAYS DIVISION

ROADWAY PLAN


**AKAKA FALLS ROAD RESURFACING
HONOLULU TOWN TO AKAKA FALLS
PROJECT NO. 220A-01-02M**

Scale: 1"=40' Date: April, 2002


SHEET No. 4 OF 8 SHEETS

"AS-BUILT"

FED. ROAD DIST. NO.	STATE	PROJ. NO.	FISCAL YEAR	SHEET NO.	TOTAL SHEETS
HAWAII	HAW.	220A-01-02M	2002	11	49

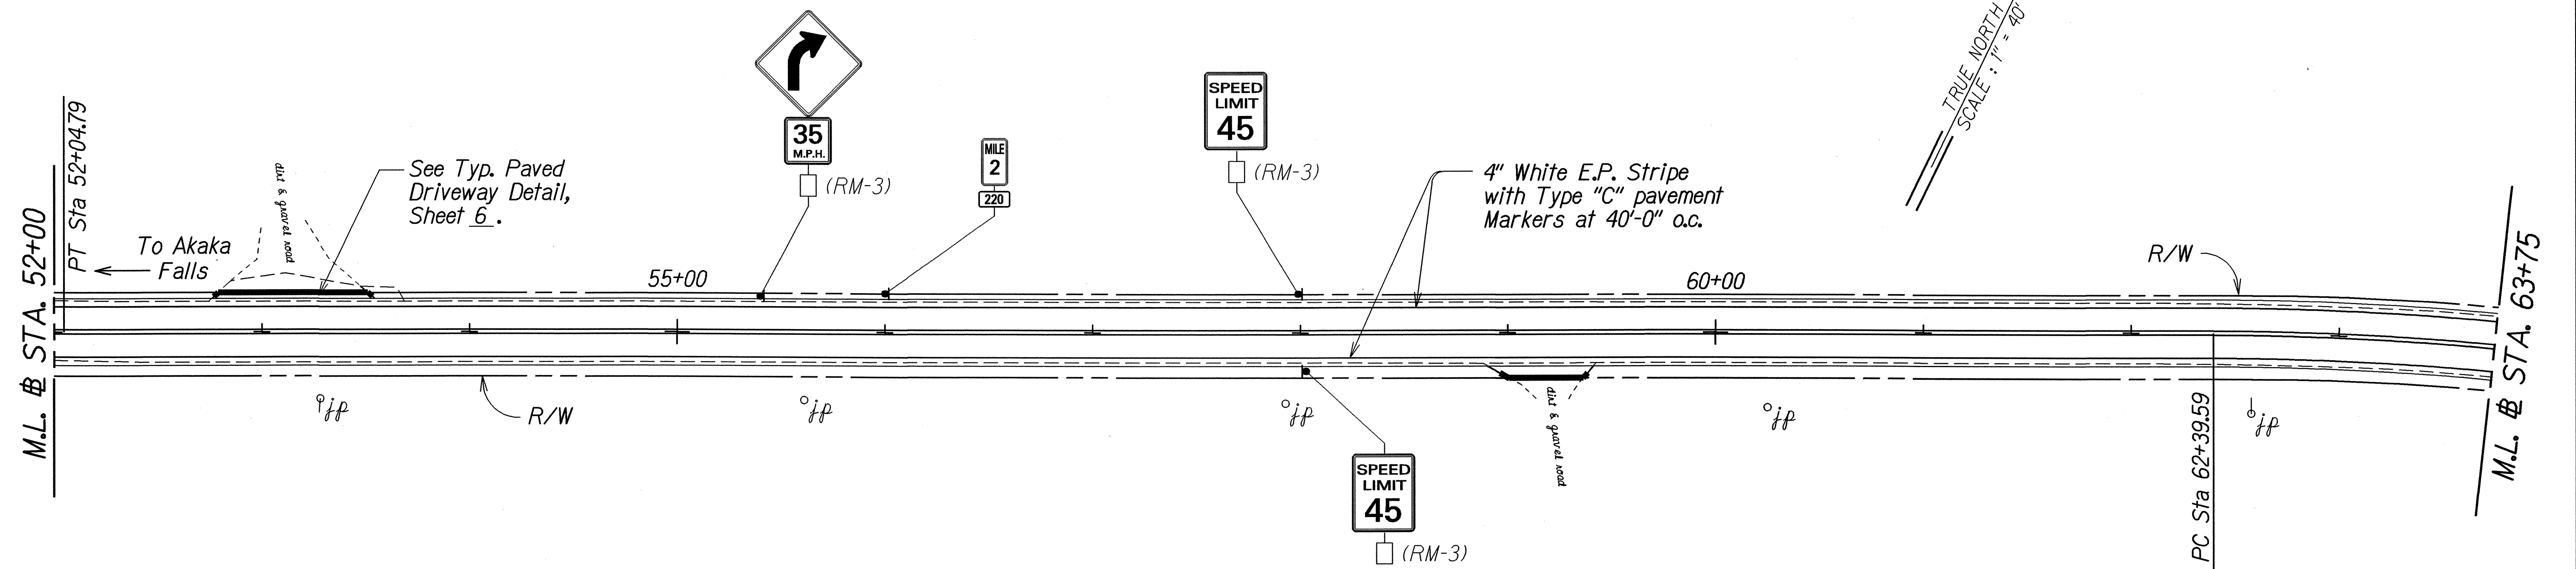

FLEAT 350 LEADING END TREATMENT STA 73+17.5 RT
FLEAT 350 TRAILING END TREATMENT STA 80+86 RT
700 LIN. FT. STD. MLT G/R AND POST, AND 20 EACH
8 FT POST STATION 76+94 RT TO STATION 79+28 RT

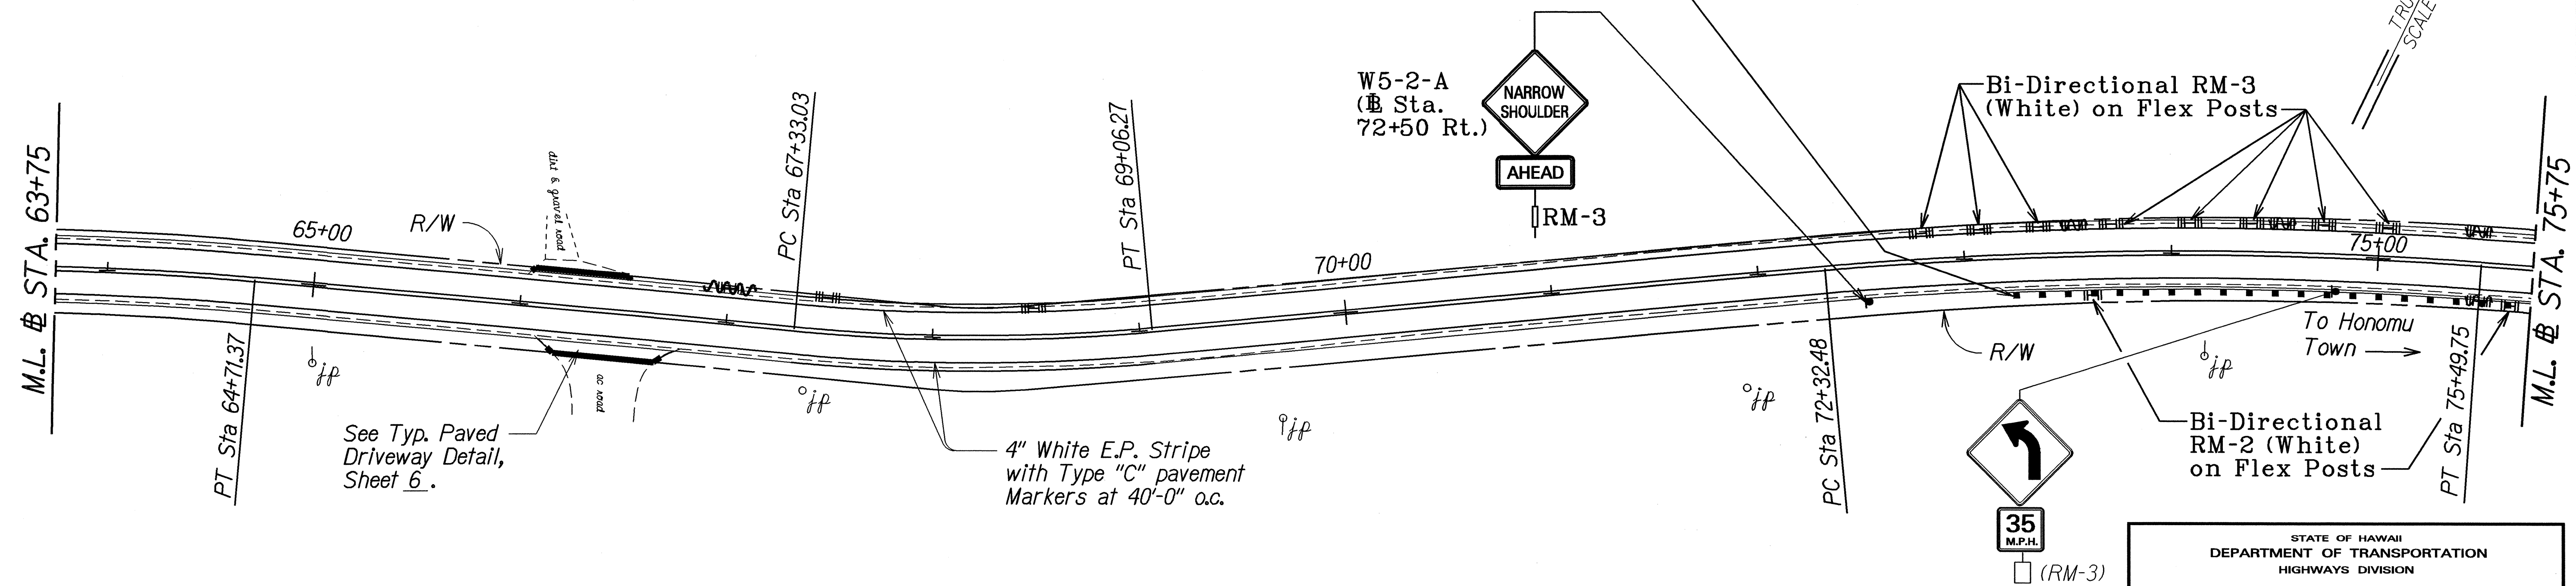

LEGEND FOR AS-BUILT POSTINGS	
	Squiggly line for as-built deletion
	Double line for as-built deletion
Roadway	Text for as-built posting

STATE OF HAWAII
DEPARTMENT OF TRANSPORTATION
HIGHWAYS DIVISION

ROADWAY PLAN

**AKAKA FALLS ROAD RESURFACING
HONOMU TOWN TO AKAKA FALLS**


PROJECT NO. 220A-01-02M

Scale: 1"=40' Date: April, 2002

SHEET No. 5 OF 8 SHEETS

"AS-BUILT"

FED. ROAD DIST. NO.	STATE	PROJ. NO.	FISCAL YEAR	SHEET NO.	TOTAL SHEETS
HAWAII	HAW.	220A-01-02M	2002	12	49

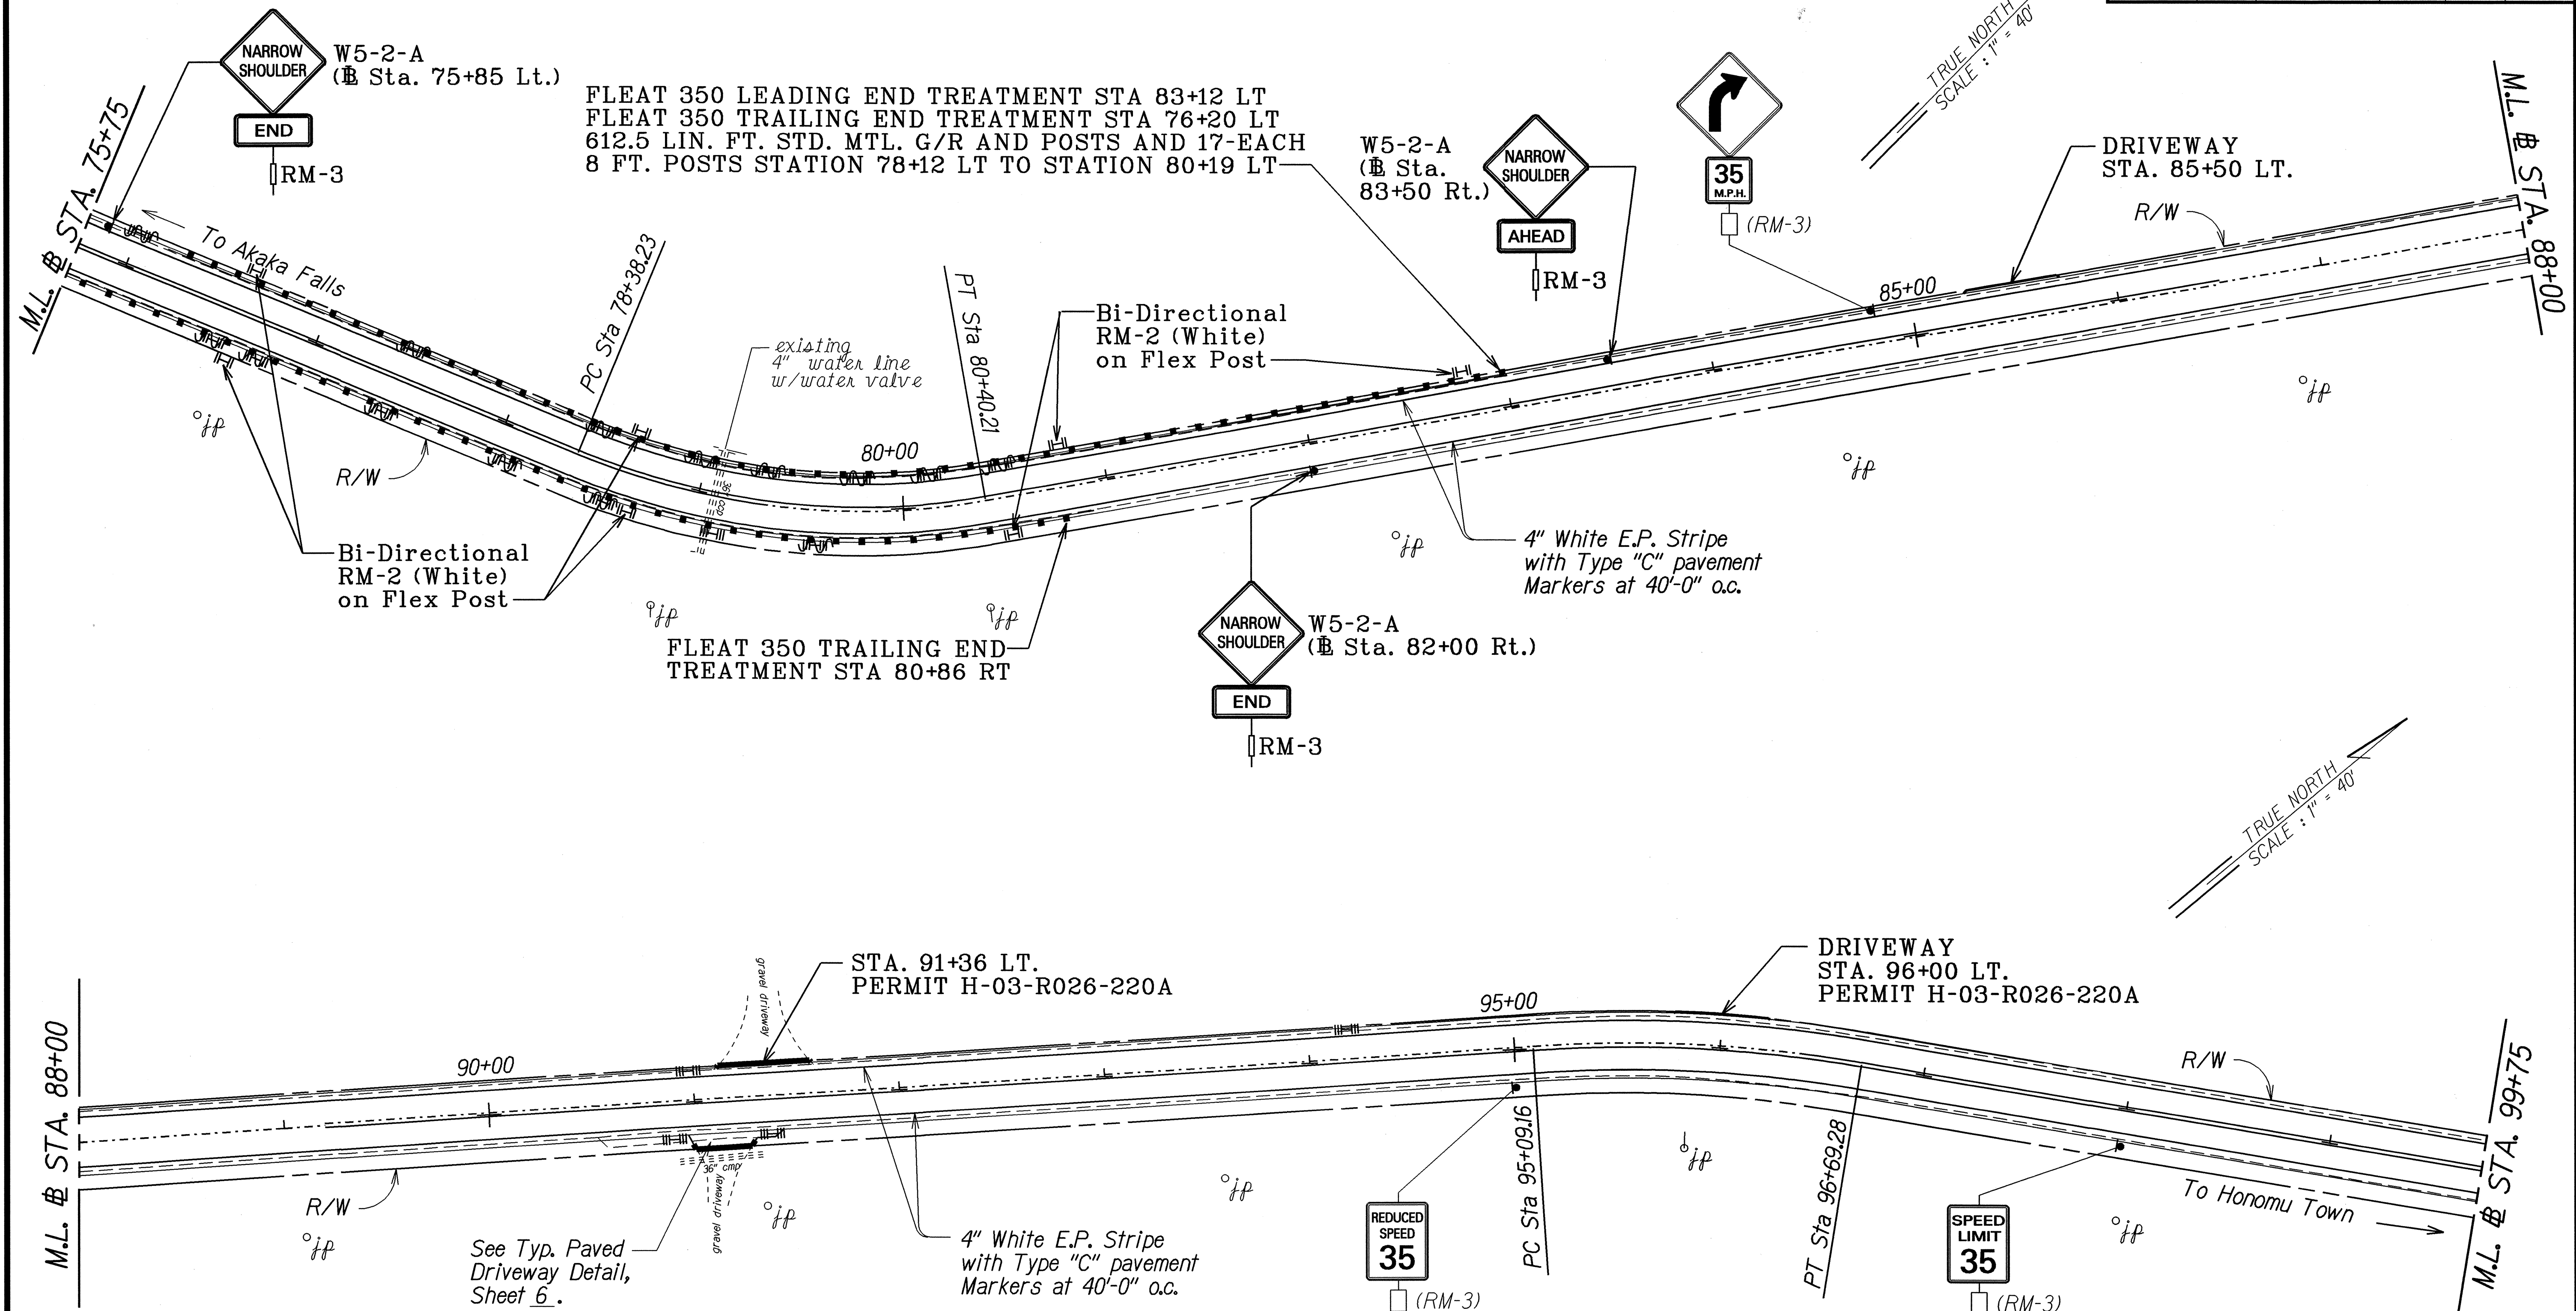

ORIGINAL PLAN	SURVEY PLOTTED BY	DATE
NOTE BOOK	DRAWN BY	
01/01/03/00/00	DESIGNED BY	
01/01/03/00/00	CHECKED BY	

LEGEND FOR AS-BUILT POSTINGS	
	Squiggly line for as-built deletion
	Double line for as-built deletion
Roadway	Text for as-built posting

STATE OF HAWAII
DEPARTMENT OF TRANSPORTATION
HIGHWAYS DIVISION

ROADWAY PLAN


AKAKA FALLS ROAD RESURFACING
HONOLULU TOWN TO AKAKA FALLS
PROJECT NO. 220A-01-02M

Scale: 1"=40' Date: April, 2002

SHEET No. 6 OF 8 SHEETS

"AS-BUILT"

FED. ROAD DIST. NO.	STATE	PROJ. NO.	FISCAL YEAR	SHEET NO.	TOTAL SHEETS
HAWAII	HAW.	220A-01-02M	2002	13	49

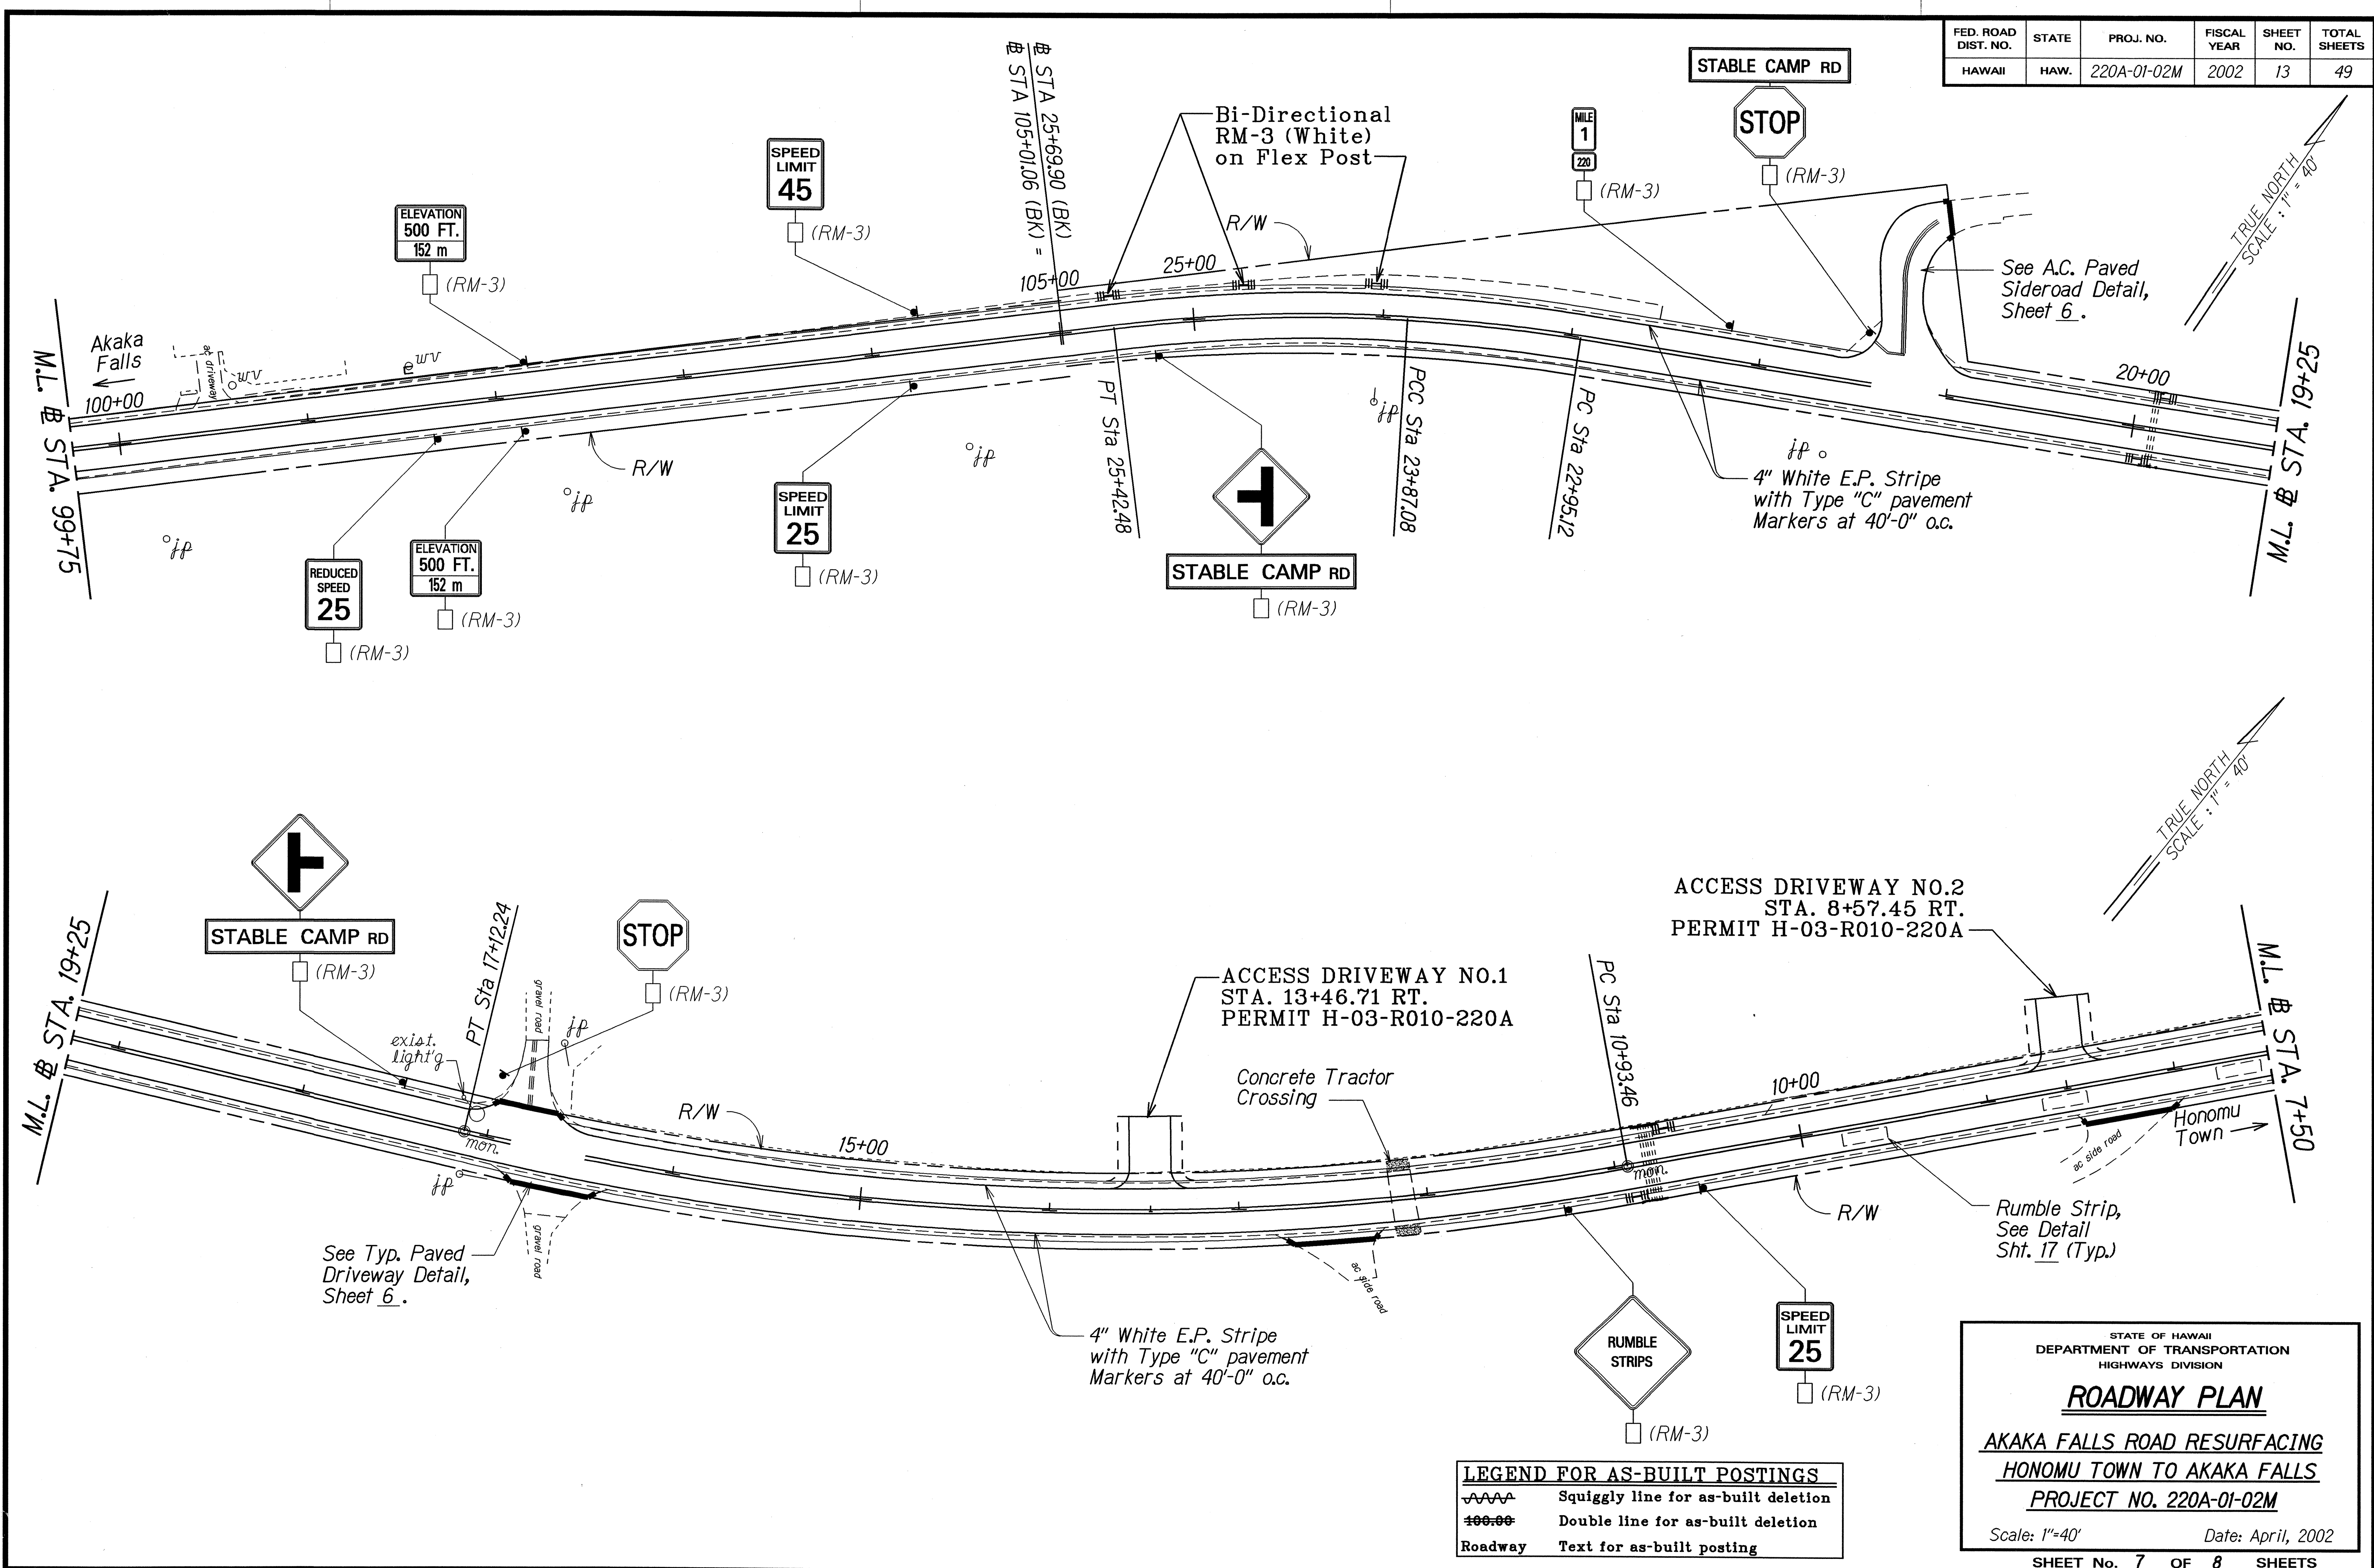

SURVEY PLOTTED BY	DATE
DRAWN BY	
DESIGNED BY	
QUANTITIES BY	
CHECKED BY	

LEGEND FOR AS-BUILT POSTINGS	
	Squiggly line for as-built deletion
	Double line for as-built deletion
	Text for as-built posting

STATE OF HAWAII
DEPARTMENT OF TRANSPORTATION
HIGHWAYS DIVISION

ROADWAY PLAN

**AKAKA FALLS ROAD RESURFACING
HONOLULU TOWN TO AKAKA FALLS**


PROJECT NO. 220A-01-02M

Scale: 1"=40' Date: April, 2002

SHEET NO. 7 OF 8 SHEETS

"AS-BUILT"

FED. ROAD DIST. NO.	STATE	PROJ. NO.	FISCAL YEAR	SHEET NO.	TOTAL SHEETS
HAWAII	HAW.	220A-01-02M	2002	14	49

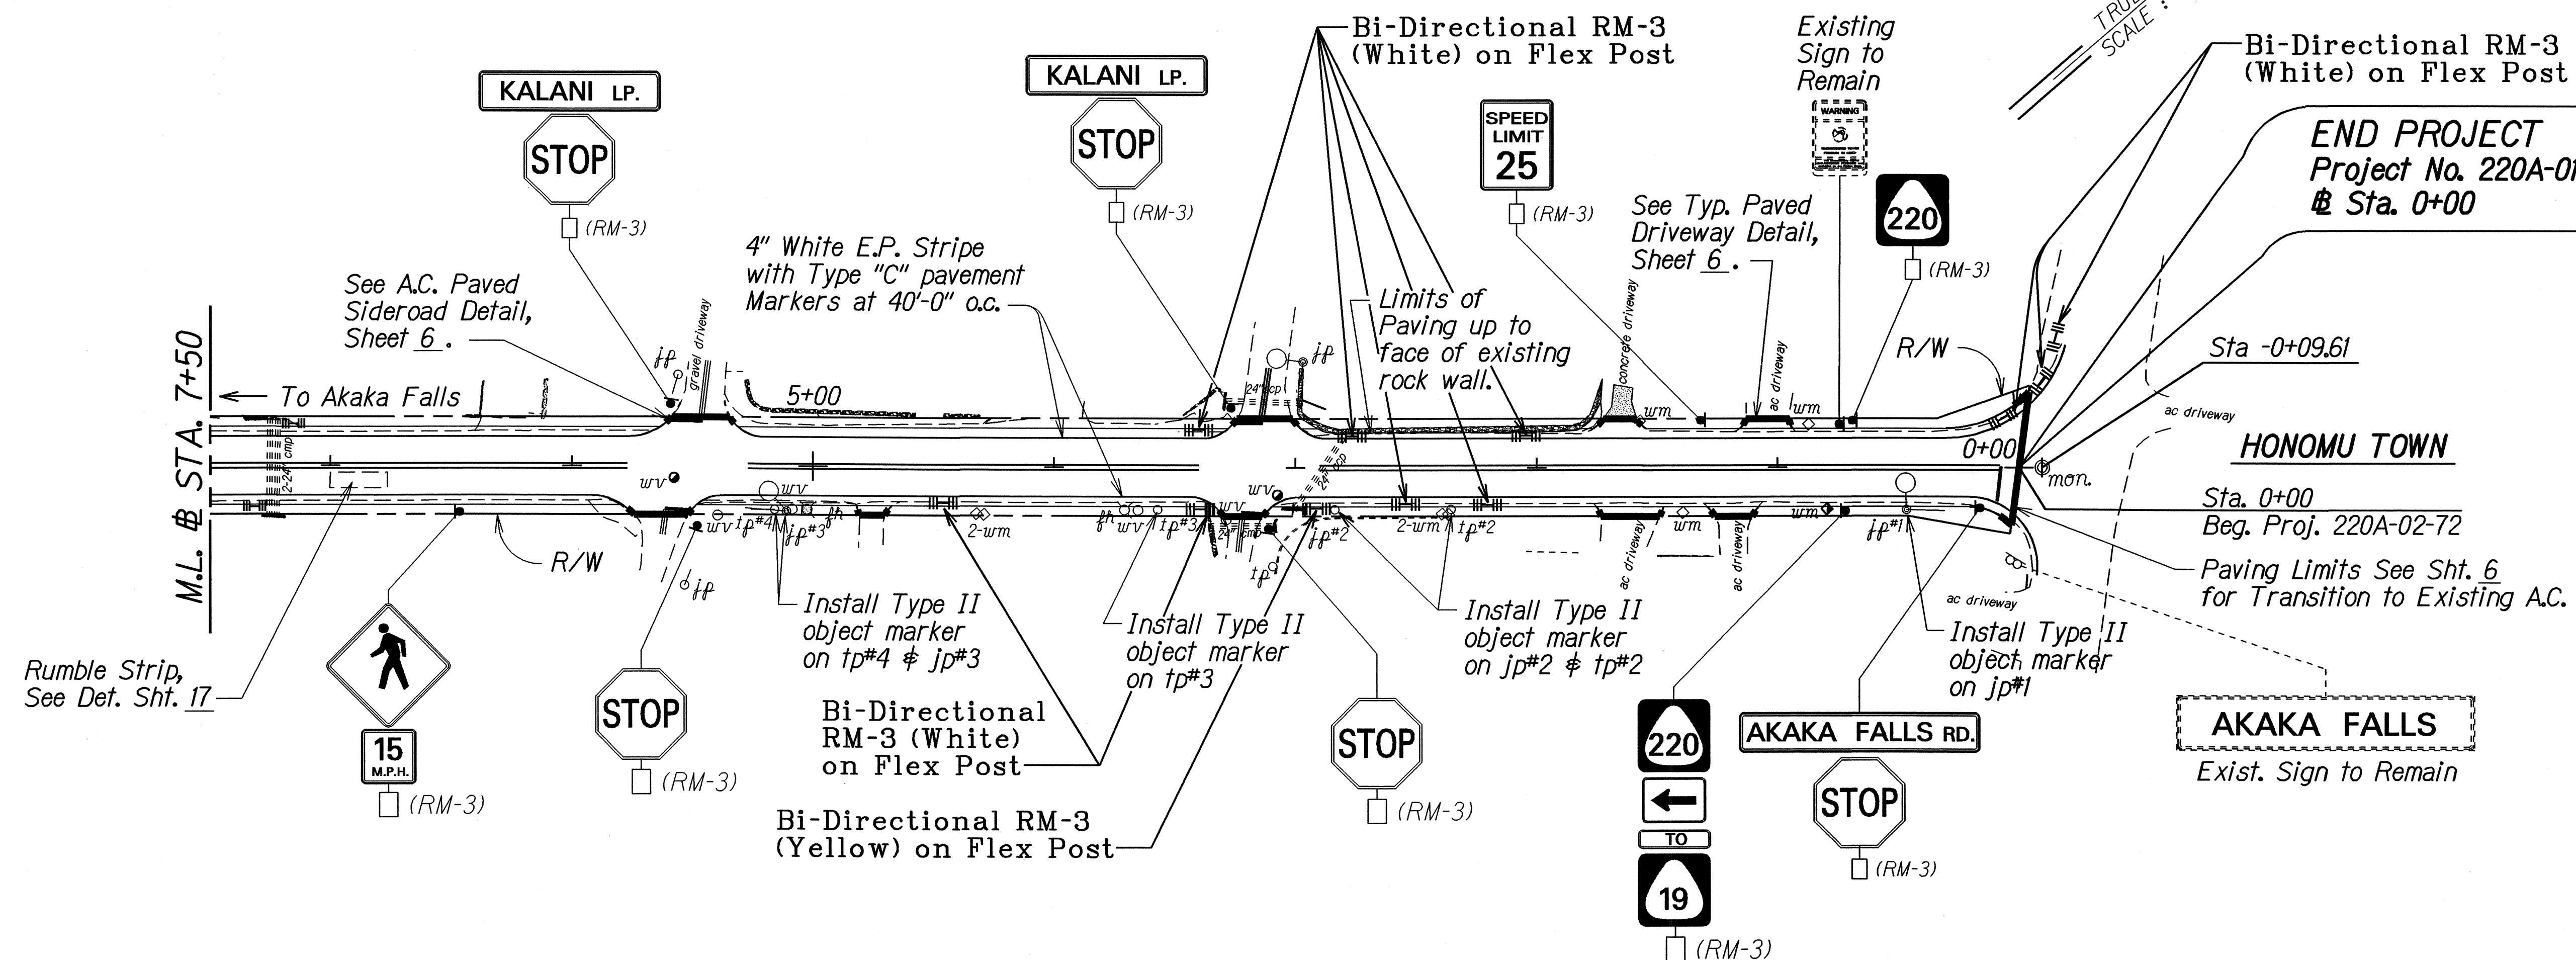

ORIGINAL PLAN	SURVEY PLOTTED BY	DATE
NOTE BOOK	DRAWN BY	
DESIGNED BY	CHECKED BY	
QUANTITIES BY		
BY		

LEGEND FOR AS-BUILT POSTINGS	
	Squiggly line for as-built deletion
	Double line for as-built deletion
Roadway	Text for as-built posting

STATE OF HAWAII
DEPARTMENT OF TRANSPORTATION
HIGHWAYS DIVISION

ROADWAY PLAN

**AKAKA FALLS ROAD RESURFACING
HONOMU TOWN TO AKAKA FALLS
PROJECT NO. 220A-01-02M**

Scale: 1"=40' Date: April, 2002

SHEET No. 8 OF 8 SHEETS

"AS-BUILT"