

SIGN REPLACEMENT, REMOVAL, AND INSTALLATION SCHEDULE										
STATION	LEFT	RIGHT	MILE POST	TYPE	SIGN TO REMAIN	REMOVE	INSTALL (10 SQ. FT. OR LESS)		DESTINATION SIGN PANEL (S.F.)	RM-3 WO/ POST
							W/POST	WO/POST		
Project No. 1416										
0+04 0+00		●	3.73	R2-1 (25)			1			1
1+09 1+07	●		3.70	W14-1		1	1			1
1+47		●	3.69	"Adopt -A--Highway"	2					2
4+40		●	3.64	W1-5 (R)/W13-1 (25)		1	1	1		1
Project No. A-220-01-61										
8+30		●	3.56	W1-8 (Bi-Directional)			1			
9+00		●	3.55	W1-8 (Bi-Directional)			1			
9+92 9+90		●	3.53	W1-8 (Bi-Directional)			1			
10+57 10+50		●	3.52	W1-8 (Bi-Directional)			1			
13+20	●		3.47	W1-8 (Bi-Directional)			1			
14+00	●		3.46	W1-8 (Bi-Directional)			1			
14+80	●		3.44	W1-8 (Bi-Directional)			1			
15+60	●		3.42	W1-8 (Bi-Directional)			1			
17+79 17+80		●	3.38	W5-3/W13-1 (10)		1	1	1		1
18+22 18+20	●		3.38	W1-2 (L)/W13-1 (25)/W14-3			1	2		1
18+75 18+80		●	3.36	W3-2a/W3-2a-A		1	1	1		1
20+36 20+40		●	3.33	RI-2		1	1			1
20+36 20+40		●	3.33	"TO ONCOMING TRAFFIC"		1		1		
24+27 24+26	●		3.26	W5-3/W13-1 (10)		1	1	1		1
35+00	●		3.23	R2-1 (25)			1			1
Project No. 1416										
1+25	●		3.05	R2-5b (25)			1			1
4+00		●	2.94	R2-5b (35) R2-1(45)			1			1
4+00	●		2.94	R2-5b (45) R2-1(35)			1			1
5+60	●	●	2.91	W1-5 (L)/W13-1 (35)			2	2		2
8+50	●		2.86	R2-5b (35)			1			1
12+10	●	●	2.79	D-2 (Elevation/1000ft/305m) (24"x20")		2			6.67	2
14+80	●		2.74	W1-2 (R)/W13-1 (35)			1	1		1
Project No. A-220-01-64										
46+40		●	2.14	W1-2 (L)/W13-1 (35)			1	1		1
55+40	●		1.97	W1-2 (R)/W13-1 (35)			1	1		1
58+00	●	●	1.92	R2-1 (45)			2			2

SIGN REPLACEMENT, REMOVAL, AND INSTALLATION SCHEDULE										
STATION	LEFT	RIGHT	MILE POST	TYPE	SIGN TO REMAIN	REMOVE	INSTALL (10 SQ. FT. OR LESS)		DESTINATION SIGN PANEL (S.F.)	RM-3 WO/ POST
							W/POST	WO/POST		
74+80		●	1.60	W1-2 (R) W13-1 (35)			1	1		1
84+80	●		1.42	W1-2 (R)/W13-1 (35)			1	1		1
95+00		●	1.22	R2-5B (35)			1			1
98+00		●	1.17	R2-1 (35)			1			1
101+67		●	1.10	R2-5B (25)	1					1
102+15	●	●	1.09	D-2 (Elevation/500ft/152m) (24"x20")		2			6.67	2
104+17 104+20		●	1.08 1.05	R2-1 (25)		1	1			1
104+20 104+25	●		1.05 1.08	R2-1 (45)		1	1			1
Project No. A-220-02-72										
25+20	●		1.06	W2-2/D3-2 (Stable Camp Rd.)			1	1		1
21+45		●	0.98	RI-1/D3-1 (Stable Camp Rd.)		2	1	1		1
17+50		●	0.91	W2-2/D3-2 (Stable Camp Rd.)			1	1		1
17+00		●	0.90	RI-1		1	1			1
11+28	●		0.79	W (Rumble Strips)		1	1			1
10+58 10+56	●		0.78	R2-1 (25)		1	1			1
6+47	●		0.70	W11-2/W13-1 (15)		2	1	1		1
5+59		●	0.68	RI-1/D3-1 (Kalani Lp.)		2	1	1		1
5+48	●		0.68	RI-1		1	1			1
3+27		●	0.64	RI-1/D3-1 (Kalani Lp.)		2	1	1		1
3+11	●		0.63	RI-1		1	1			1
1+32		●	0.60	R2-1 (25)		1	1			1
0+16	●		0.58	RI-1/D3-1 (Akaka Falls Rd.)		1	1	1		1
TOTALS					3	28	47	21	14	46
CONTRACT ITEM NUMBER							621.5100	621.5000	621.0200	621.4030

NOTE:

1. See sheet 18 for Sign Details and Notes.

LEGEND FOR AS-BUILT POSTINGS	
	Squiggly line for as-built deletion
	Double line for as-built deletion
Roadway	Text for as-built posting

STATE OF HAWAII
DEPARTMENT OF TRANSPORTATION
HIGHWAYS DIVISION

SIGN SCHEDULE

AKAKA FALLS ROAD RESURFACING
HONOMU TOWN TO AKAKA FALLS PARK
PROJECT NO. 220A-01-02M

Date: April, 2002

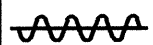
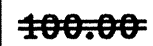
SHEET No. 1 OF 1 SHEETS

SURVEY PLOTTED BY	DATE
DRAWN BY	
TRACED BY	
NOTED BY	
CHECKED BY	
ORIGINAL PLAN	
NOTE BOOK	
REVISIONS	
NO. 1	

FED. ROAD DIST. NO.	STATE	PROJ. NO.	FISCAL YEAR	SHEET NO.	TOTAL SHEETS
HAWAII	HAW.	220A-01-02M	2002	21S-1	49

SIGN REPLACEMENT, REMOVAL, AND INSTALLATION SCHEDULE							
STATION	LEFT	RIGHT	MILE POST	TYPE	10 SQ. FT. OR LESS		RM-3 W/O POST
					W/POST	W/O POST	
Project No. A-220-01-64							
72+50		●	1.69	W5-2-A/"AHEAD"	1	1	1
75+85	●		1.62	W5-2-A/"END"	1	1	1
82+00		●	1.51	W5-2-A/"AHEAD"	1	1	1
83+50	●		1.48	W5-2-A/"END"	1	1	1

ORIGINAL PLAN	SURVEY PLOTTED BY	DATE
NOTE BOOK	DESIGNED BY	
BY PASS/ADCS	QUANTITIES BY	
N. 10/1/02	CHECKED BY	

LEGEND FOR AS-BUILT POSTINGS	
	Squiggly line for as-built deletion
	Double line for as-built deletion
Roadway	Text for as-built posting

STATE OF HAWAII
DEPARTMENT OF TRANSPORTATION
HIGHWAYS DIVISION

SIGN SCHEDULE

AKAKA FALLS ROAD RESURFACING
HONOMU TOWN TO AKAKA FALLS PARK
PROJECT NO. 220A-01-02M

Date: April, 2002

SHEET No. 1 OF 1 SHEETS

Note: This tracing prepared during "As-Built" posting.