

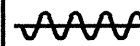
STRIPING AND PAVEMENT MARKING SCHEDULE

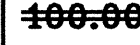
STATION	TRAFFIC REGIME		THERMOPLASTIC OR TAPE, TYPE (I), (II), or (III) (lin. ft.)															PAVEMENT MARKERS (EACH)						
			4" Double Yellow (I)	4" Double Yellow Guidelines (III)	4" Yellow (I)	12" Yellow Diagonal (II)	4" White E.P. Stripe (I)	4" White Stripe (II)	8" White Stripe (I)	8" White Stripe (II)	12" White Diagonal (II)	4" White Edge Line Extension (III)	4" White Guide Lines (III)	12" Stop Bar (III)	SOLID WHITE ARROW			SOLID WHITE WORDS (III)	A	C	D	H	J	FIRE HYDRANT MARKER
	Left (III)	Straight (III)													Right (III)									
(-) 1+09																								
20+43	N	N	2152				2804		1500										108	108				
OPEN	Pahee- hee Bridge					254							10						6					
21+70	N	N	1530				1560		1500										80	80				
37+00 0+19.63	Eq.Sta.																							
32+90	N	N	3270				6540												163	163				
40+00	N	N	710		710		1420												36	35 48	77	68		
	N	N	715		715		1430												38	36 49	77	68		
47+15.32 47+26.32	Eq.Sta.																							
79+30	N	N	3204				6408												160	160				
86+50	N	P			720		1440												36	18	17	68		
89+20	P	P					540												12	6		20		
96+40	P	N			720		1440												36	18	17	68		
	N	N	861				1722												42	42				
105+01.06 25+69.90	Eq.Sta.																							
21+40	N	N	430				860												22	22				
OPEN	Stable Camp Road		70				100						18						3					
21+00																			3	4				
16+87	N	N	413				826												20	20				
OPEN	Side Road		70				100						18						3					
16+47																			3	4				
5+77	N	N	1070				2140												54	54				

(Continued)

ORIGINAL PLAN	SURVEY PLOTTED BY	DATE
NOTED	DRAWN BY	
DESIGNED BY	TRACED BY	
CHECKED BY	DESIGNED BY	
	CHECKED BY	

LEGEND FOR AS-BUILT POSTINGS

 Squiggly line for as-built deletion

 Double line for as-built deletion

Roadway Text for as-built posting

STATE OF HAWAII
DEPARTMENT OF TRANSPORTATION
HIGHWAYS DIVISION

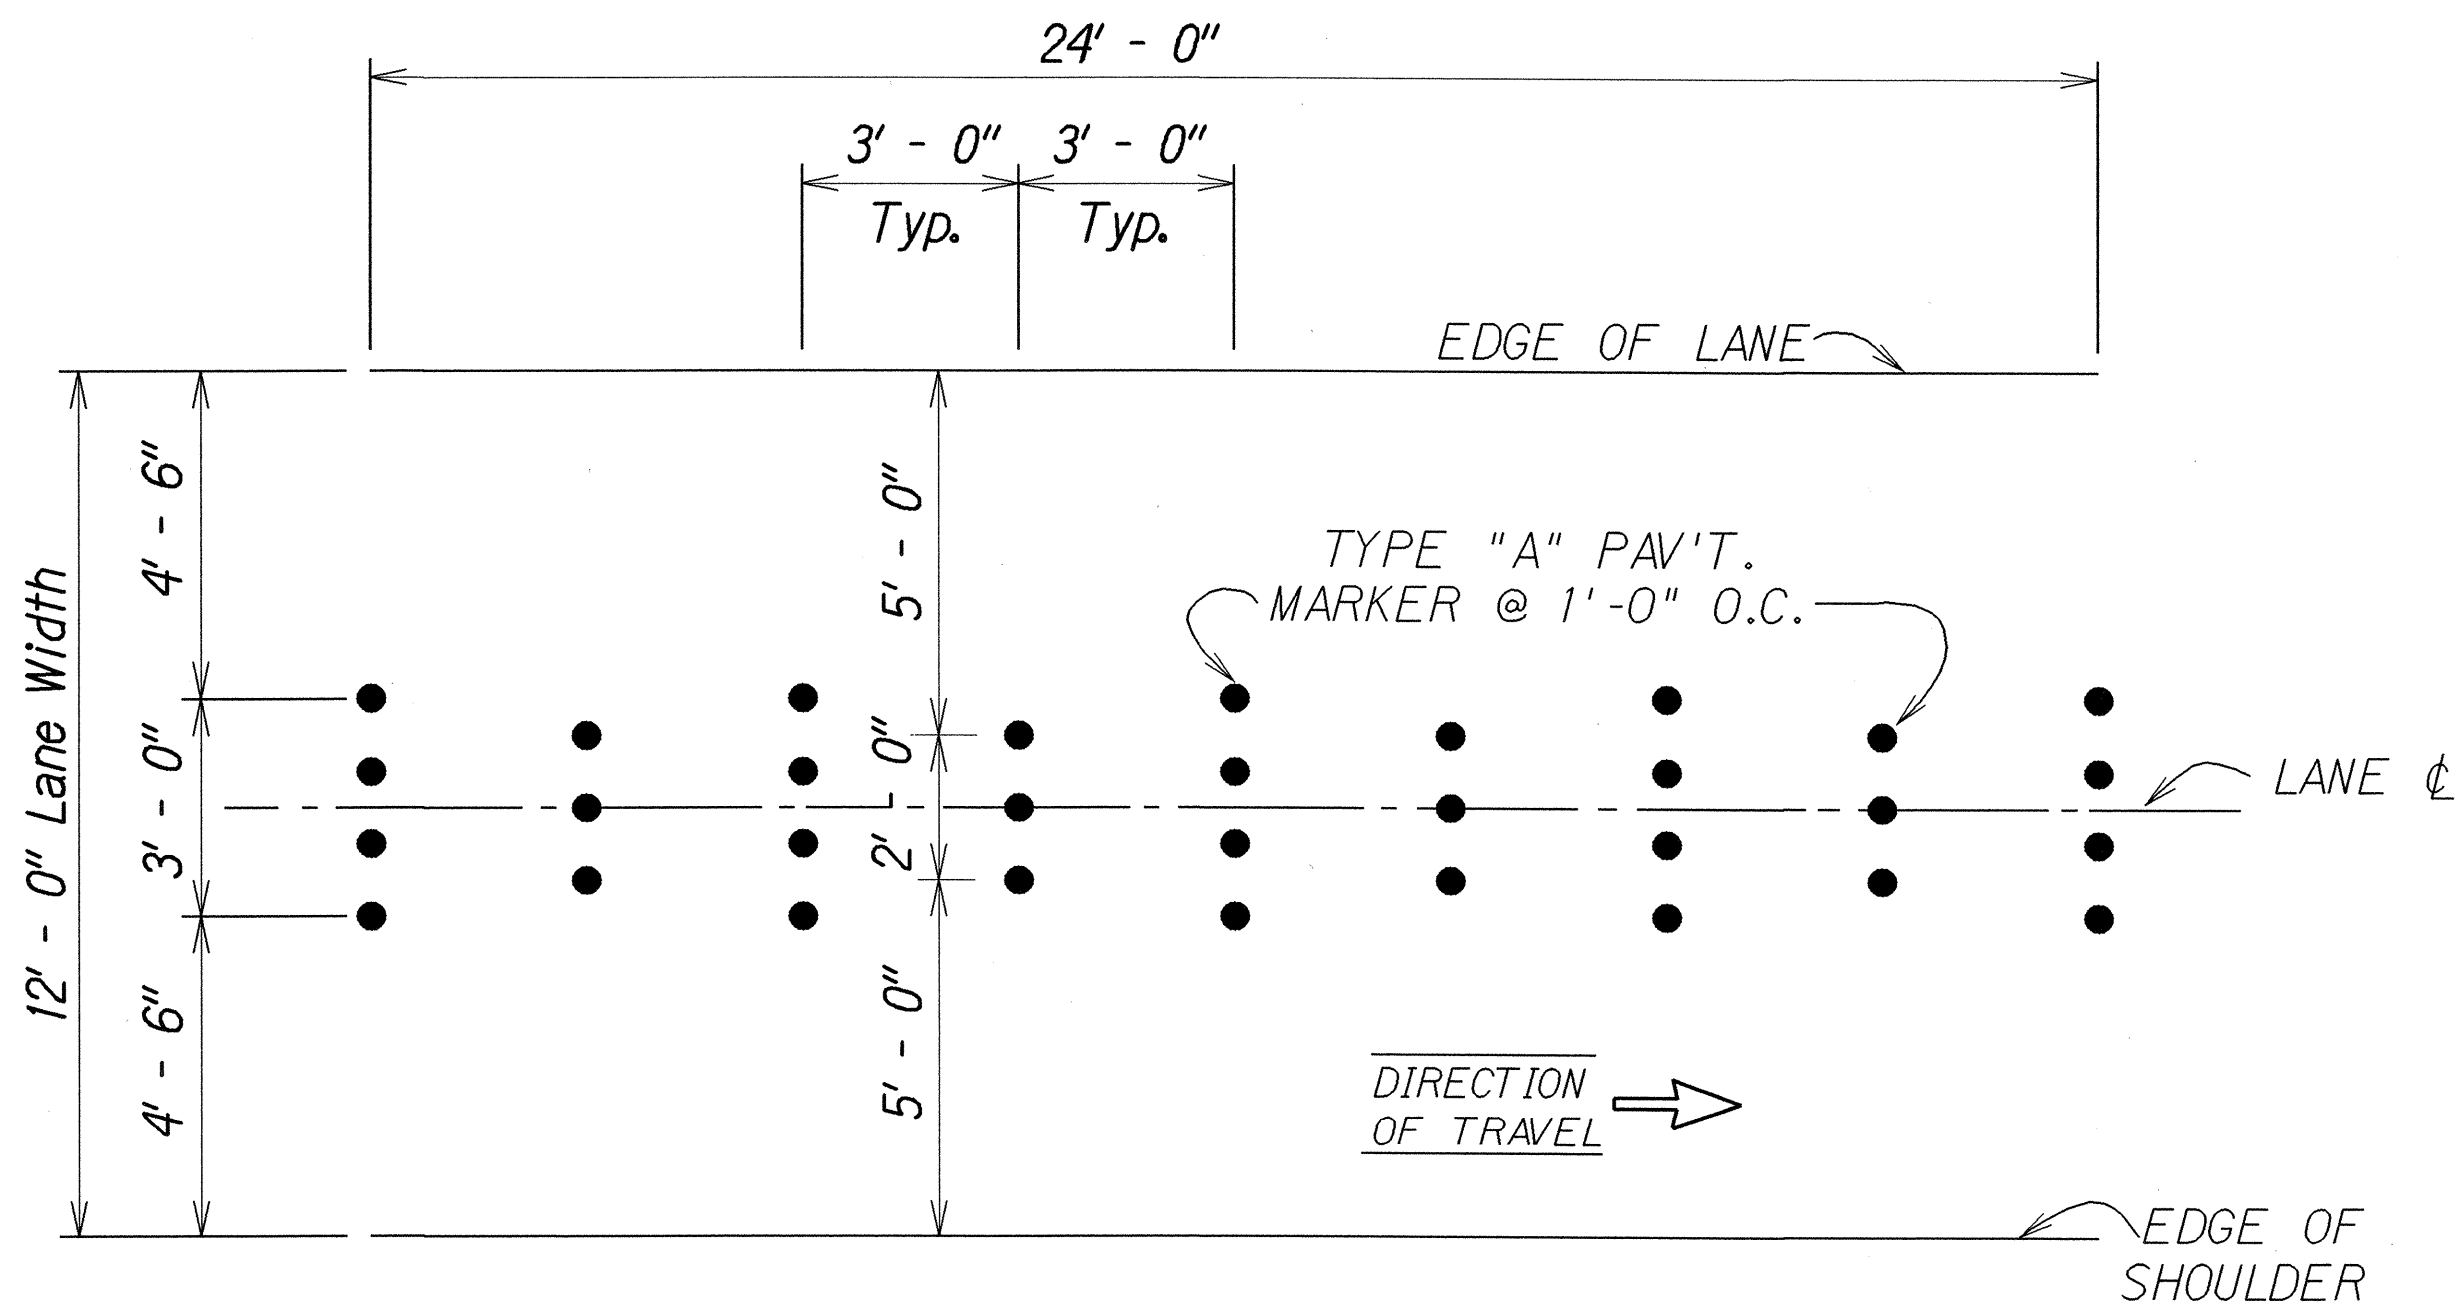
STRIPING AND PAVEMENT
MARKING SCHEDULE & DETAIL

AKAKA FALLS ROAD RESURFACING
HONOLULU TOWN TO AKAKA FALLS
PROJECT NO. 220A-01-02M

Scale: None Date: April, 2002

SHEET No. 1 OF 2 SHEETS

STRIPING AND PAVEMENT MARKING SCHEDULE																									
STATION	TRAFFIC REGIME		THERMOPLASTIC OR TAPE, TYPE (I), (II), or (III) (lin. ft.)															PAVEMENT MARKERS (EACH)							
			4" Double Yellow (I)	4" Double Yellow Guidelines (III)	4" Yellow ¢ (I)	12" Yellow Diagonal (II)	4" White E.P. Stripe (I)	4" White Stripe (II)	8" White Stripe (I)	8" White Stripe (II)	12" White Diagonal (II)	4" White Edge Line Extension (III)	4" White Guide Lines (III)	12" Stop Bar (III)	SOLID WHITE ARROW			SOLID WHITE WORDS (III)	A	C	D	H	J	FIRE HYDRANT MARKER	
	Left (III)	Straight (II)													Right (III)										
5+77	RIGHT	LEFT	Kalani Loop Side Rd	70				110						26						3					
OPEN																						3	4		
5+27	N	N		197				394												9	9				2
3+40	RIGHT	LEFT	Kalani Loop Side Rd	70				110						23						3					
OPEN																						3	4		
2+90	N	N		282				564						14						14	14				
0+08																									
TOTALS				15,114 13,689		1,440 2,865		30,762		3,000				109					128	860	838 767	34 68	156 292		2
CONTRACT ITEM NUMBER				629.1018		629.1011		629.1013		629.1014				629.1017					629.2010	629.2030	629.2040	629.2070	629.2080		



TYPICAL RUMBLE STRIP DETAIL
(12'-0" 2 LANE 2 WAY)
Not To Scale

LEGEND FOR AS-BUILT POSTINGS	
	Squiggly line for as-built deletion
	Double line for as-built deletion
Roadway	Text for as-built posting

STATE OF HAWAII
DEPARTMENT OF TRANSPORTATION
HIGHWAYS DIVISION

STRIPING AND PAVEMENT
MARKING SCHEDULE & DETAIL

AKAKA FALLS ROAD RESURFACING
HONOLULU TOWN TO AKAKA FALLS
PROJECT NO. 220A-01-02M

Scale: None Date: April, 2002

SHEET No. 2 OF 2 SHEETS

"AS-BUILT"