


SHEET NO.	INDEX TO DRAWINGS
DESCRIPTION	
1	TITLE SHEET
2	STANDARD PLANS SUMMARY
3	GENERAL NOTES
4-5	WATER POLLUTION AND EROSION CONTROL NOTES
6	TYPICAL SECTION AND DETAILS
7-14	ROADWAY PLANS
15	PAVEMENT MARKING LEGEND AND NOTES
16-17	STRIPING AND PAVEMENT MARKING SCHEDULE AND DETAIL
18	SIGN DETAILS AND NOTES
19-20	RECONSTRUCTION AREA SCHEDULE AND DETAILS
21 ①	SIGN SCHEDULE
22	CENTERLINE AND REFERENCE SURVEY MONUMENT SCHEDULE
23	CONSTRUCTION SIGN PLAN AND SCHEDULE
24	MISCELLANEOUS SCHEDULES
25-26	REFLECTOR AND OBJECT MARKER SCHEDULE
27	GUARDRAIL SCHEDULE
28	GUARDRAIL DETAILS AND NOTES
29-45	GUARDRAIL DETAILS
46-49	BRIDGE DETAILS



SHEET NO. ① 215-1 IS SUPPLEMENTAL TO THIS PROJECT. TOTAL SHEET COUNT AFTER "AS BUILT" POSTING IS 50 SHEETS.

APRIL 2002 DATE
933-8866 PHONE
ROBERT TAIRA P. S. & E. BY
DESIGNED BY

STATE OF HAWAII
DEPARTMENT OF TRANSPORTATION
HIGHWAYS DIVISION
HONOLULU, HAWAII
"AS-BUILT"
PLANS FOR
AKAKA FALLS ROAD RESURFACING
HONOMU TOWN TO AKAKA FALLS
PROJECT NO. 220A-01-02M
DISTRICT OF SOUTH HILO
ISLAND OF HAWAII

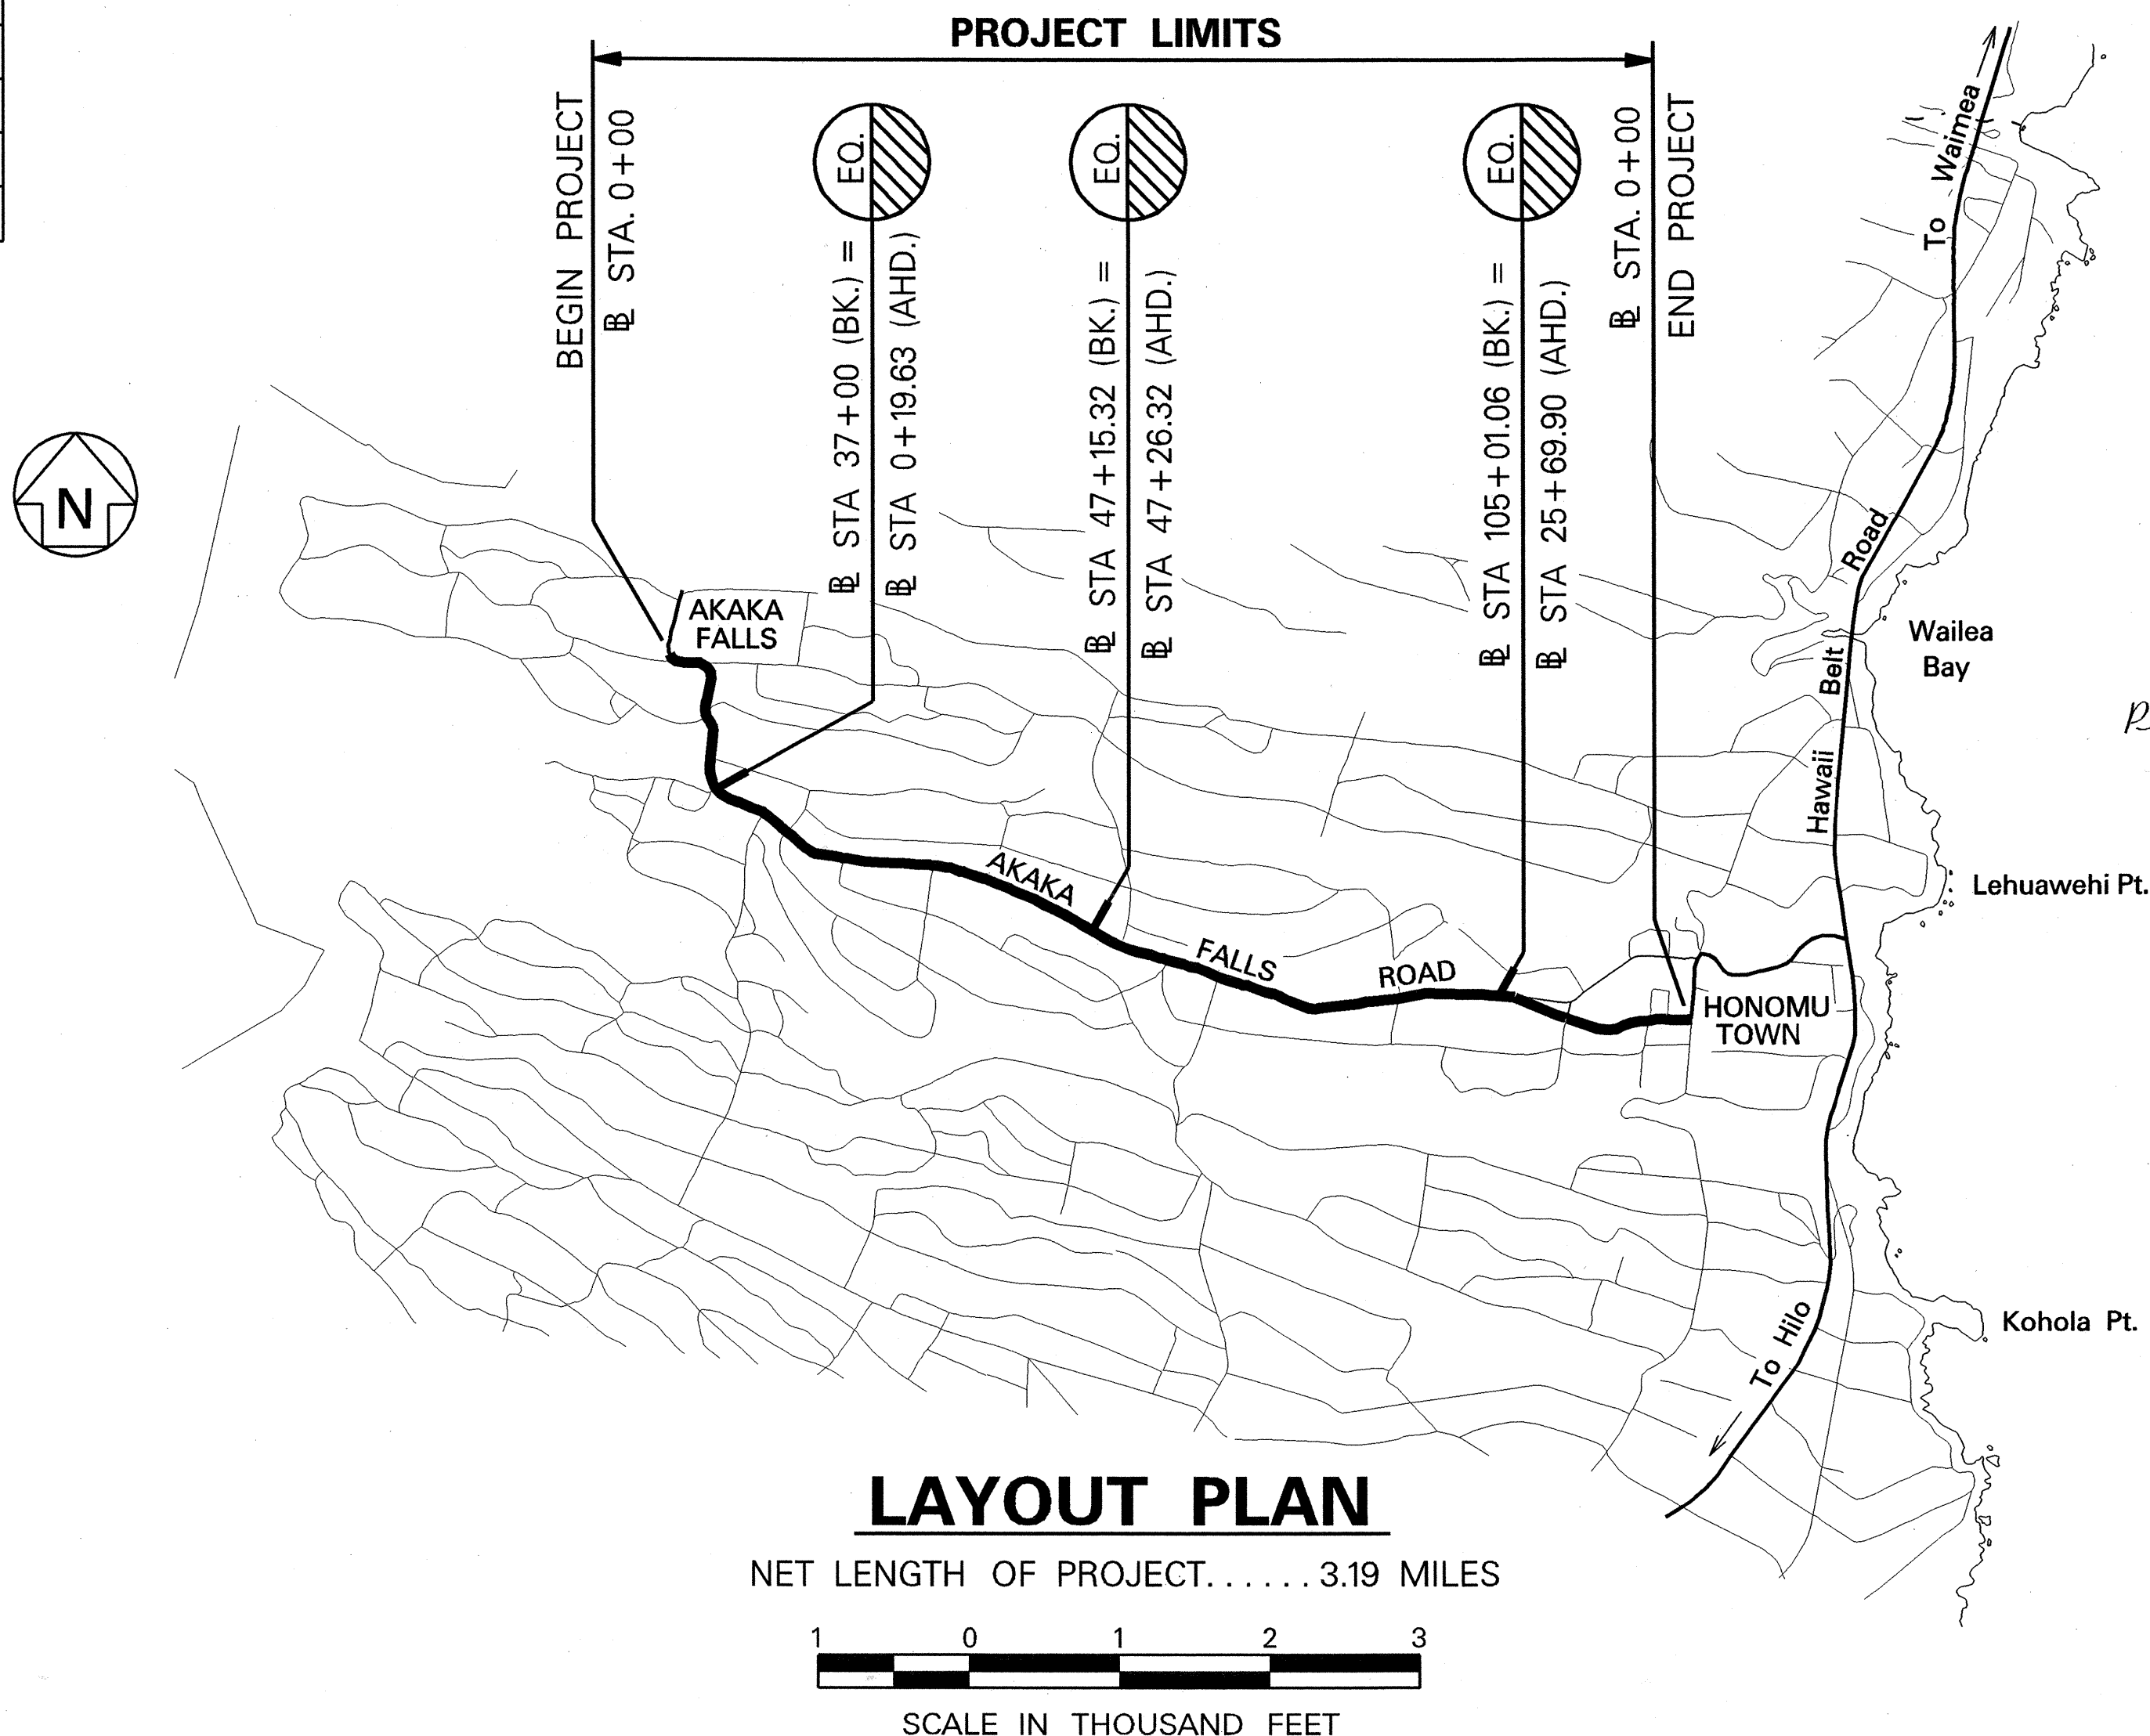

FED. ROAD DIST. NO.	STATE	PROJ. NO.	FISCAL YEAR	SHEET NO.	TOTAL SHEETS
HAWAII	HAW.	220A-01-02M	2002	1	49

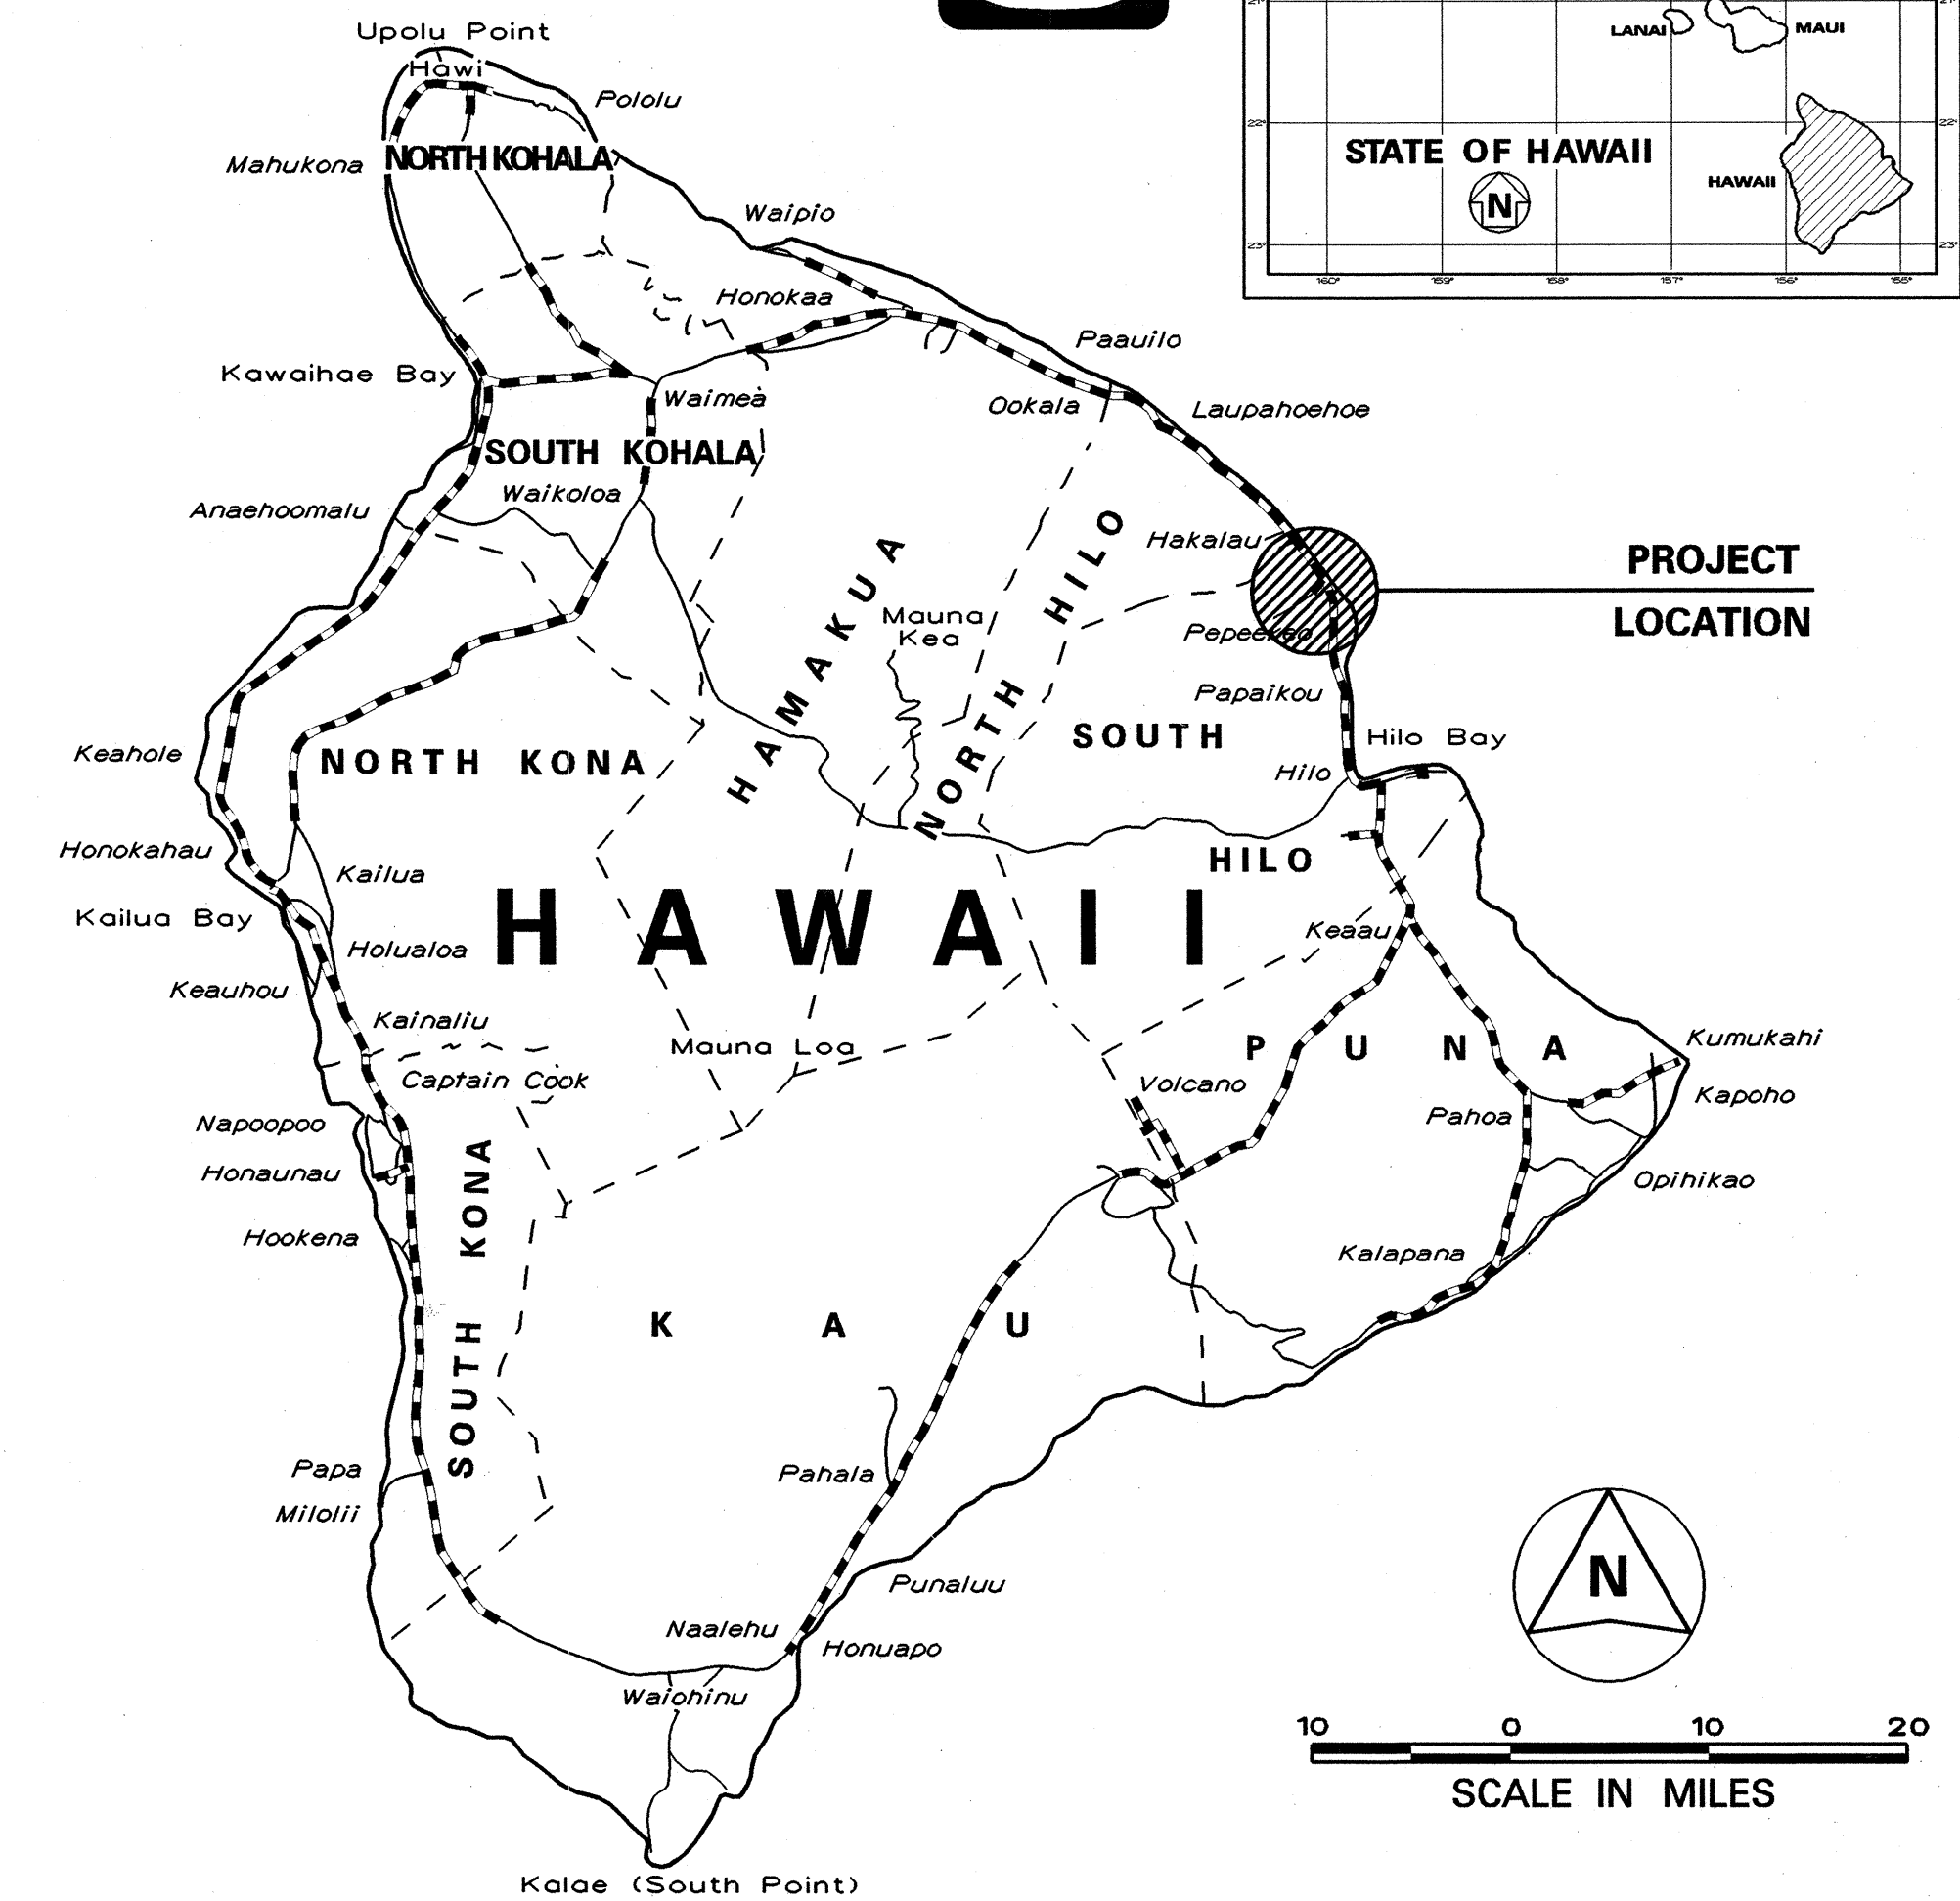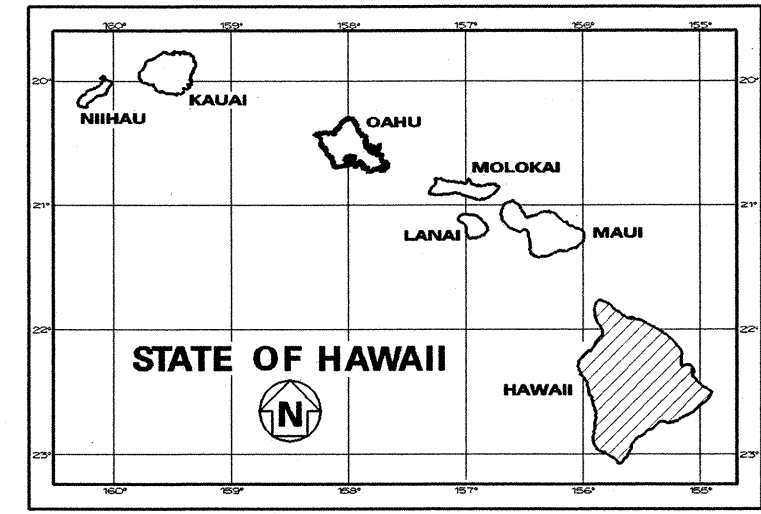

FEDERAL AID PROJECTS PREVIOUSLY CONSTRUCTED OR UNDER CONSTRUCTION

MILE POST 0.58 TO MILE POST 3.77

CHANGES MADE DURING CONSTRUCTION HAVE BEEN INCORPORATED ON THESE PLANS EXCEPT CHANGES IN THE ORIGINAL THEORETICAL QUANTITIES. FOR ACTUAL QUANTITIES, REFER TO PROJECT LEDGER AND/OR CONSTRUCTION LOG.

21- J.L. Chen 12-24-05
IN DATE

DEPARTMENT OF TRANSPORTATION
STATE OF HAWAII

APPROVED: *[Signature]* 4.26.02
IN DIR. OF TRANSPORTATION DATE