


ROAD DIST. NO.	STATE	PROJECT NUMBER	FISCAL YEAR	SHEET NO.	TOTAL SHEETS
HAWAII	HAW.	220A-01-03M	2003	12	37

GUARDRAIL SCHEDULE					
STATION		OFFSET FROM RD. C		GUARDRAIL TYPE	REMARKS
FROM	TO	LEFT	RIGHT		
<del>3+11</del> 2+77	<del>3+18.5</del> 3+14.5		●	End treatment, Type Fleat-350	Guardrail 1
<del>3+18.5</del> 3+14.5	<del>3+83.5</del> 4+14.5		●	Type 3 - Strong Post w-Beam	Guardrail 1
<del>3+83.5</del> 4+14.5	<del>4+21</del> 4+27.0		●	End treatment, Type <del>Fleat-350</del> G1-1d	Guardrail 1
3+64	3+71	●		Terminal Section, Type G1-1d	Guardrail 2
3+71	<del>4+25.5</del> 6+71.0	●		Type 3 - Strong Post w-Beam	Guardrail 2
<del>4+25.5</del> 6+71.0	<del>4+63</del> 6+90.0	●		End treatment, Type <del>Fleat-350</del> G1-1d	Guardrail 2
<del>8+17</del> 7+44.5	<del>8+54.5</del> 7+57.0	●		End treatment, Type <del>Fleat-350</del> G1-1d	Guardrail 3
<del>8+54.5</del> 7+57.0	8+82	●		Type 3 - Strong Post w-Beam	Guardrail 3
8+82	<del>8+89</del> 8+92.0	●		Terminal Section, Type G1-1d	Guardrail 3
<del>12+67</del> 12+68.0	<del>12+74</del> 12+80.0	●		Terminal Section, Type G1-1d	Guardrail 4
<del>12+74</del> 12+80.0	<del>14+00.5</del> 14+05.0	●		Type 3 - Strong Post w-Beam	Guardrail 4
<del>14+00.5</del> 14+05.0	<del>14+38</del> 14+43.0	●		End treatment, Type Fleat-350	Guardrail 4

GUARDRAIL TOTALS		
Item No.	Pay Item	Estimated Qty.
606.3111	Type 3 - Strong Post W-Beam	<del>246</del> L.F. 650
606.3113	End Treatment, Type FLEAT-350 ( <sup>2</sup> / <sub>5</sub> Each)	<del>187.5</del> L.F. 75.0
606.3114	Terminal Section, Type G1-1d ( <sup>6</sup> / <sub>3</sub> Each)	<del>37.5</del> L.F. 75.0

ORIGINAL PLAN	SURVEY PLOTTED BY	DATE
NOTE BOOK	DRAWN BY	
No.	DESIGNED BY	
	QUANTITIES BY	
	CHECKED BY	

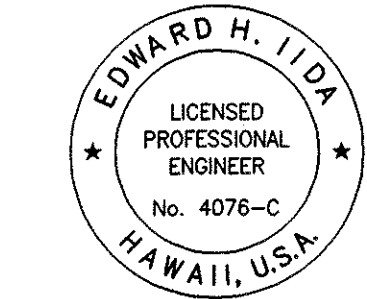

THIS WORK WAS PREPARED BY ME OR  
UNDER MY SUPERVISION  
*Edward H. Iida*  
MITSUNAGA & ASSOCIATES

STATE OF HAWAII DEPARTMENT OF TRANSPORTATION HIGHWAYS DIVISION
<b>GUARDRAIL SCHEDULE</b>
<b>AKAKA FALLS ROAD RESURFACING</b> <b>Hawaii Belt Road to Honouliuli Town</b> <b>Project No. 220A-01-03M</b>
Scale: As Noted      Date: April 2003
SHEET No. 1 OF 1 SHEETS

"AS-BUILT"