


ROAD DIST. NO.	STATE	PROJECT NUMBER	FISCAL YEAR	SHEET NO.	TOTAL SHEETS
HAWAII	HAW.	220A-01-03M	2003	19	37

REFLECTOR AND OBJECT MARKER SCHEDULE												
STATION		LEFT	RIGHT	RM-2 (White)			RM-3 (Yellow)		RM-3 (Bi-dir) (Yellow)		TYPE II	REMARKS
FROM	TO			STEEL POST	FLEX POST	W/OUT POST	FLEX POST	W/OUT POST	FLEX POST	W/OUT POST	W/OUT POST	
MAMALAHOA HIGHWAY												
0+72	0+72		●						2			Fire Hydrant
1+04	1+04		●								1	Utility Pole
1+75	1+75	●									1	Utility Pole
2+51	2+51		●								1	Telephone Pole
2+64	2+64		●		1							Drainage Structure
3+32	3+32	●									1	Utility Pole
4+18	4+18	●	✕								2	Telephone Pole, Electrical Pole
4+65	4+65	●	●						2			Hydrant
4+95	4+95	●									1	Utility Pole
6+16	6+16		●								1	Utility Pole
6+60	6+60	●									1	Utility Pole
7+64	7+64		●								1	Utility Pole
7+70	7+70	●									1	Utility Pole
8+21	8+21	●							2			Fire Hydrant
9+00	9+00		●								1	Utility Pole
9+18	9+18										1	Telephone Pole
HONOMU ROAD												
1+60	3+10	●	●				3				2	Horizontal Curve, Utility Poles
3+13	4+33		●		2				≠2		≠	Guardrail, Utility Poles
3+65	4+60	●			≠5				1			Guardrail
4+96	4+96	●									≠2	Utility Pole
5+06	6+00	●							≠			Horizontal Curve
6+04	6+04		●								≠2	Utility Pole
6+10	6+10		●						2			Hydrant
6+60	6+60	●									1	Utility Pole
6+90	6+90								1			Guardrail
7+64	7+64		●						1		1	Utility Pole, Guardrail
7+70	7+70	●									≠	Utility Pole
8+17	8+90	●			2						2	Guardrail, Utility Poles
8+73	8+73		●						≠2			Drainage Structure, Guardrail
9+00	9+00	●									1	Utility Pole
9+18	9+18		●								1	Utility Pole
12+67	14+38	●			≠3				1			Guardrail
12+75	12+75		●						1			Drainage Structure
TOTALS				--	12	--	3	--	11	--	25	
CONTRACT ITEM NUMBER					621.4145		621.4140		621.4130		621.4010	

ORIGINAL PLAN	SURVEY PLOTTED BY	DATE
NOTE BOOK	DRAWN BY	
No.	DESIGNED BY	
	QUANTITIES BY	
	CHECKED BY	

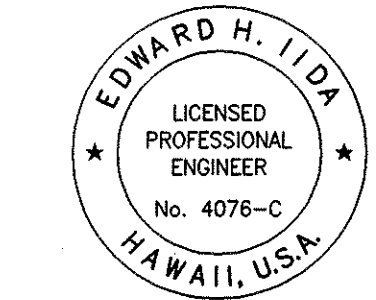

THIS WORK WAS PREPARED BY ME OR UNDER MY SUPERVISION
Edward H. Iida
MITSUNAGA & ASSOCIATES

STATE OF HAWAII
DEPARTMENT OF TRANSPORTATION
HIGHWAYS DIVISION
**REFLECTOR AND OBJECT
MARKER SCHEDULE**
AKAKA FALLS ROAD RESURFACING
Hawaii Belt Road to Honomu Town
Project No. 220A-01-03M
Scale: As Noted Date: April 2003

SHEET No. 1 OF 1 SHEETS

"AS-BUILT"