



ROAD DIST. NO.	STATE	PROJECT NUMBER	FISCAL YEAR	SHEET NO.	TOTAL SHEETS
HAWAII	HAW.	220A-01-03M	2003	8	37

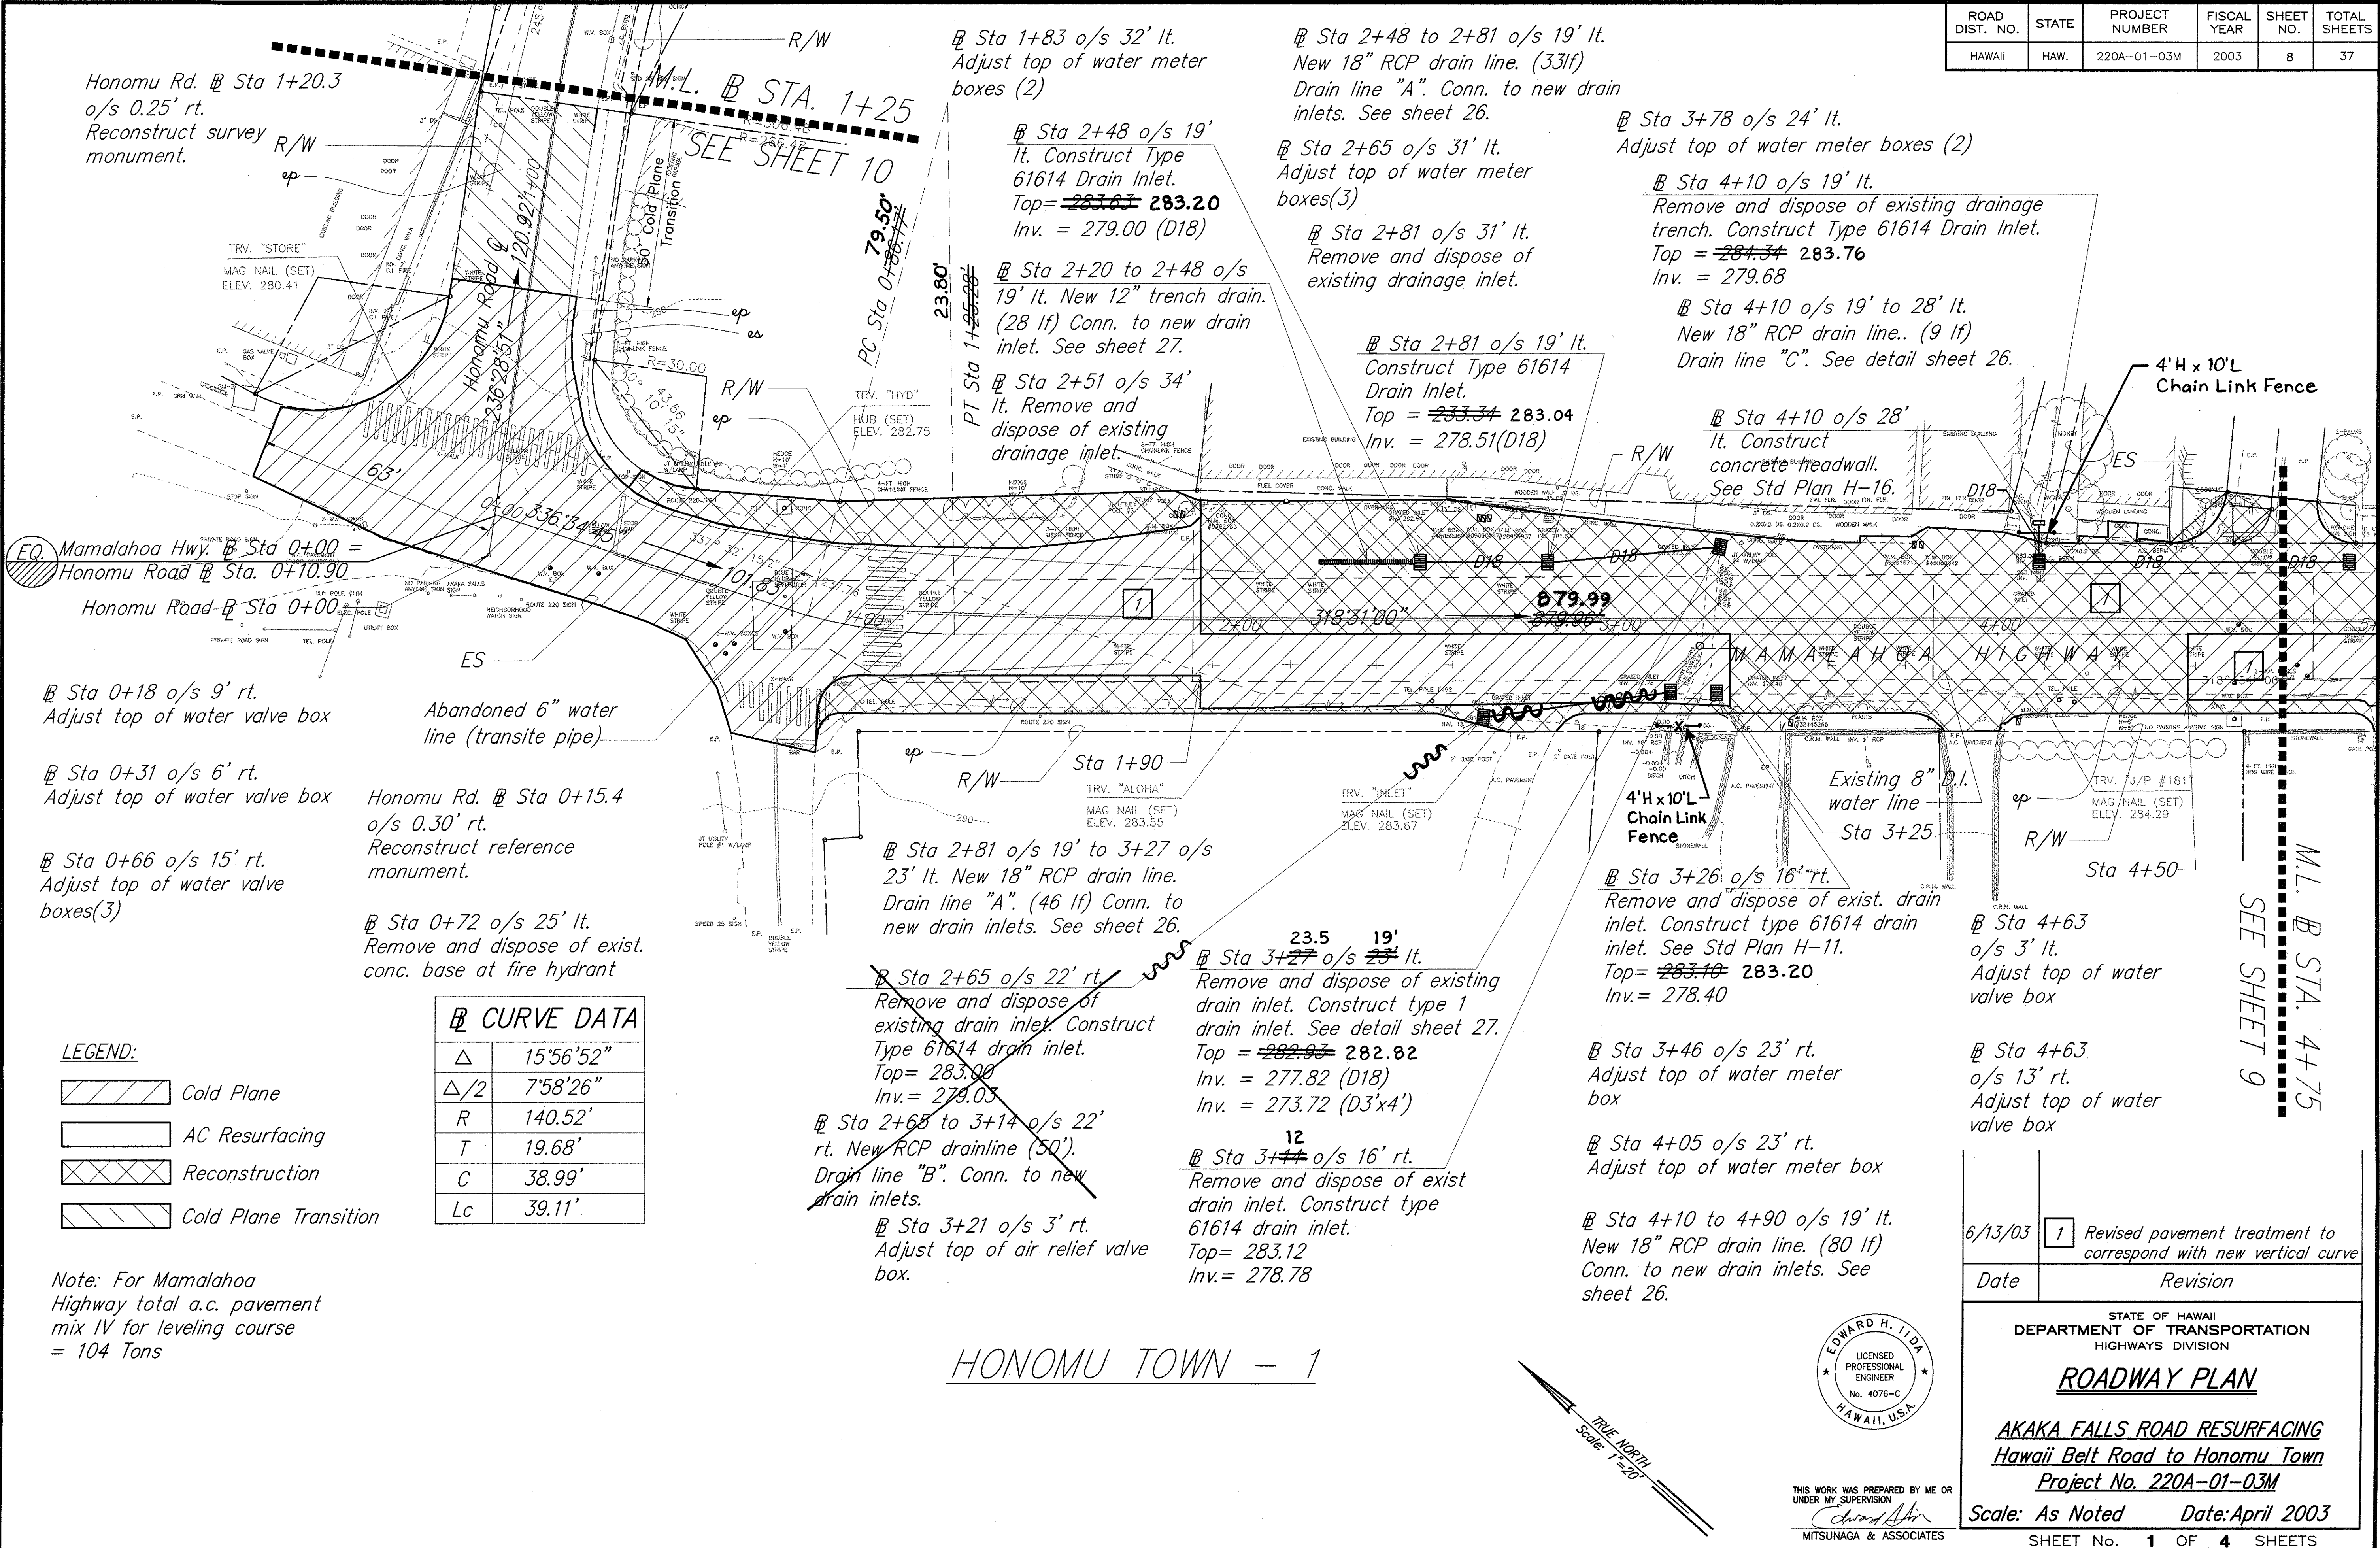

ROAD DIST. NO.	STATE	PROJECT NUMBER	FISCAL YEAR	SHEET NO.	TOTAL SHEETS
HAWAII	HAW.	220A-01-03M	2003	9	37

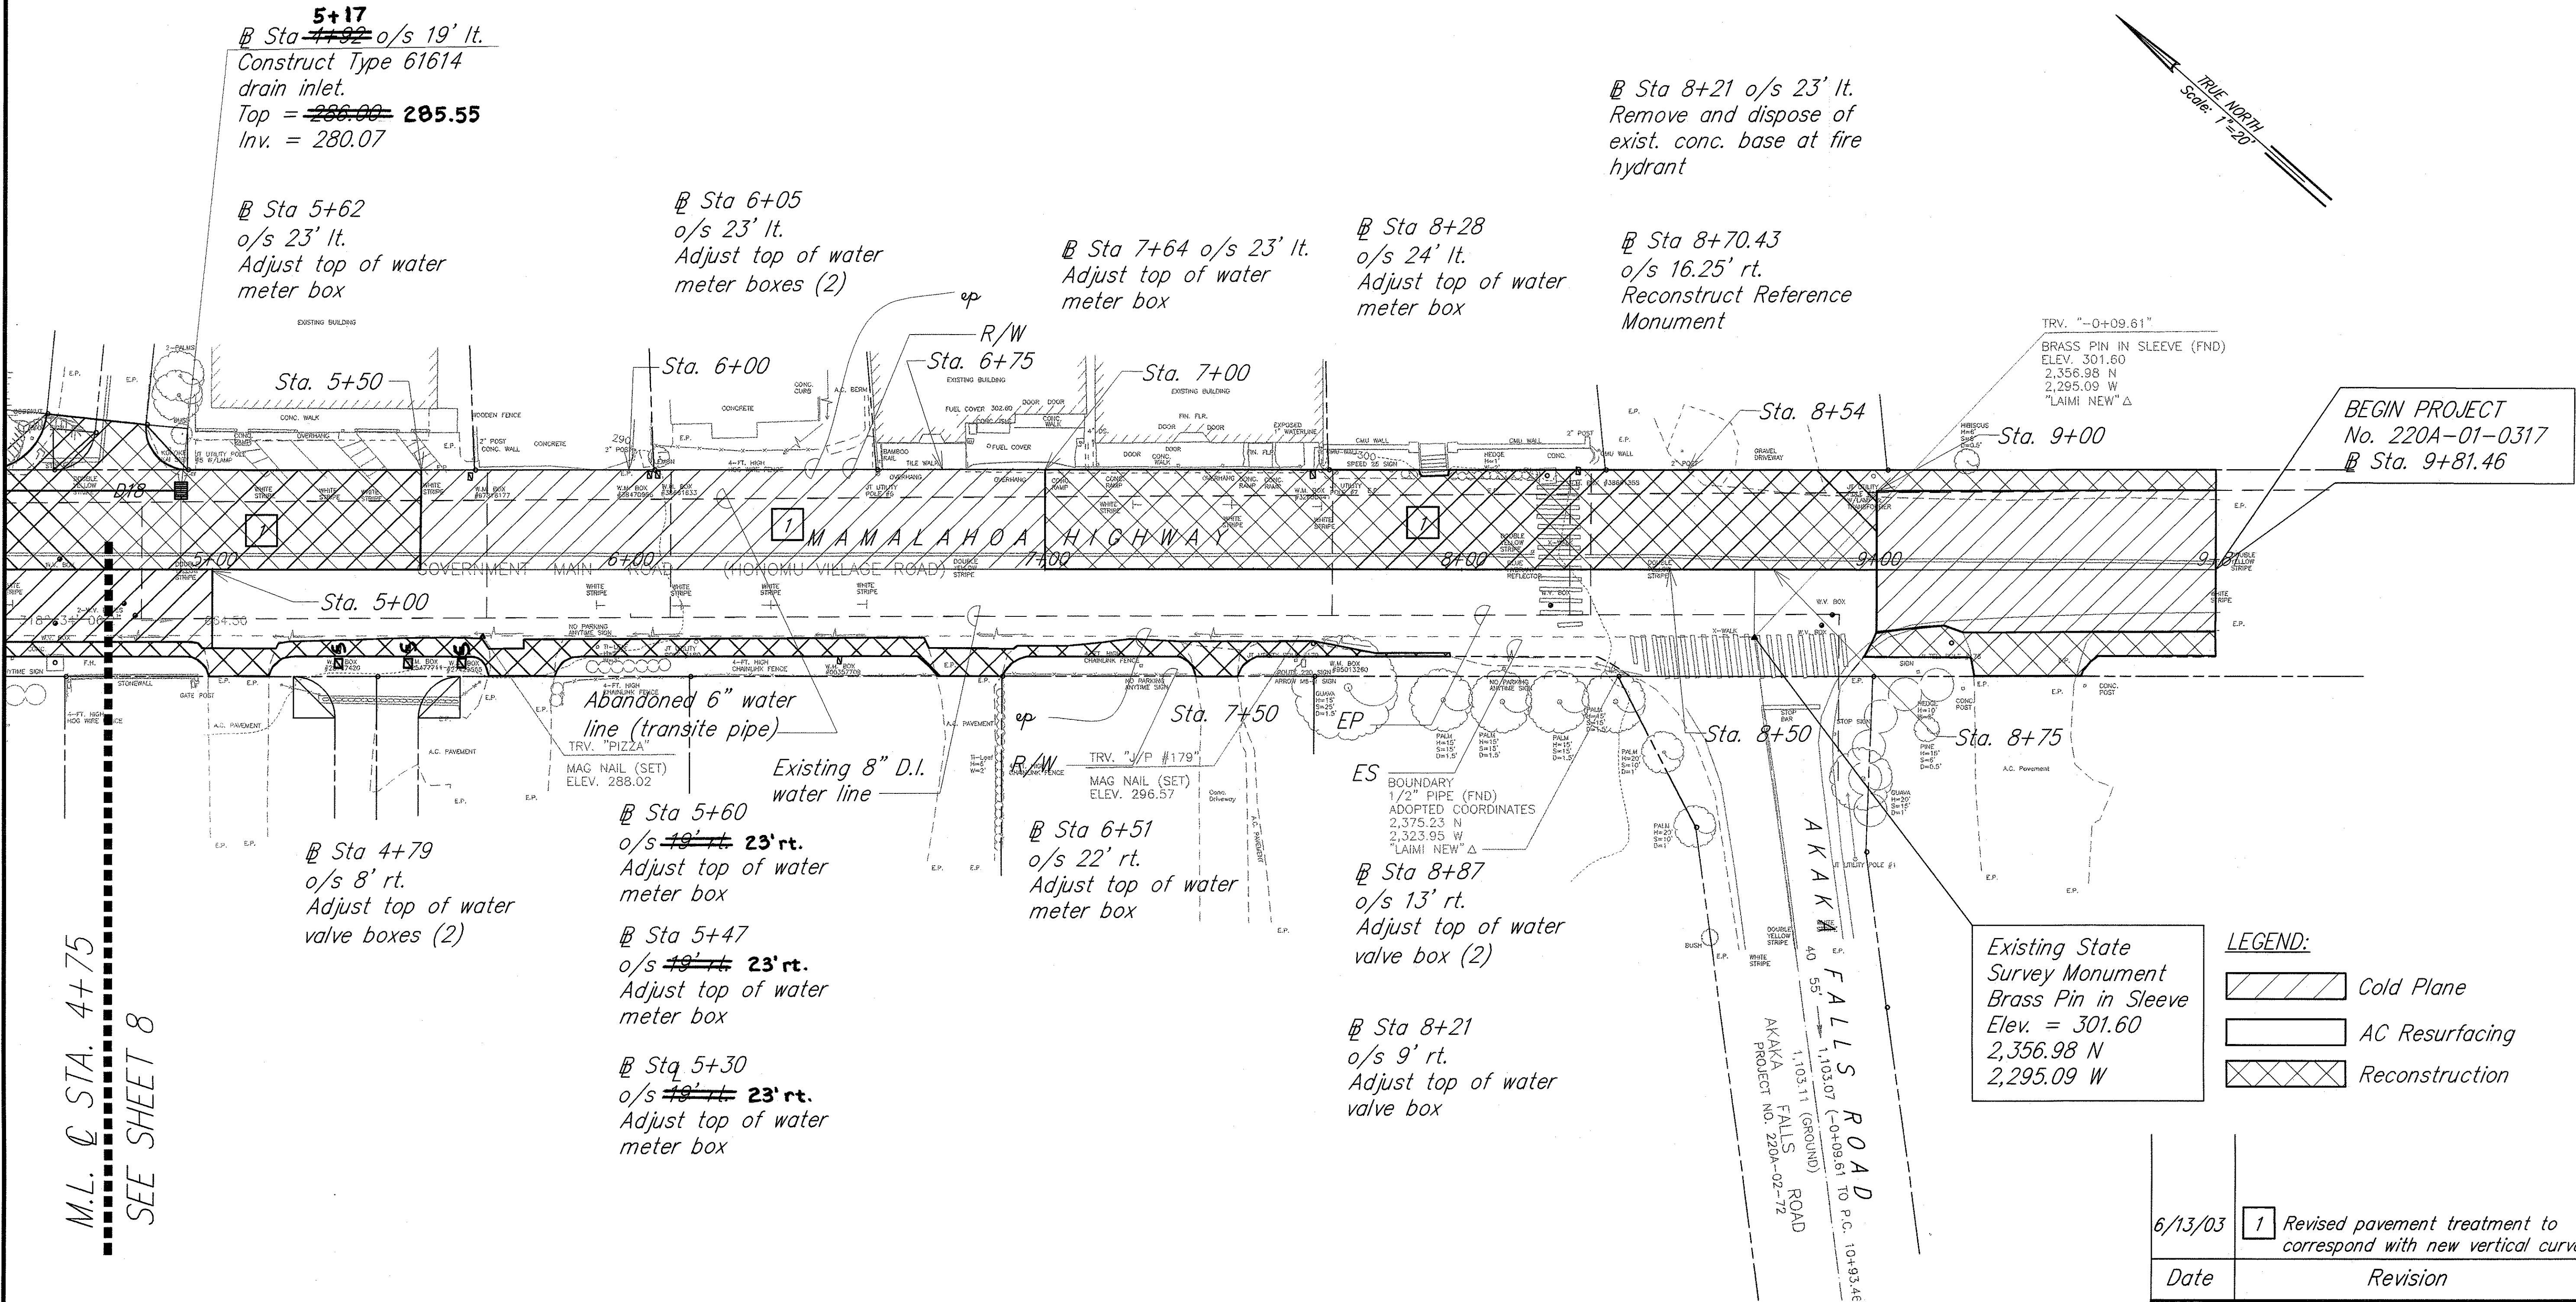

ORIGINAL PLAN	DATE
NOTED BY	
DESIGNED BY	
CHECKED BY	
NO.	



M.L. STA. 4+75
SEE SHEET 8

HONOLULU TOWN - 2


"AS-BUILT"

ADD. 9

ROAD DIST. NO.	STATE	PROJECT NUMBER	FISCAL YEAR	SHEET NO.	TOTAL SHEETS
HAWAII	HAW.	220A-01-03M	2003	10	37

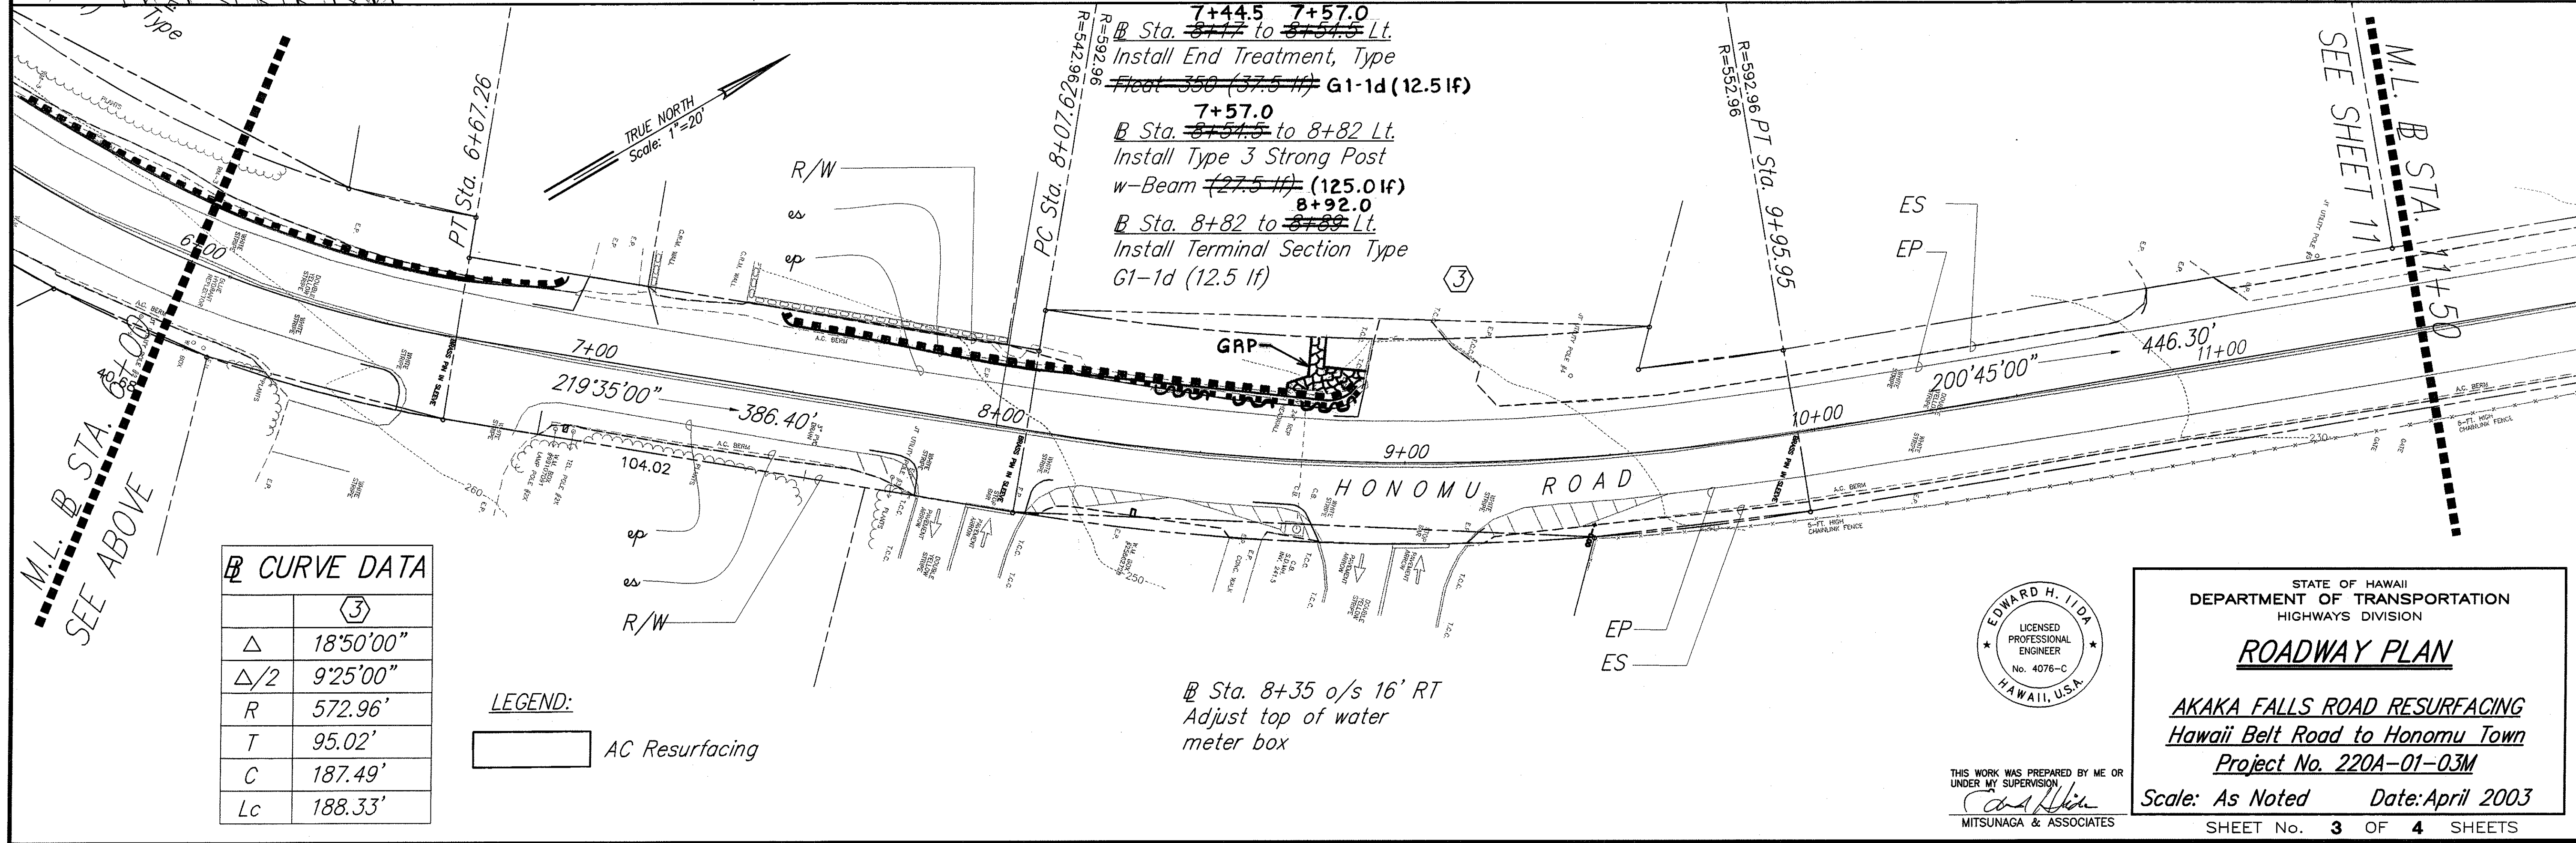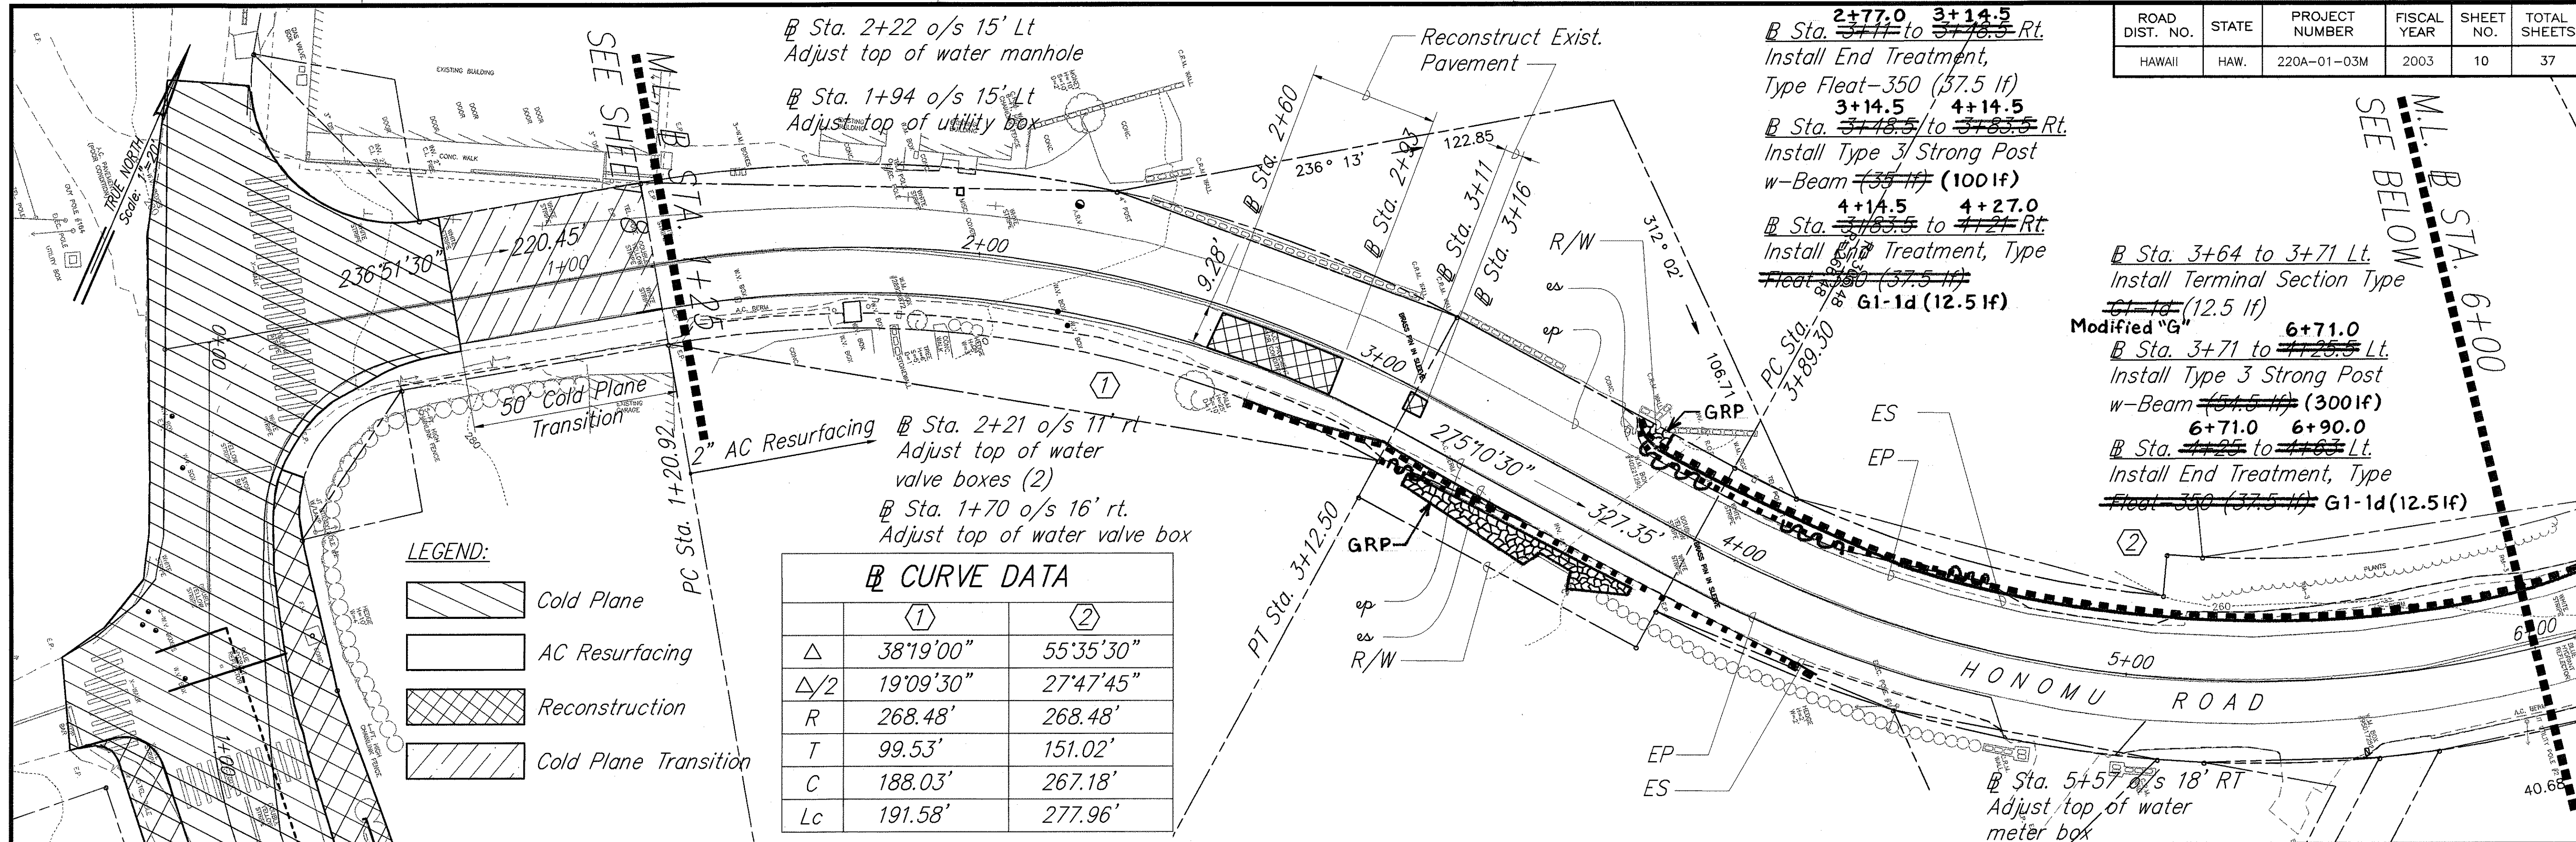

SURVEY PLOTTED BY	DATE
DRAWN BY	
DESIGNED BY	
QUANTITIES BY	
CHECKED BY	
ORIGINAL PLAN	
NOTE BOOK	
No.	

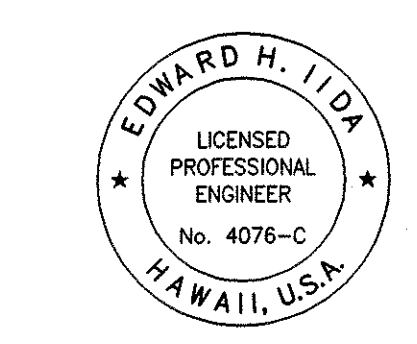

STATE OF HAWAII
DEPARTMENT OF TRANSPORTATION
HIGHWAYS DIVISION

ROADWAY PLAN



AKAKA FALLS ROAD RESURFACING
Hawaii Belt Road to Hononu Town
Project No. 220A-01-03M

Scale: As Noted Date: April 2003


SHEET No. 3 OF 4 SHEETS

"AS-BUILT"

ROAD DIST. NO.	STATE	PROJECT NUMBER	FISCAL YEAR	SHEET NO.	TOTAL SHEETS
HAWAII	HAW.	220A-01-03M	2003	11	37

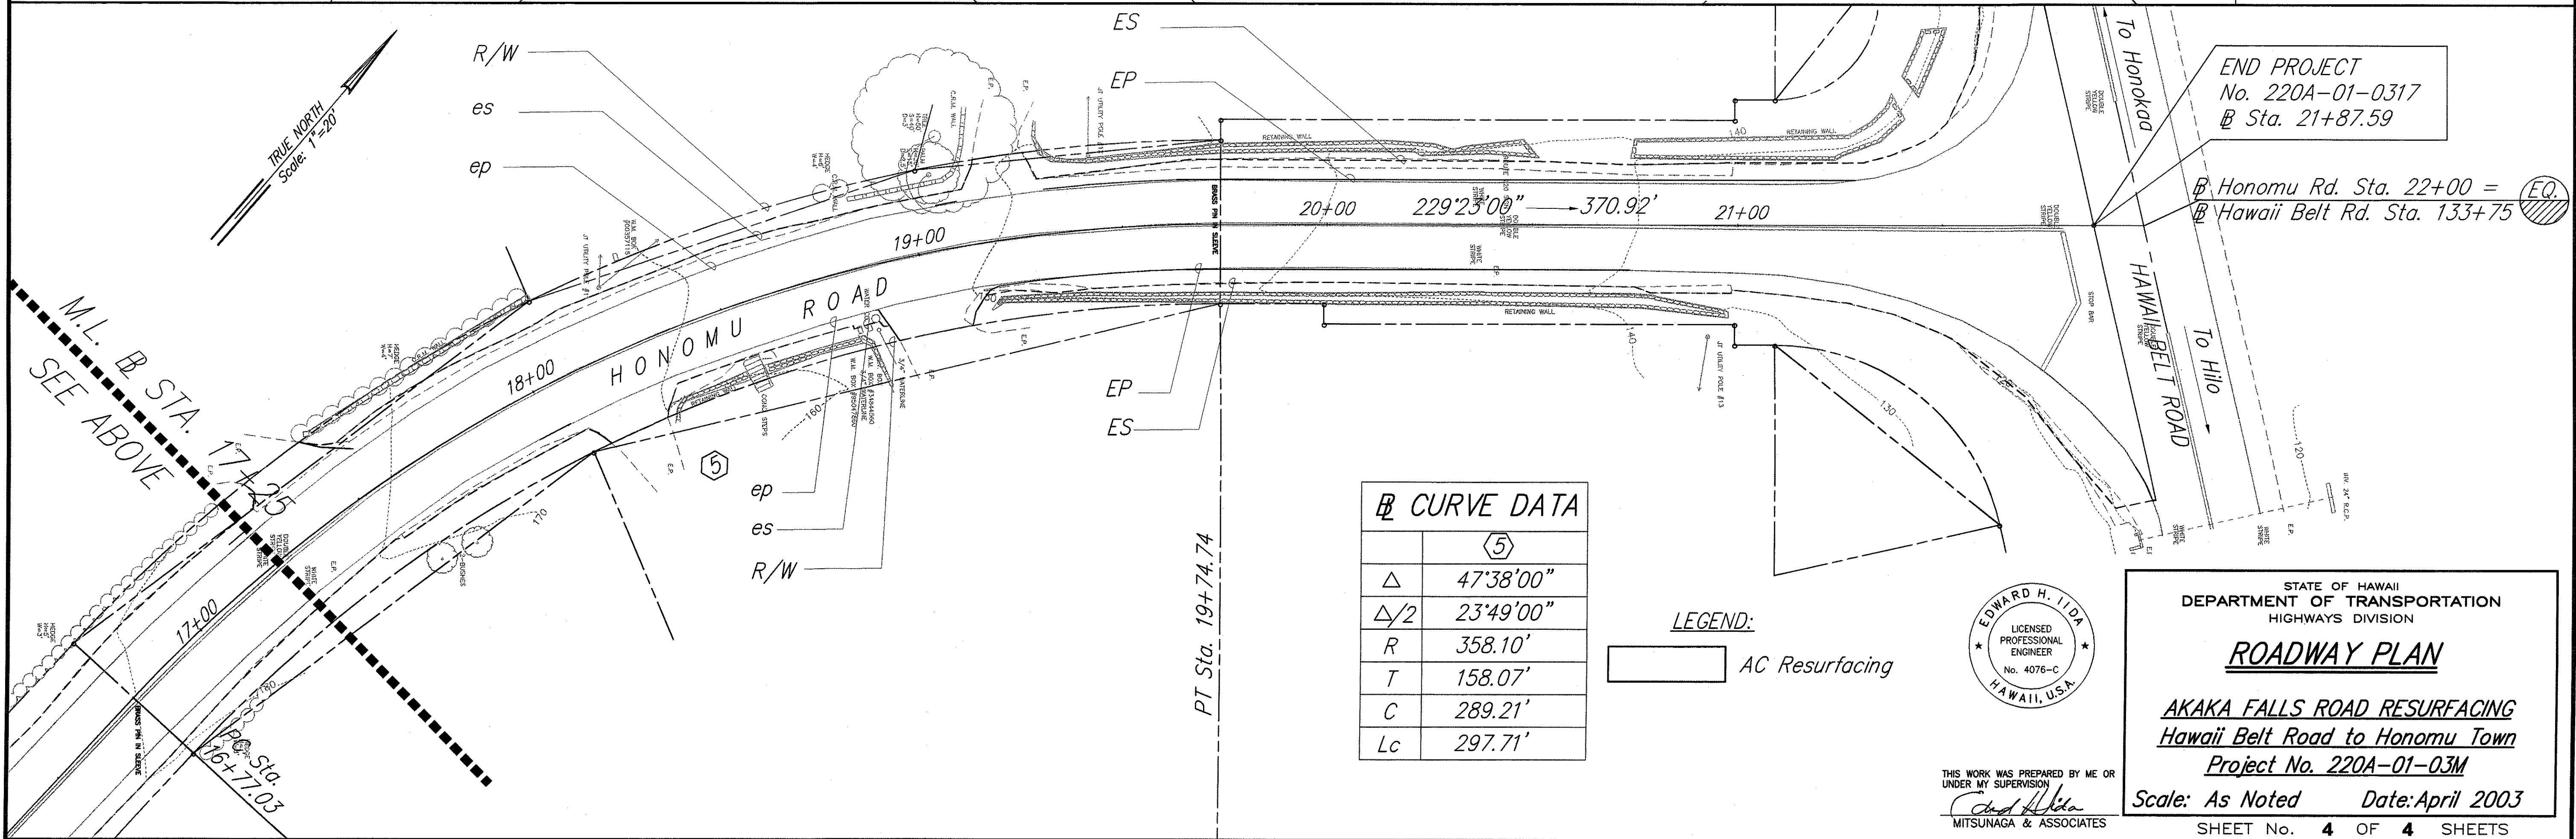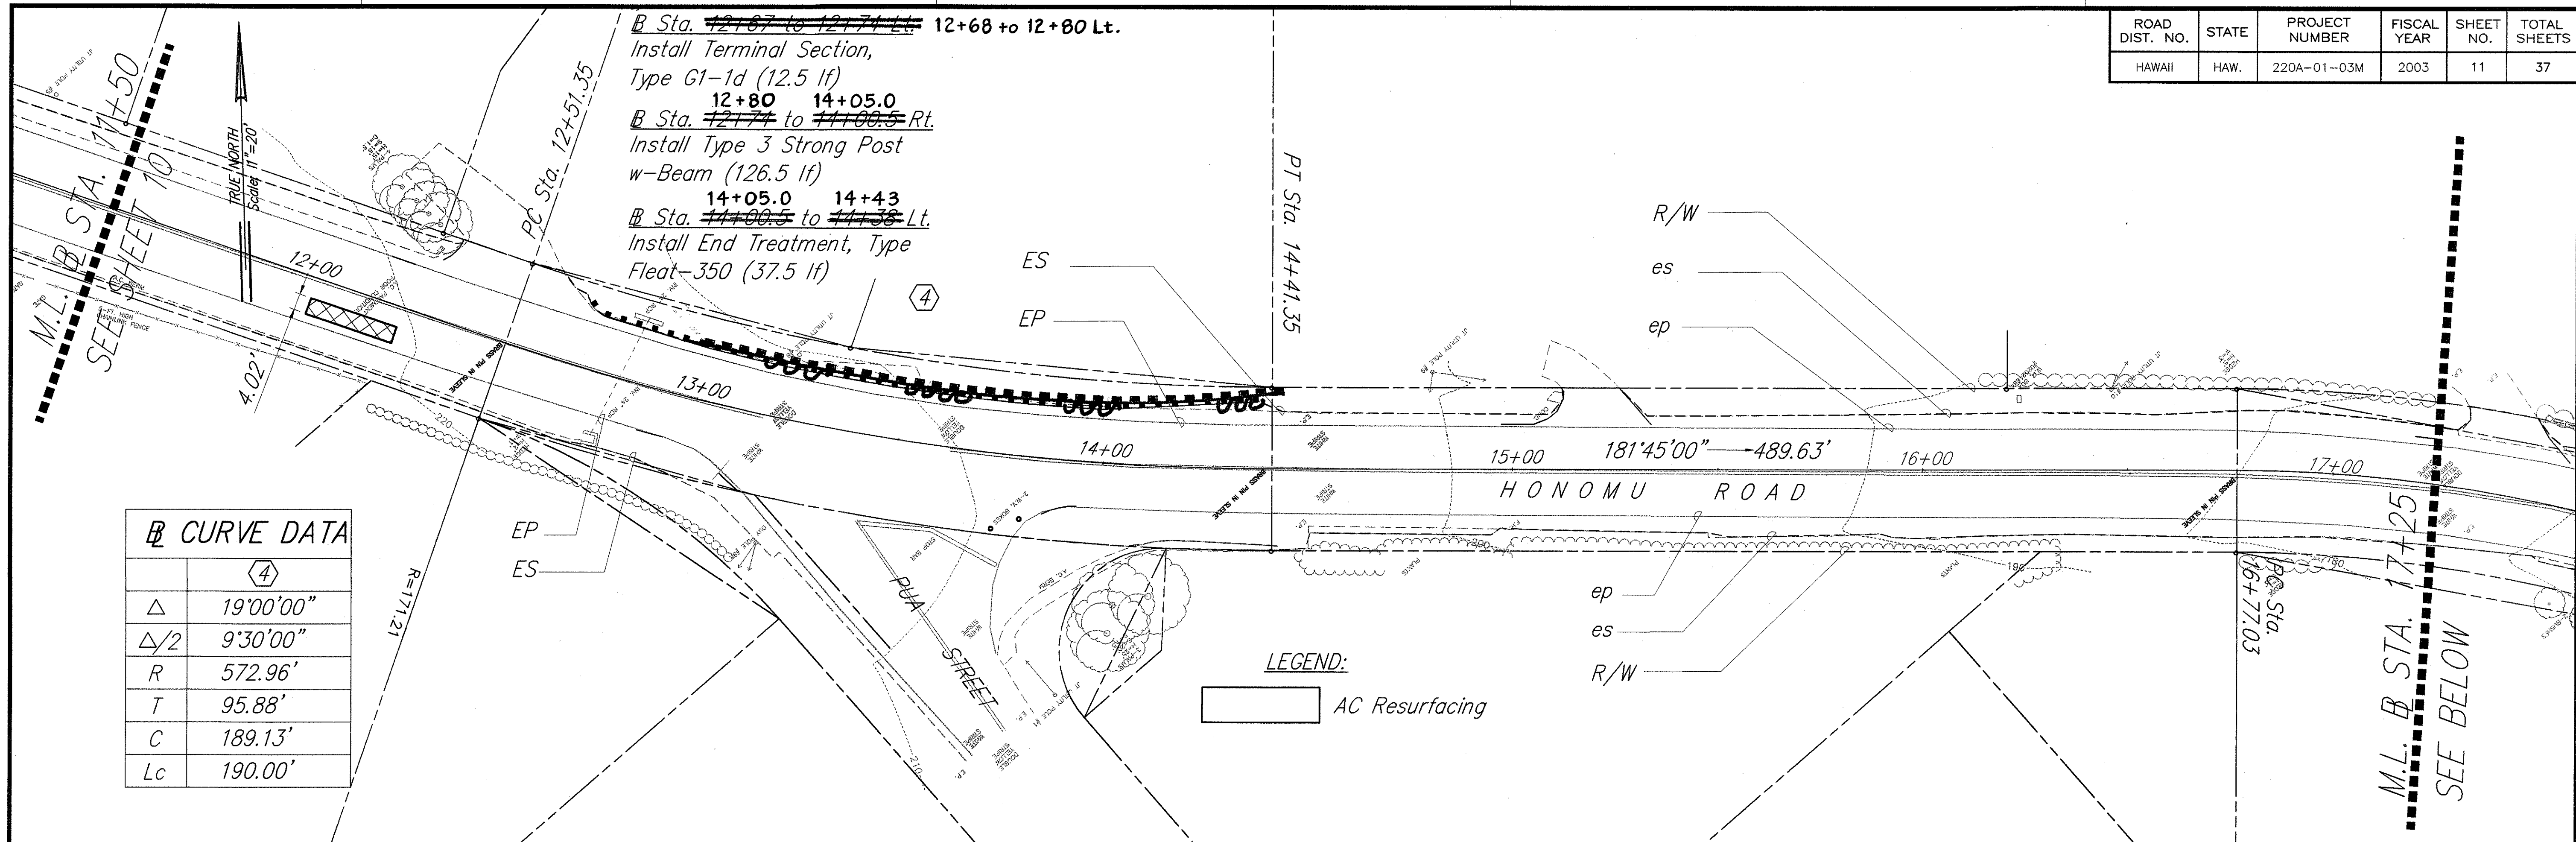

DATE	
DESIGNED BY	
CHECKED BY	
NOTED BY	
ORIGINAL PLAN	
NO.	

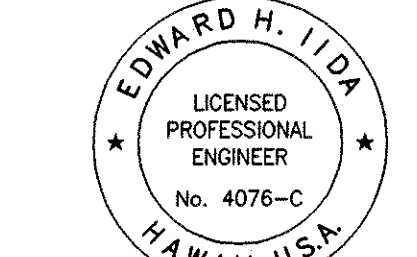

THIS WORK WAS PREPARED BY ME OR UNDER MY SUPERVISION
Edward H. Iida
 MITSUNAGA & ASSOCIATES

STATE OF HAWAII
 DEPARTMENT OF TRANSPORTATION
 HIGHWAYS DIVISION

ROADWAY PLAN

AKAKA FALLS ROAD RESURFACING
Hawaii Belt Road to Honomu Town
Project No. 220A-01-03M

Scale: As Noted Date: April 2003

SHEET No. 4 OF 4 SHEETS

"AS-BUILT"