


ROAD DIST. NO.	STATE	PROJECT NUMBER	FISCAL YEAR	SHEET NO.	TOTAL SHEETS
HAWAII	HAW.	220A-01-03M	2003	18	37

SIGN REPLACEMENT, REMOVAL, AND INSTALLATION SCHEDULE											
STATION	LEFT	RIGHT	MILE POST	TYPE	SIGN TO REMAIN	REMOVE	INSTALL (10 SQ. FT. OR LESS)		INSTALL (GREATER THAN 10 SQ. FT.)		REMARKS
							W/POST	WO/POST	W/POST	WO/POST	
HONOLULU ROAD	0+85		●	35.91	R8-3a (24"x24")		1	1			
	3+16		●	35.91	R8-3a (24"x24")		1	1			
	4+60		●	35.91	R2-1 (25) (24"x30")			1			
	5+20		●	35.91	R8-3a (24"x24")		1	1			
	5+85		●	35.81	W7-1 (30"x30")		1	1	1		
	6+68	●		35.78	R8-3b (36"x24")		1	1			
	8+12		●	35.73	R1-1 (36"x36") 30"x30"		1	1			
	8+44		●	35.73	R8-3a (24"x24")		1	1			
	9+15		●	35.72	R1-1 (36"x36") 30"x30"		1	1			
	9+68		●	35.70	R8-3a (24"x24")		1	1			
	9+73	●		35.70	R8-3a (24"x24")		1	1			
	13+82		●	35.54	R1-1 (36"x36")		1	1			
	15+00		●	35.38	W7-1 (30"x30")		1	1	1		
	16+56		●	35.11	W3-1A (36"x36")		1	1			
	17+06	●		35.11	"UNLAWFUL TO LITTER"		1	1			
	18+11	●		35.11	"NEIGHBORHOOD WATCH"	1					
	18+32	●		34.77	"ADOPT A HIGHWAY"	1					
	20+02	●		34.76	R2-1(25) (24"x30")		1	1			
	21+34		●	34.75	R1-1 (36"x36")		1	1			
	MAHALAHOA HIGHWAY	(-)0+63		●	34.70	R1-1 (36"x36") 30"x30"		1	1		
(-)0+61			●	34.70	"PRIVATE ROAD"	1					
(-)0+54			●	34.70	"PRIVATE ROAD"	1					
(-)0+09			●	34.38	R8-3a (24"x24")		1	1			
(-)0+01			●	34.36	"AKAKA FALLS"		1		1		
0+08			●	34.35	"NEIGHBORHOOD WATCH"	1					
0+30		●		34.35	R1-1 (36"x36")		1	1			
0+89			●	34.35	R2-1(25) (24"x30")		1	1			
1+64			●	34.35	R2-1(25) (24"x30")		1	1			
4+52			●	34.35	R8-3a (24"x24")	Deleted Memo B.4-7	1	1			
4+56		●		34.35	R1-1 (36"x36")		1	1			
4+89			●	33.81	"KOKOKE KAI"		1	1			
5+93			●	33.72	R8-3a (24"x24")	Deleted Memo B.4-7	1	1			
7+24			●	33.72	R8-3a (24"x24")	Deleted Memo B.4-7	1	1			
7+50			●	33.72	"AKAKA FALLS"				1		
7+83		●		33.72	R2-1(25) (24"x30")		1	1			
8+10			●	33.72	R8-3a (24"x24")		1	1			
8+68		●		33.72	"TO HAWAII BELT ROAD"				1		
8+90			●	33.72	R1-1 (36"x36")		1	1			
9+70			●	33.72	W14-2 (24"x24")			2			
TOTALS						30	32	2	3		
CONTRACT ITEM NUMBER								621.5100	621.5150	621.5200	

ROUTE MARKER SCHEDULE						
STATION	LEFT	RIGHT	ROUTE MARKER SIGN NO. (ROUTE NO.)	REMOVE	INSTALL TYPE A ASSEMBLY	
19+15		●	MI-6(19)	1	1	
20+40	●		MI-6(220)	1	1	
0+14		●	MI-6(220)	1	1	
0+45	●		MI-6(220)	1	1	
1+48		●	MI-6(220)	1	1	
9+10		●	MI-6(220)	1	1	
TOTALS				6	6	
CONTRACT ITEM NUMBER					621.6110	

MEMO B.4-7
ADD Sta. 1+40 Rt. M.P. 35.91 TYPE R-8-3a (24"x24")

ORIGINAL PLAN	SURVEY PLOTTED BY	DATE
NOTE BOOK	DRAWN BY	
	DESIGNED BY	
	CHECKED BY	

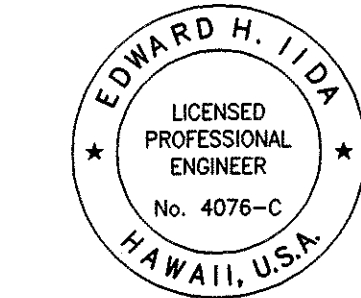

THIS WORK WAS PREPARED BY ME OR UNDER MY SUPERVISION
MITSUNAGA & ASSOCIATES

STATE OF HAWAII
DEPARTMENT OF TRANSPORTATION
HIGHWAYS DIVISION
SIGN REPLACEMENT, REMOVAL AND INSTALLATION SCHEDULE
AKAKA FALLS ROAD RESURFACING
Hawaii Belt Road to Honomu Town
Project No. 220A-01-03M
Scale: As Noted Date: April 2003
SHEET No. 1 OF 1 SHEETS

"AS-BUILT"