


ROAD DIST. NO.	STATE	PROJECT NUMBER	FISCAL YEAR	SHEET NO.	TOTAL SHEETS
HAWAII	HAW.	220A-01-03M	2003	15	37

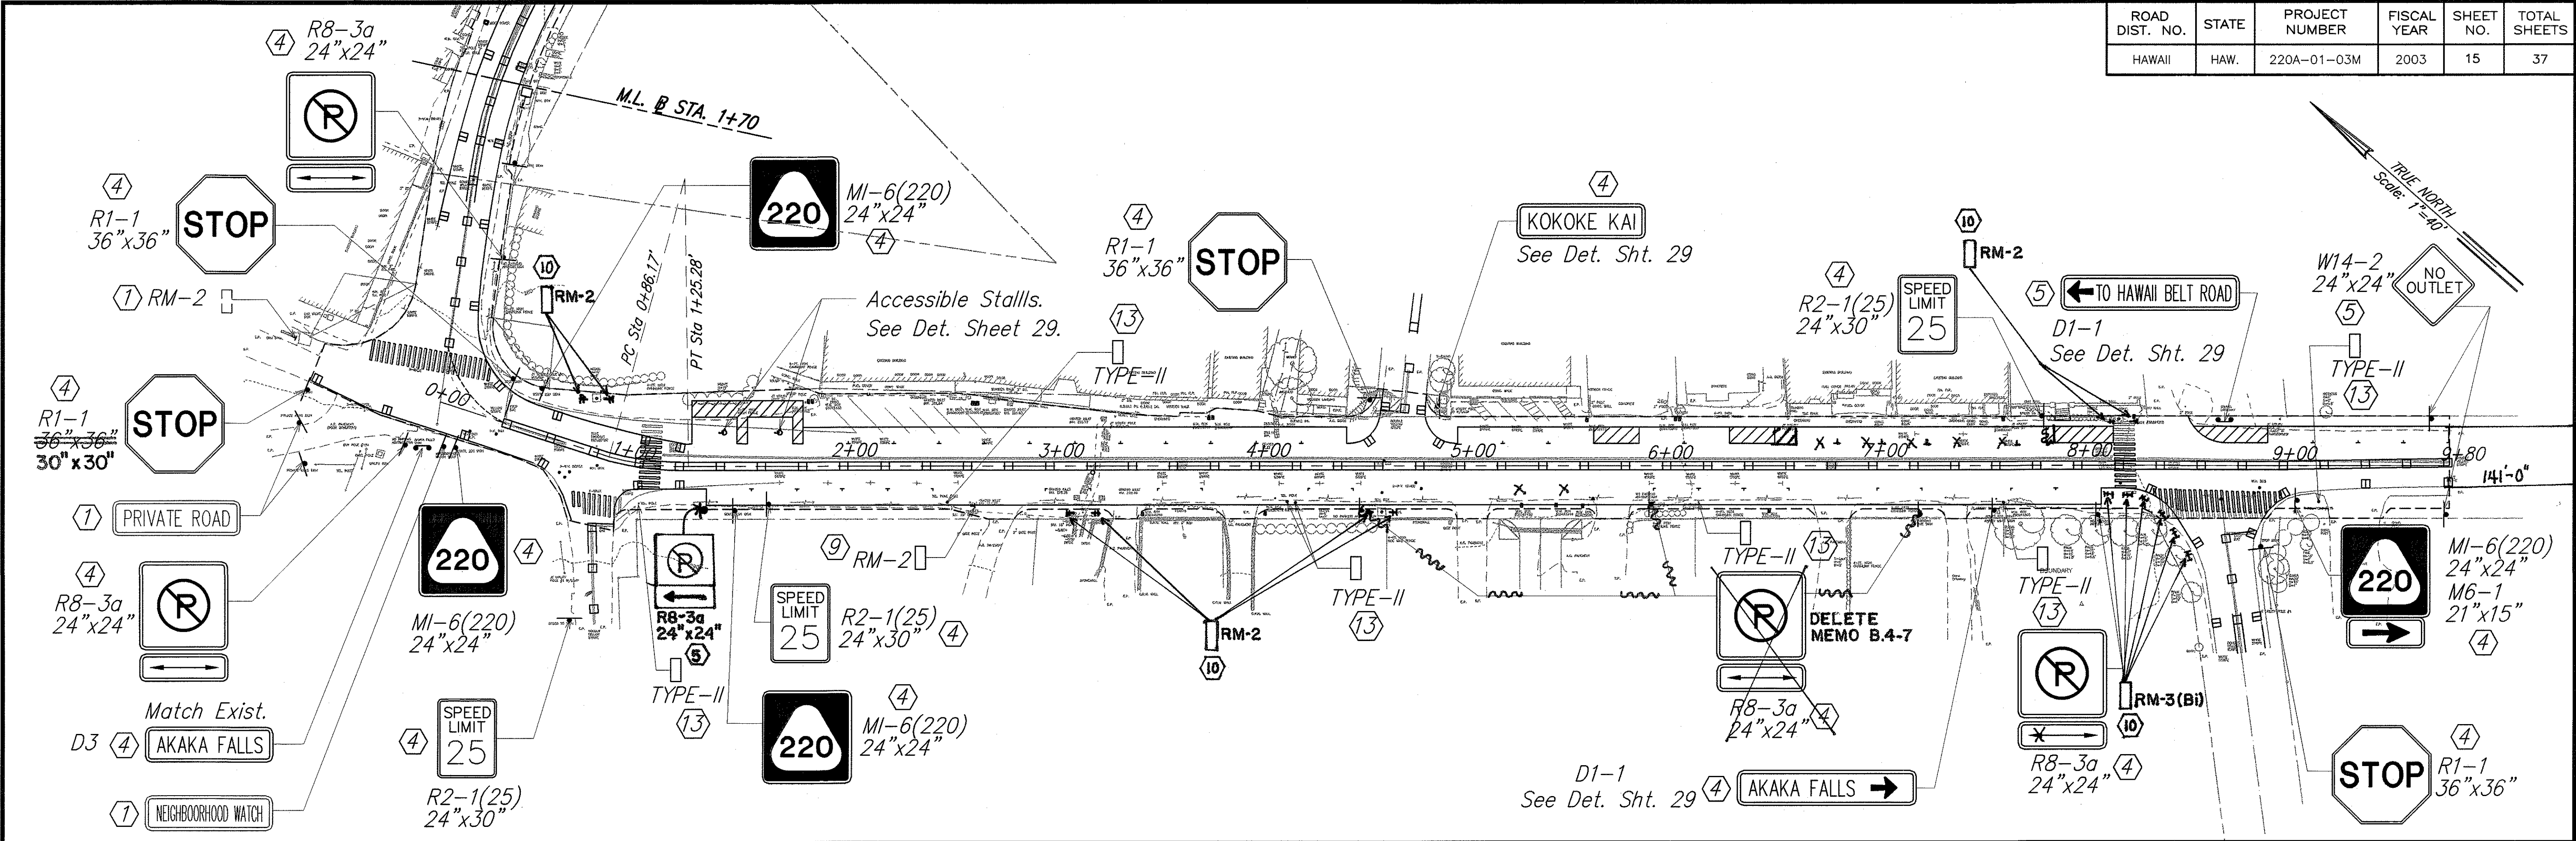

KEY

- | | | | |
|---|---|---|--|
| ① Exist. sign(s) w/ post(s) to remain | ⑤ Install new sign(s) w/ post(s) | ⑨ Remove exist. marker(s) & install new marker(s) w/ flex post(s) | ⑬ Install new type II marker(s) to utility poles |
| ② Remove exist. sign(s) w/ post(s) | ⑥ Remove exist. sign(s)/ marker(s) & install new sign(s)/ marker(s) | ⑩ Install new marker(s) w/ flex post(s) | |
| ③ Remove exist. sign(s) & install new sign(s) on exist. post/ pole | ⑦ Install new sign(s)/ marker(s) | ⑪ Remove exist. marker(s) w/ post(s) & install new marker(s) w/ steel post(s) | |
| ④ Remove exist. sign(s) w/ post(s) & install new sign(s) w/ post(s) | ⑧ Remove exist. sign(s) & reinstall | ⑫ Install new marker(s) w/ steel post(s) | |

SURVEY PLOTTED BY	DATE
DRAWN BY	
DESIGNED BY	
CHECKED BY	
ORIGINAL PLAN	
NOTE BOOK	
NO.	

EDWARD H. IIDA

LICENSED PROFESSIONAL ENGINEER

No. 4076-C

HAWAII, U.S.A.

THIS WORK WAS PREPARED BY ME OR UNDER MY SUPERVISION

Edward H. Iida

EDWARD H. IIDA & ASSOCIATES

STATE OF HAWAII

DEPARTMENT OF TRANSPORTATION

HIGHWAYS DIVISION

SIGNAGE AND PAVEMENT MARKING PLAN

AKAKA FALLS ROAD RESURFACING

Hawaii Belt Road to Honouliuli Town


Project No. 220A-01-03M

Scale: As Noted Date: April 2003

SHEET No. 1 OF 2 SHEETS



"AS-BUILT"

ROAD DIST. NO.	STATE	PROJECT NUMBER	FISCAL YEAR	SHEET NO.	TOTAL SHEETS
HAWAII	HAW.	220A-01-03M	2003	16	37

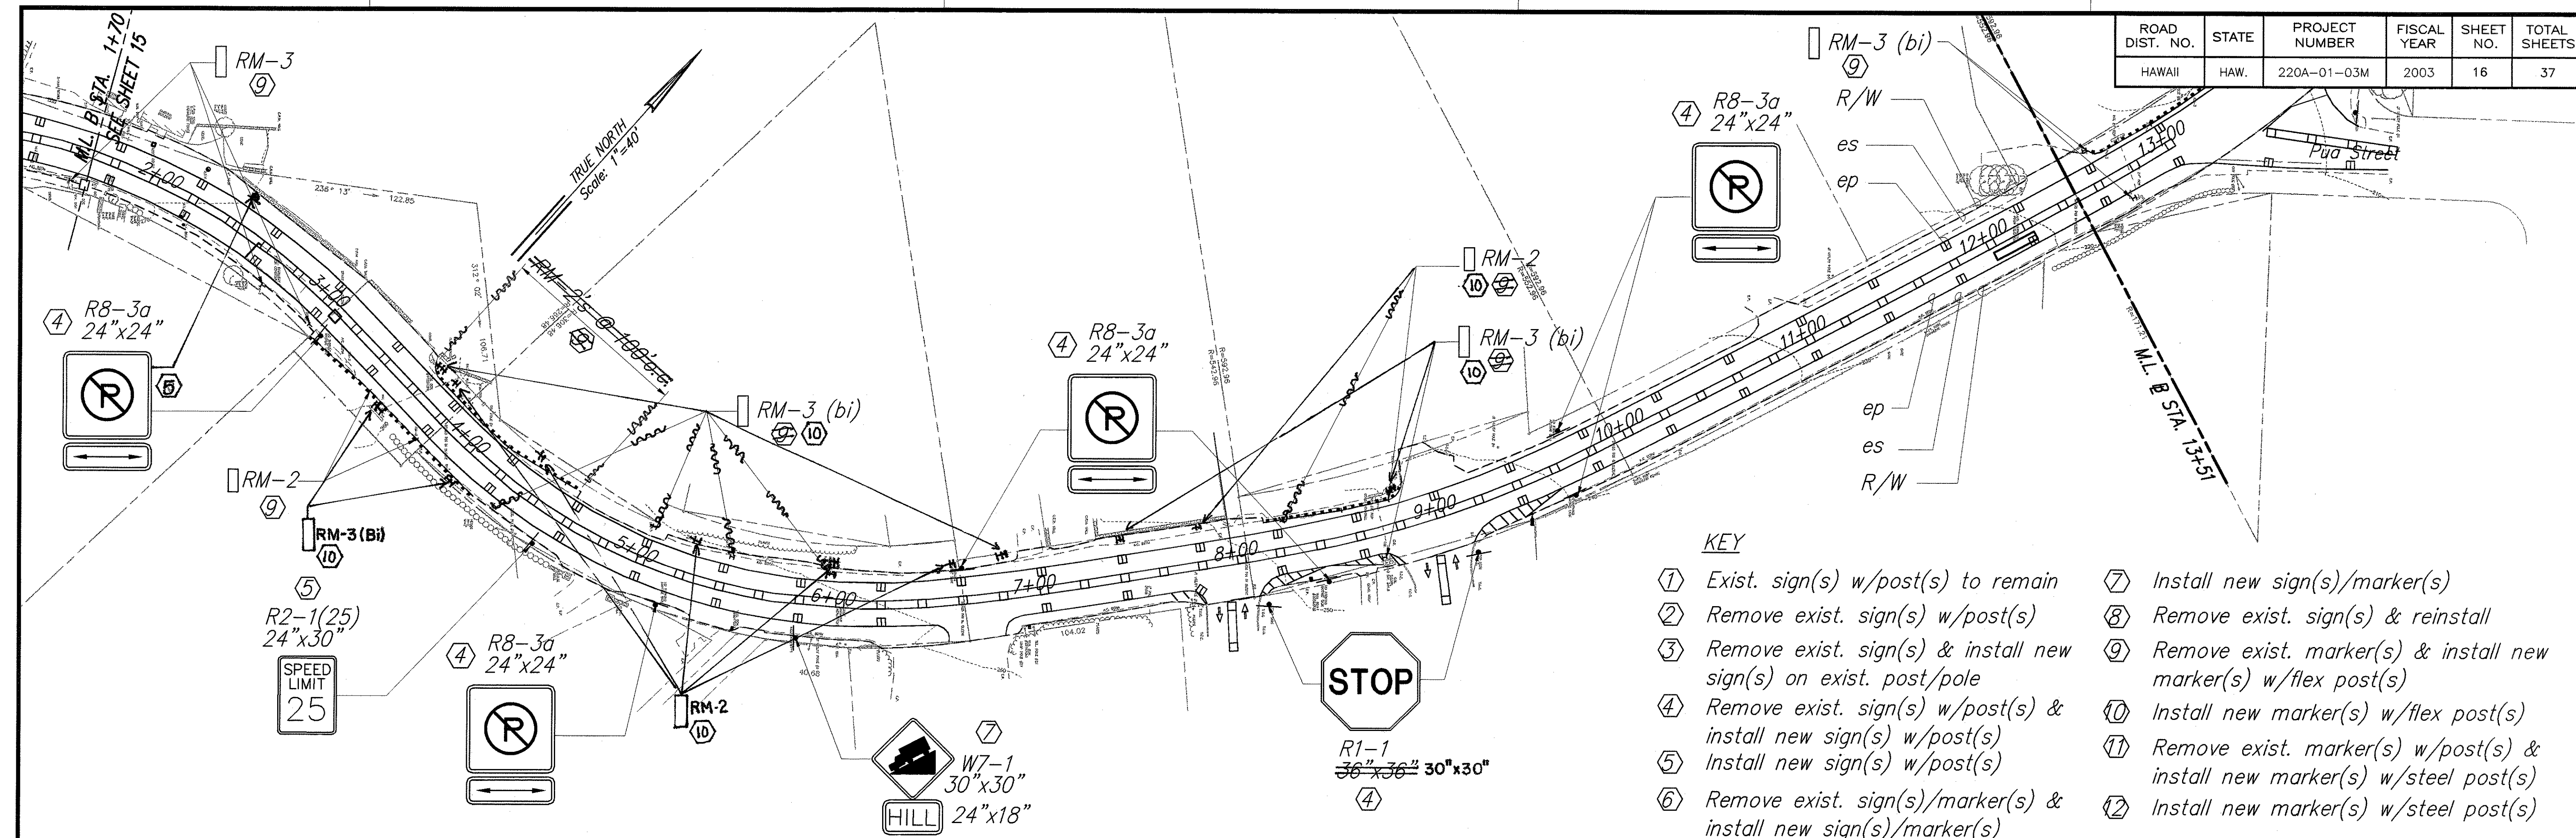

KEY

- Exist. sign(s) w/post(s) to remain
- Remove exist. sign(s) w/post(s)
- Remove exist. sign(s) & install new sign(s) on exist. post/pole
- Remove exist. sign(s) w/post(s) & install new sign(s) w/post(s)
- Install new sign(s) w/post(s)
- Remove exist. sign(s)/marker(s) & install new sign(s)/marker(s)
- Install new sign(s)/marker(s)
- Remove exist. sign(s) & reinstall
- Remove exist. marker(s) & install new marker(s) w/flex post(s)
- Install new marker(s) w/flex post(s)
- Remove exist. marker(s) w/post(s) & install new marker(s) w/steel post(s)
- Install new marker(s) w/steel post(s)

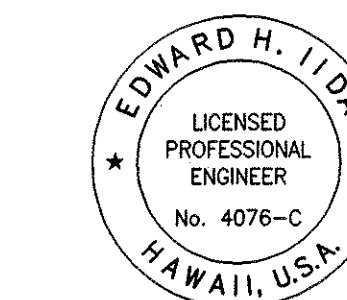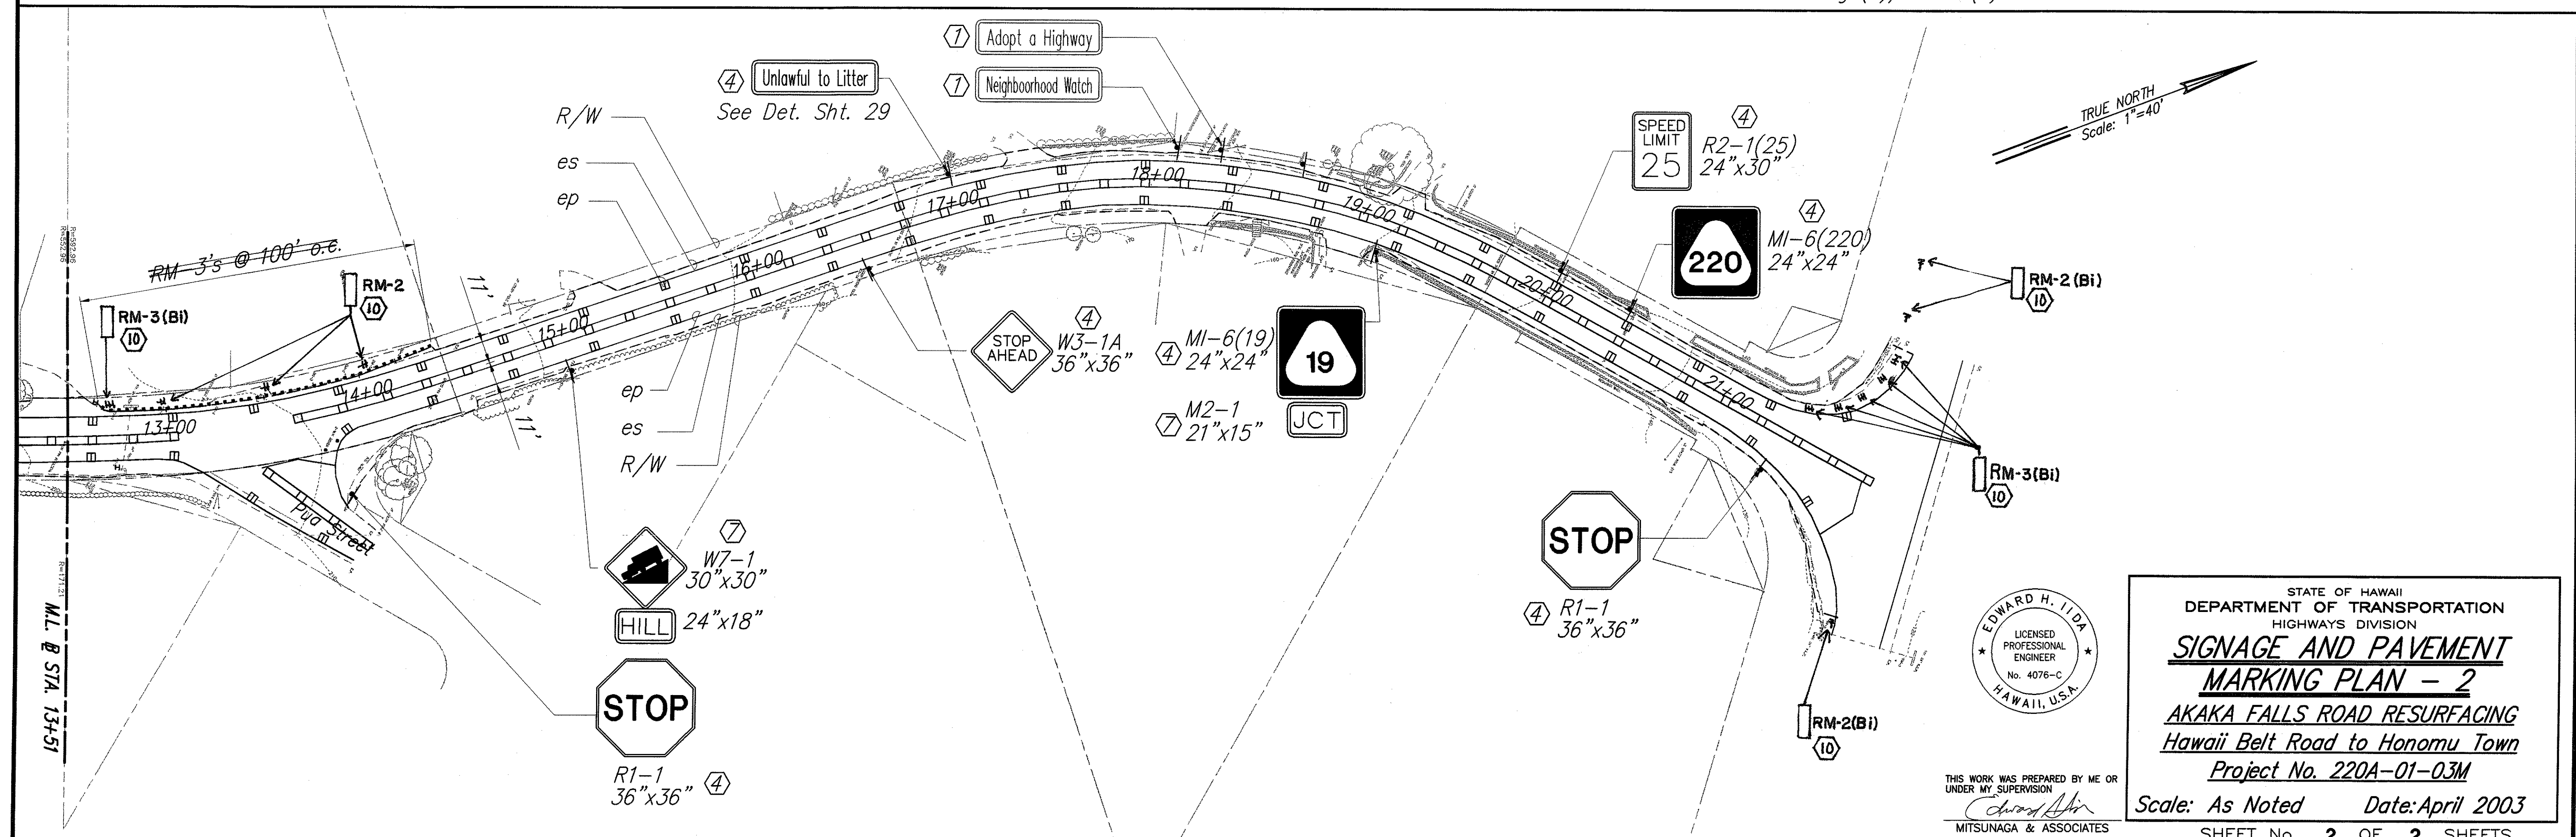

STATE OF HAWAII
DEPARTMENT OF TRANSPORTATION
HIGHWAYS DIVISION
**SIGNAGE AND PAVEMENT
MARKING PLAN - 2**
AKAKA FALLS ROAD RESURFACING
Hawaii Belt Road to Honoumua Town
Project No. 220A-01-03M
Scale: As Noted Date: April 2003
SHEET No. 2 OF 2 SHEETS

THIS WORK WAS PREPARED BY ME OR
UNDER MY SUPERVISION
Edward H. Iida
MITSUNAGA & ASSOCIATES

"AS-BUILT"