



INDEX TO DRAWINGS	
SHEET NO.	DESCRIPTION
1	TITLE SHEET
2	STANDARD PLANS SUMMARY
3	GENERAL NOTES AND LEGEND
4-5	WATER POLLUTION & EROSION CONTROL NOTES
6-7	TYPICAL SECTIONS
8-11	ROADWAY PLANS
12	GUARDRAIL SCHEDULE
13	PAVEMENT MARKINGS, LEGEND, DETAILS & NOTES
14	SIGNAGE NOTES
15-16	SIGNAGE & PAVEMENT MARKING PLANS
17	STRIPING AND PAVEMENT MARKING SCHEDULE
18	SIGN REPLACEMENT, REMOVAL AND INSTALLATION SCHEDULE
19	REFLECTOR AND OBJECT MARKER SCHEDULE
20	UTILITY SCHEDULES
21-25	GUARDRAIL DETAILS & NOTES
26	ROAD AND DRAIN LINE PROFILES
27	DRAINAGE DETAILS
28-29	MISCELLANEOUS DETAILS
30-37	CROSS SECTIONS - MAMALAHOA HIGHWAY


STATE OF HAWAII
DEPARTMENT OF TRANSPORTATION
HIGHWAYS DIVISION
HONOLULU, HAWAII
"AS-BUILT"
PLANS FOR
AKAKA FALLS ROAD RESURFACING
HAWAII BELT ROAD TO HONOMU TOWN
M.P. 0.00 TO M.P. 0.61
PROJECT NO. 220A-01-03M
DISTRICT OF SOUTH HILO
ISLAND OF HAWAII

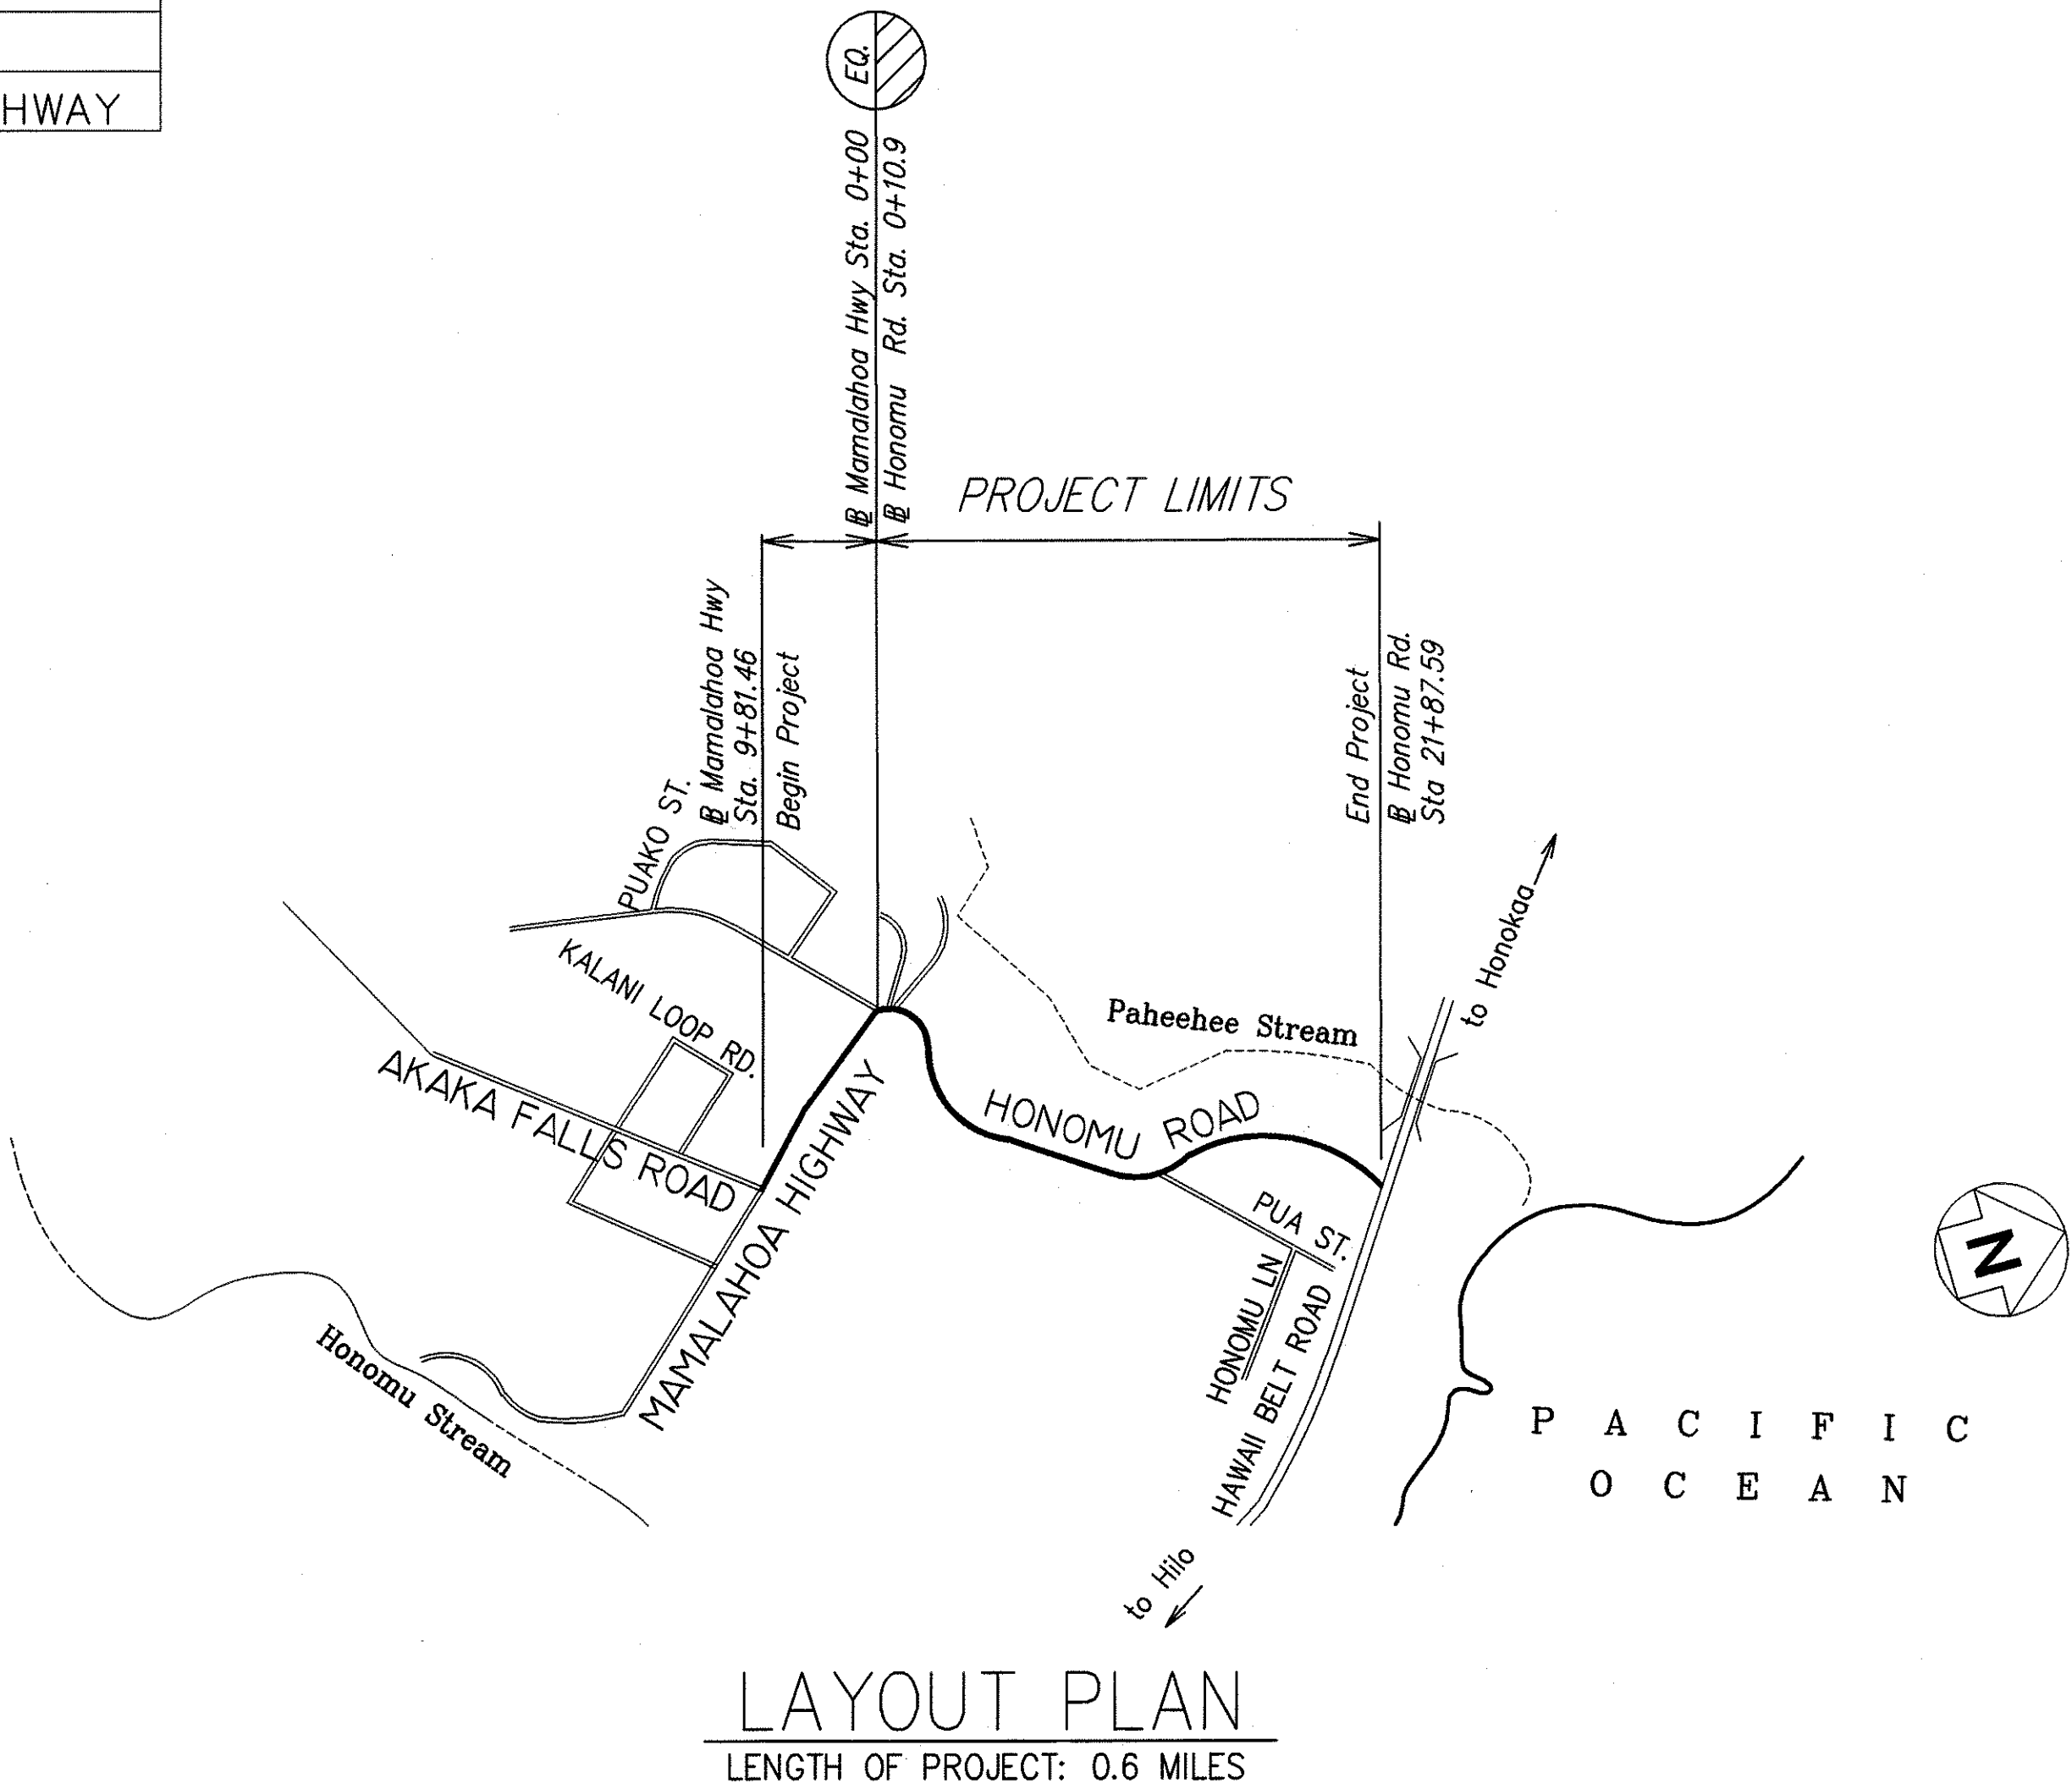

ROAD DIST. NO.	STATE	PROJECT NUMBER	FISCAL YEAR	SHEET NO.	TOTAL SHEETS
HAWAII	HAW.	220A-01-03M	2003	1	37

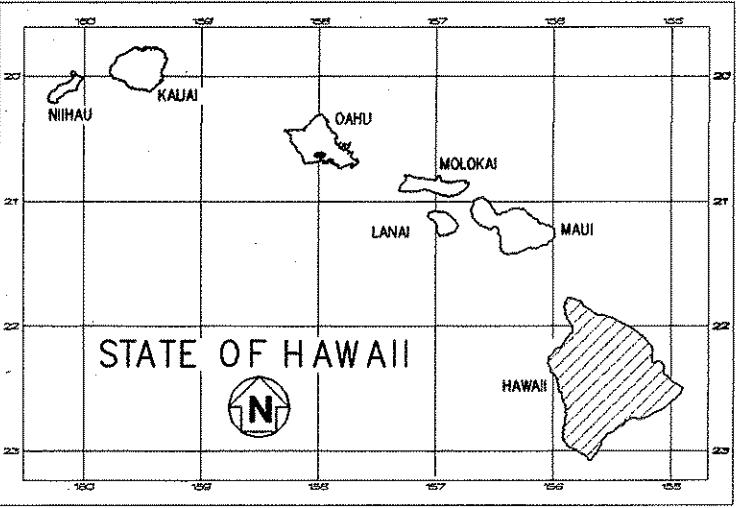

LOCATION OF PROJECT

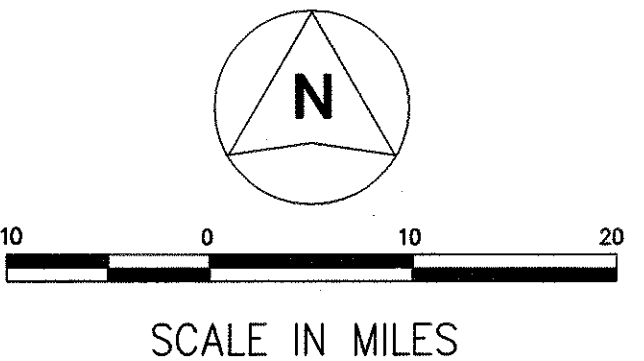

FEDERAL AID PROJECTS PREVIOUSLY CONSTRUCTED OR UNDER CONSTRUCTION
MILE POST 0.00 TO MILE POST 0.61

CHANGES MADE DURING CONSTRUCTION HAVE BEEN INCORPORATED ON THESE PLANS EXCEPT CHANGES IN THE ORIGINAL THEORETICAL QUANTITIES. FOR ACTUAL QUANTITIES, REFER TO PROJECT LEDGER AND/OR COMPUTATION BOOK.

1/17/2003
DATE

DEPARTMENT OF TRANSPORTATION STATE OF HAWAII	
APPROVED:	5/4/03
DIR. OF TRANSPORTATION	DATE

MITSUNAGA & ASSOCIATES
DESIGNED BY
R. SHIOJI
P. S. & E. BY
933-8866
PHONE
APRIL 2003
DATE