

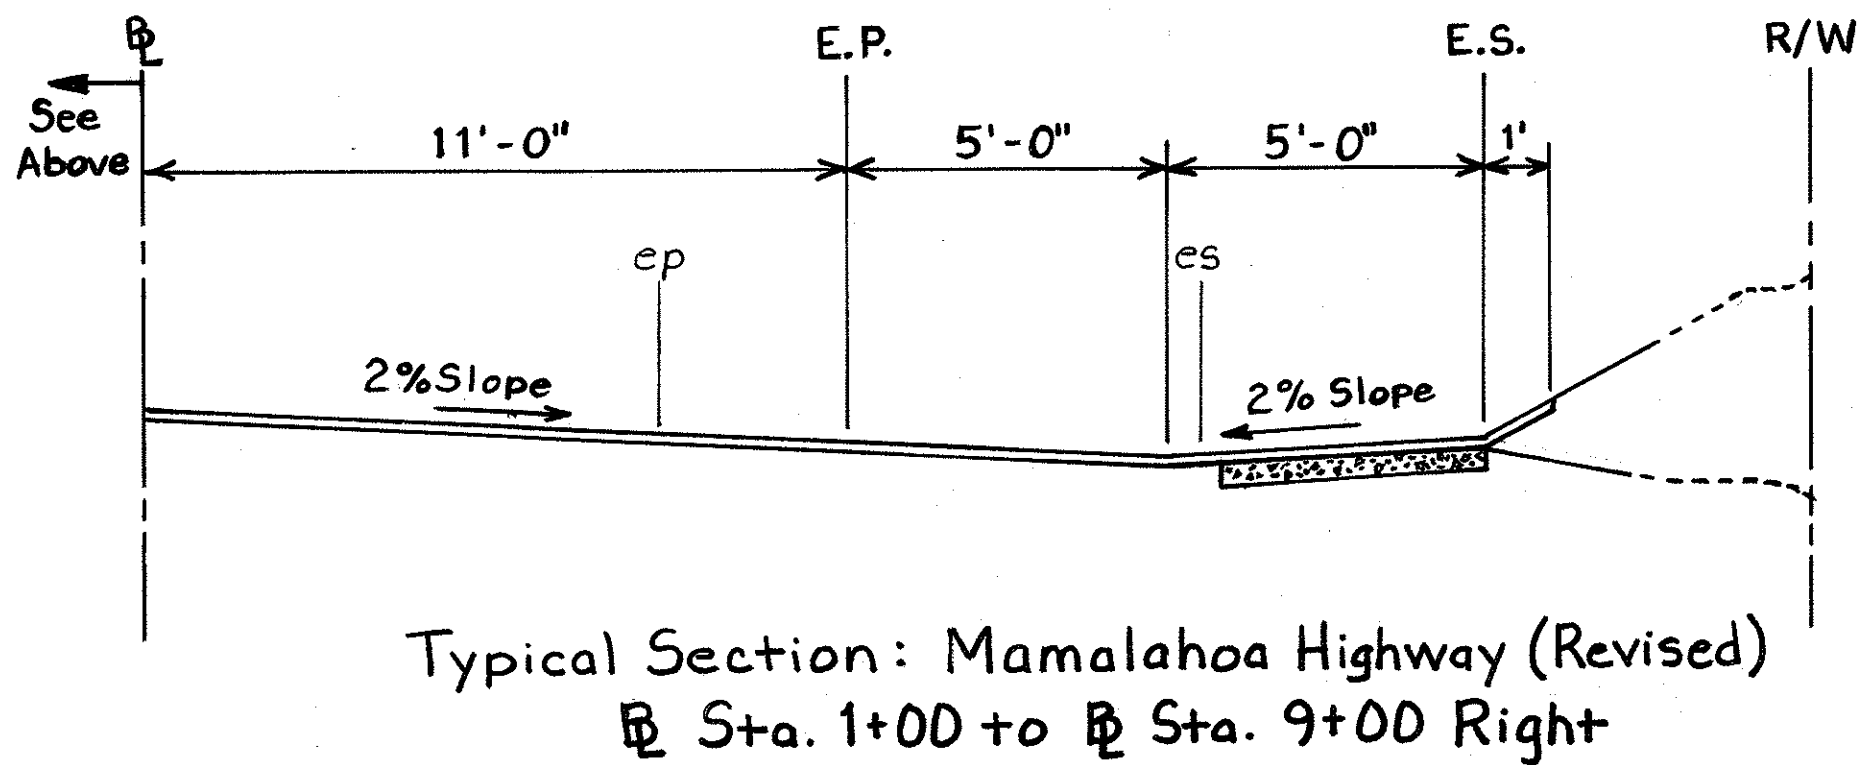
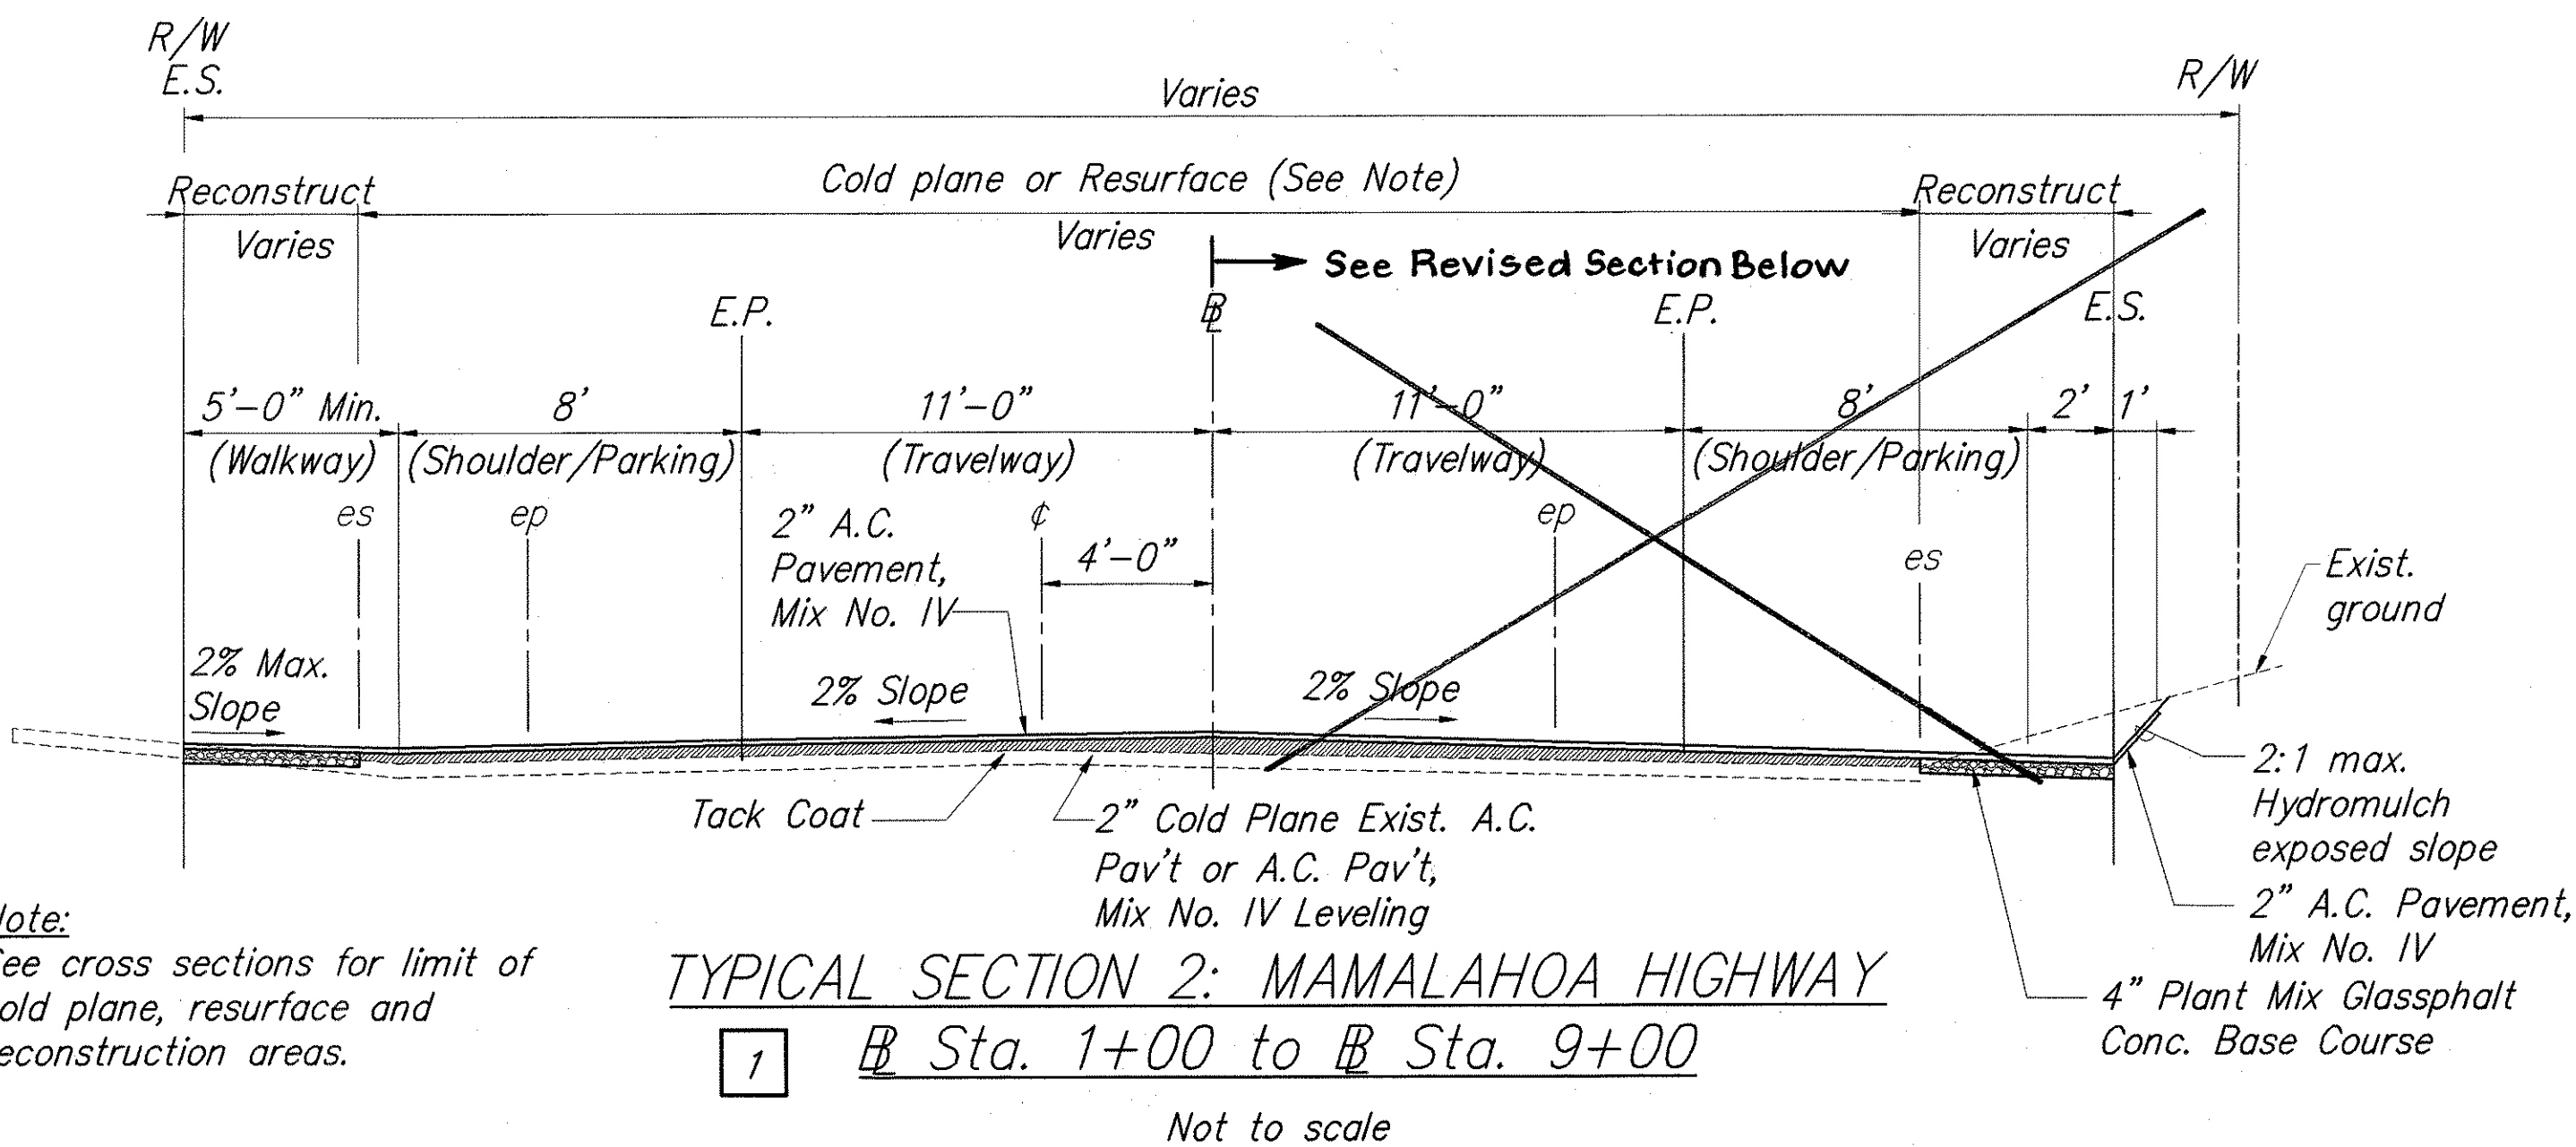
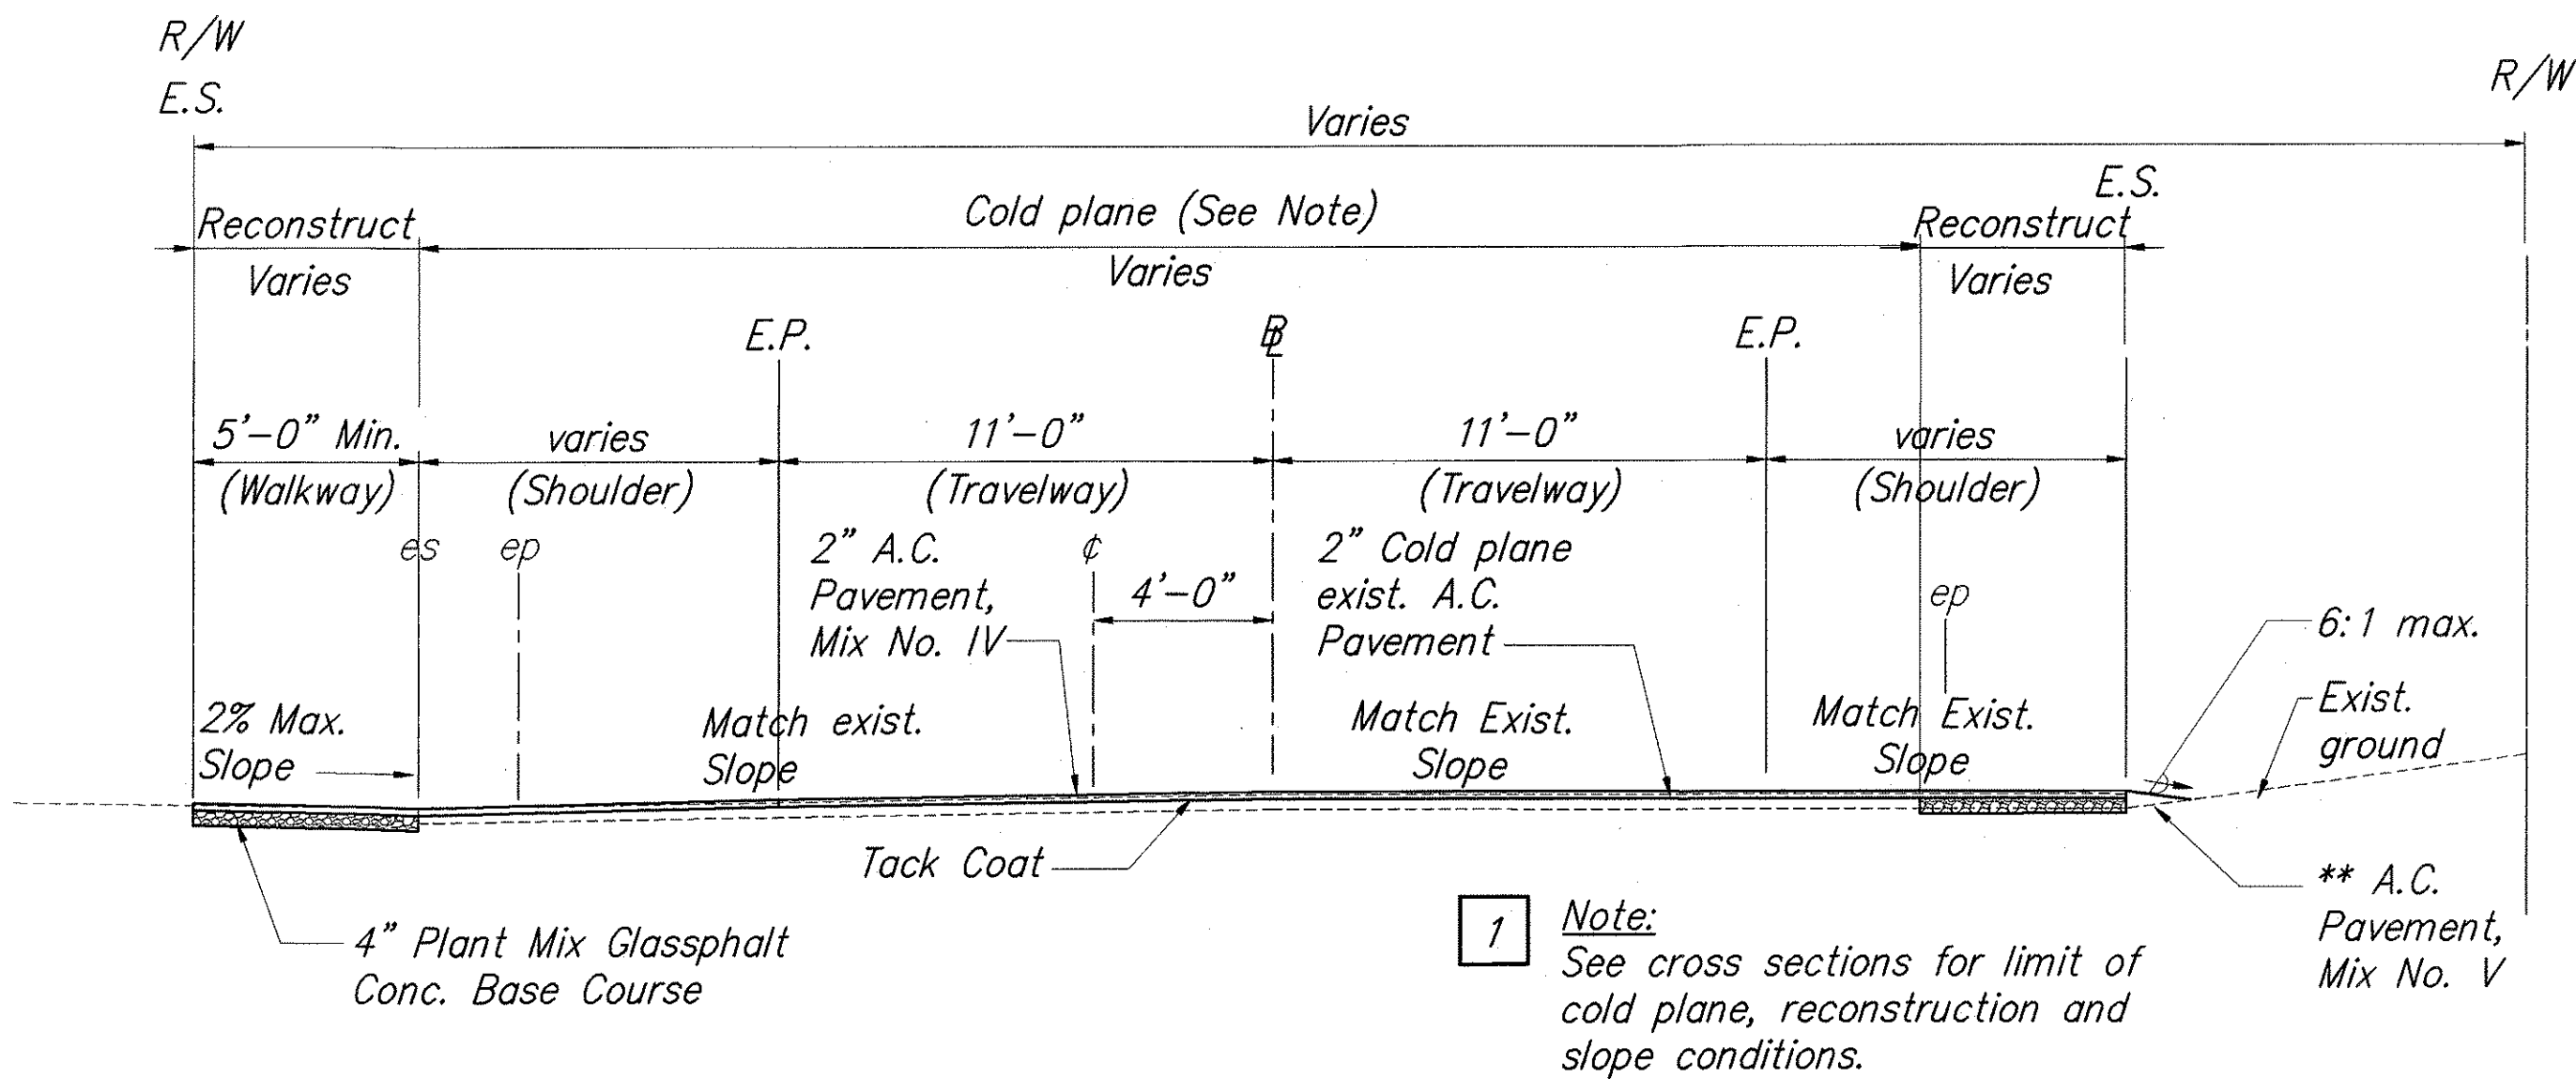



ROAD DIST. NO.	STATE	PROJECT NUMBER	FISCAL YEAR	SHEET NO.	TOTAL SHEETS
HAWAII	HAW.	220A-01-03M	2003	6	37

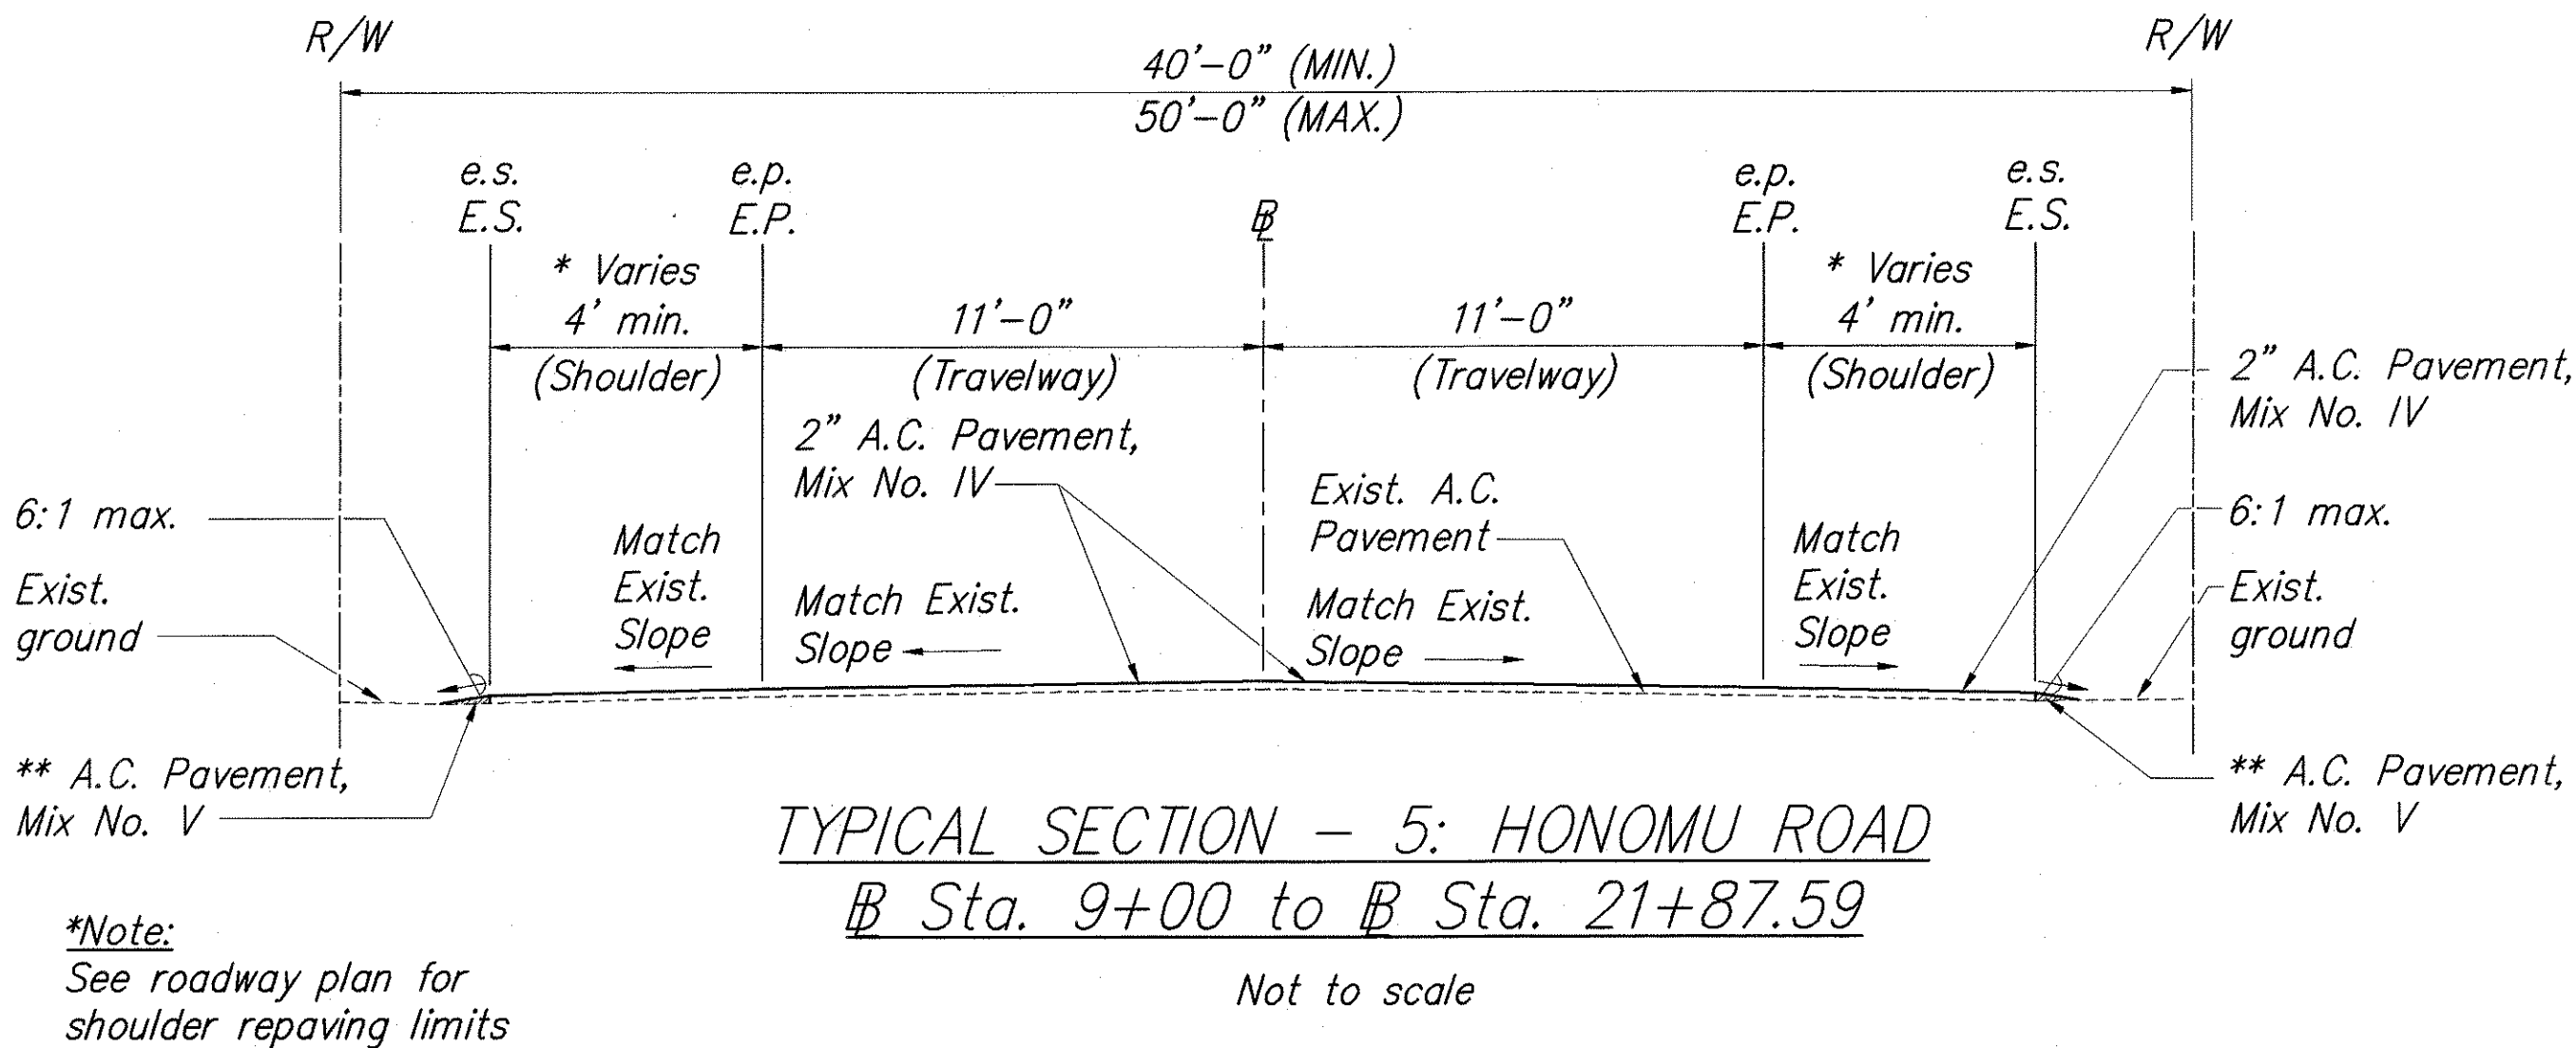

- Legend**
- e.p. Existing edge of pavement
  - e.s. Existing edge of shoulder
  - E.P. New edge of pavement
  - E.S. New edge of shoulder
  - ¢ Existing center line
  - ¢ New center line

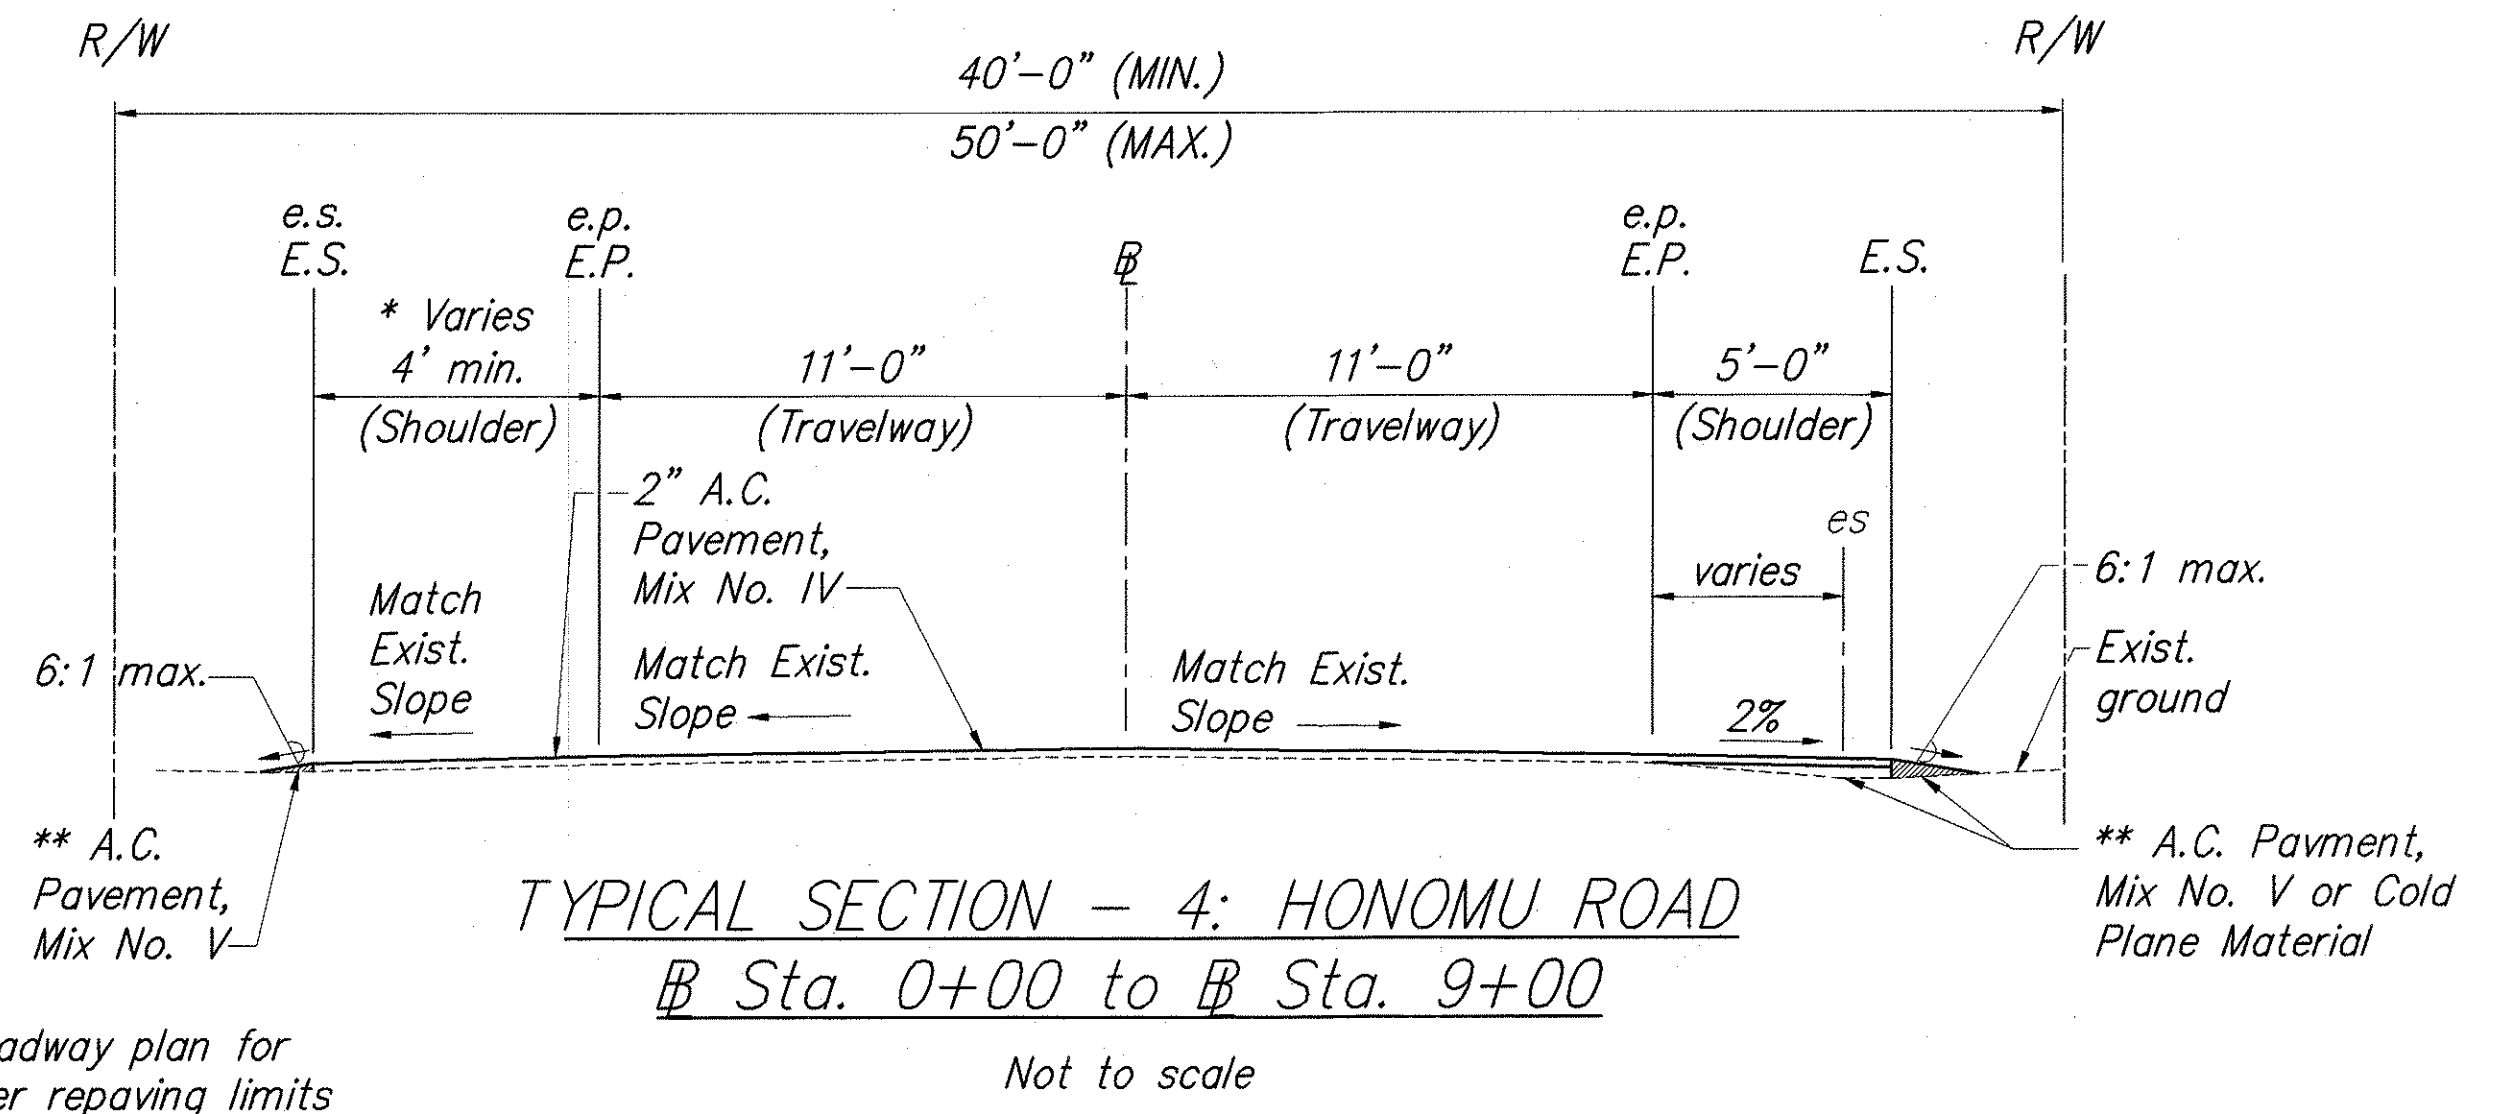

- \*\* Notes:**
1. Clearing and grubbing shall be provided for shoulder areas to be improved. The cost shall be incidental to paving work.
  2. All excess useable cold-planned material shall be stockpiled within the project limits at no cost to the State. Stockpile shall be determined by the engineer. Use cold planned material to dress shoulders prior to paving.
  3. Where exist. slopes in areas beyond paved shoulder are greater than 6:1, a maximum slope of 4:1 shall be used with the approval of the Engineer.
  4. A.C. Mix V where paved, cold plane/dirt where grassed

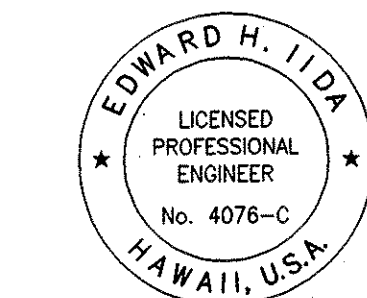

THIS WORK WAS PREPARED BY ME OR UNDER MY SUPERVISION  
 Mitsunaga & Associates


6/13/03	1	Revised Typical Section 1 & 2. Deleted Typical Section 3.
Date	Revision	

STATE OF HAWAII DEPARTMENT OF TRANSPORTATION HIGHWAYS DIVISION		
<u><b>TYPICAL SECTIONS</b></u>		
<u>AKAKA FALLS ROAD RESURFACING</u> <u>Hawaii Belt Road to Honomu Town</u> <u>Project No. 220A-01-03M</u>		
Scale: As Noted	Date: April 2003	
SHEET No. 1 OF 2 SHEETS		


**"AS-BUILT"**

**ADD. 6**


ROAD DIST. NO.	STATE	PROJECT NUMBER	FISCAL YEAR	SHEET NO.	TOTAL SHEETS
HAWAII	HAW.	220A-01-03M	2003	7	37

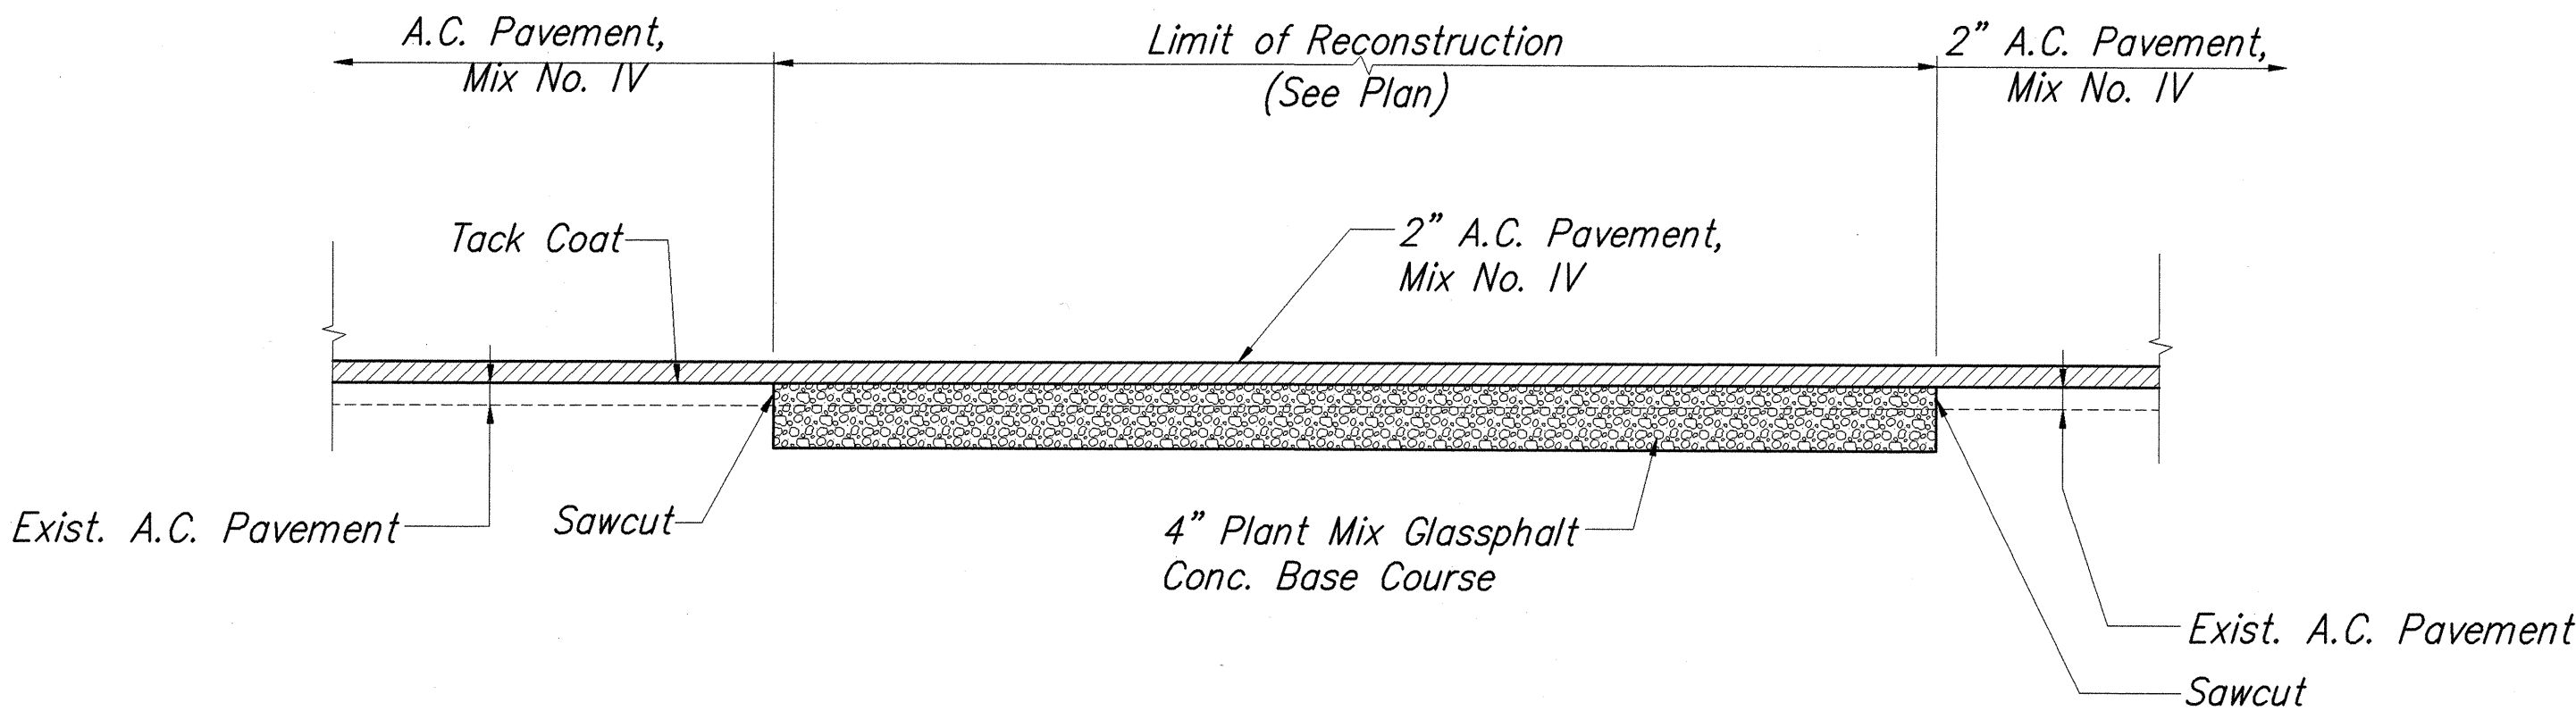


TYPICAL PAVEMENT RECONSTRUCTION  
Not to Scale

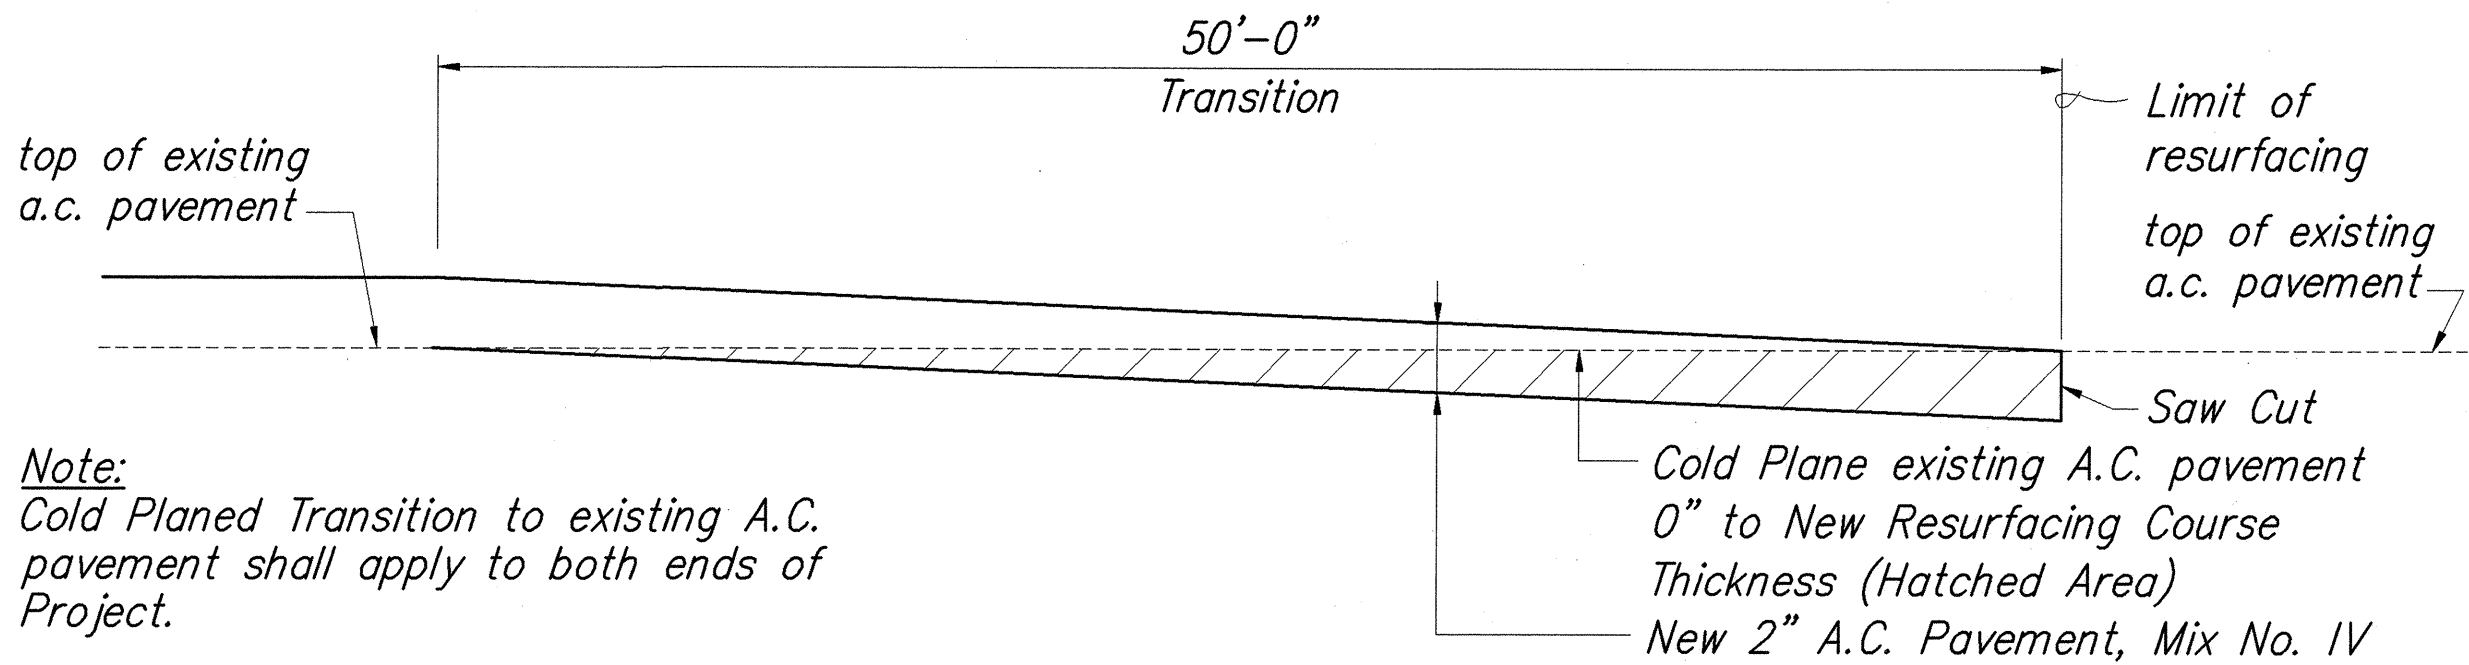


COLD PLANED TRANSITION TO EXISTING A.C. PAVEMENT  
Not to Scale

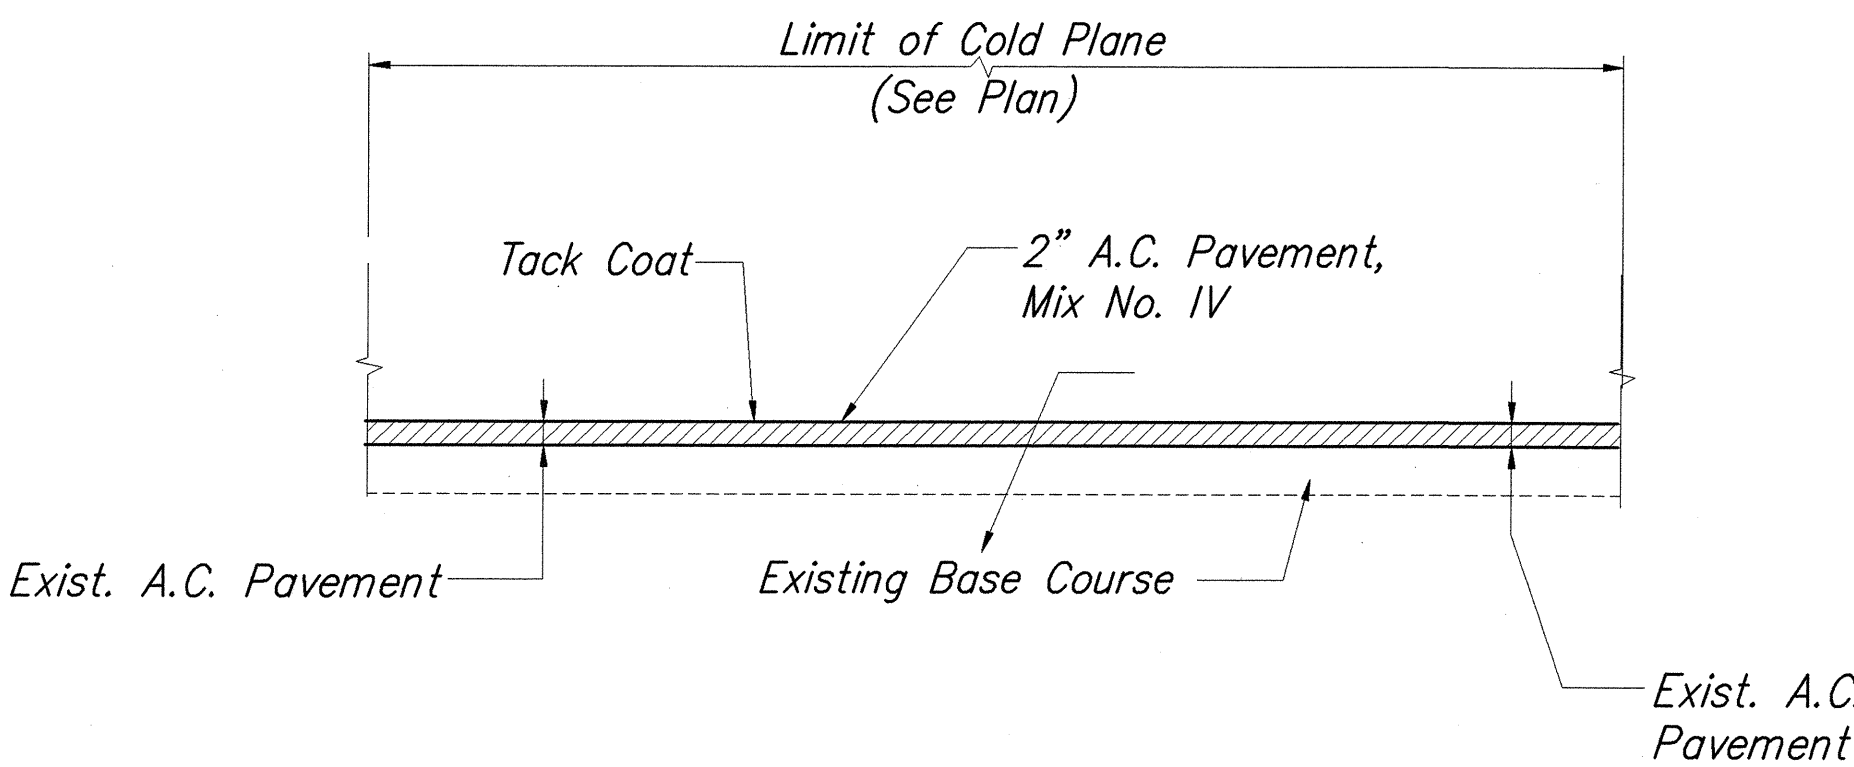


1 TYPICAL PAVEMENT COLD PLANE  
Not to Scale

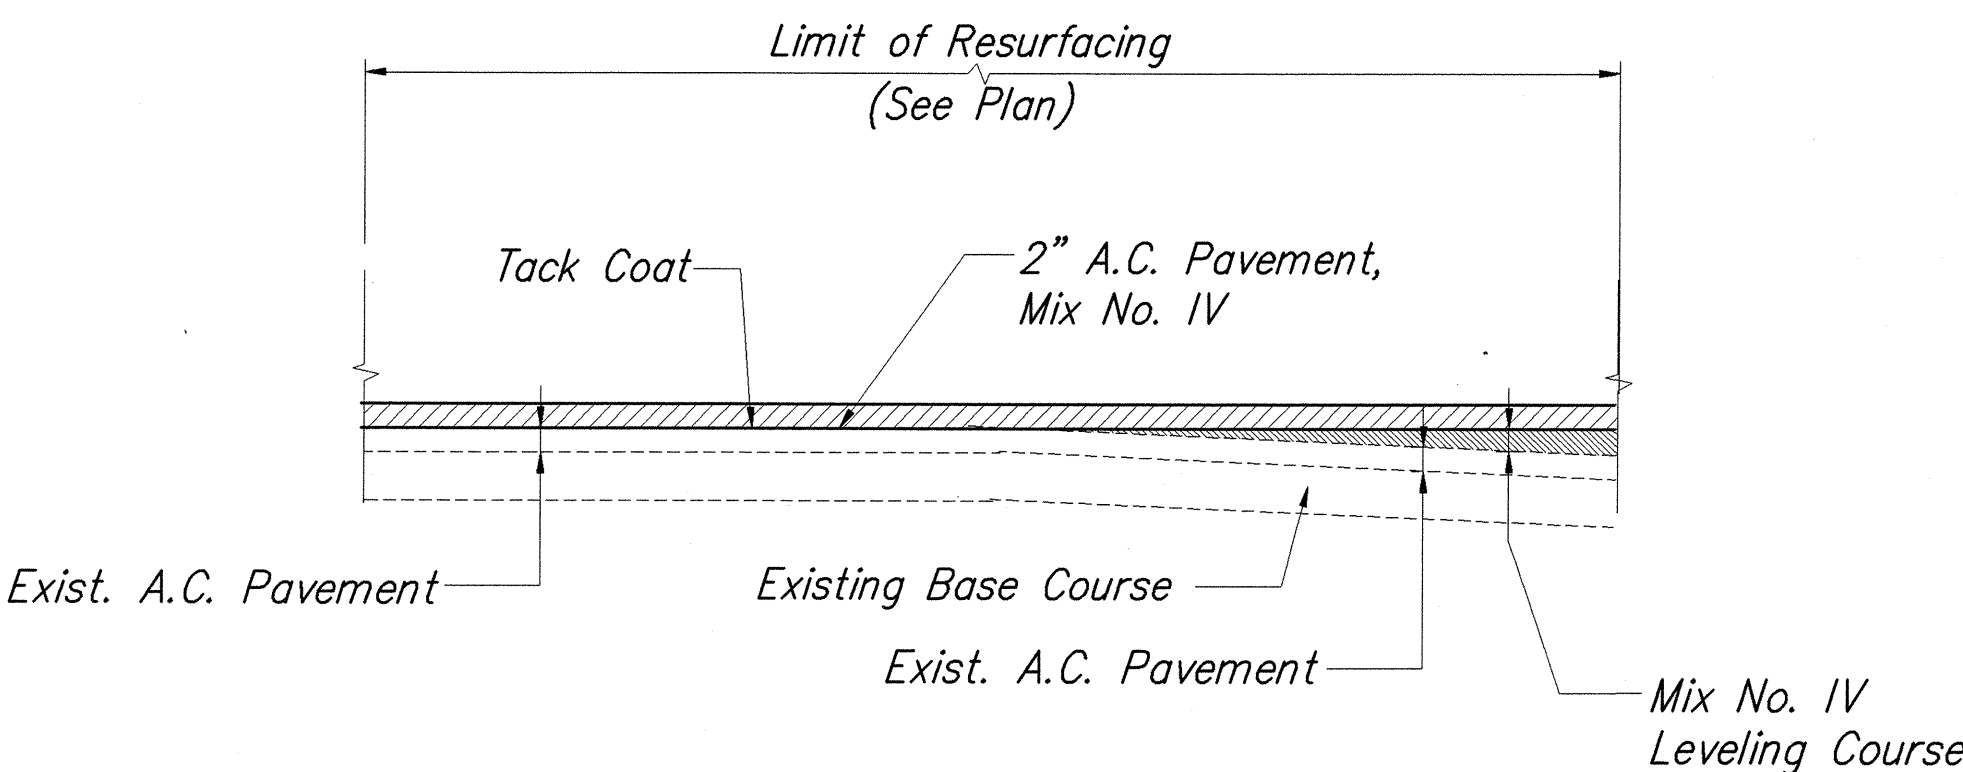


1 TYPICAL PAVEMENT RESURFACE  
Not to Scale

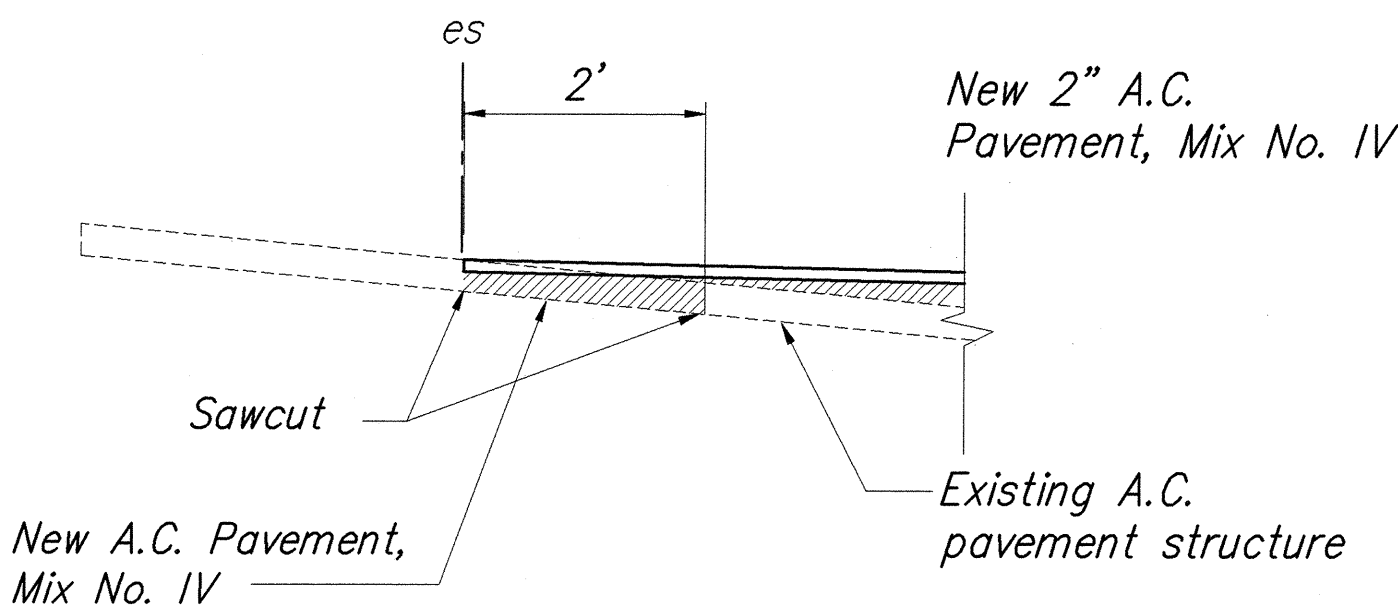

TYPICAL EDGE TRANSITION  
Not to Scale

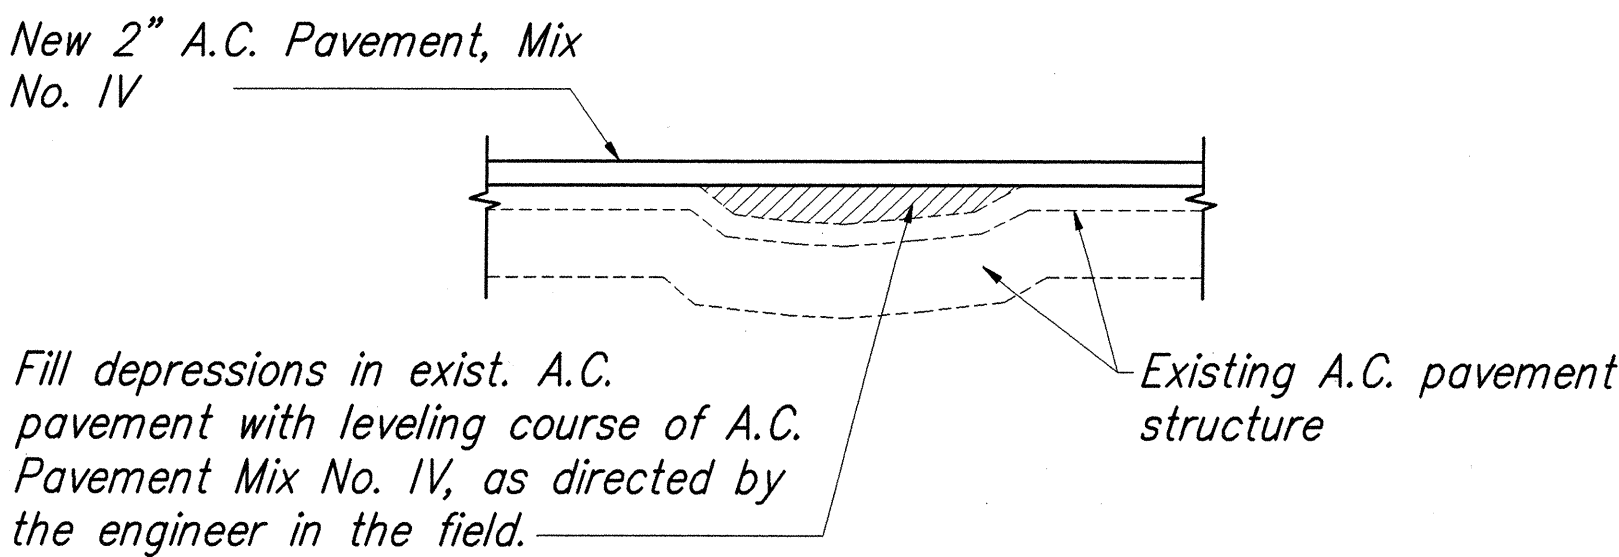


LEVELING COURSE DETAIL  
Not to Scale

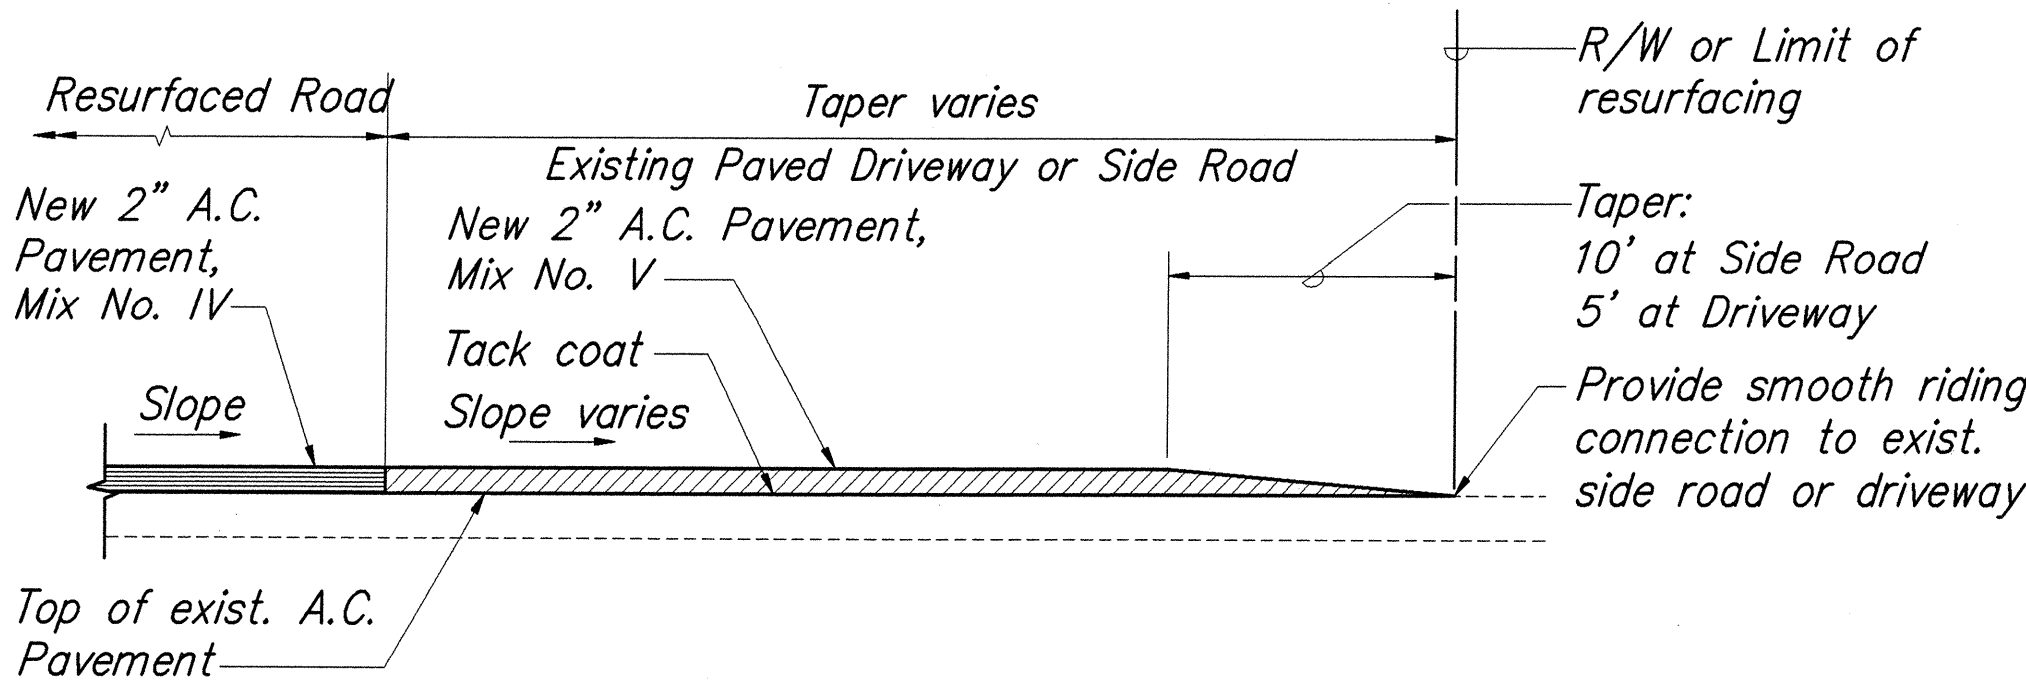

A.C. RESURFACING AT PAVED SIDE ROAD & DRIVEWAY  
Not to Scale

6/13/03	<u>1</u> Added Typical Cold Plane Detail and Typical Resurfacing Detail.
Date	Revision

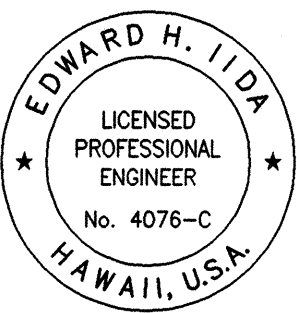

THIS WORK WAS PREPARED BY ME OR UNDER MY SUPERVISION  
*Edward H. Iida*  
MITSUNAGA & ASSOCIATES

STATE OF HAWAII  
DEPARTMENT OF TRANSPORTATION  
HIGHWAYS DIVISION

**TYPICAL SECTIONS**

AKAKA FALLS ROAD RESURFACING  
Hawaii Belt Road to Honoumua Town  
Project No. 220A-01-03M

Scale: As Noted      Date: April 2003

SHEET No. 2 OF 2 SHEETS

SURVEY PLOTTED BY	DATE
DRAWN BY	
TRACED BY	
DESIGNED BY	
CHECKED BY	
ORIGINAL PLAN	
NOTE BOOK	
No.	