
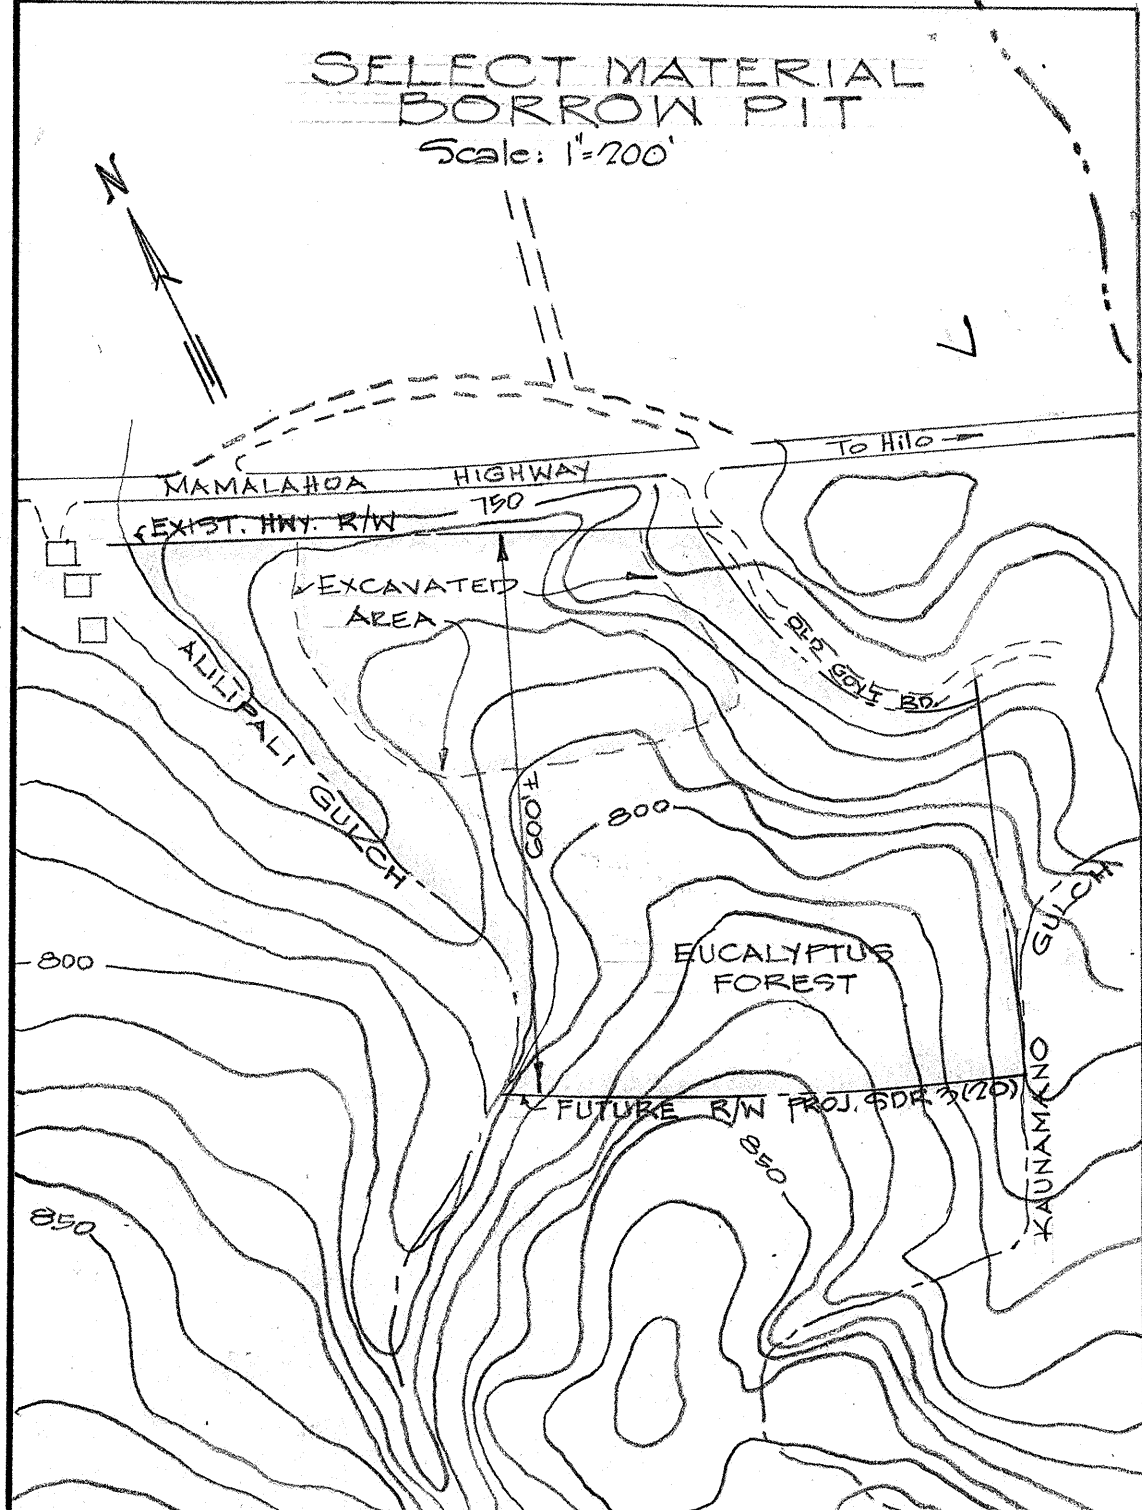


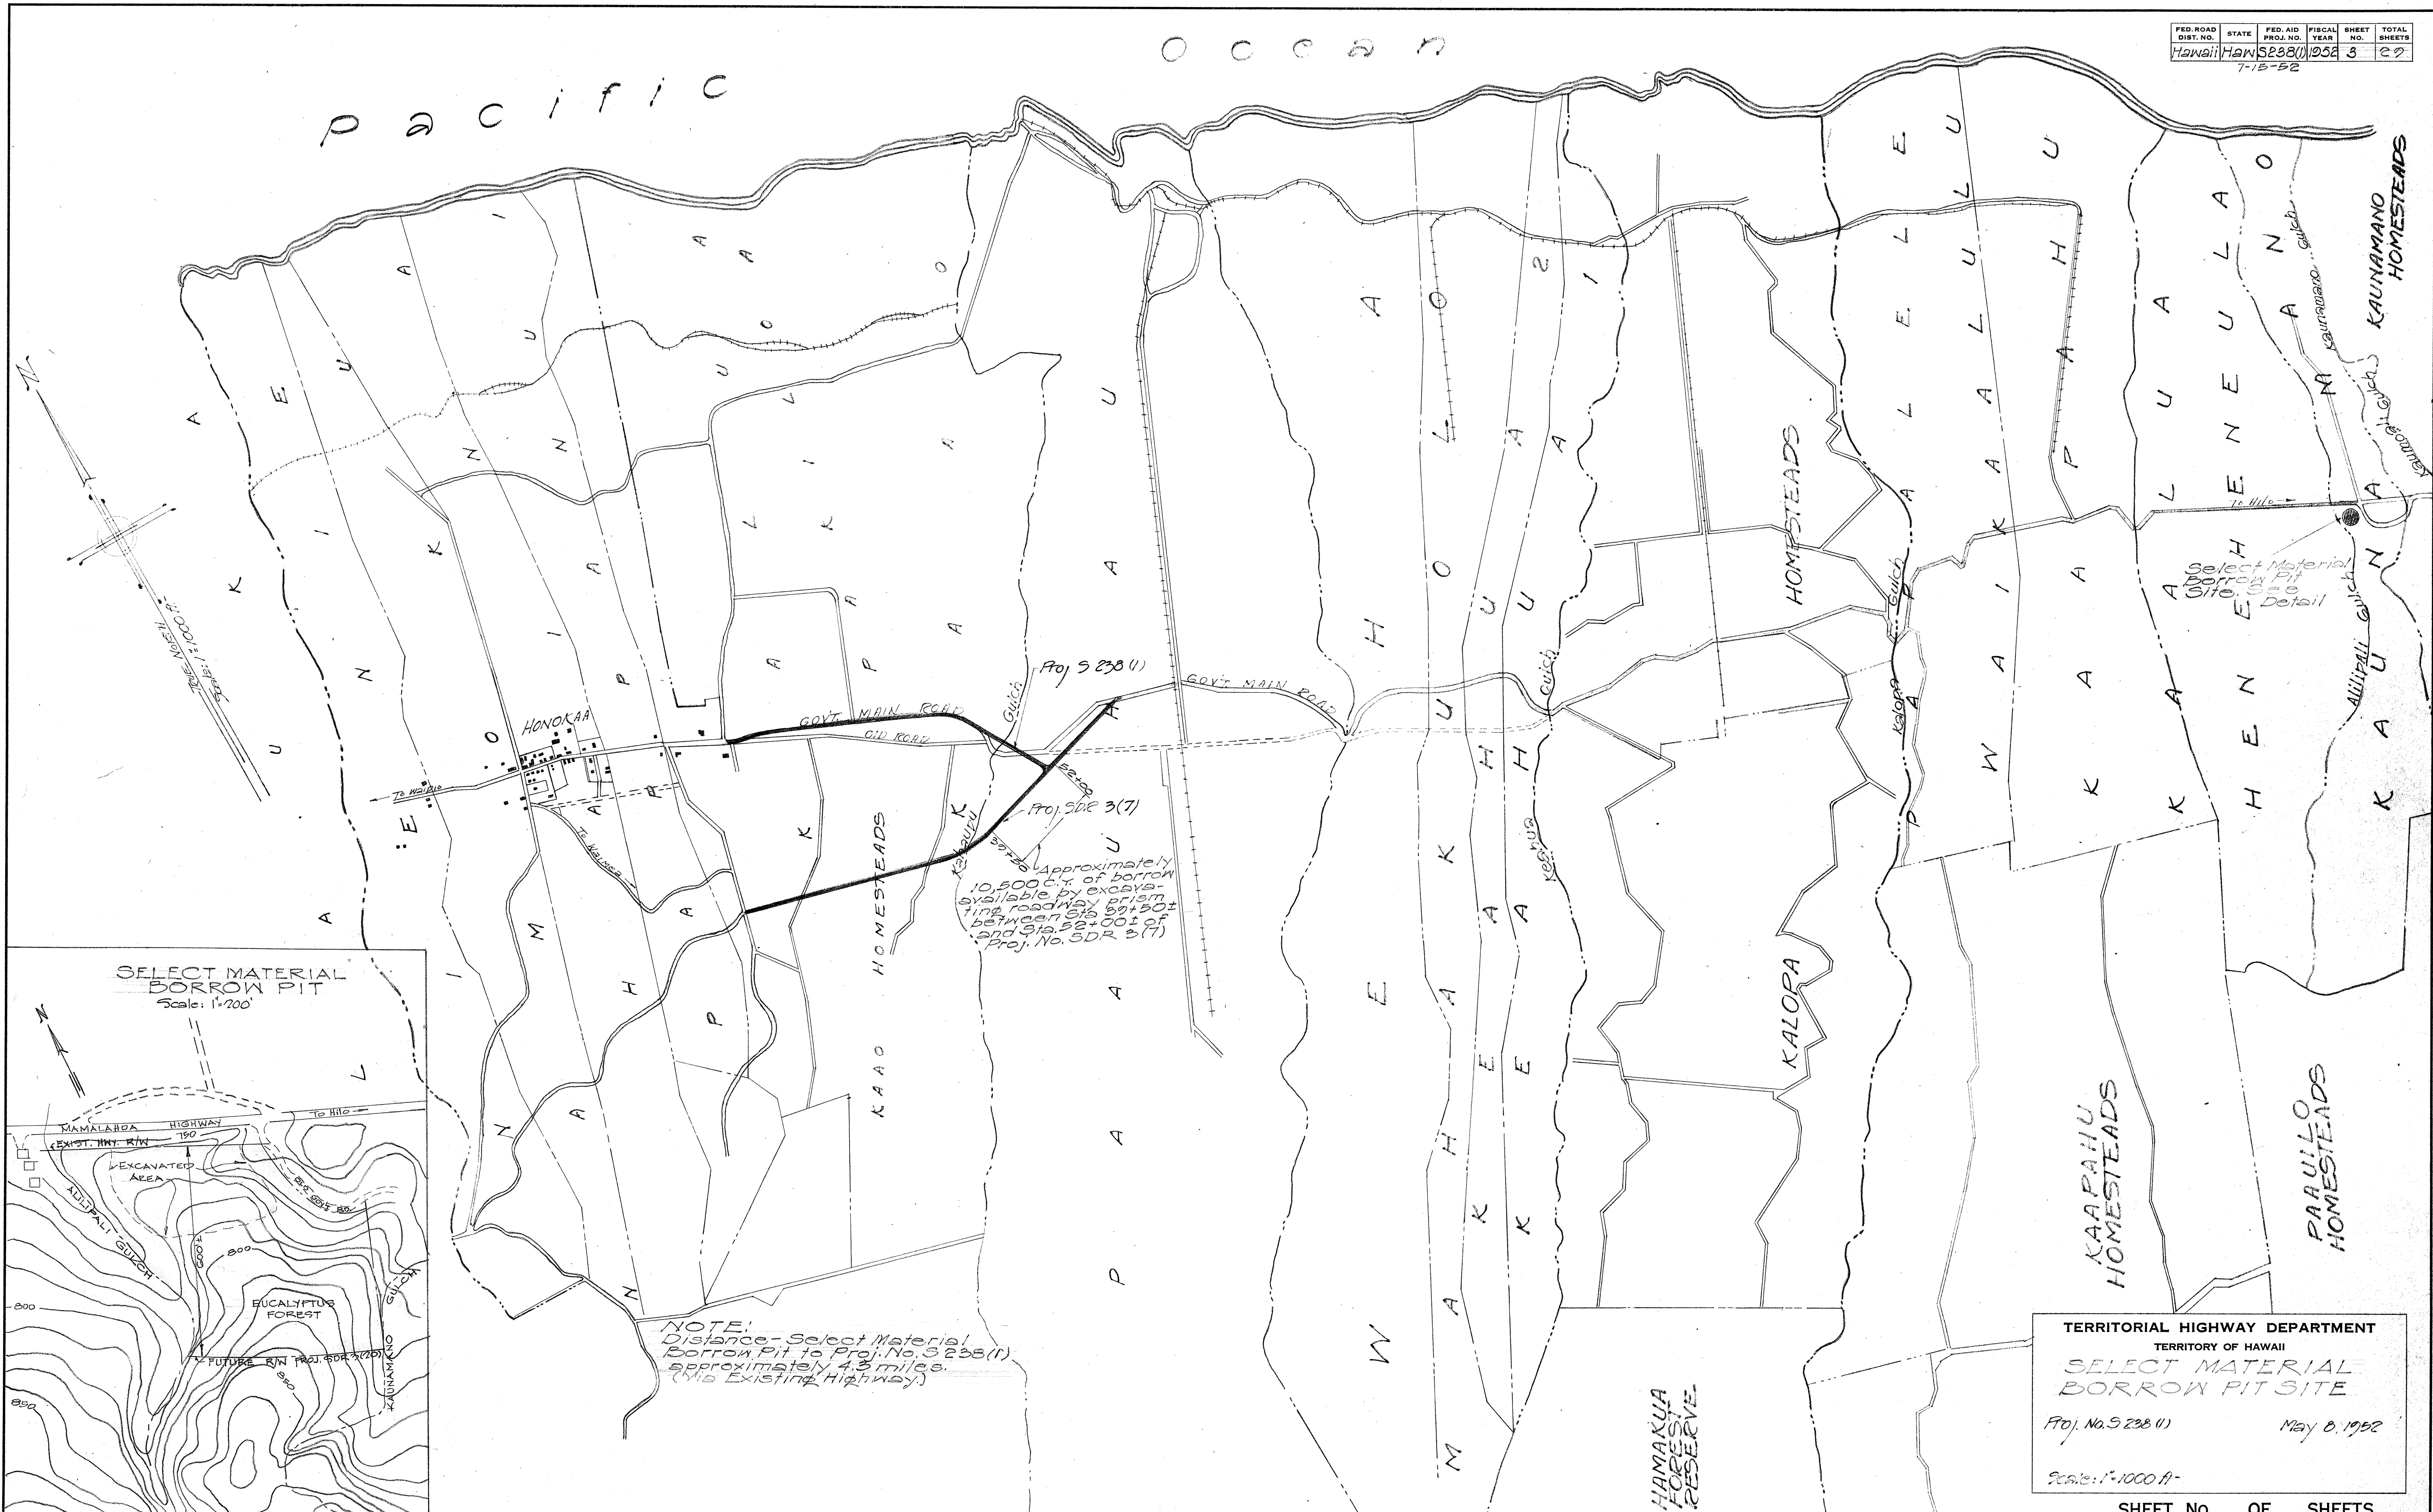

TERRITORIAL HIGHWAY DEPARTMENT
TERRITORY OF HAWAII
SELECT MATERIAL BORROW PIT SITE
Proj. No. SDR 3(1) May 8, 1952
Scale: 1"=1000 ft.

SURVEY PLOTTED BY _____ DATE _____
DESIGNED BY _____
DRAWN BY _____
CHECKED BY _____
NOTE BOOK NO. _____