



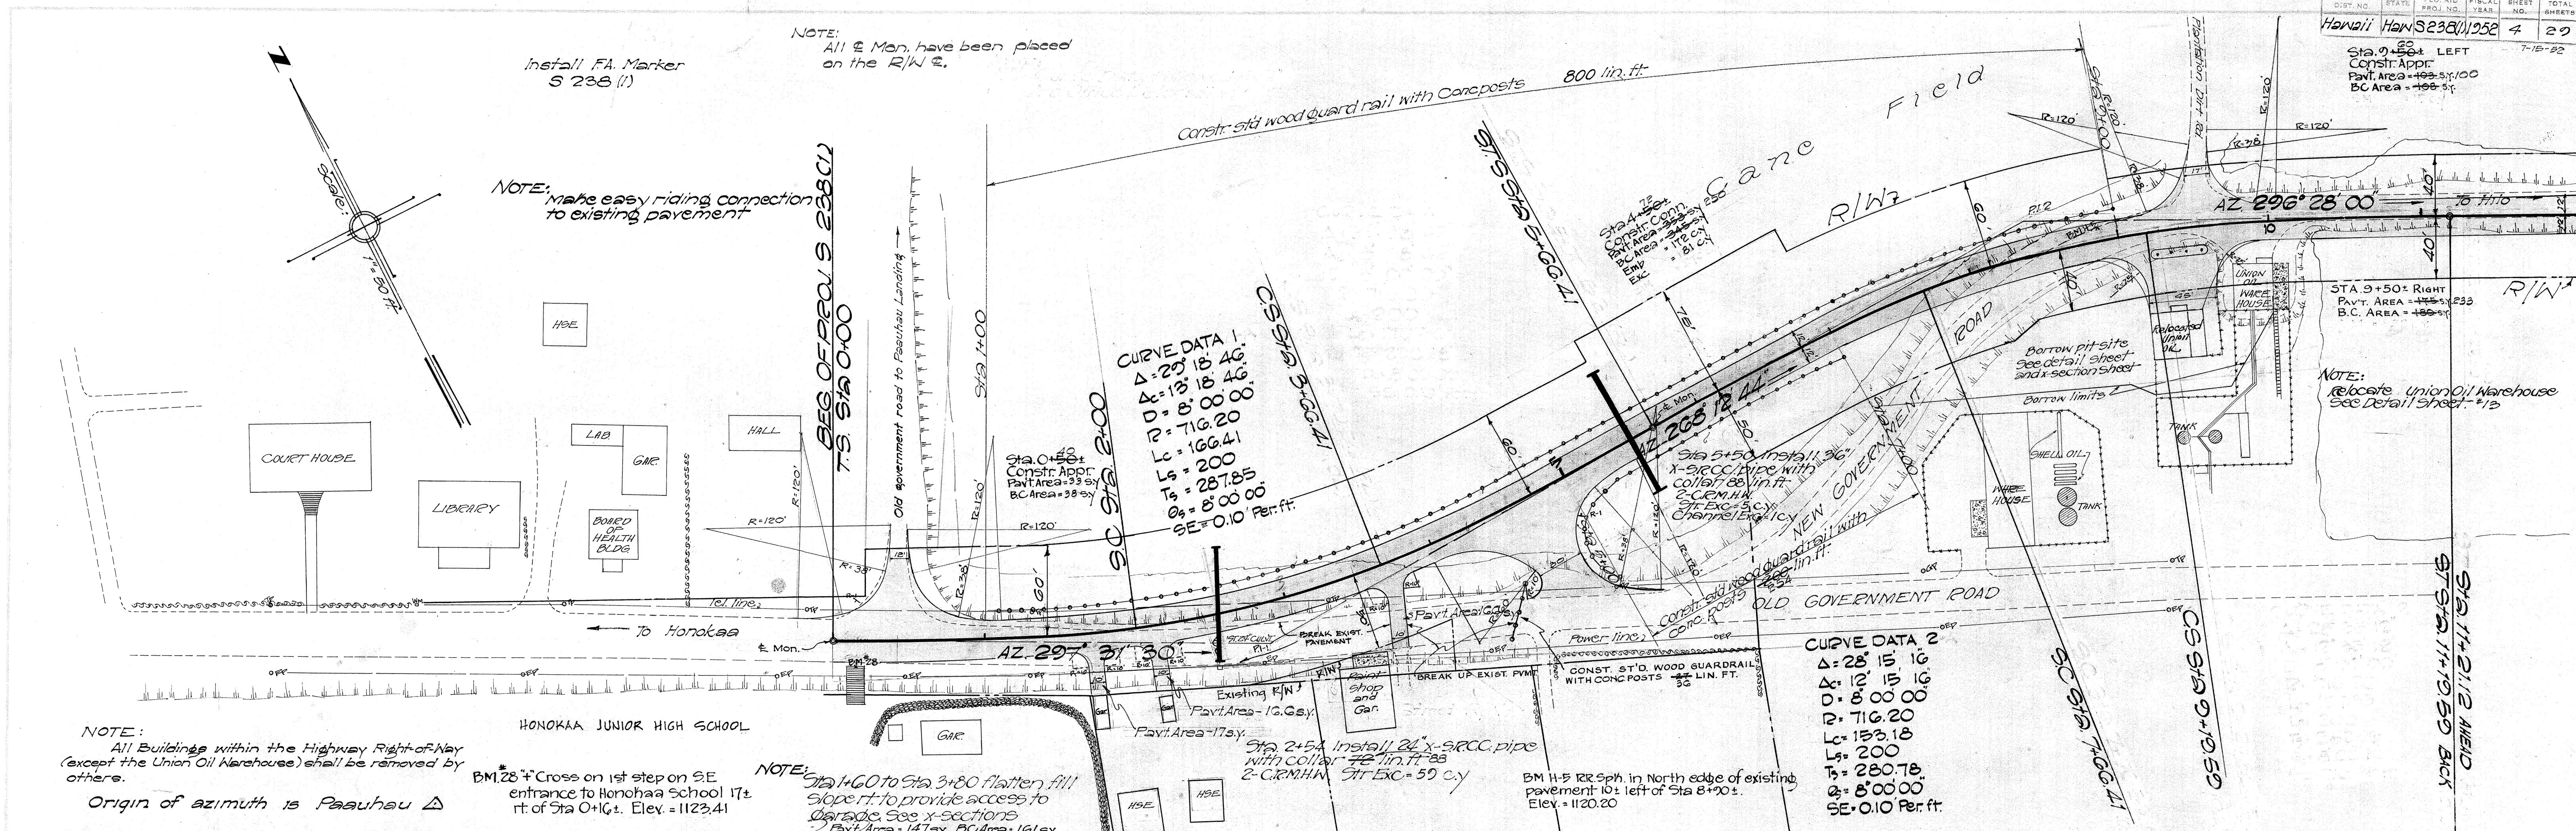
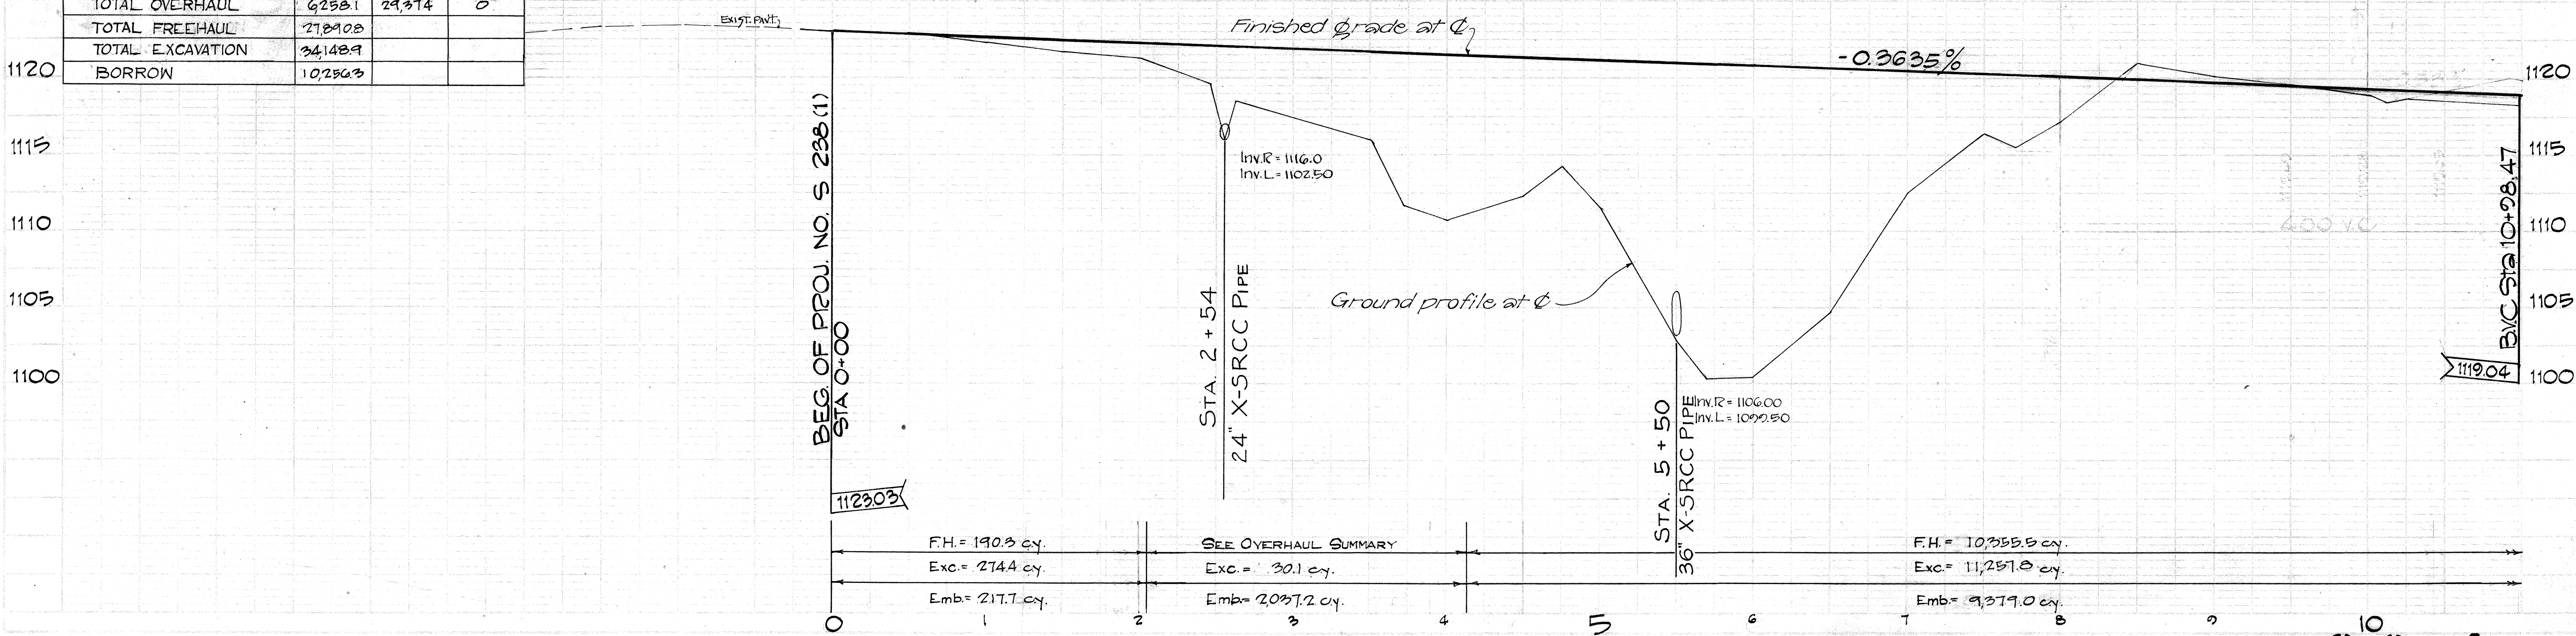


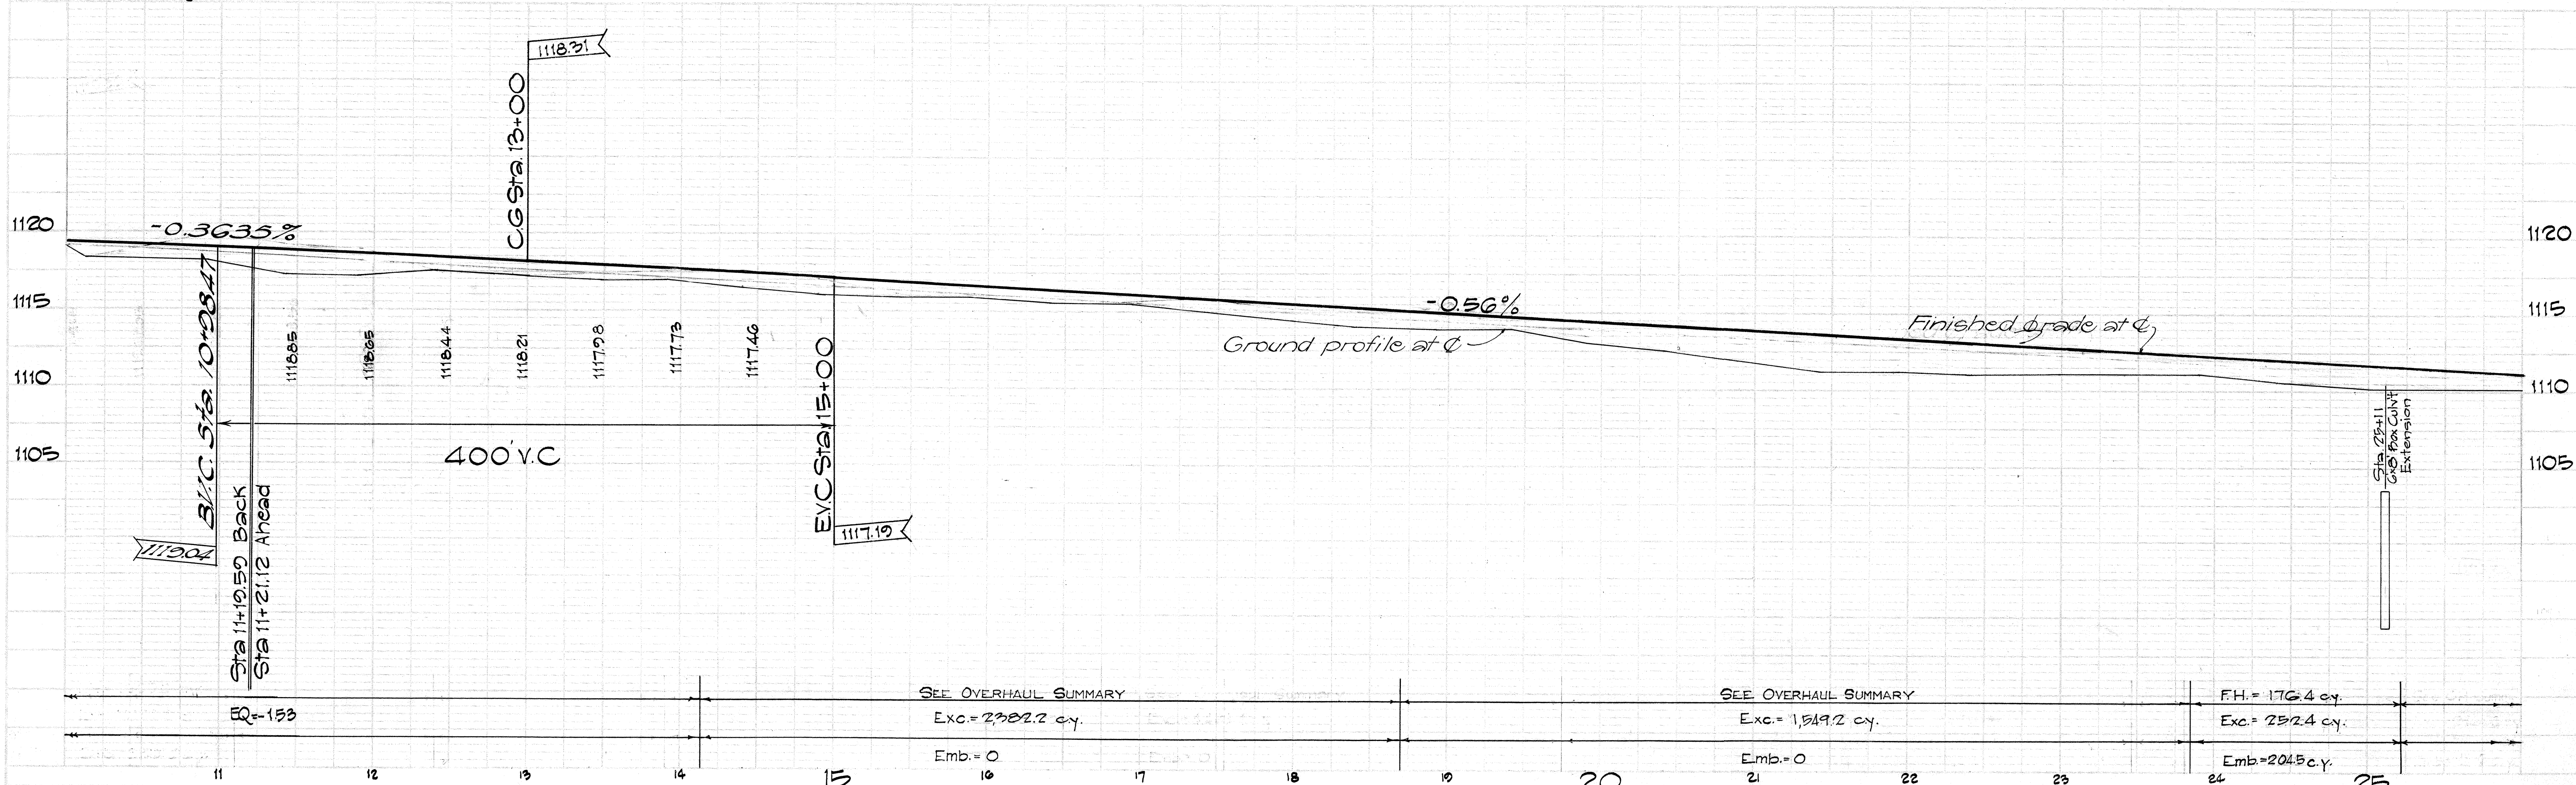

OVERHAUL SUMMARY					
FROM STA.	TO STA.	OVERHAUL DIST.	CUBIC YARDS	STATION YARDS	MILE YARDS
16+35	3+25	3.10	2,401.3	7,444	
21+10	40+45	9.35	1,540.2	14,401	
27+20	40+45	3.25	2,316.6	7,529	
TOTAL OVERHAUL			6,258.1	29,374	0
TOTAL FREEHAUL			27,890.8		
TOTAL EXCAVATION			34,148.9		
BORROW			10,250.3		

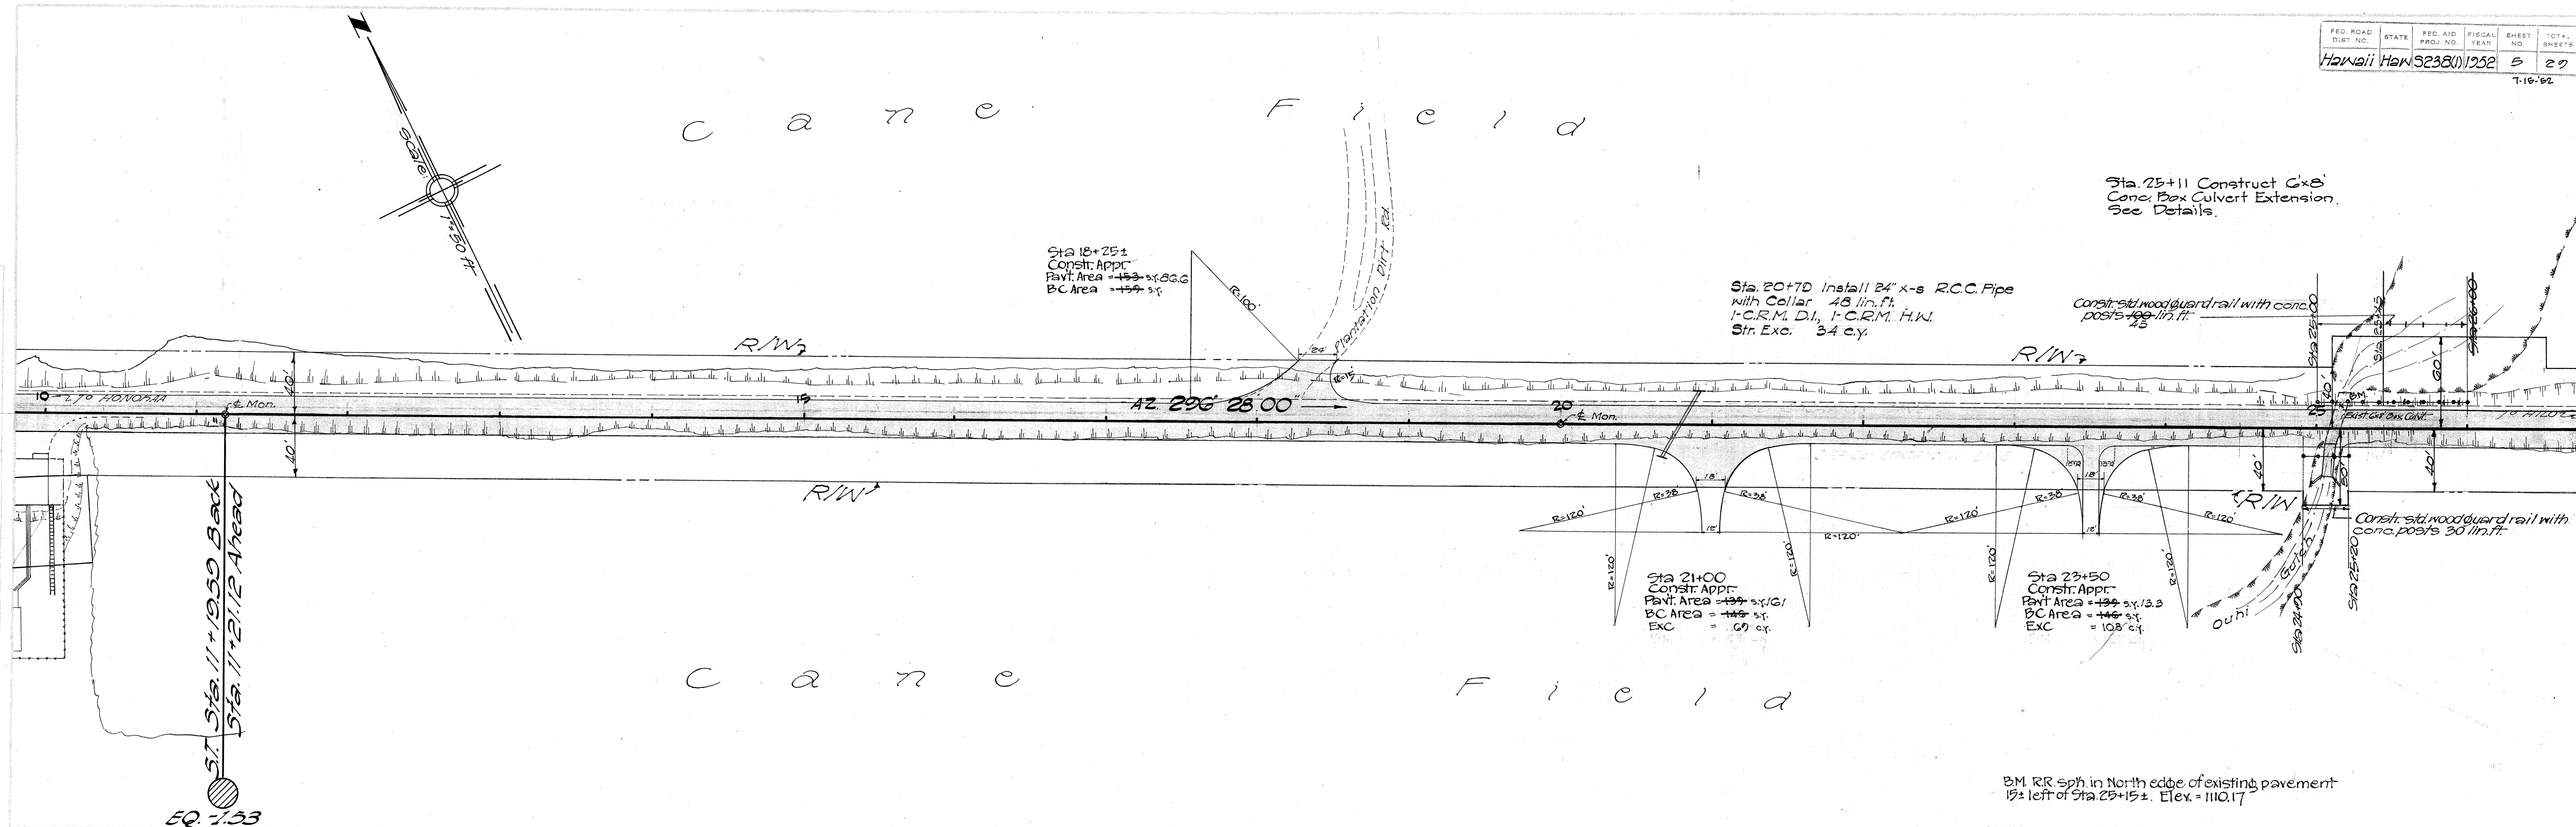


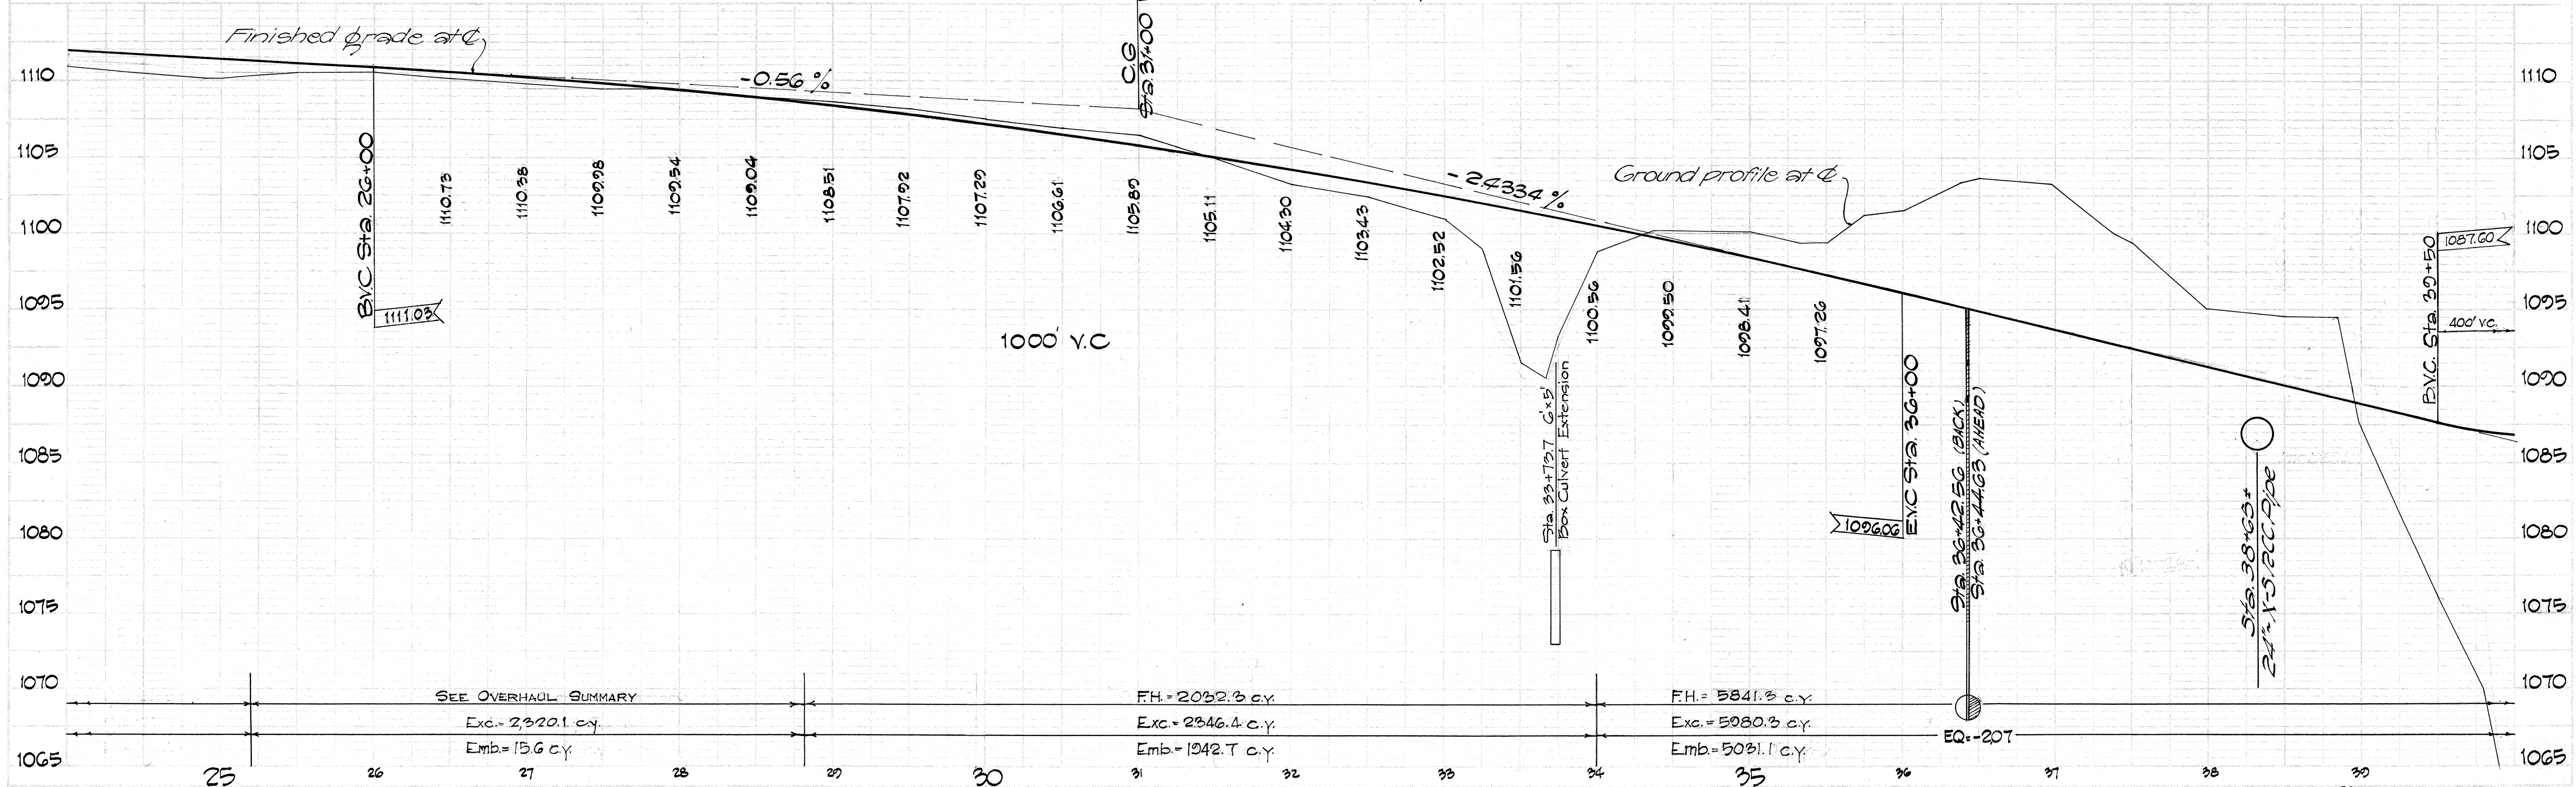

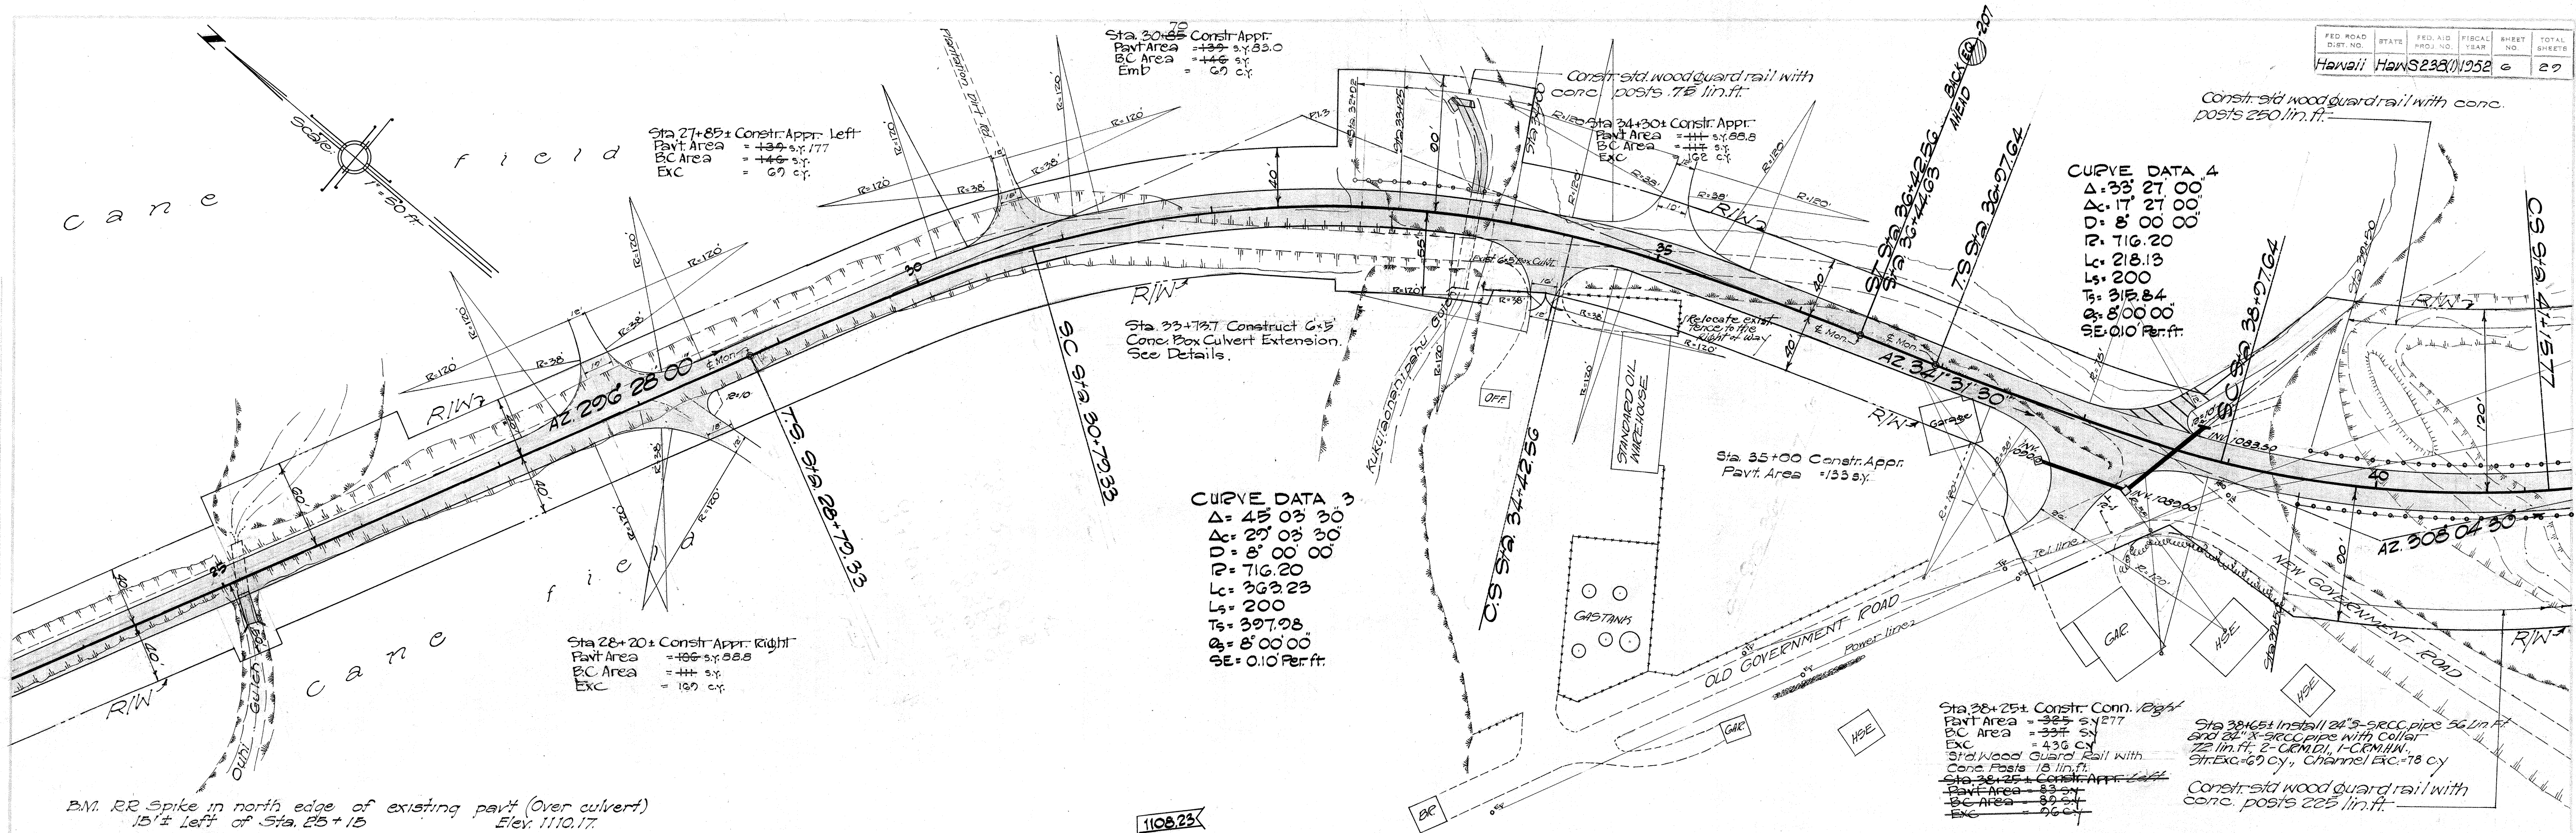

FED. ROAD DIST. NO.	STATE	FED. AID PROJ. NO.	FISCAL YEAR	SHEET NO.	TOTAL SHEETS
Hawaii	Haw	5238(1)	1952	7	27

7-19-52

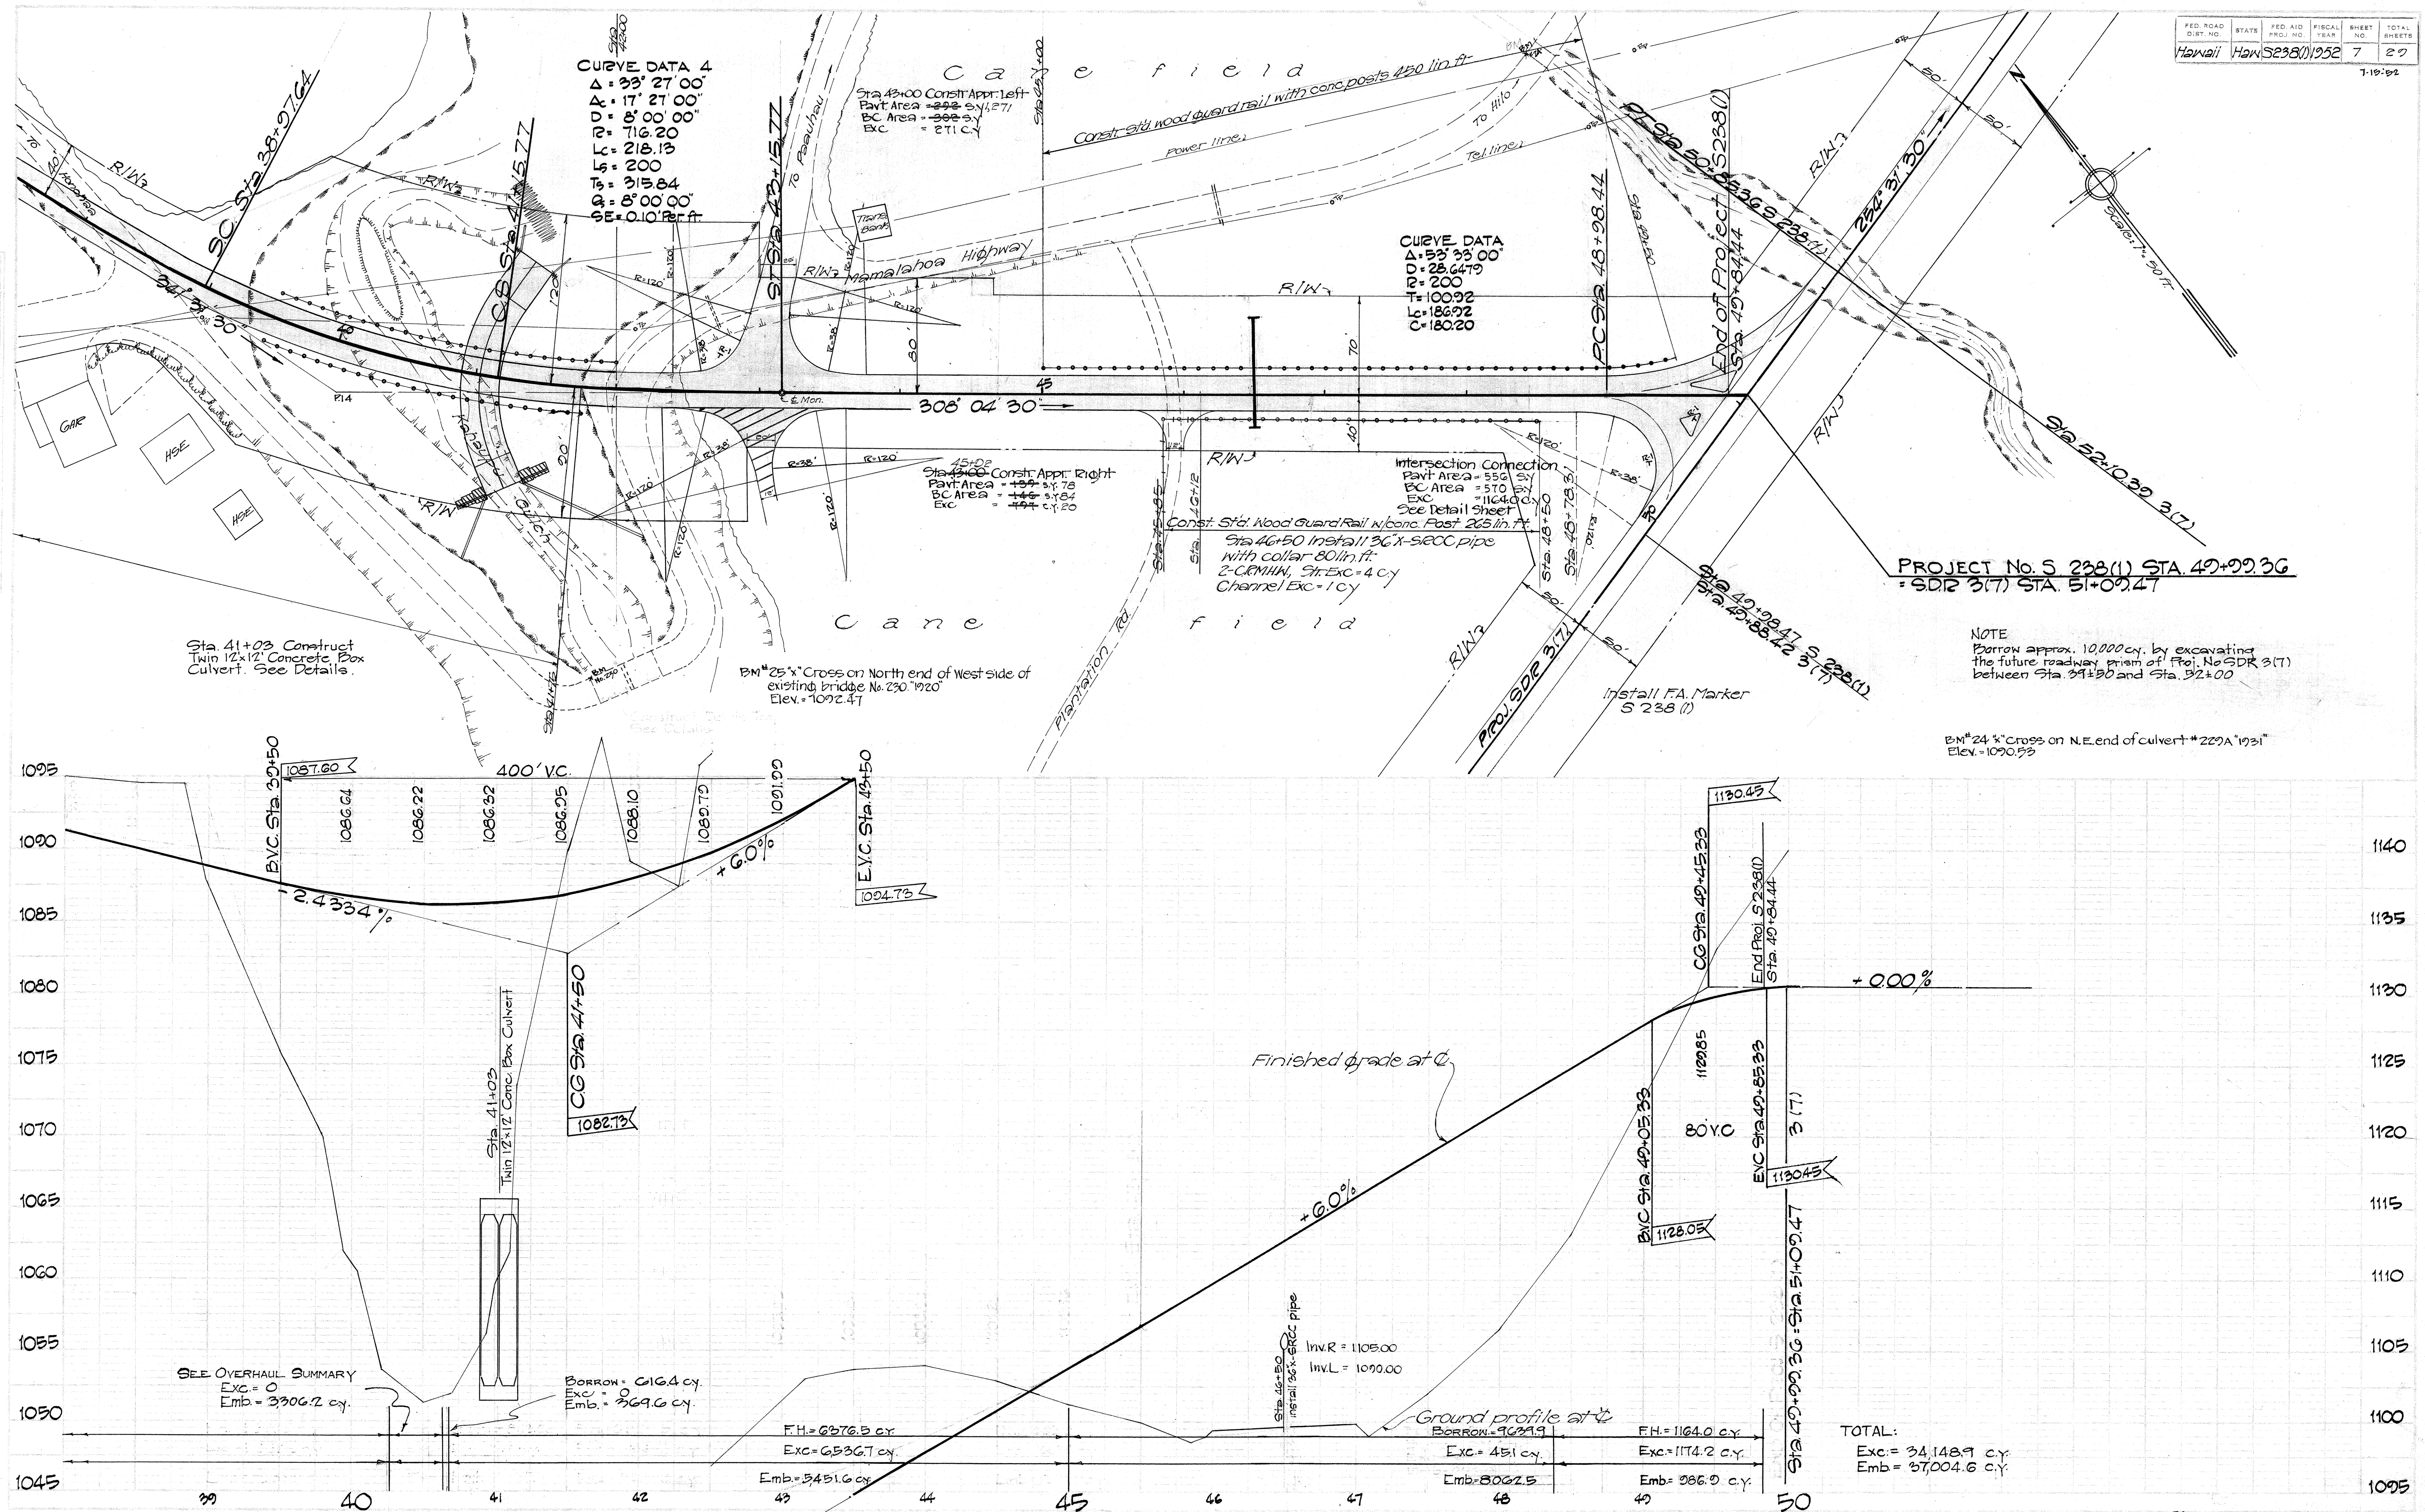

55 \$ 9.7